

GENERAL NOTES



1. The Contractor shall notify the Board of Water Supply in writing one week prior to commencing work on the water system.
2. Asterisk (*) indicates work to be performed by B.W.S. Materials to be furnished by the Contractor unless specified as "relocate".
3. All excavation and backfill shall be done by the Contractor.
4. The locations of existing water mains and appurtenances shown on the plans are approximate only. Any adjustment to the water mains and appurtenances whether shown on the construction plans or not shall be made and paid for by the project.

FED. ROAD DIST. NO.	STATE	FED. AID PROJ. NO.	FISCAL YEAR	SHEET NO.	TOTAL SHEETS
HAWAII	HAW.	F-075-1(3)	1966	17	42

True North
Scale 1"=50'

PLAN	DATE	BY
SURVEYED		
PLOTTED		
NOTE BOOK		
ALIGNMENT CHECKED		
RT. OF WAY CHECKED		


PROFILE	DATE	BY
SURVEYED		
PLOTTED		
NOTE BOOK		
B.M. S. NOTED		
STRUCTURE NOTATIONS CH'KD		

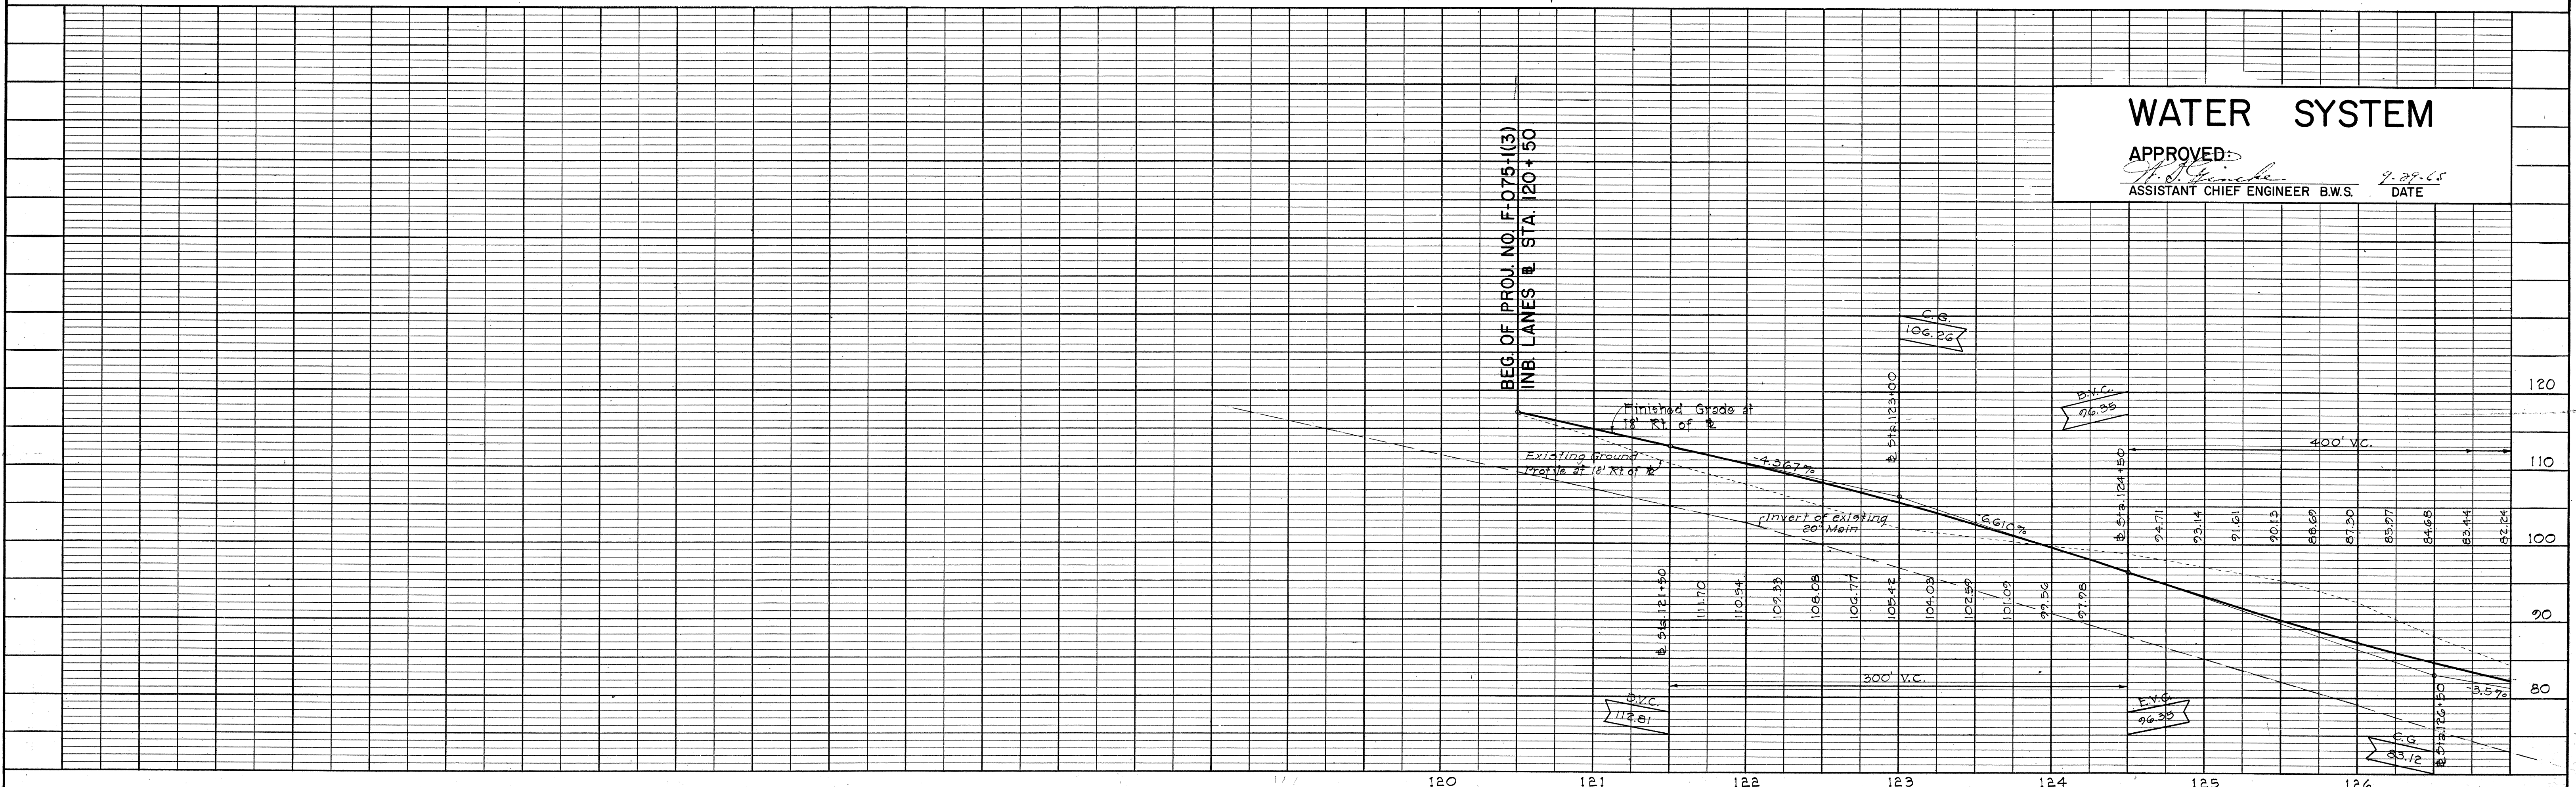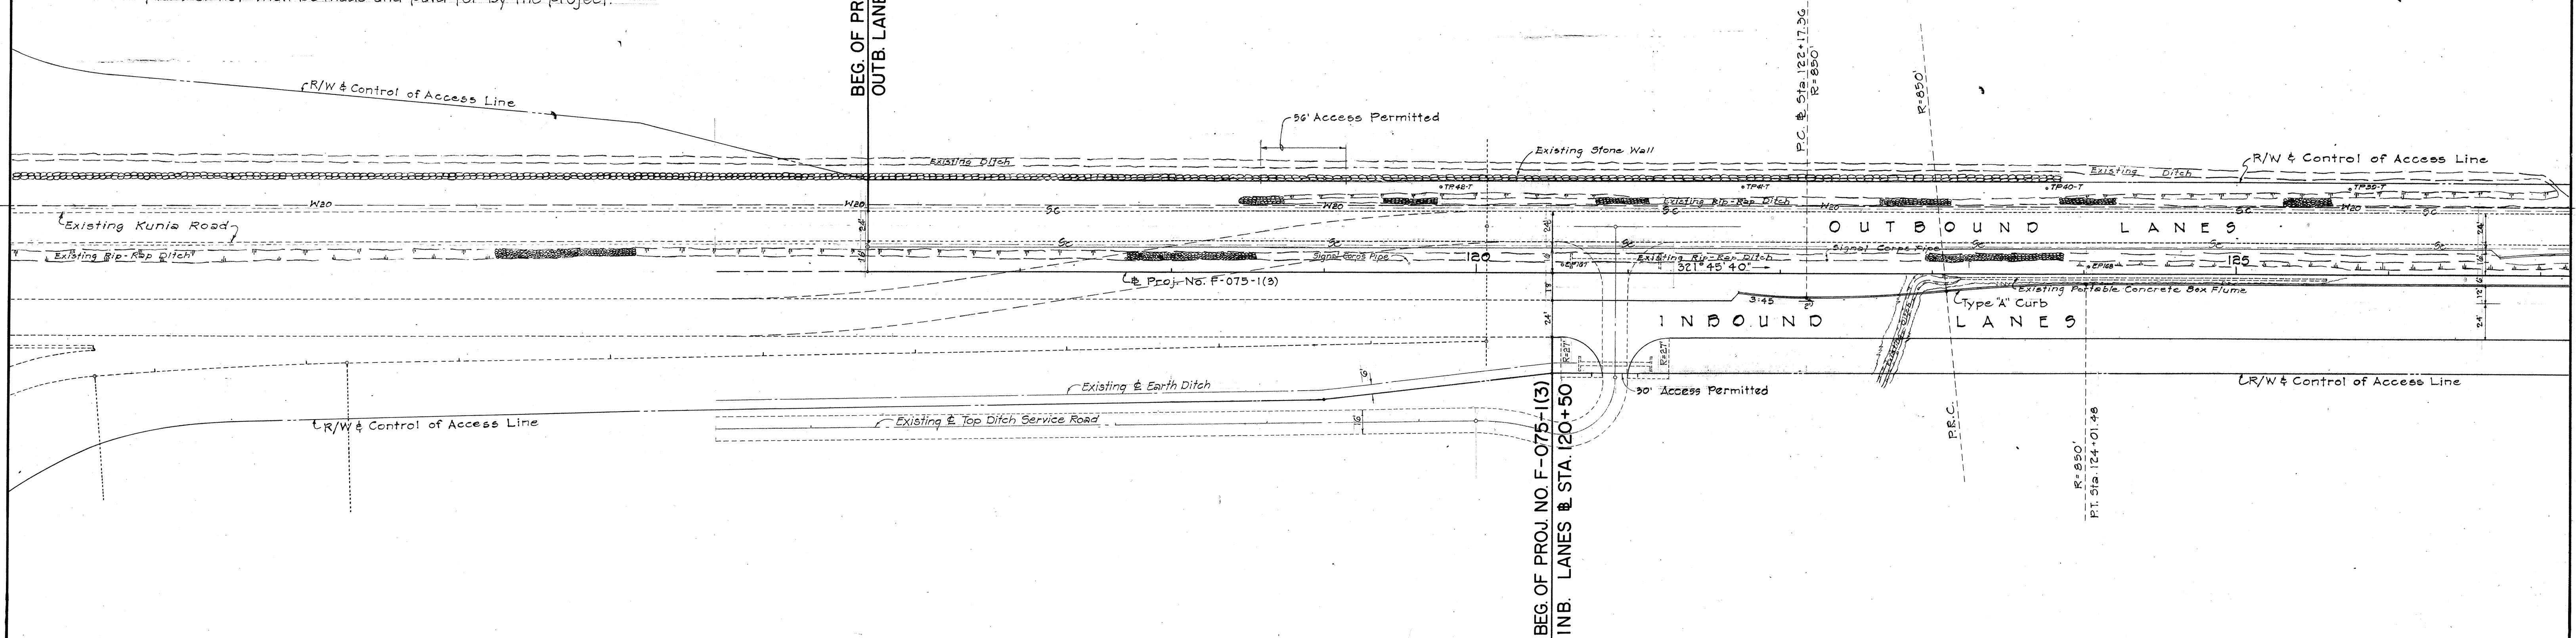

FED. ROAD DIST. NO.	STATE	FED. AID PROJ. NO.	FISCAL YEAR	SHEET NO	TOTAL SHEETS
HAWAII	HAW.	F-075-1(3)	1966	18	42

Note:
For details of connection at
Waipahu St., see Sht. No. 6

Note:
For details of connection at
Farrington Hwy, see Sht. No. 1

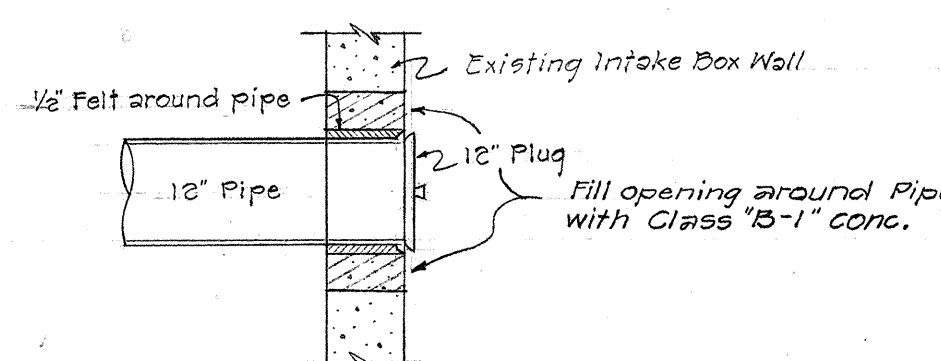

TYPICAL DETAIL OF 12" CLEANOUT THRU INTAKE BOX WALL
Not to Scale

