

INDEX TO DRAWINGS	
SHEET NO.	DESCRIPTION
1	TITLE SHEET
2	TYPICAL SECTIONS
3	PROJ. INFORMATION SIGN

DESIGNED BY: Ronald Tsuzuki
 HIGHWAY DESIGN UNIT
 548-7490
 Jan, 1971
 DATE



STATE OF HAWAII
 DEPARTMENT OF TRANSPORTATION
 HIGHWAYS DIVISION
 HONOLULU, HAWAII
 "AS BUILT"
 PLANS FOR

RESURFACING OF FORT WEAVER ROAD
 (FARRINGTON HWY. TO NAVAL RESERVATION GATE)

PROJECT NO. 760B-02-71

DISTRICT OF EWA
 ISLAND OF OAHU

FED. ROAD DIST. NO.	STATE	FED. AID PROJ. NO.	FISCAL YEAR	SHEET NO.	TOTAL SHEETS
HAWAII	HAW.	760B-02-71	1971	1	3

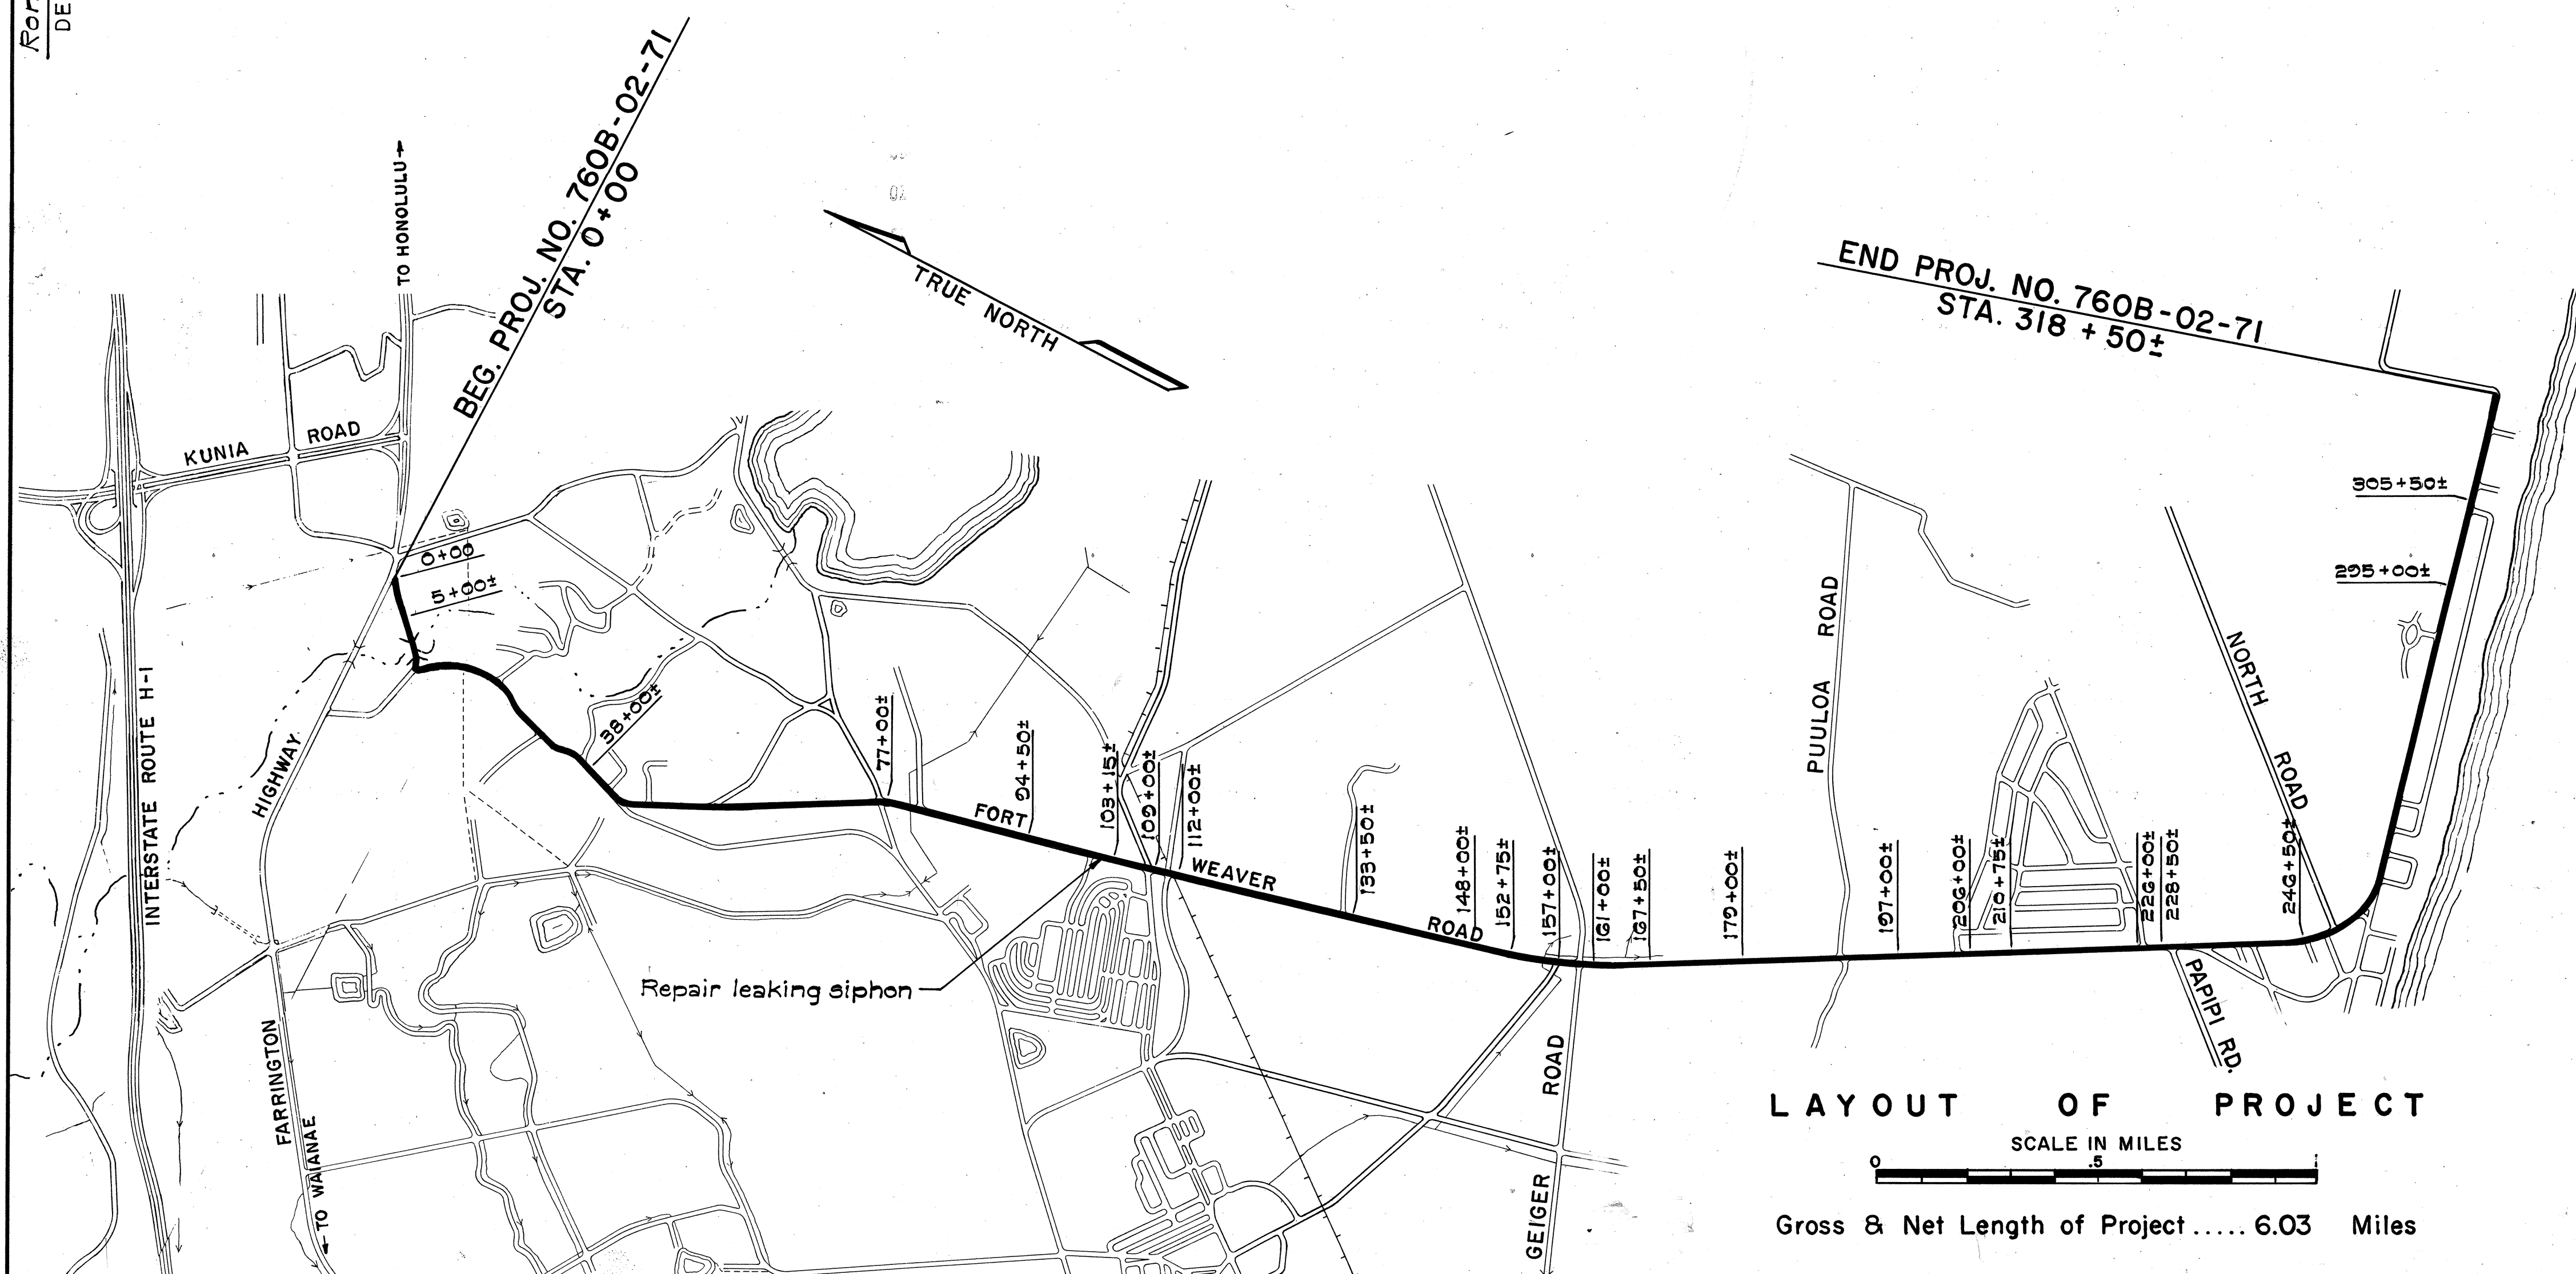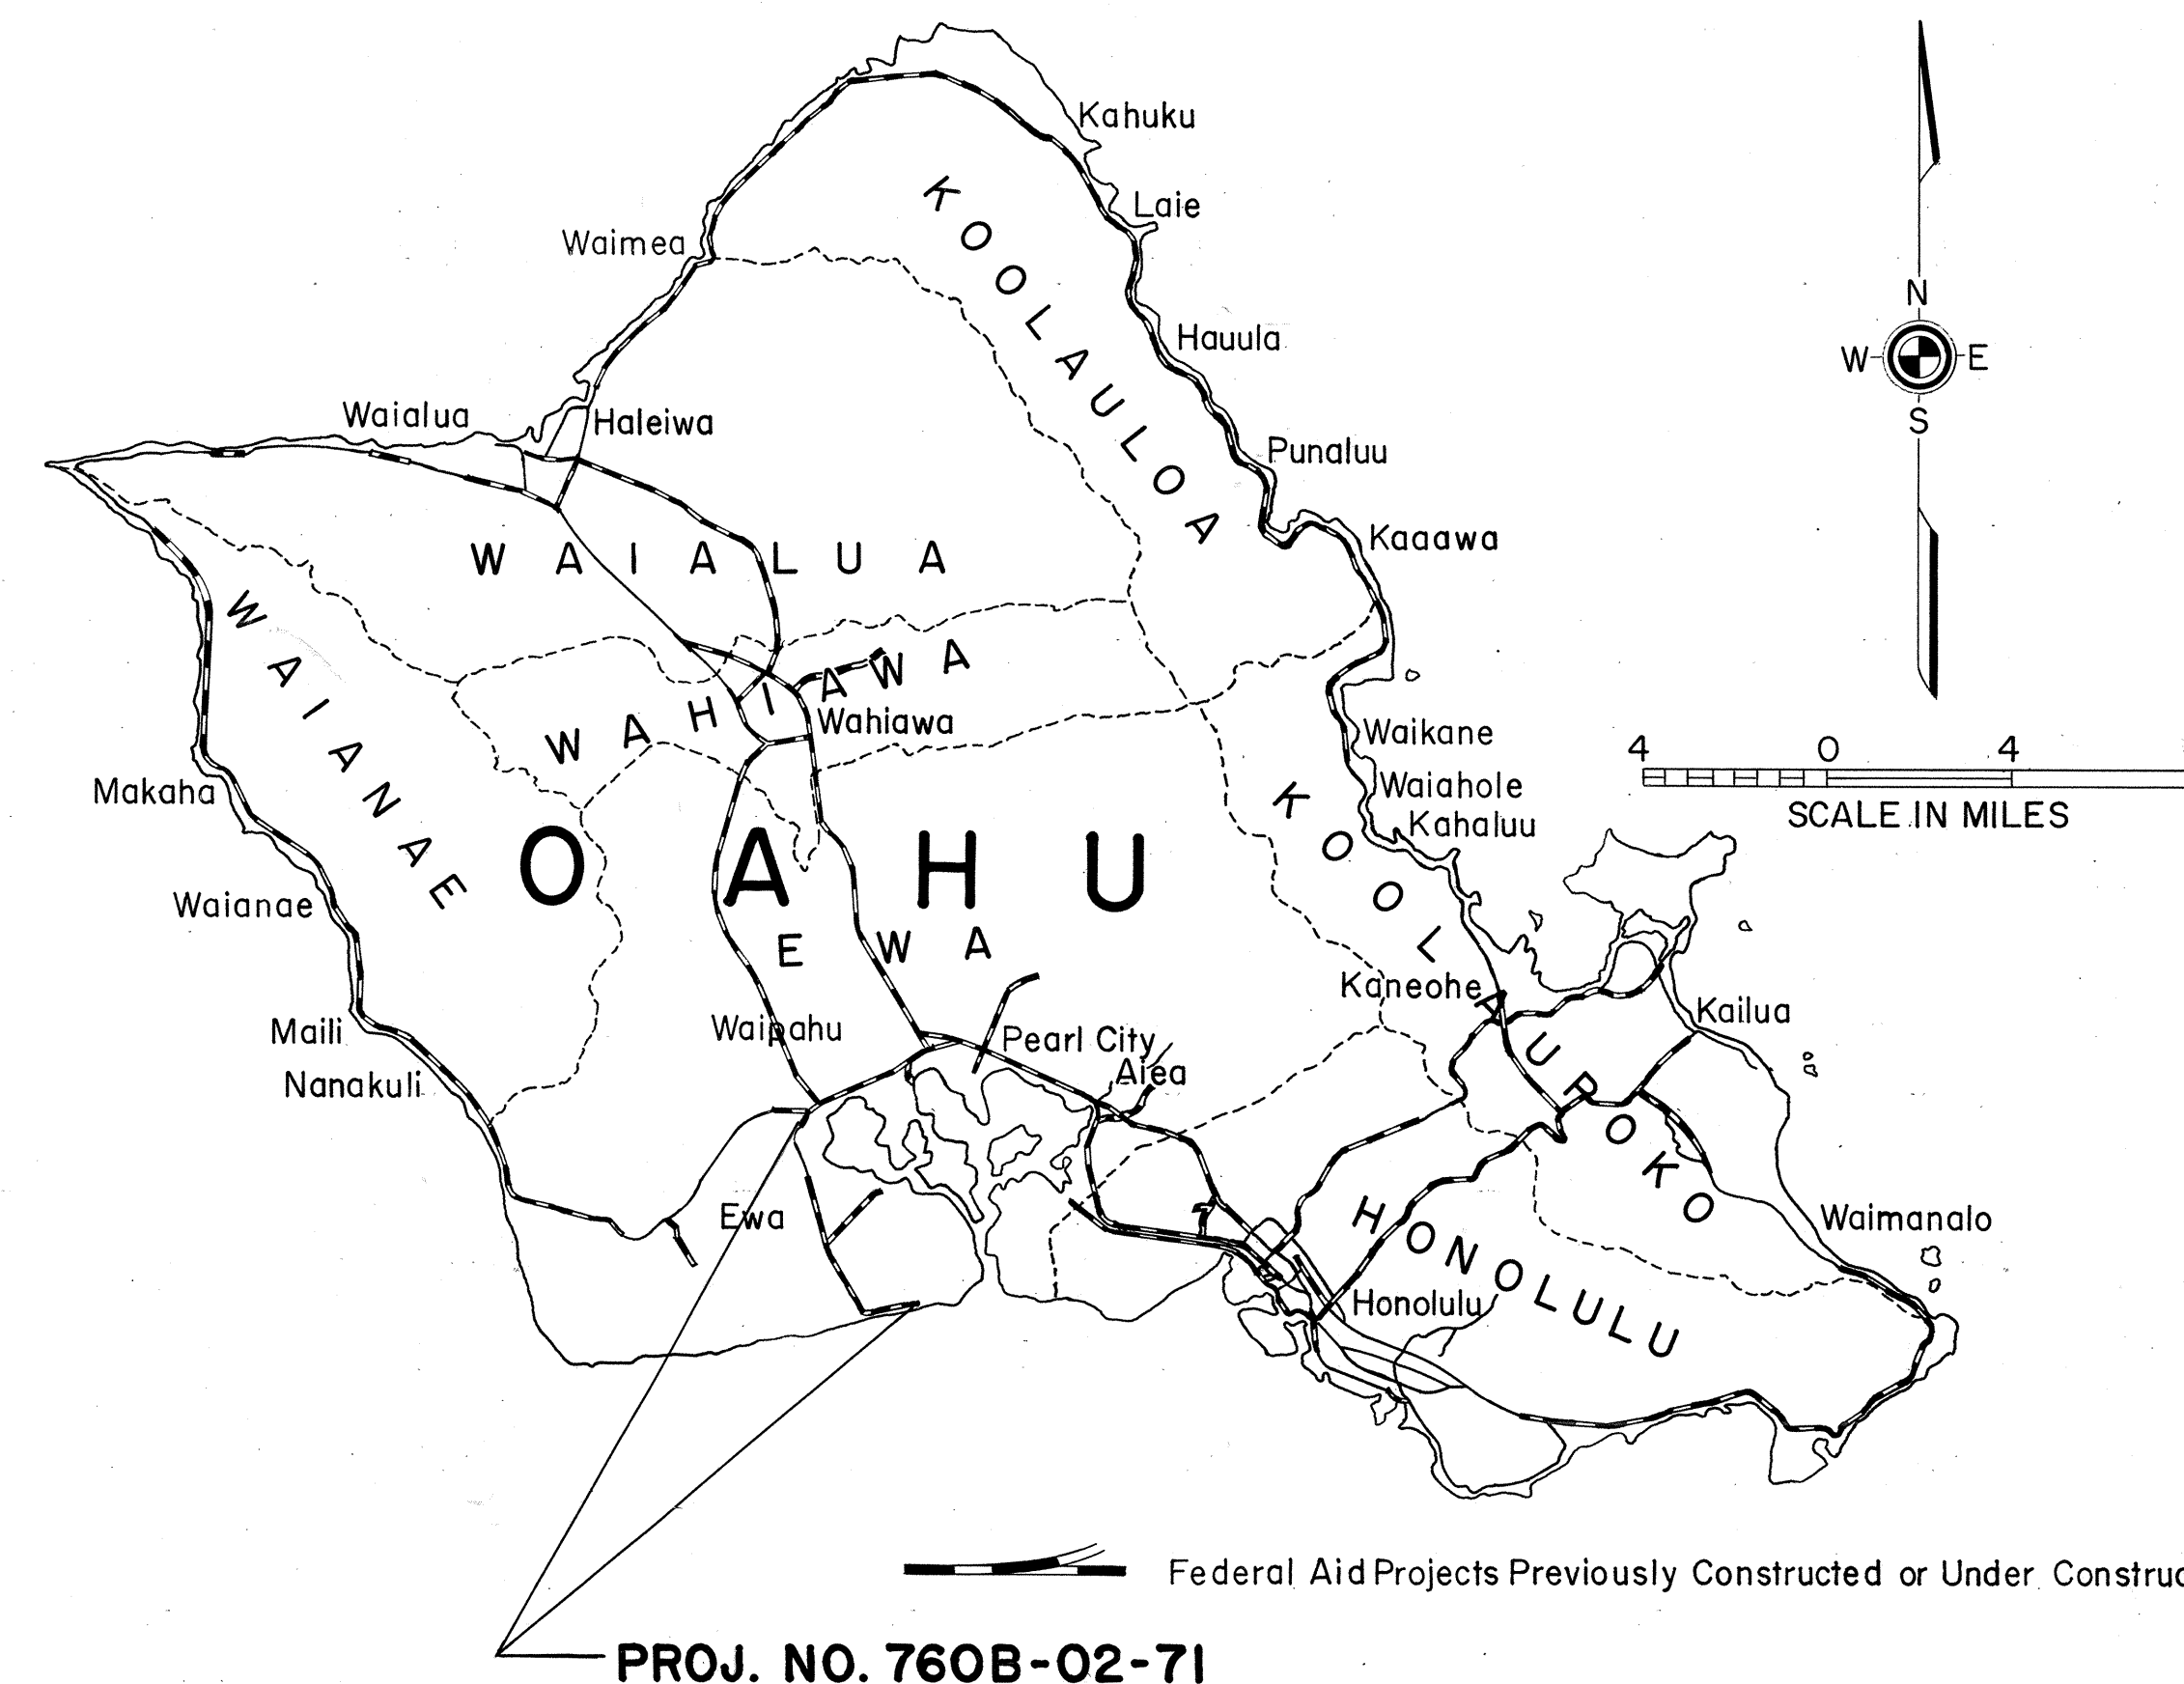

LAYOUT OF PROJECT

SCALE IN MILES
 0 1 2 3 4 5 6 7 8
 Gross & Net Length of Project 6.03 Miles

NOTE:

ALL CHANGES MADE DURING CONSTRUCTION HAVE
 BEEN NOTED IN RED ON THESE TRACINGS AND
 CHECKED BY

Bernard J. Kach
 PROJECT ENGINEER

7/18/73
 DATE

DEPARTMENT OF TRANSPORTATION STATE OF HAWAII	
APPROVED:	
<u>E. Alvey Knight</u>	2/8/71
for DIR. OF TRANSPORTATION	DATE