



FED. ROAD DIST. NO.	STATE	PROJ. NO.	FISCAL YEAR	SHEET NO.	TOTAL SHEETS
HAWAII	HAW.	760AB-01-72	1972	13	16

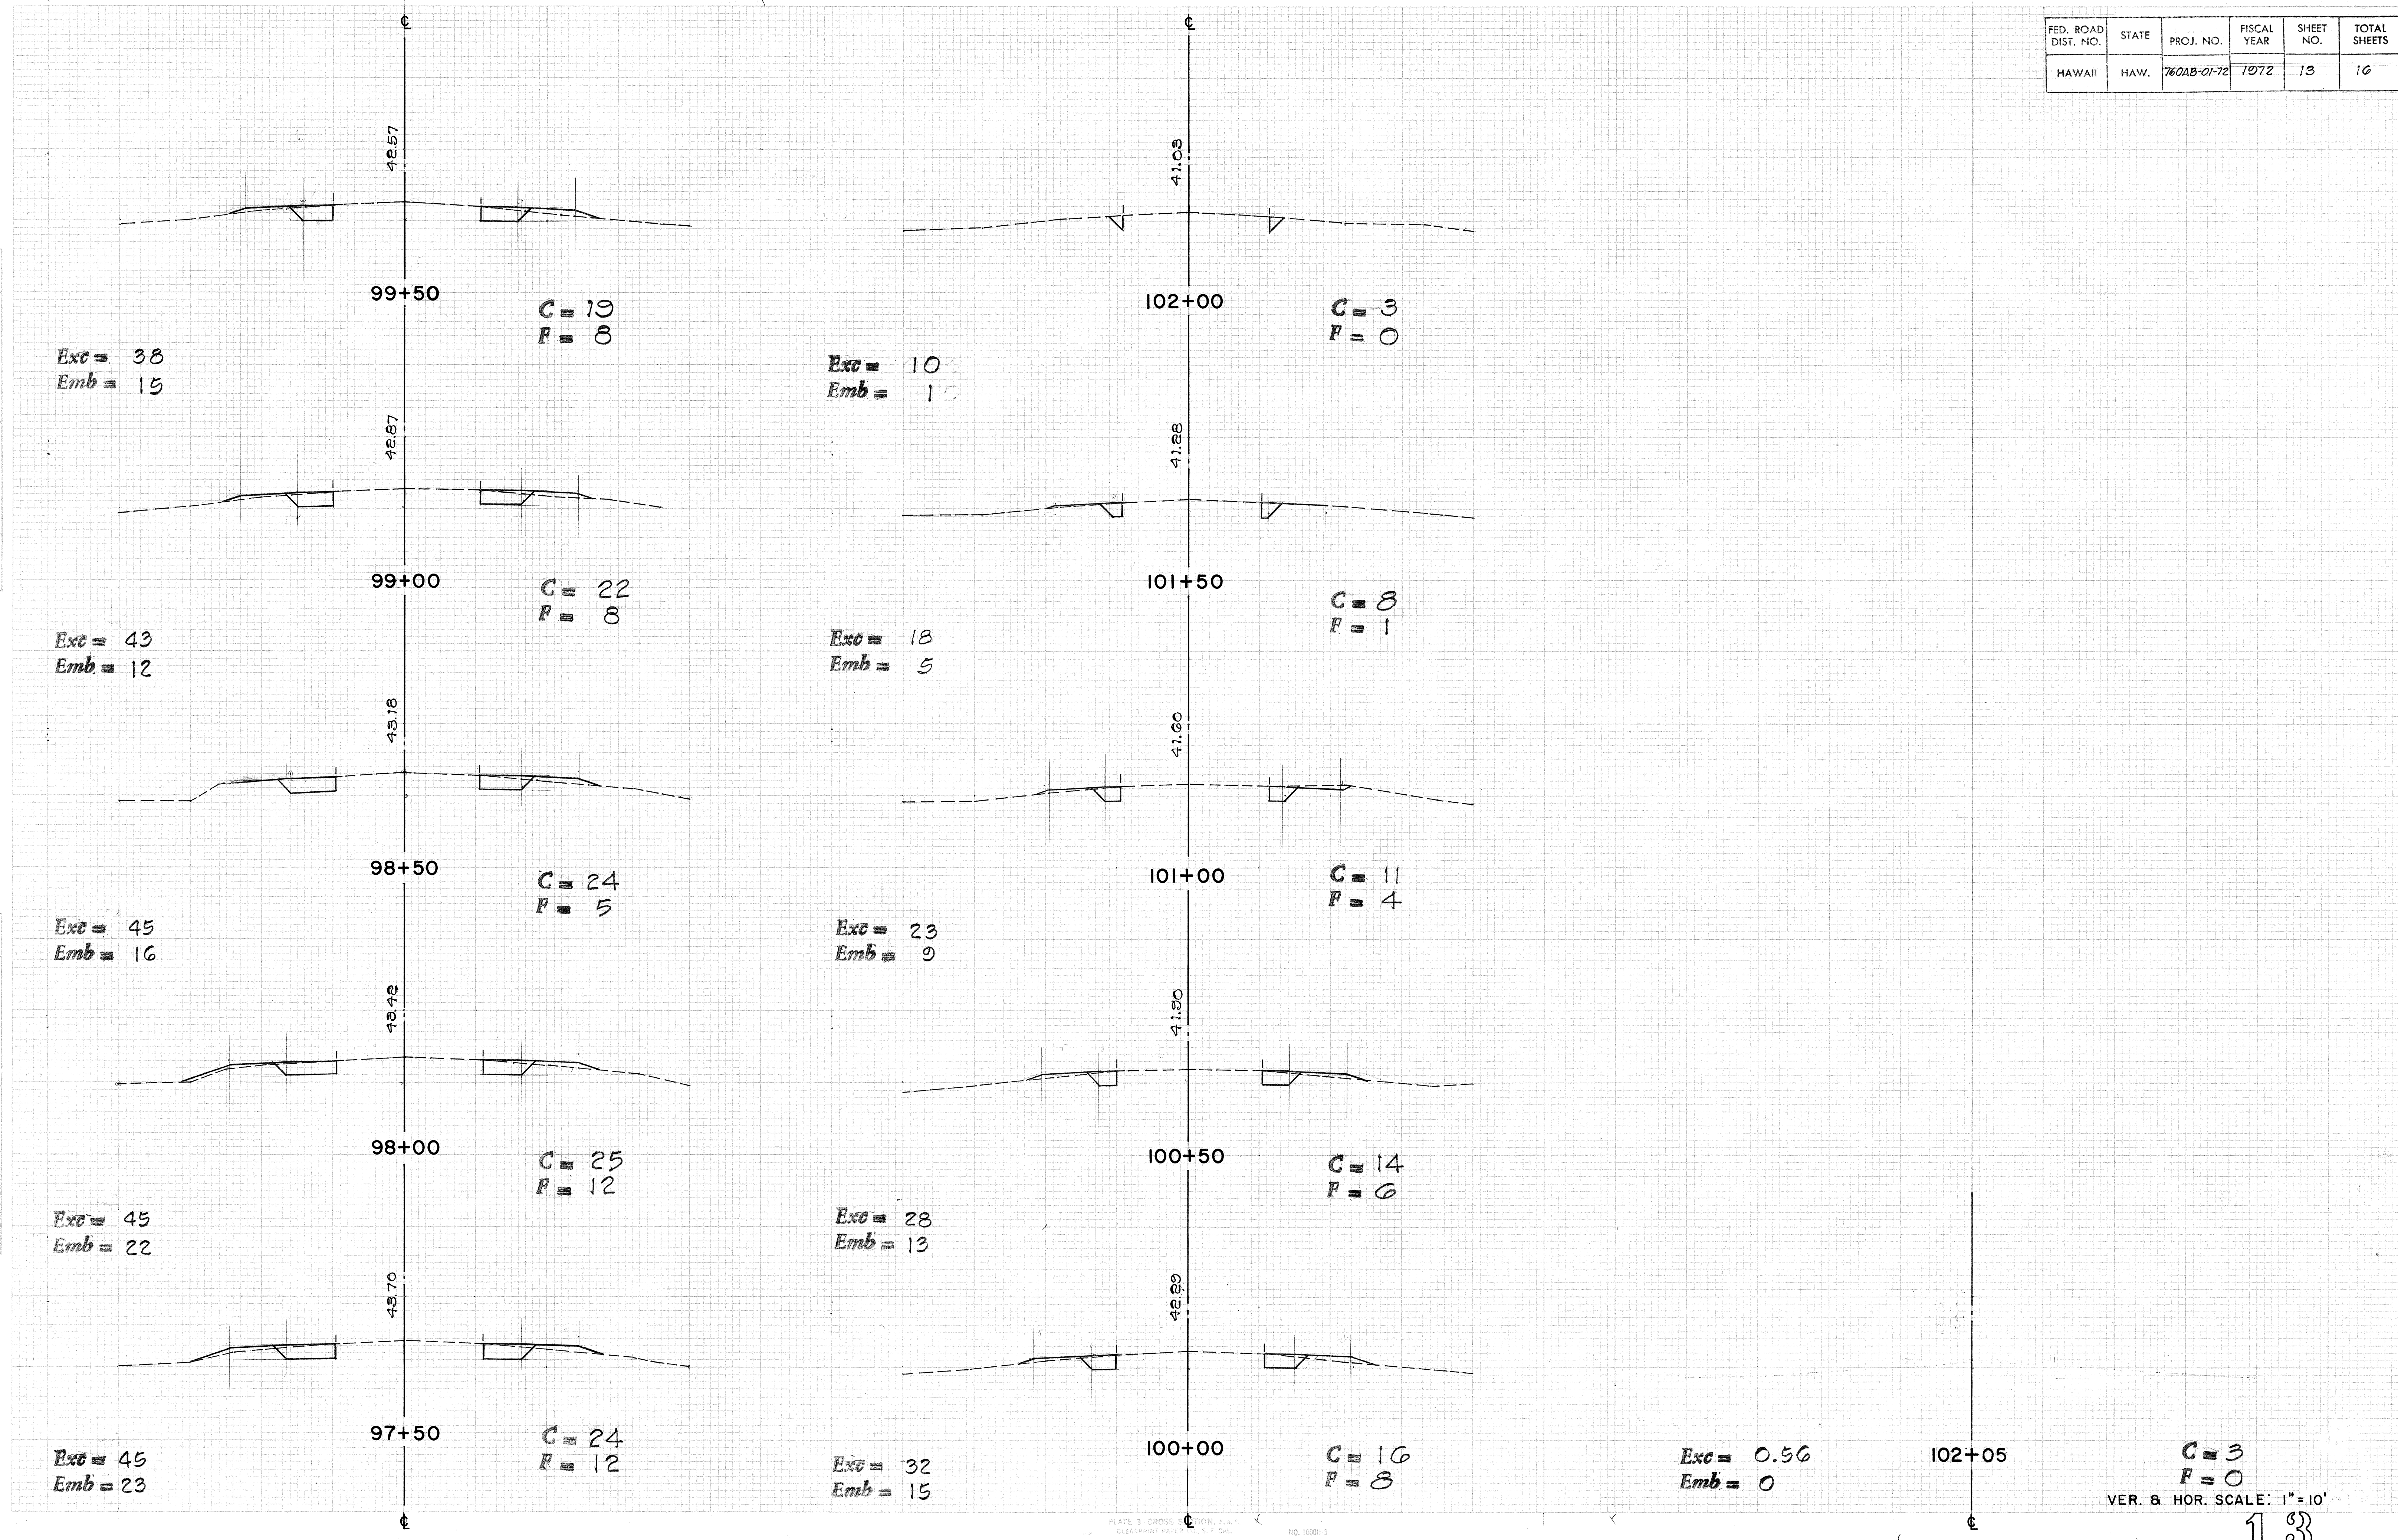

FED. ROAD DIST. NO.	STATE	PROJ. NO.	FISCAL YEAR	SHEET NO.	TOTAL SHEETS
HAWAII	HAW.	760AB-01-72	1972	14	16

DATE	BY	NO.

DATE	BY	NO.

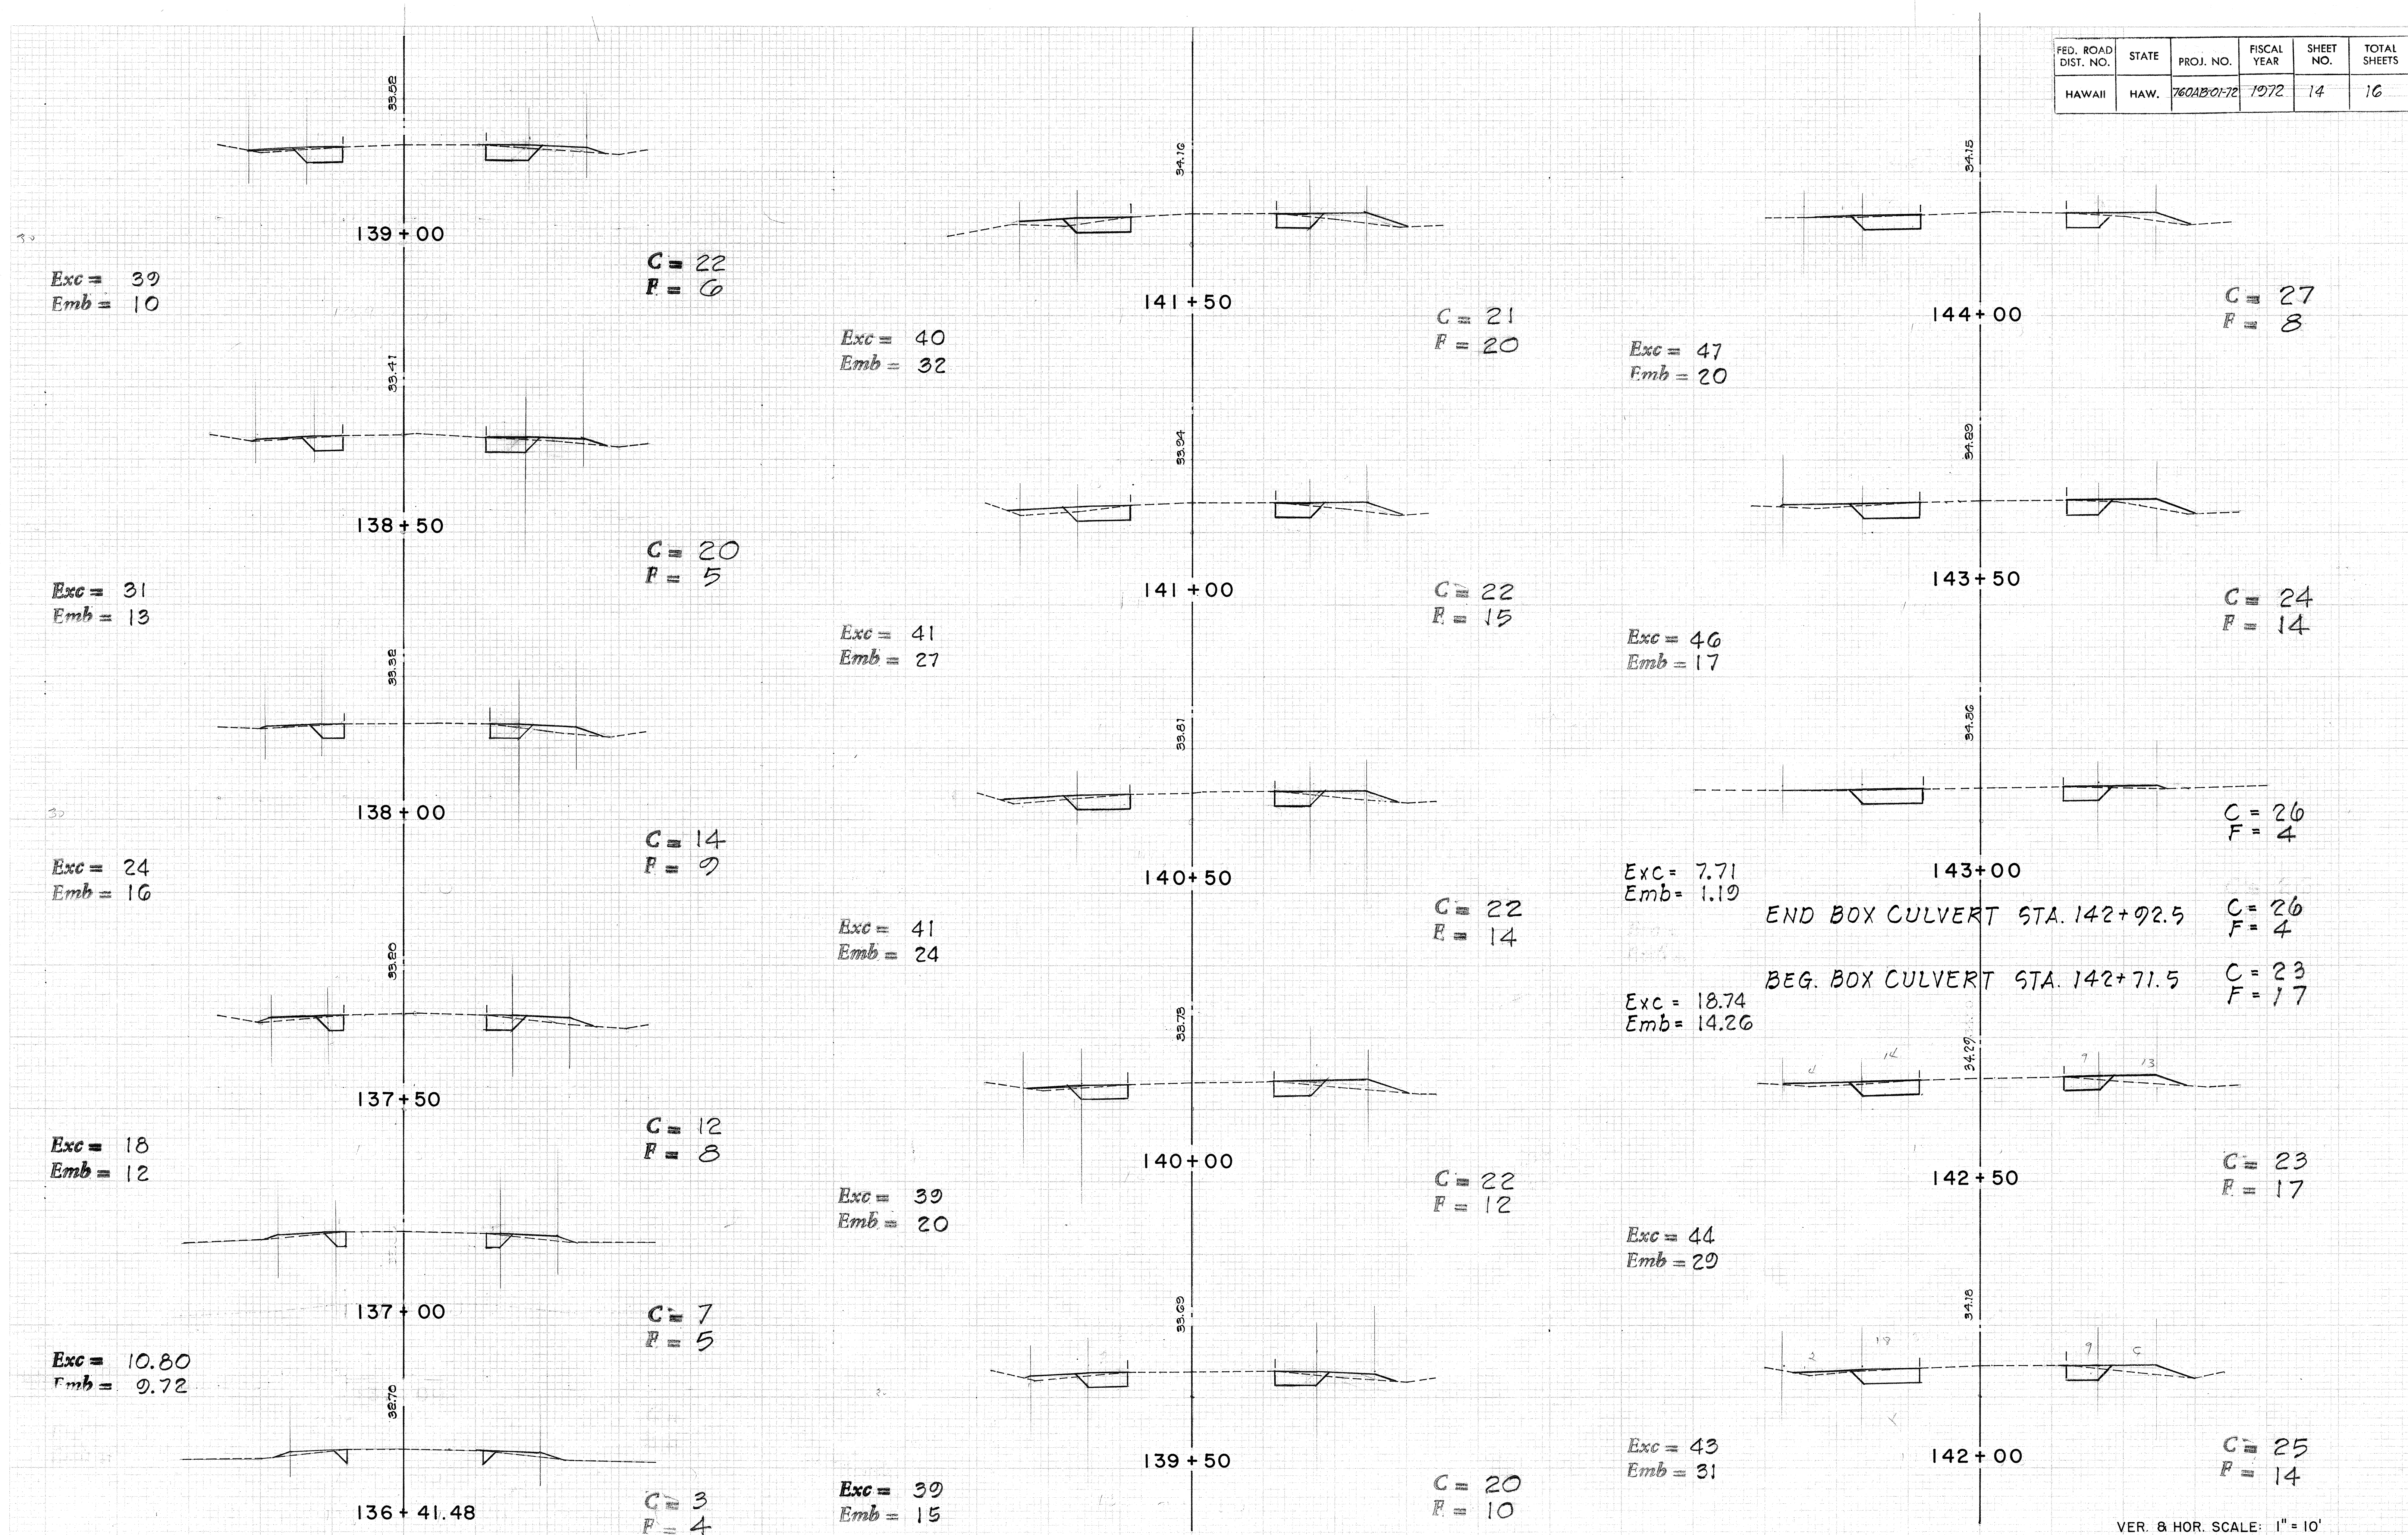

FED. ROAD DIST. NO.	STATE	PROJ. NO.	FISCAL YEAR	SHEET NO.	TOTAL SHEETS
HAWAII	HAW.	7604B-01-72	1972	15	16

DATE: _____
BY: _____
SURVEYED: _____
PLOTTED: _____
NOTE BOOK: _____
NO. _____

DATE: _____
BY: _____
SURVEYED: _____
PLOTTED: _____
NOTE BOOK: _____
NO. _____

Exc = 9
Emb = 0

Exc = 33
Emb = 1

Exc = 53
Emb = 1

Exc = 54
Emb = 2

Exc = 50
Emb = 9

146+50

146+00

145+50

145+00

144+50

C = 0
F = 0

C = 10
F = 0

C = 26
F = 1

C = 31
F = 0

C = 27
F = 2

Exc = 44
Emb = 5

Exc = 44
Emb = 6

Exc = 46
Emb = 3

Exc = 30
Emb = 0

Exc = 6
Emb = 0

149+00

148+50

148+00

147+50

147+00

C = 25
F = 2

C = 23
F = 3

C = 24
F = 3

C = 26
F = 0

C = 6
F = 0

Exc = 48
Emb = 6

Exc = 48
Emb = 7

Exc = 49
Emb = 5

Exc = 48
Emb = 4

Exc = 46
Emb = 4

151+50

151+00

150+50

150+00

149+50

C = 26
F = 2

C = 26
F = 4

C = 26
F = 3

C = 27
F = 2









C = 25
F = 2

VER. & HOR. SCALE: 1" = 10'

FED. ROAD DIST. NO.	STATE	PROJ. NO.	FISCAL YEAR	SHEET NO.	TOTAL SHEETS
HAWAII	HAW.	760AB-01-72	1972	16	16

FINAL	DATE
SURVEY	BY
NOTE BOOK	NO.
REMARKS	
AREAS CHECKED	

FINAL	DATE
SURVEY	BY
NOTE BOOK	NO.
REMARKS	
AREAS CHECKED	

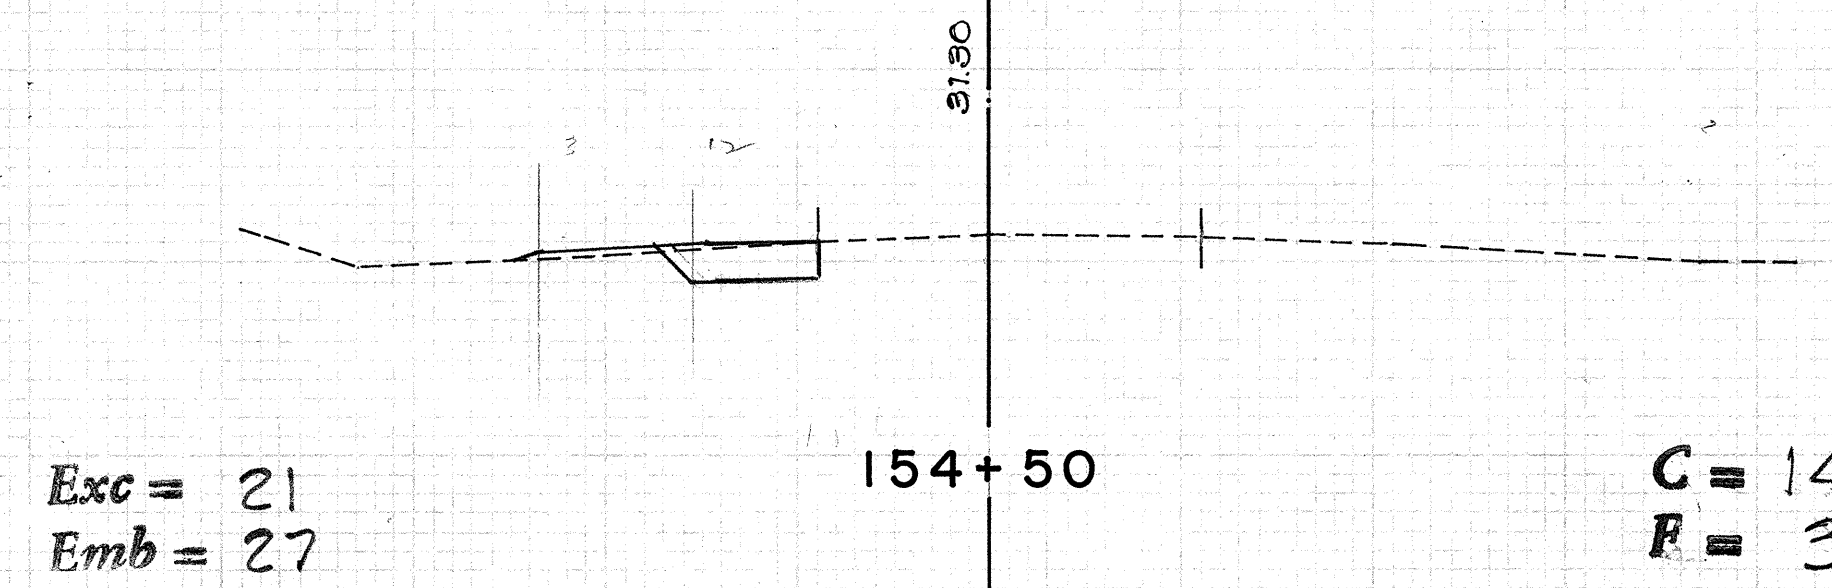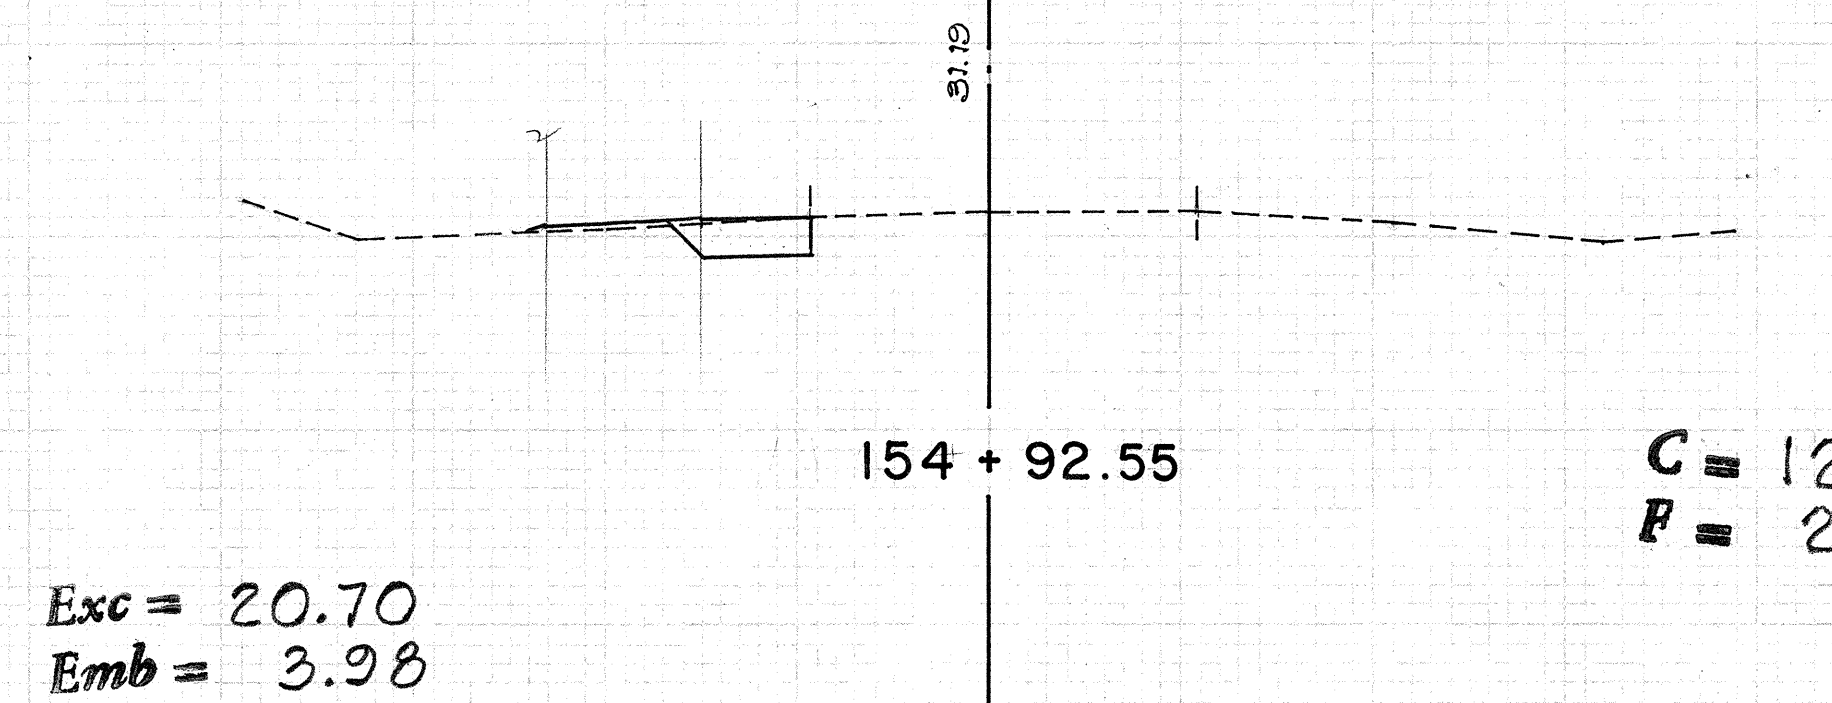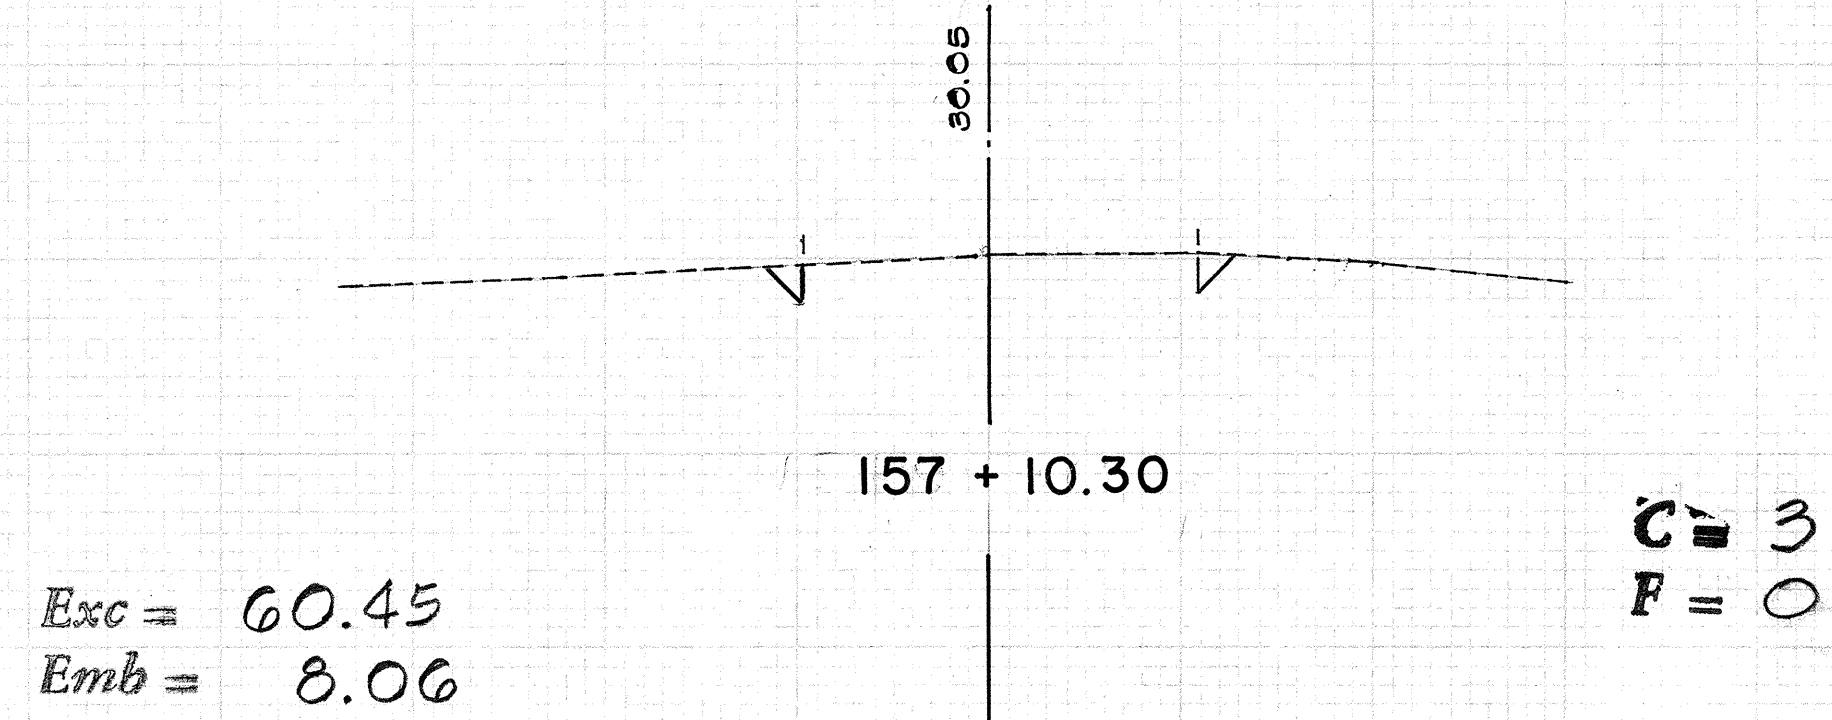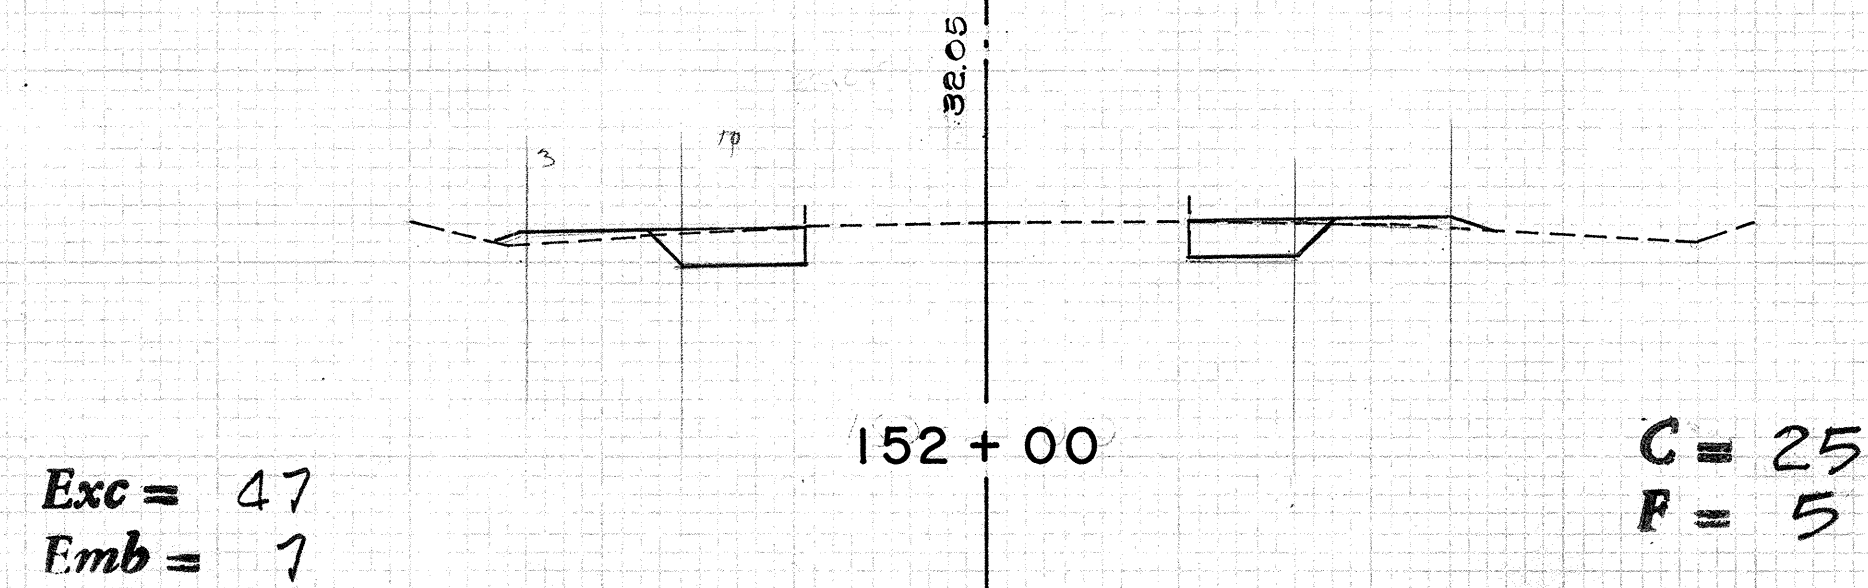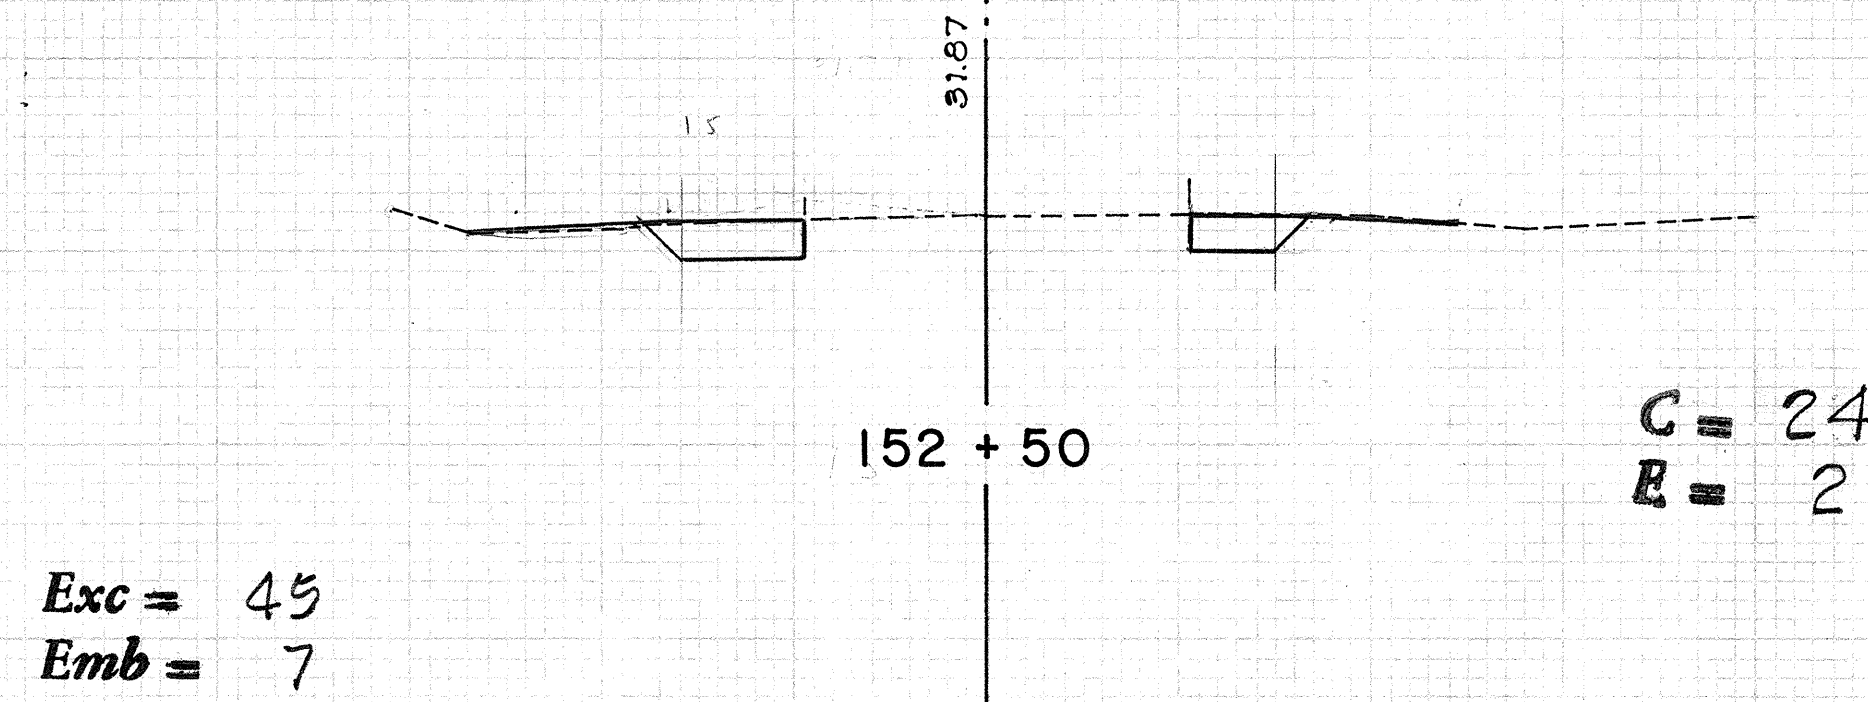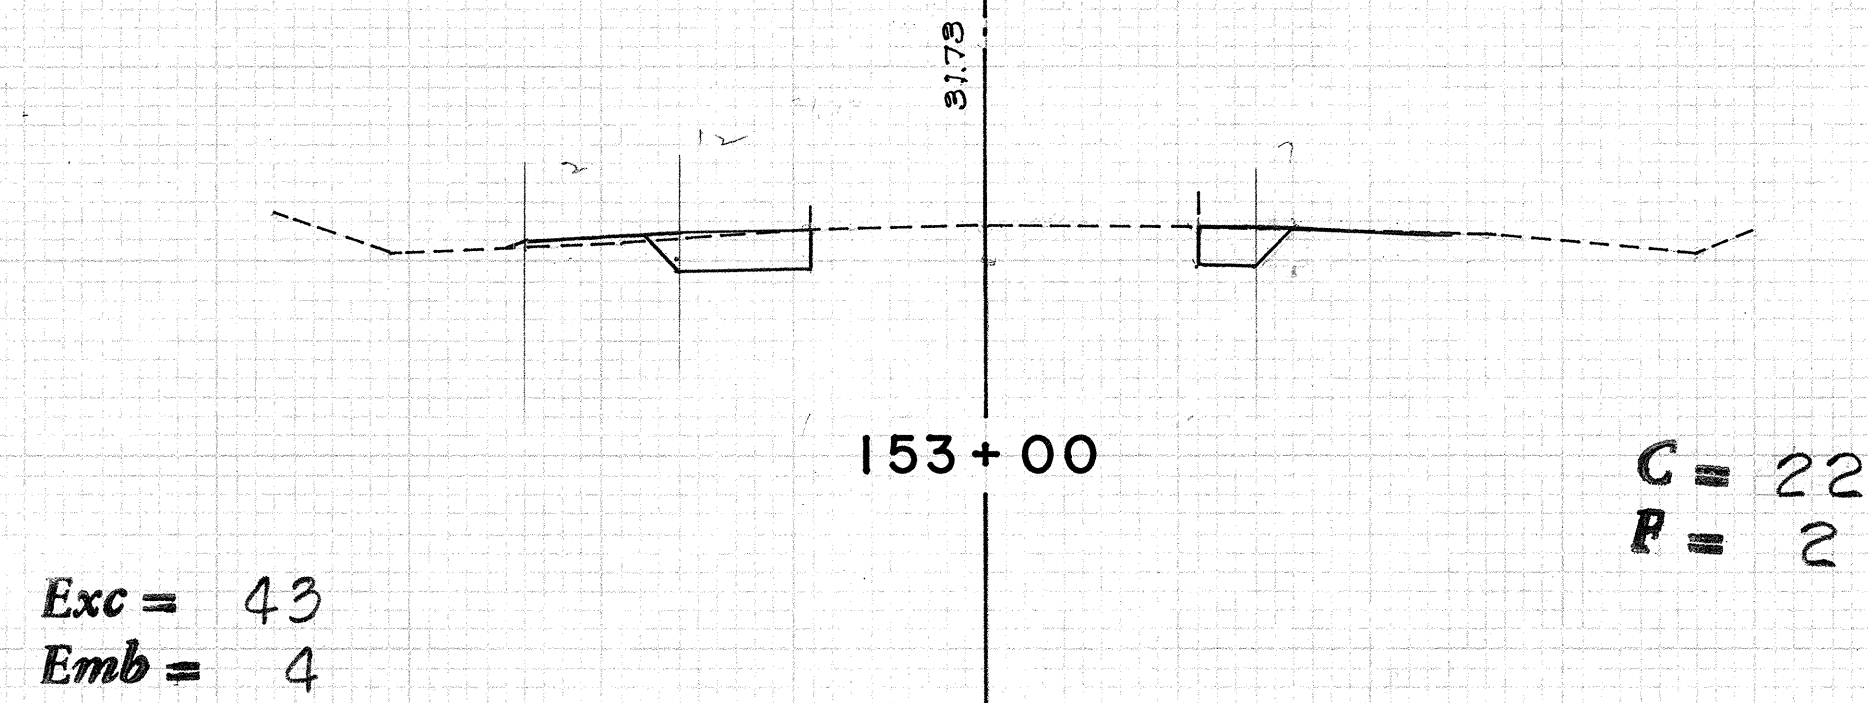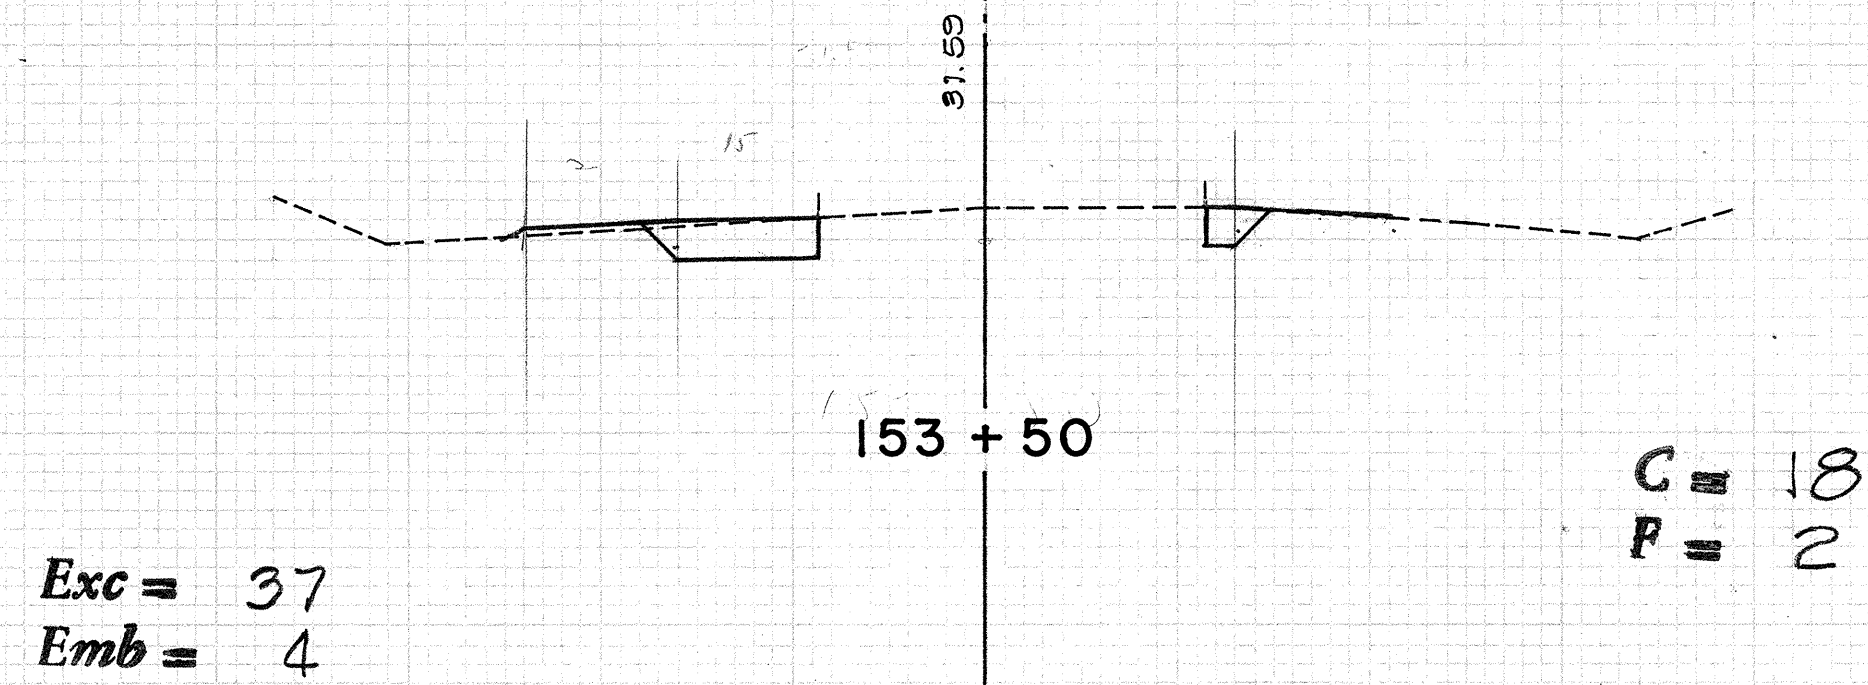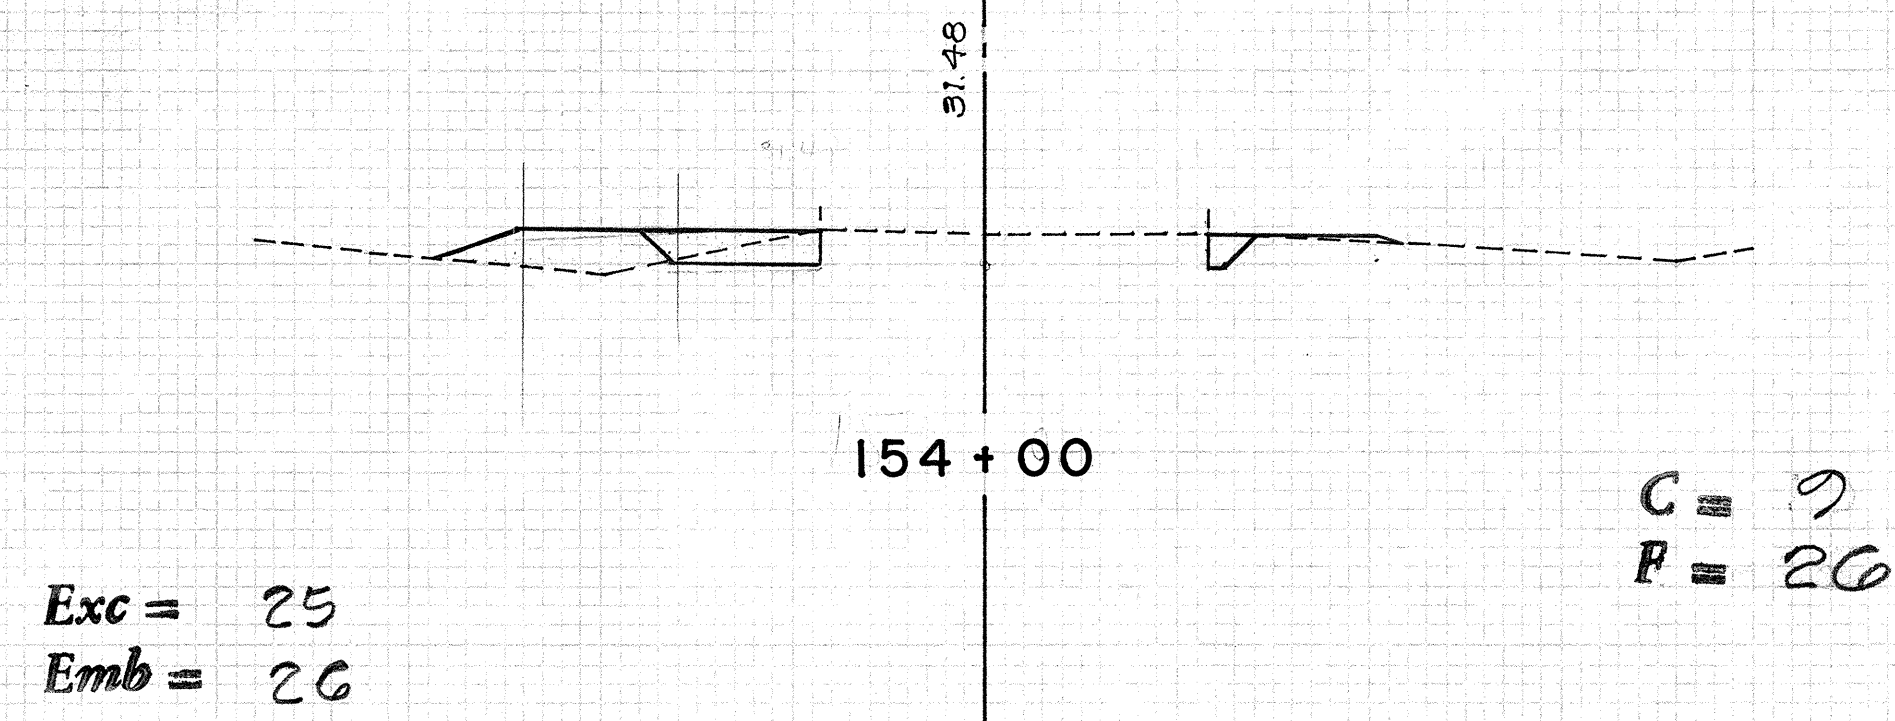

VER. & HOR. SCALE: 1" = 10'