



FED. ROAD DIST. NO.	STATE	PROJ. NO.	FISCAL YEAR	SHEET NO.	TOTAL SHEETS
HAWAII	HAW.	760AB-01-72	1972	3	10

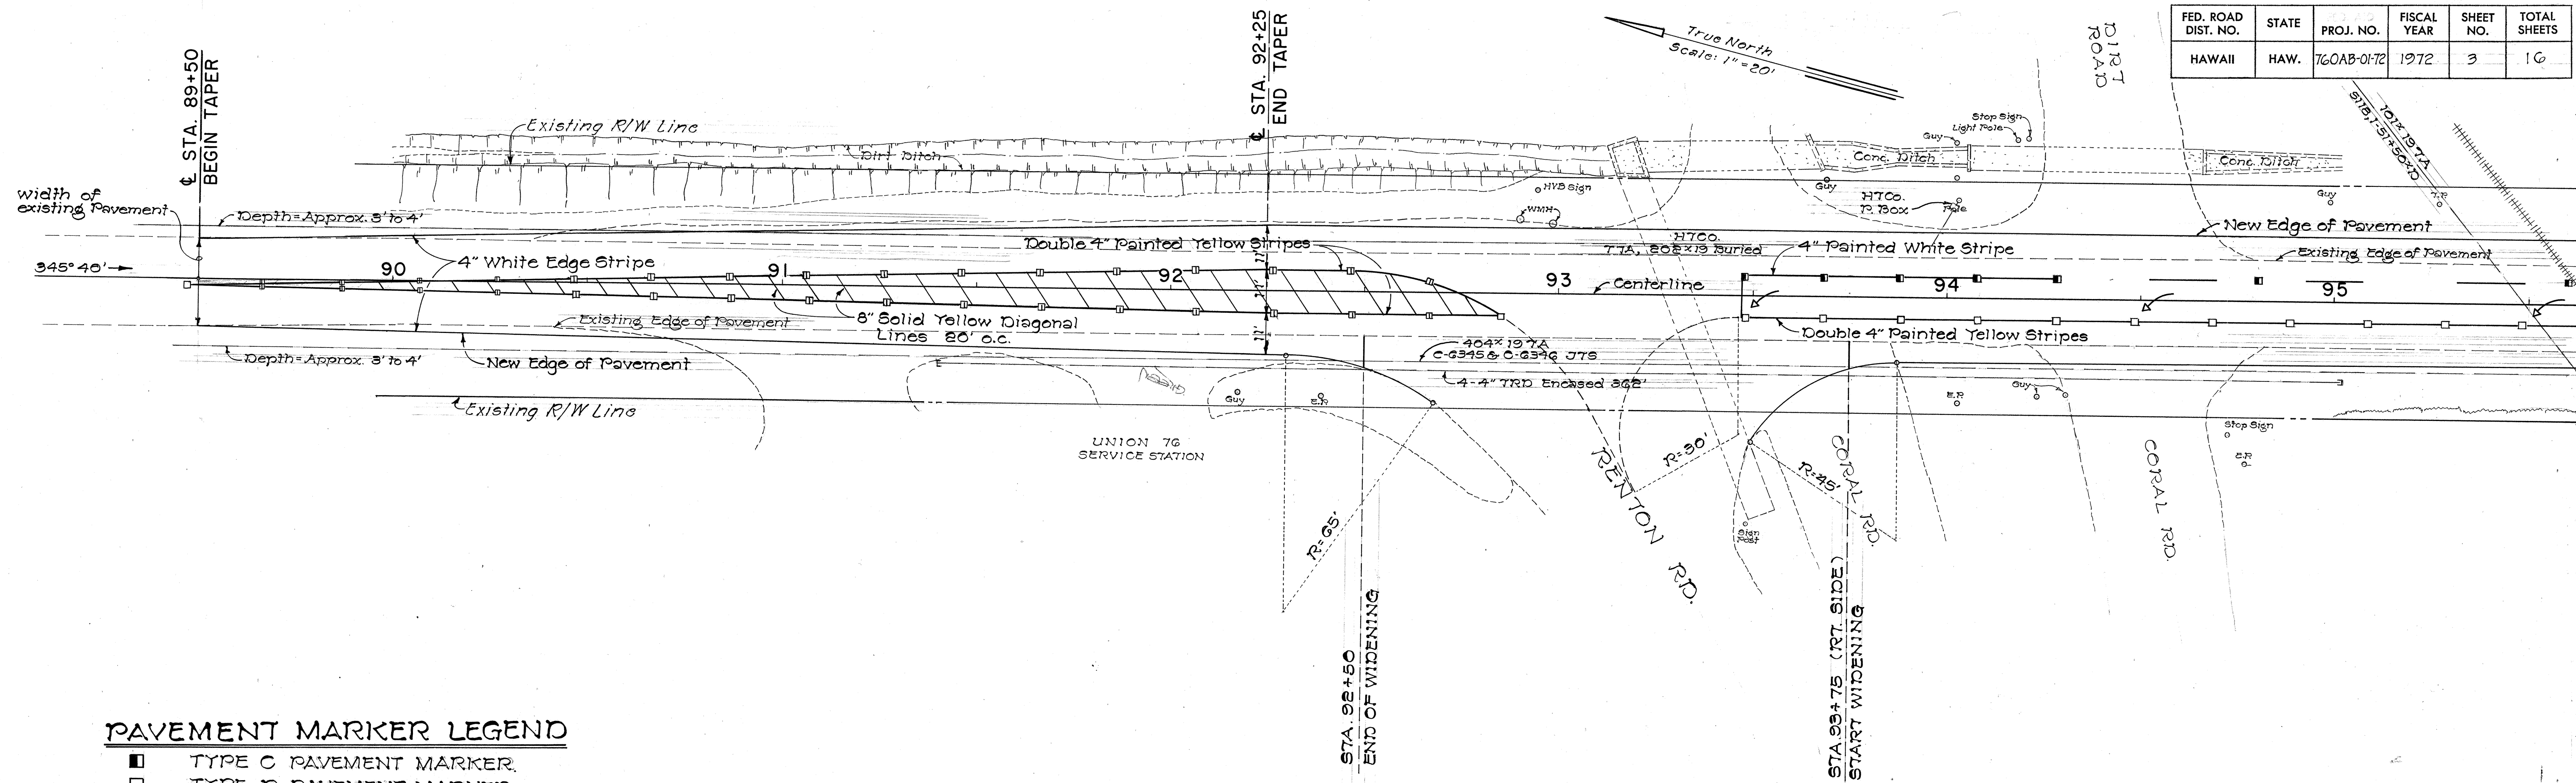

PAVEMENT MARKER LEGEND

- TYPE C PAVEMENT MARKER.
- TYPE D PAVEMENT MARKER.
- TYPE H PAVEMENT MARKER.
- TYPE A PAVEMENT MARKERS (6 @ 3' o.c.)

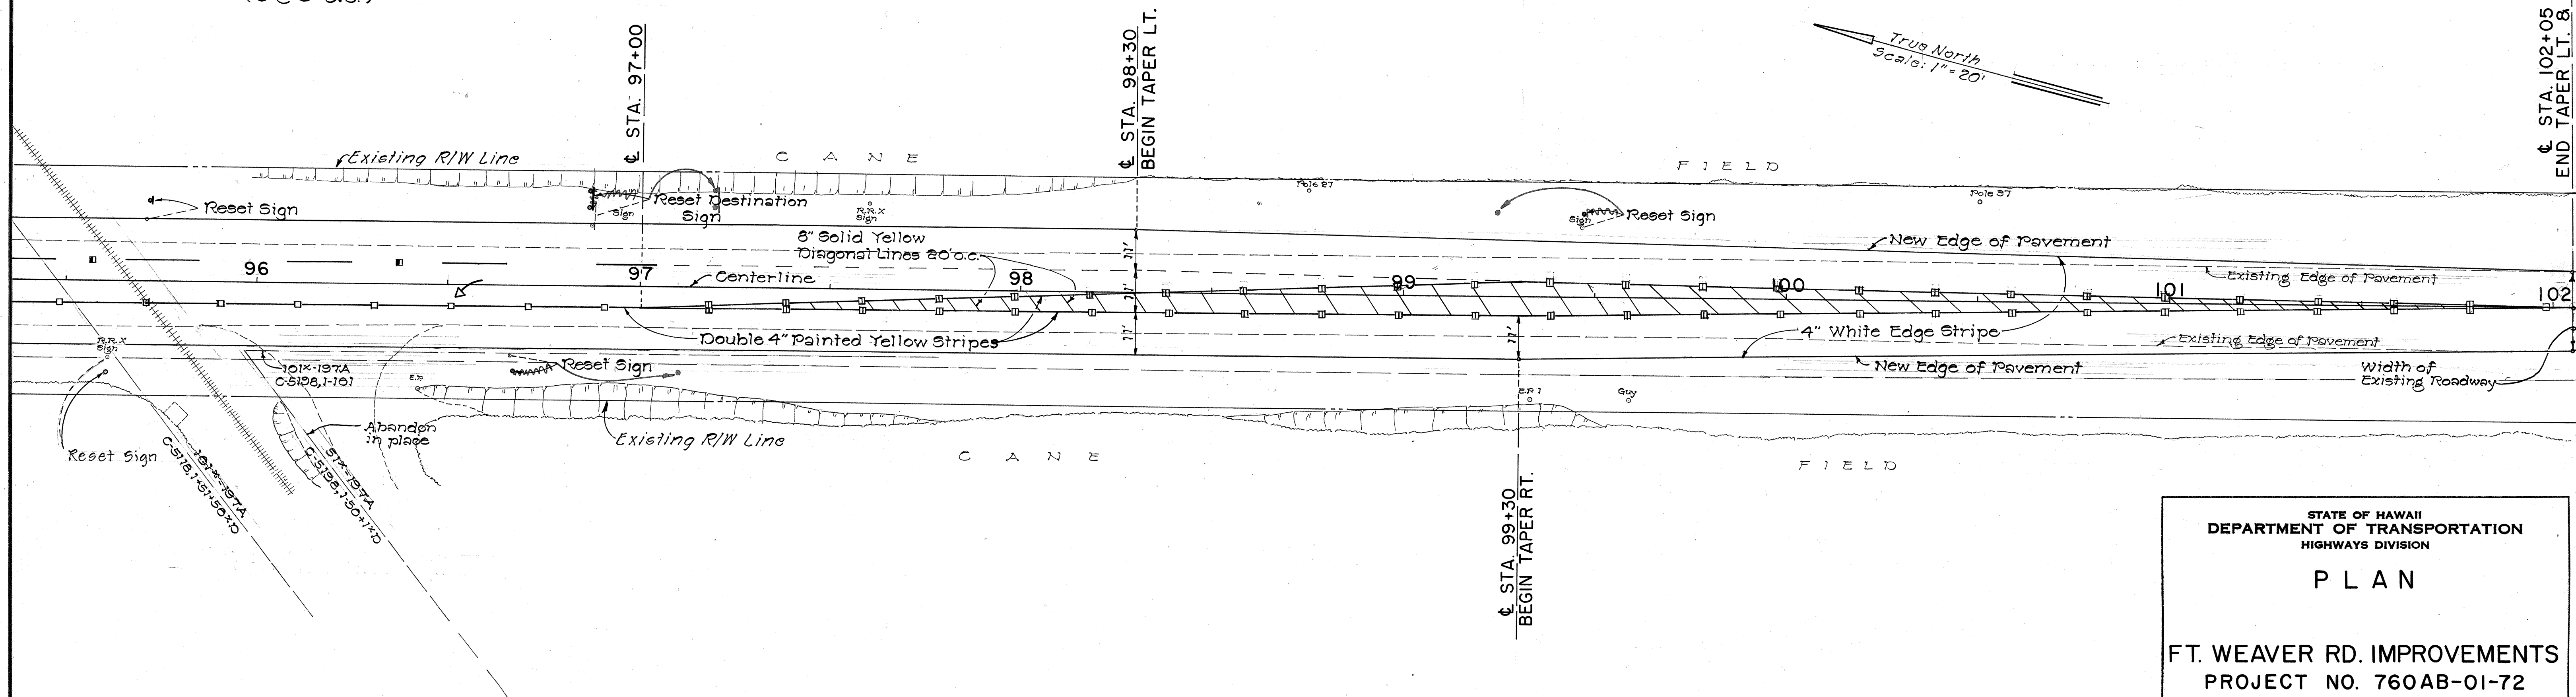

STATE OF HAWAII
DEPARTMENT OF TRANSPORTATION
HIGHWAYS DIVISION


P L A N

FT. WEAVER RD. IMPROVEMENTS
PROJECT NO. 760AB-01-72

SHEET No. 1 OF 3 SHEETS

ORIGINAL PLAN	DATE
DESIGNED BY	TRACED BY
QUANTITIES BY	CHECKED BY
NO.	

FED. ROAD DIST. NO.	STATE	PROJ. NO.	FISCAL YEAR	SHEET NO.	TOTAL SHEETS
HAWAII	HAW.	760AB-01-72	1972	4	10

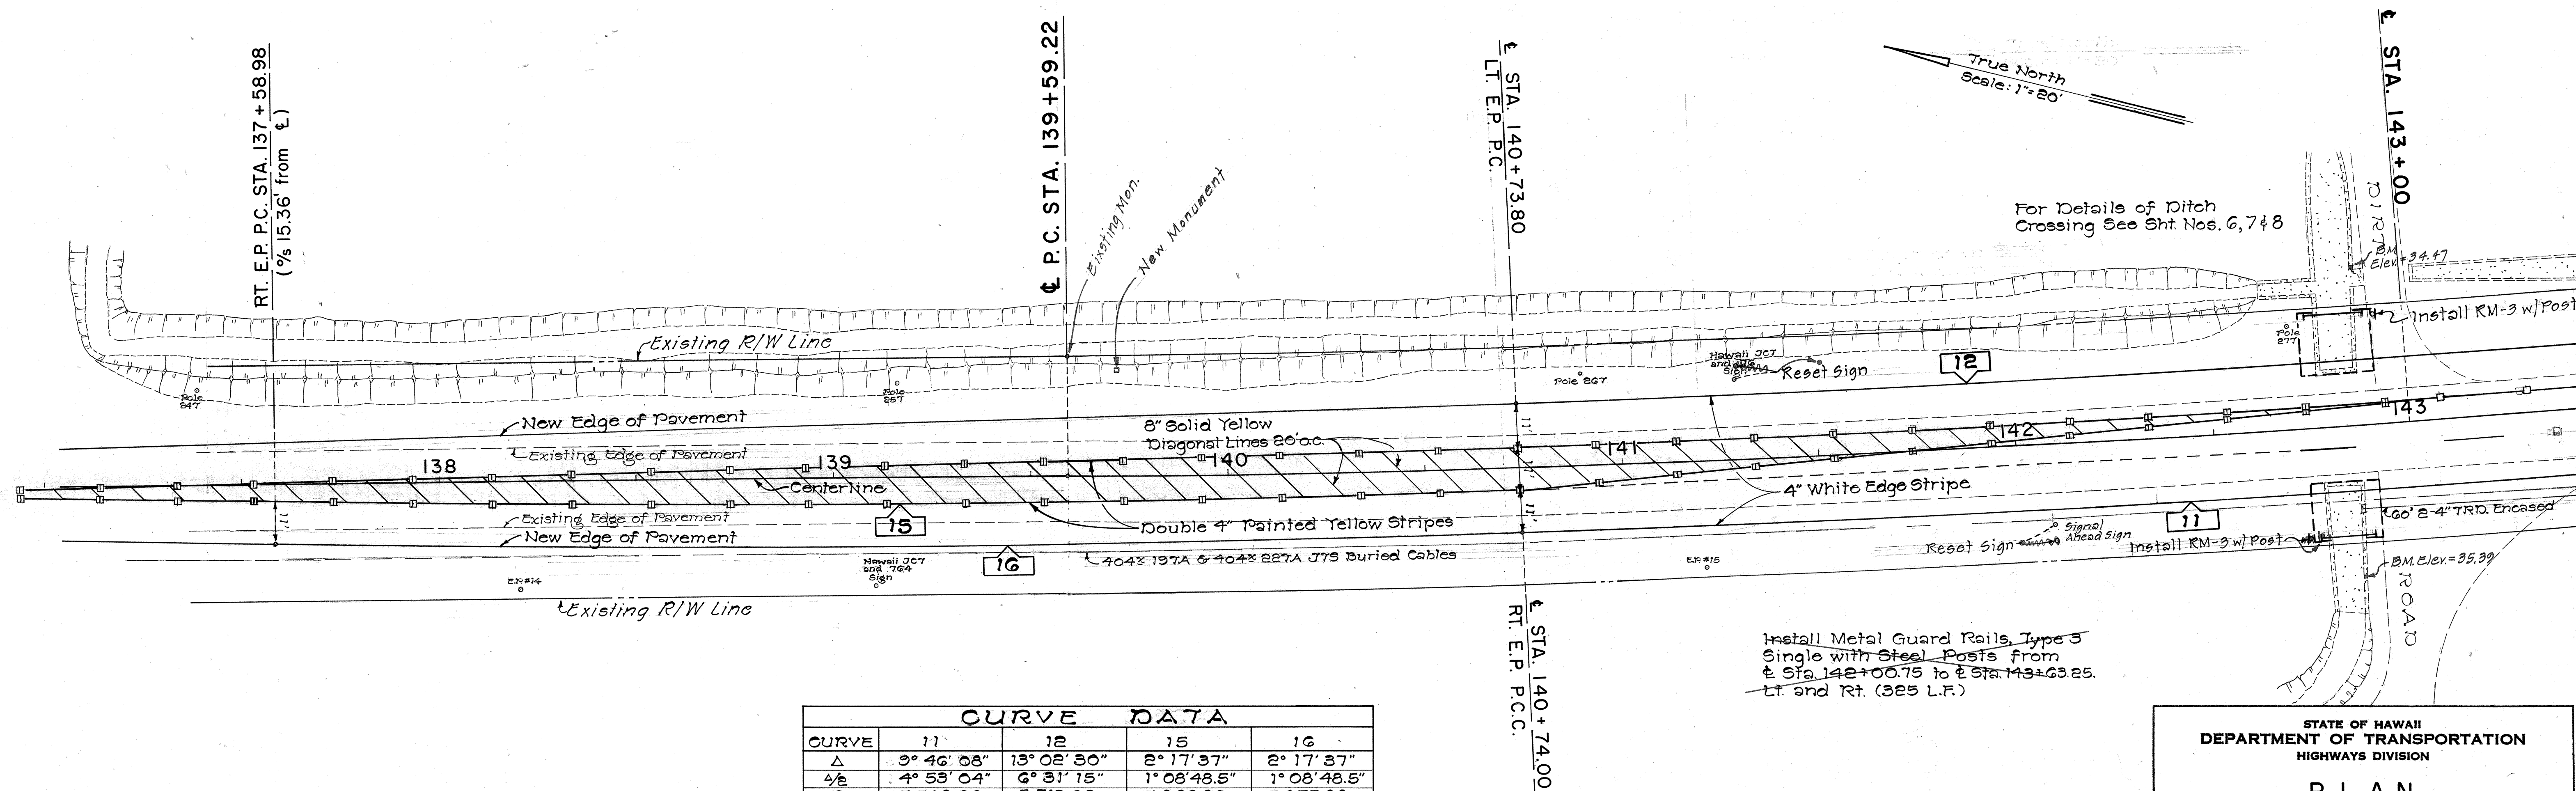

CURVE DATA				
CURVE	11	12	15	16
Δ	9° 46' 08"	13° 02' 30"	2° 17' 37"	2° 17' 37"
Δ/2	4° 53' 04"	6° 31' 15"	1° 08' 48.5"	1° 08' 48.5"
R	5,746.08	5,713.08	7,866.88	7,877.88
T	491.04	655.03	157.48	157.70
C	978.52	1,297.61	314.90	315.34
L	979.70	1,300.41	314.92	315.36

STATE OF HAWAII
DEPARTMENT OF TRANSPORTATION
HIGHWAYS DIVISION

PLAN

FT. WEAVER RD. IMPROVEMENTS
PROJECT NO. 760AB-01-72


SHEET No. 2 OF 3 SHEETS

DATE	BY
DESIGNED BY	
TRACED BY	
QUANTITIES BY	
CHECKED BY	
ORIGINAL PLAN	
NOTE BOOK	
No.	

FED. ROAD DIST. NO.	STATE	PROJ. NO.	FISCAL YEAR	SHEET NO.	TOTAL SHEETS
HAWAII	HAW.	760AB-0172	1971	5	16

CURVE DATA

$\Delta = 15^\circ 20' 00''$
 $\frac{\Delta}{2} = 7^\circ 40' 00''$
 $R = 5,729.58$
 $T = 771.28$
 $LC = 1,533.33$

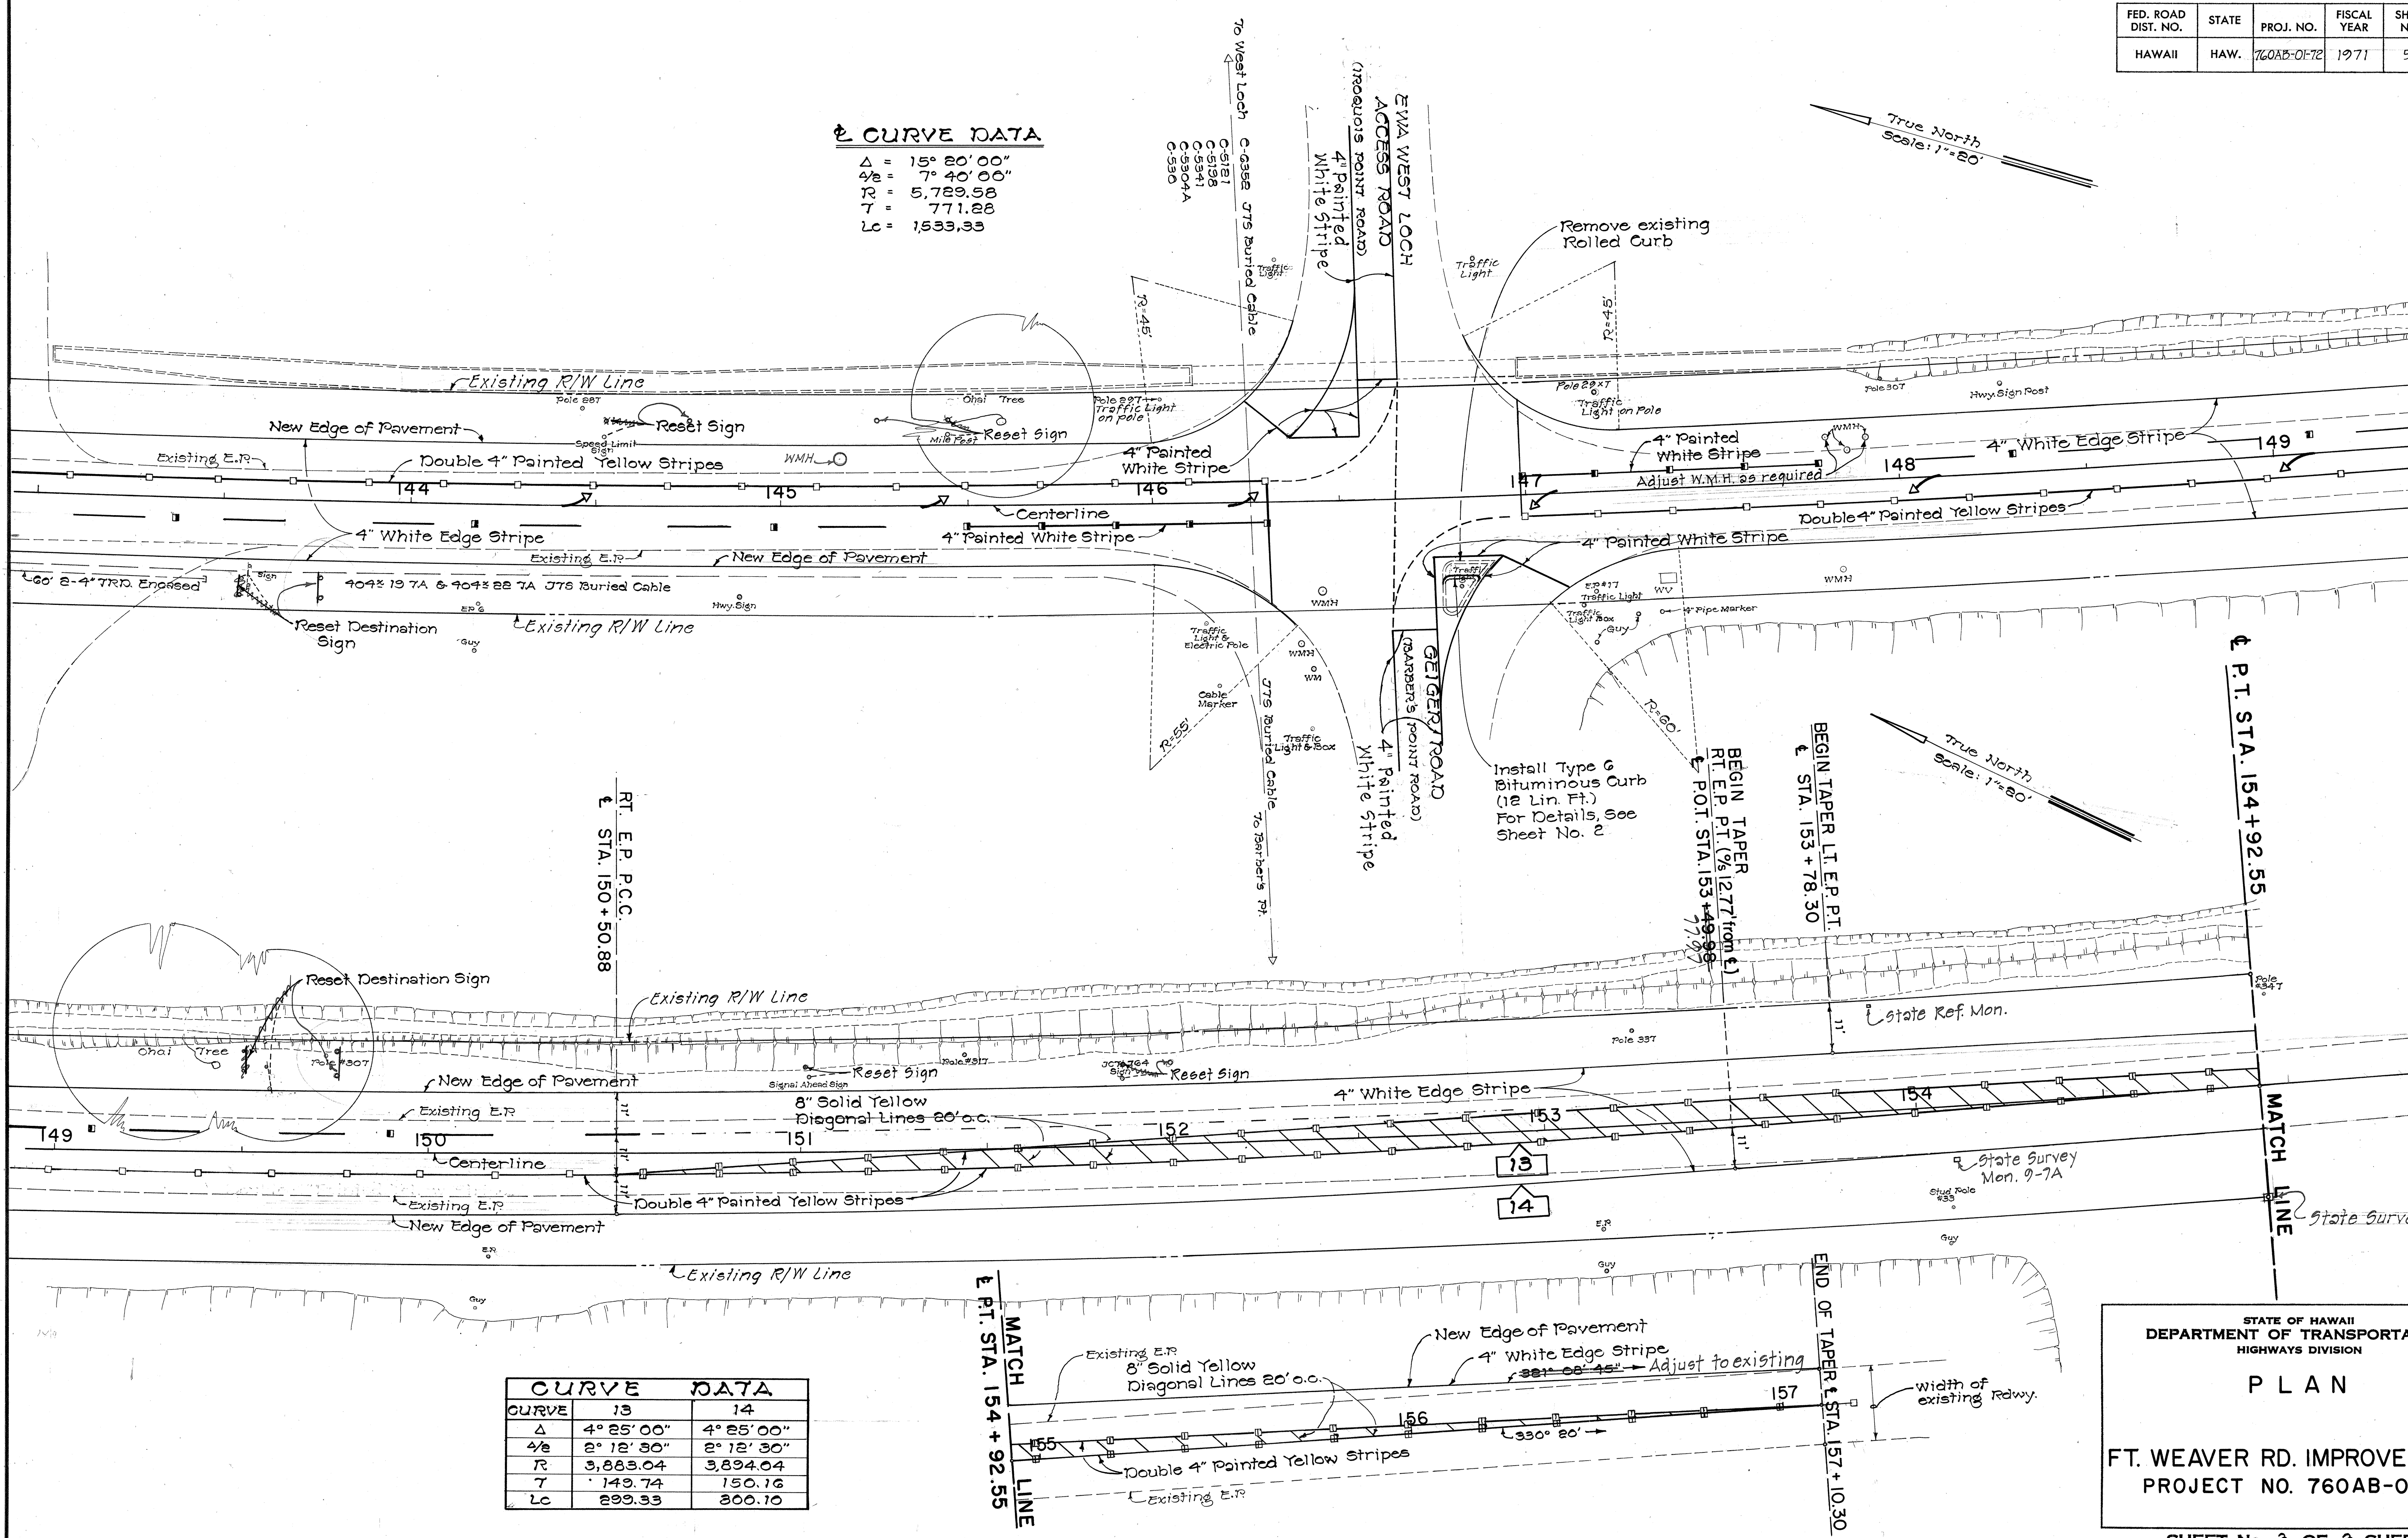

CURVE DATA		
CURVE	13	14
Δ	$4^\circ 25' 00''$	$4^\circ 25' 00''$
$\frac{\Delta}{2}$	$2^\circ 12' 30''$	$2^\circ 12' 30''$
R	3,883.04	3,894.04
T	149.74	150.16
LC	299.33	300.10

STATE OF HAWAII
 DEPARTMENT OF TRANSPORTATION
 HIGHWAYS DIVISION
PLAN
 FT. WEAVER RD. IMPROVEMENTS
 PROJECT NO. 760AB-01-72
 SHEET No. 3 OF 3 SHEETS

DATE	
DESIGNED BY	
DRAWN BY	
CHECKED BY	
ORIGINAL PLAN	
NOTE BOOK	