

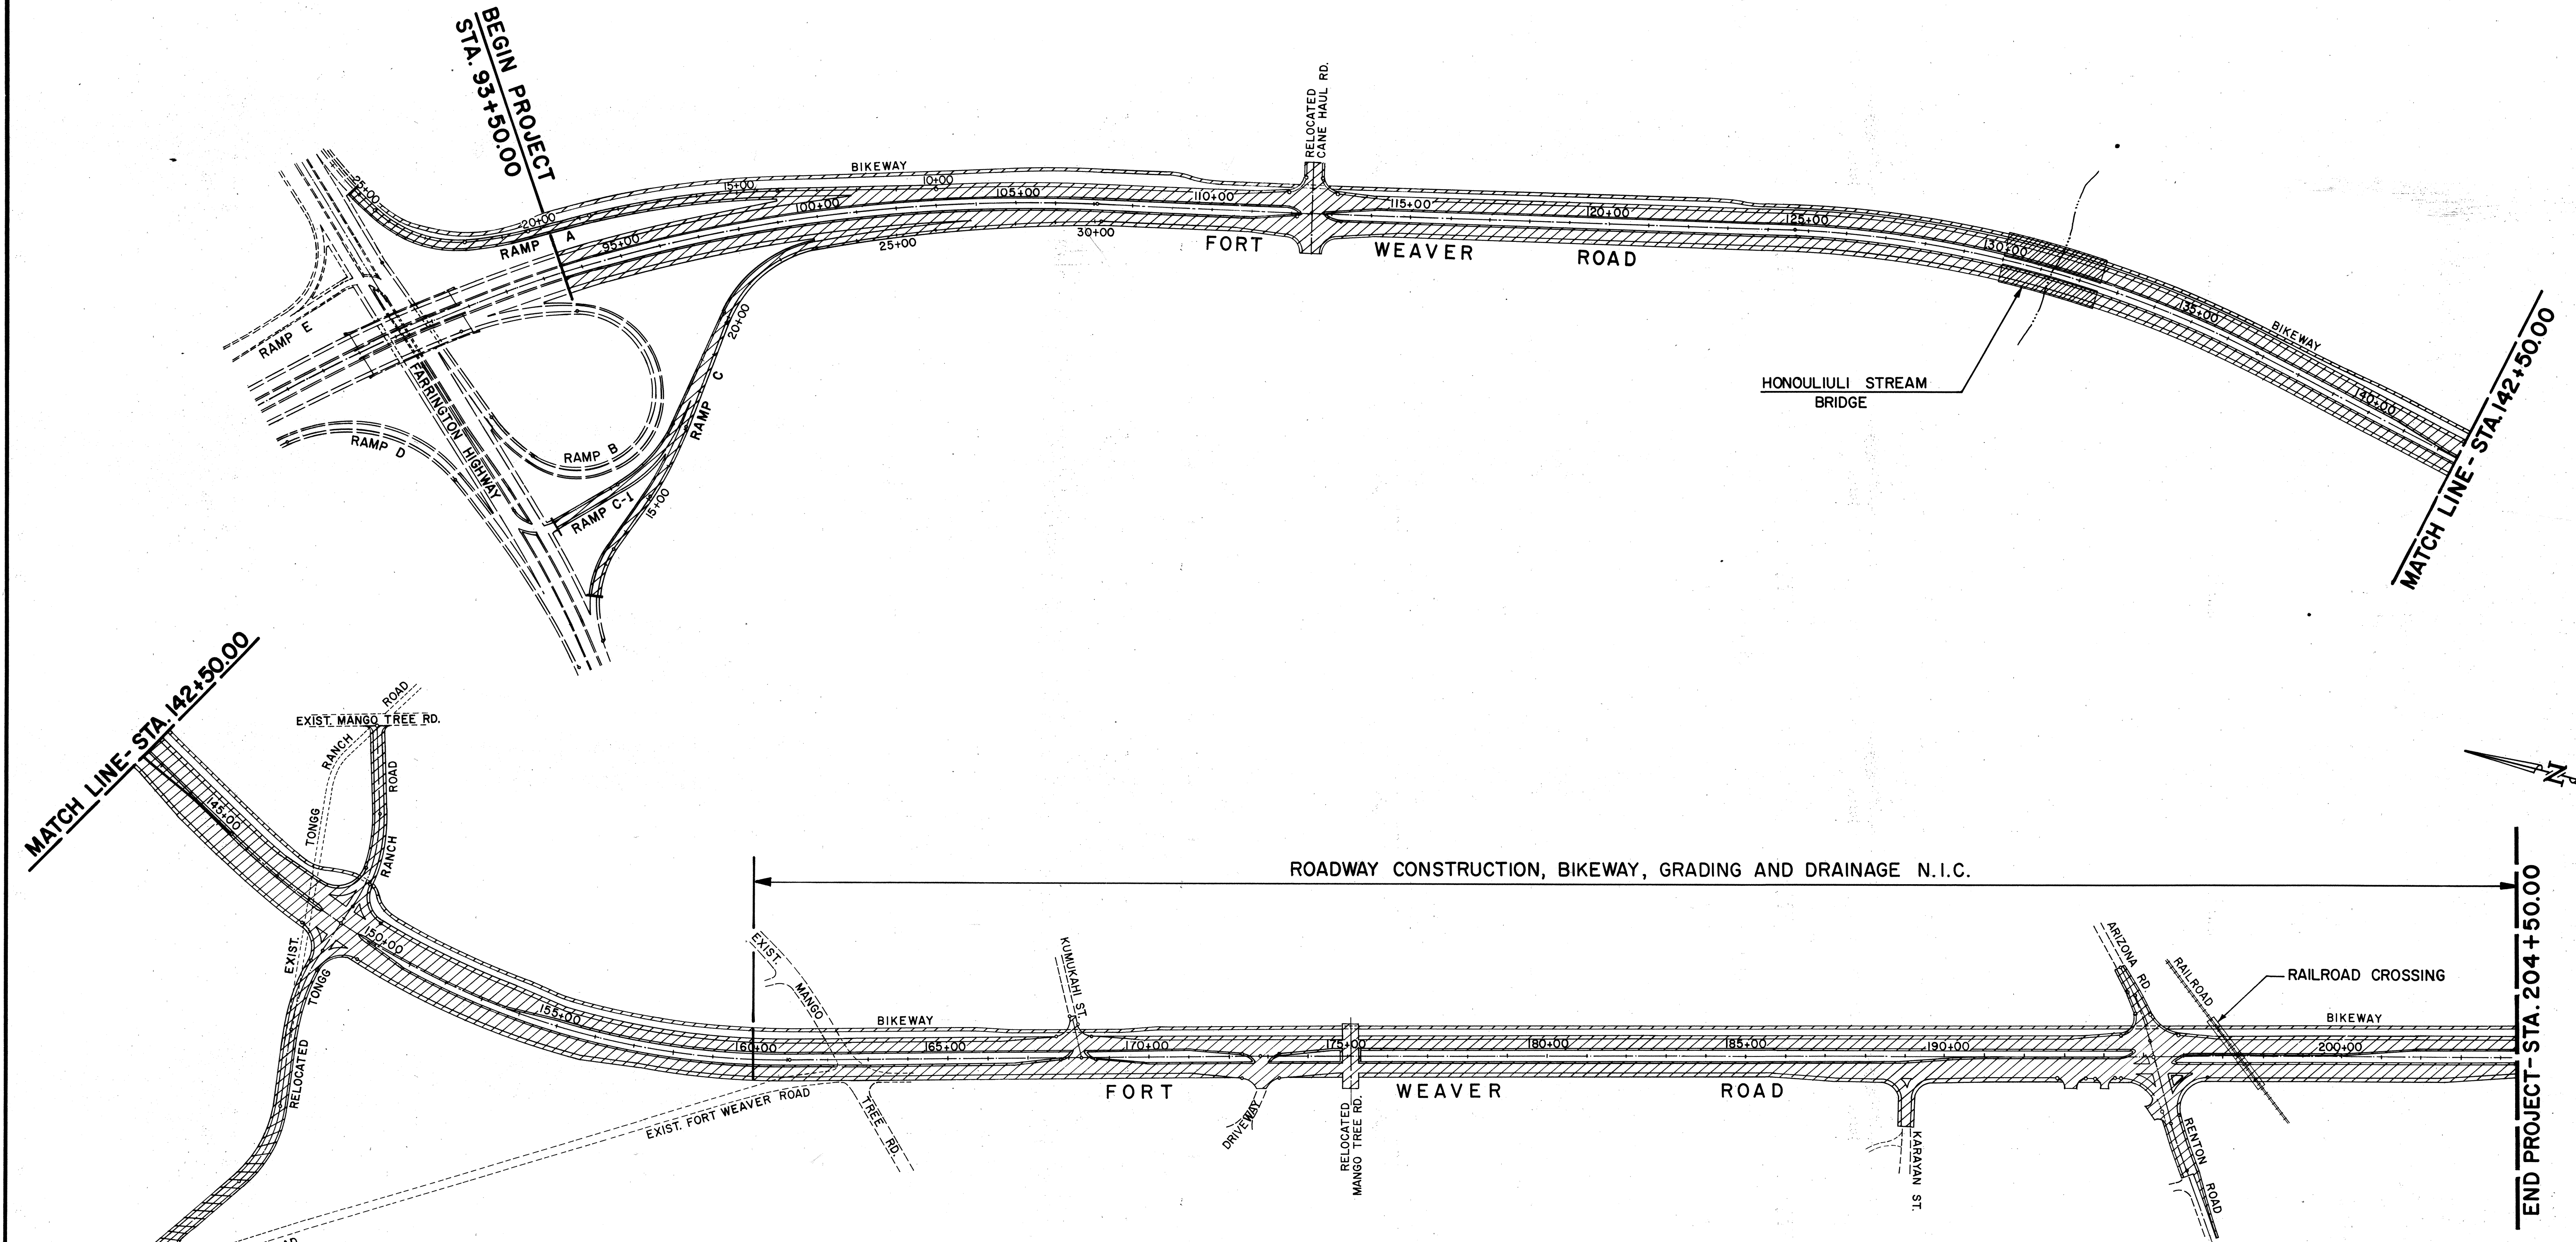


FED. ROAD DIST. NO.	STATE	FED. AID PROJ. NO.	FISCAL YEAR	SHEET NO.	TOTAL SHEETS
HAWAII	HAW.	M-7600(2)	1980	2	244

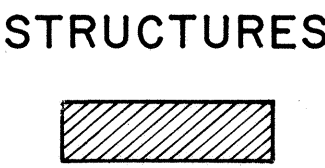

SURVEY PLOTTED BY	DATE
DRAWN BY	
DESIGNED BY	
QUANTITIES BY	
CHECKED BY	
NO.	

PERMANENT CONSTRUCTION
FOR THIS CONTRACT

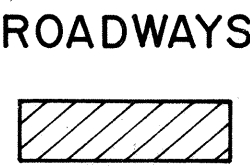

LEGEND



STATE OF HAWAII
DEPARTMENT OF TRANSPORTATION
HIGHWAYS DIVISION

GENERAL PLAN
FORT WEAVER ROAD
STA. 93+50.00 TO STA. 204+50.00
FORT WEAVER ROAD
SOUTH OF FARRINGTON HIGHWAY
TO THE VICINITY OF RENTON ROAD
SCALE: 1" = 200' DATE: SEPT 1979
SHEET No. 1 OF 1 SHEETS