




DATE	REVISION
11/7/80	Revised Alignment and Fin. Elev. of West Leg of Fort Weaver Rd./Reloc. Tongg Ranch Rd. Intersection. Added PCC Pavement with Joint Details for New Cane Haul Road Crossing.
2/4/81	Revised All Fin. Elev. of Fort Weaver Rd./Reloc. Tongg Ranch Rd. Intersection.

FED. ROAD DIST. NO.	STATE	FED. AID PROJ. NO.	FISCAL YEAR	SHEET NO.	TOTAL SHEETS
HAWAII	HAW.	M-7600(2)	1980	27	244

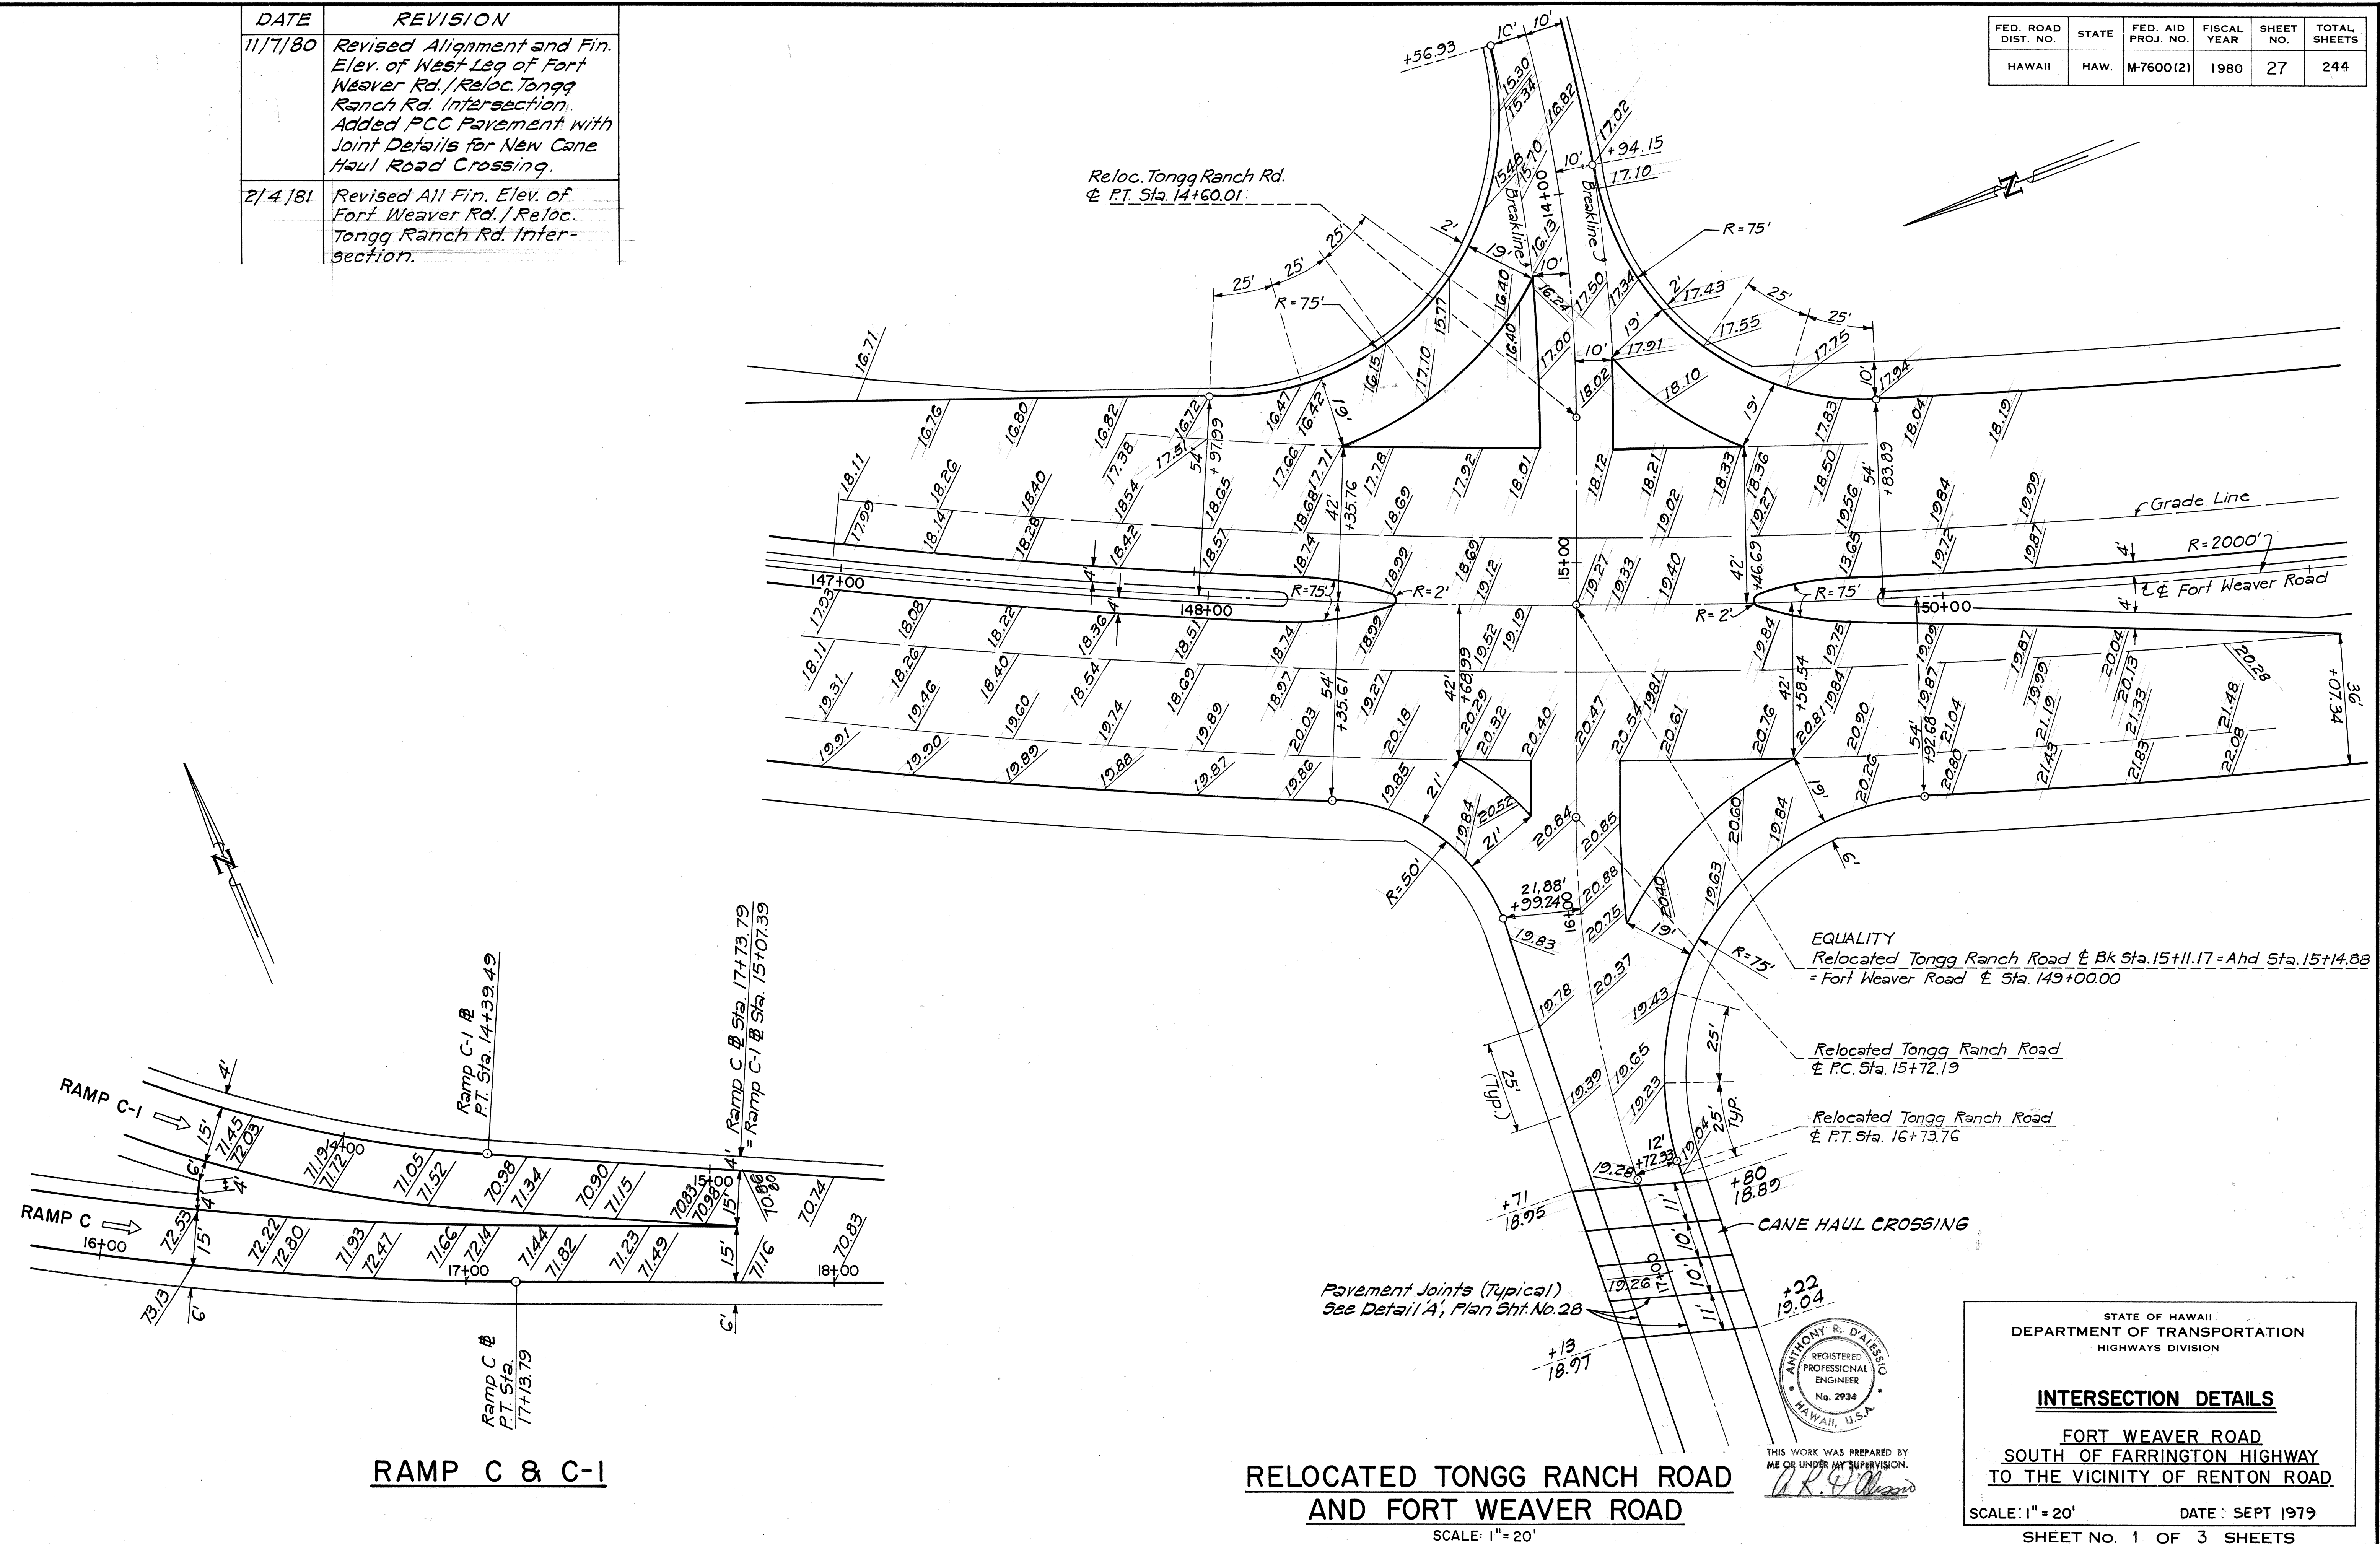


SURVEY PLOTTED BY	DATE
DESIGNED BY	
TRACED BY	
NOTED BY	
CHECKED BY	

FED. ROAD DIST. NO.	STATE	FED. AID PROJ. NO.	FISCAL YEAR	SHEET NO.	TOTAL SHEETS
HAWAII	HAW.	M-7600(2)	1980	28	244

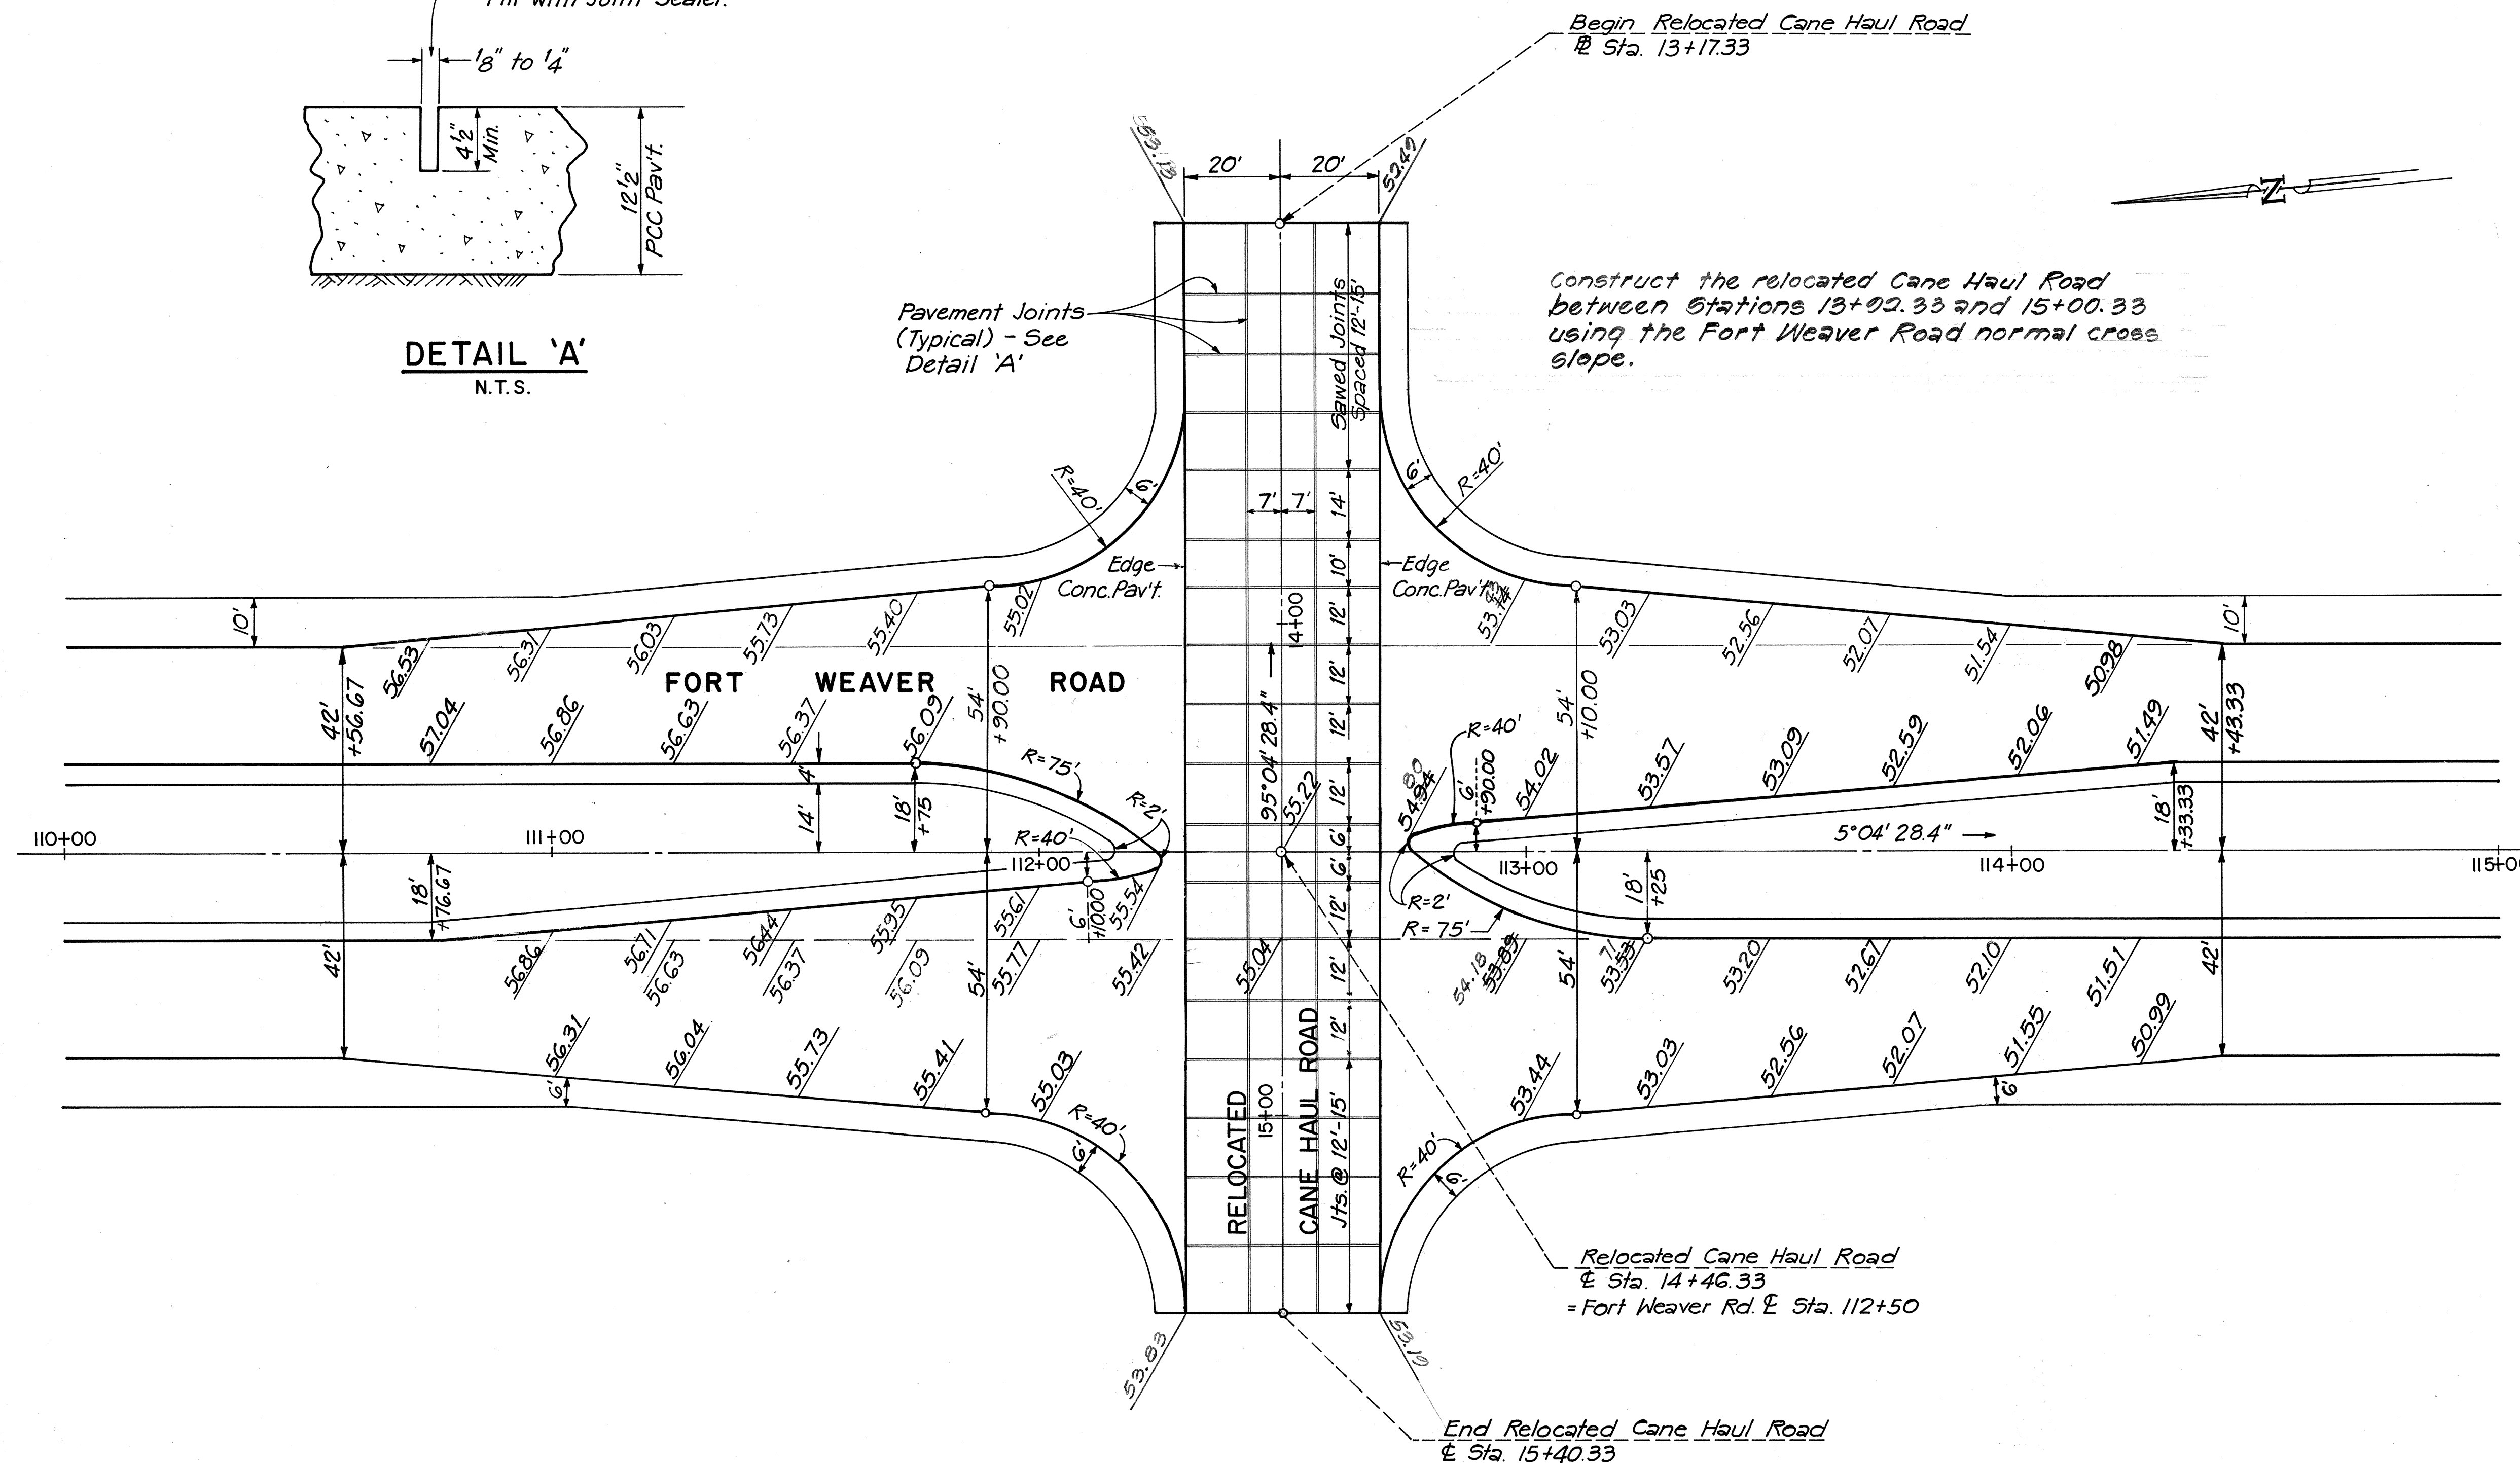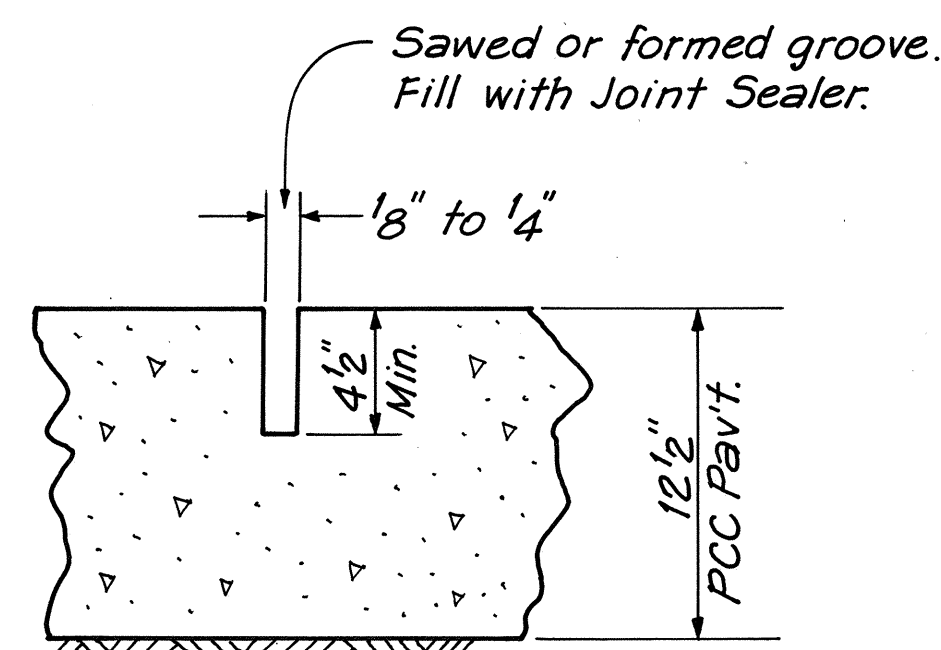

RELOCATED CANE HAUL ROAD AND FORT WEAVER ROAD

SCALE: 1" = 20'

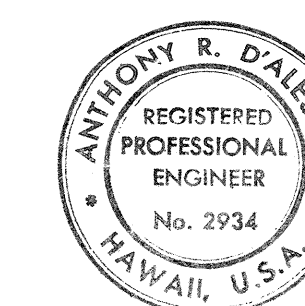

THIS WORK WAS PREPARED BY ME OR UNDER MY SUPERVISION.

Anthony R. Dalessio

STATE OF HAWAII
DEPARTMENT OF TRANSPORTATION
HIGHWAYS DIVISION

INTERSECTION DETAILS

FORT WEAVER ROAD
SOUTH OF FARRINGTON HIGHWAY
TO THE VICINITY OF RENTON ROAD

SCALE: 1" = 20'



DATE: SEPT 1979

SHEET No. 2 OF 3 SHEETS

SURVEY PLOTTED BY	DATE
DESIGNED BY	
TRACED BY	
NOTE BOOK	
QUANTITIES BY	
CHECKED BY	
No.	

FED. ROAD DIST. NO.	STATE	FED. AID PROJ. NO.	FISCAL YEAR	SHEET NO.	TOTAL SHEETS
HAWAII	HAW.	M-7600(2)	1980	29	244

SURVEY PLOTTED BY	DATE
DESIGNED BY	
NOTED BY	
CHECKED BY	
ORIGINAL PLAN	
NO.	

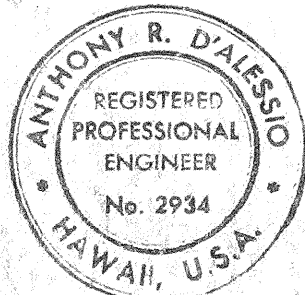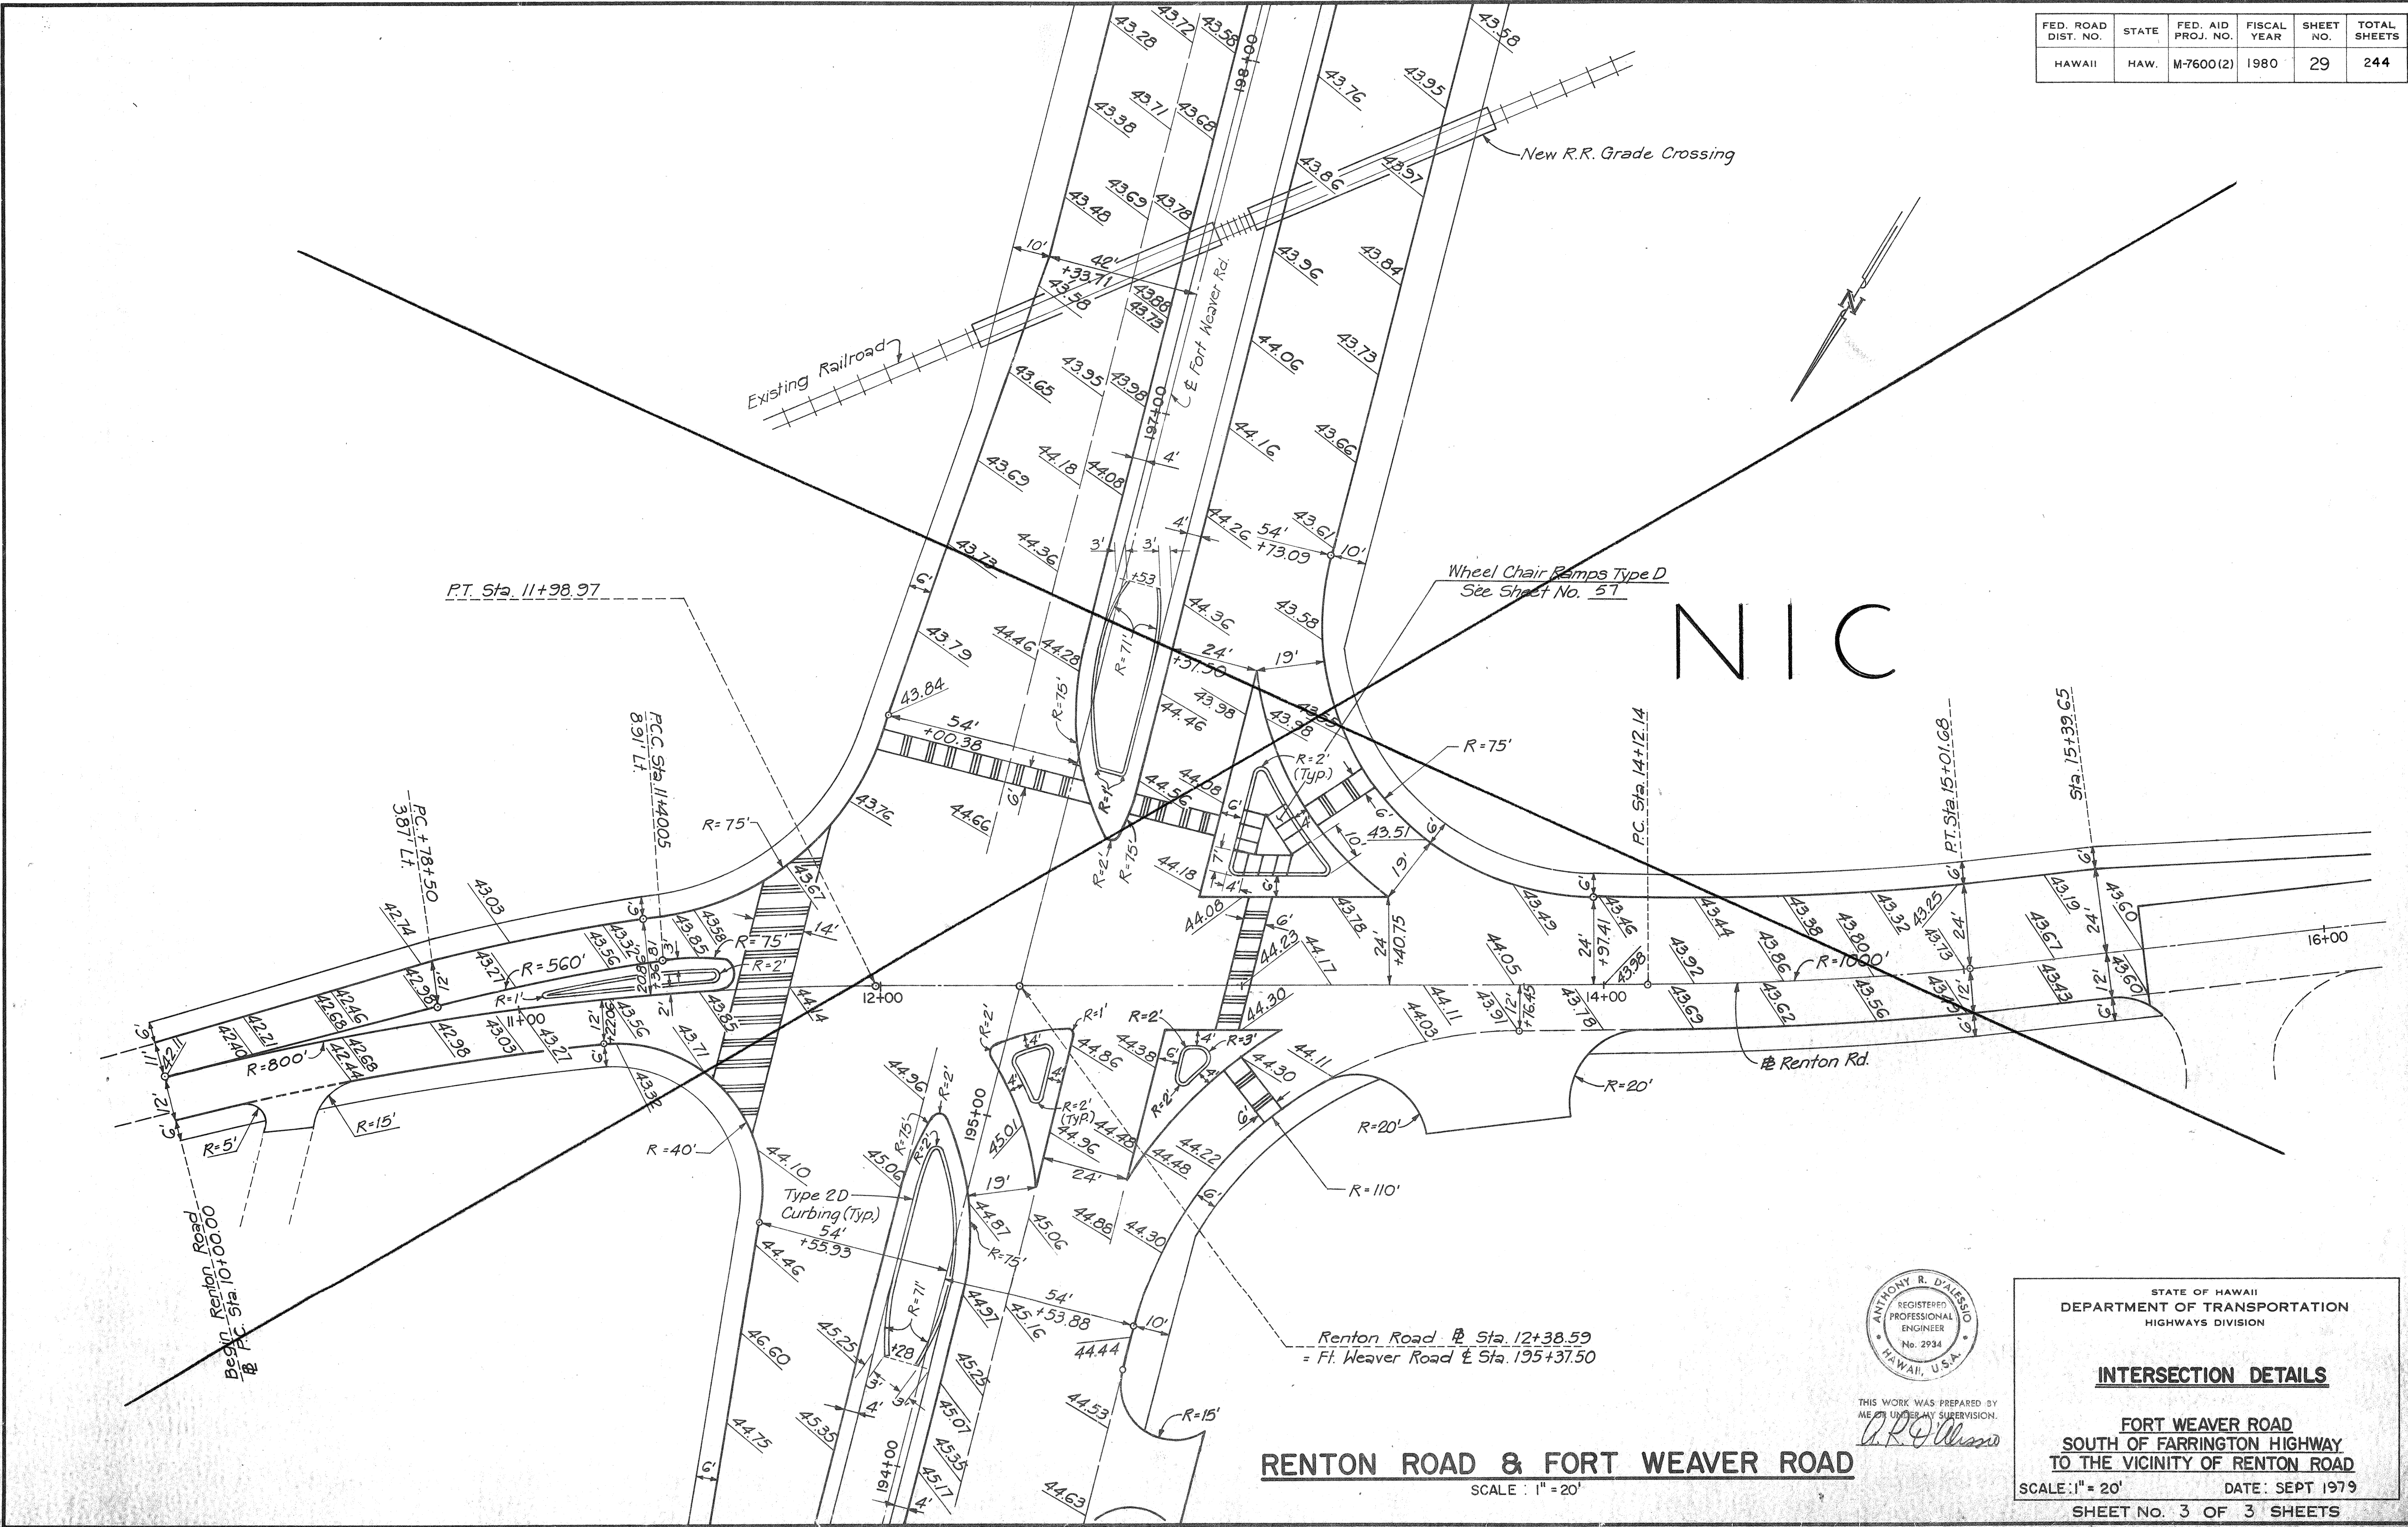

THIS WORK WAS PREPARED BY
ME IN MY OWN SUPERVISION.
A.R. D'Alessio

RENTON ROAD & FORT WEAVER ROAD

SCALE: 1" = 20'

STATE OF HAWAII
DEPARTMENT OF TRANSPORTATION
HIGHWAYS DIVISION

INTERSECTION DETAILS

**FORT WEAVER ROAD
SOUTH OF FARRINGTON HIGHWAY
TO THE VICINITY OF RENTON ROAD**

SCALE: 1" = 20' DATE: SEPT 1979

SHEET NO. 3 OF 3 SHEETS