

FED. ROAD DIST. NO.	STATE	PROJ. NO.	FISCAL YEAR	SHEET NO.	TOTAL SHEETS
HAWAII	HAW.	7600A-01-83M	1983	5	21

BEGIN PROJECT
PROJ. NO. 7600A-01-83M
@ STA. 102+00

TRUE NORTH
Scale: 1"=50'

Construct 2' Roadway Pavement Widening Both Sides,
1 1/2" A.C. Mix No. II Overlay

S/N 782-12339
MIN 166375277-2"

Construct 2' Roadway Pav't.
Widening Both Sides, Provide
100' Smooth Riding Taper
Transition.

Construct 2' Roadway Pavement Widening Both Sides
1 1/2" A.C. Mix No. II Overlay

Construct 2' Roadway Pav't. Widening Both Sides,
2 1/2" A.C. Mix No. IV Overlay

ORIGINAL PLAN	DATE
DRAWN BY	
DESIGNED BY	
QUANTITIES BY	
CHECKED BY	

APPROVED:
R. Hagata
Chief, Planning & Engineering, Date 8-3-82
B.W.S.

STATE OF HAWAII
DEPARTMENT OF TRANSPORTATION
LAND TRANSPORTATION FACILITIES DIVISION


ROADWAY PLANS

FORT WEAVER ROAD RESURFACING
VICINITY OF RENTON RD. TO NORTH RD.
PROJECT NO. 7600A-01-83M
SCALE: 1"=50' DATE: JULY, 1982
SHEET NO. 1 OF 5 SHEETS

FED. ROAD DIST. NO.	STATE	PROJ. NO.	FISCAL YEAR	SHEET NO.	TOTAL SHEETS
HAWAII	HAW.	7600A-01-B3M	1983	6	21


TRUE NORTH
Scale: 1"=50'

Construct 2' Roadway Pavement Widening Both Sides,
2 1/2" A.C. Mix No. I Overlay

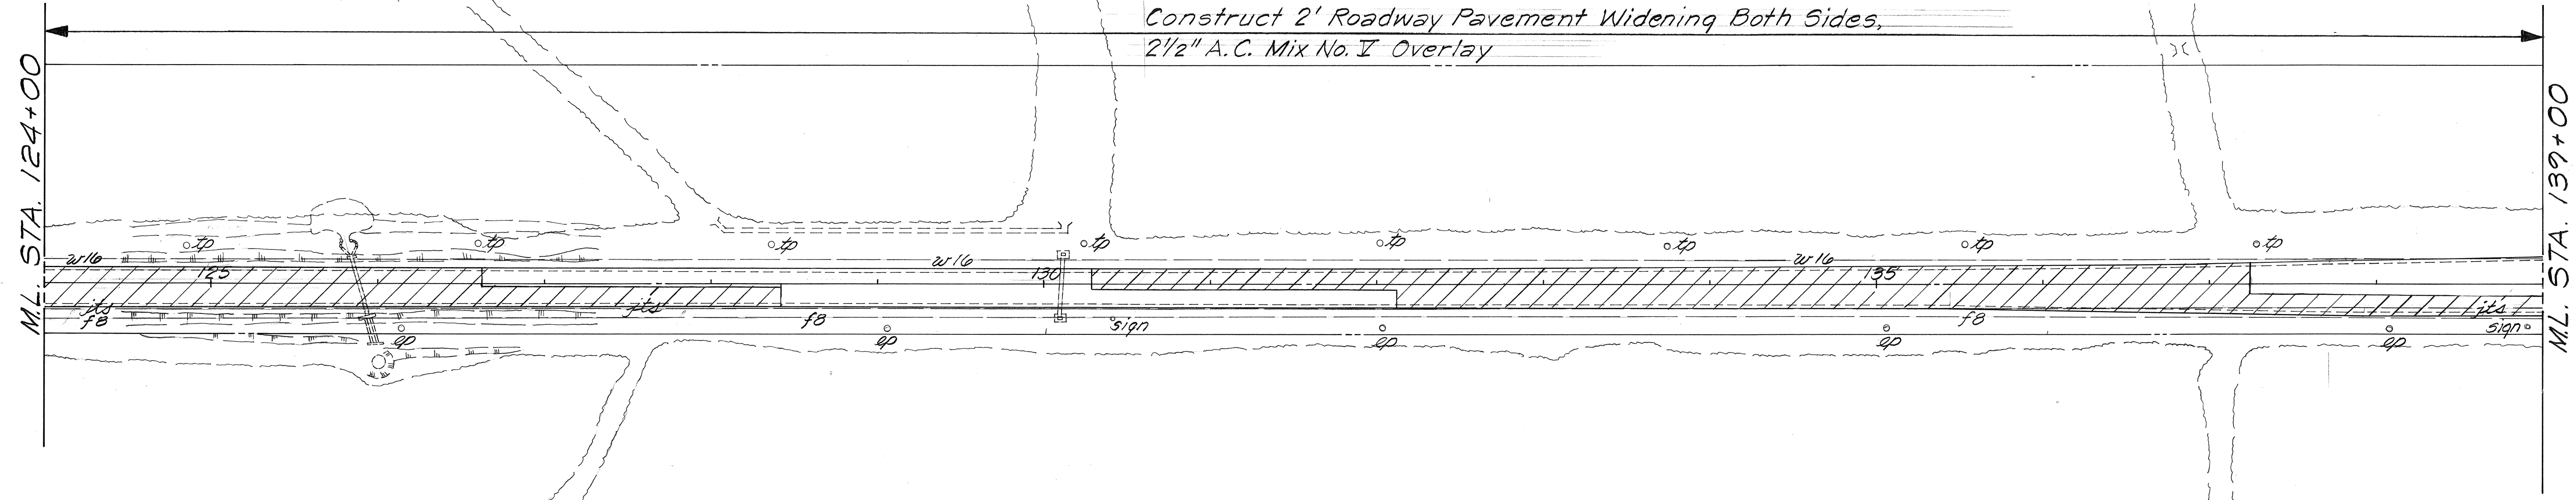

Construct 2' Roadway Pavement Widening Both Sides,
2 1/2" A.C. Mix No. I Overlay

TRUE NORTH
Scale: 1"=50'

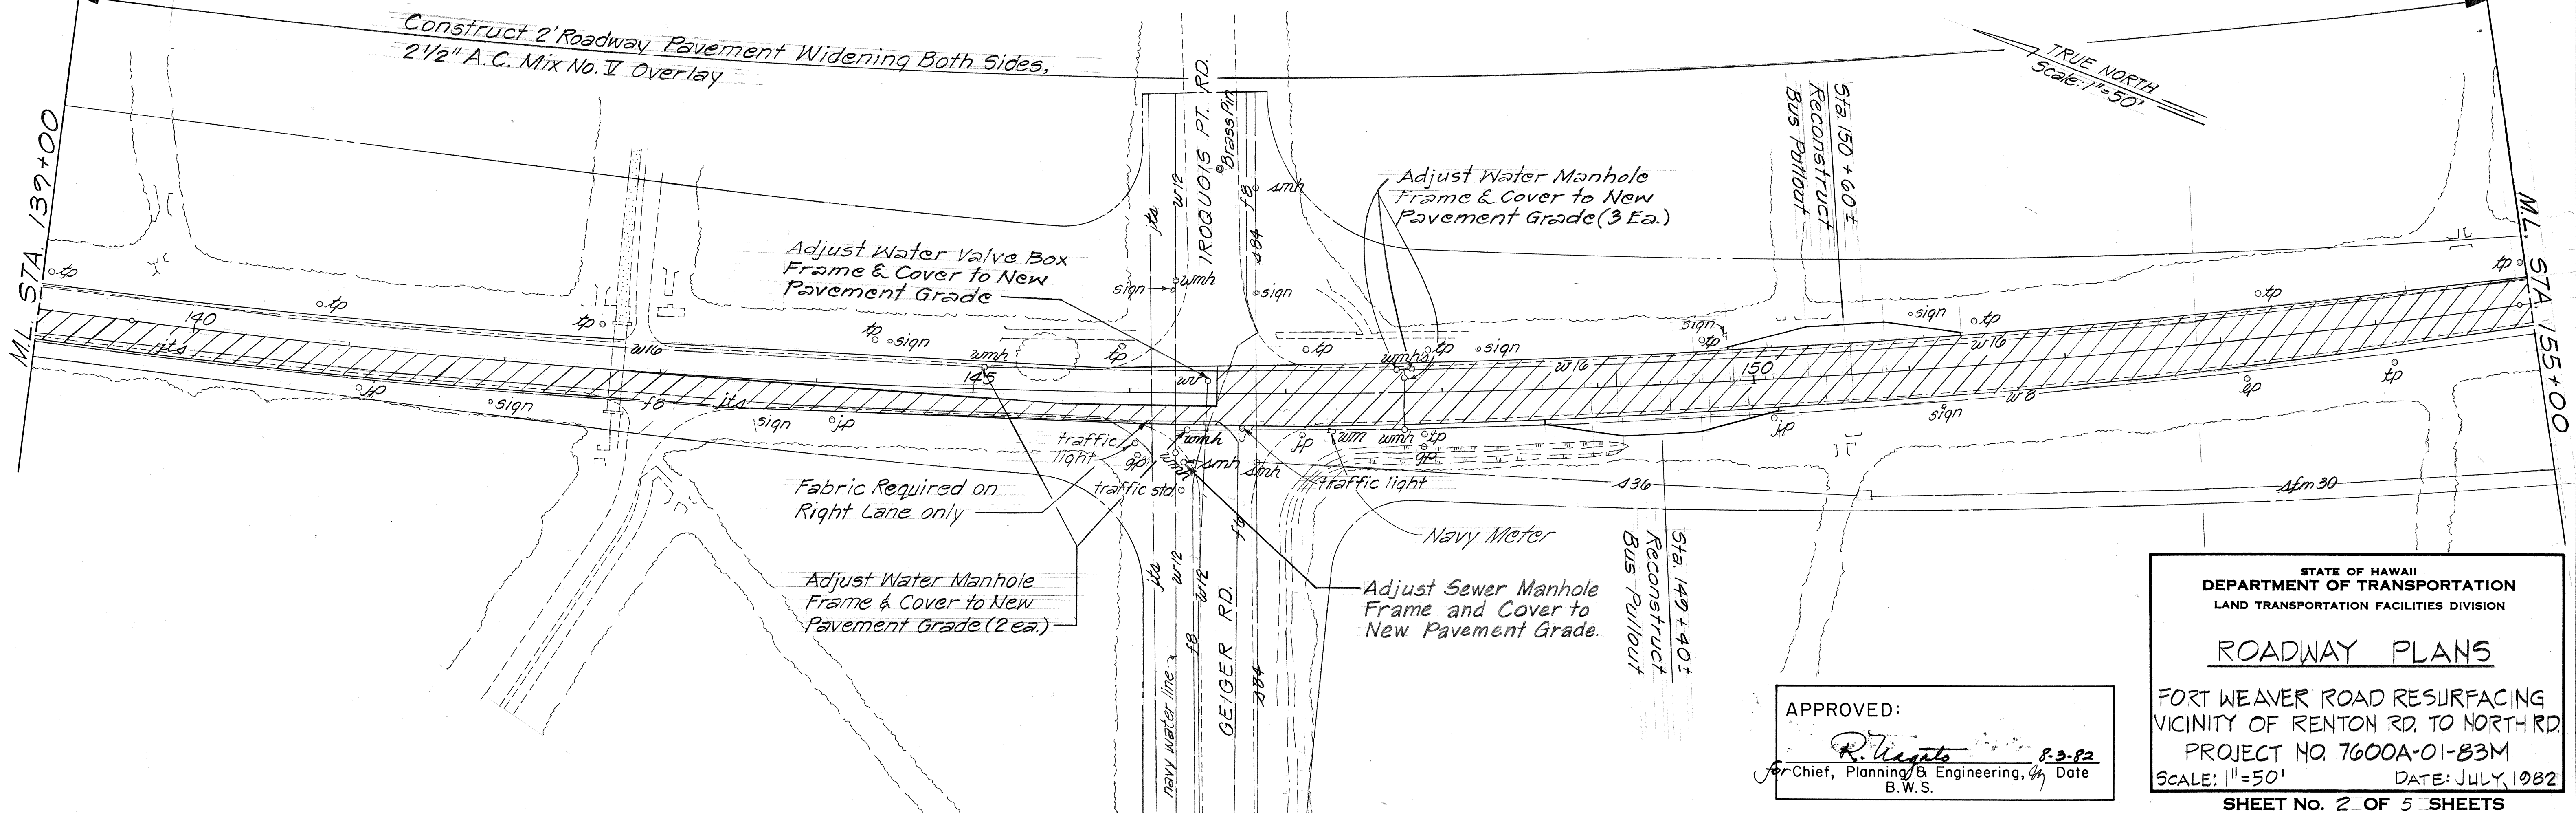

ORIGINAL PLAN	DATE
DESIGNED BY	
TRACED BY	
NOTE BOOK	
QUANTITIES BY	
CHECKED BY	

APPROVED:
R. Nagata
Chief, Planning & Engineering, Date 8-2-82
B.W.S.

STATE OF HAWAII
DEPARTMENT OF TRANSPORTATION
LAND TRANSPORTATION FACILITIES DIVISION


ROADWAY PLANS

FORT WEAVER ROAD RESURFACING
VICINITY OF RENTON RD. TO NORTH RD.
PROJECT NO. 7600A-01-B3M
SCALE: 1"=50' DATE: JULY 1982


SHEET NO. 2 OF 5 SHEETS

FED. ROAD DIST. NO.	STATE	PROJ. NO.	FISCAL YEAR	SHEET NO.	TOTAL SHEETS
HAWAII	HAW.	7600A-01-83M	1983	7	21

TRUE NORTH
Scale: 1"=50'

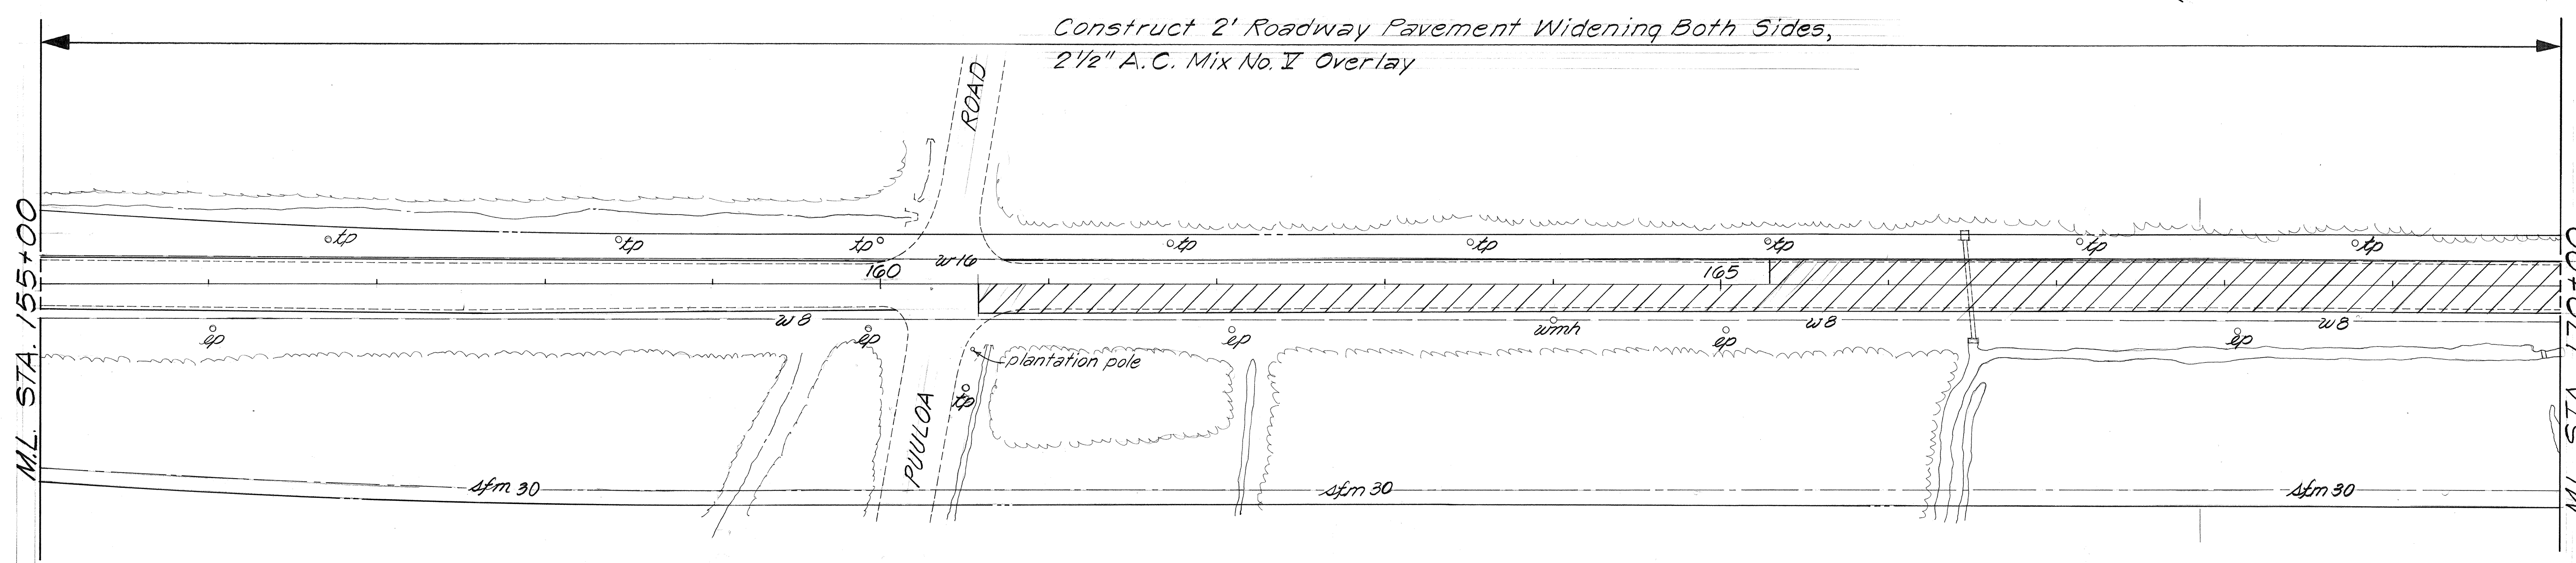

TRUE NORTH
Scale: 1"=50'

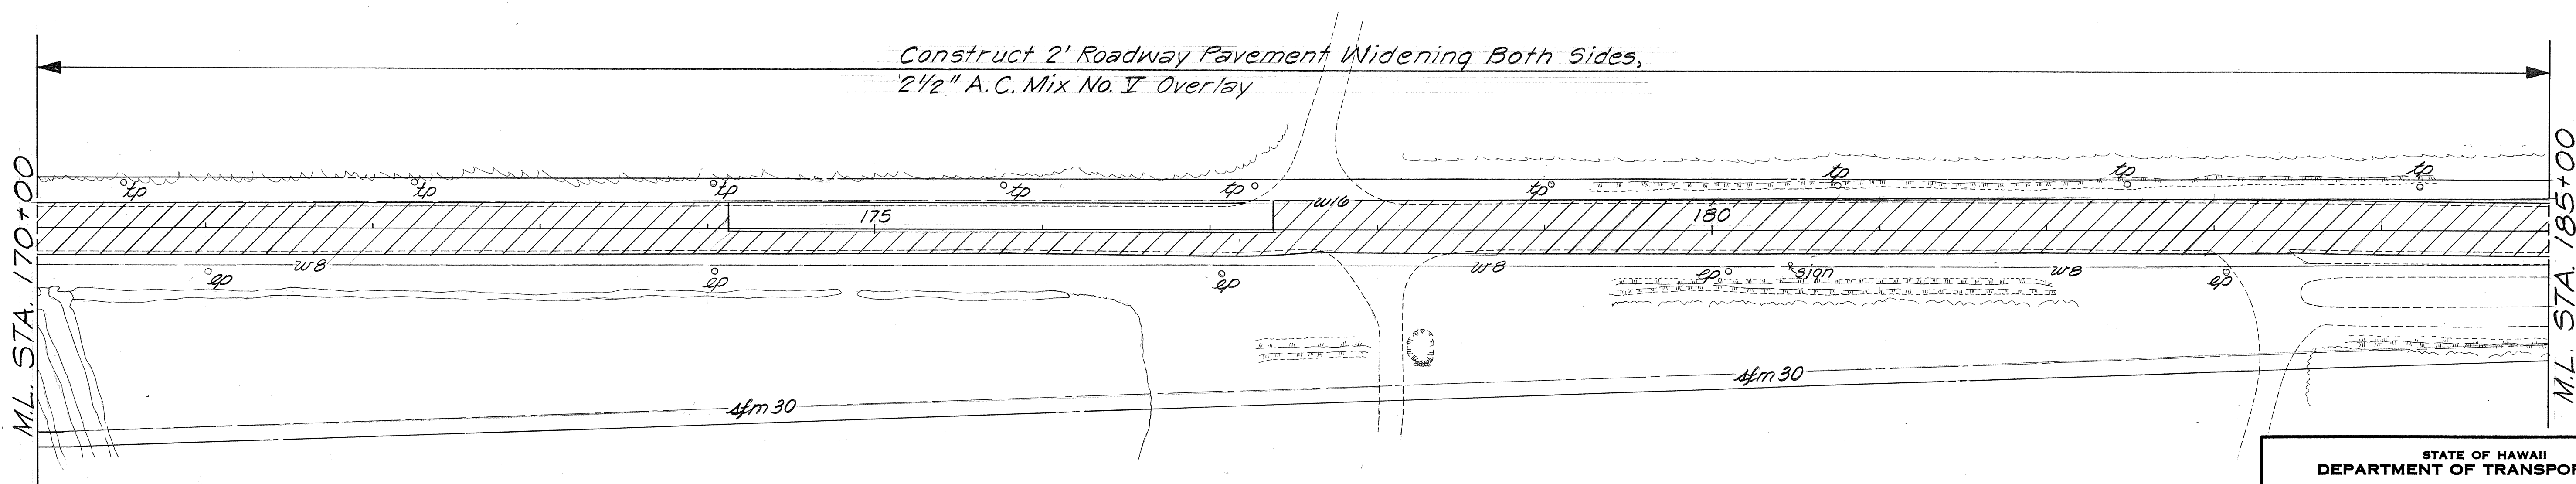

STATE OF HAWAII
DEPARTMENT OF TRANSPORTATION
LAND TRANSPORTATION FACILITIES DIVISION



ROADWAY PLANS

FORT WEAVER ROAD RESURFACING
VICINITY OF RENTON RD TO NORTH RD
PROJECT NO. 7600A-01-83M
SCALE: 1"=50' DATE: JULY, 1982
SHEET NO. 3 OF 5 SHEETS

ORIGINAL	SURVEY PLOTTED BY	DATE
PLAN	DESIGNED BY	
NOTE BOOK	TRACED BY	
NO.	QUANTITIES BY	
	CHECKED BY	

FED. ROAD DIST. NO.	STATE	PROJ. NO.	FISCAL YEAR	SHEET NO.	TOTAL SHEETS
HAWAII	HAW.	7600A-01-83M	1983	8	21

TRUE NORTH
Scale: 1"=50'

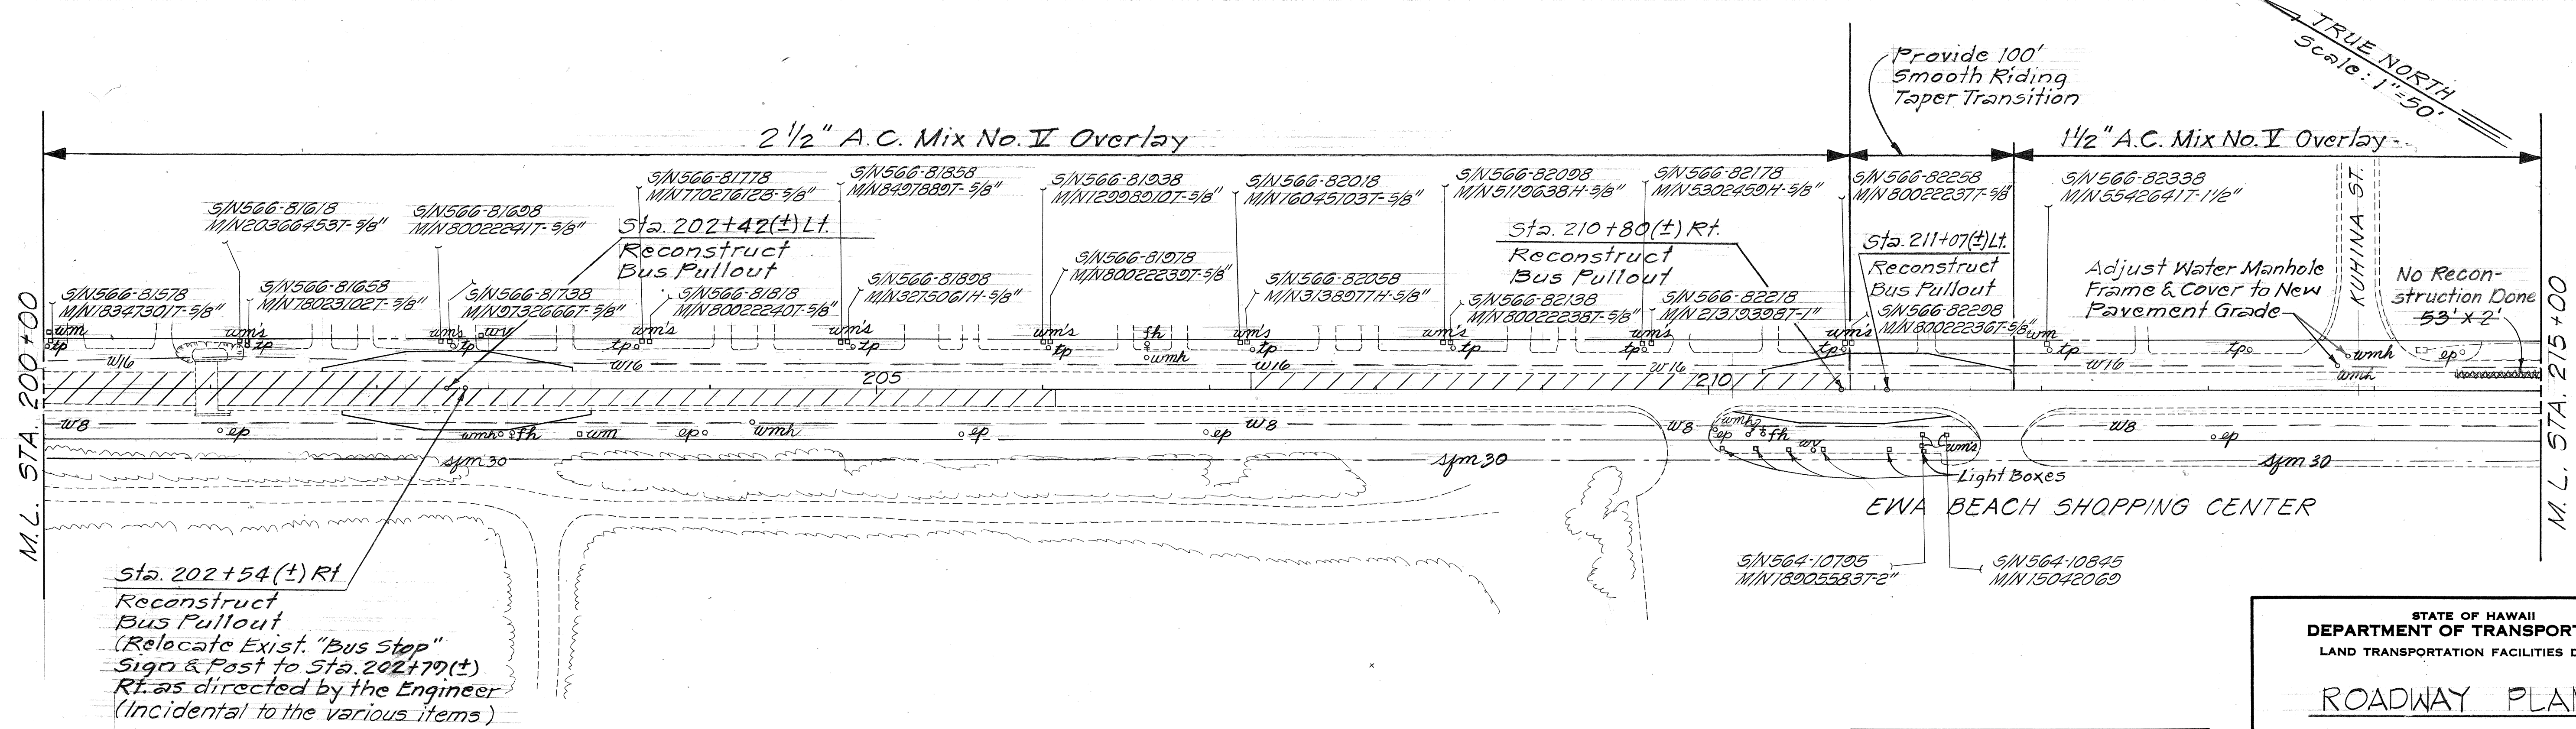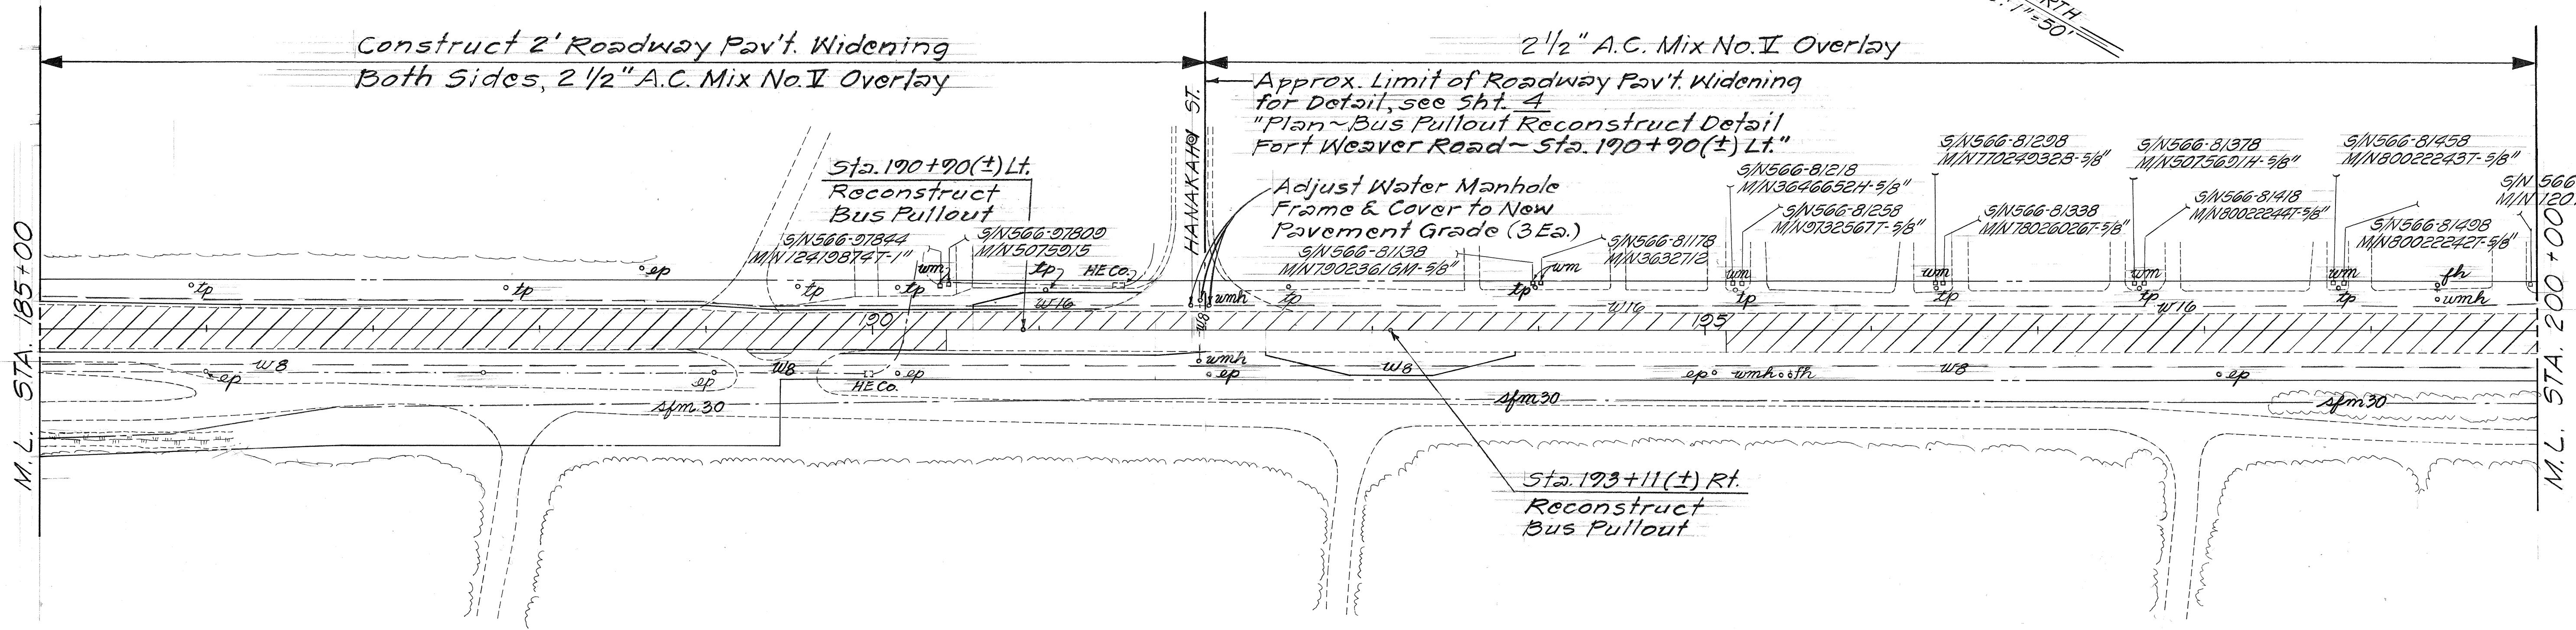


ORIGINAL PLAN	DATE
DRAWN BY	
TRACED BY	
DESIGNED BY	
QUANTITIES BY	
CHECKED BY	

APPROVED:
R. Wright
for Chief, Planning & Engineering, B.W.S. 8-2-82 Date

STATE OF HAWAII
DEPARTMENT OF TRANSPORTATION
LAND TRANSPORTATION FACILITIES DIVISION
ROADWAY PLANS
FORT WEAVER ROAD RESURFACING
VICINITY OF RENTON RD. TO NORTH RD.
PROJECT NO. 7600A-01-83M
SCALE: 1"=50' DATE: JULY, 1982
SHEET NO. 4 OF 5 SHEETS

FED. ROAD DIST. NO.	STATE	PROJ. NO.	FISCAL YEAR	SHEET NO.	TOTAL SHEETS
HAWAII	HAW.	7600A-01-B3M	1983	9R	21

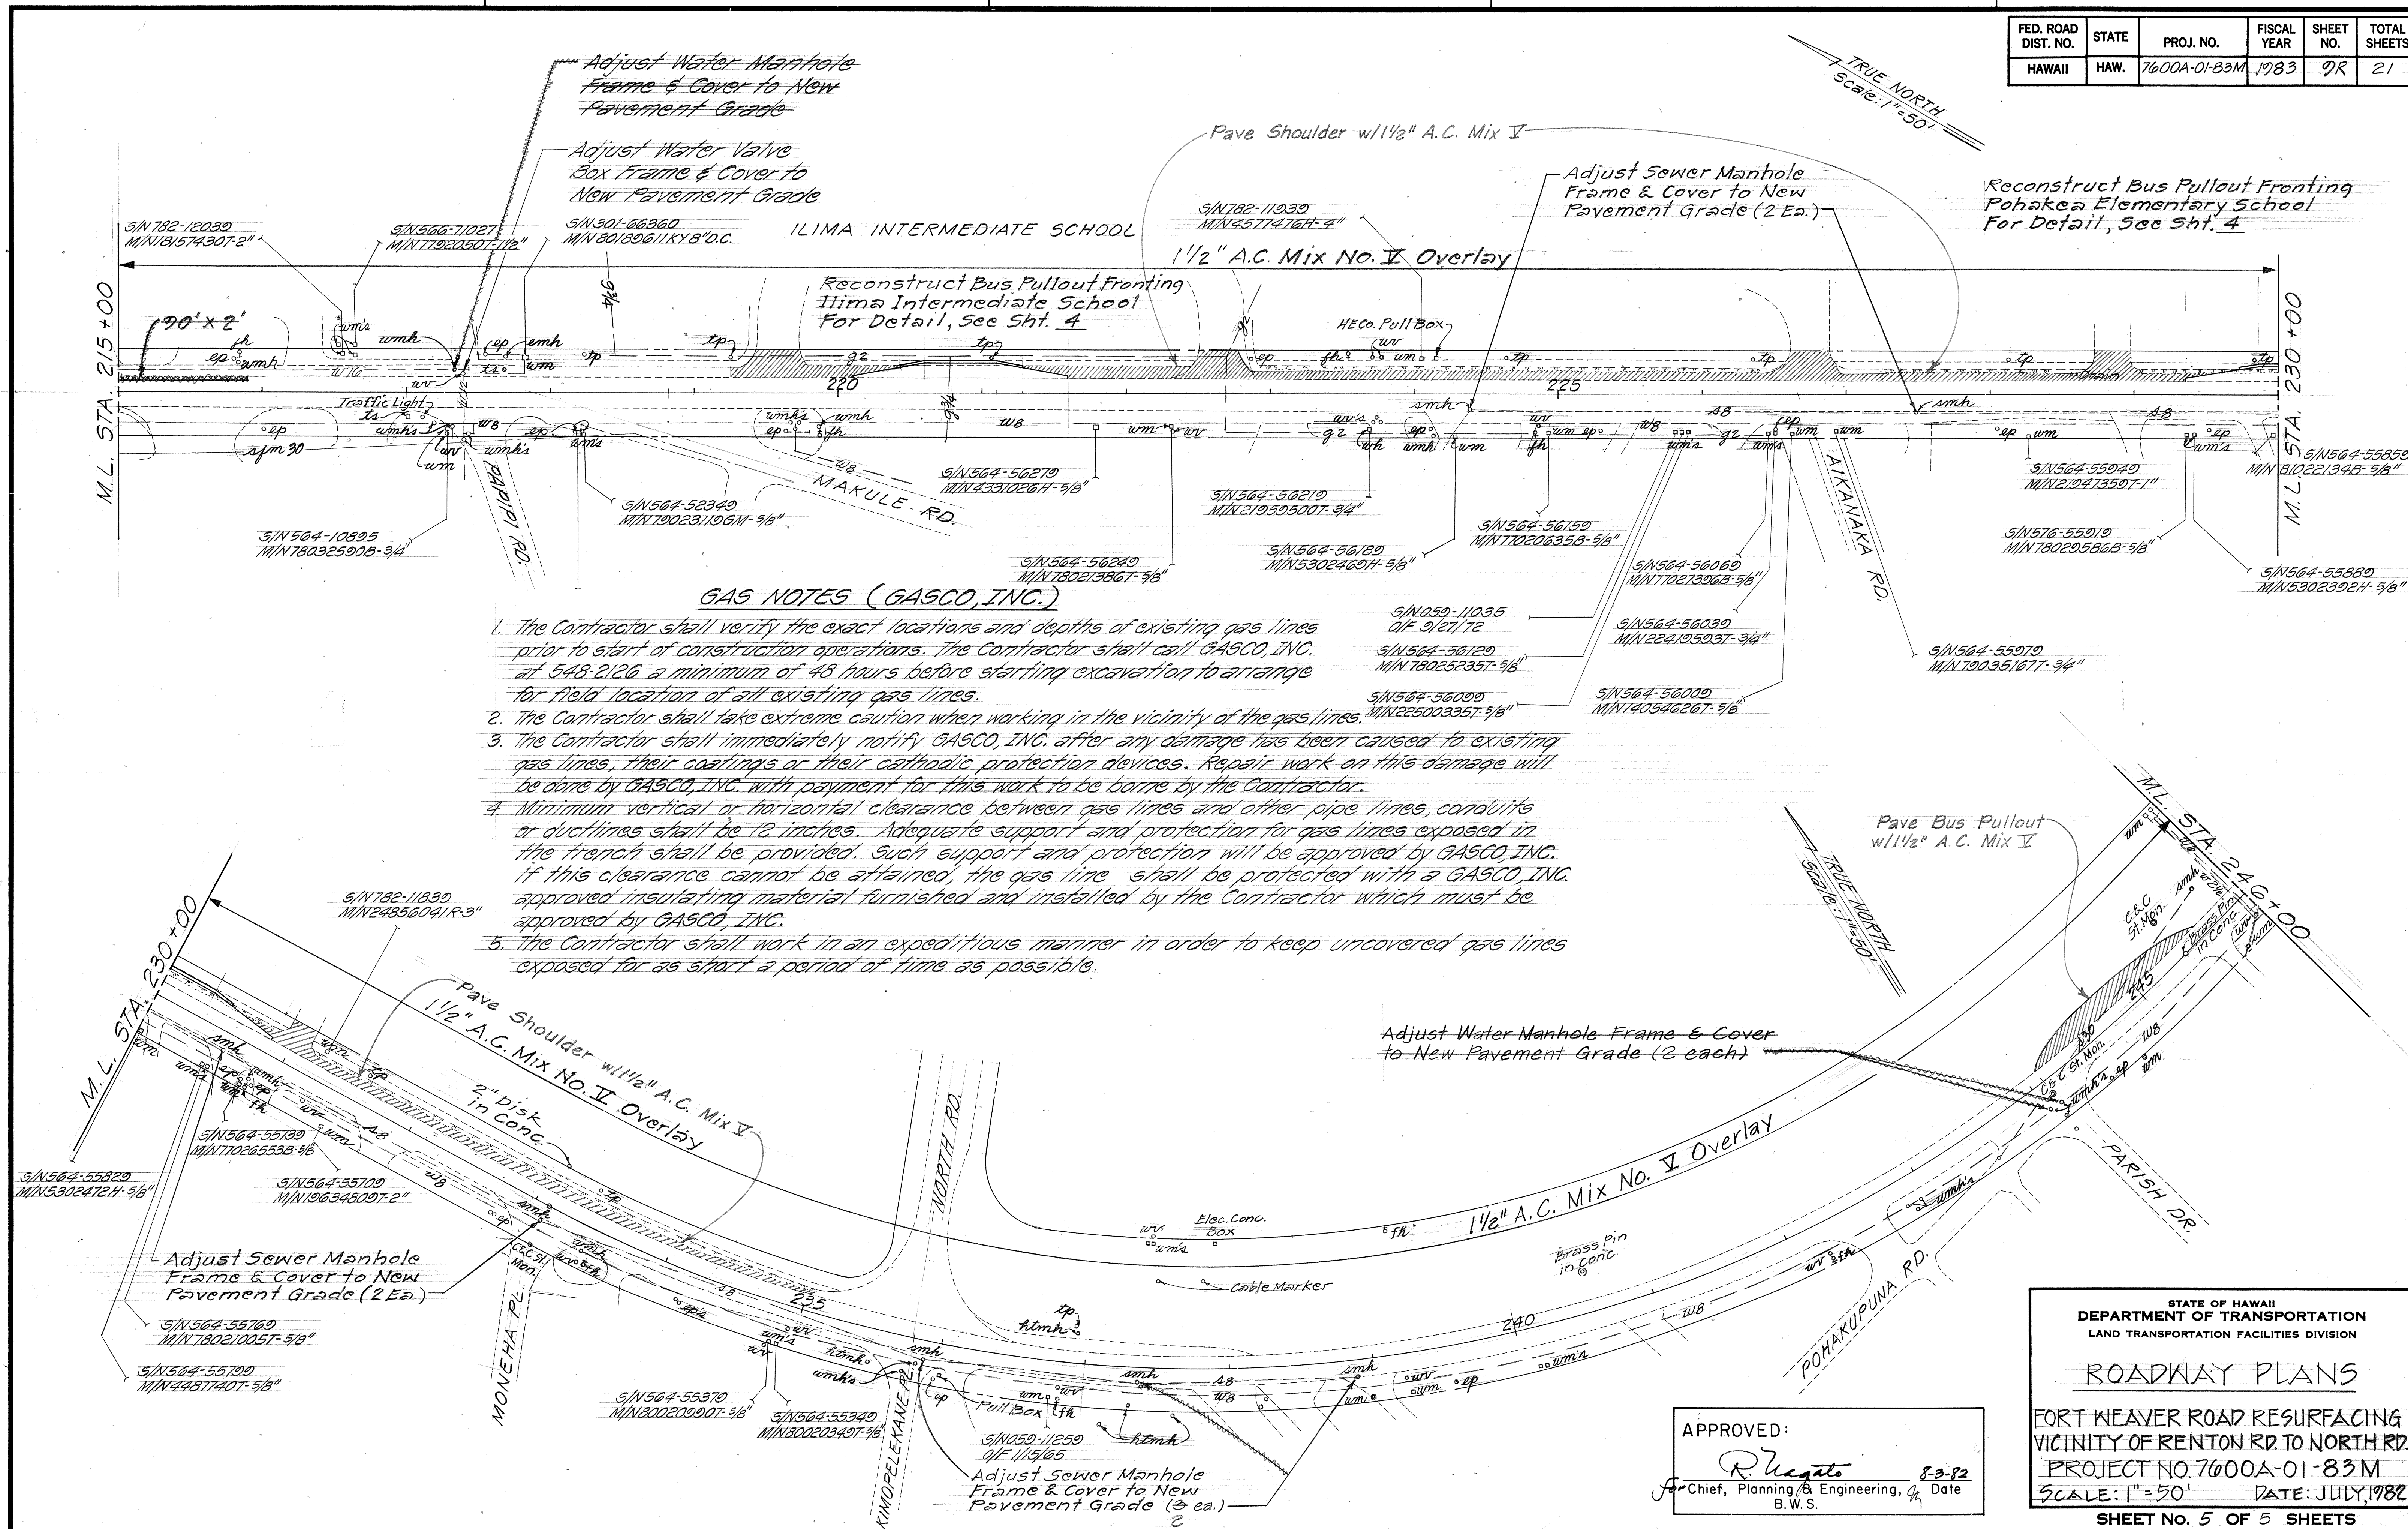

ORIGINAL PLAN	SURVEY PLOTTED BY _____	DATE _____
	DRAWN BY _____	" _____
	TRACED BY _____	" _____
NOTE BOOK	DESIGNED BY _____	" _____
	QUANTITIES BY _____	" _____
No. _____	CHECKED BY _____	" _____

**STATE OF HAWAII
DEPARTMENT OF TRANSPORTATION
LAND TRANSPORTATION FACILITIES DIVISION**



ROADWAY PLANS

FORT WEAVER ROAD RESURFACING
VICINITY OF RENTON RD TO NORTH RD.
PROJECT NO. 7600A-01-83M
SCALE: 1" = 50' DATE: JULY, 1982

SHEET No. 5 OF 5 SHEETS

98

FED. ROAD DIST. NO.	STATE	FED. AID PROJ. NO.	FISCAL YEAR	SHEET NO.	TOTAL SHEETS
HAWAII	HAW.	7600A-01-B3M	1983	95-1	25

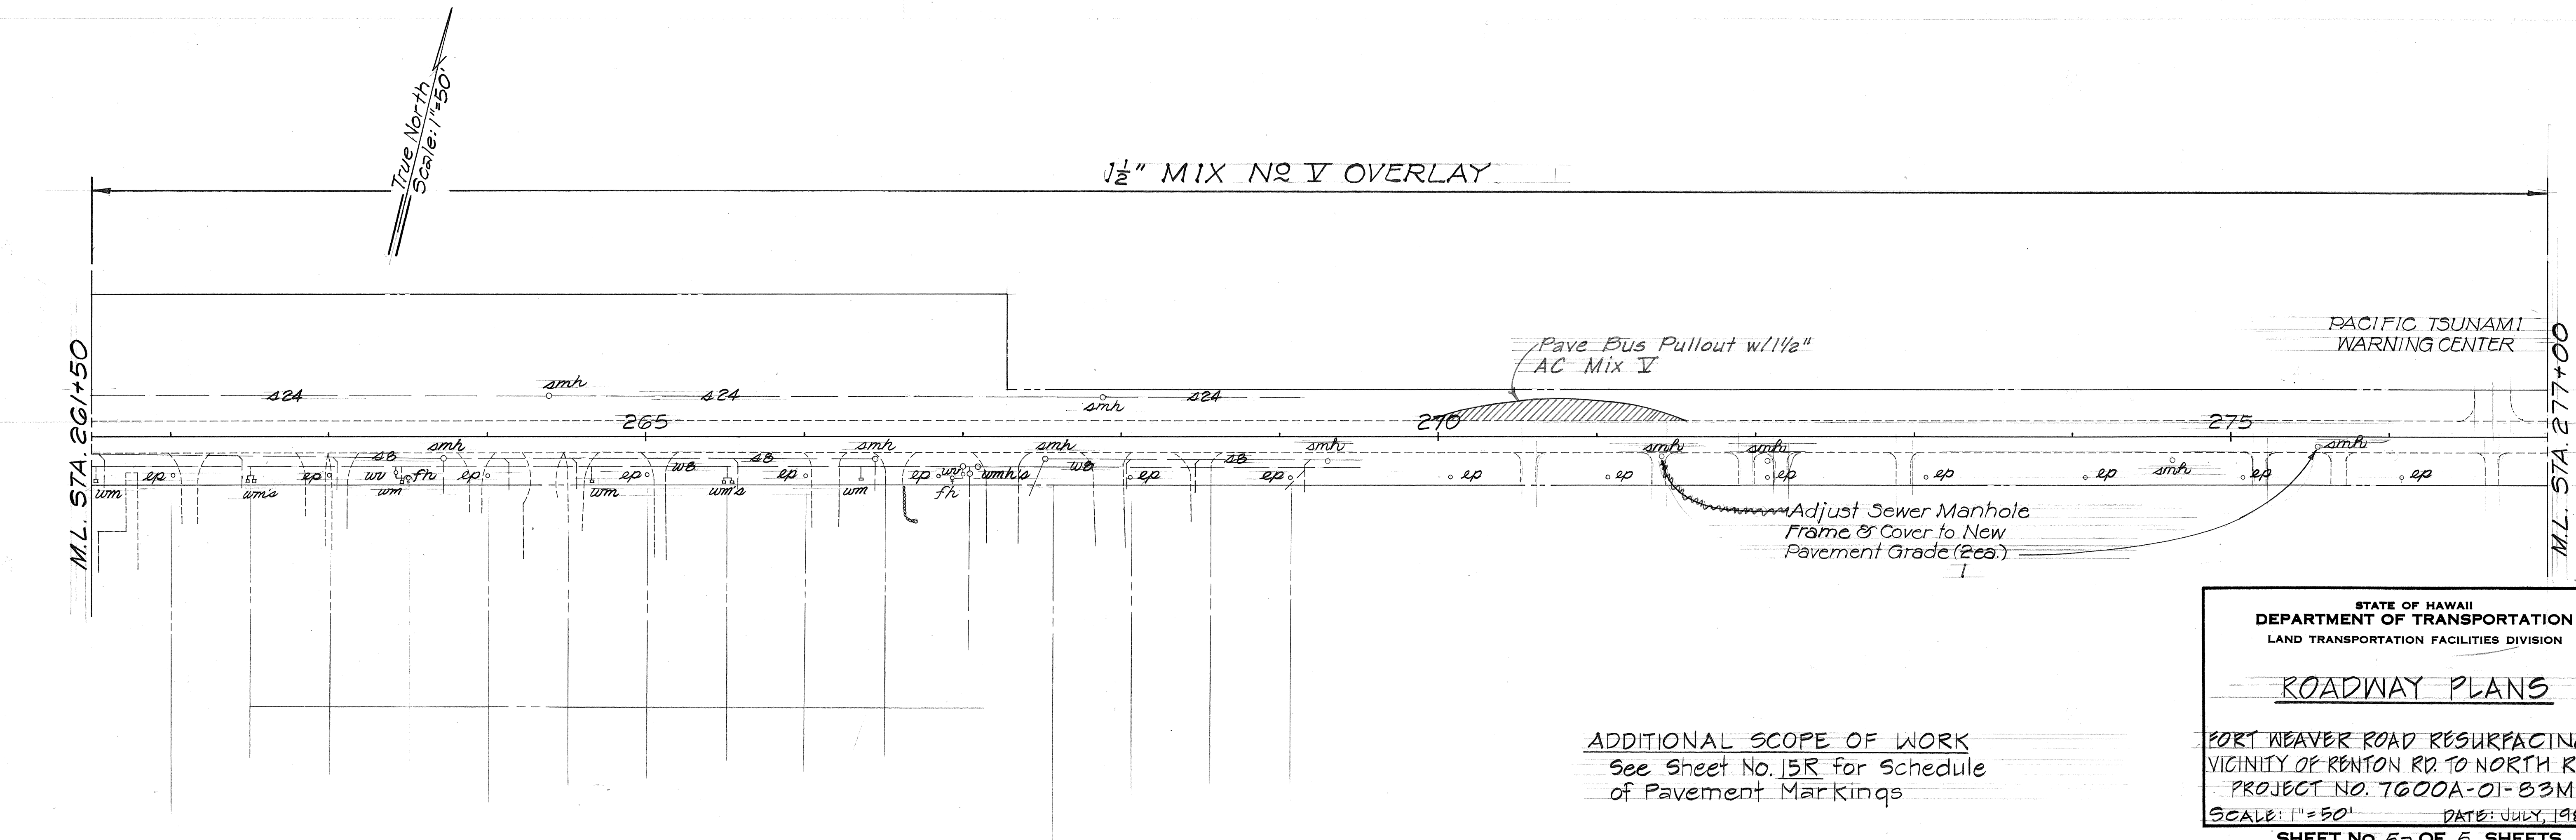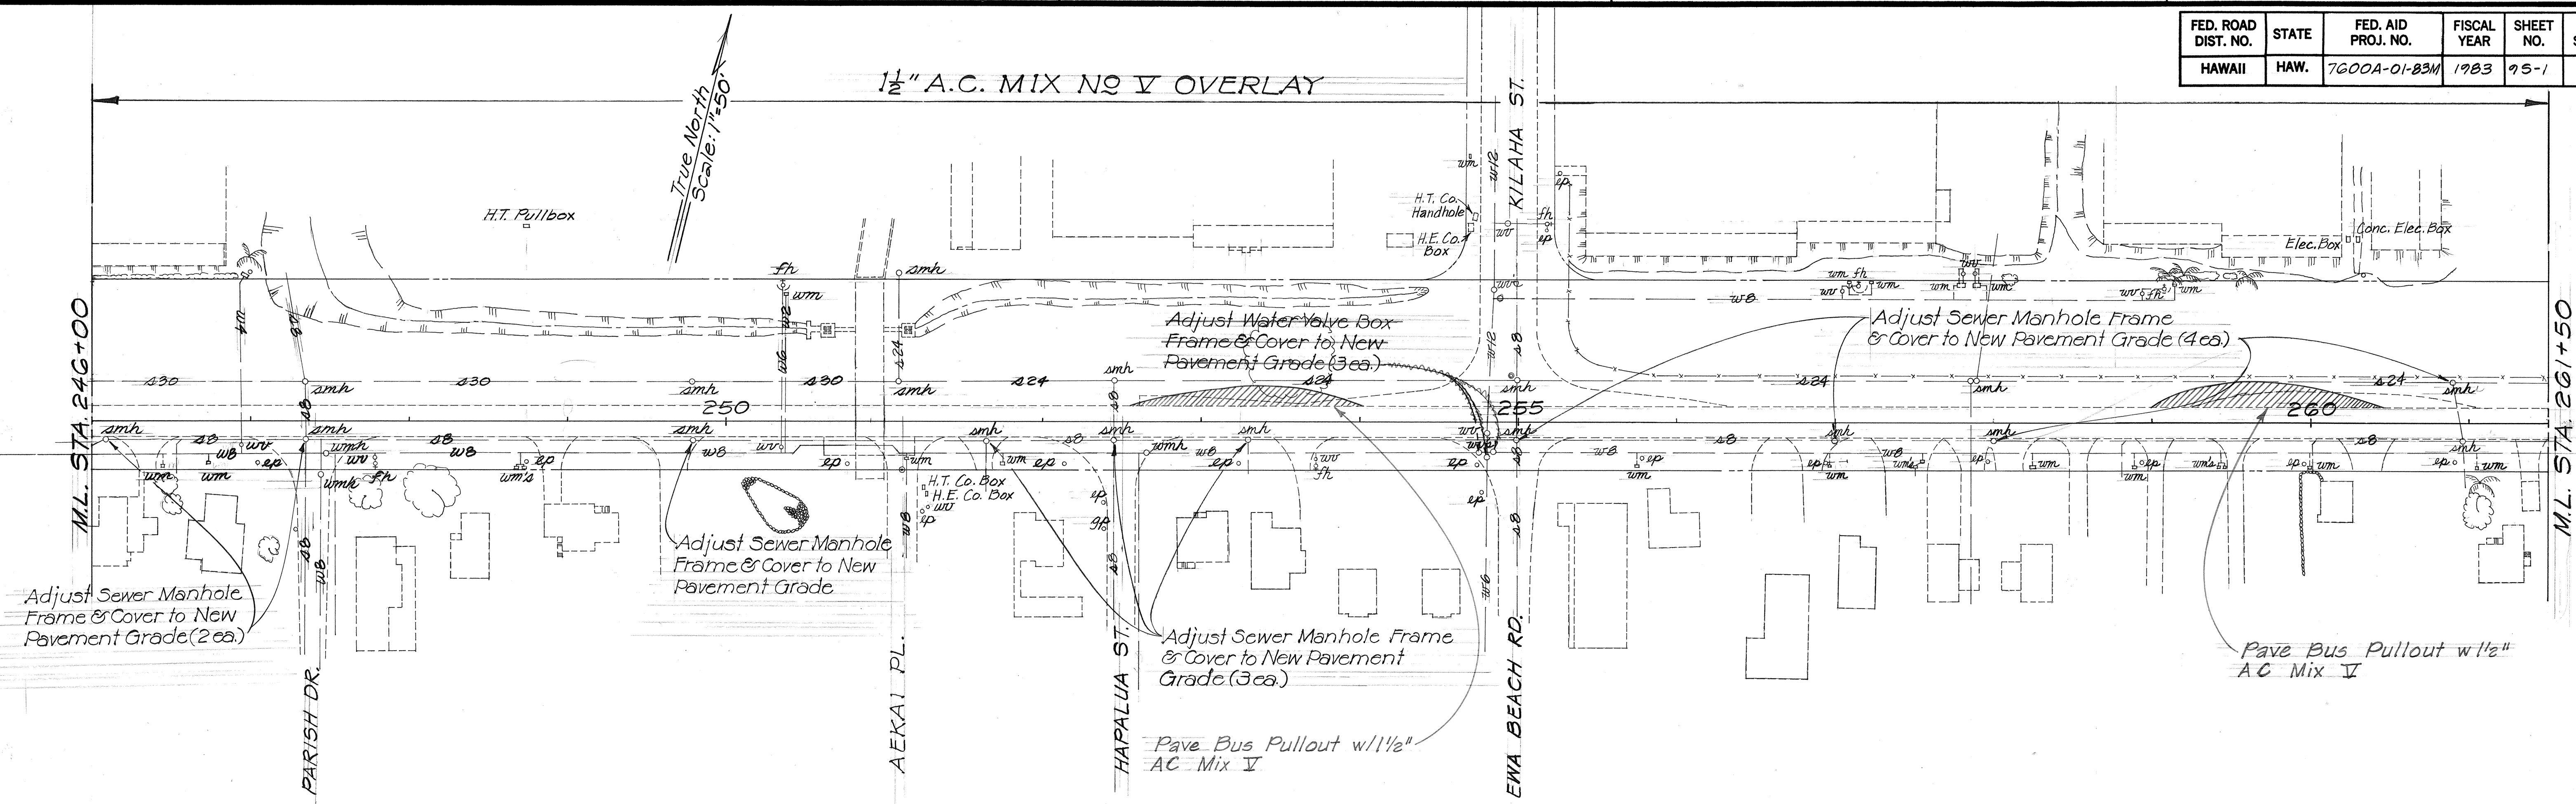

ORIGINAL PLAN	DATE
SURVEY PLOTTED BY	
DESIGNED BY	
NOTE BOOK	
QUANTITIES BY	
CHECKED BY	



ADDITIONAL SCOPE OF WORK
See Sheet No. 15R for Schedule
of Pavement Markings

STATE OF HAWAII
DEPARTMENT OF TRANSPORTATION
LAND TRANSPORTATION FACILITIES DIVISION

ROADWAY PLANS

FORT WEAVER ROAD RESURFACING
VICINITY OF RENTON RD TO NORTH RD
PROJECT NO. 7600A-01-B3M
SCALE: 1" = 50' DATE: JULY, 1982
SHEET NO. 52 OF 5 SHEETS

FED. ROAD DIST. NO.	STATE	FED. AID PROJ. NO.	FISCAL YEAR	SHEET NO.	TOTAL SHEETS
HAWAII	HAW.	7600A-01-83M	1983	95-2	25

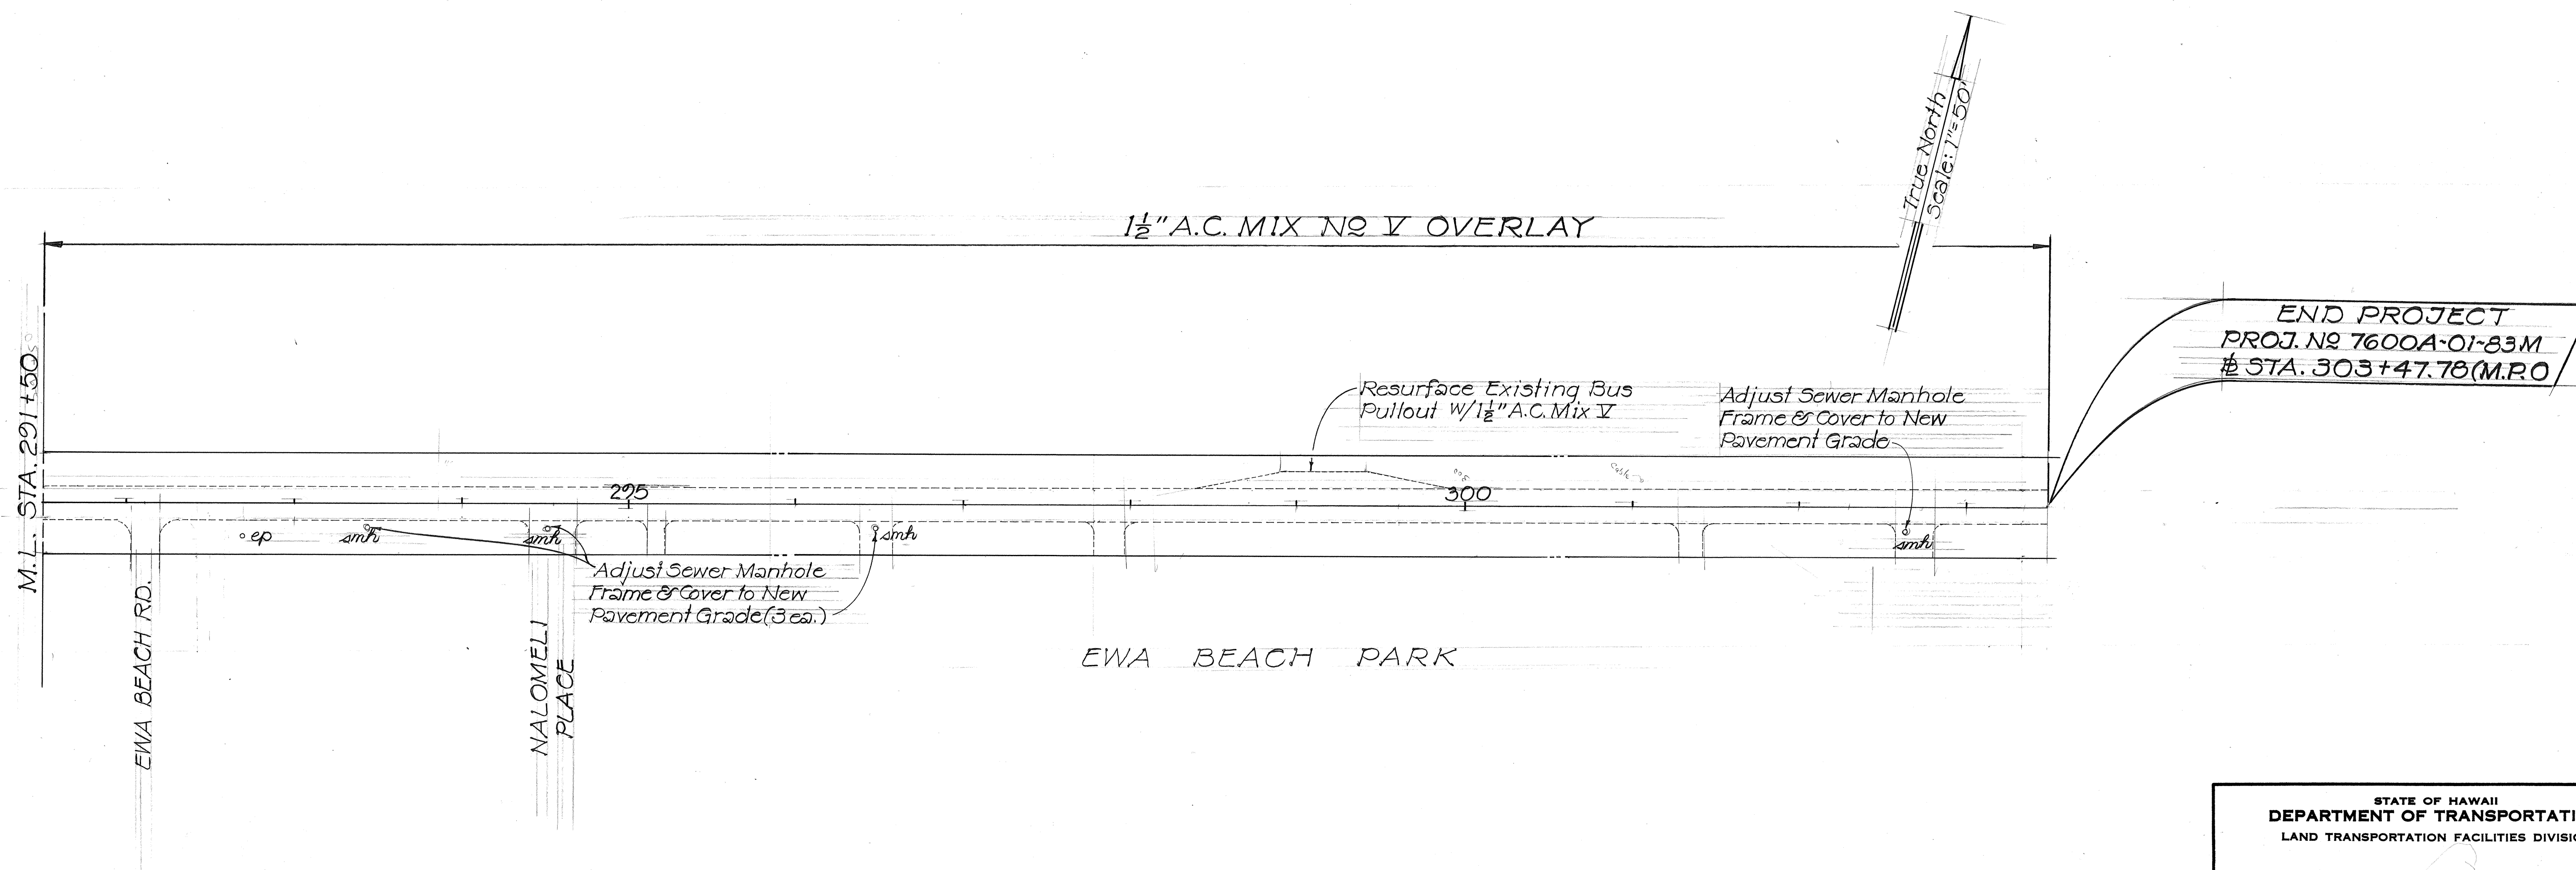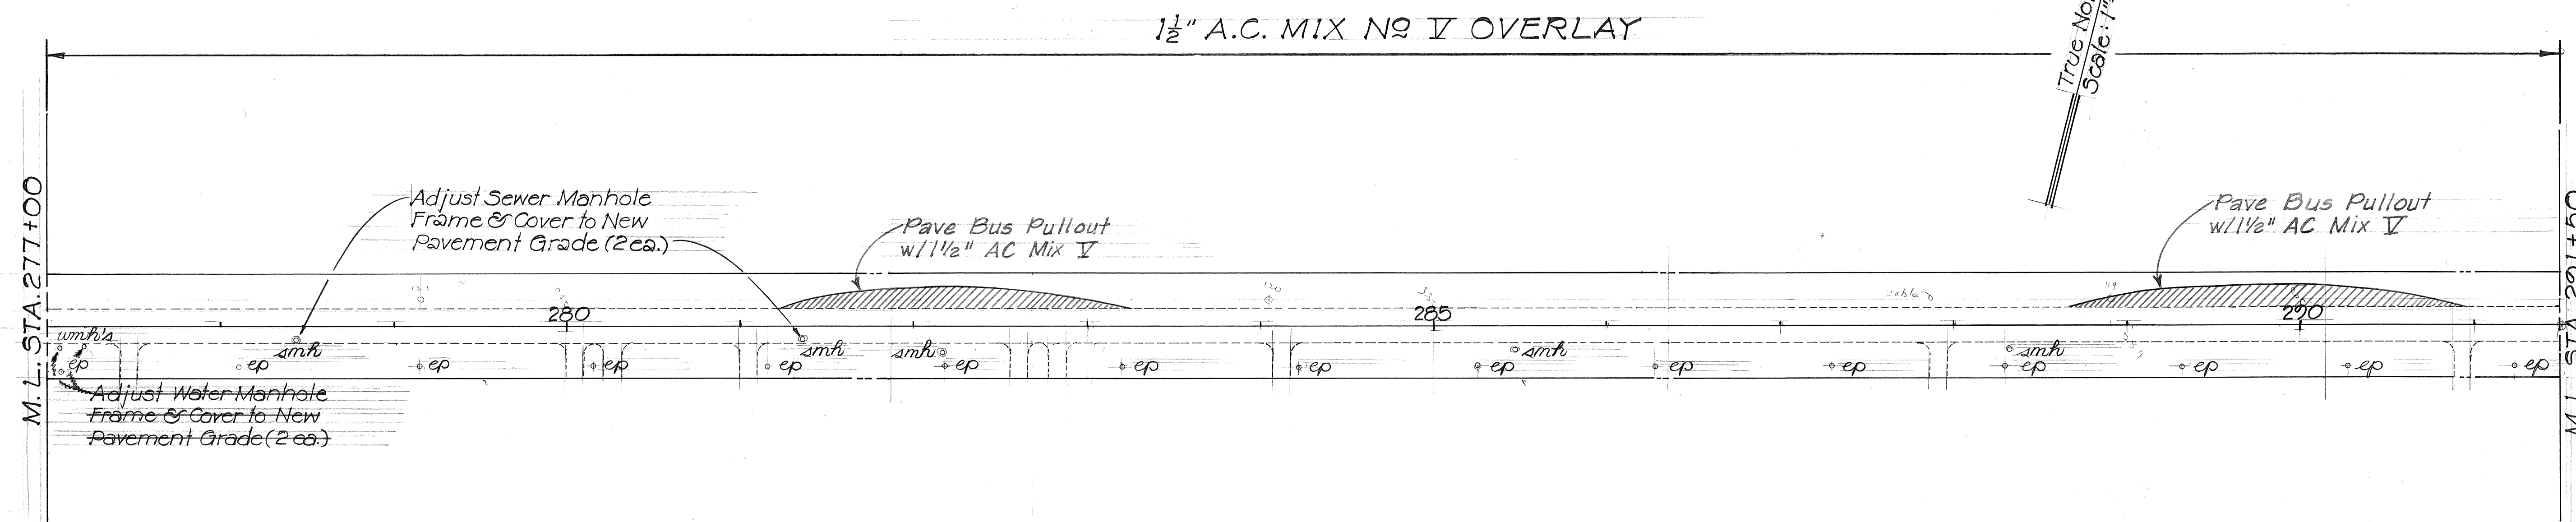

DATE	_____
DESIGNED BY	_____
NOTED BY	_____
CHECKED BY	_____
ORIGINAL PLAN	_____
NOTE BOOK	_____
NO.	_____

ADDITIONAL SCOPE OF WORK
See Sheet No. 15R for Schedule
of Pavement Markings

STATE OF HAWAII
DEPARTMENT OF TRANSPORTATION
LAND TRANSPORTATION FACILITIES DIVISION

ROADWAY PLANS

FORT WEAVER ROAD RESURFACING
VICINITY OF RENTON RD TO NORTH RD
PROJECT NO. 7600A-01-83M
SCALE: 1" = 50' DATE: JULY, 1982
SHEET NO. 56 OF 5 SHEETS