	INDEX TO DRAWINGS
SHEET NO.	DESCRIPTION
	TITLE SHEET
2-12	TRAFFIC SIGNAL, PAVEMENT MARKING & STRIPING PLANS AND DETAILS
(2)	TRAFFIC SIGNAL PLAN, LEGEND AND NOTES
(3)	PAVEMENT MARKING, SIGNING, AND MISC. DETAILS
(4)	TRAFFIC SIGNAL MISC. DETAILS
(5)	LOOP DETECTORS
(6-12)	STANDARD DETAILS
`	
•	
•	
. *	



STATE OF HAWAII

DEPARTMENT OF TRANSPORTATION

HIGHWAYS DIVISION

PLANS FOR

"AS-BUILT"

FORT WEAVER ROAD

TRAFFIC SIGNAL IMPROVEMENTS AT GEIGER ROAD


PROJECT NO. 76A-01-85

DISTRICT OF EWA

PROJECT NO. 76A-01-85

WEAVER
ROAD

LAYOUT PLAN

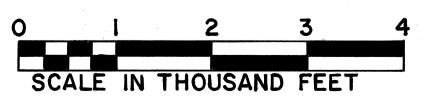

Waidlua Haleiwa Haleiwa Punaluu Kaaawa Wainnole Kahaluu Wainnole Kahaluu Wainnole Kahaluu Handuu Pearl Citaiea Kahaluu Kailua Kaaluu Kailua Ka

FEDERAL AID PROJECTS PREVIOUSLY CONSTRUCTED
OR UNDER CONSTRUCTION

NO SIGNIFICANT CHANGES WERE MADE DURING CONSTRUCTION ON THESE PLANS EXCEPT CHANGES IN THE ORIGINAL THEORETICAL QUANTITIES. FOR ACTUAL QUANTITIES, REFER TO PROJECT LEDGER AND/OR COMPUTATION BOOK.

RESIDENT ENGINEER

<u>//- /- 85</u> DATE FISCAL SHEET TOTAL YEAR NO. SHEETS

1985

PROJ. NO.

76A-01-85

DEPARTMENT OF TRANSPORTATION
STATE OF HAWAII

APPROVED:

Check D. Loon
2/13/85

FOLDIR. OF TRANSPORTATION
DATE

A. NISHIMURA 548-7490 F P. S. & E. BY PHONE

A. NISHIMURA