



ORIGINAL SURVEY	DATE	BY
SURVEYED		
PLOTTED		
NOTE BOOK		
AREAS		
CHECKED		

ORIGINAL SURVEY	DATE	BY
SURVEYED		
PLOTTED		
NOTE BOOK		
AREAS		
CHECKED		

FED. ROAD DIST. NO.	STATE	FED. AID PROJ. NO.	FISCAL YEAR	SHEET NO.	TOTAL SHEETS
HAWAII	HAW.	F0761(1)	1986	98	121

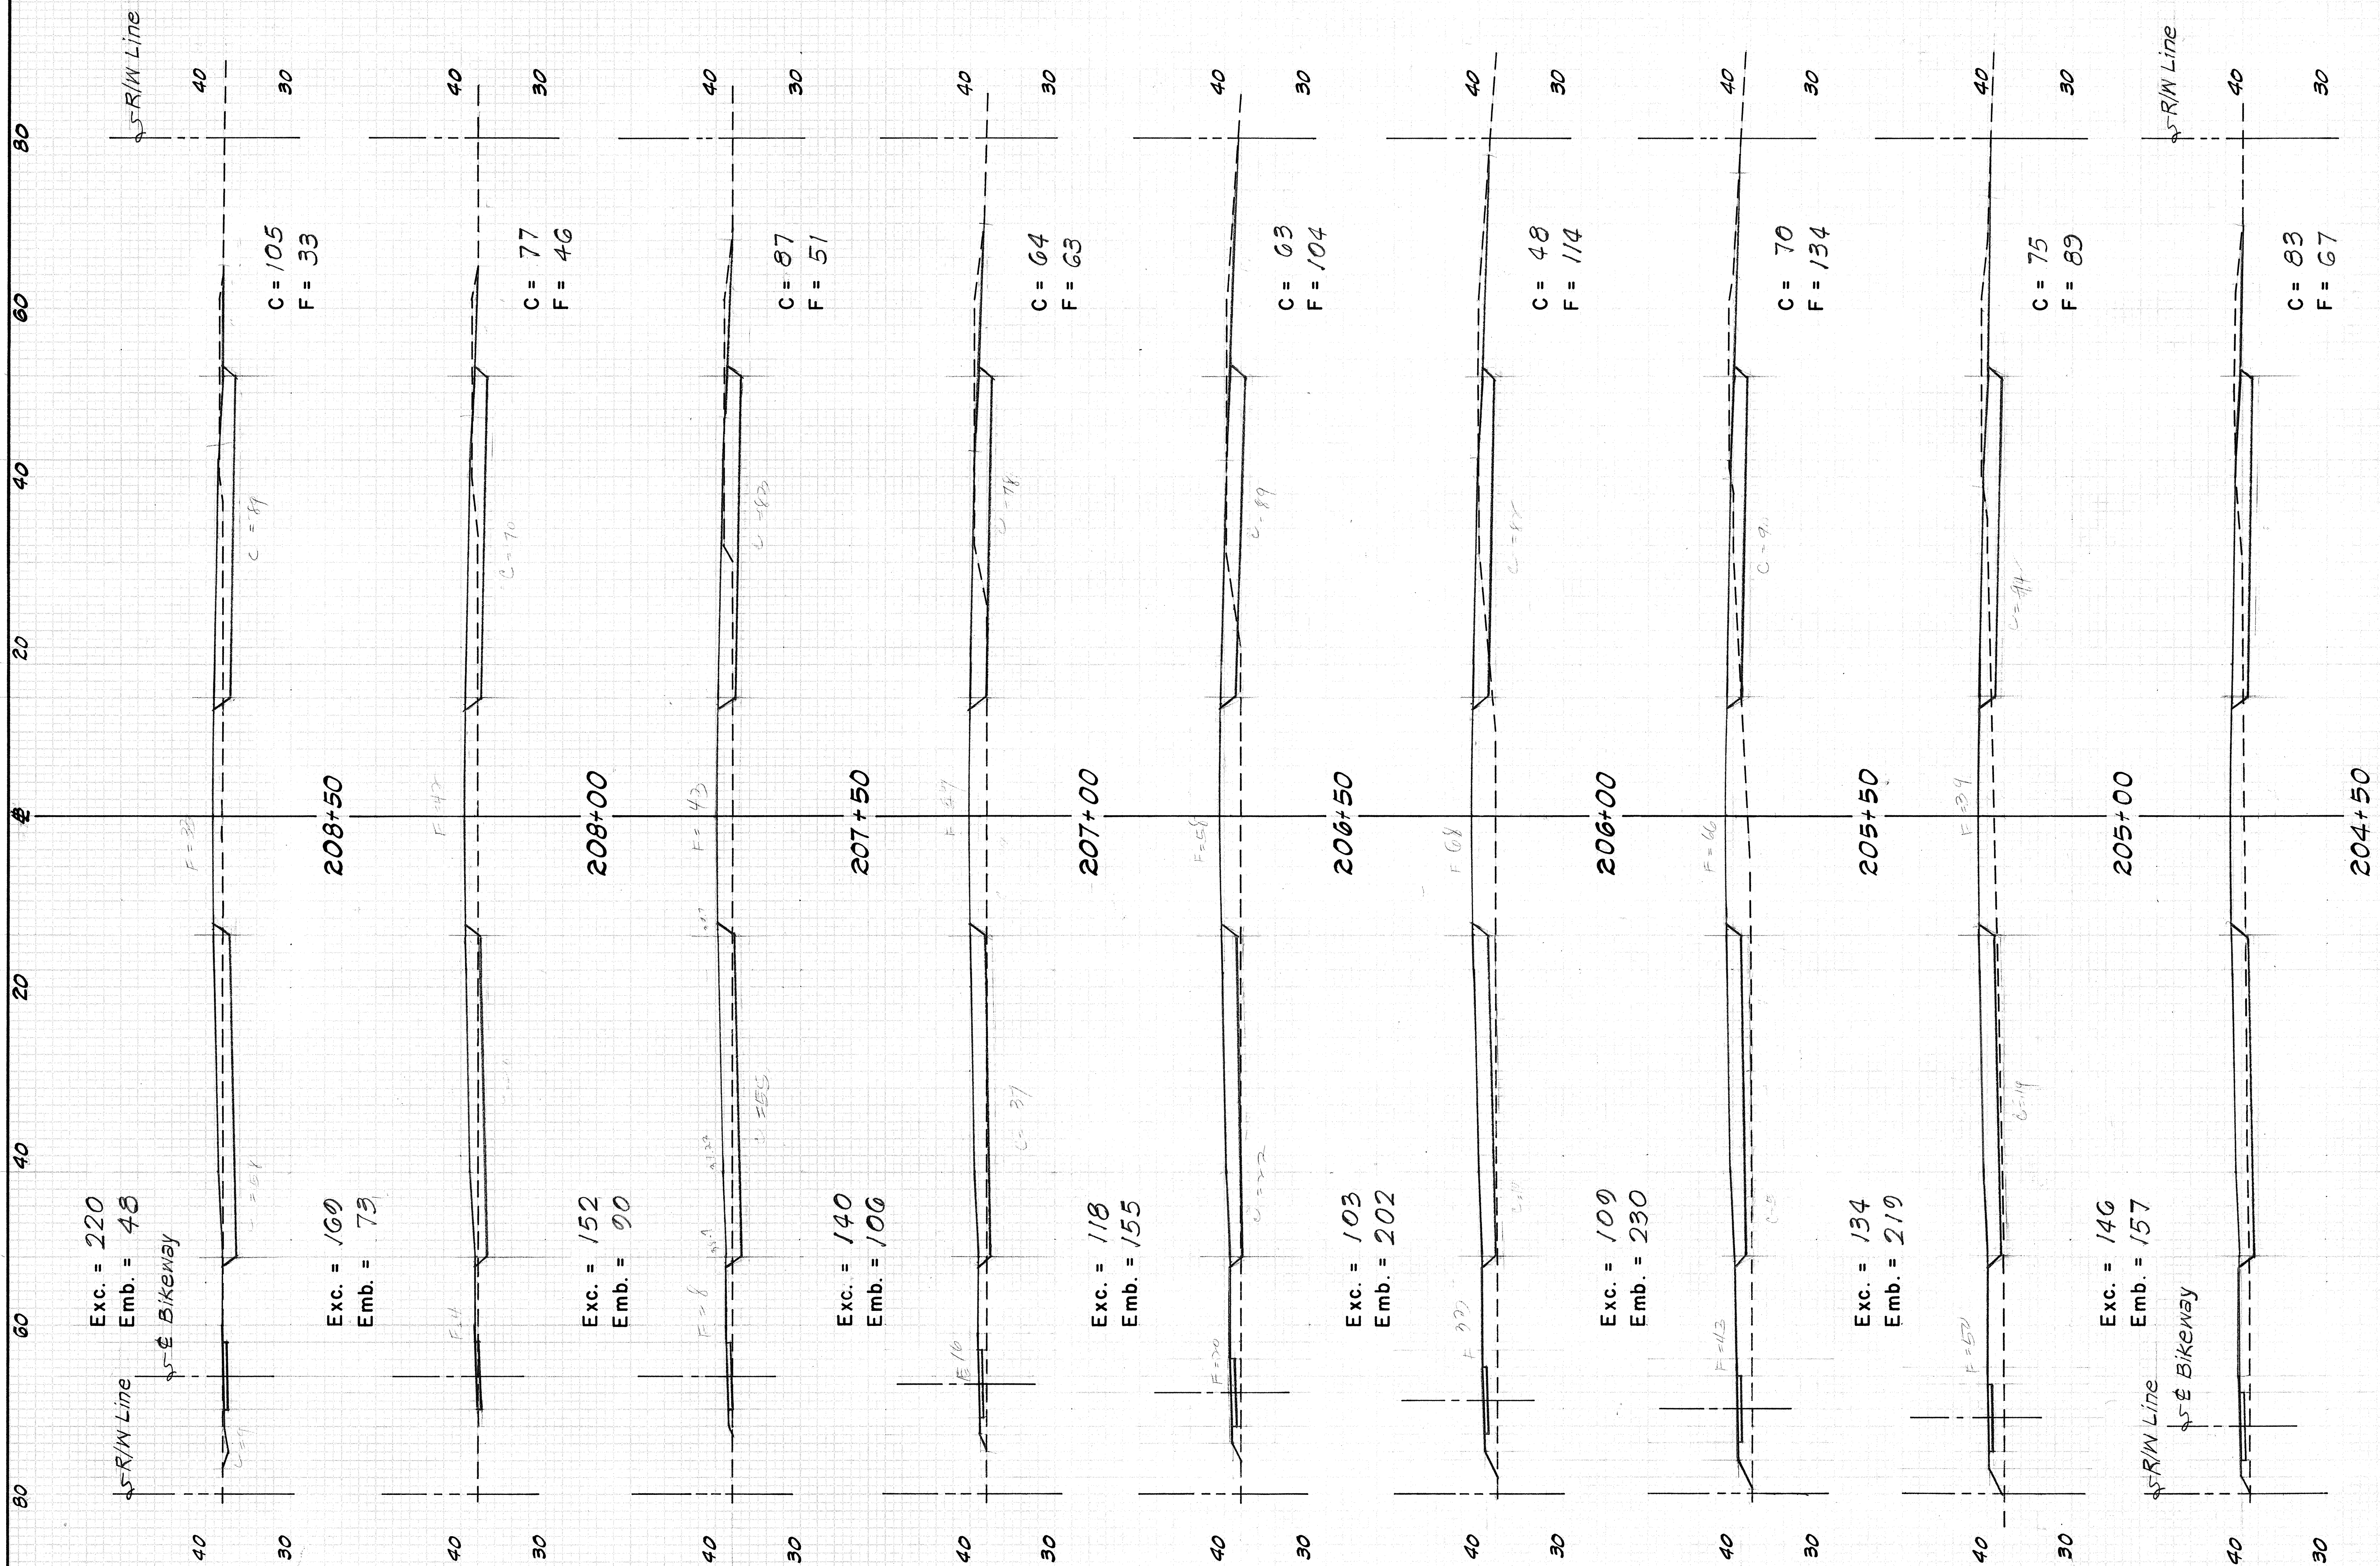

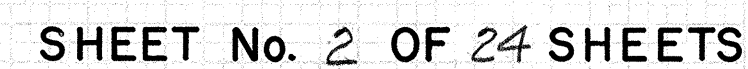


ADD. 99

FED. ROAD DIST. NO.	STATE	FED. AID PROJ. NO.	FISCAL YEAR	SHEET NO.	TOTAL SHEETS
HAWAII	HAW.	F076-1(1)	1986	99	121


FINAL	SURVEYED	BY	DATE
SURVEY	PLOTTED		
NOTE BOOK	AREAS		
NO.	AREAS CHECKED		

ORIGINAL	SURVEYED	BY	DATE
SURVEY	PLOTTED		
NOTE BOOK	AREAS		
NO.	AREAS CHECKED		

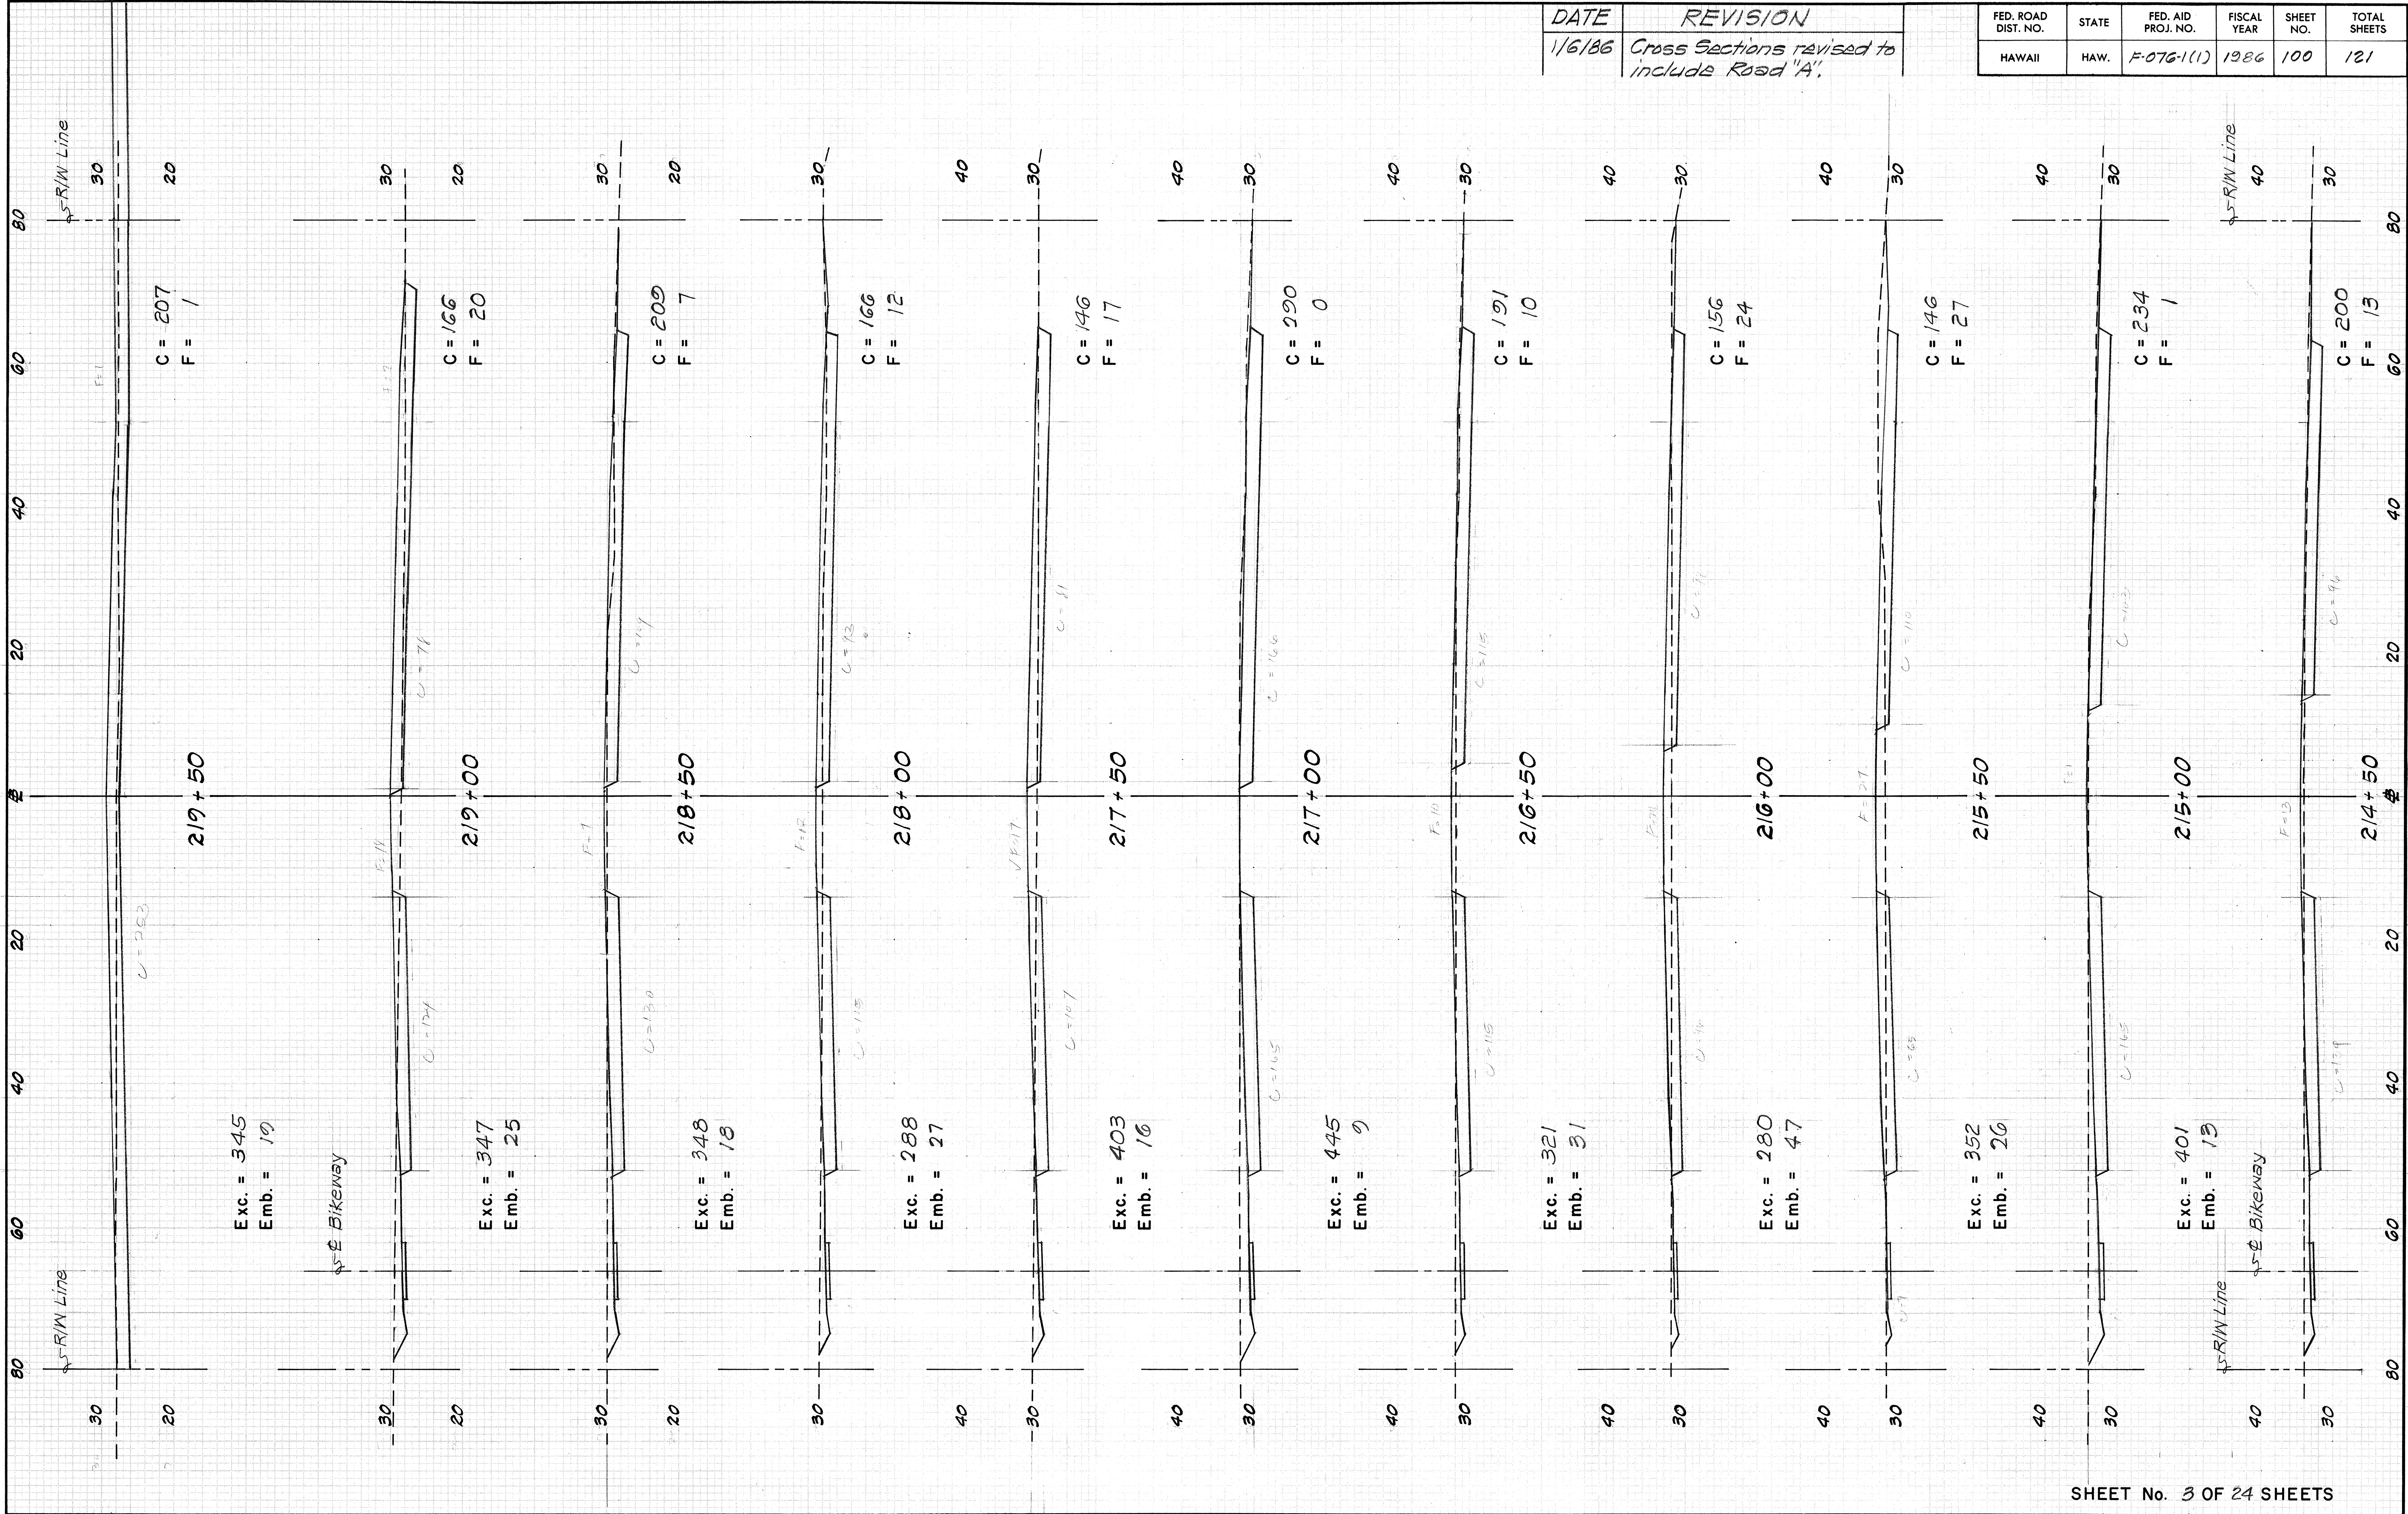


DATE	REVISION
1/6/86	Cross Sections revised to include Road "A".

FED. ROAD DIST. NO.	STATE	FED. AID PROJ. NO.	FISCAL YEAR	SHEET NO.	TOTAL SHEETS
HAWAII	HAW.	F-076-1(1)	1986	100	121

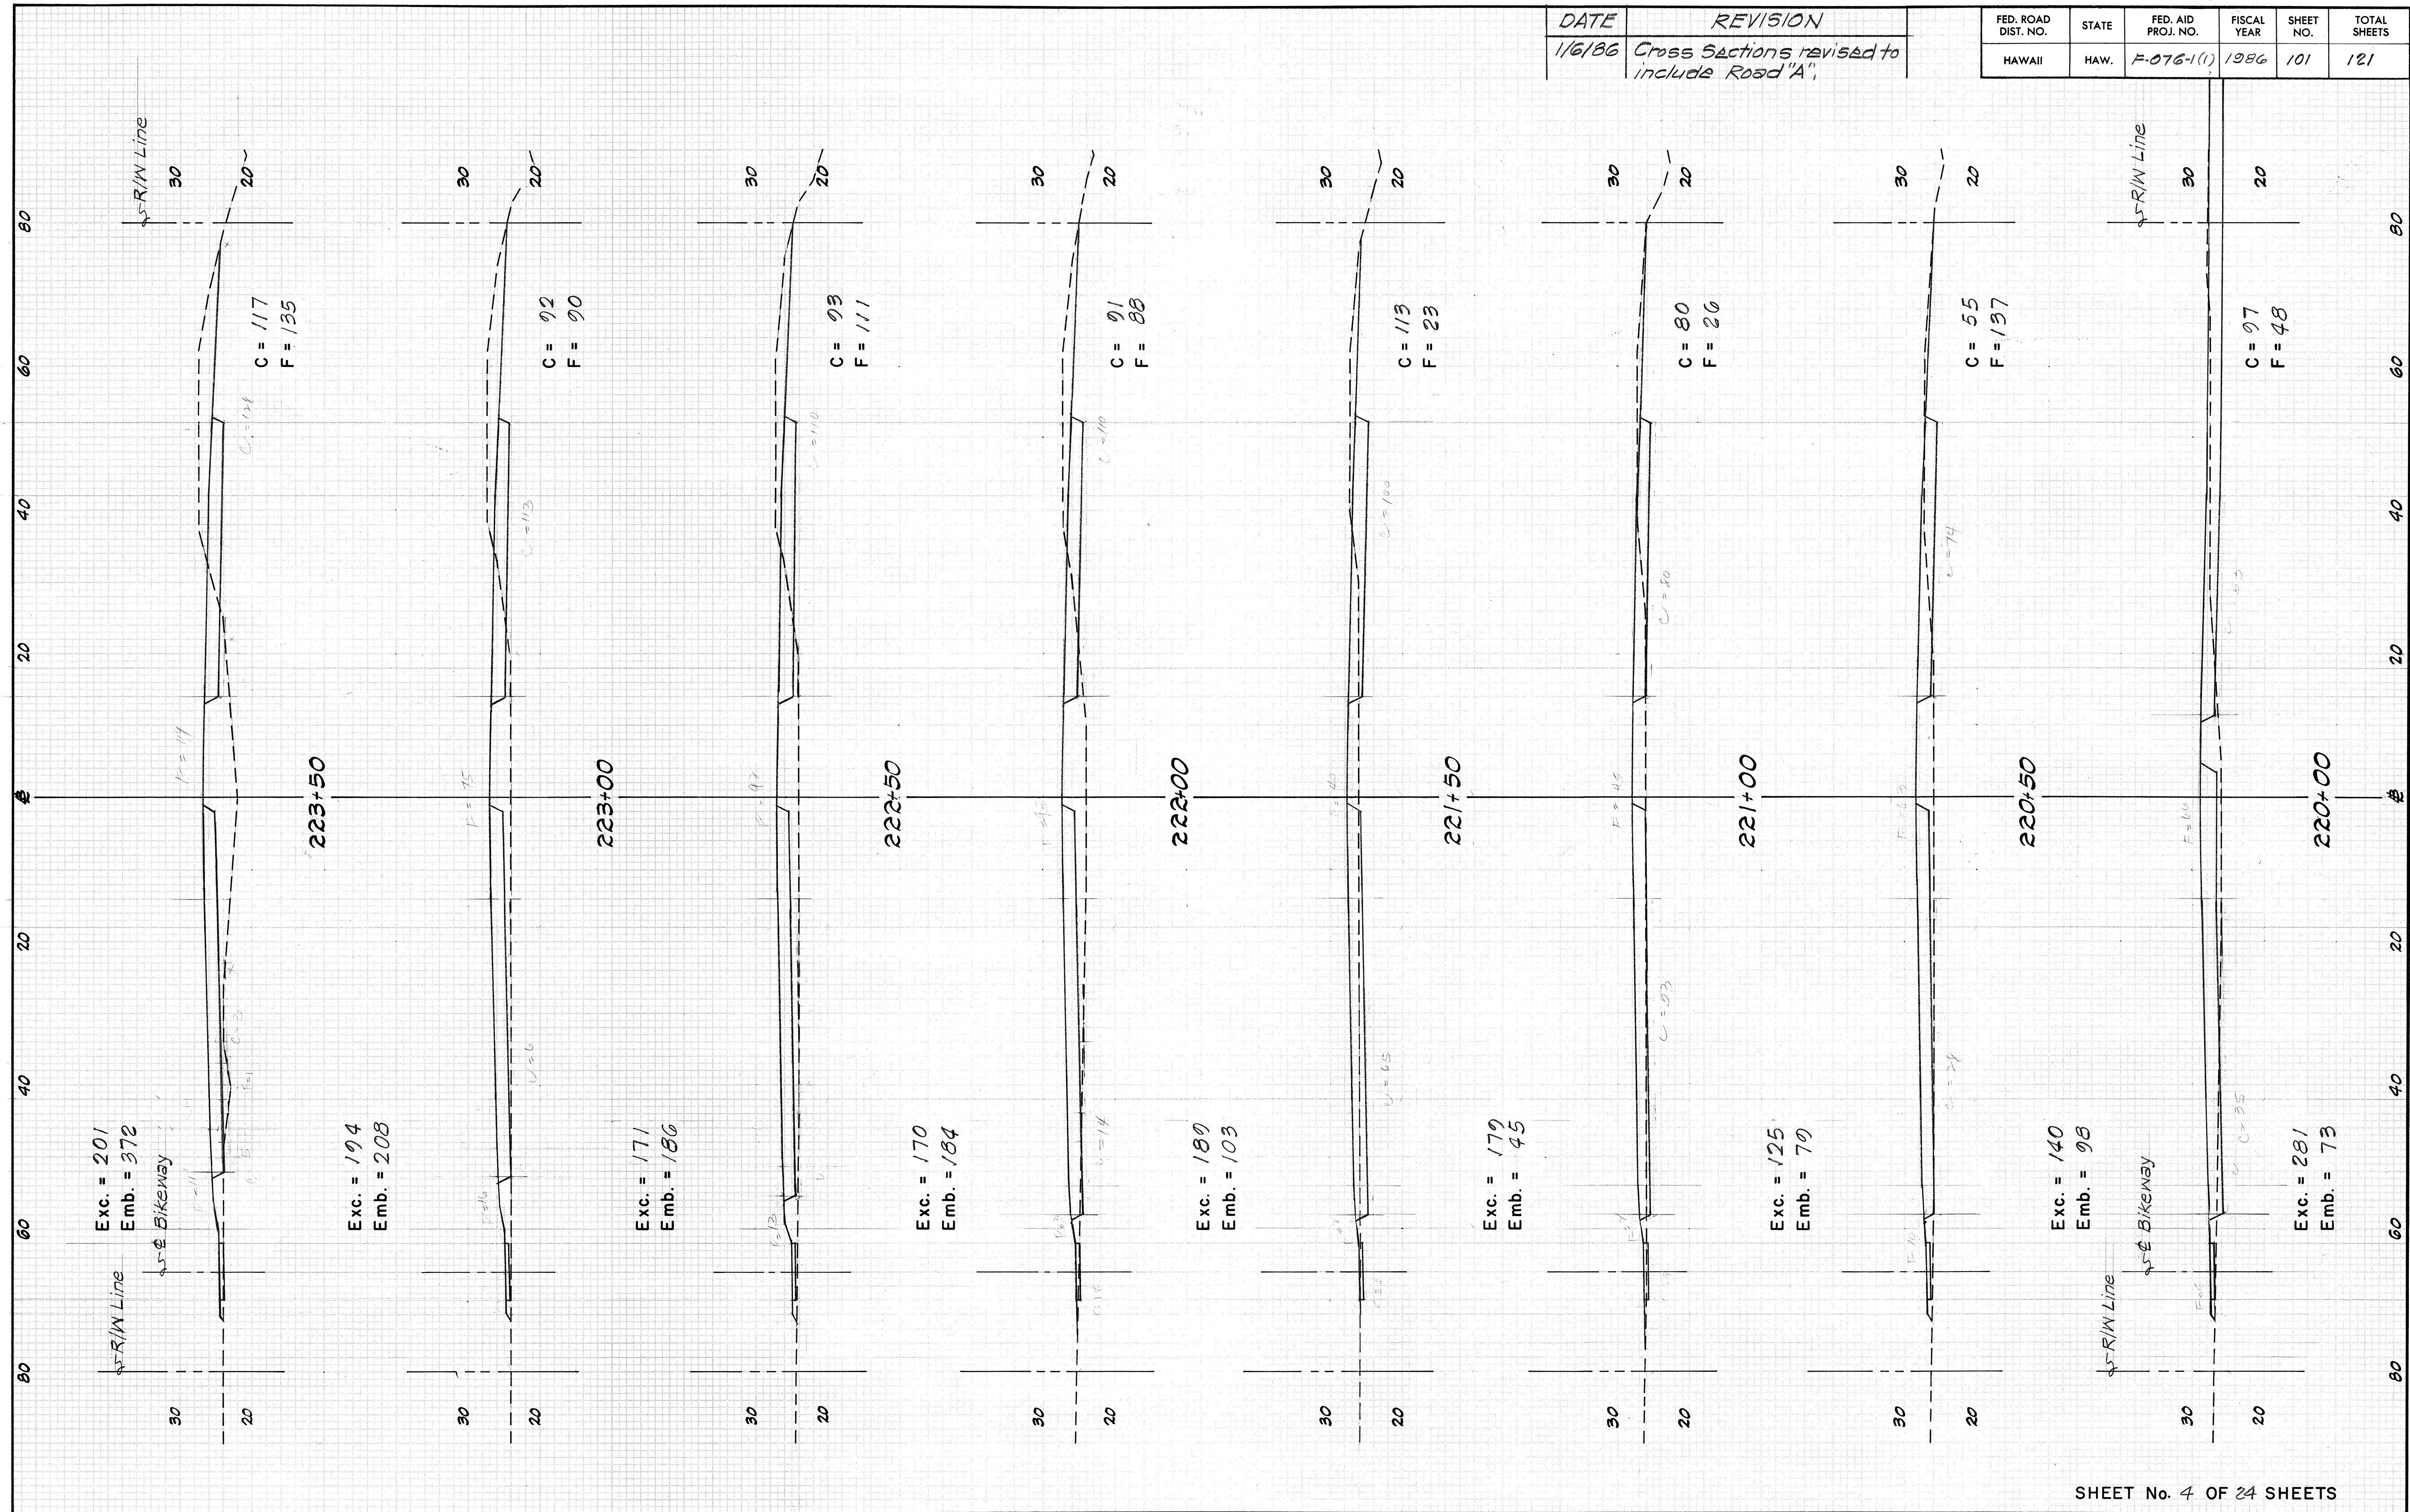


FINAL	SURVEY	DATE
SURVEY	PLOTTED	
NOTE BOOK	AREAS	
NO.	AREAS CHECKED	


ORIGINAL	SURVEY	DATE
SURVEY	PLOTTED	
NOTE BOOK	AREAS	
NO.	AREAS CHECKED	

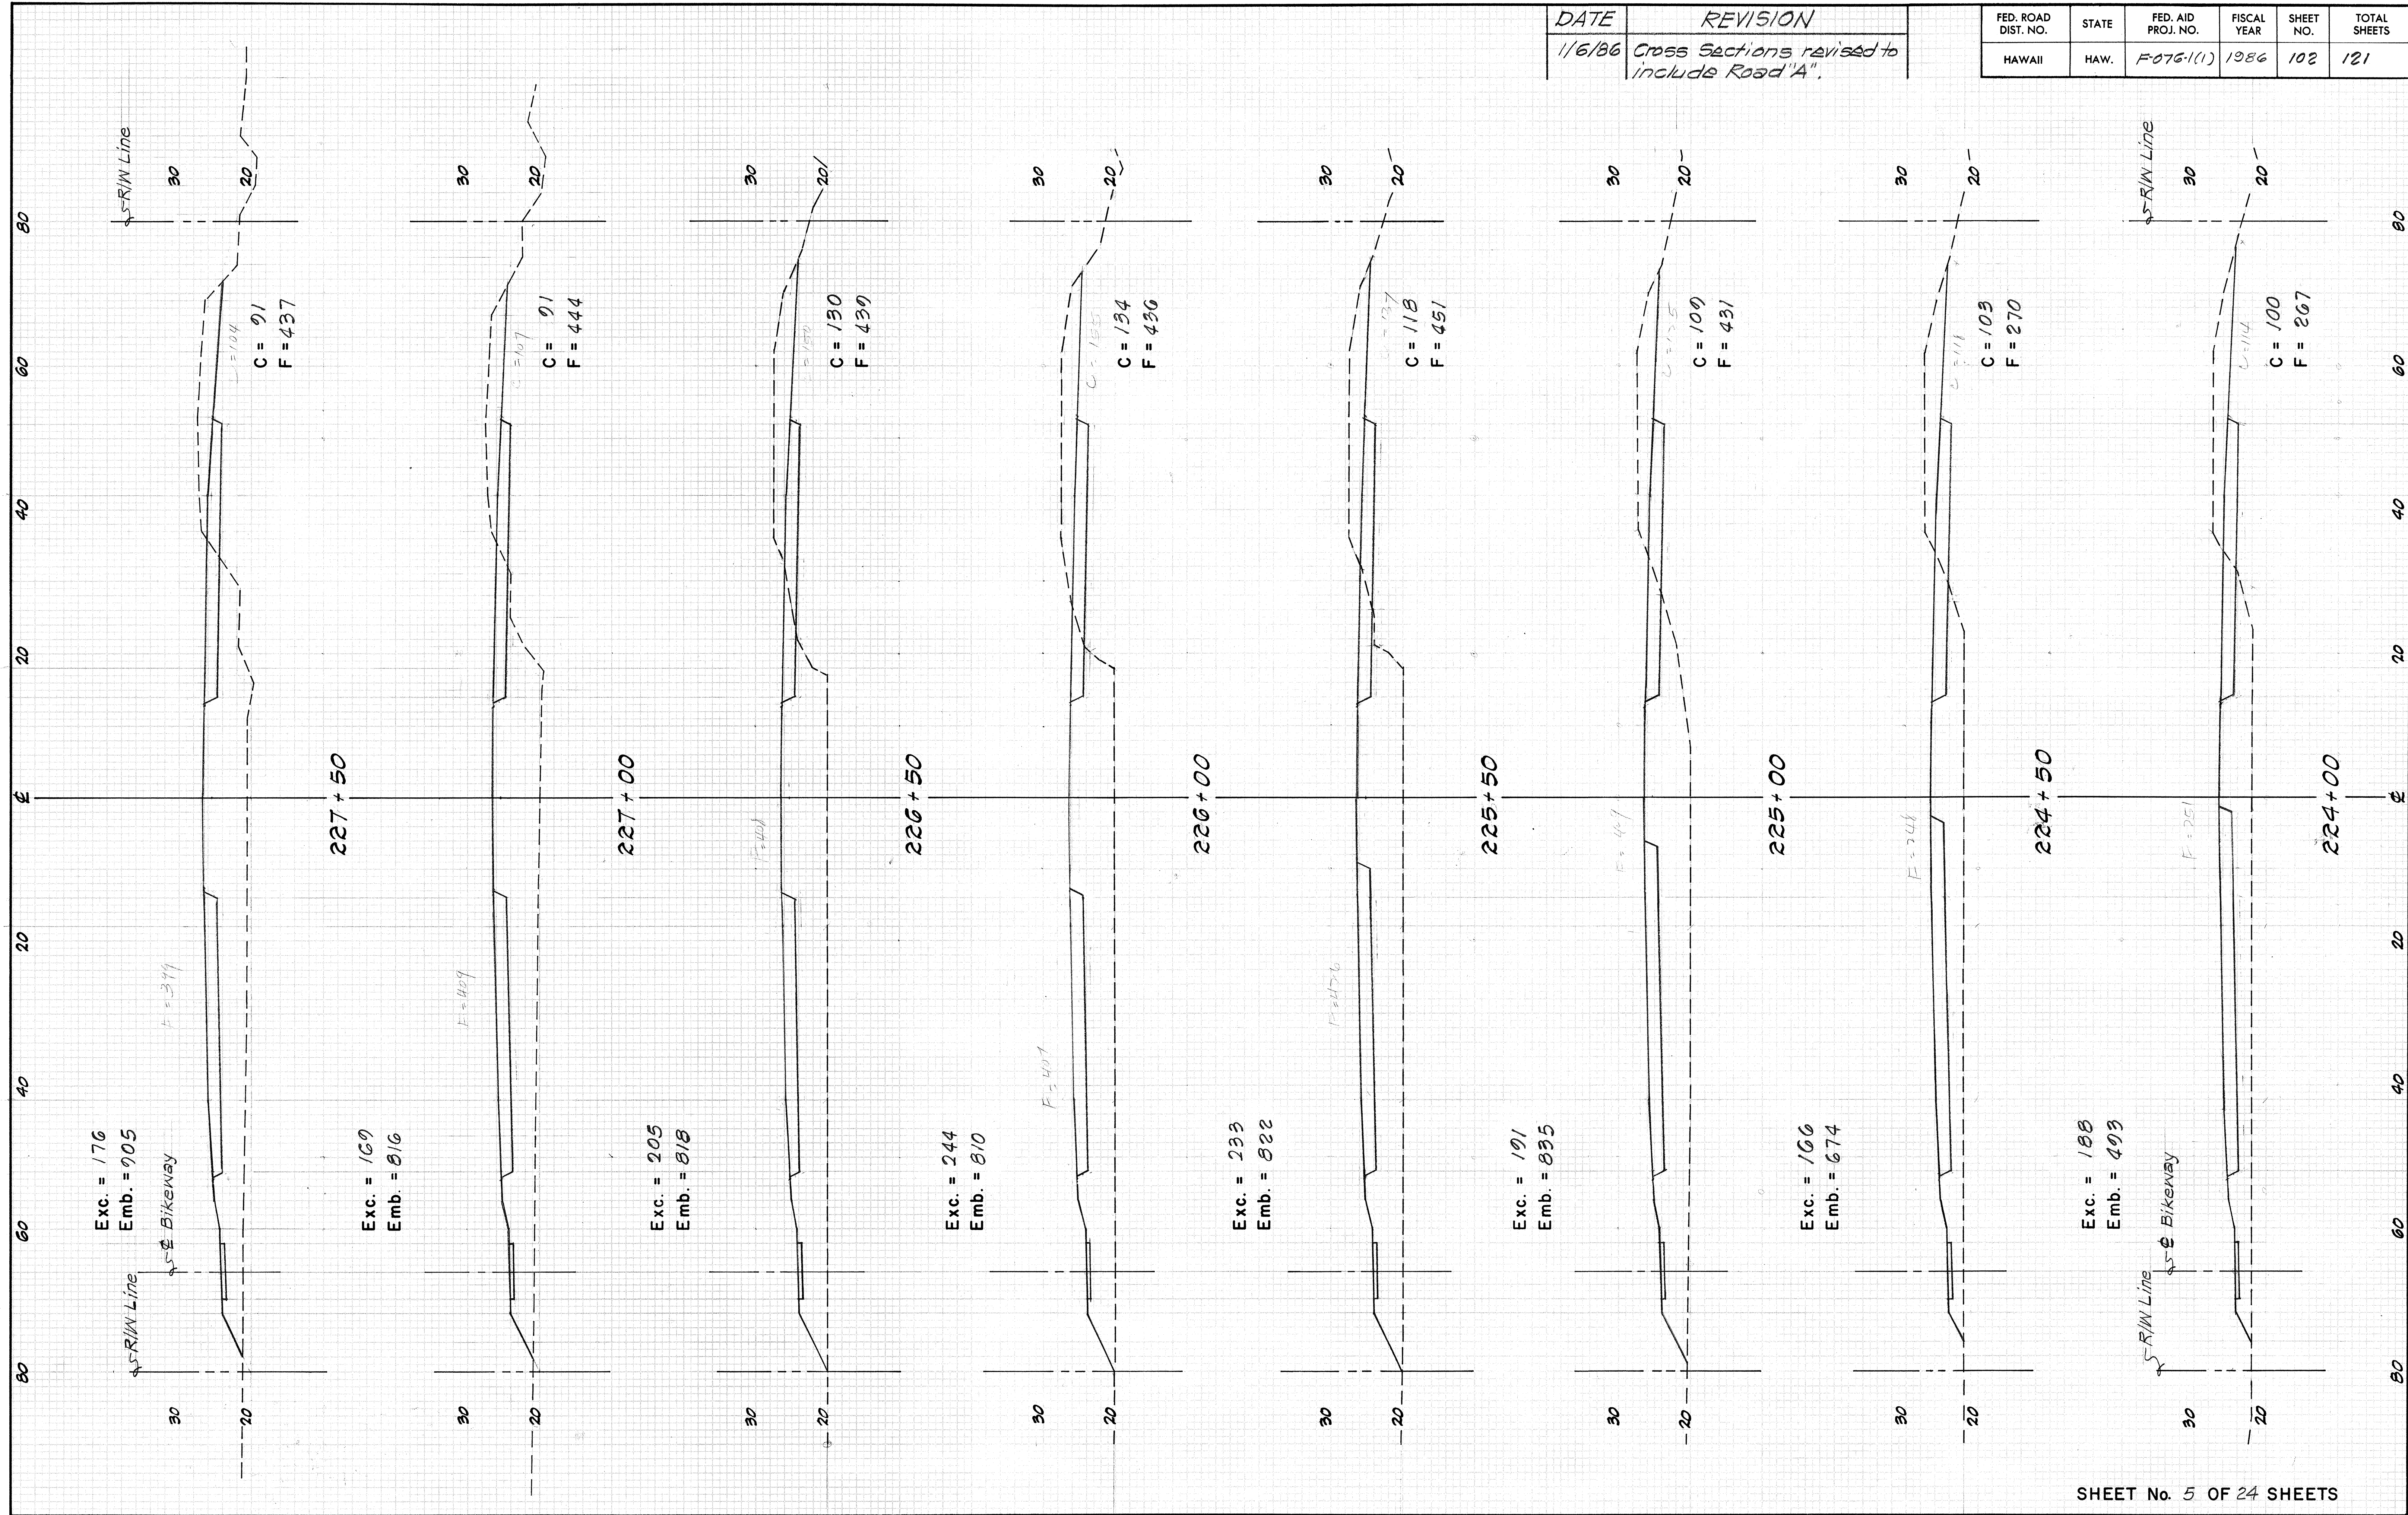


DATE	REVISION
11/6/86	Cross Sections revised to include Road 'A'.

FED. ROAD DIST. NO.	STATE	FED. AID PROJ. NO.	FISCAL YEAR	SHEET NO.	TOTAL SHEETS
HAWAII	HAW.	F-076-1(1)	1986	102	121

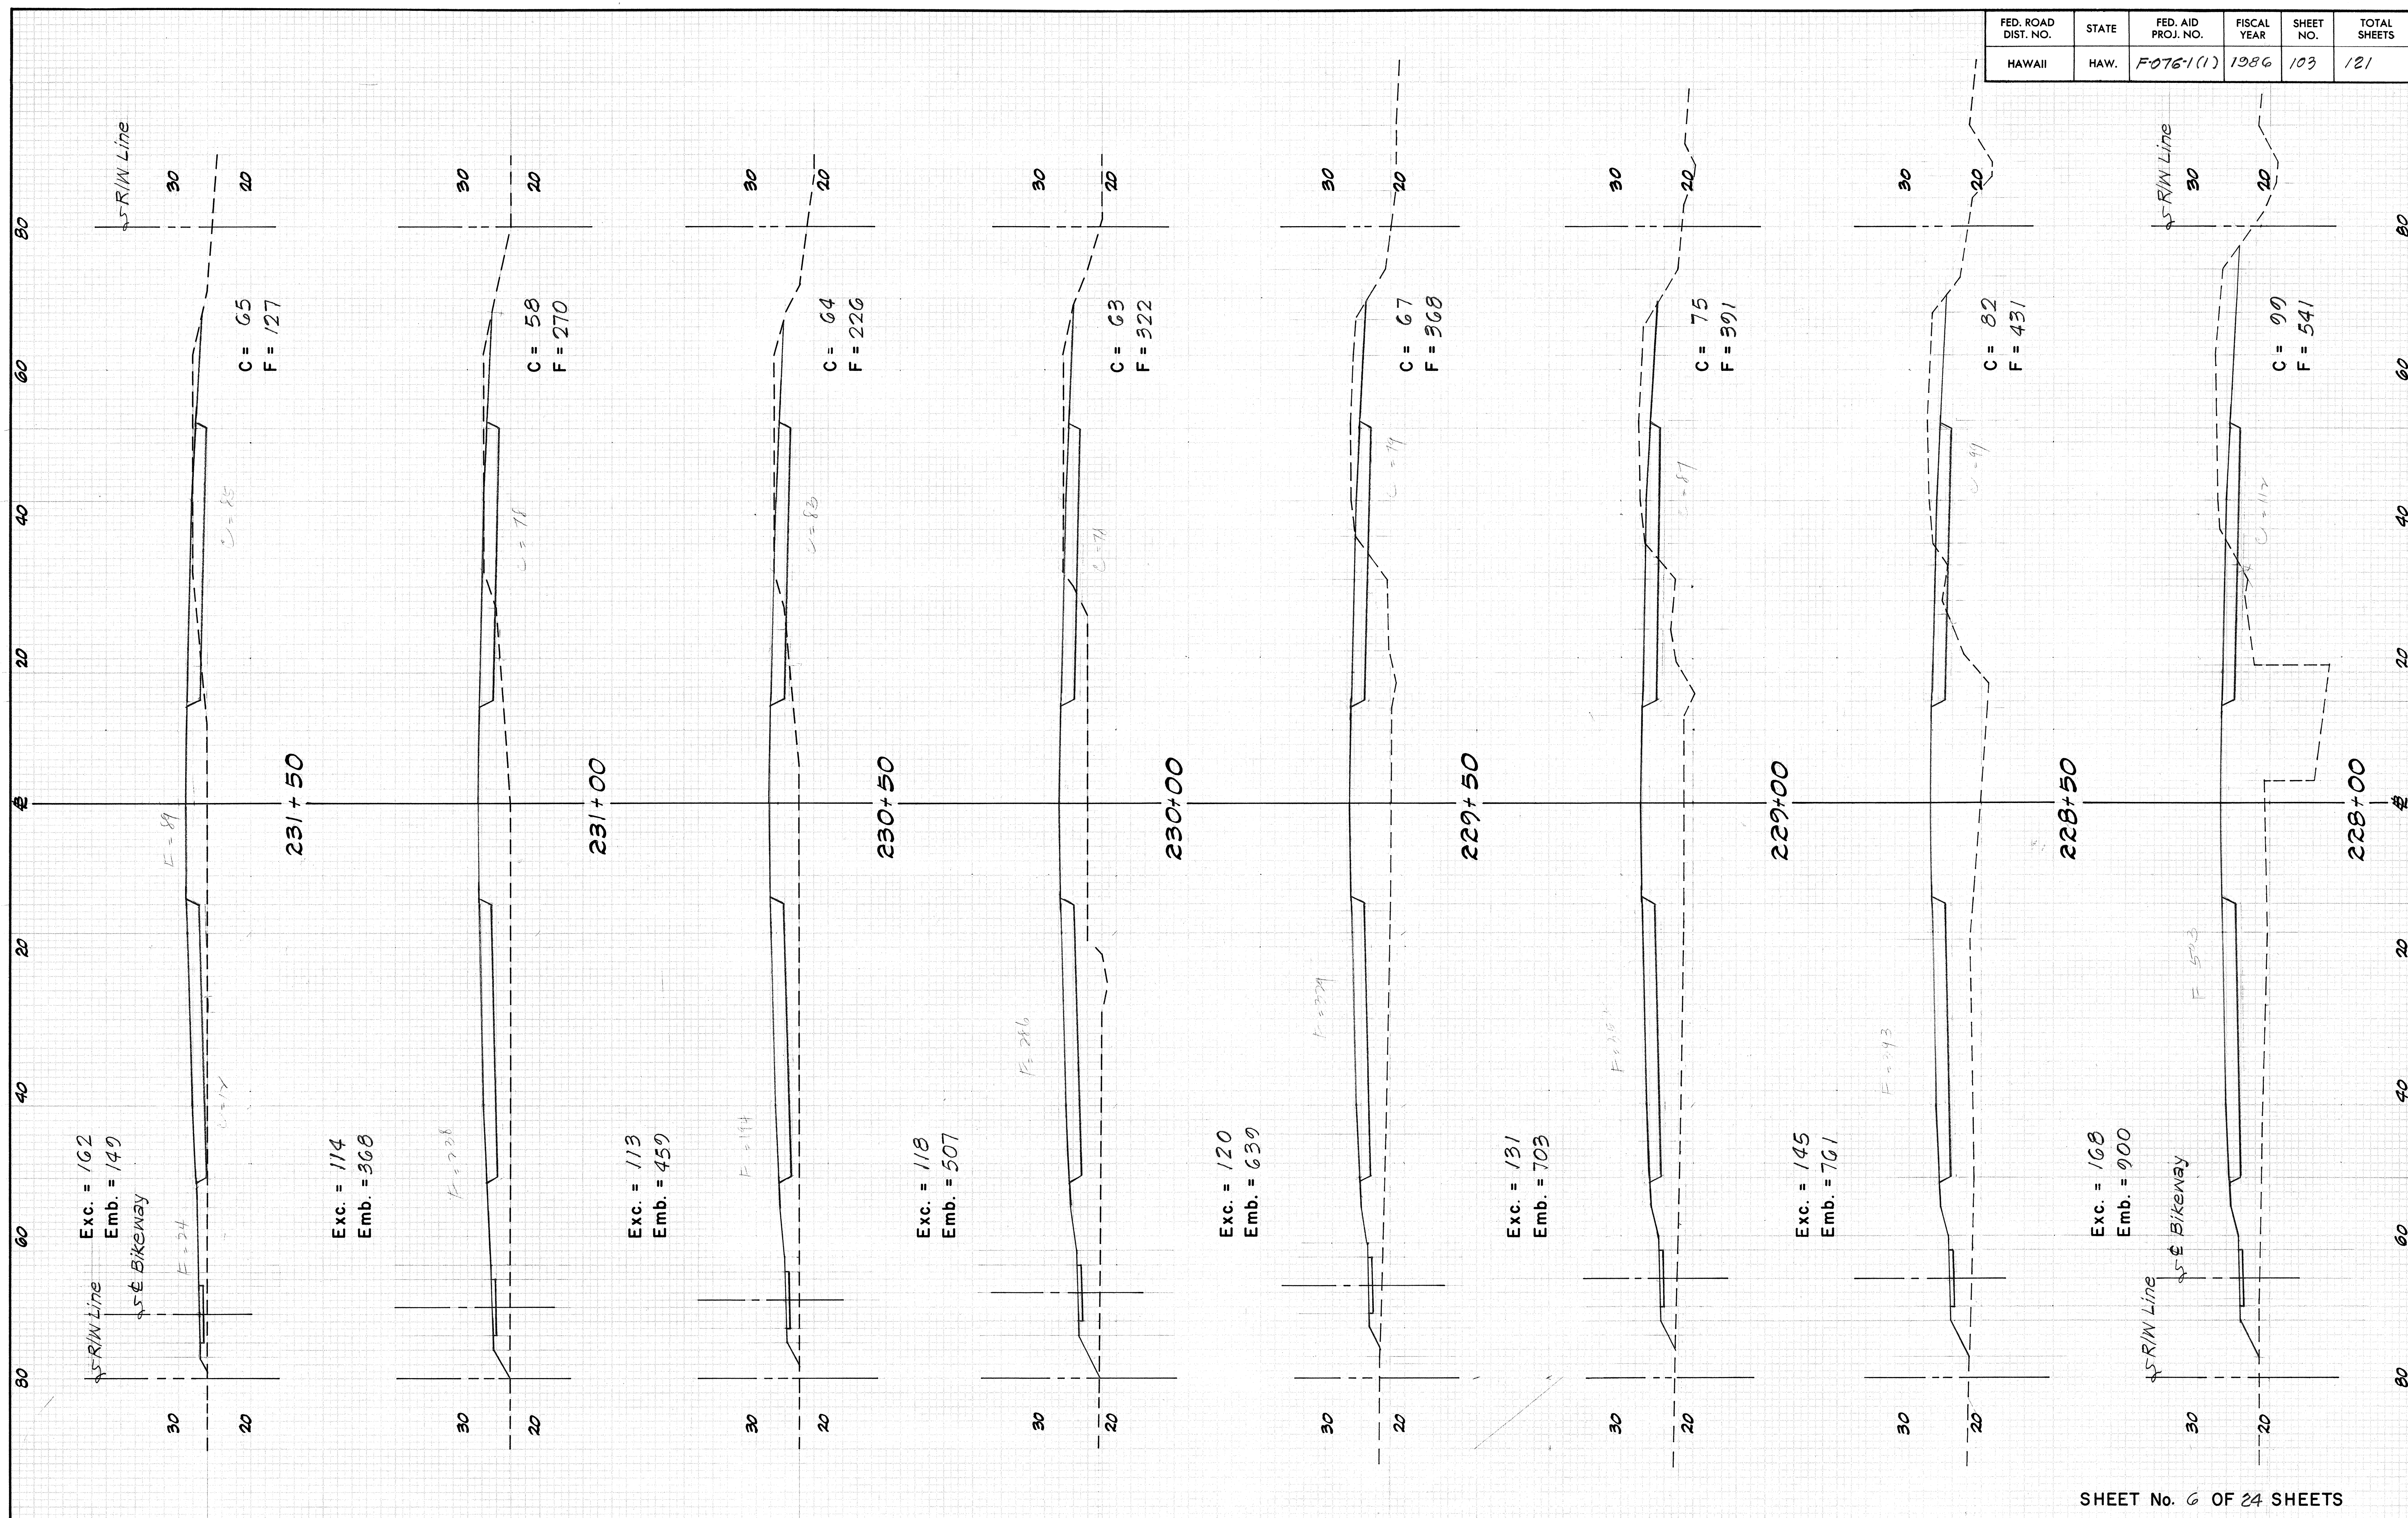

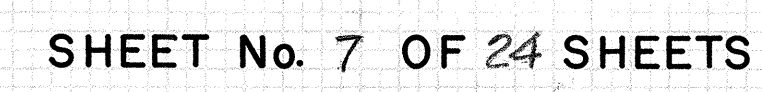


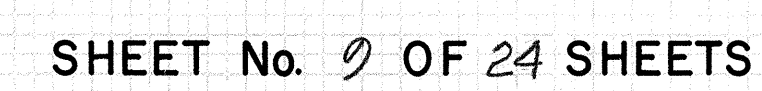

FINAL SURVEY NOTE BOOK NO.	SUPPLIED PLOTTED TEMPLATE AREA DATE	BY	DATE


ORIGINAL SURVEY NOTE BOOK NO.	SUPPLIED PLOTTED TEMPLATE AREA DATE	BY	DATE

FED. ROAD DIST. NO.	STATE	FED. AID PROJ. NO.	FISCAL YEAR	SHEET NO.	TOTAL SHEETS
HAWAII	HAW.	F-076-1(1)	1986	107	121

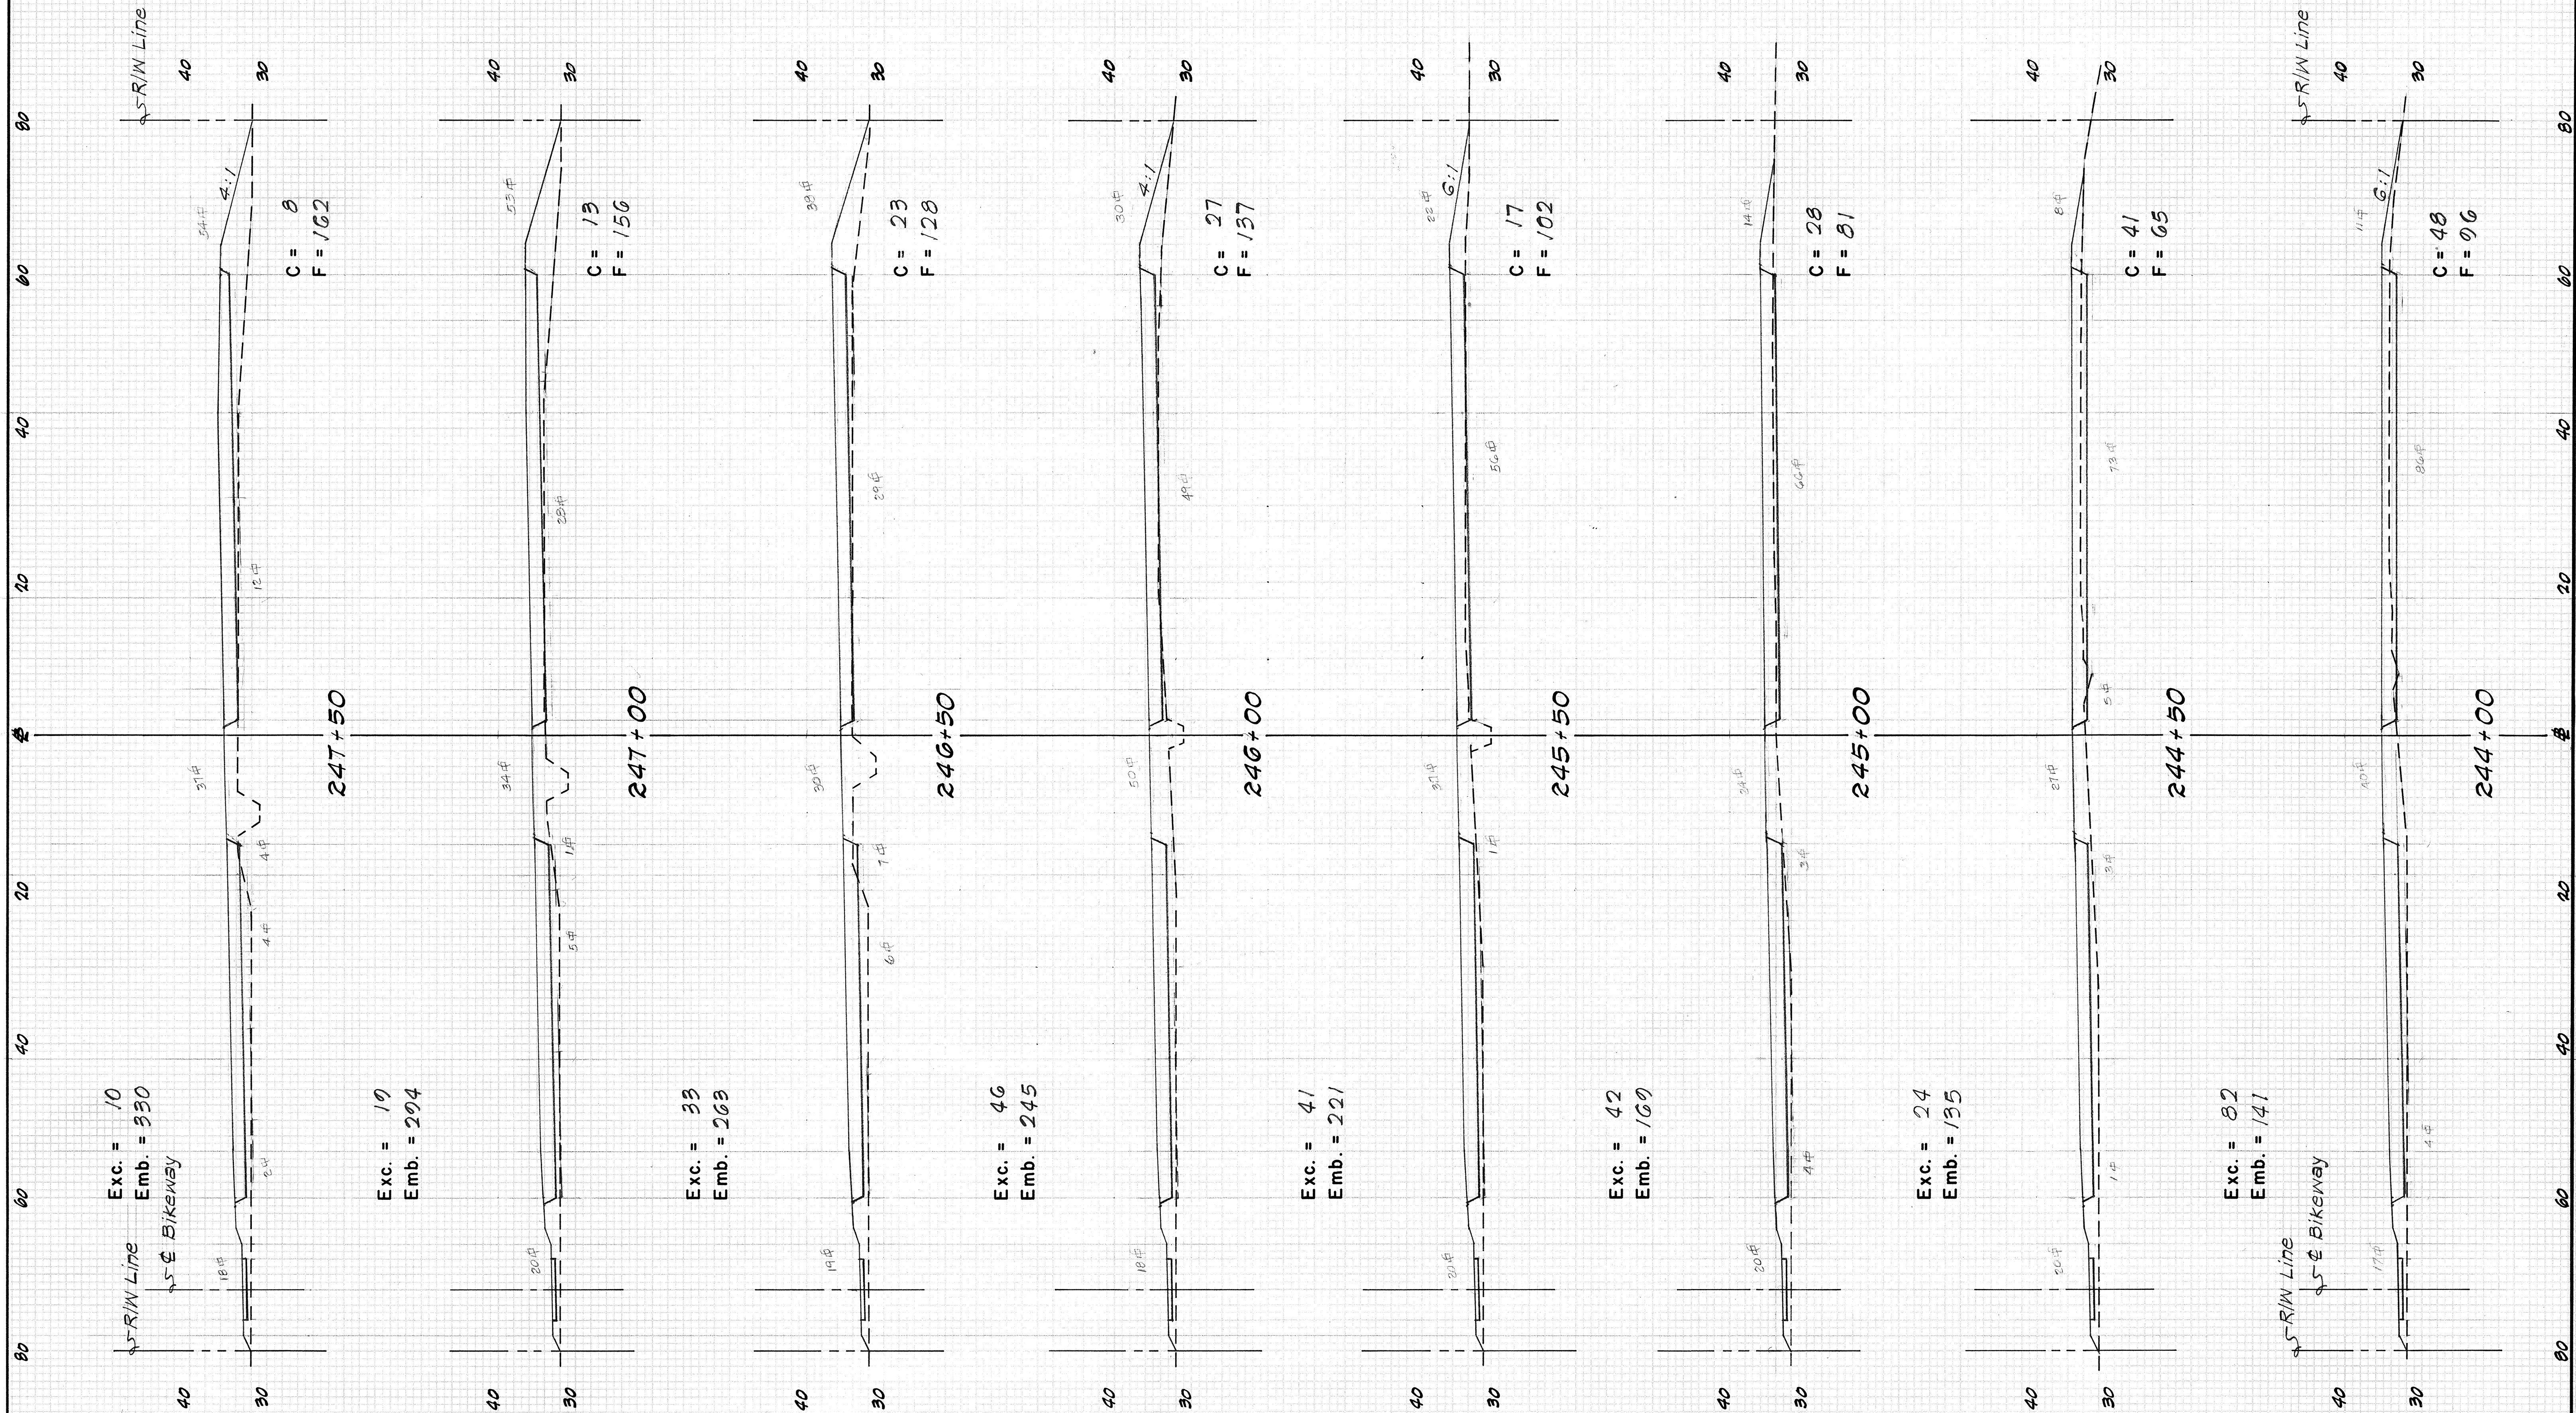

NO.	FINAL SURVEY	SURVEYED	BY	DATE
	PLOTTED			
	NOTE BOOK			
	AREAS			
	CHECKED			


NO.	ORIGINAL SURVEY	SURVEYED	BY	DATE
	PLOTTED			
	NOTE BOOK			
	AREAS			
	CHECKED			

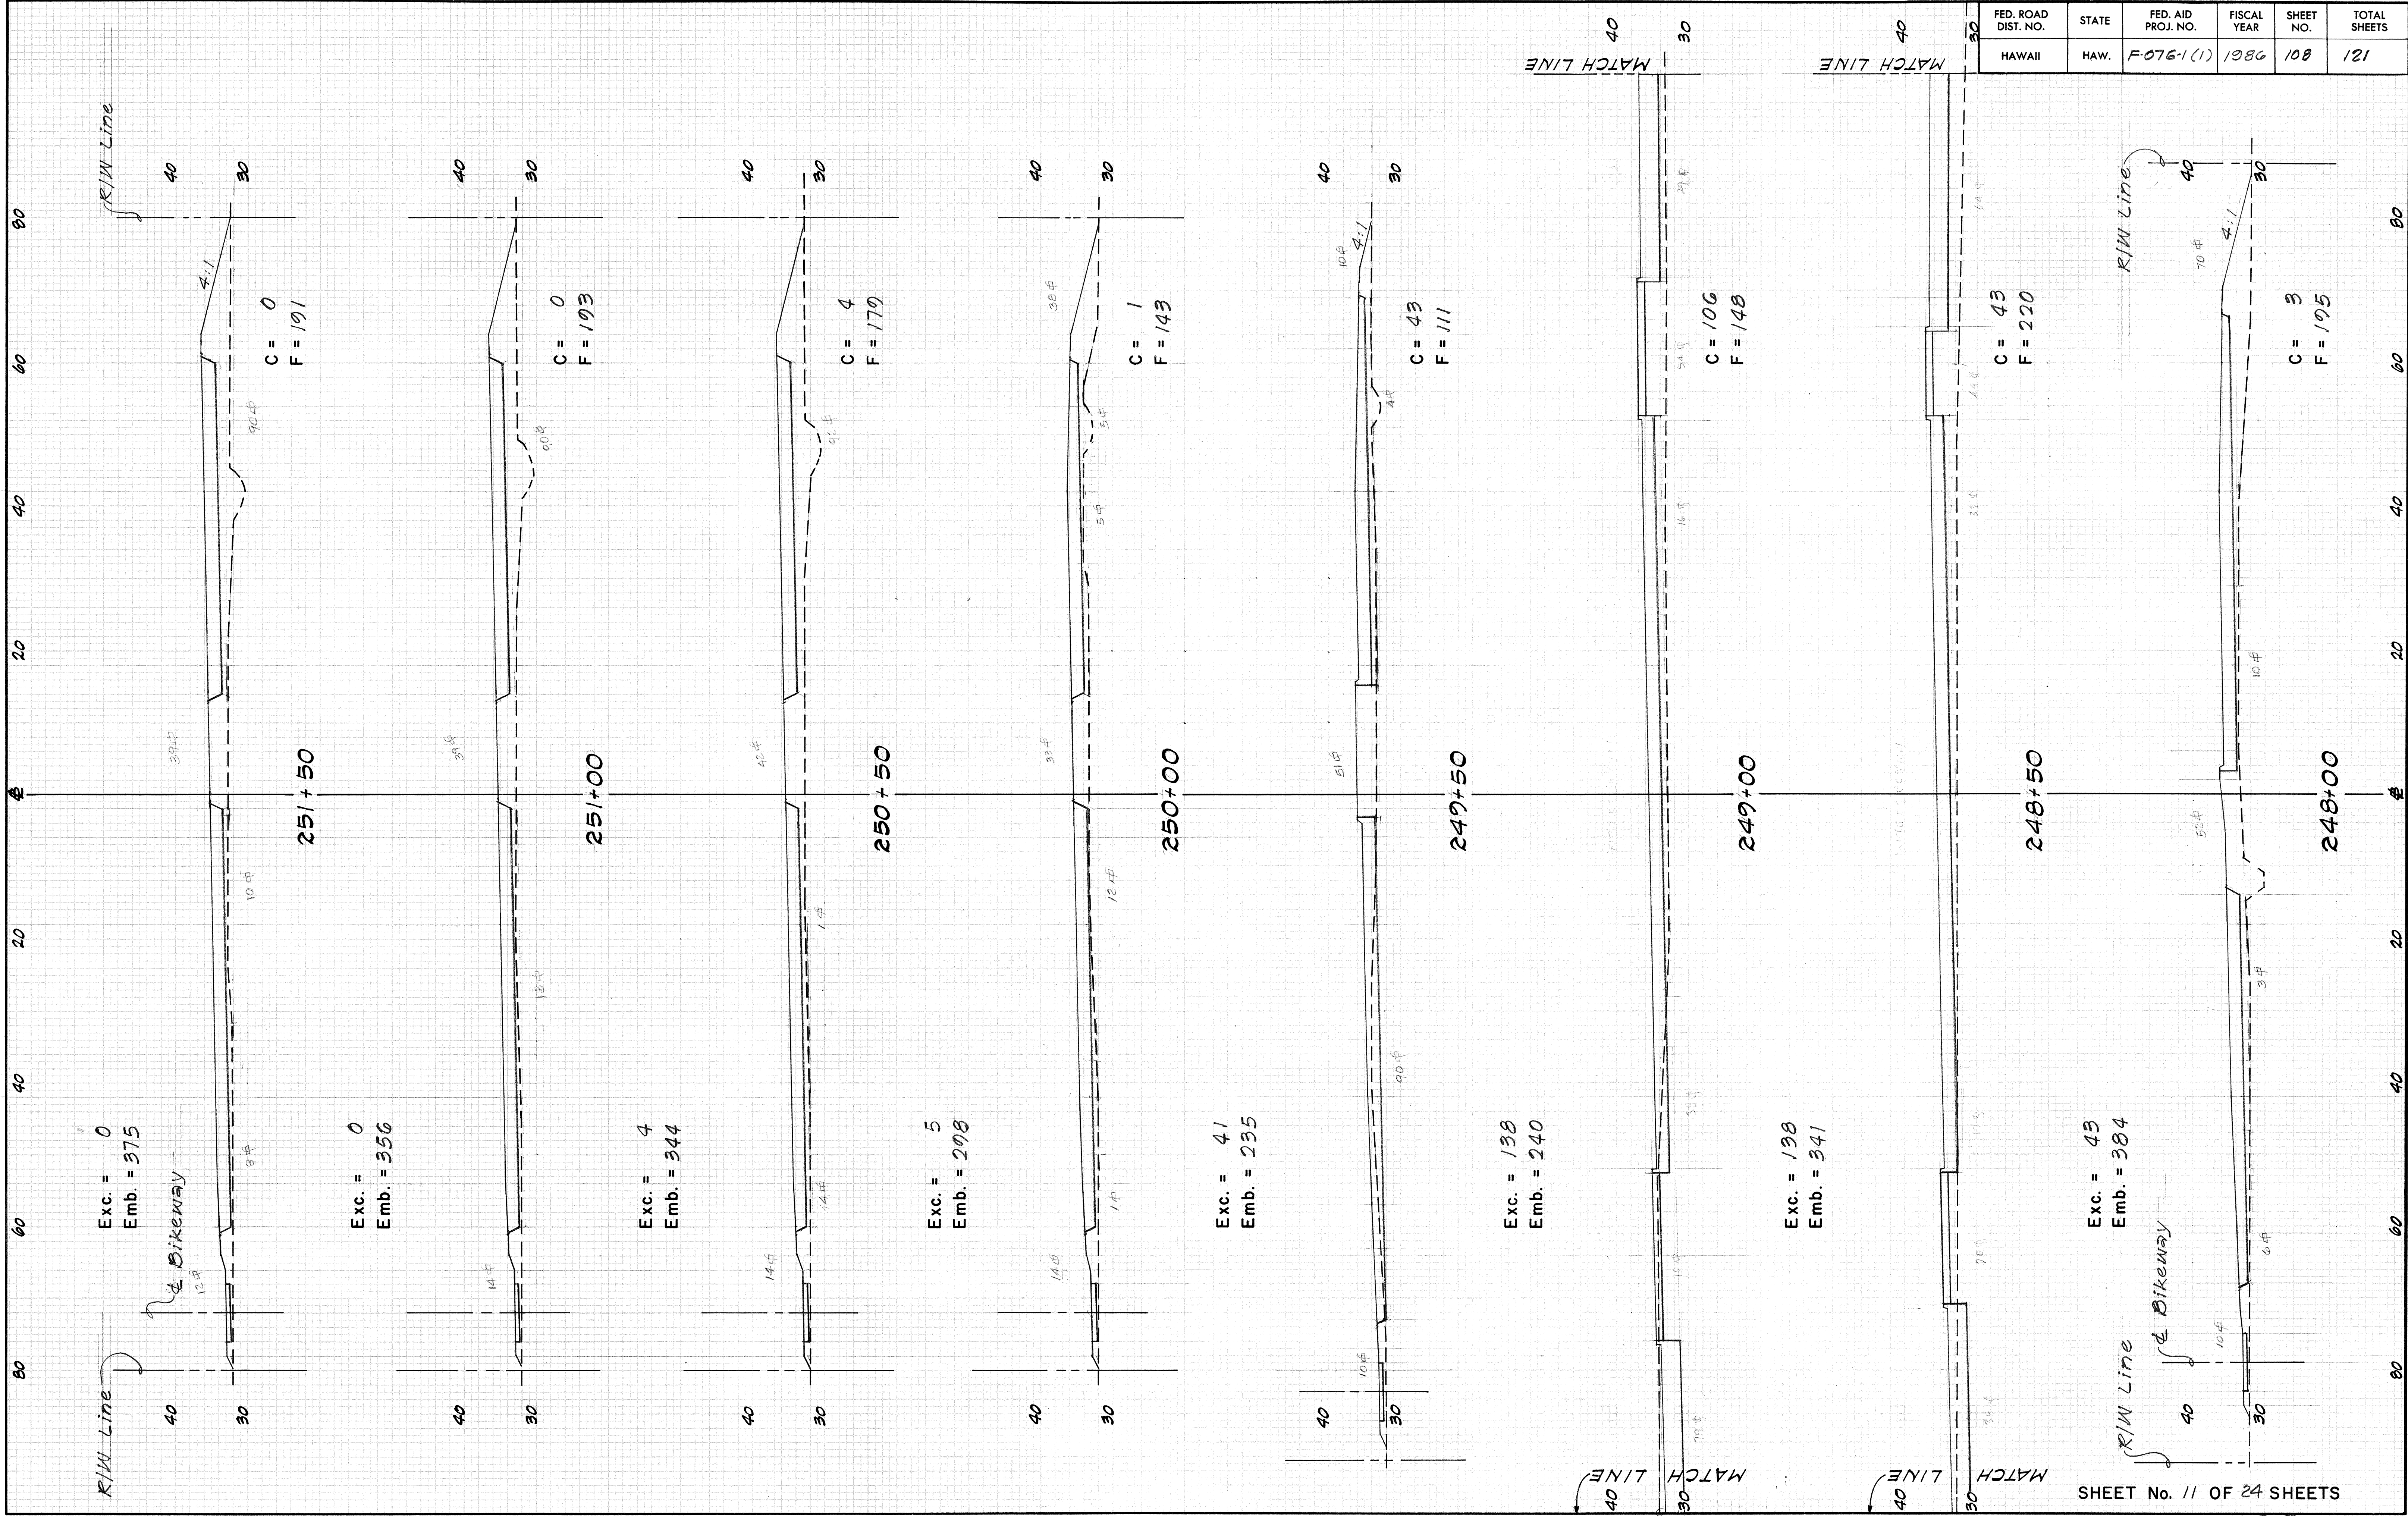

SHEET No. 11 OF 24 SHEETS


FED. ROAD DIST. NO.	STATE	FED. AID PROJ. NO.	FISCAL YEAR	SHEET NO.	TOTAL SHEETS
HAWAII	HAW.	F-076-1(1)	1986	108	121

FED. ROAD DIST. NO.	STATE	FED. AID PROJ. NO.	FISCAL YEAR	SHEET NO.	TOTAL SHEETS
HAWAII	HAW.	F-076-1(1)	1986	109	121

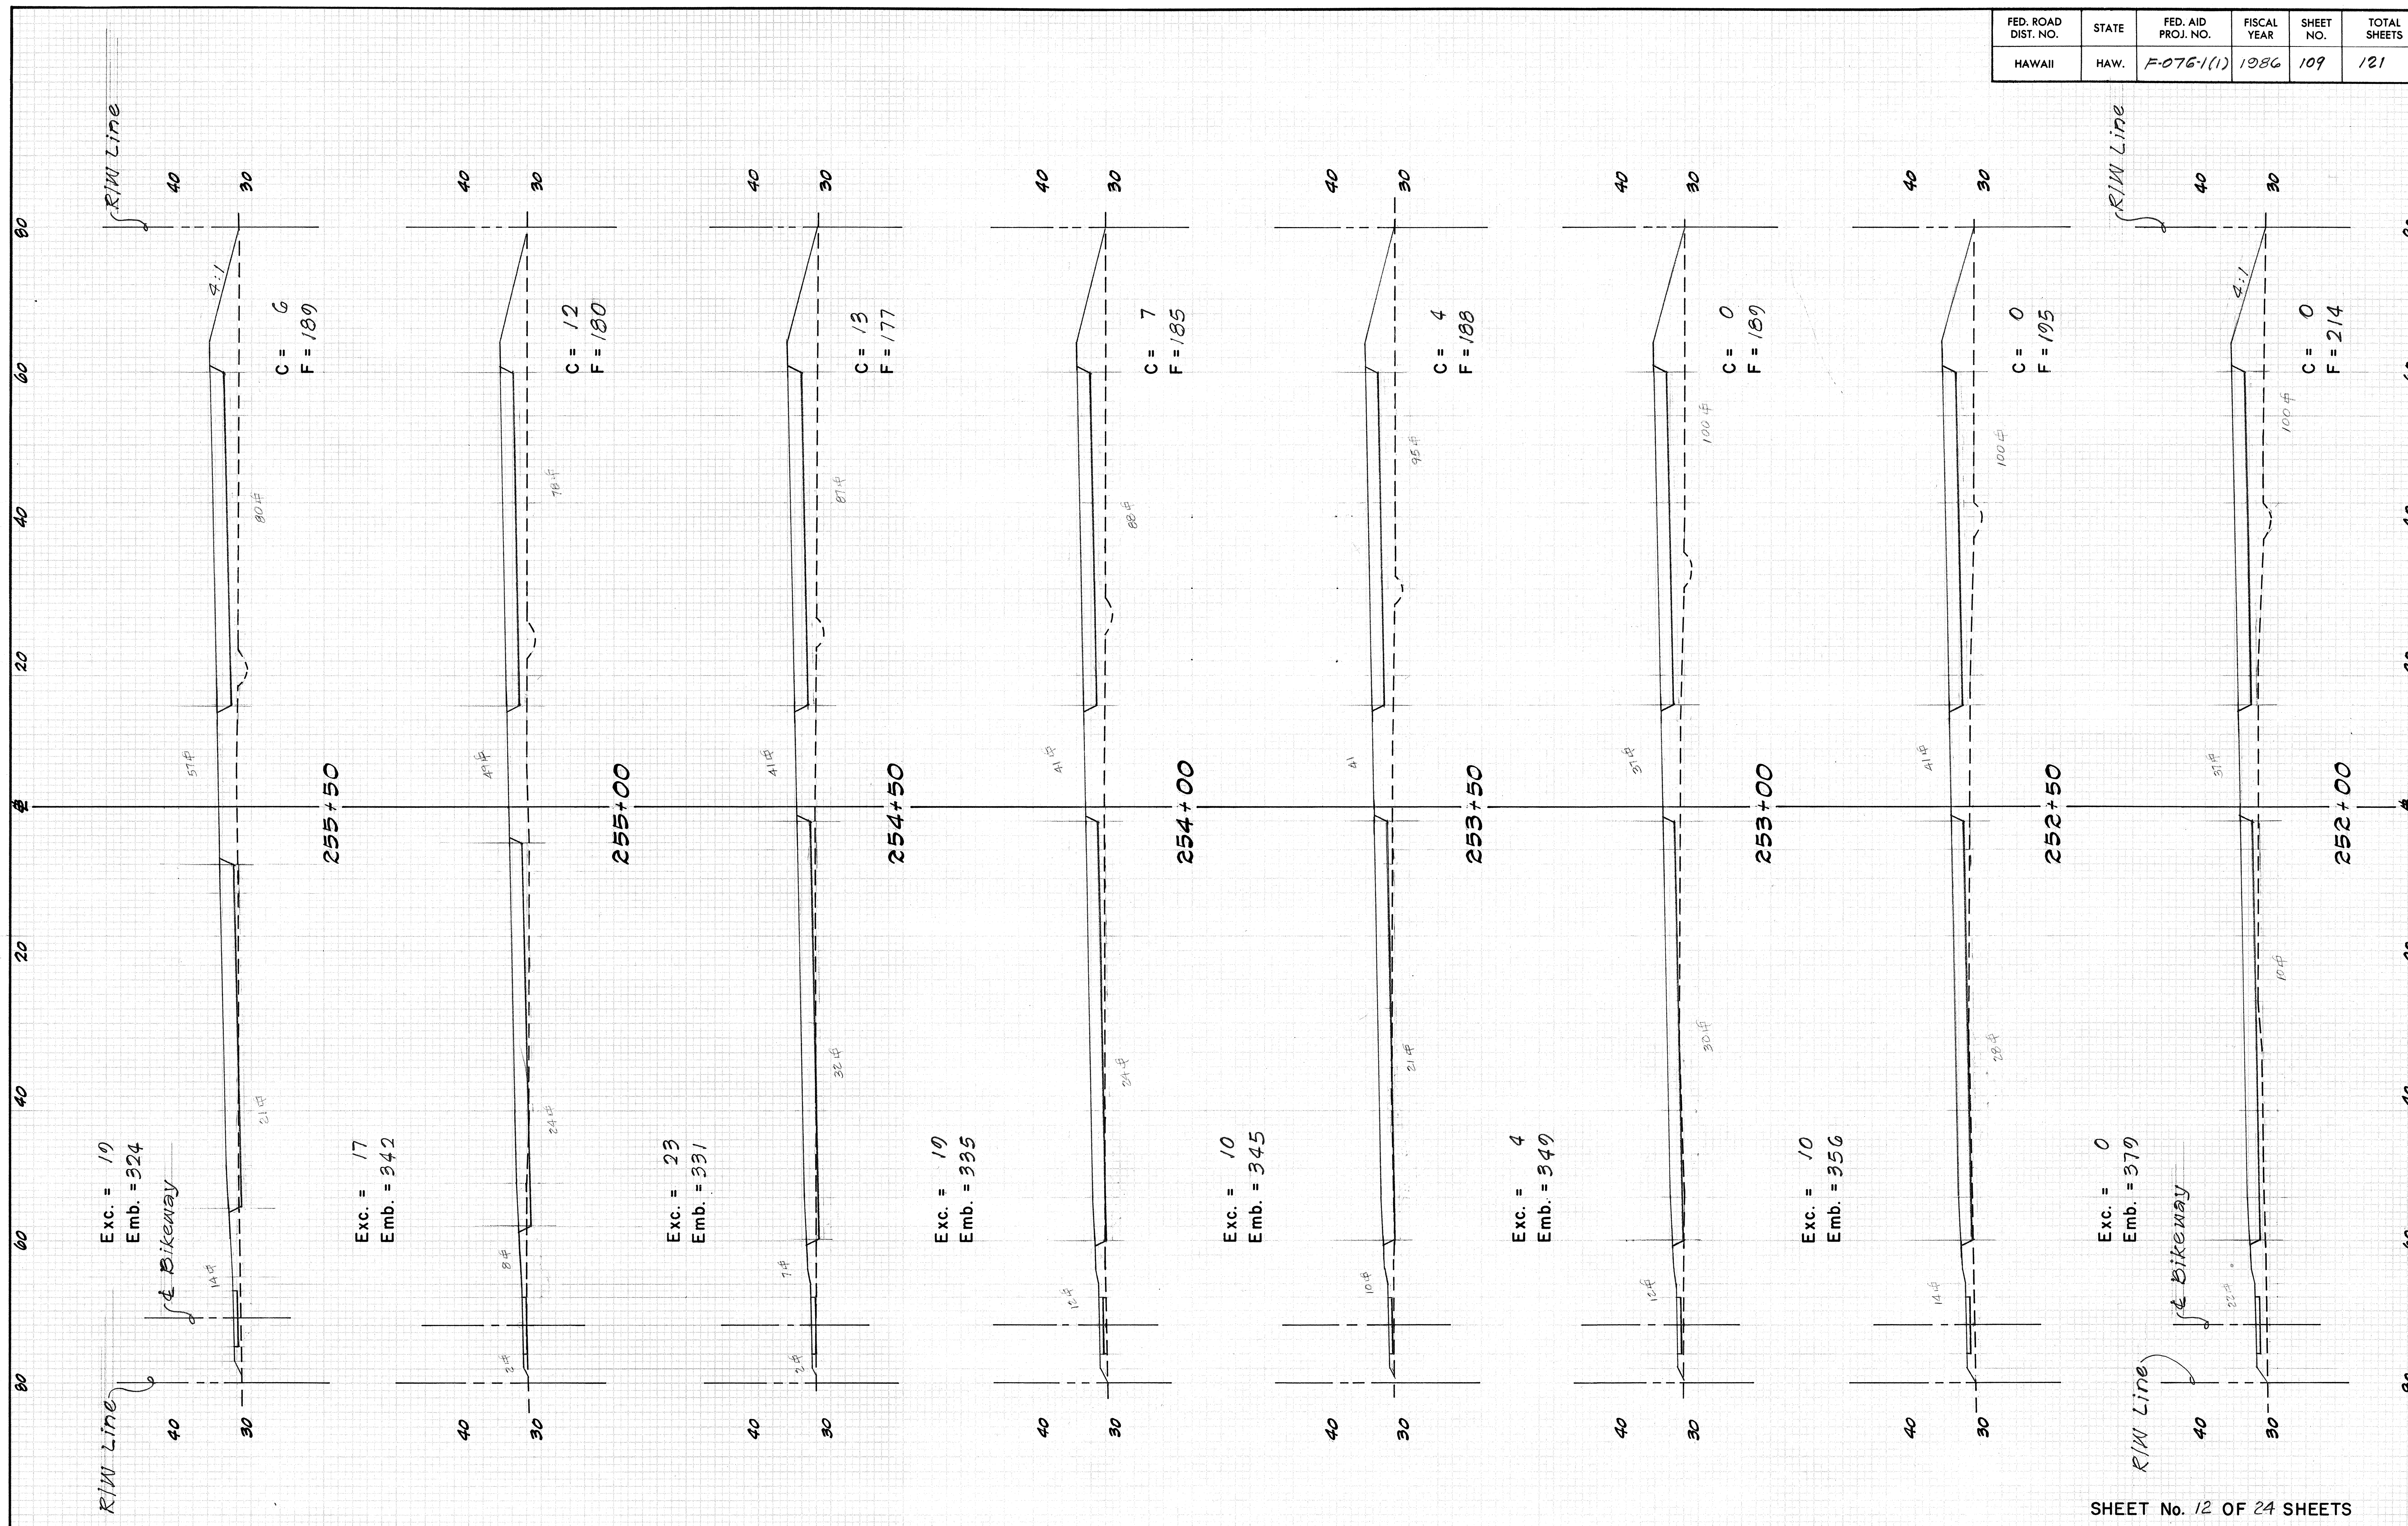


ORIGINAL SURVEY	DATE
NO.	

FINAL SURVEY	DATE
NO.	

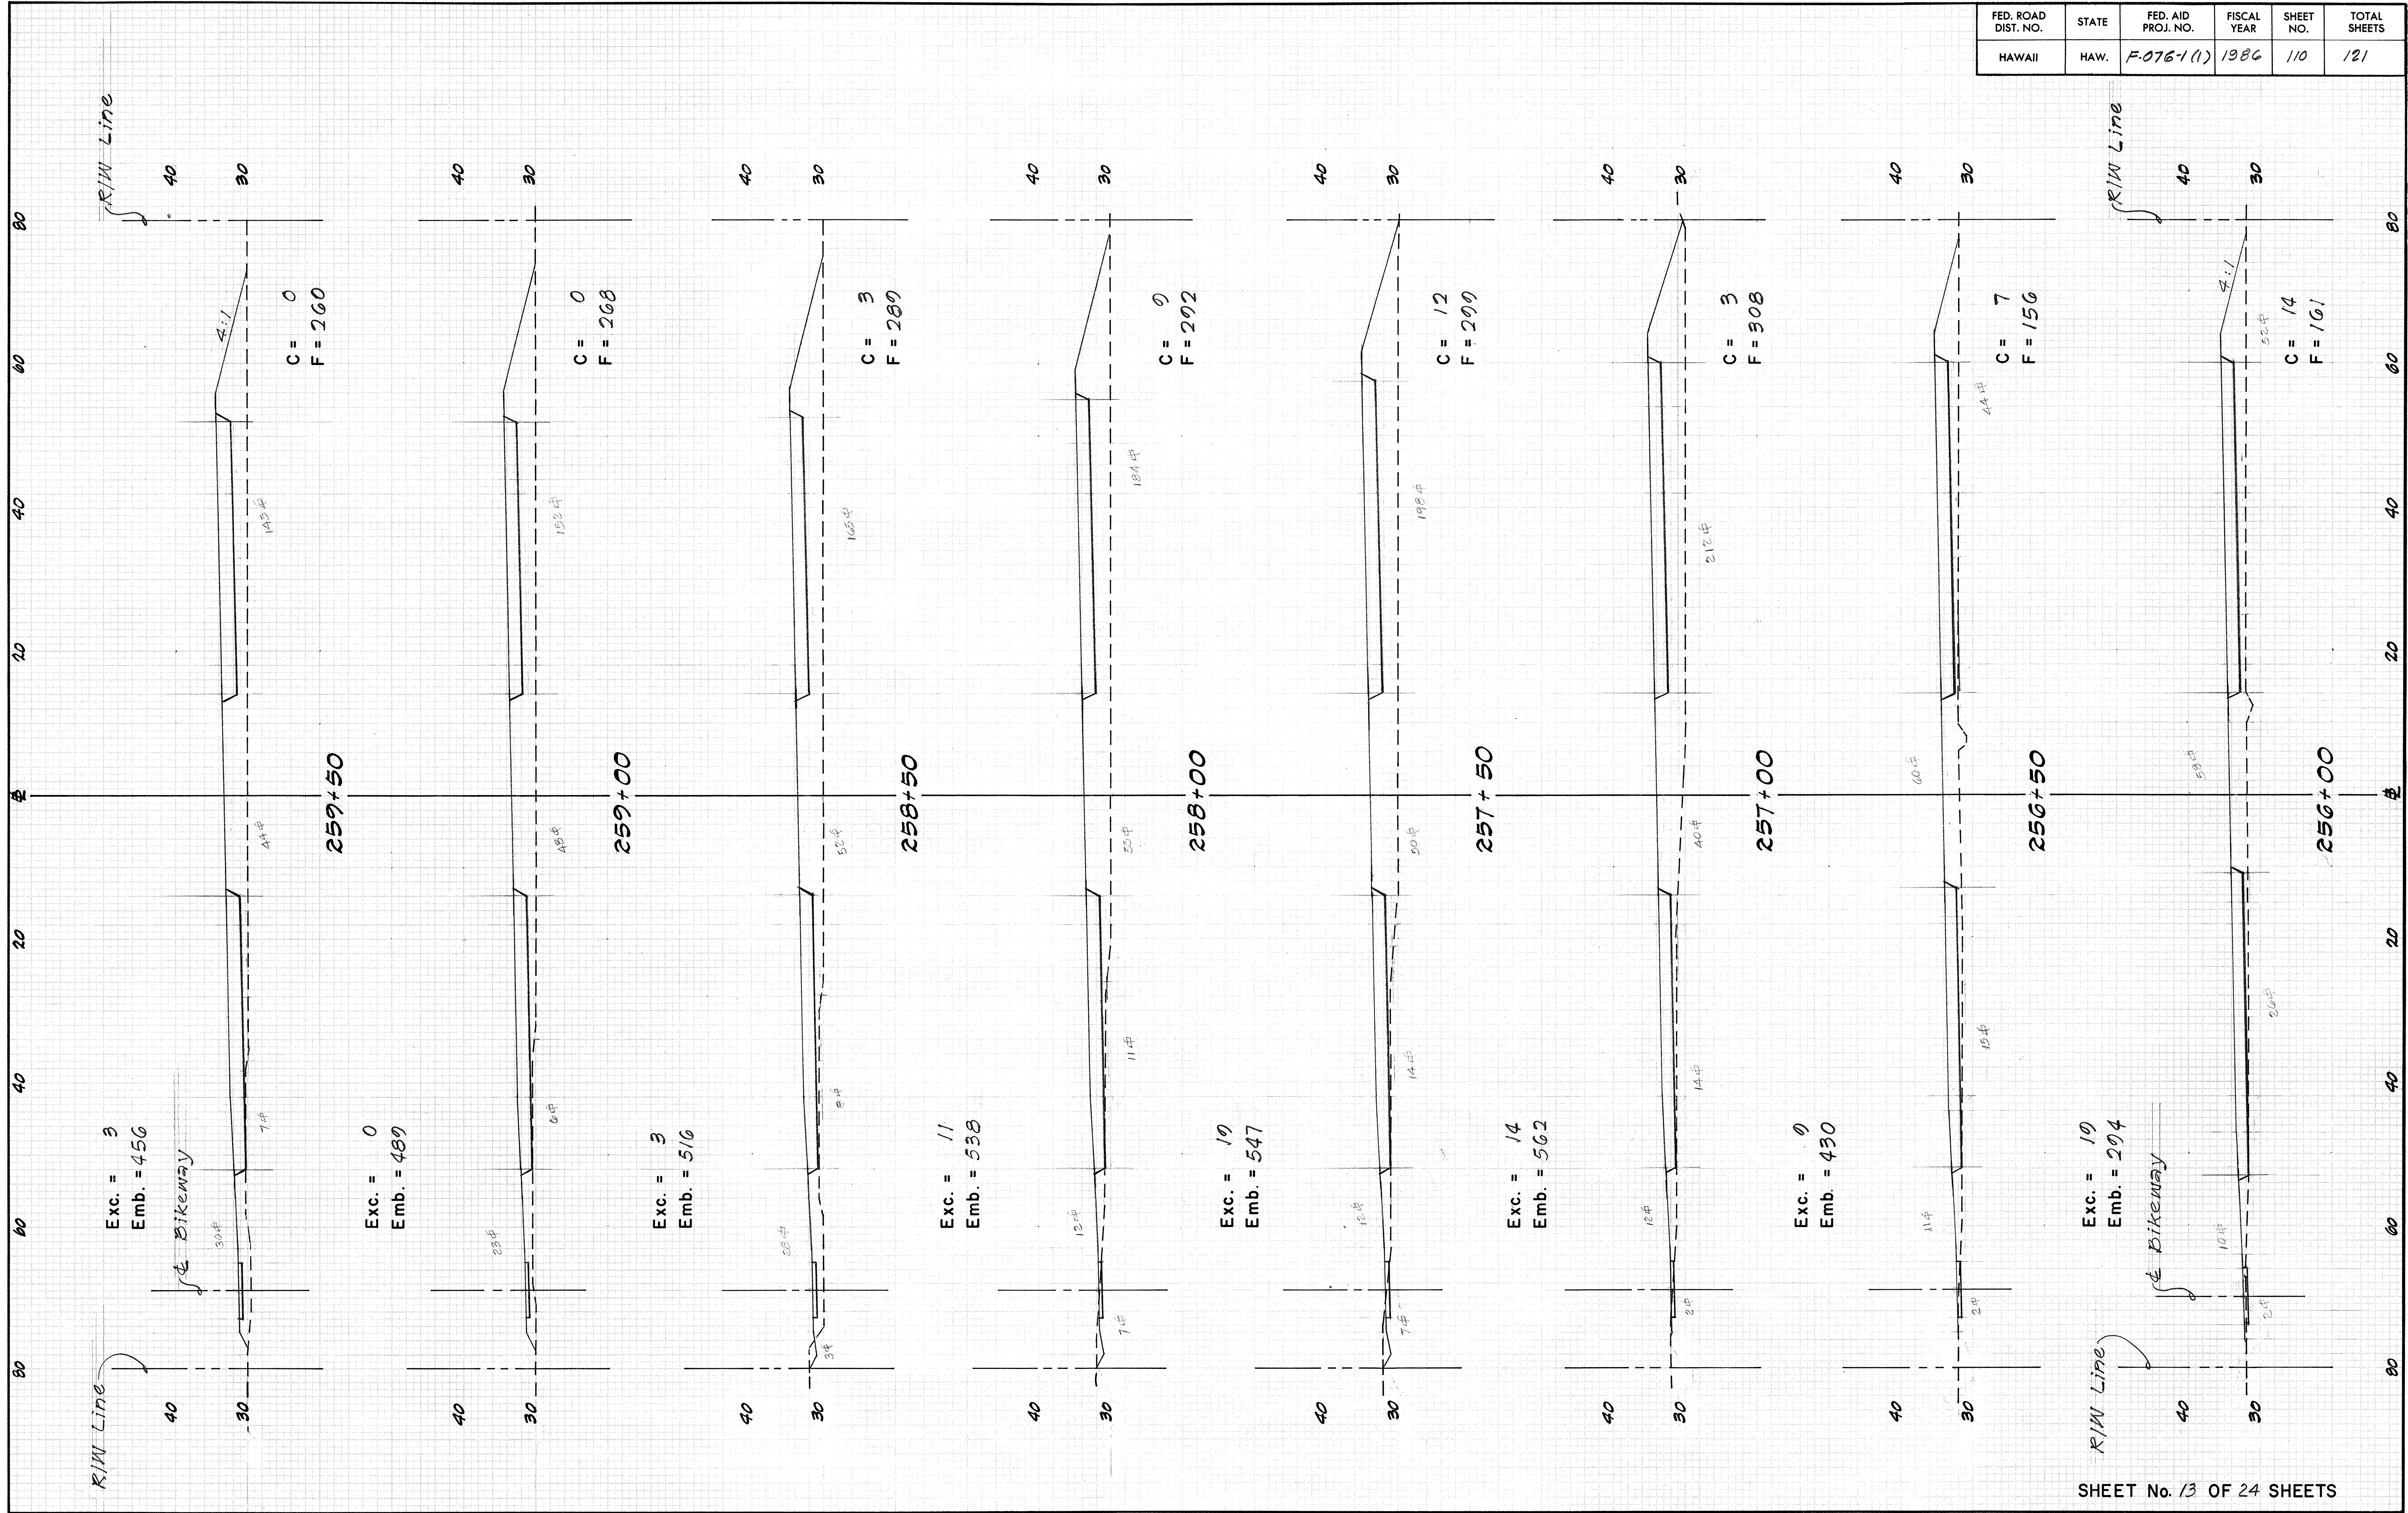

FED. ROAD DIST. NO.	STATE	FED. AID PROJ. NO.	FISCAL YEAR	SHEET NO.	TOTAL SHEETS
HAWAII	HAW.	F-076-1(1)	1986	110	121


FED. ROAD DIST. NO.	STATE	FED. AID PROJ. NO.	FISCAL YEAR	SHEET NO.	TOTAL SHEETS
HAWAII	HAW.	F-076-1(1)	1986	111	121

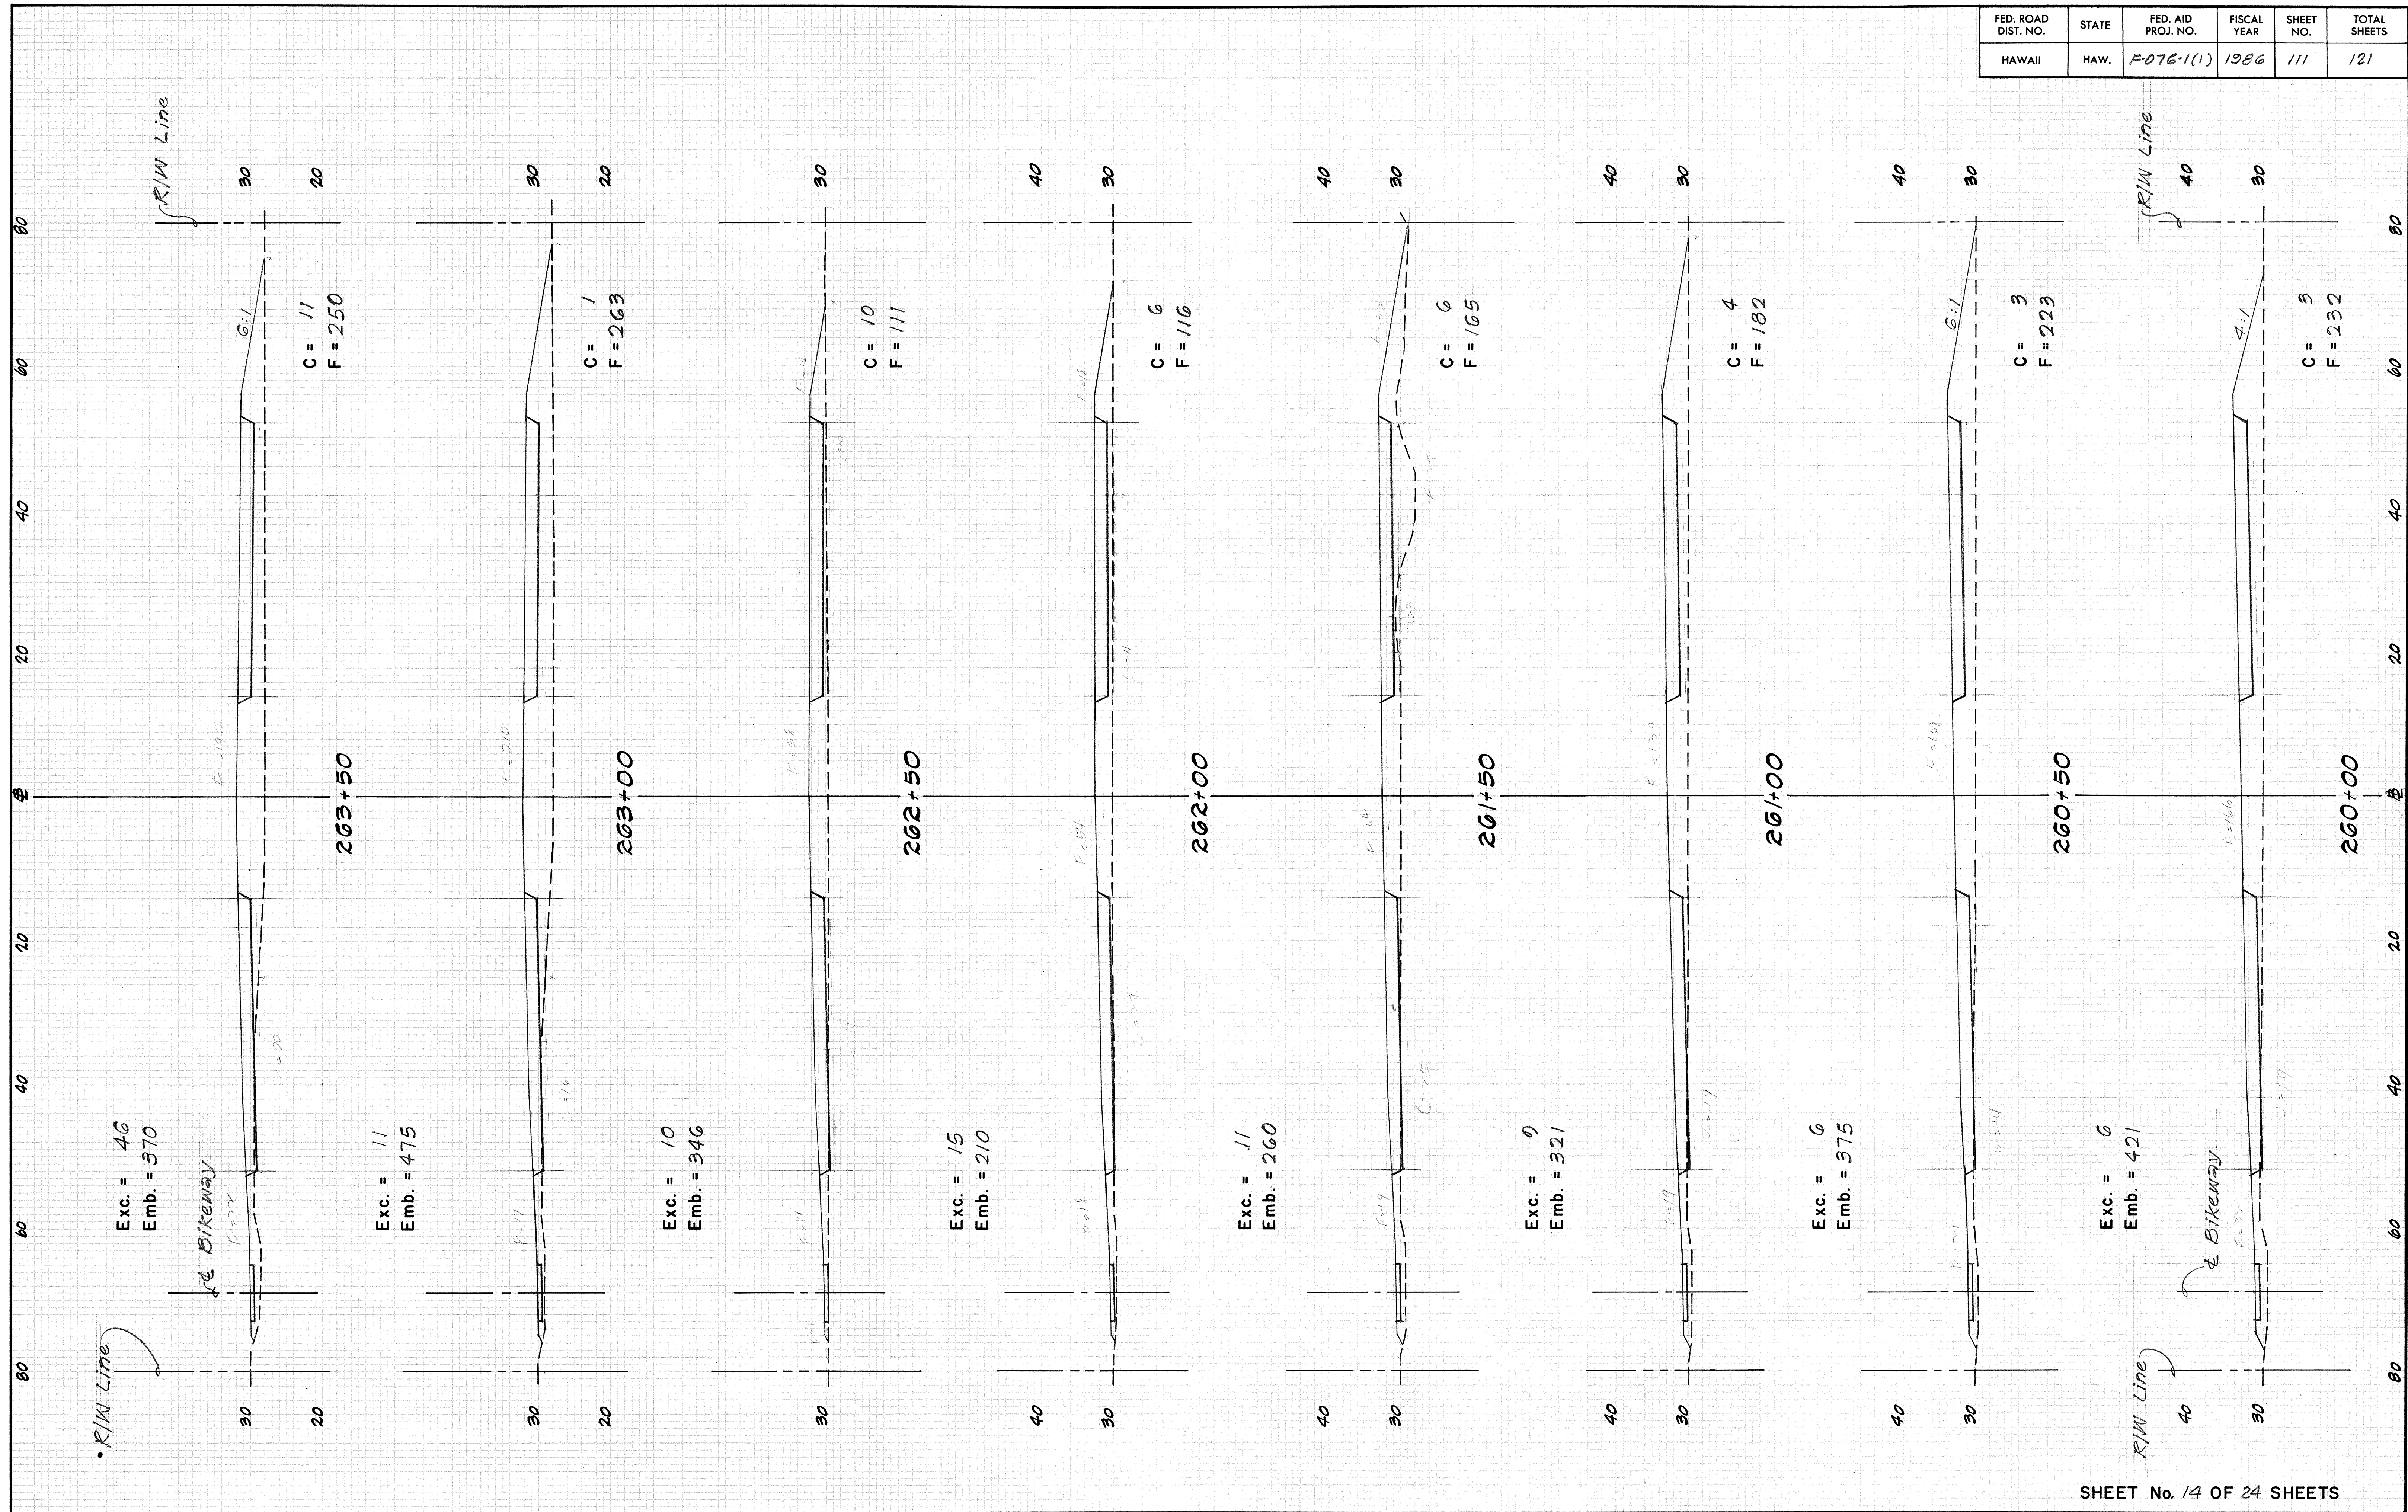

ORIGINAL	SURVEY	BY	DATE
SURVEYED	PLOTTED		
NOTE BOOK	DATE		
NO.	AREAS CHECKED		


ORIGINAL	SURVEY	BY	DATE
SURVEYED	PLOTTED		
NOTE BOOK	DATE		
NO.	AREAS CHECKED		

FED. ROAD DIST. NO.	STATE	FED. AID PROJ. NO.	FISCAL YEAR	SHEET NO.	TOTAL SHEETS
HAWAII	HAW.	F-076-1(1)	1986	112	121

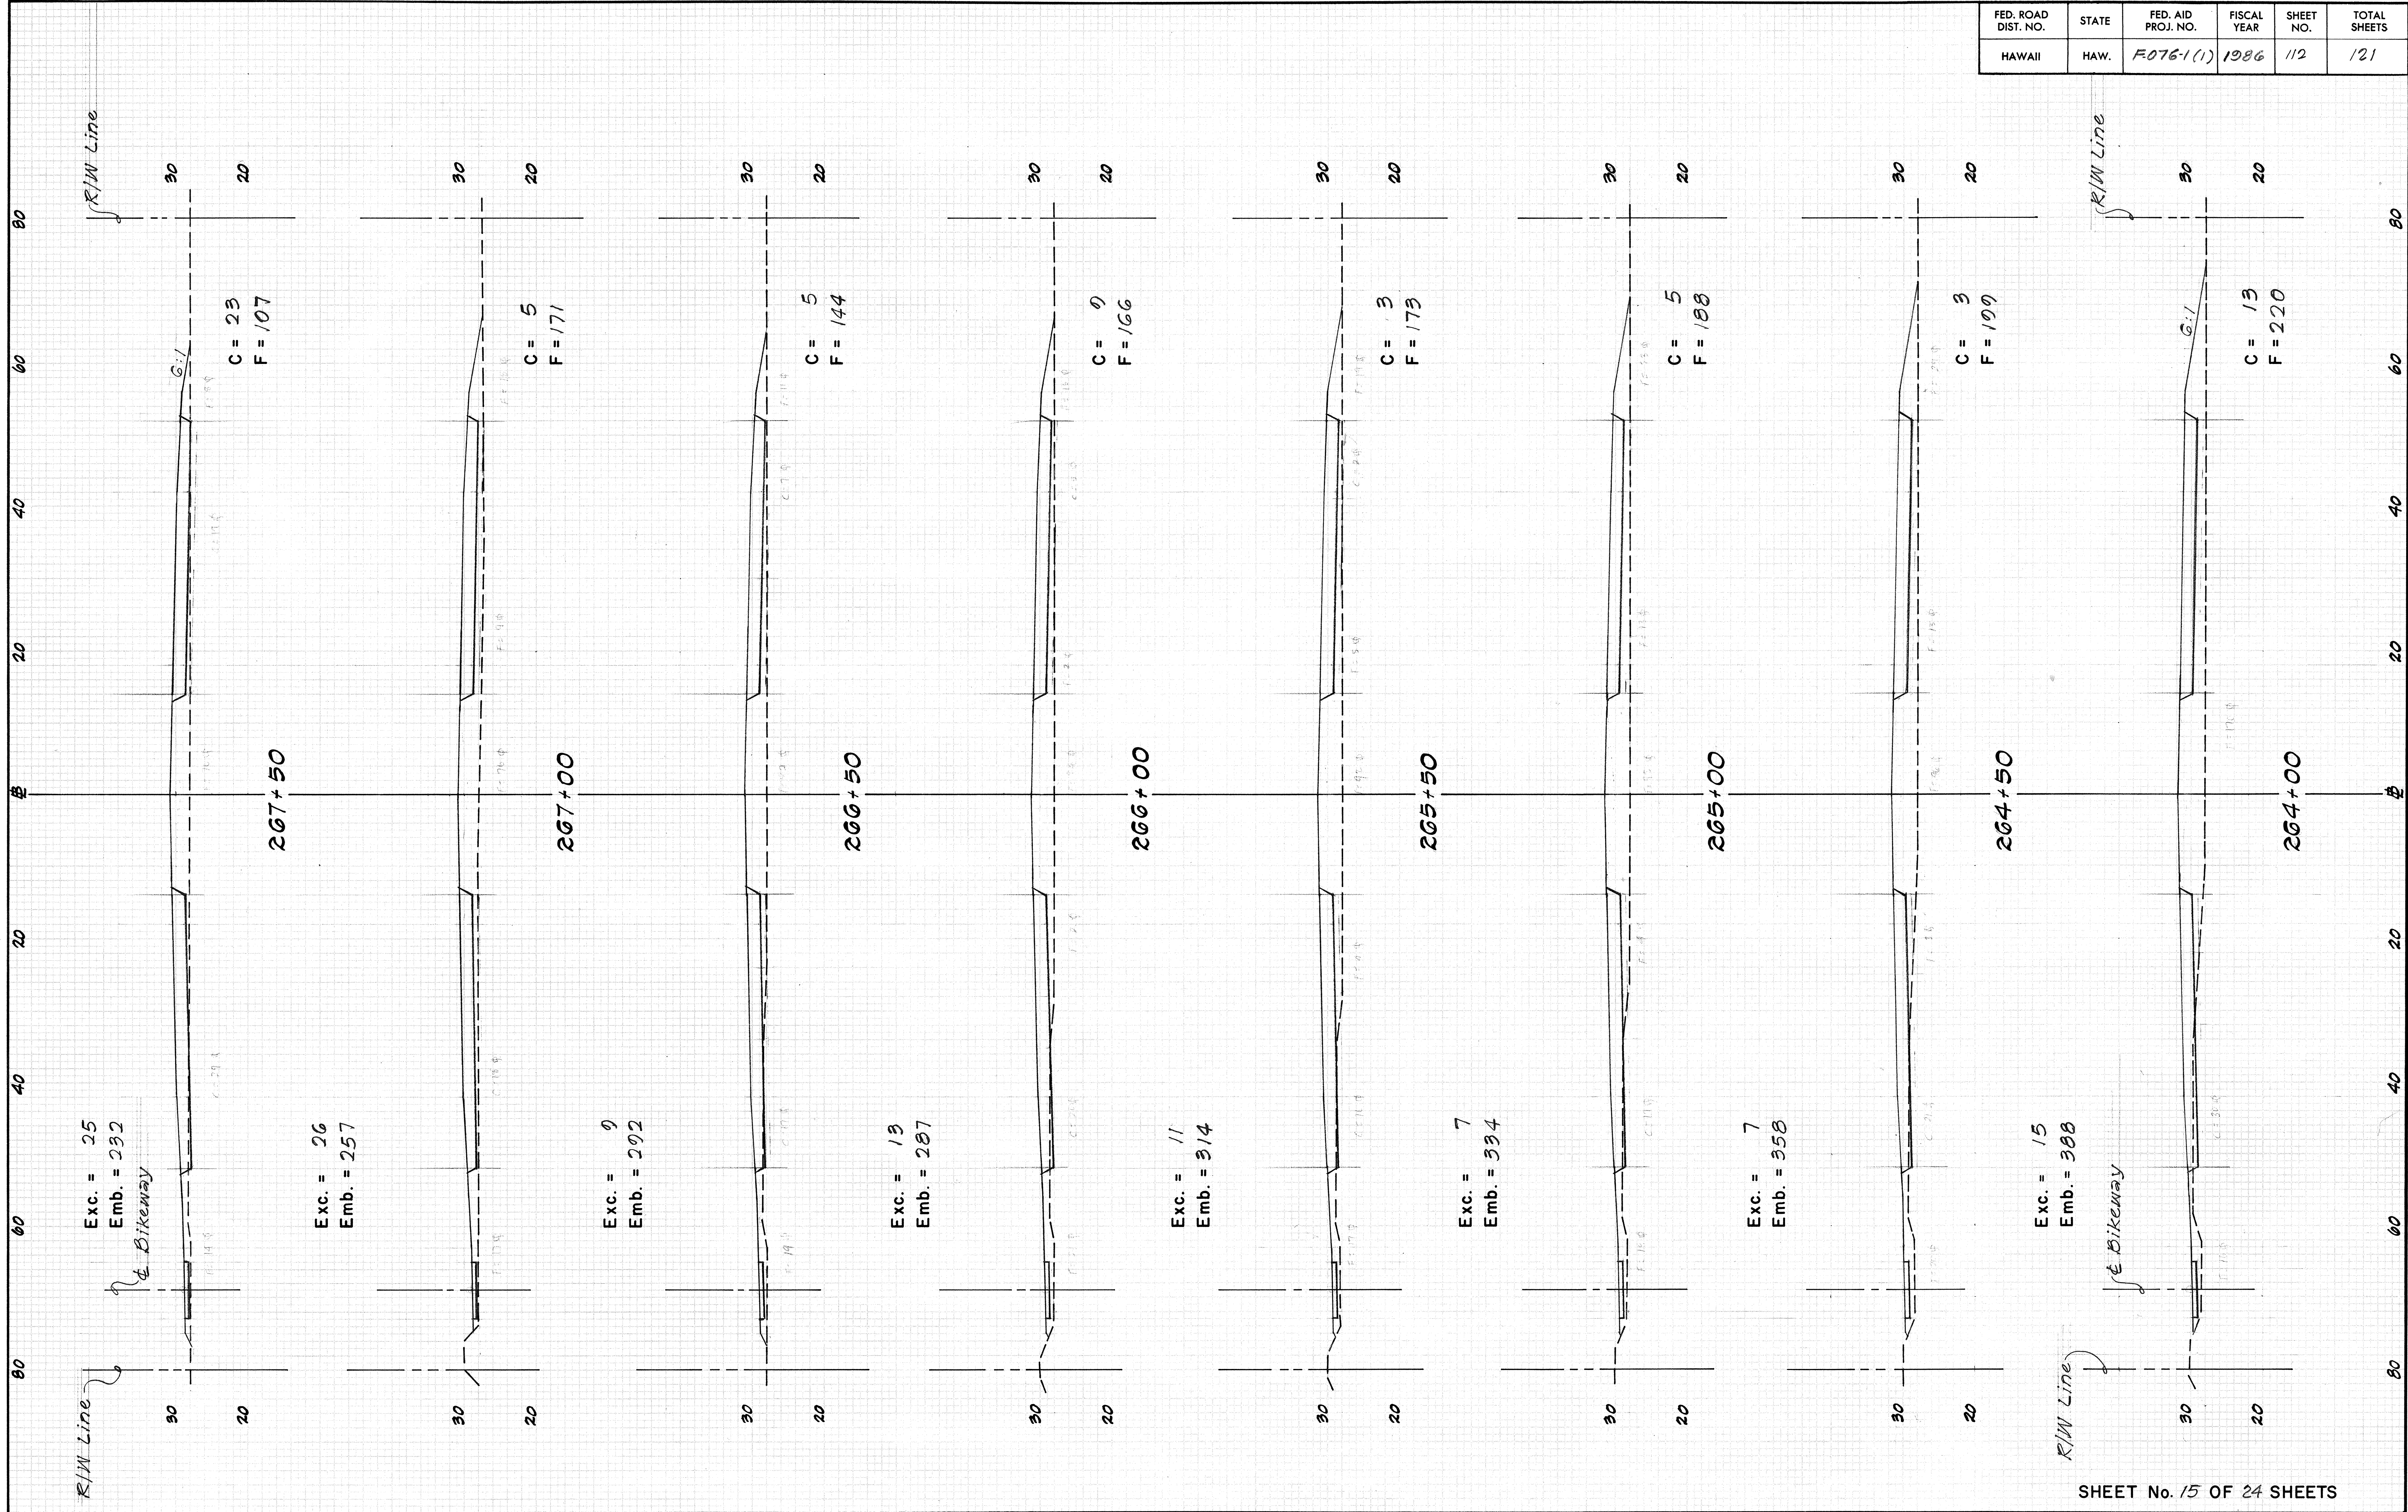


ORIGINAL	SURVEYED	DATE
SURVEY	BY	
NOTE BOOK	TEMPLATE	
NO.	AREAS CHECKED	

ORIGINAL	SURVEYED	DATE
SURVEY	BY	
NOTE BOOK	TEMPLATE	
NO.	AREAS CHECKED	

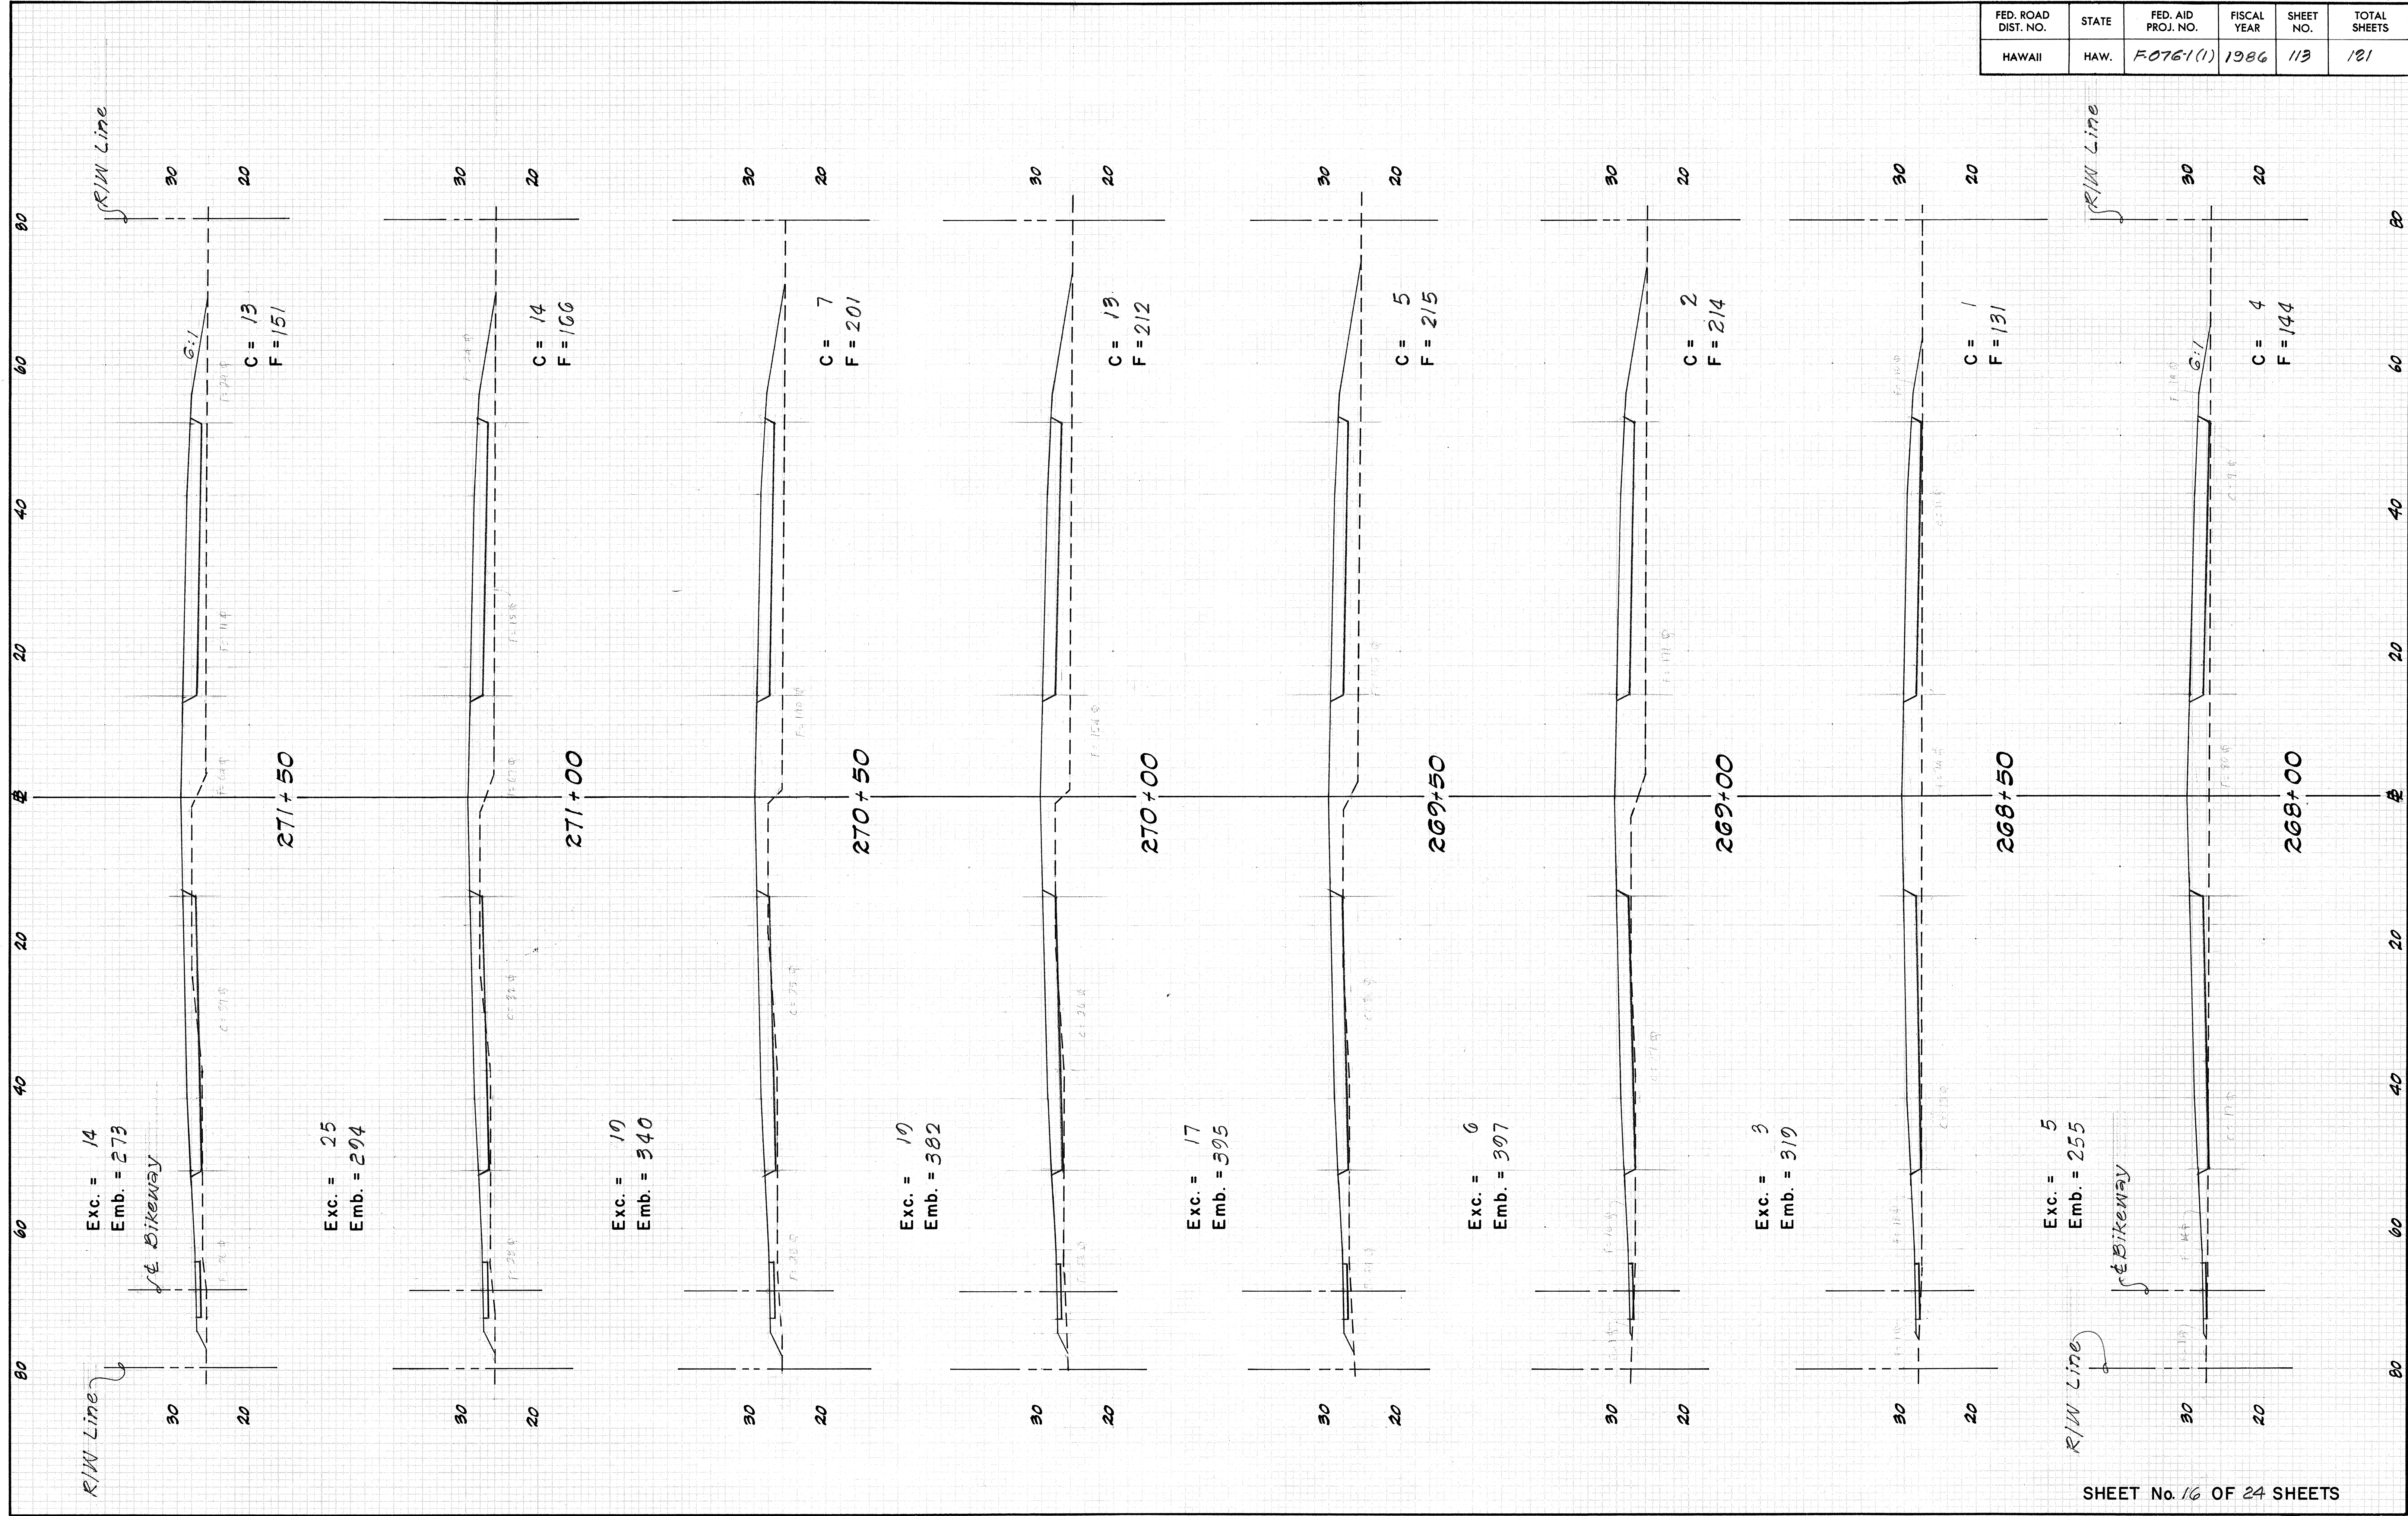


FED. ROAD DIST. NO.	STATE	FED. AID PROJ. NO.	FISCAL YEAR	SHEET NO.	TOTAL SHEETS
HAWAII	HAW.	F0761(1)	1986	113	121

FED. ROAD DIST. NO.	STATE	FED. AID PROJ. NO.	FISCAL YEAR	SHEET NO.	TOTAL SHEETS
HAWAII	HAW.	F-076-1(1)	1986	114	121

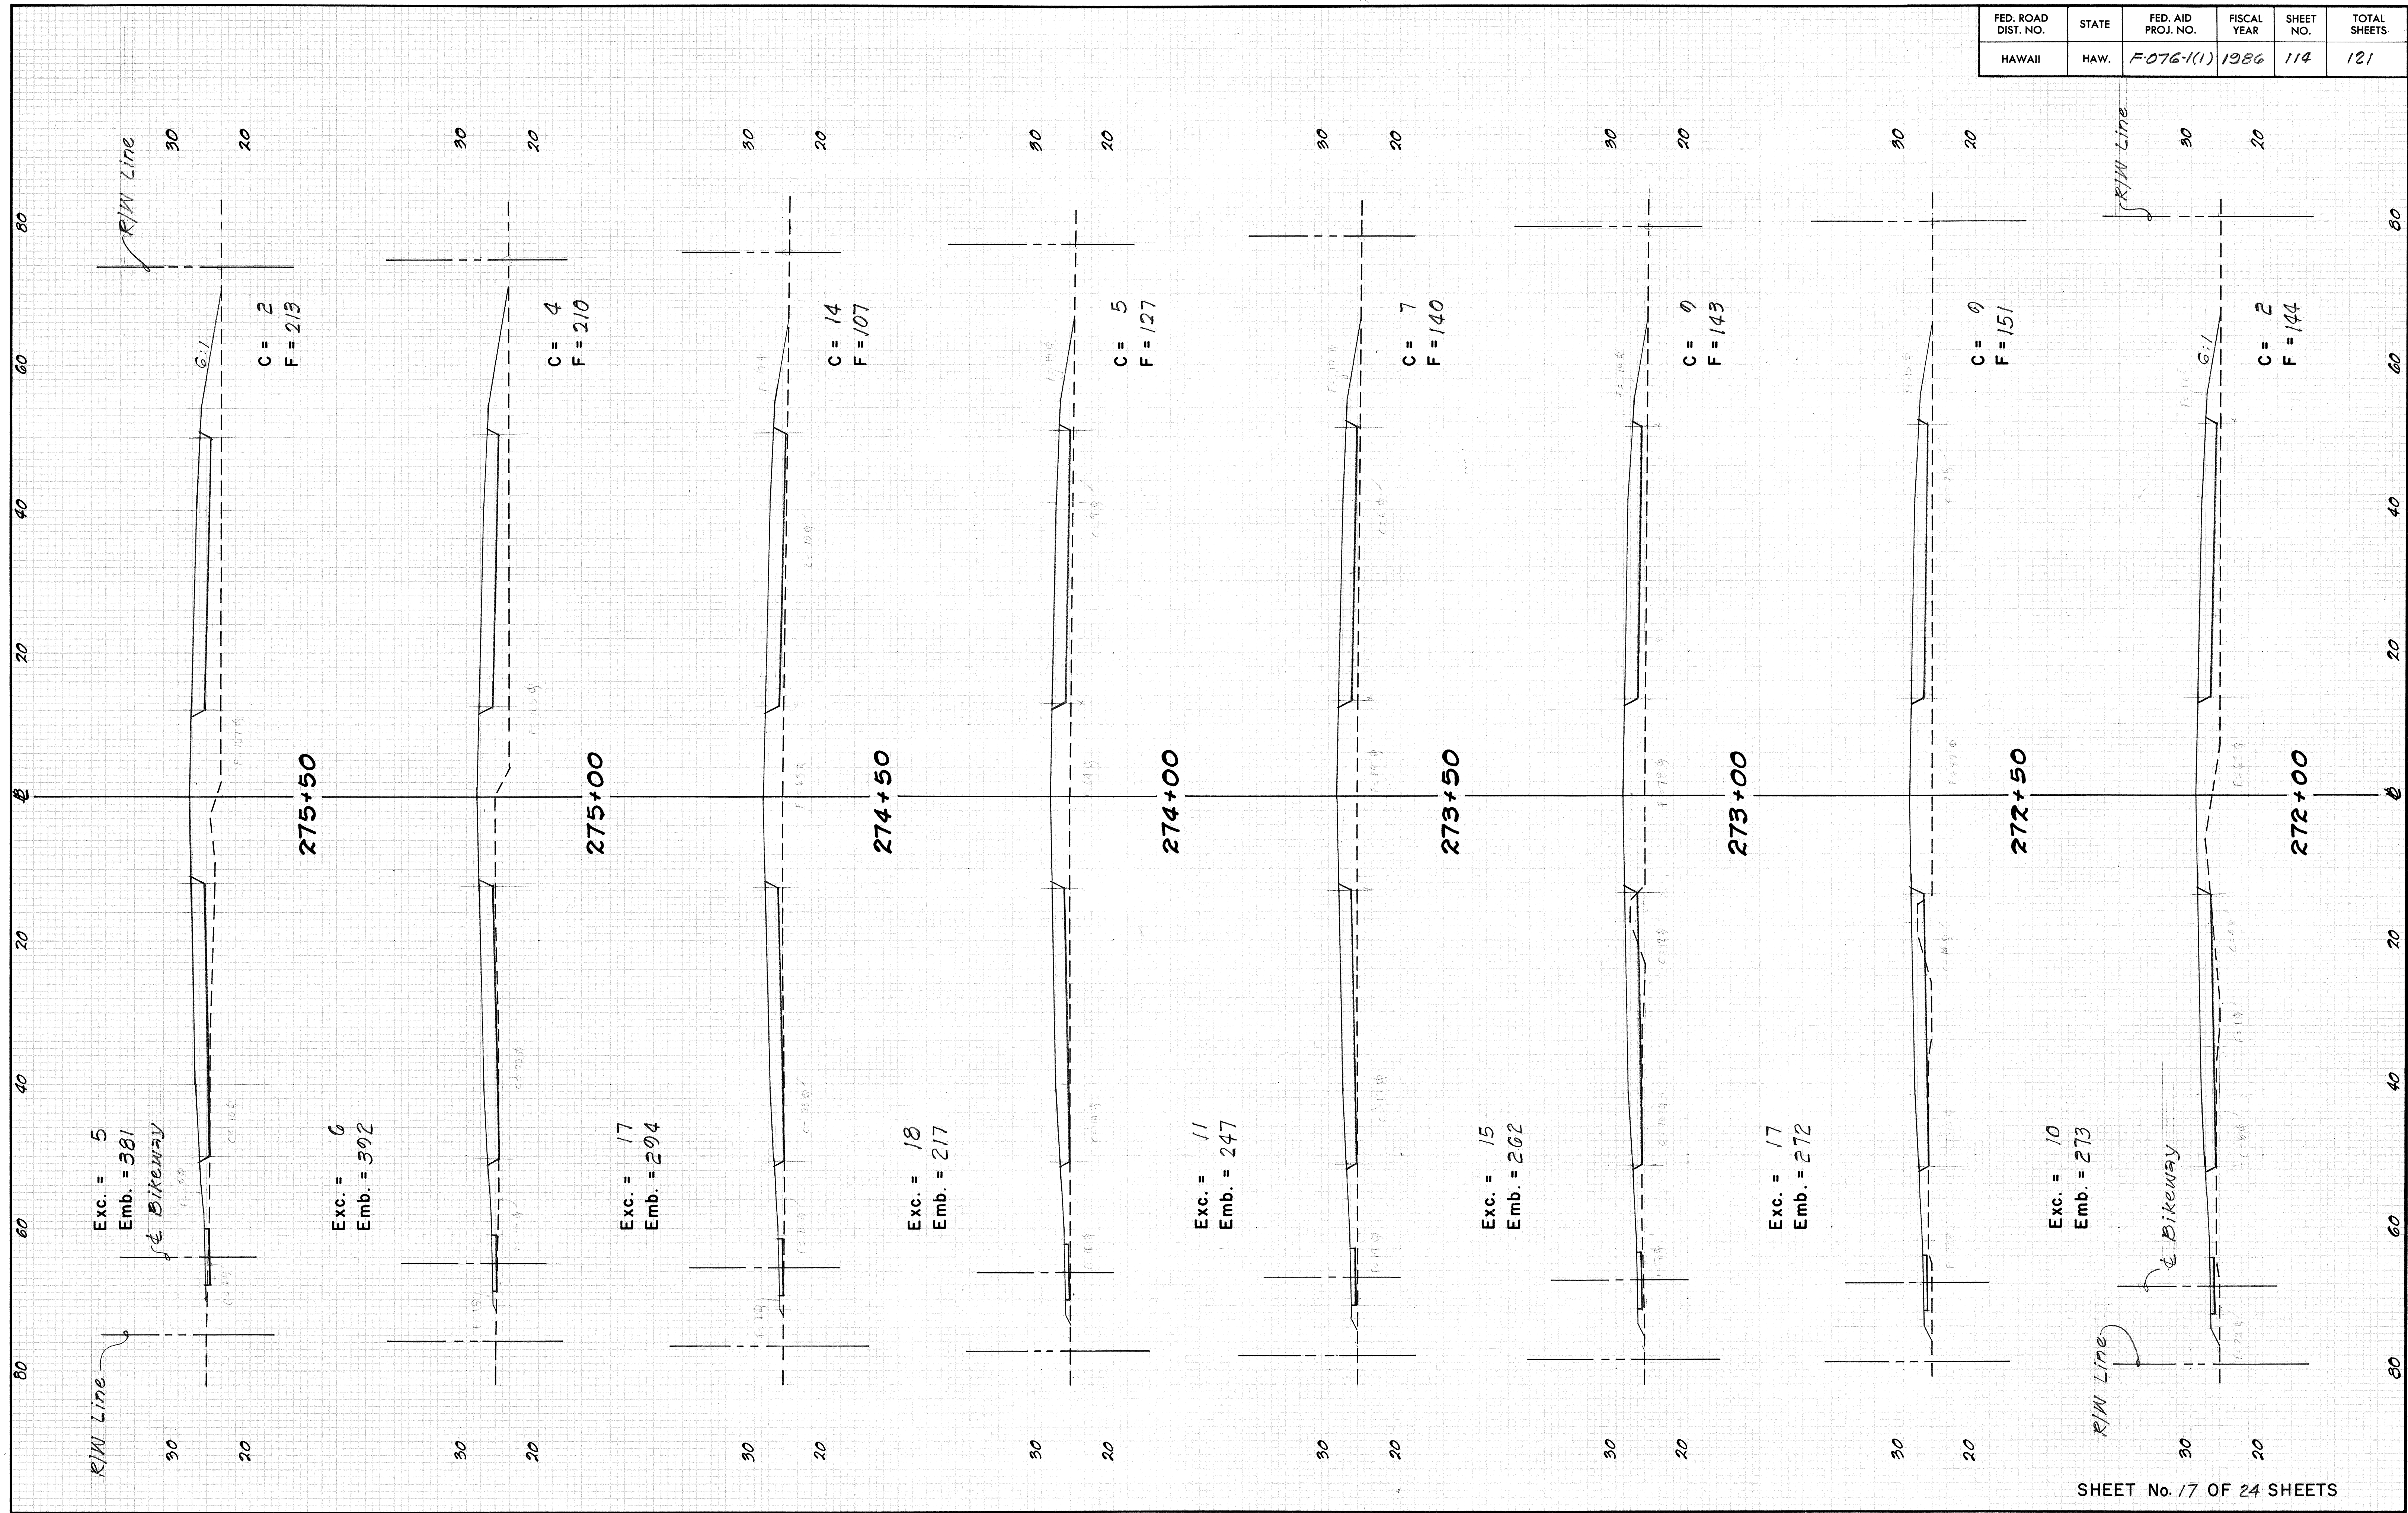

FINAL SURVEY	DATE
SURVEYED	BY
PLOTTED	
NOTE BOOK	
AREAS	
CHECKED	
NO.	


ORIGINAL SURVEY	DATE
SURVEYED	BY
PLOTTED	
NOTE BOOK	
AREAS	
CHECKED	
NO.	

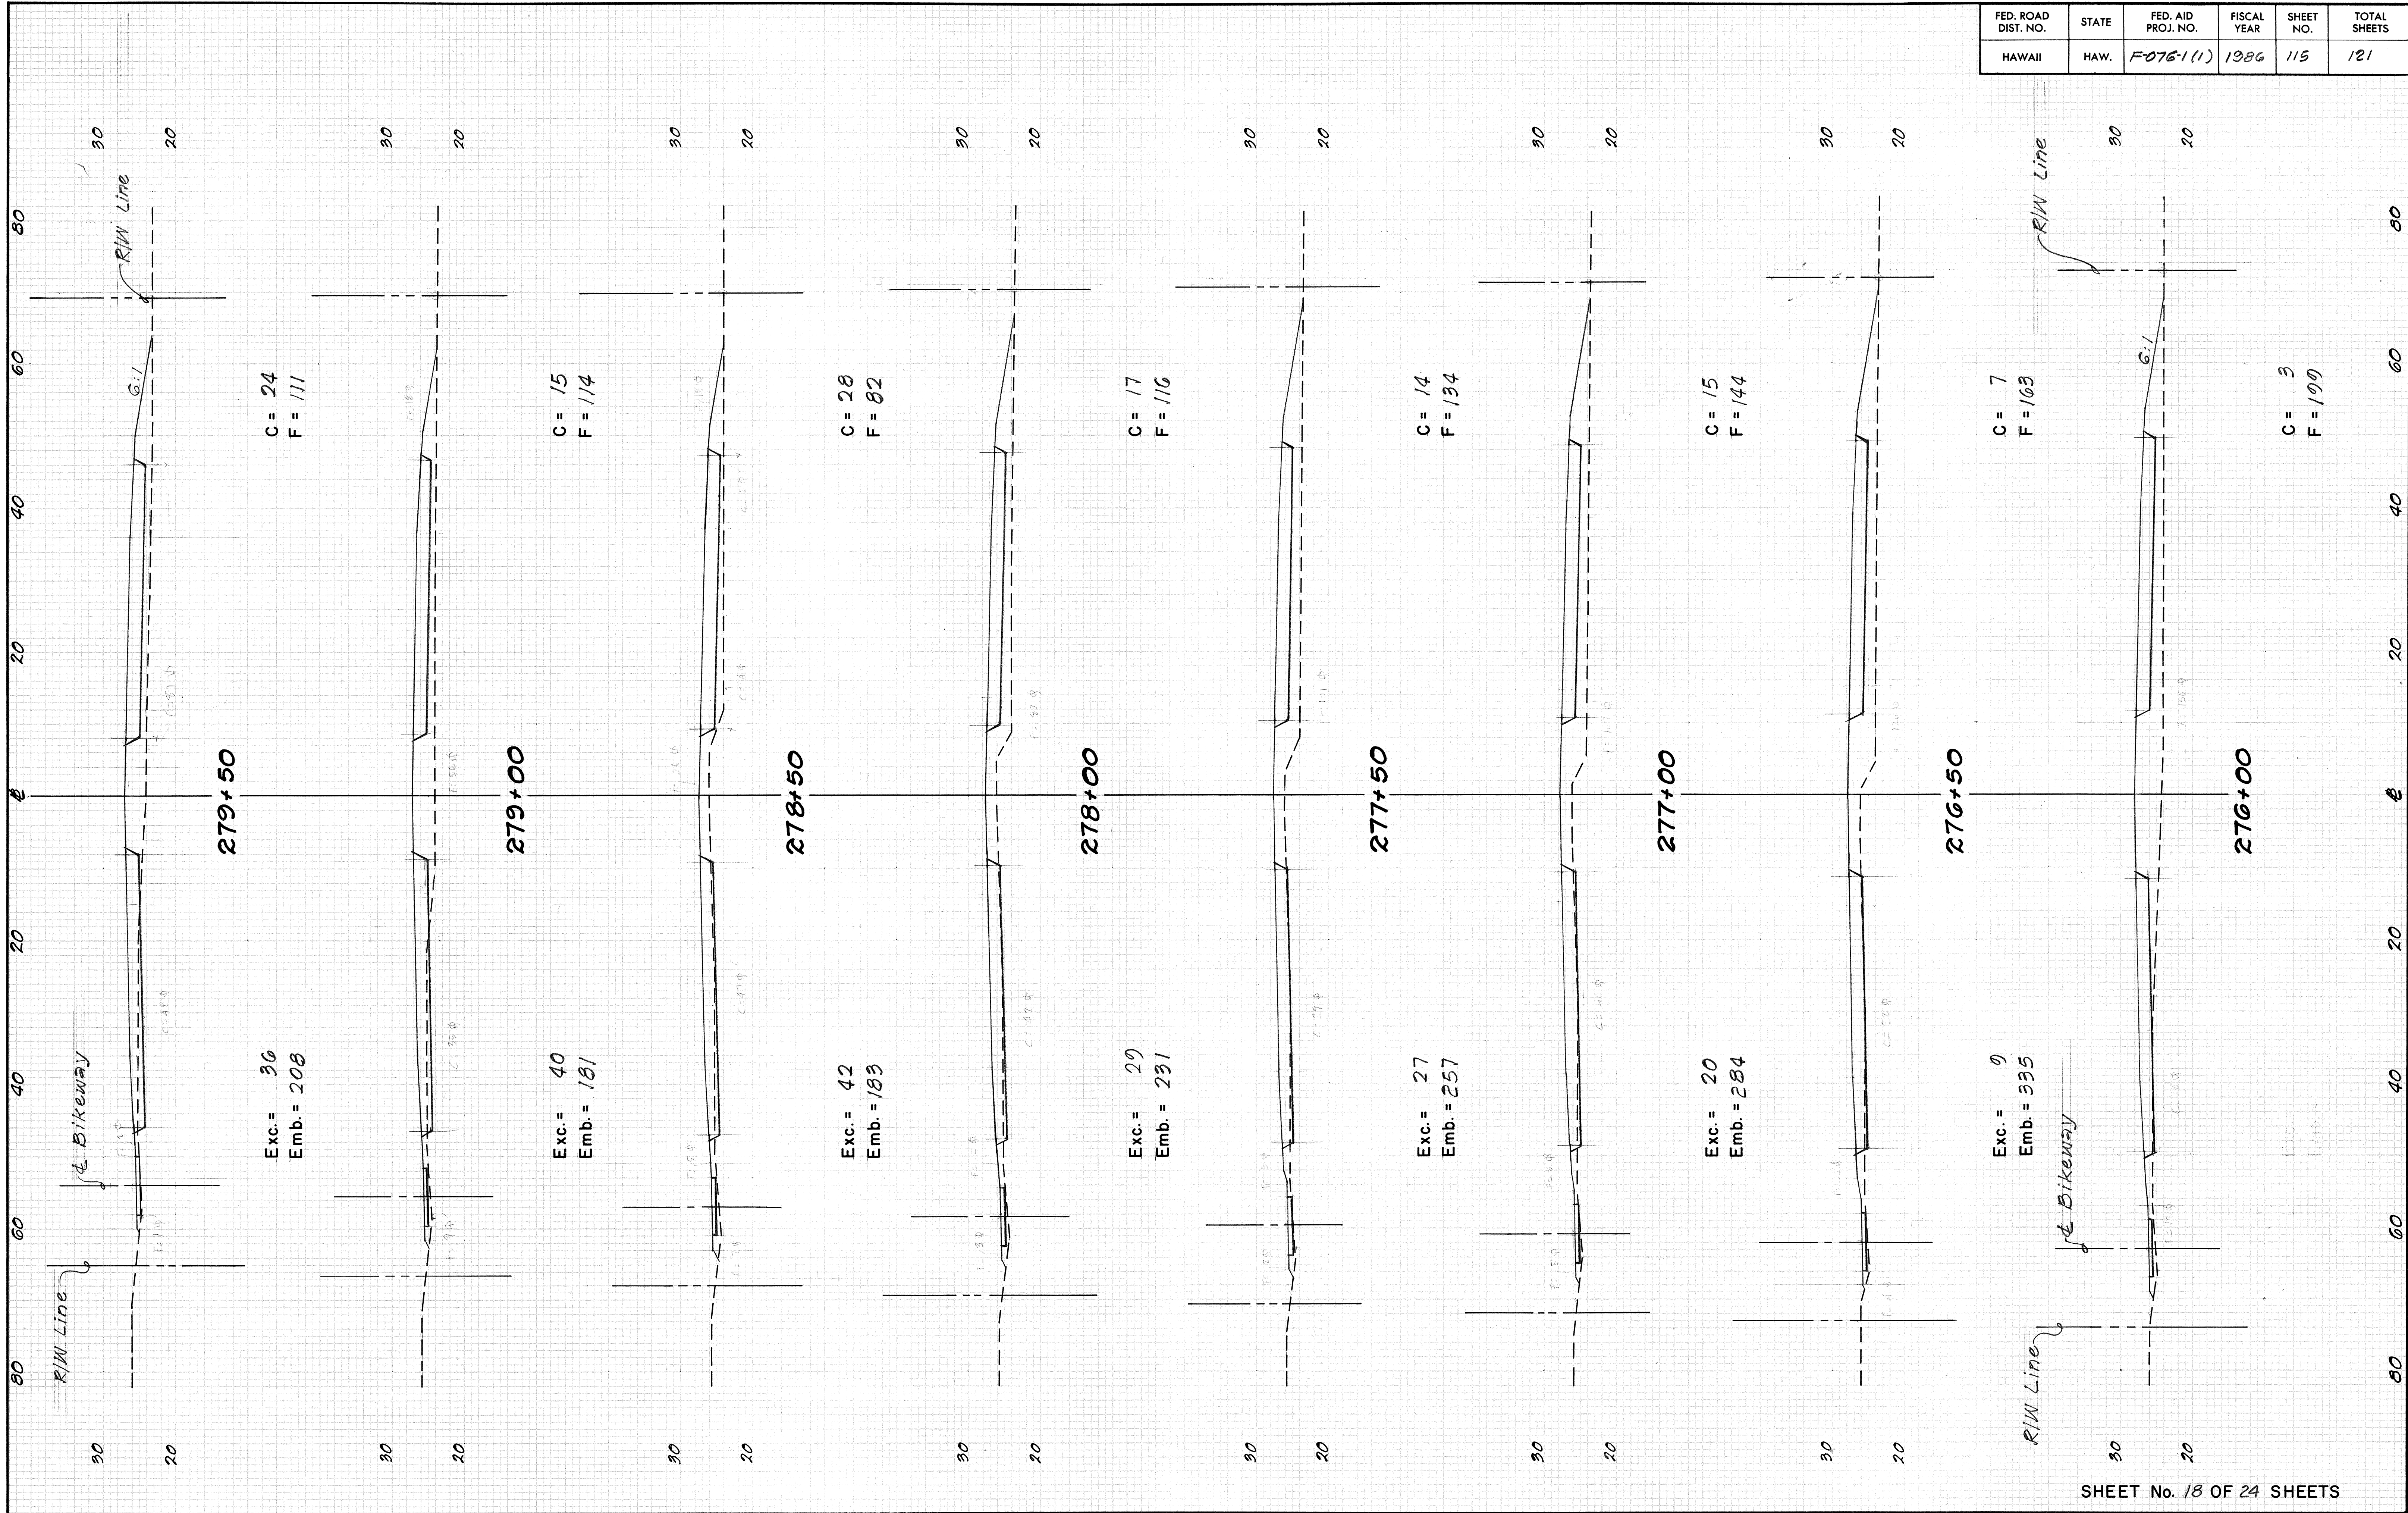

FED. ROAD DIST. NO.	STATE	FED. AID PROJ. NO.	FISCAL YEAR	SHEET NO.	TOTAL SHEETS
HAWAII	HAW.	F076-1(11)	1986	115	121

FINAL	SURVEYED	DATE
SURVEY	PLOTTED	BY
NOTE BOOK	AREA	
NO.	AREA CHECKED	

ORIGINAL	SURVEYED	DATE
SURVEY	PLOTTED	BY
NOTE BOOK	AREA	
NO.	AREA CHECKED	

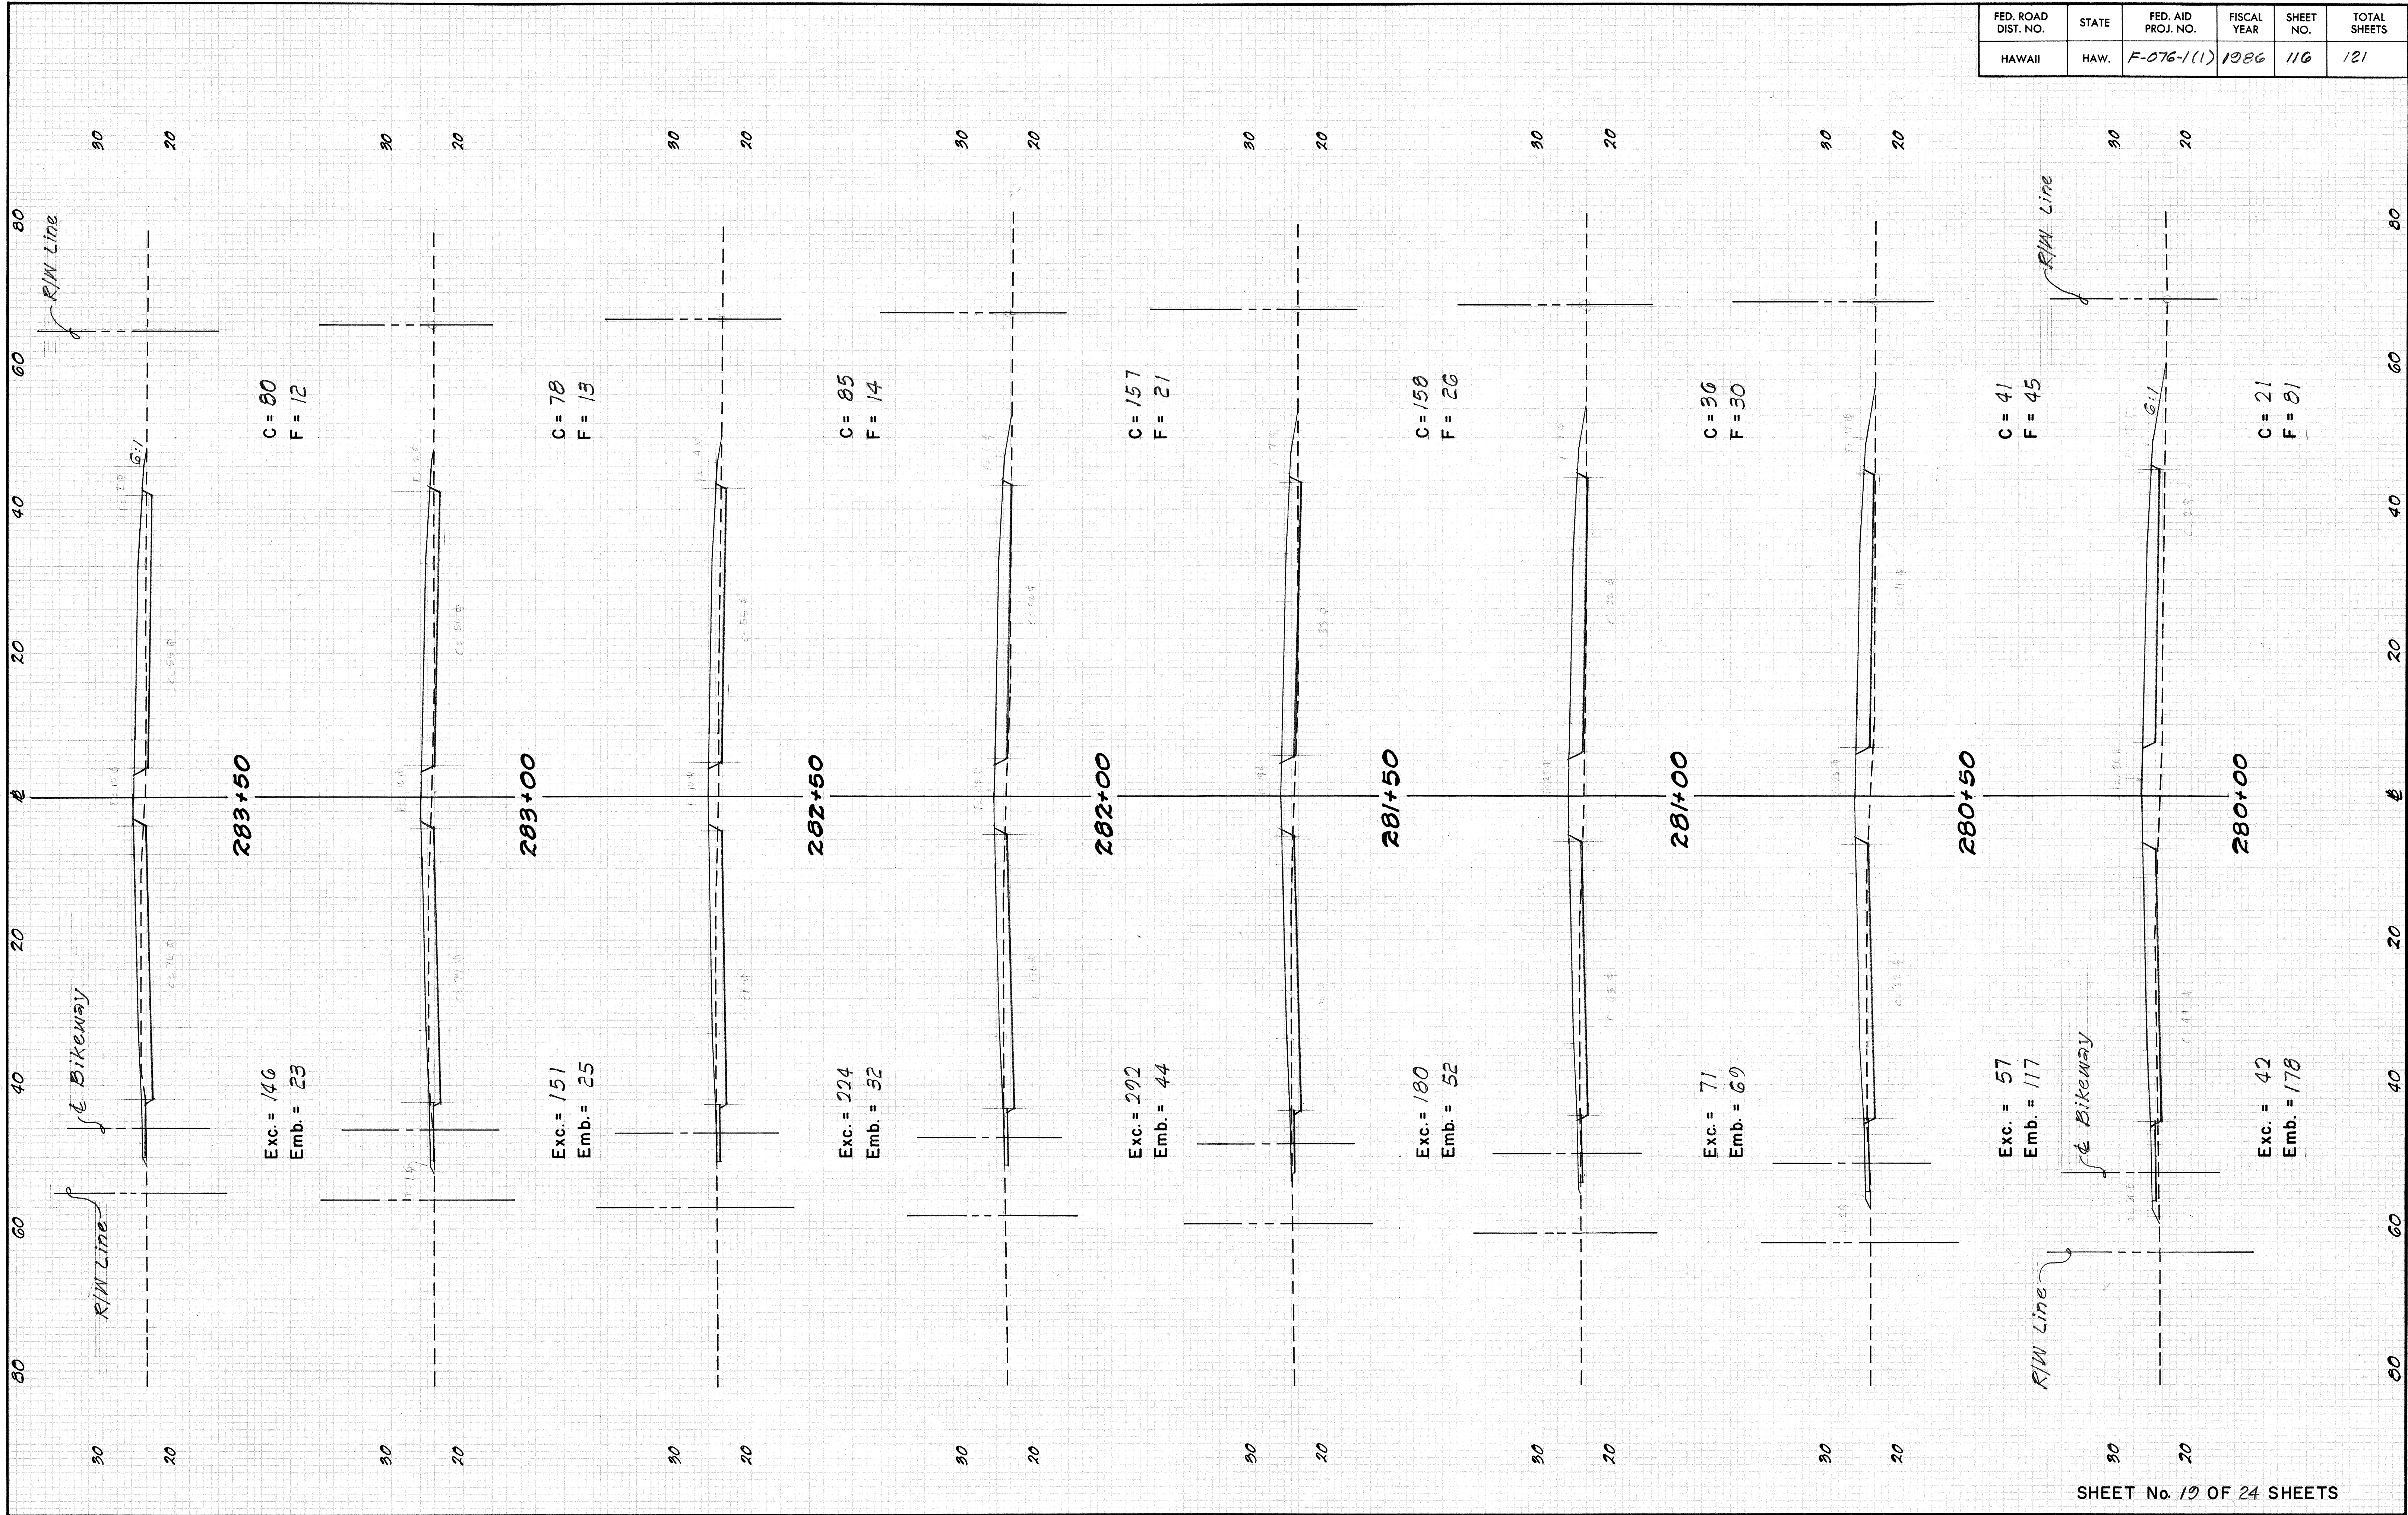


FED. ROAD DIST. NO.	STATE	FED. AID PROJ. NO.	FISCAL YEAR	SHEET NO.	TOTAL SHEETS
HAWAII	HAW.	F-076-1(1)	1986	116	121

FINAL	SURVEYED	DATE
SURVEY	BY	
NOTE BOOK	TEMPERATURE	
NO.	AREAS	
	AREAS CHECKED	

ORIGINAL	SURVEYED	DATE
SURVEY	BY	
NOTE BOOK	TEMPERATURE	
NO.	AREAS	
	AREAS CHECKED	


FED. ROAD DIST. NO.	STATE	FED. AID PROJ. NO.	FISCAL YEAR	SHEET NO.	TOTAL SHEETS
HAWAII	HAW.	F-076-1(11)	1986	117	121

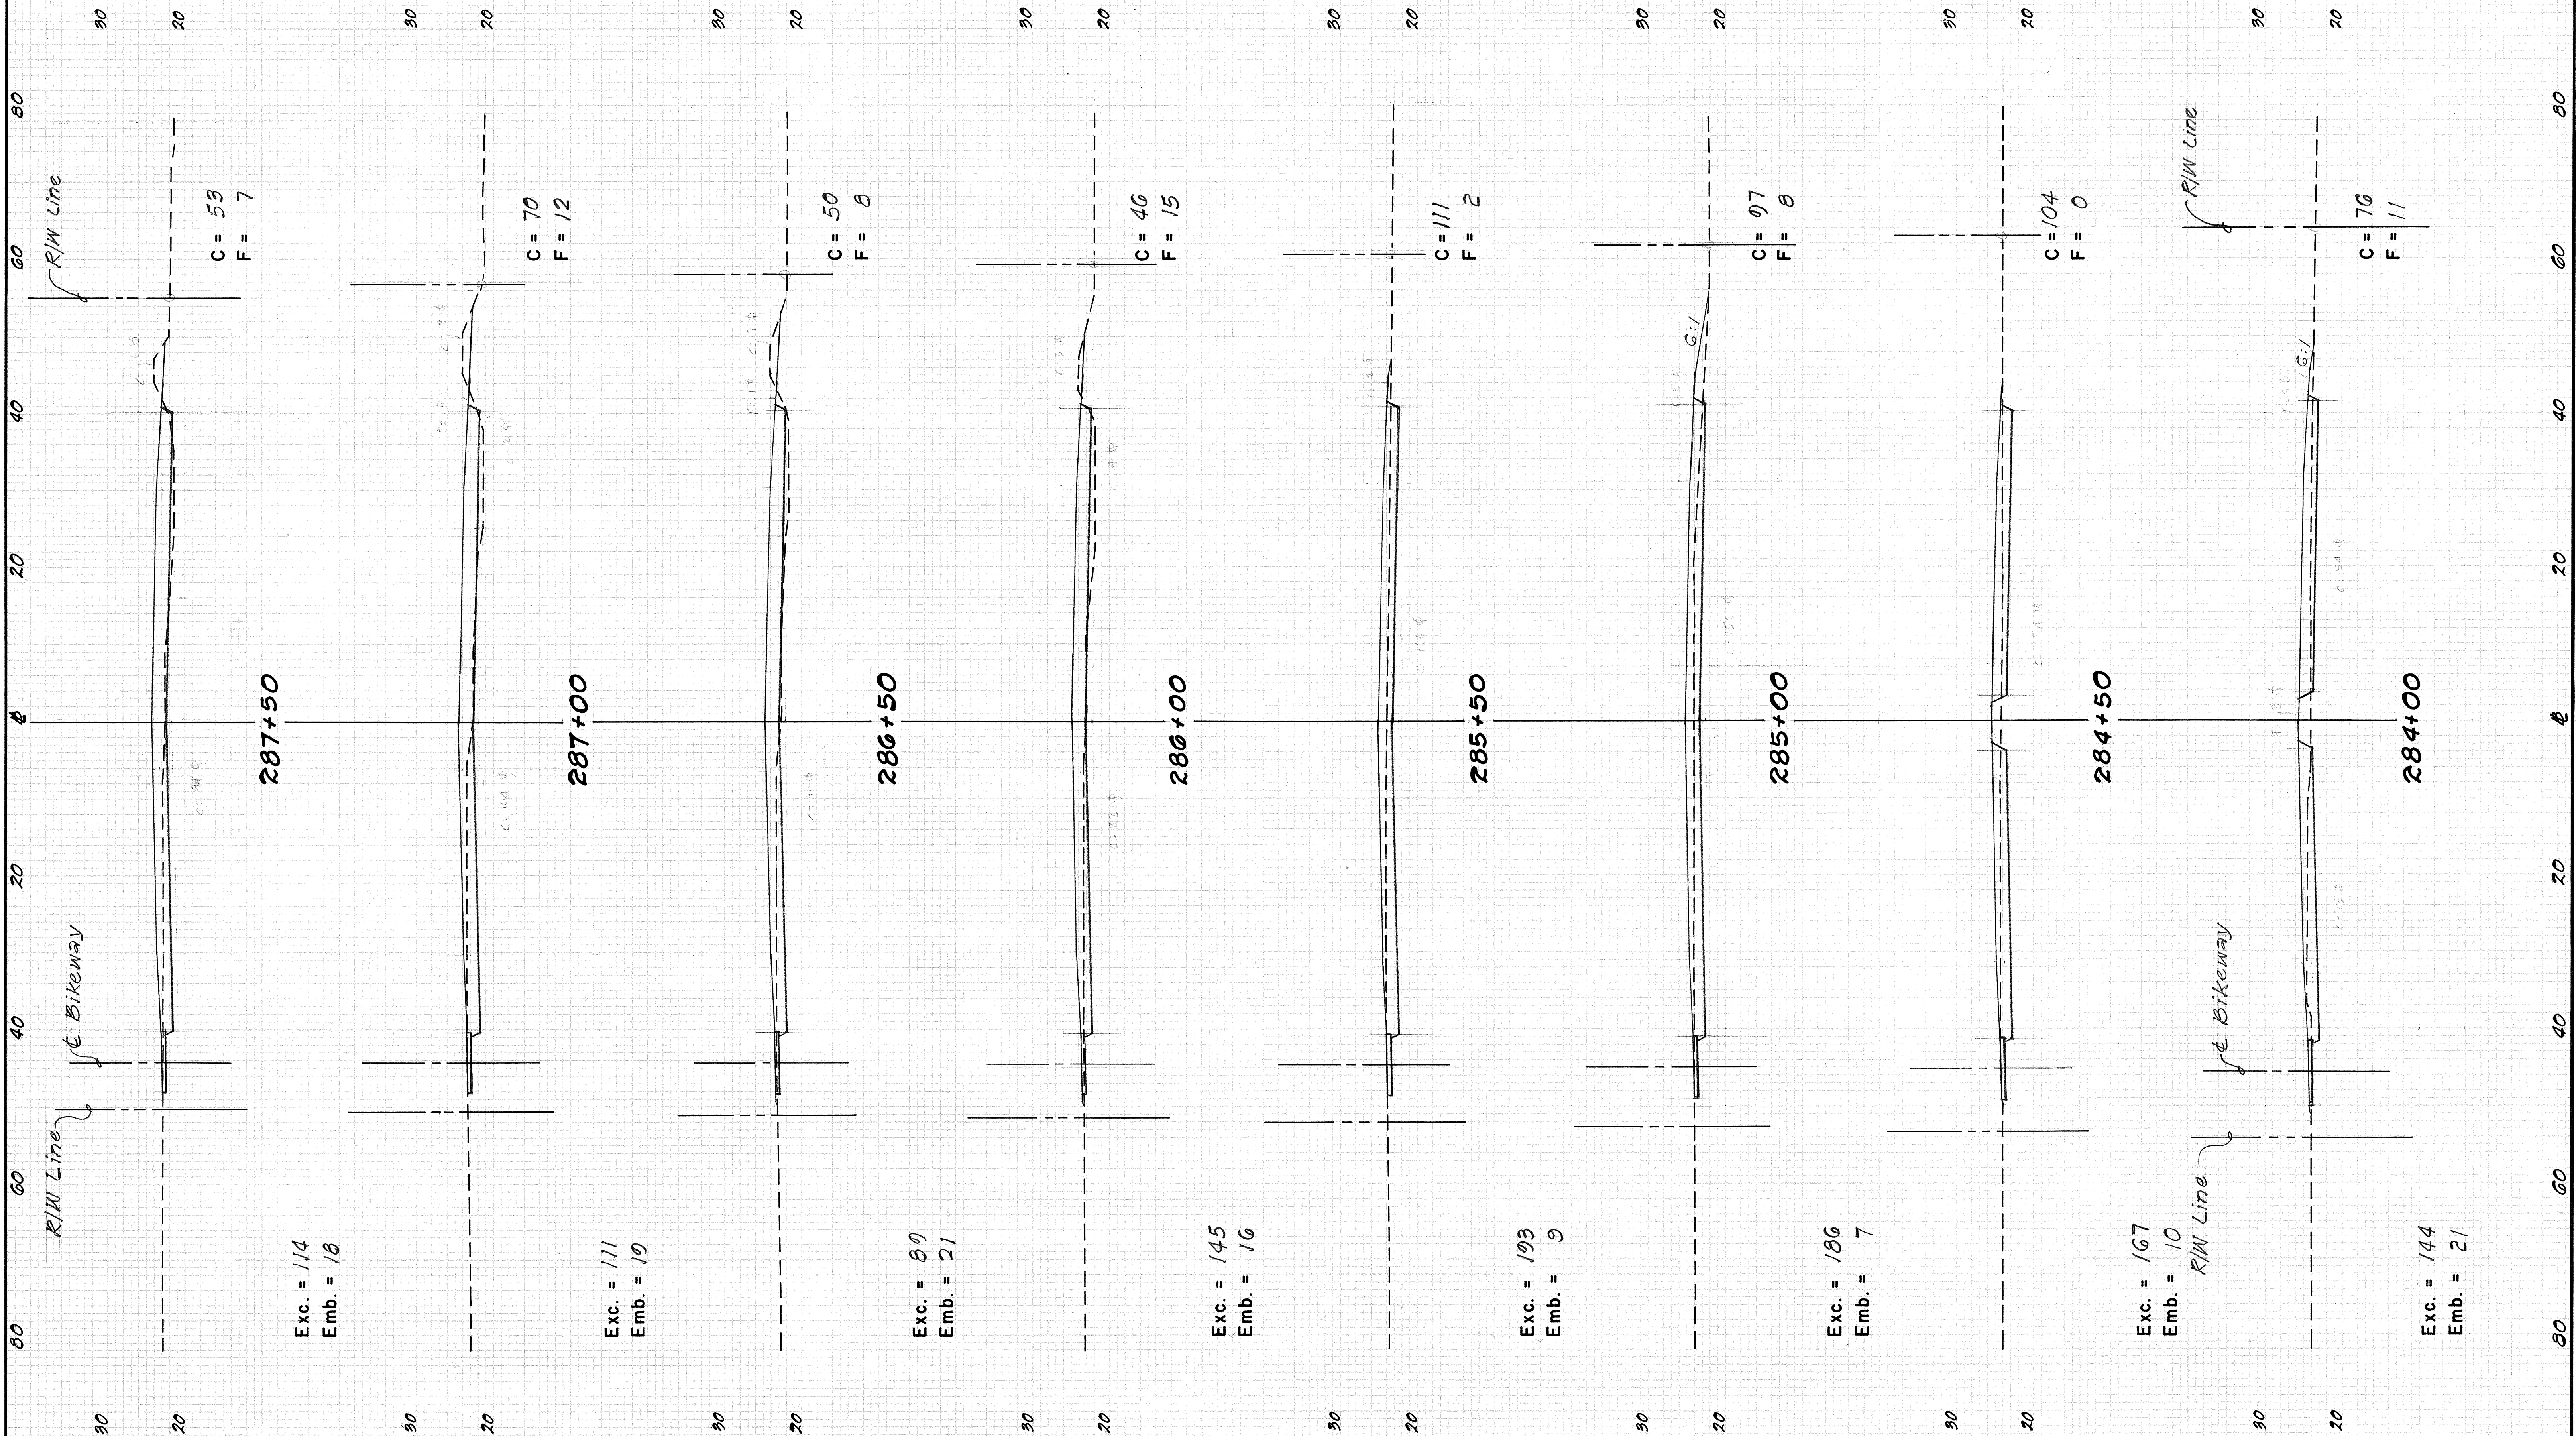


DATE	
FINAL SURVEY	
NOTED	
NOTE BOOK	
NO.	

DATE	
ORIGINAL SURVEY	
NOTED	
NOTE BOOK	
NO.	

FED. ROAD DIST. NO.	STATE	FED. AID PROJ. NO.	FISCAL YEAR	SHEET NO.	TOTAL SHEETS
HAWAII	HAW.	F-076-1(1)	1986	118	121

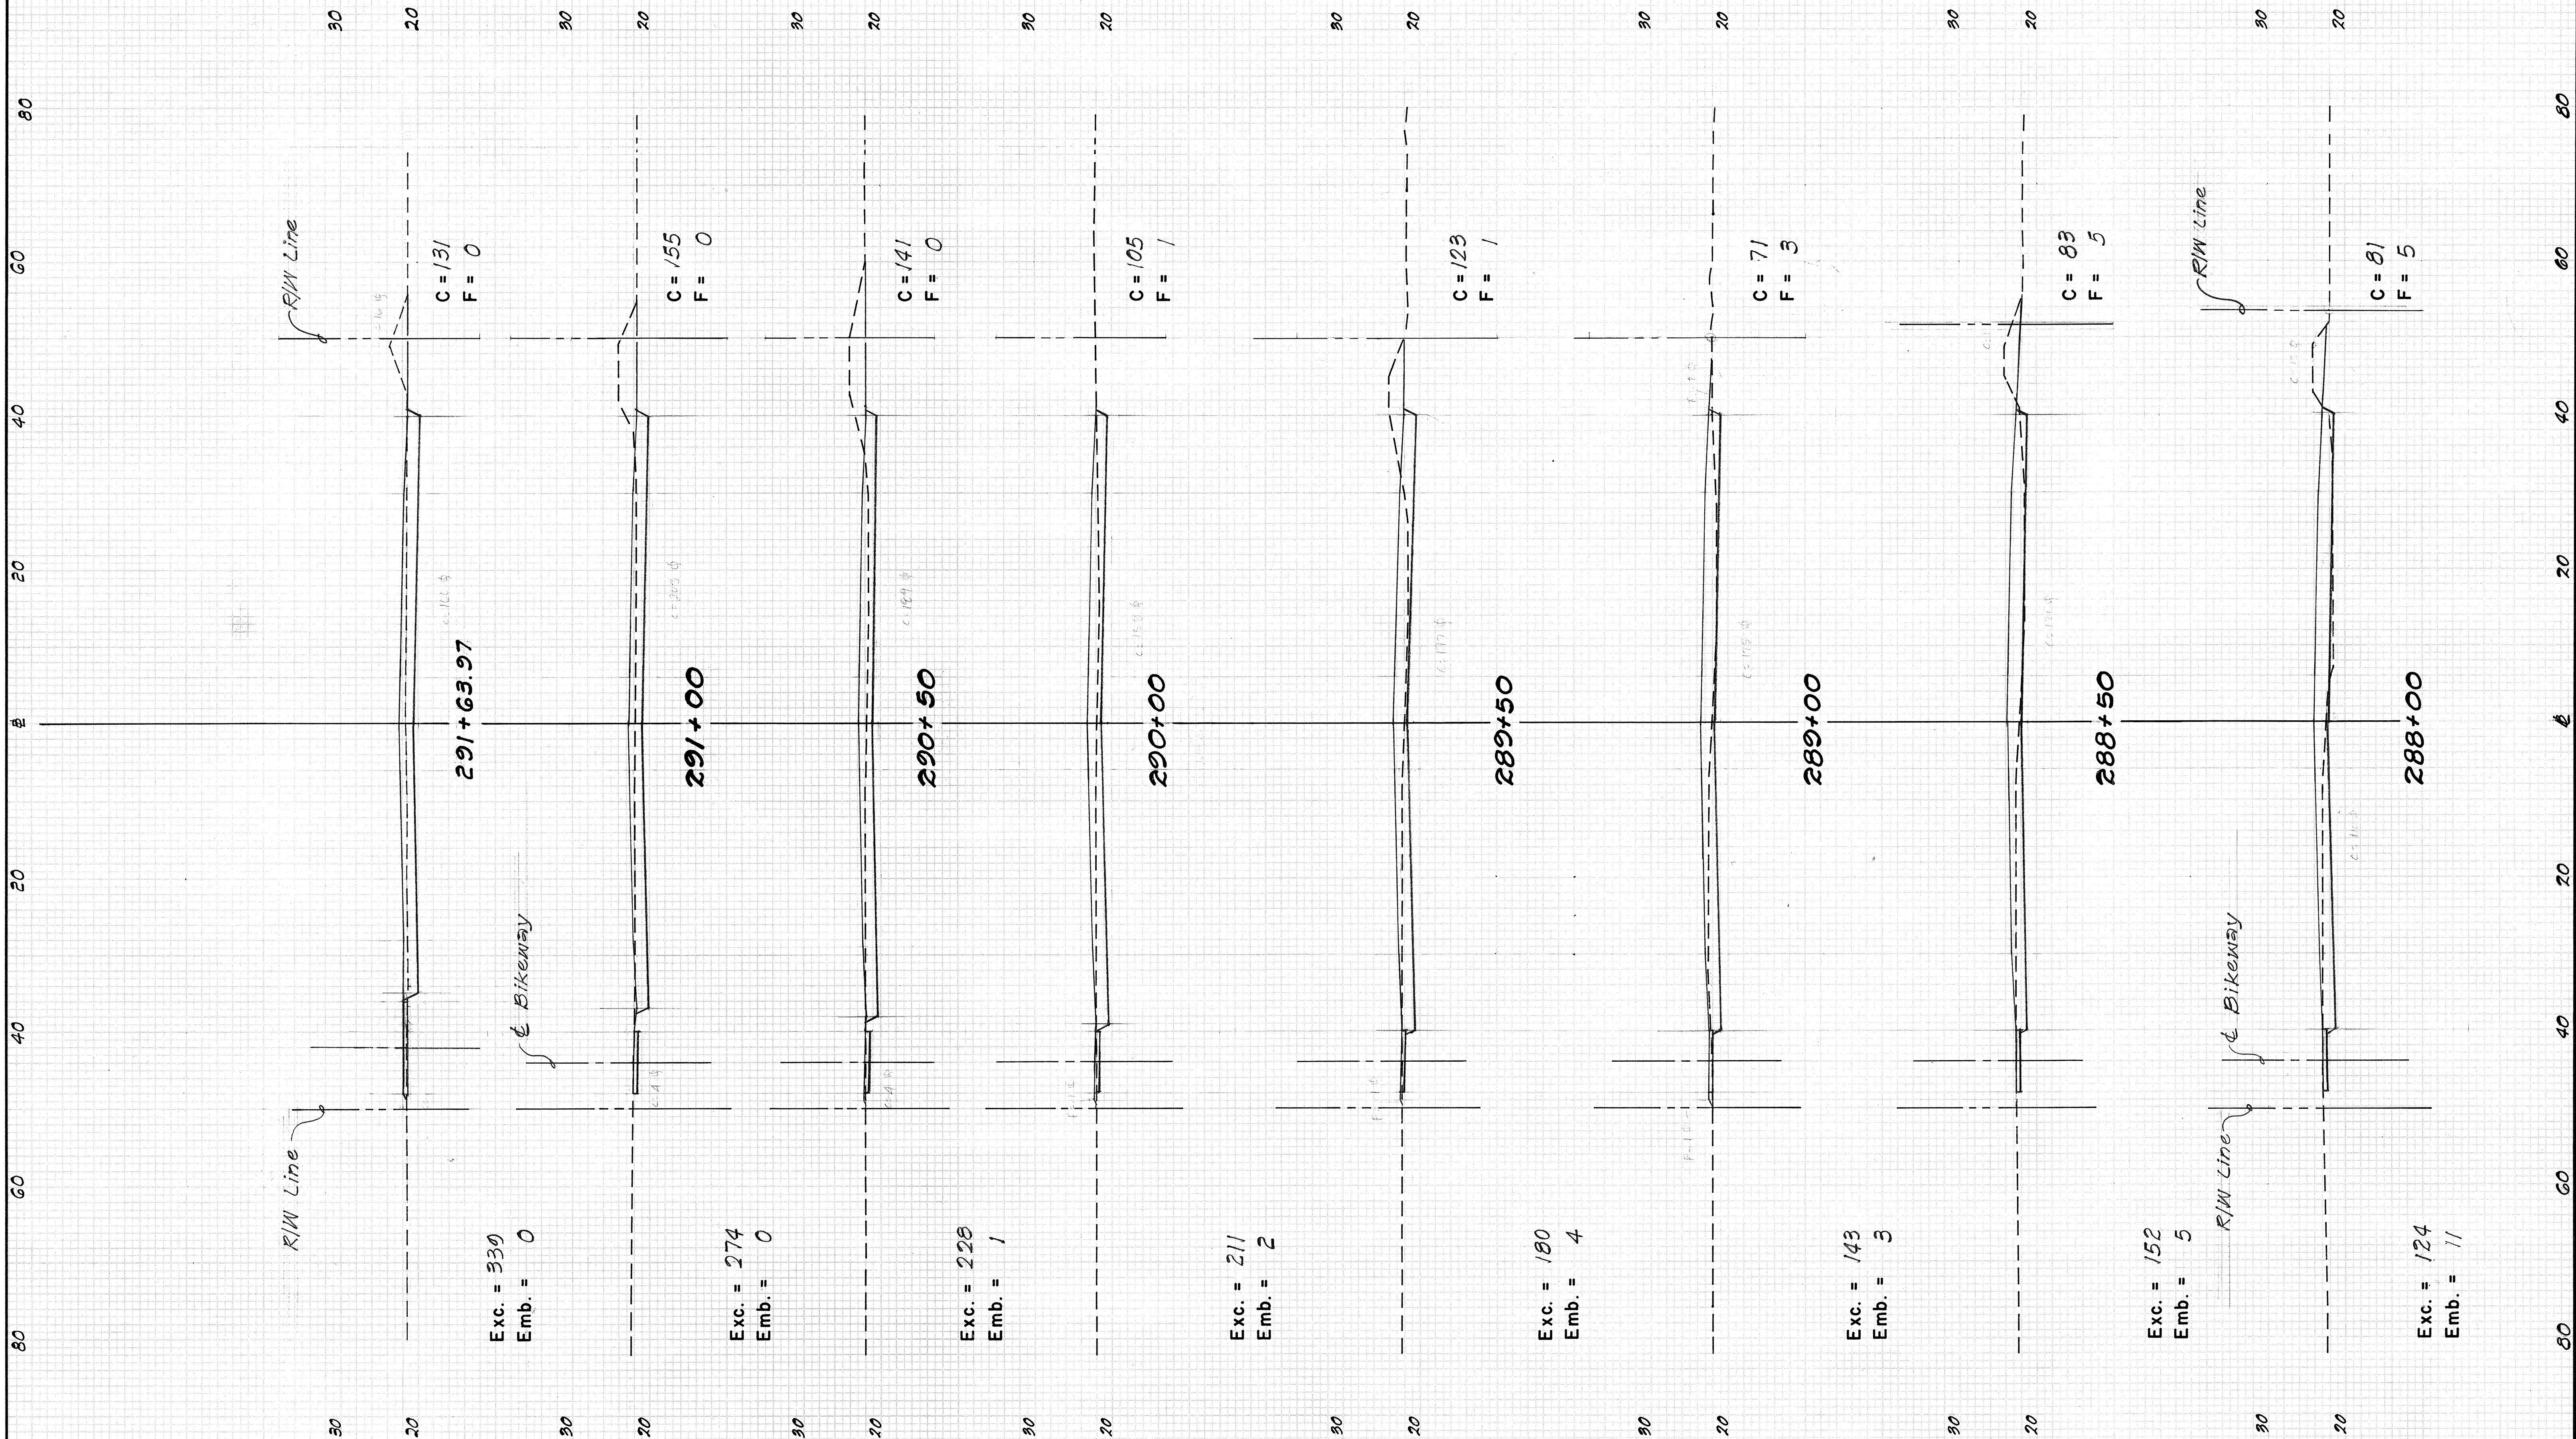

10 15 20 25 30 35

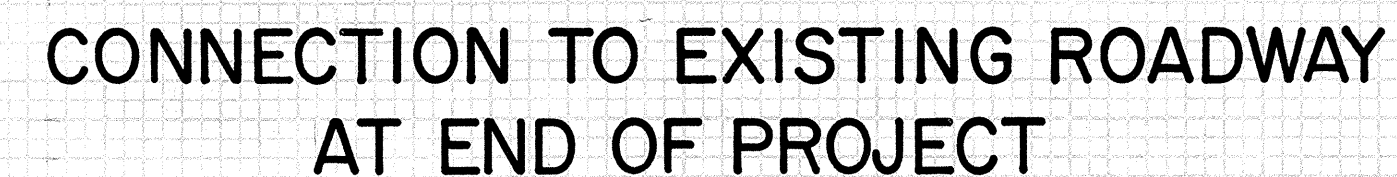


SHEET NO. 22 OF 24 SHEETS

FED. ROAD DIST. NO.	STATE	FED. AID PROJ. NO.	FISCAL YEAR	SHEET NO.	TOTAL SHEETS
HAWAII	HAW.	F-076-1(1)	1986	120	121

DATE	BY	NO.	FINAL SURVEY	SURVEYED	PLOTTED	NOTE BOOK	TEMPLATE	AREAS CHECKED


DATE	BY	NO.	ORIGINAL SURVEY	SURVEYED	PLOTTED	NOTE BOOK	TEMPLATE	AREAS CHECKED

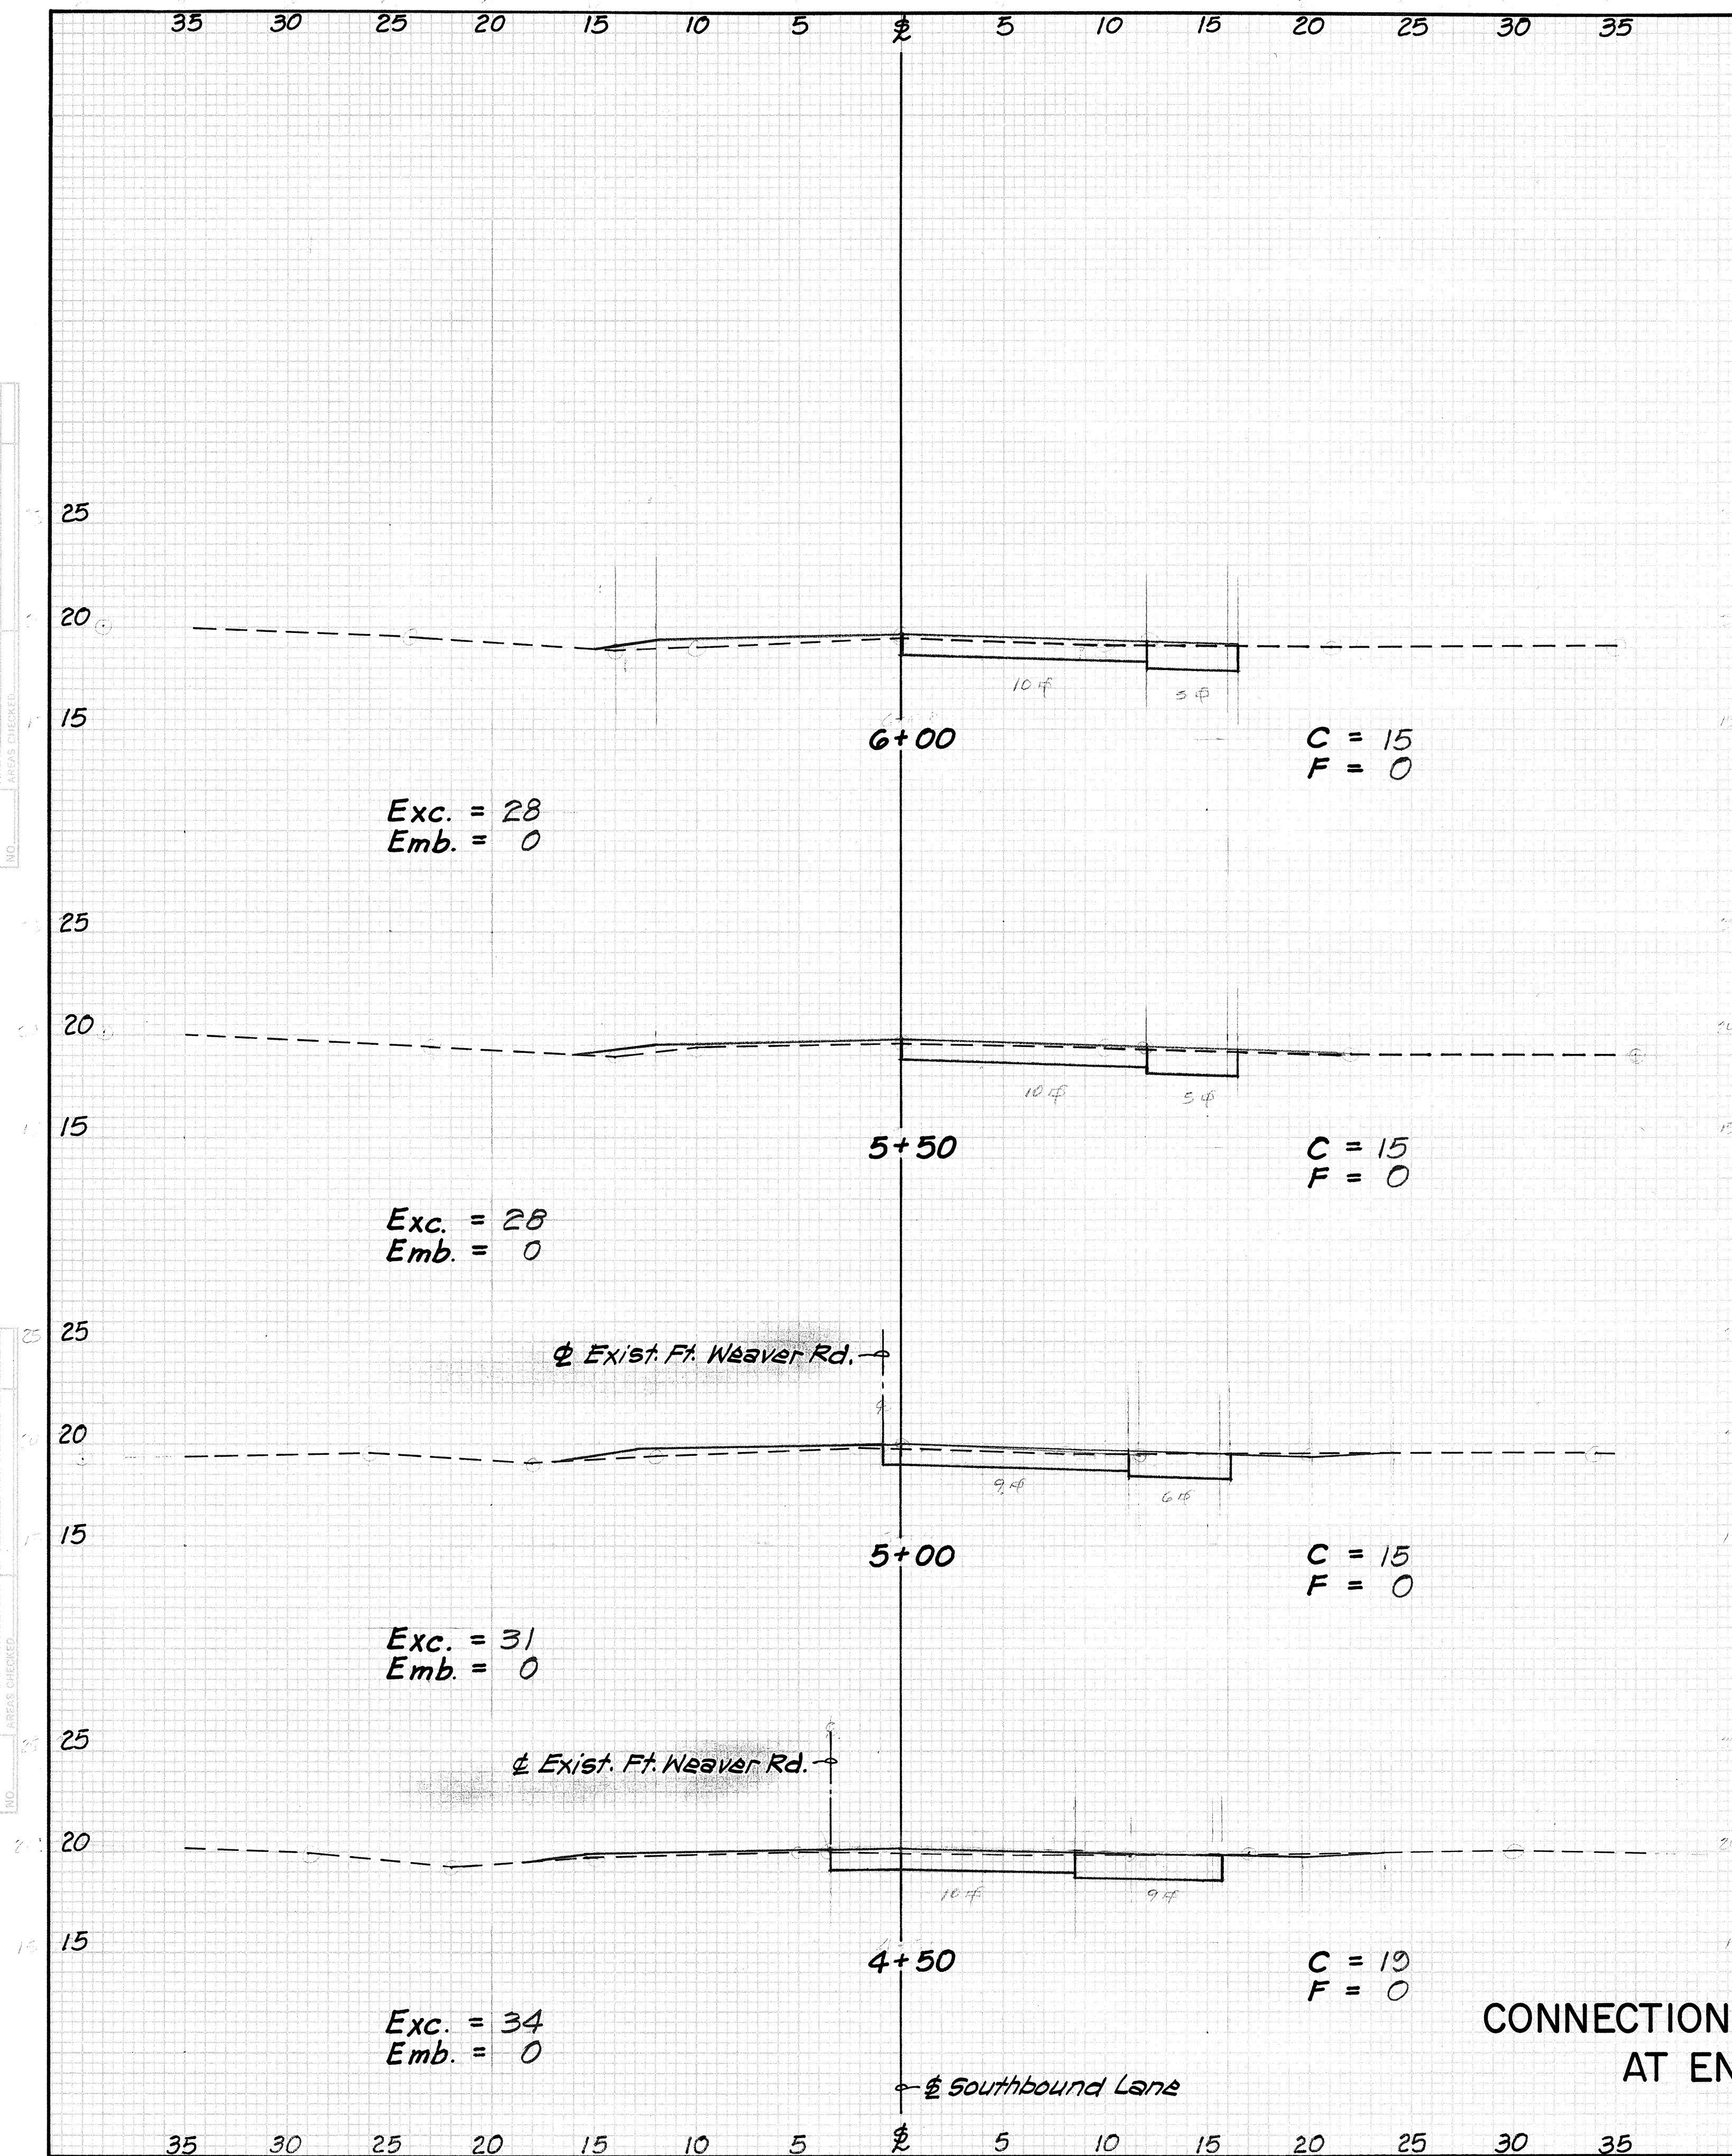

Scale: Horiz. 1" = 5'
Vert. 1" = 5'

SHEET NO. 23 OF 24 SHEETS

FED. ROAD DIST. NO.	STATE	FED. AID PROJ. NO.	FISCAL YEAR	SHEET NO.	TOTAL SHEETS
HAWAII	HAW.	F-076-1(1)	1986	121	121
20		40		60	

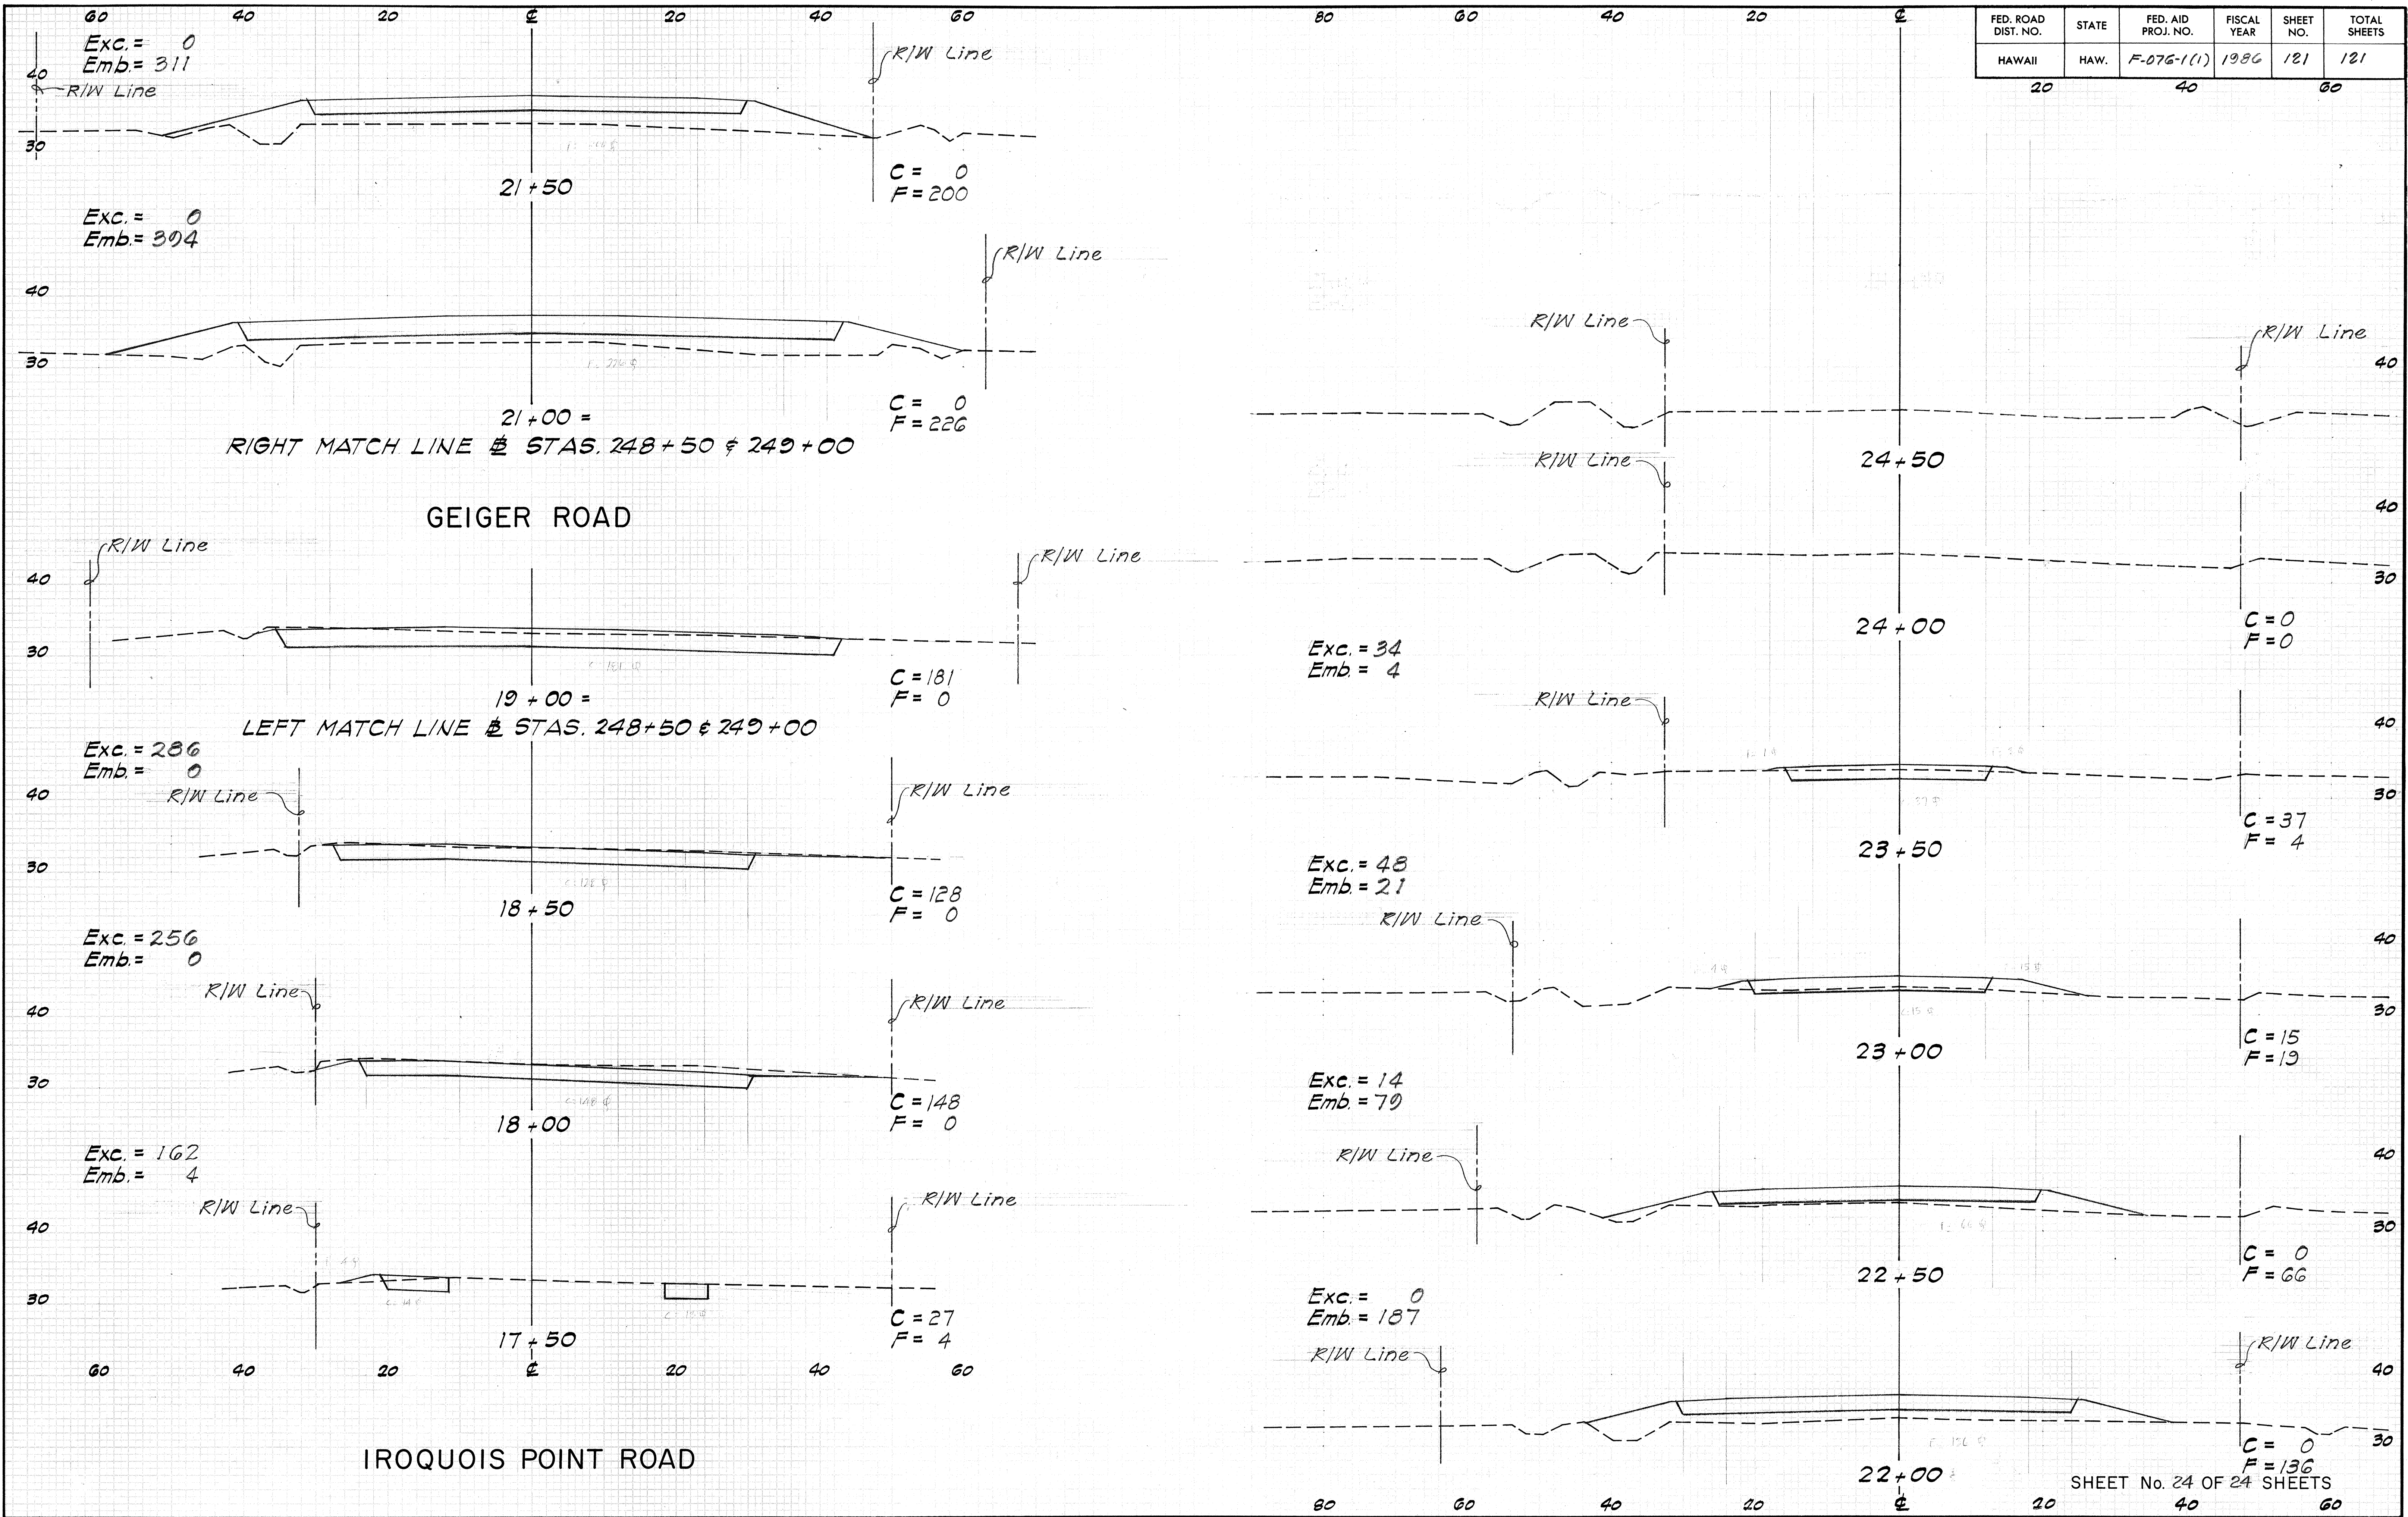

SHEET No. 24 OF 24 SHEETS