


FED. ROAD DIST. NO.	STATE	FED. AID PROJ. NO.	FISCAL YEAR	SHEET NO.	TOTAL SHEETS
HAWAII	HAW.	F-076-112) & S-RS-076012)RM	1990	132	148

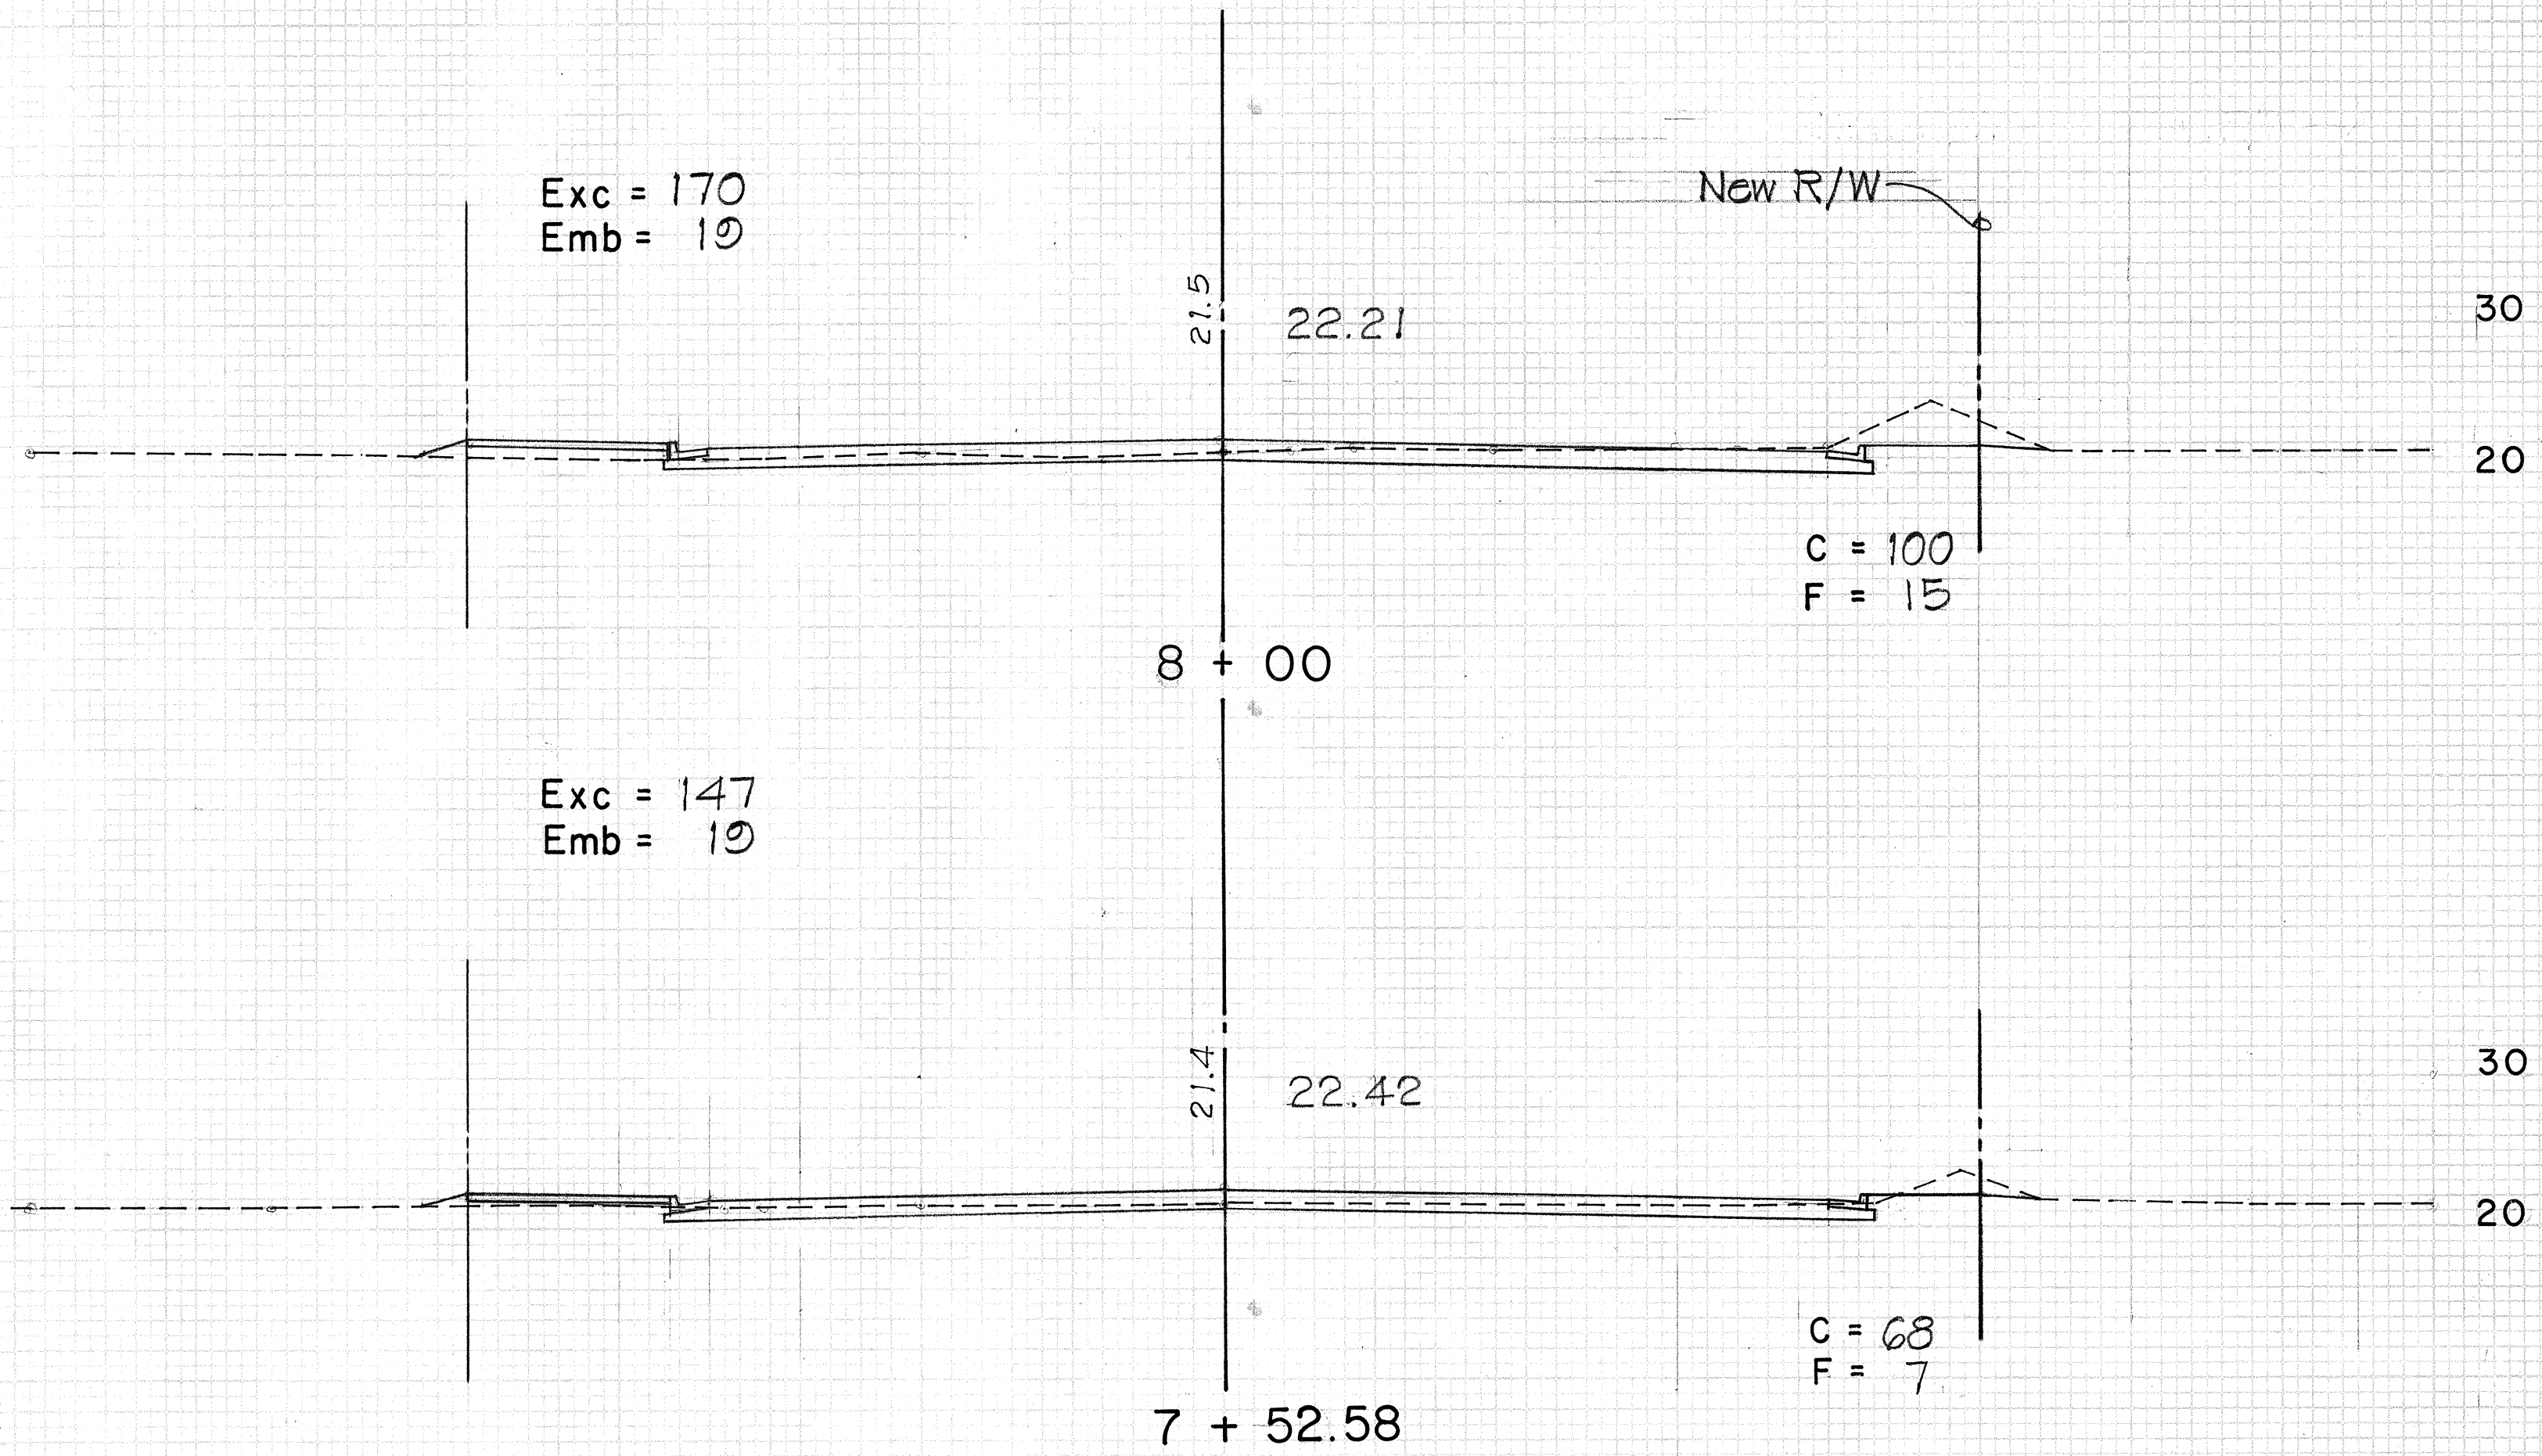



70 60 50 40 30 20 10 0 10 20 30 40 50 60 70

FINAL SURVEY	SURVEYED	BY	DATE
NOTE BOOK	PLOTTED		
NO.	AREAS CHECKED		


ORIGINAL SURVEY	SURVEYED	BY	DATE
NOTE BOOK	PLOTTED		
NO.	AREAS CHECKED		

FED. ROAD DIST. NO.	STATE	FED. AID PROJ. NO.	FISCAL YEAR	SHEET NO.	TOTAL SHEETS
HAWAII	HAW.	F-076-1(2) 6- RS-076002 R/W	1990	133	148

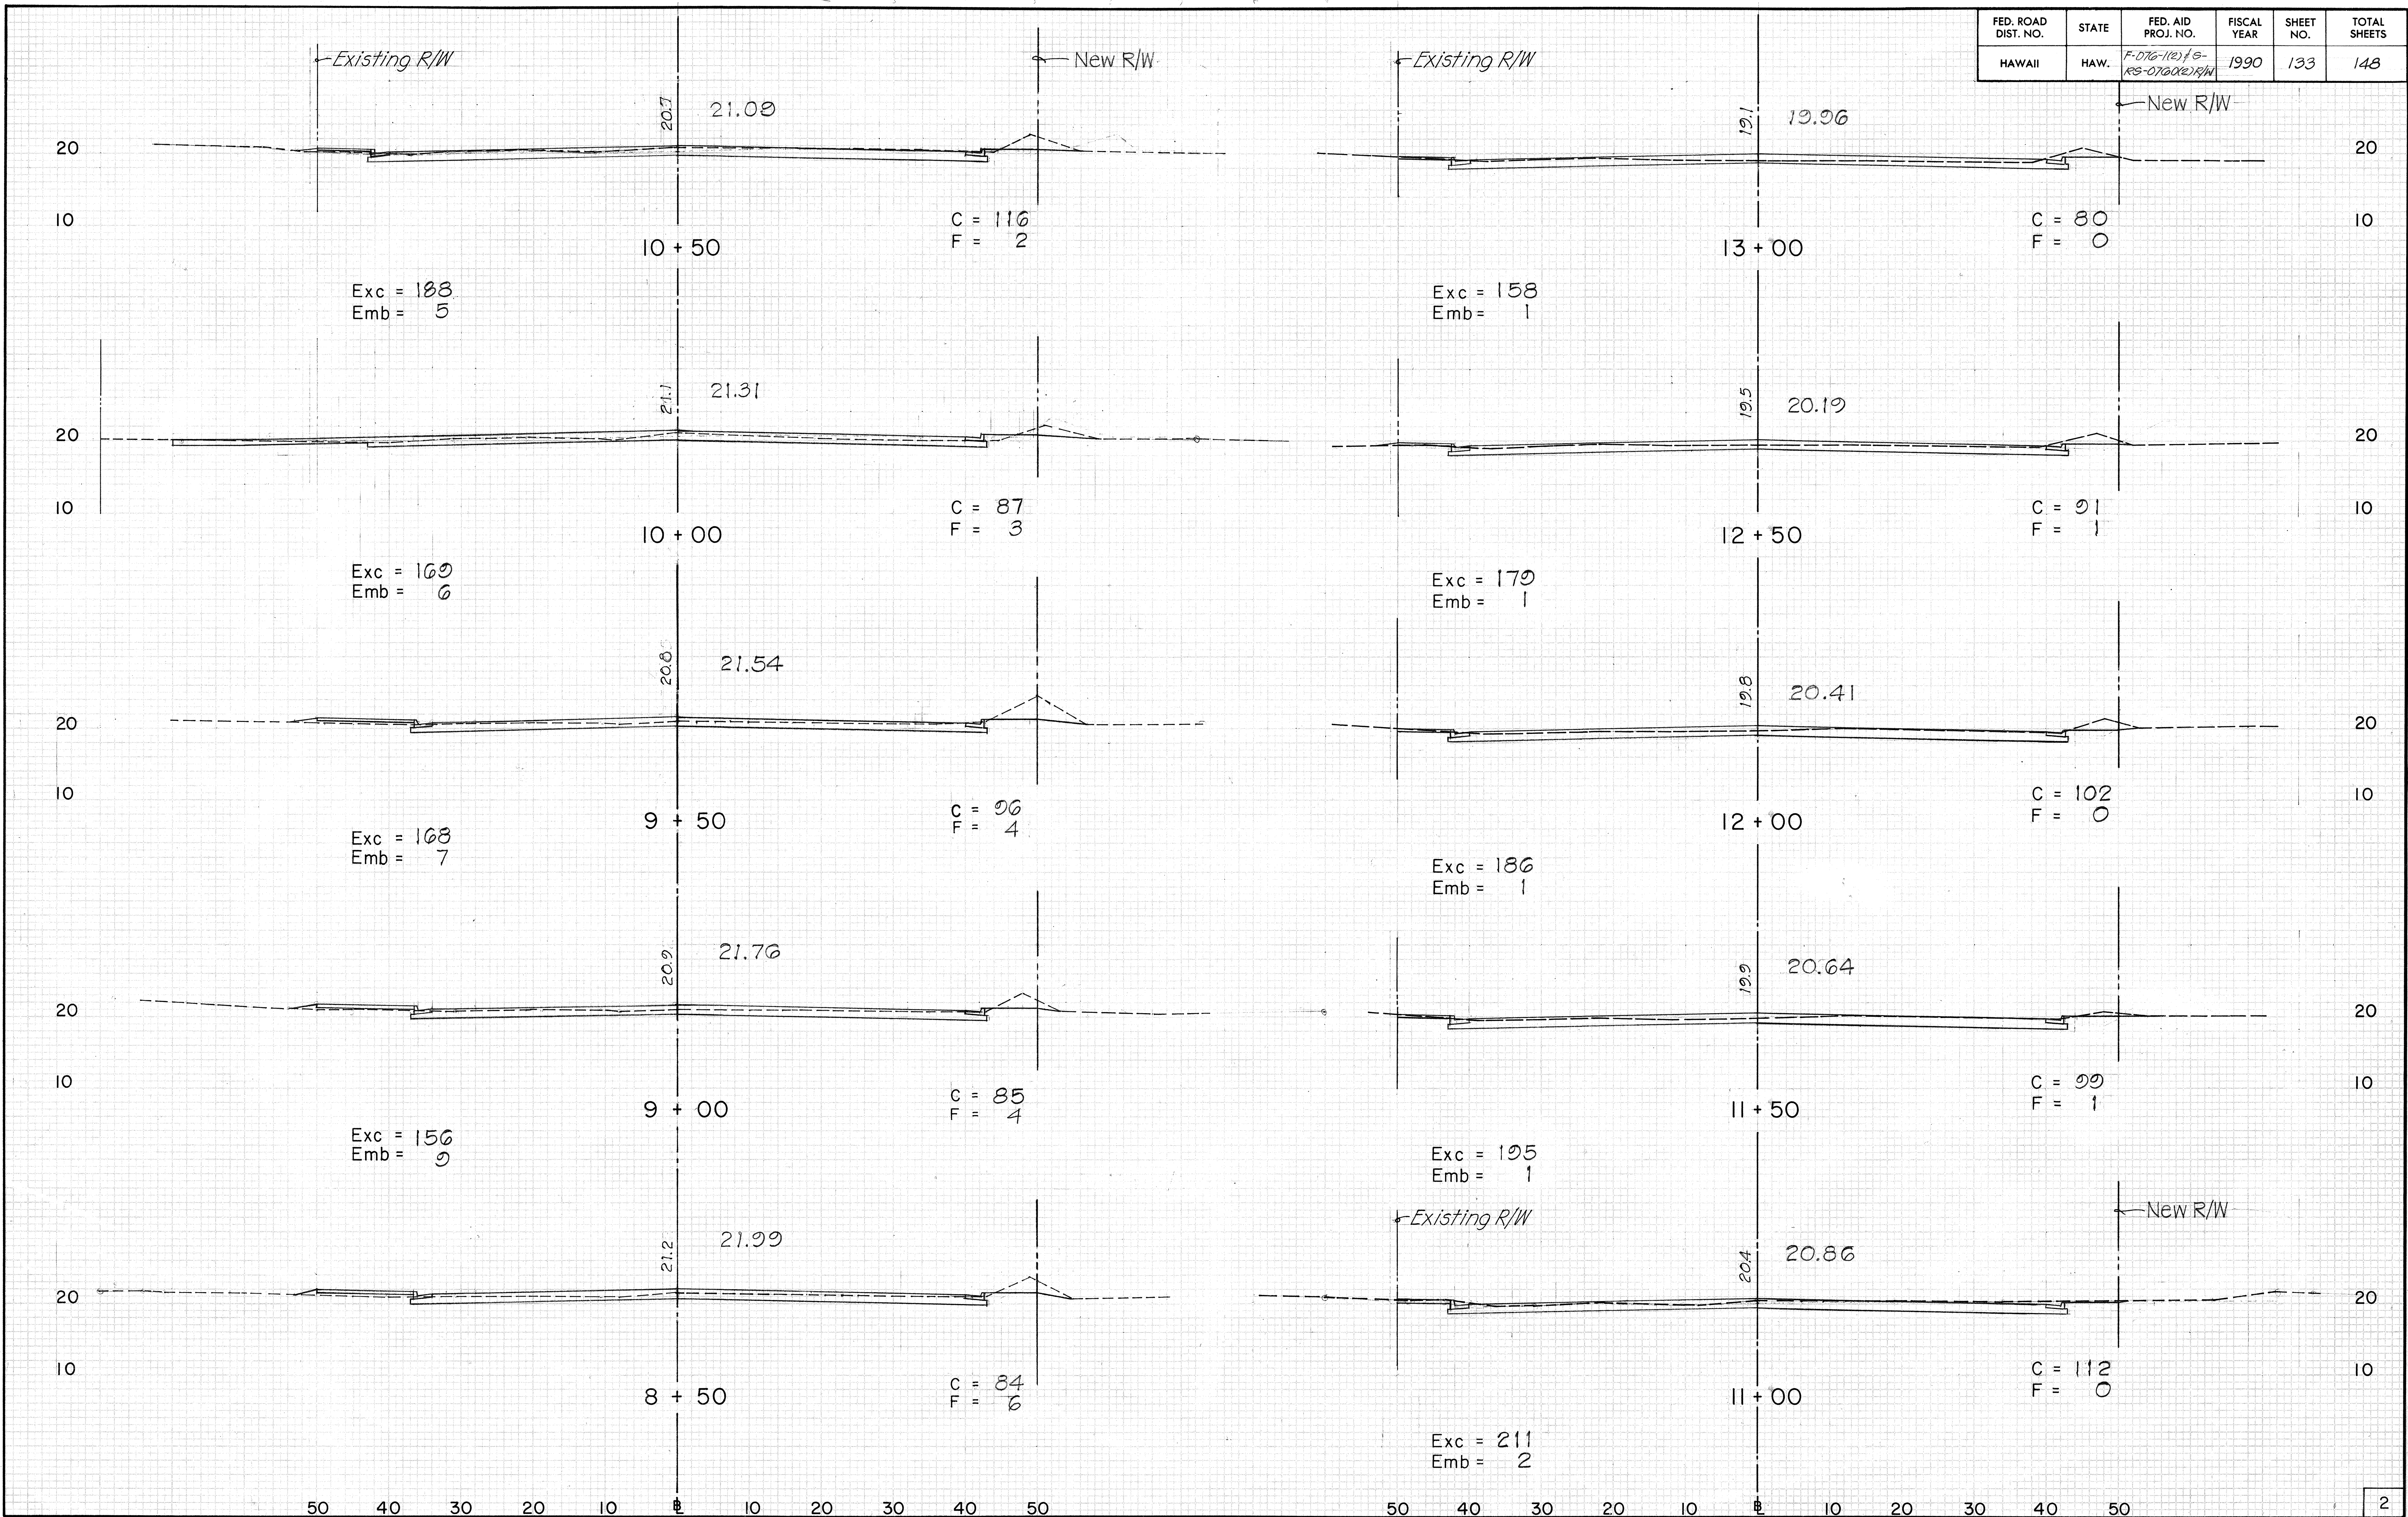

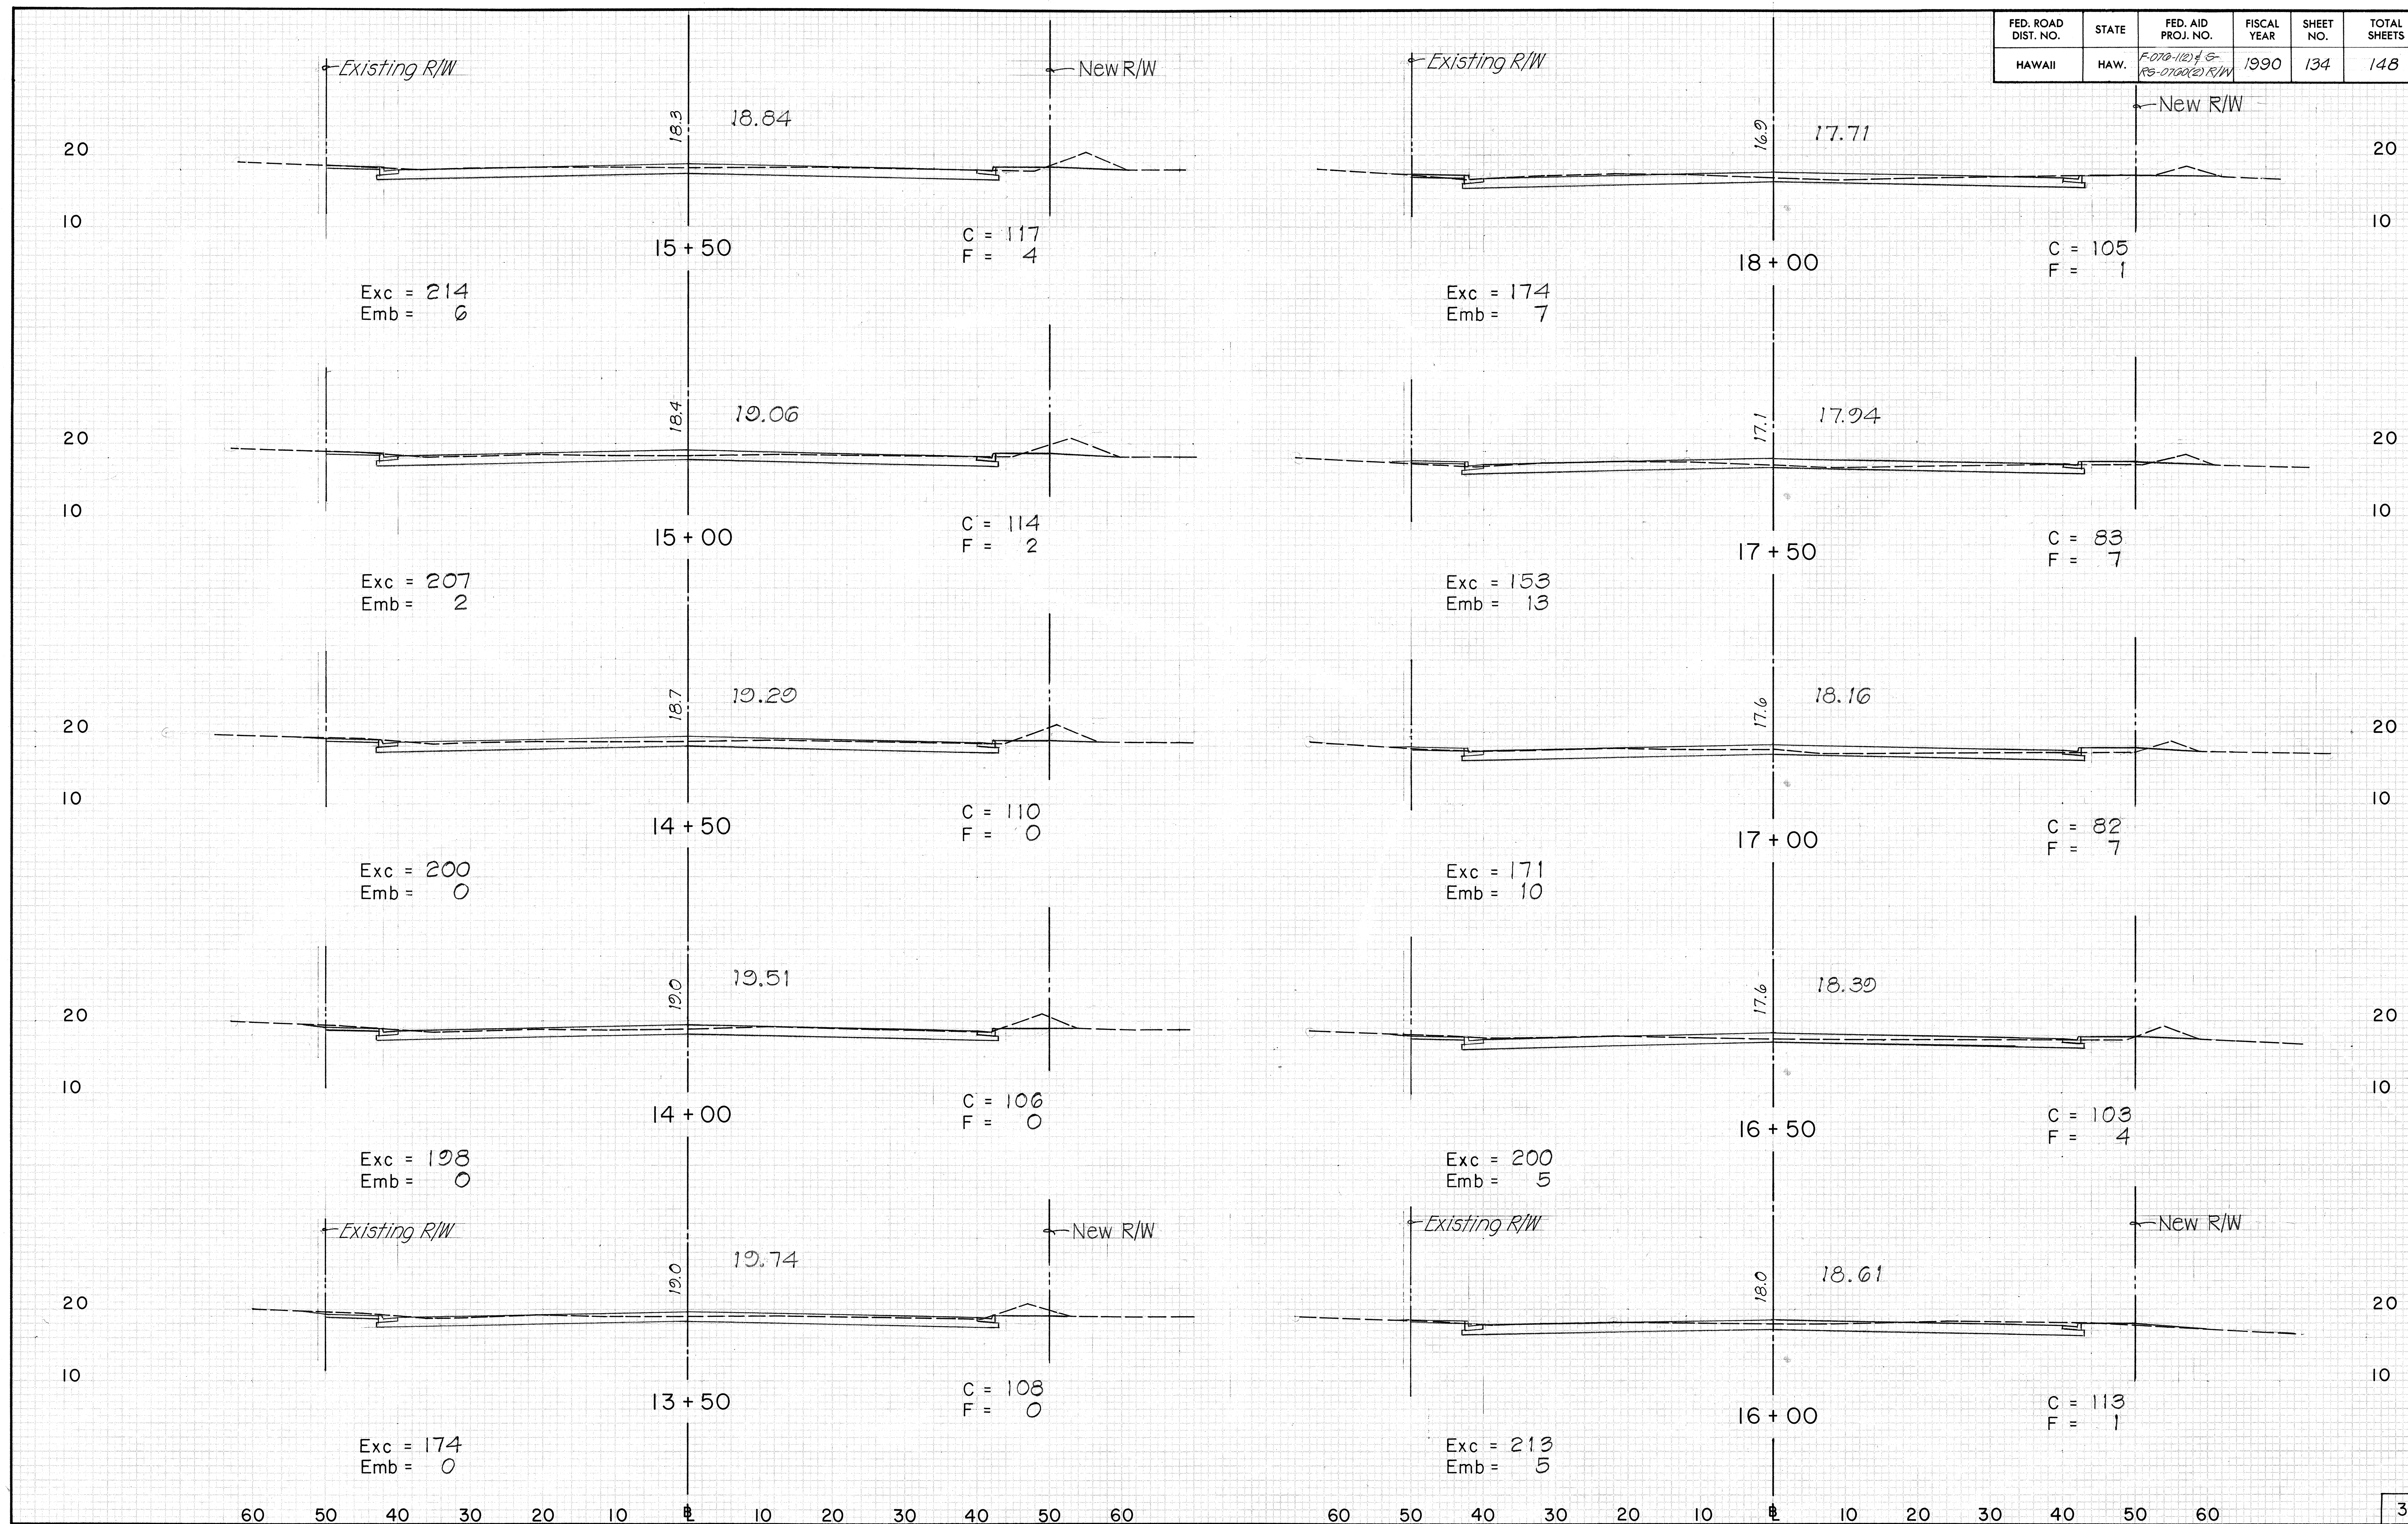


FED. ROAD DIST. NO.	STATE	FED. AID PROJ. NO.	FISCAL YEAR	SHEET NO.	TOTAL SHEETS
HAWAII	HAW.	F-070-1(2) & S-KS-07001(2) R/W	1990	135	148

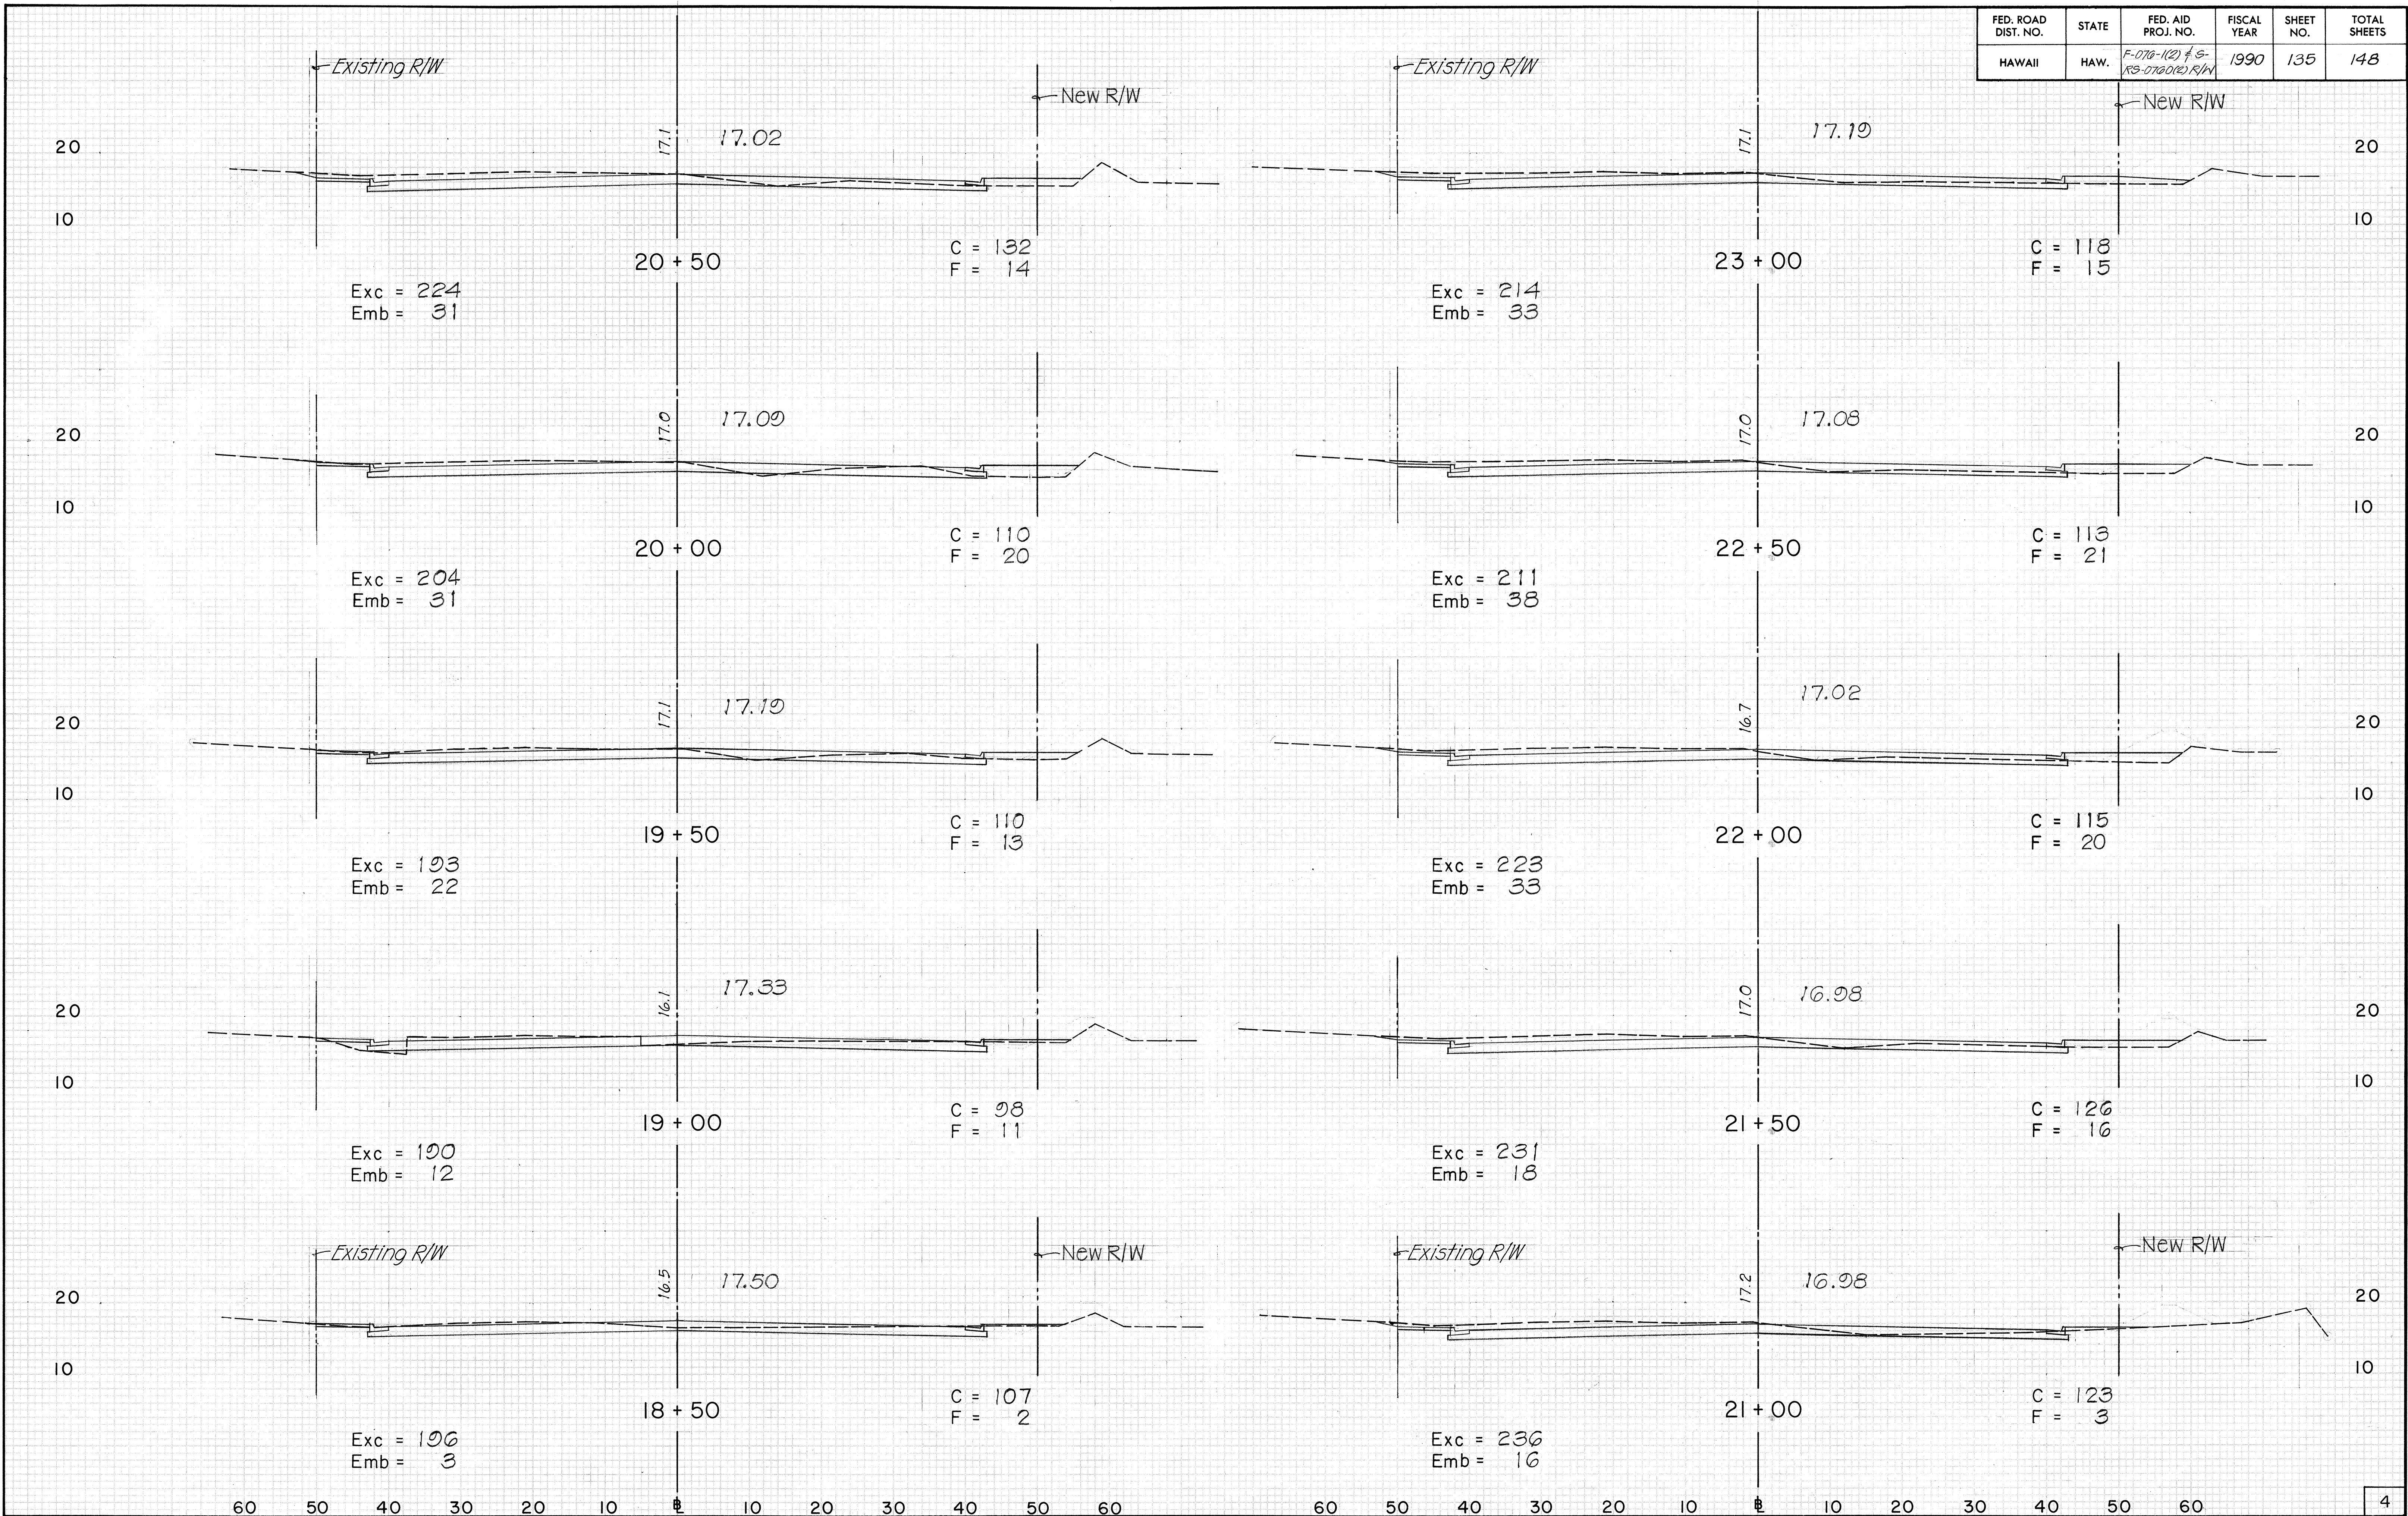


FED. ROAD DIST. NO.	STATE	FED. AID PROJ. NO.	FISCAL YEAR	SHEET NO.	TOTAL SHEETS
HAWAII	HAW.	F.D.T.G. (12) F.S. RS-D760(12) R/W	1990	136	148

DATE	BY	DATE	BY
SURVEY	PLOTTED	SURVEY	PLOTTED
NOTE BOOK	TEMPLATE	NOTE BOOK	TEMPLATE
NO.	AREAS CHECKED	NO.	AREAS CHECKED

DATE	BY	DATE	BY
SURVEY	PLOTTED	SURVEY	PLOTTED
NOTE BOOK	TEMPLATE	NOTE BOOK	TEMPLATE
NO.	AREAS CHECKED	NO.	AREAS CHECKED

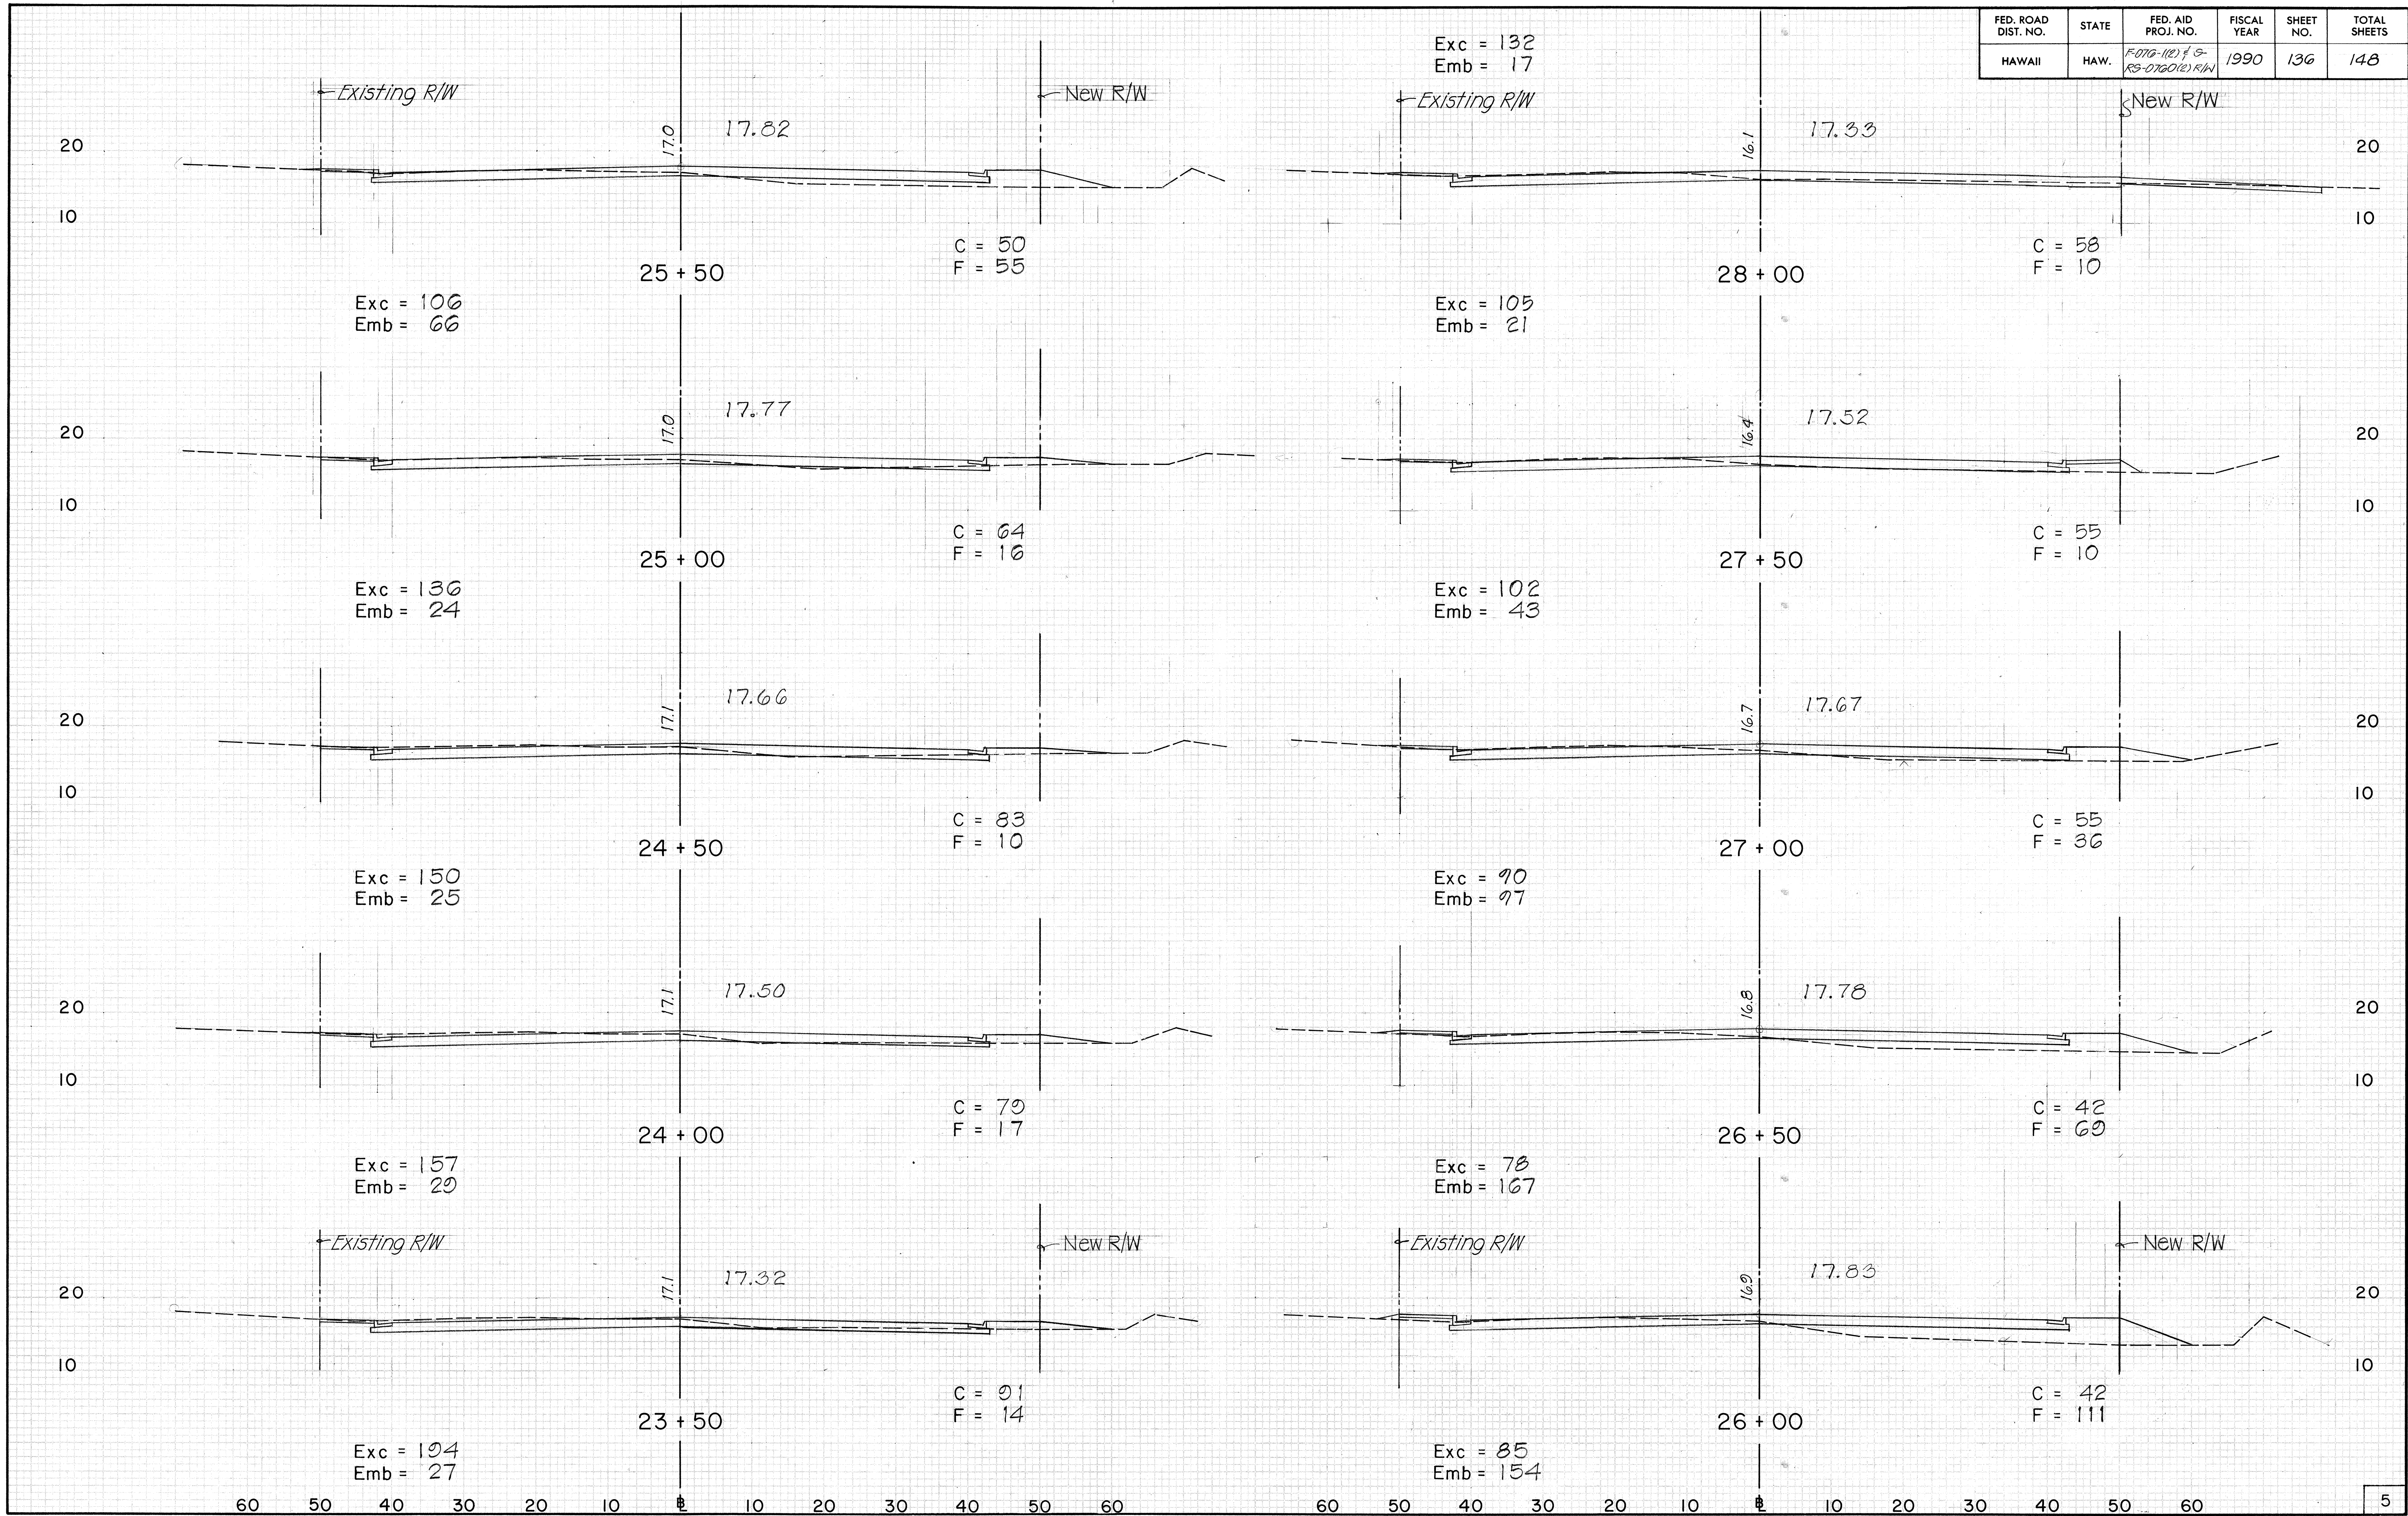


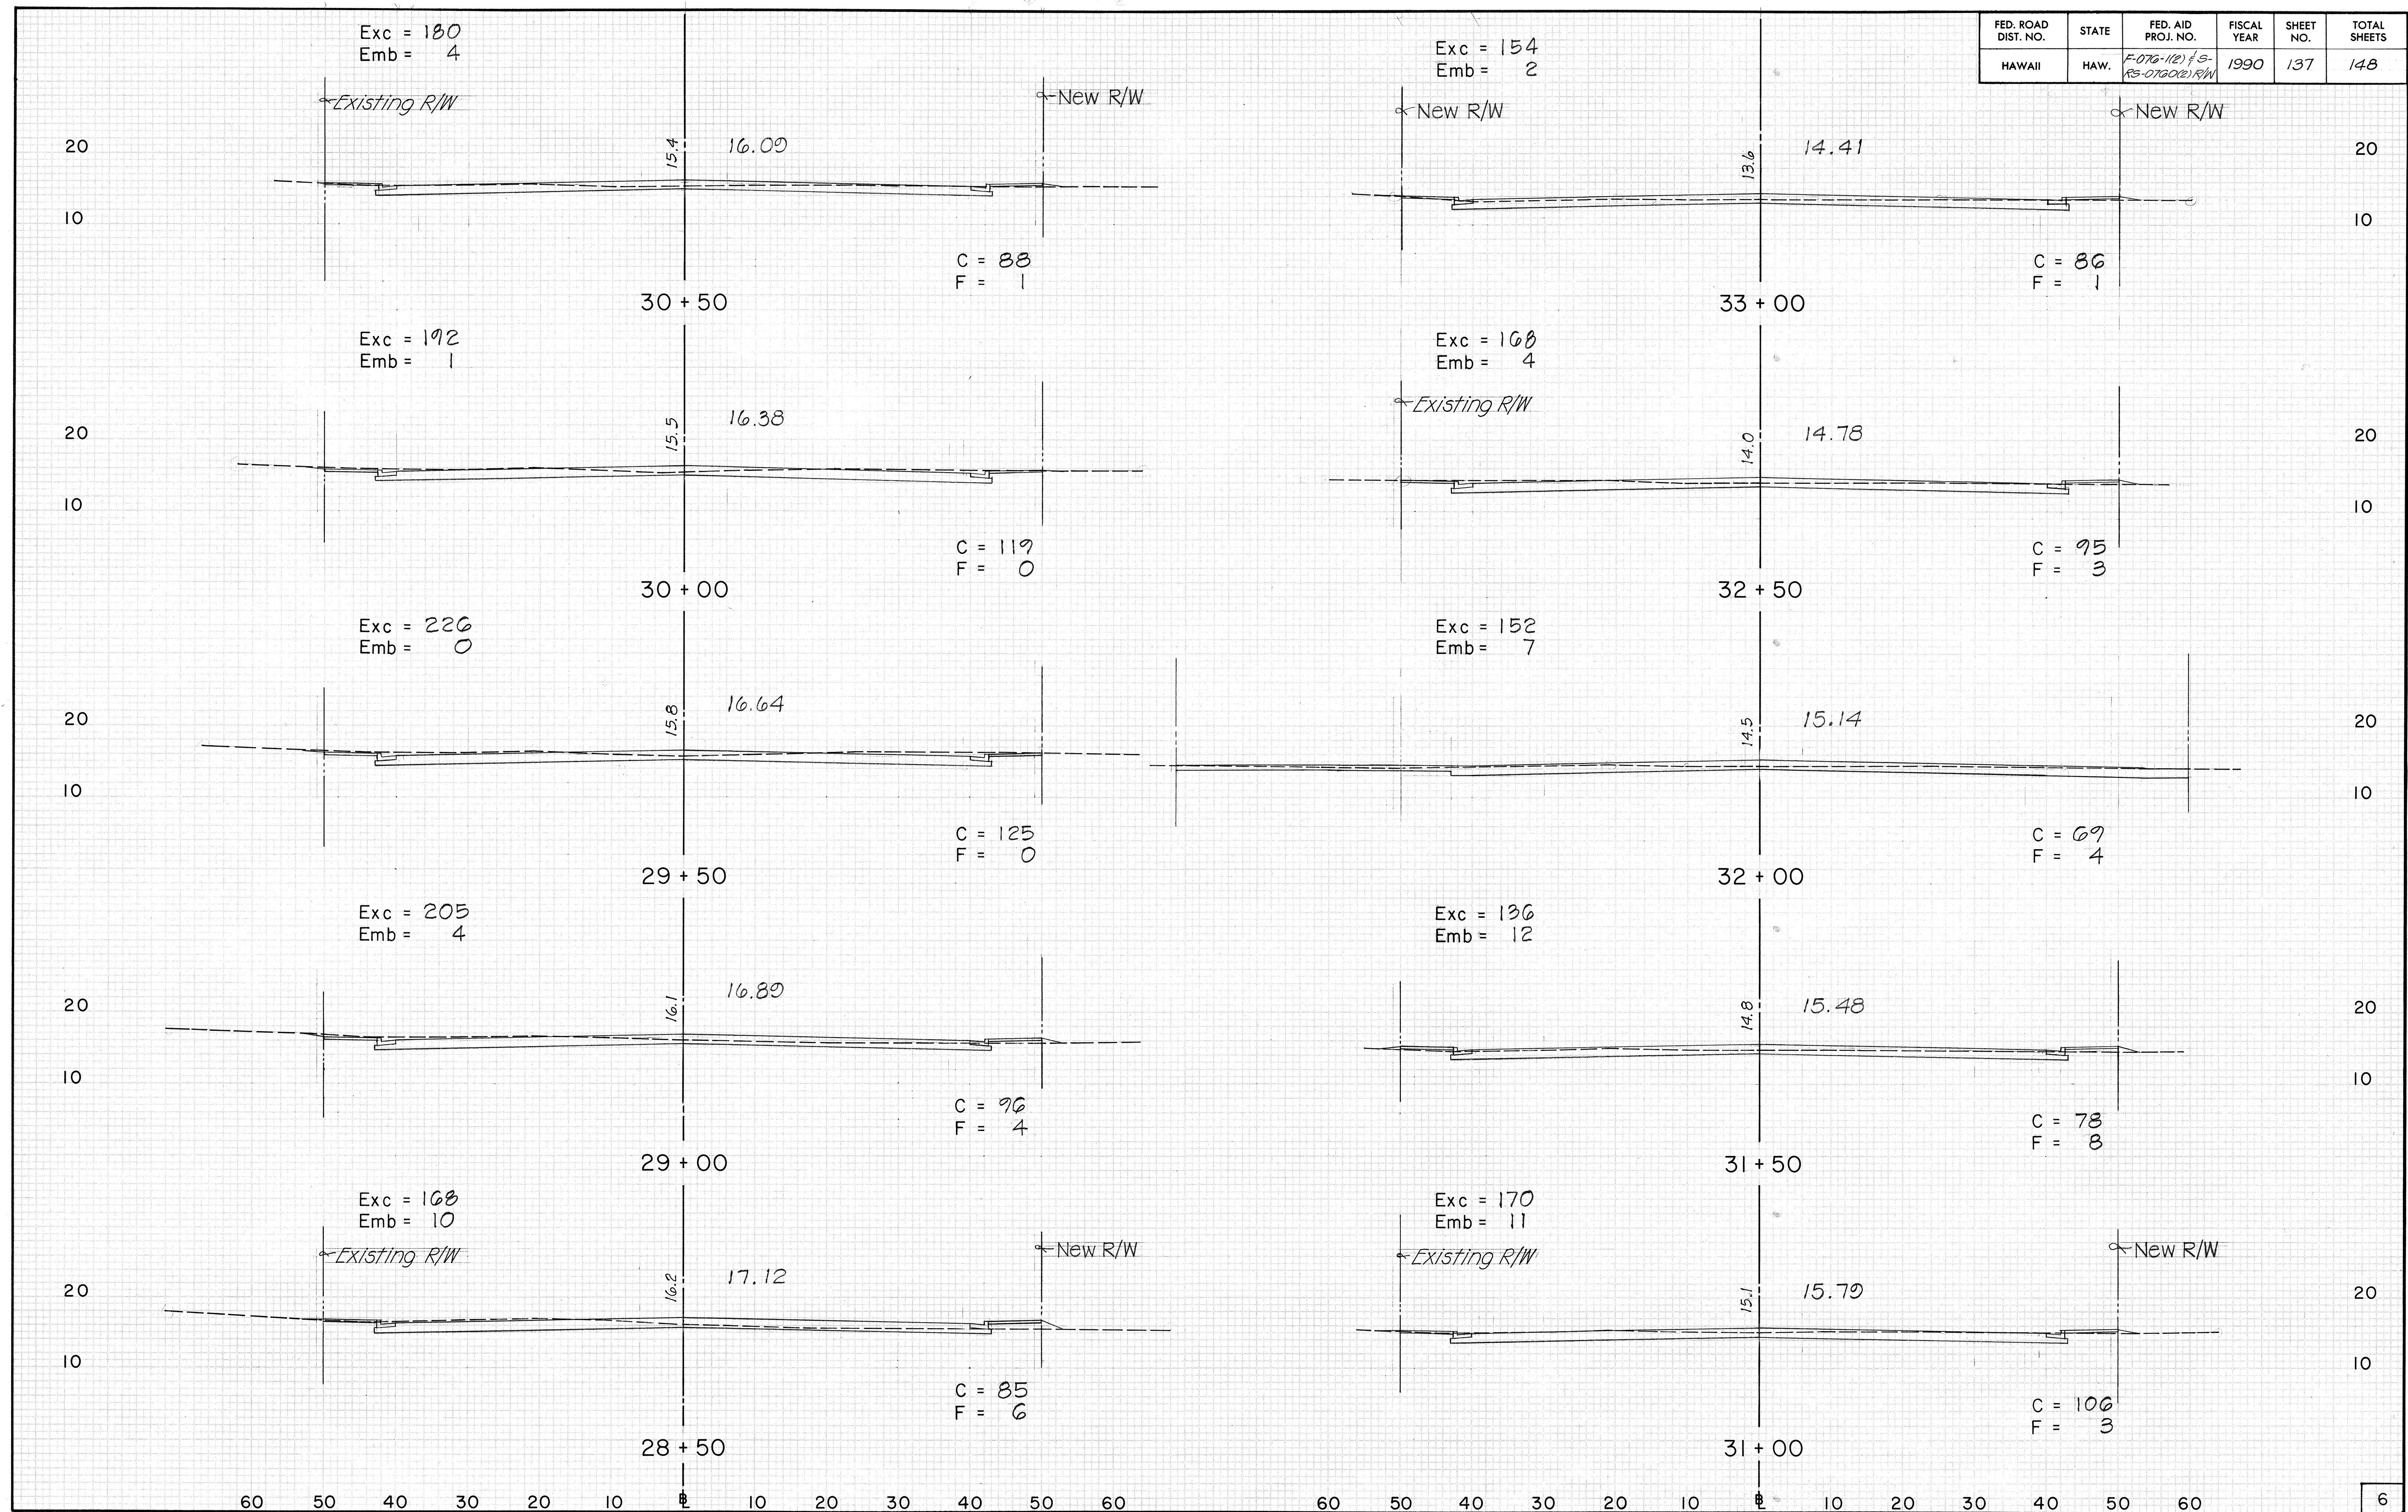


DATE	
BY	
REVIEWED	
PLOTTED	
NOTED	
NO.	

DATE	
BY	
REVIEWED	
PLOTTED	
NOTED	
NO.	

FED. ROAD DIST. NO.	STATE	FED. AID PROJ. NO.	FISCAL YEAR	SHEET NO.	TOTAL SHEETS
HAWAII	HAW.	F-070-112) & S- RS-070(2) R/W	1990	138	148

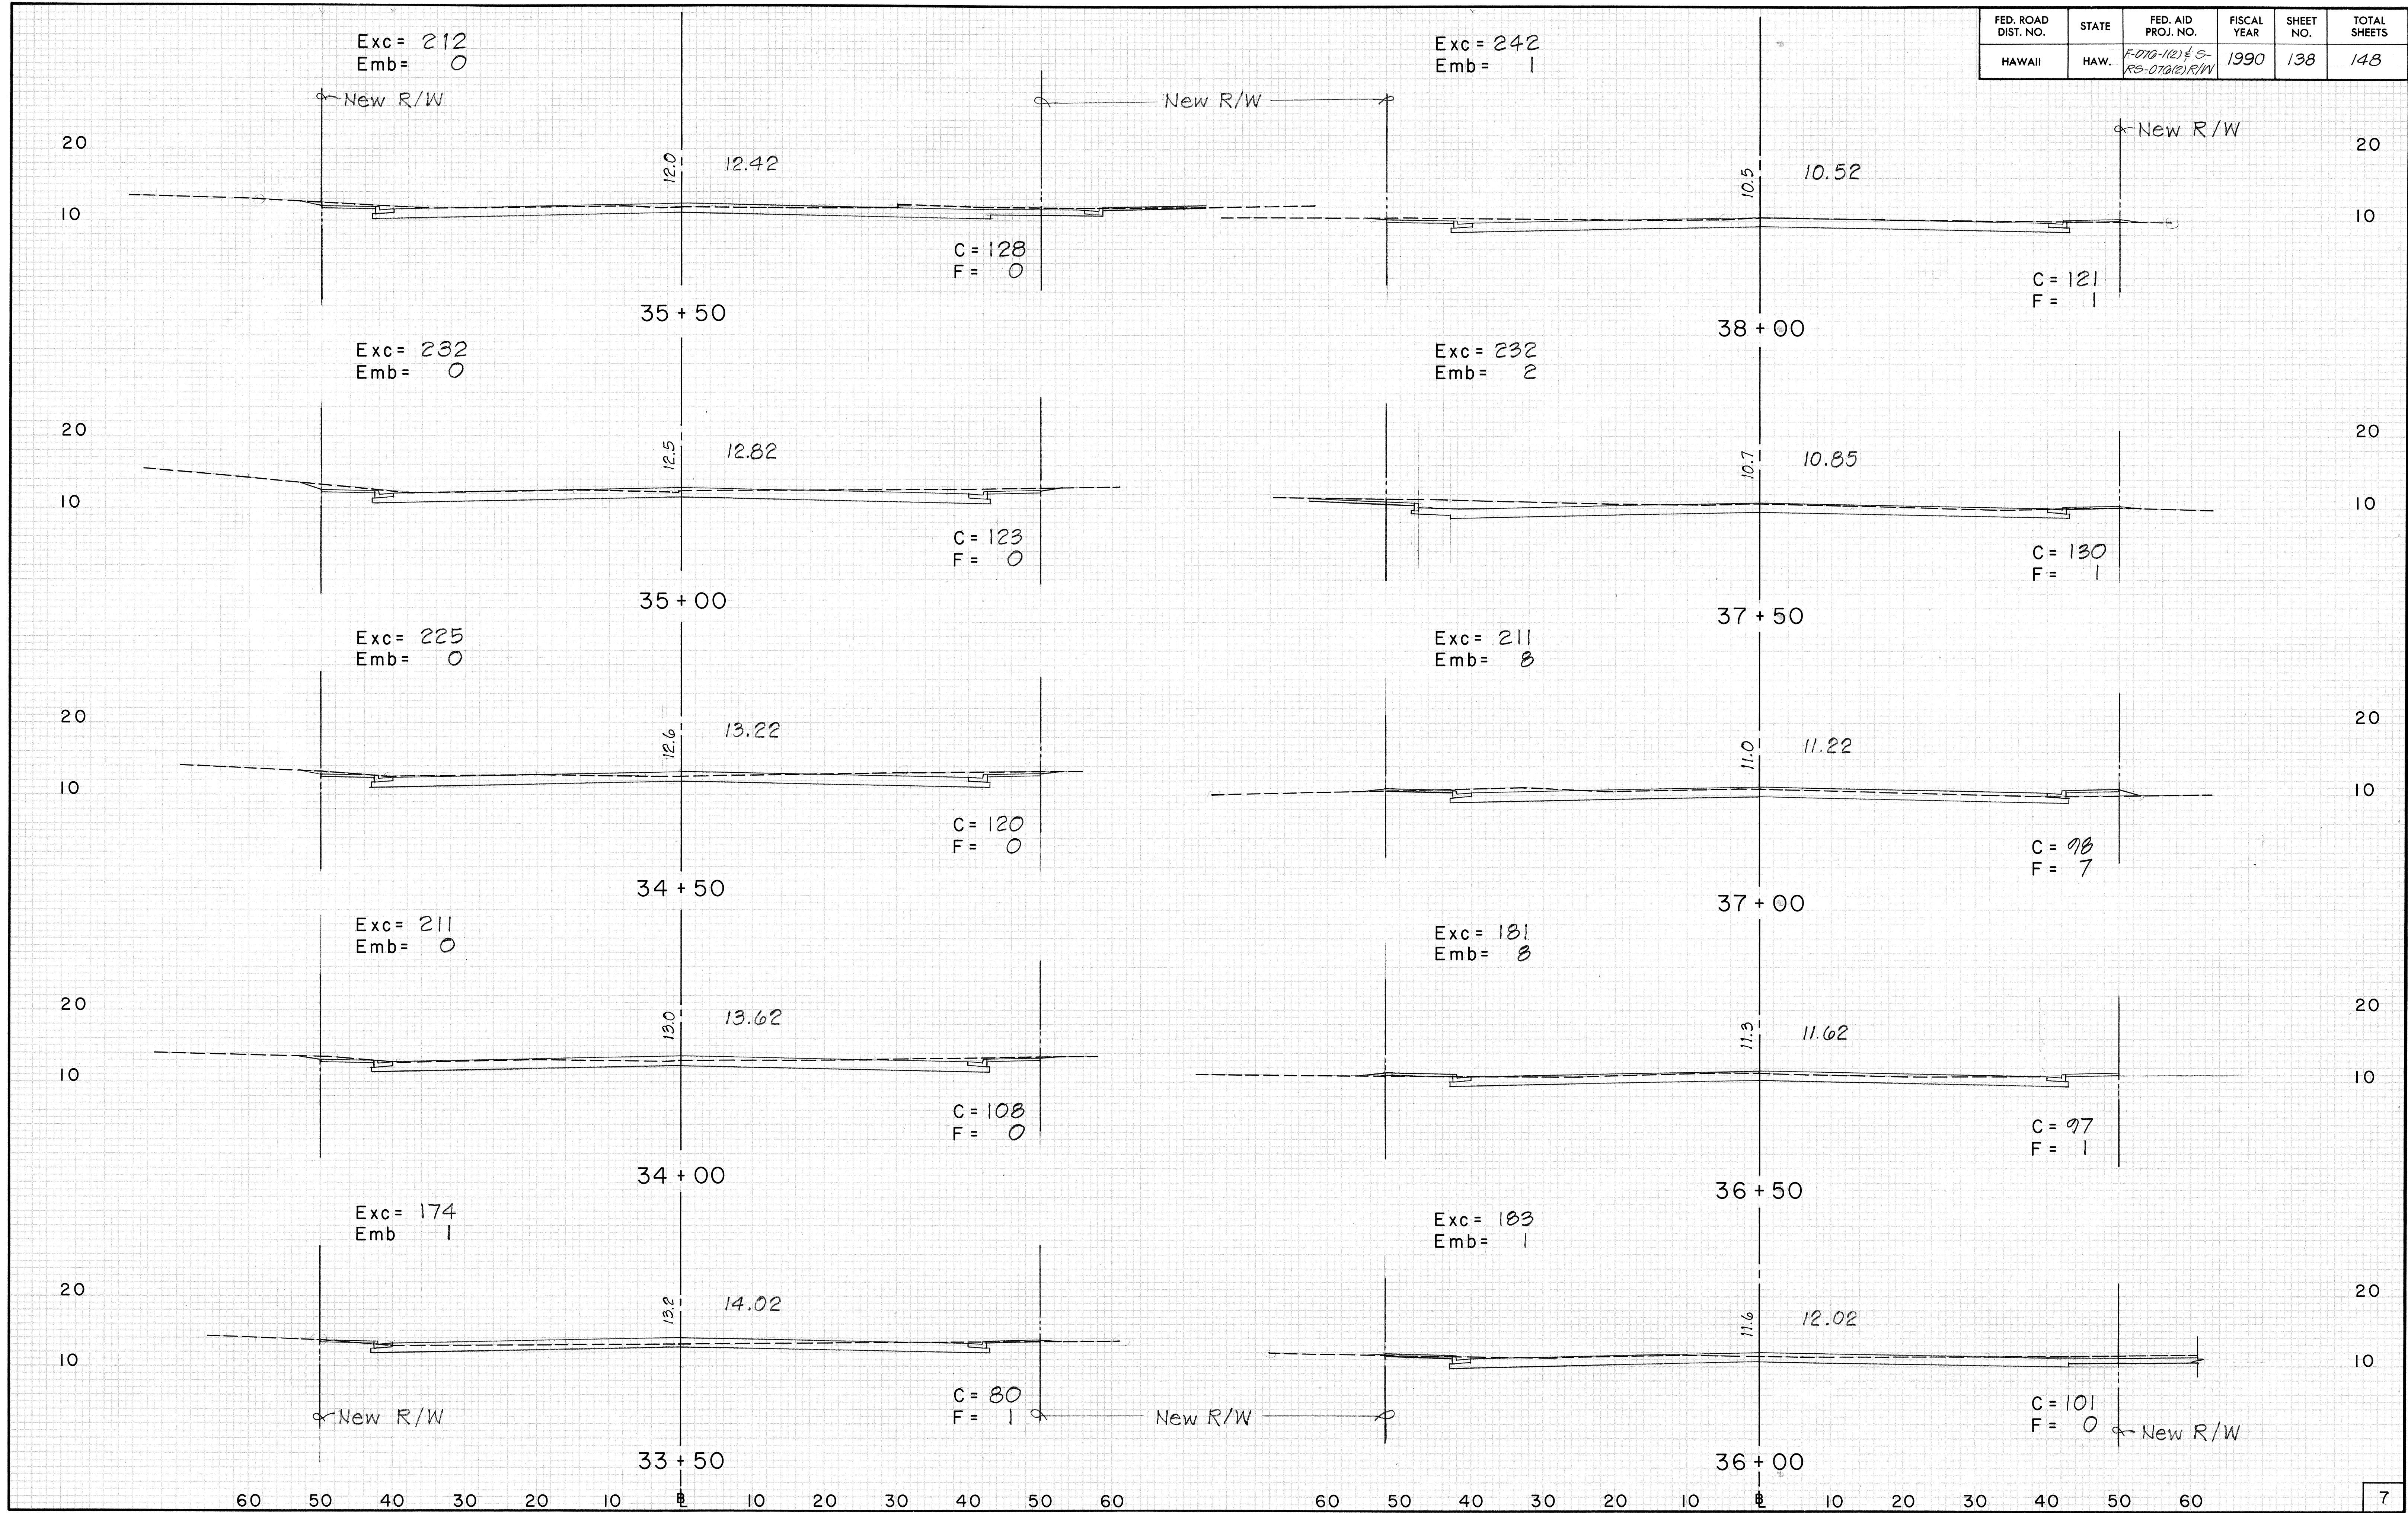


FED. ROAD DIST. NO.	STATE	FED. AID PROJ. NO.	FISCAL YEAR	SHEET NO.	TOTAL SHEETS
HAWAII	HAW.	F-07G-1(2) & S- RS-07G0(2) R/W	1990	139	148

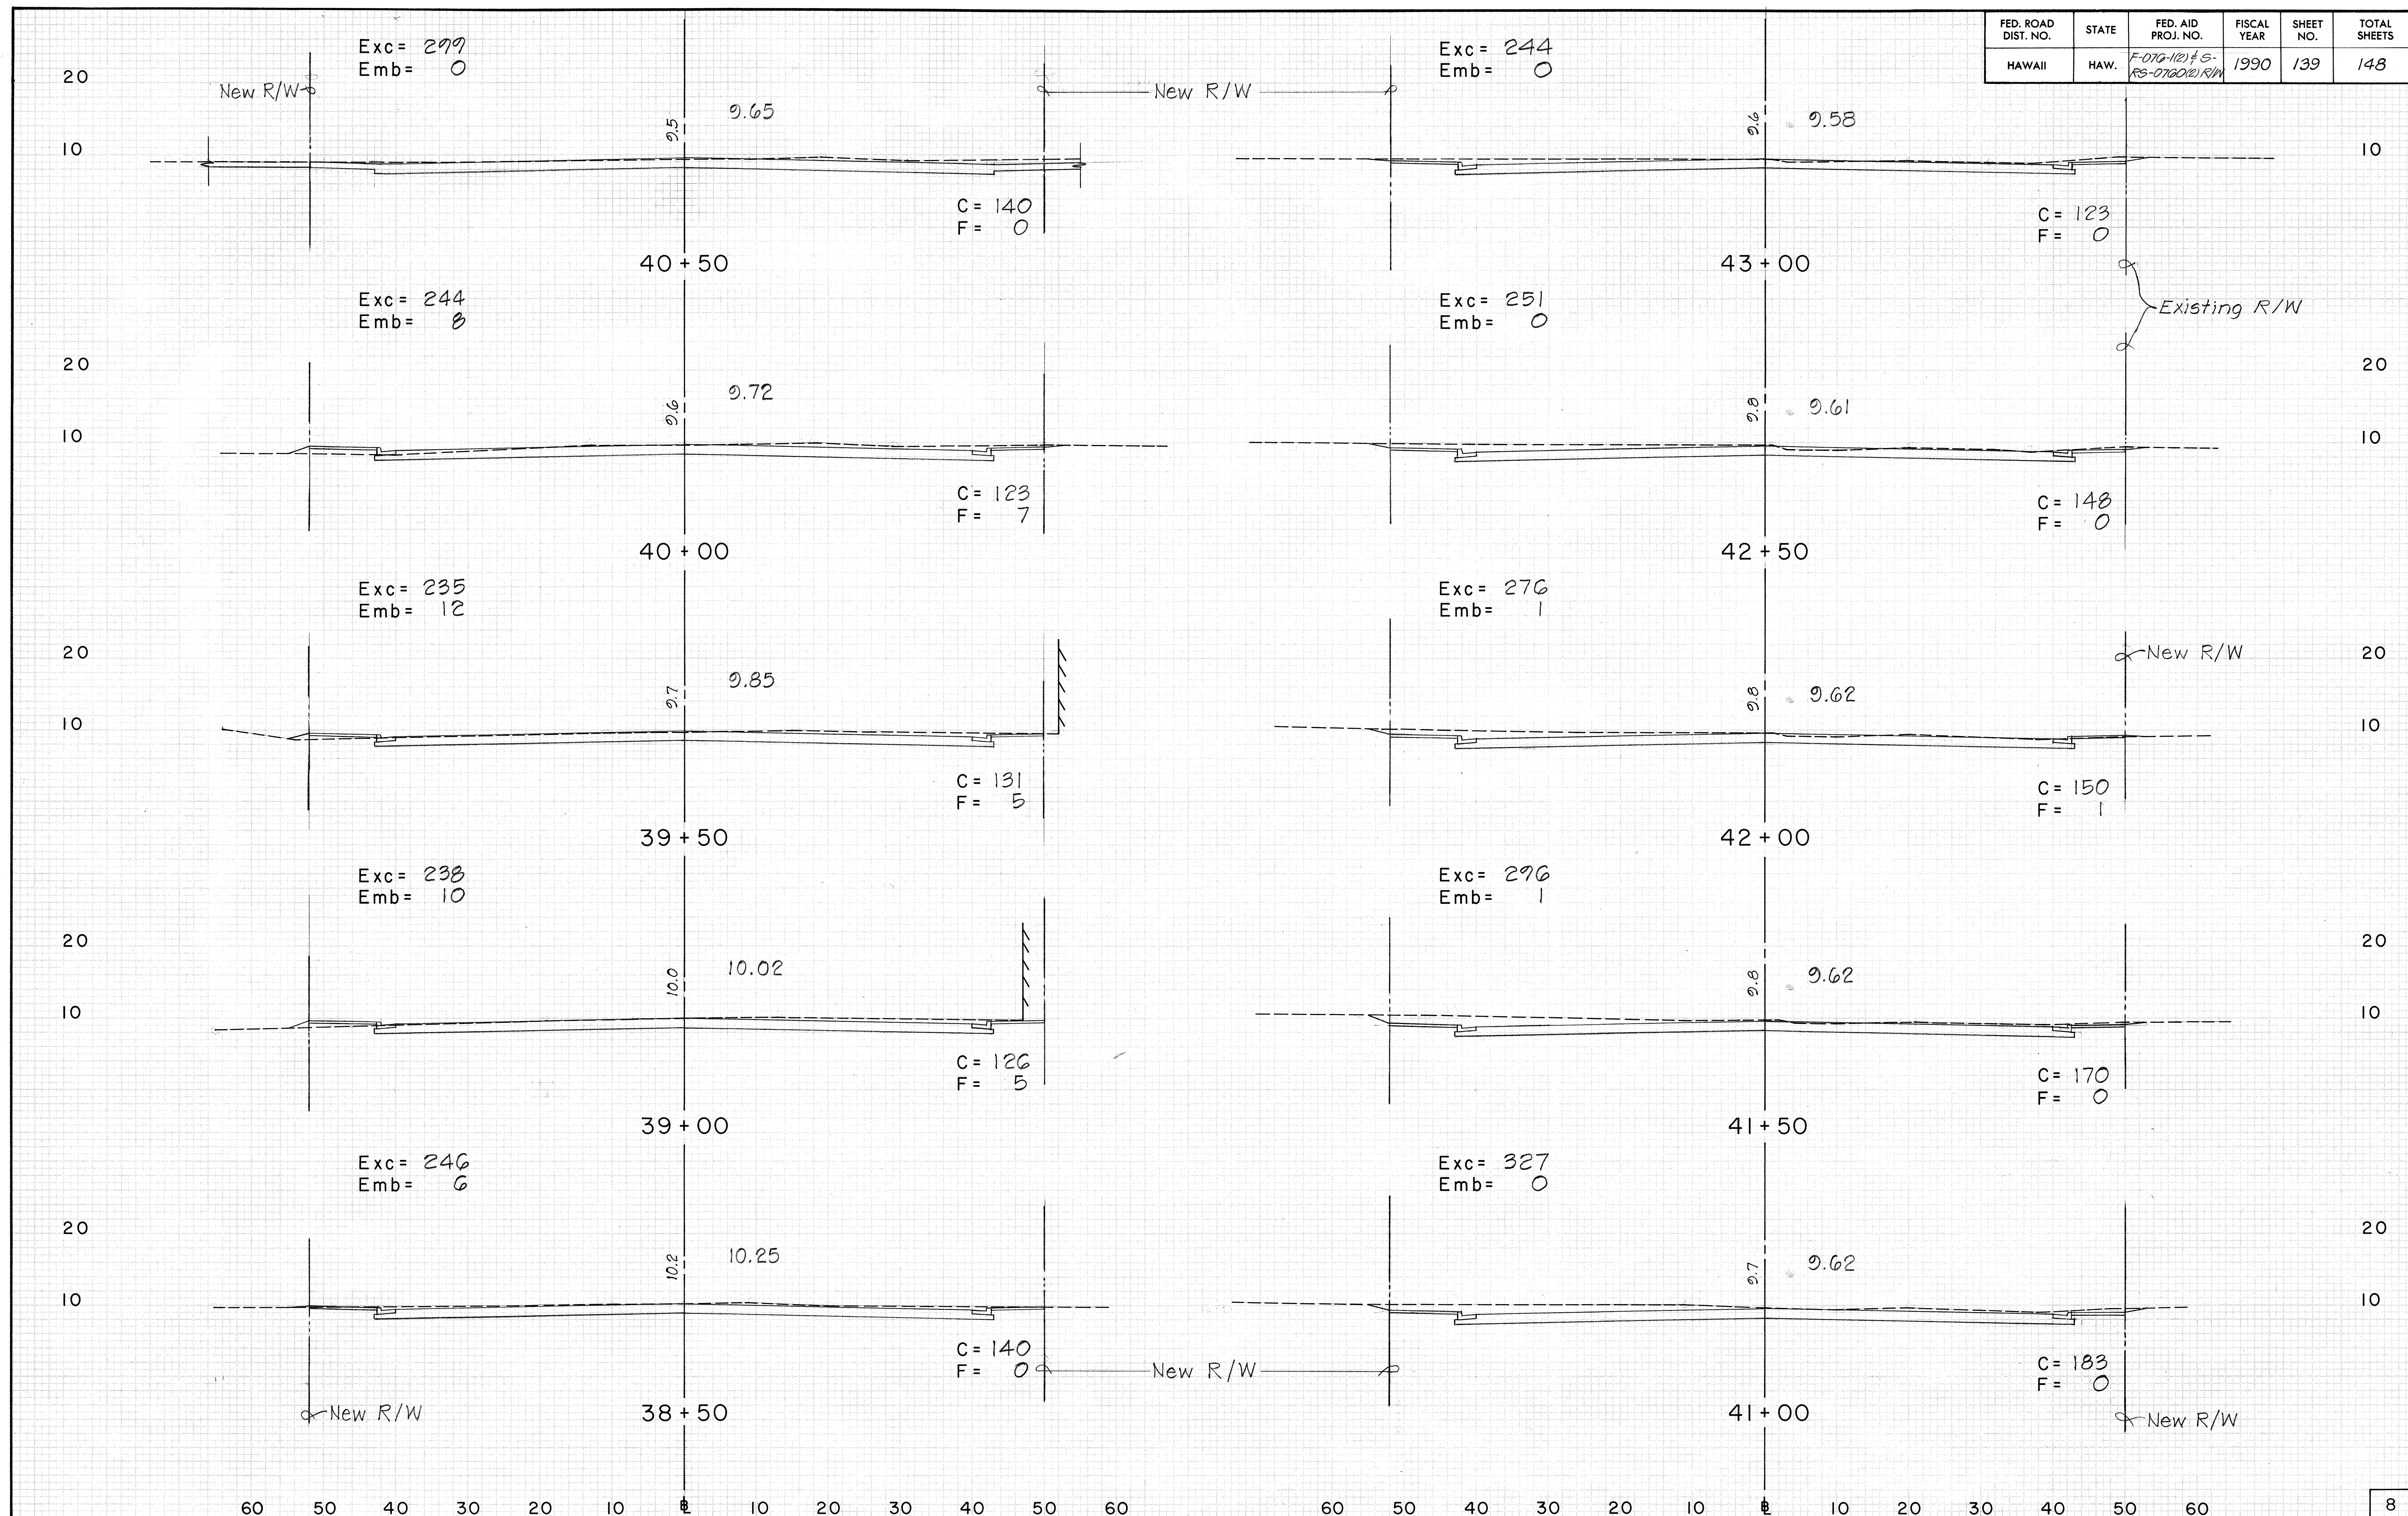

FED. ROAD DIST. NO.	STATE	FED. AID PROJ. NO.	FISCAL YEAR	SHEET NO.	TOTAL SHEETS
HAWAII	HAW.	F-070-102/S- RS-070012/R/W	1990	141	148

DATE	BY	CHK'D
DESIGNED	SURVEYED	PLOTTED
NOTE BOOK	TEMPLATE	
NO.	AREA CHECKED	


DATE	BY	CHK'D
DESIGNED	SURVEYED	PLOTTED
NOTE BOOK	TEMPLATE	
NO.	AREA CHECKED	

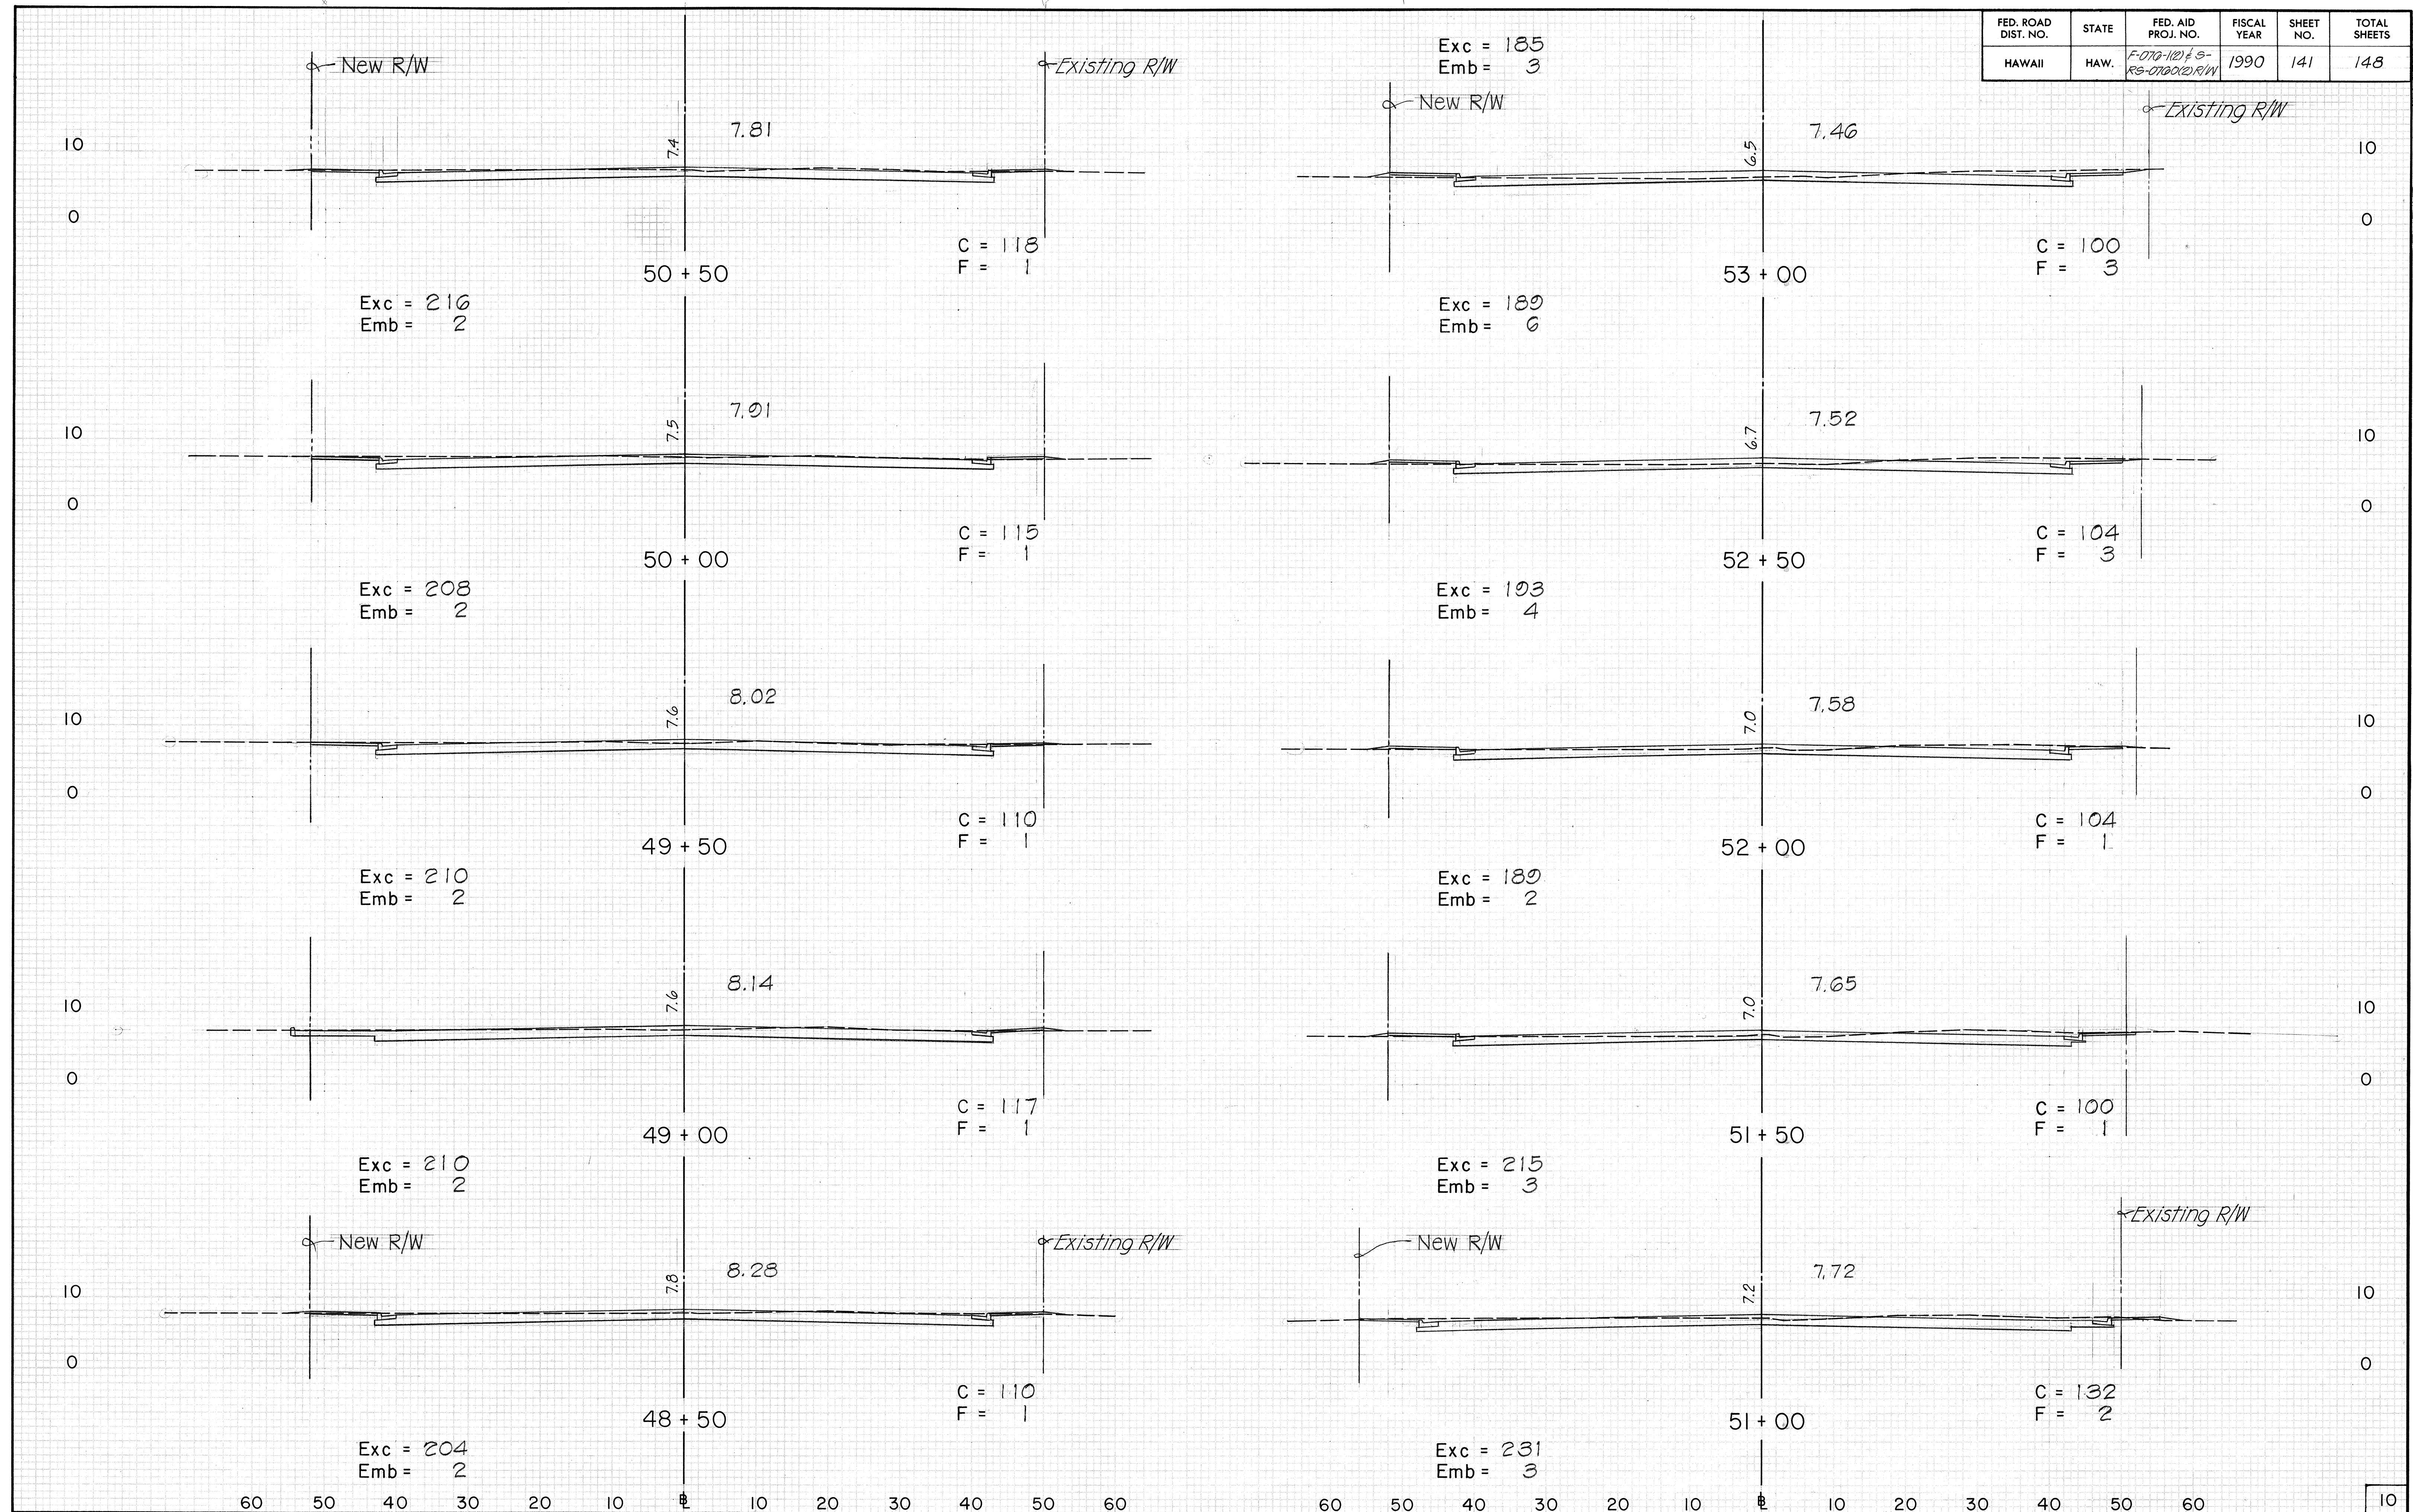

FED. ROAD DIST. NO.	STATE	FED. AID PROJ. NO.	FISCAL YEAR	SHEET NO.	TOTAL SHEETS
HAWAII	HAW.	F-070-1021-5- R3-070021 R/W	1990	142	148

CHIEF	SURVEY	PLANNED	NO.
DATE	BY	DATE	BY
NO.	DATE	NO.	DATE


CHIEF	SURVEY	PLANNED	NO.
DATE	BY	DATE	BY
NO.	DATE	NO.	DATE

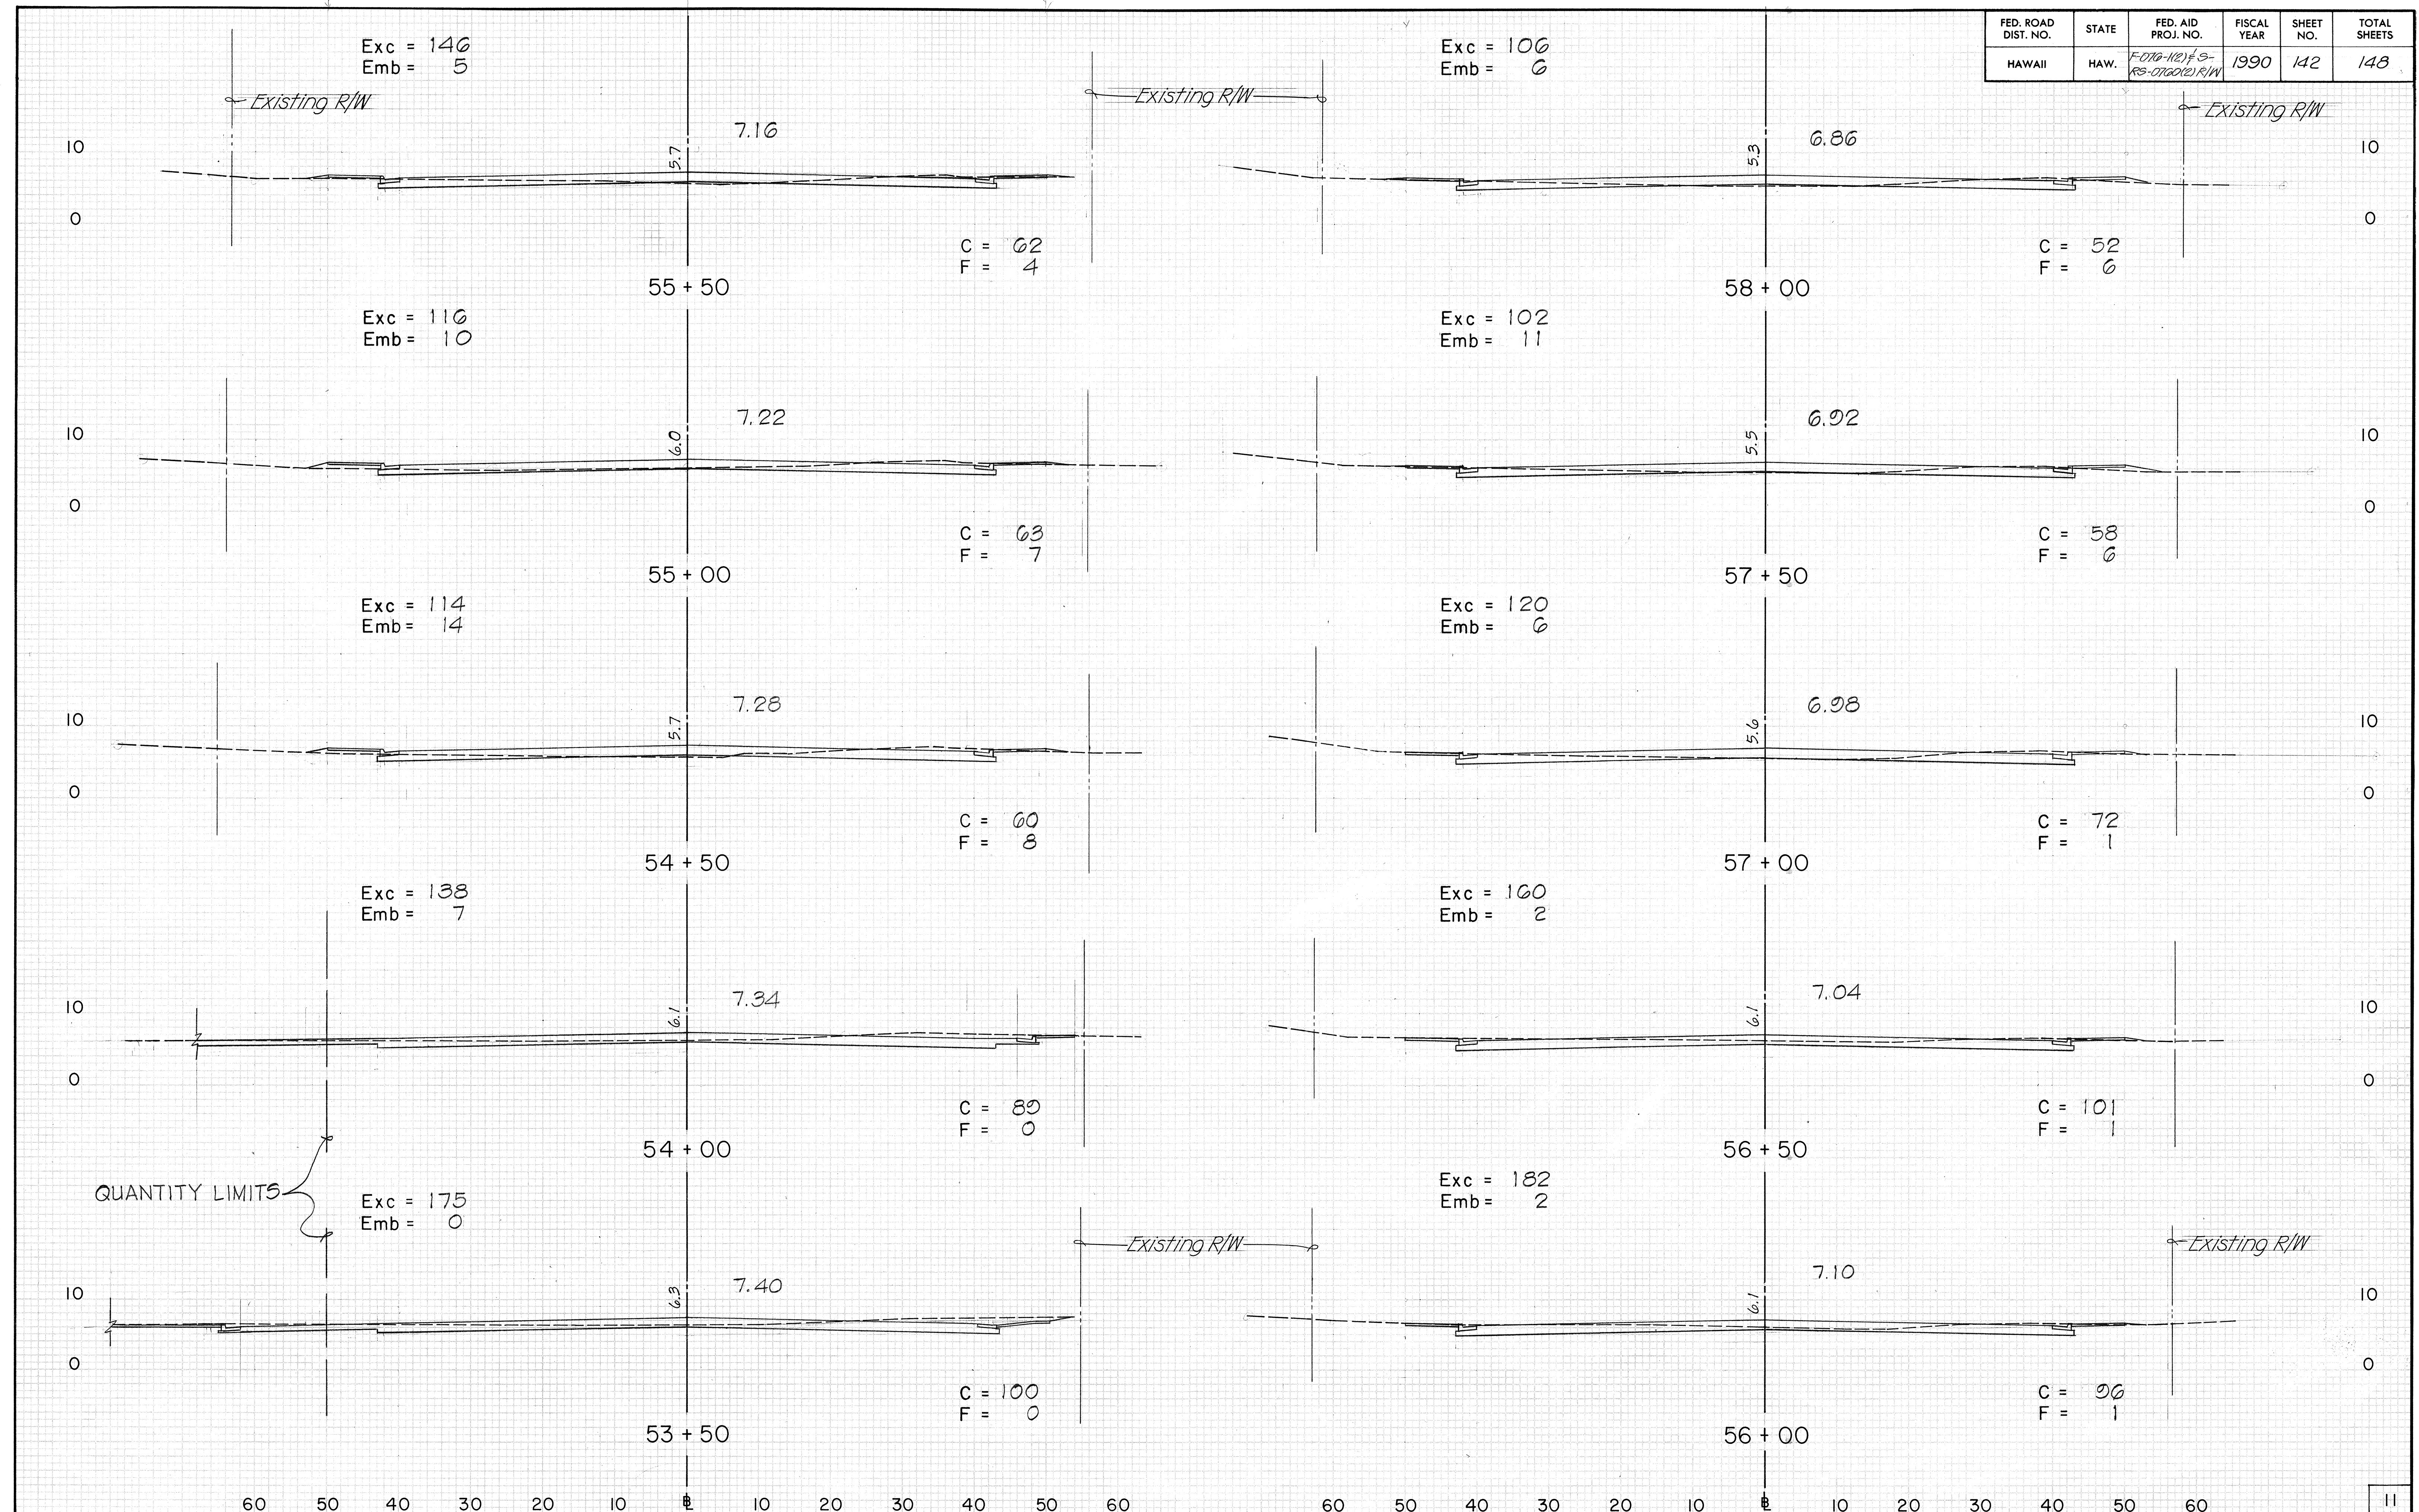

FED. ROAD DIST. NO.	STATE	FED. AID PROJ. NO.	FISCAL YEAR	SHEET NO.	TOTAL SHEETS
HAWAII	HAW.	F-076-1021-S- RS-076002(R/W)	1990	143	148

ORIGINAL SURVEY	SURVEY	DATE
NOTE BOOK	FLIGHT	
FIG.	AREA CHECKED	


ORIGINAL SURVEY	SURVEY	DATE
NOTE BOOK	FLIGHT	
FIG.	AREA CHECKED	

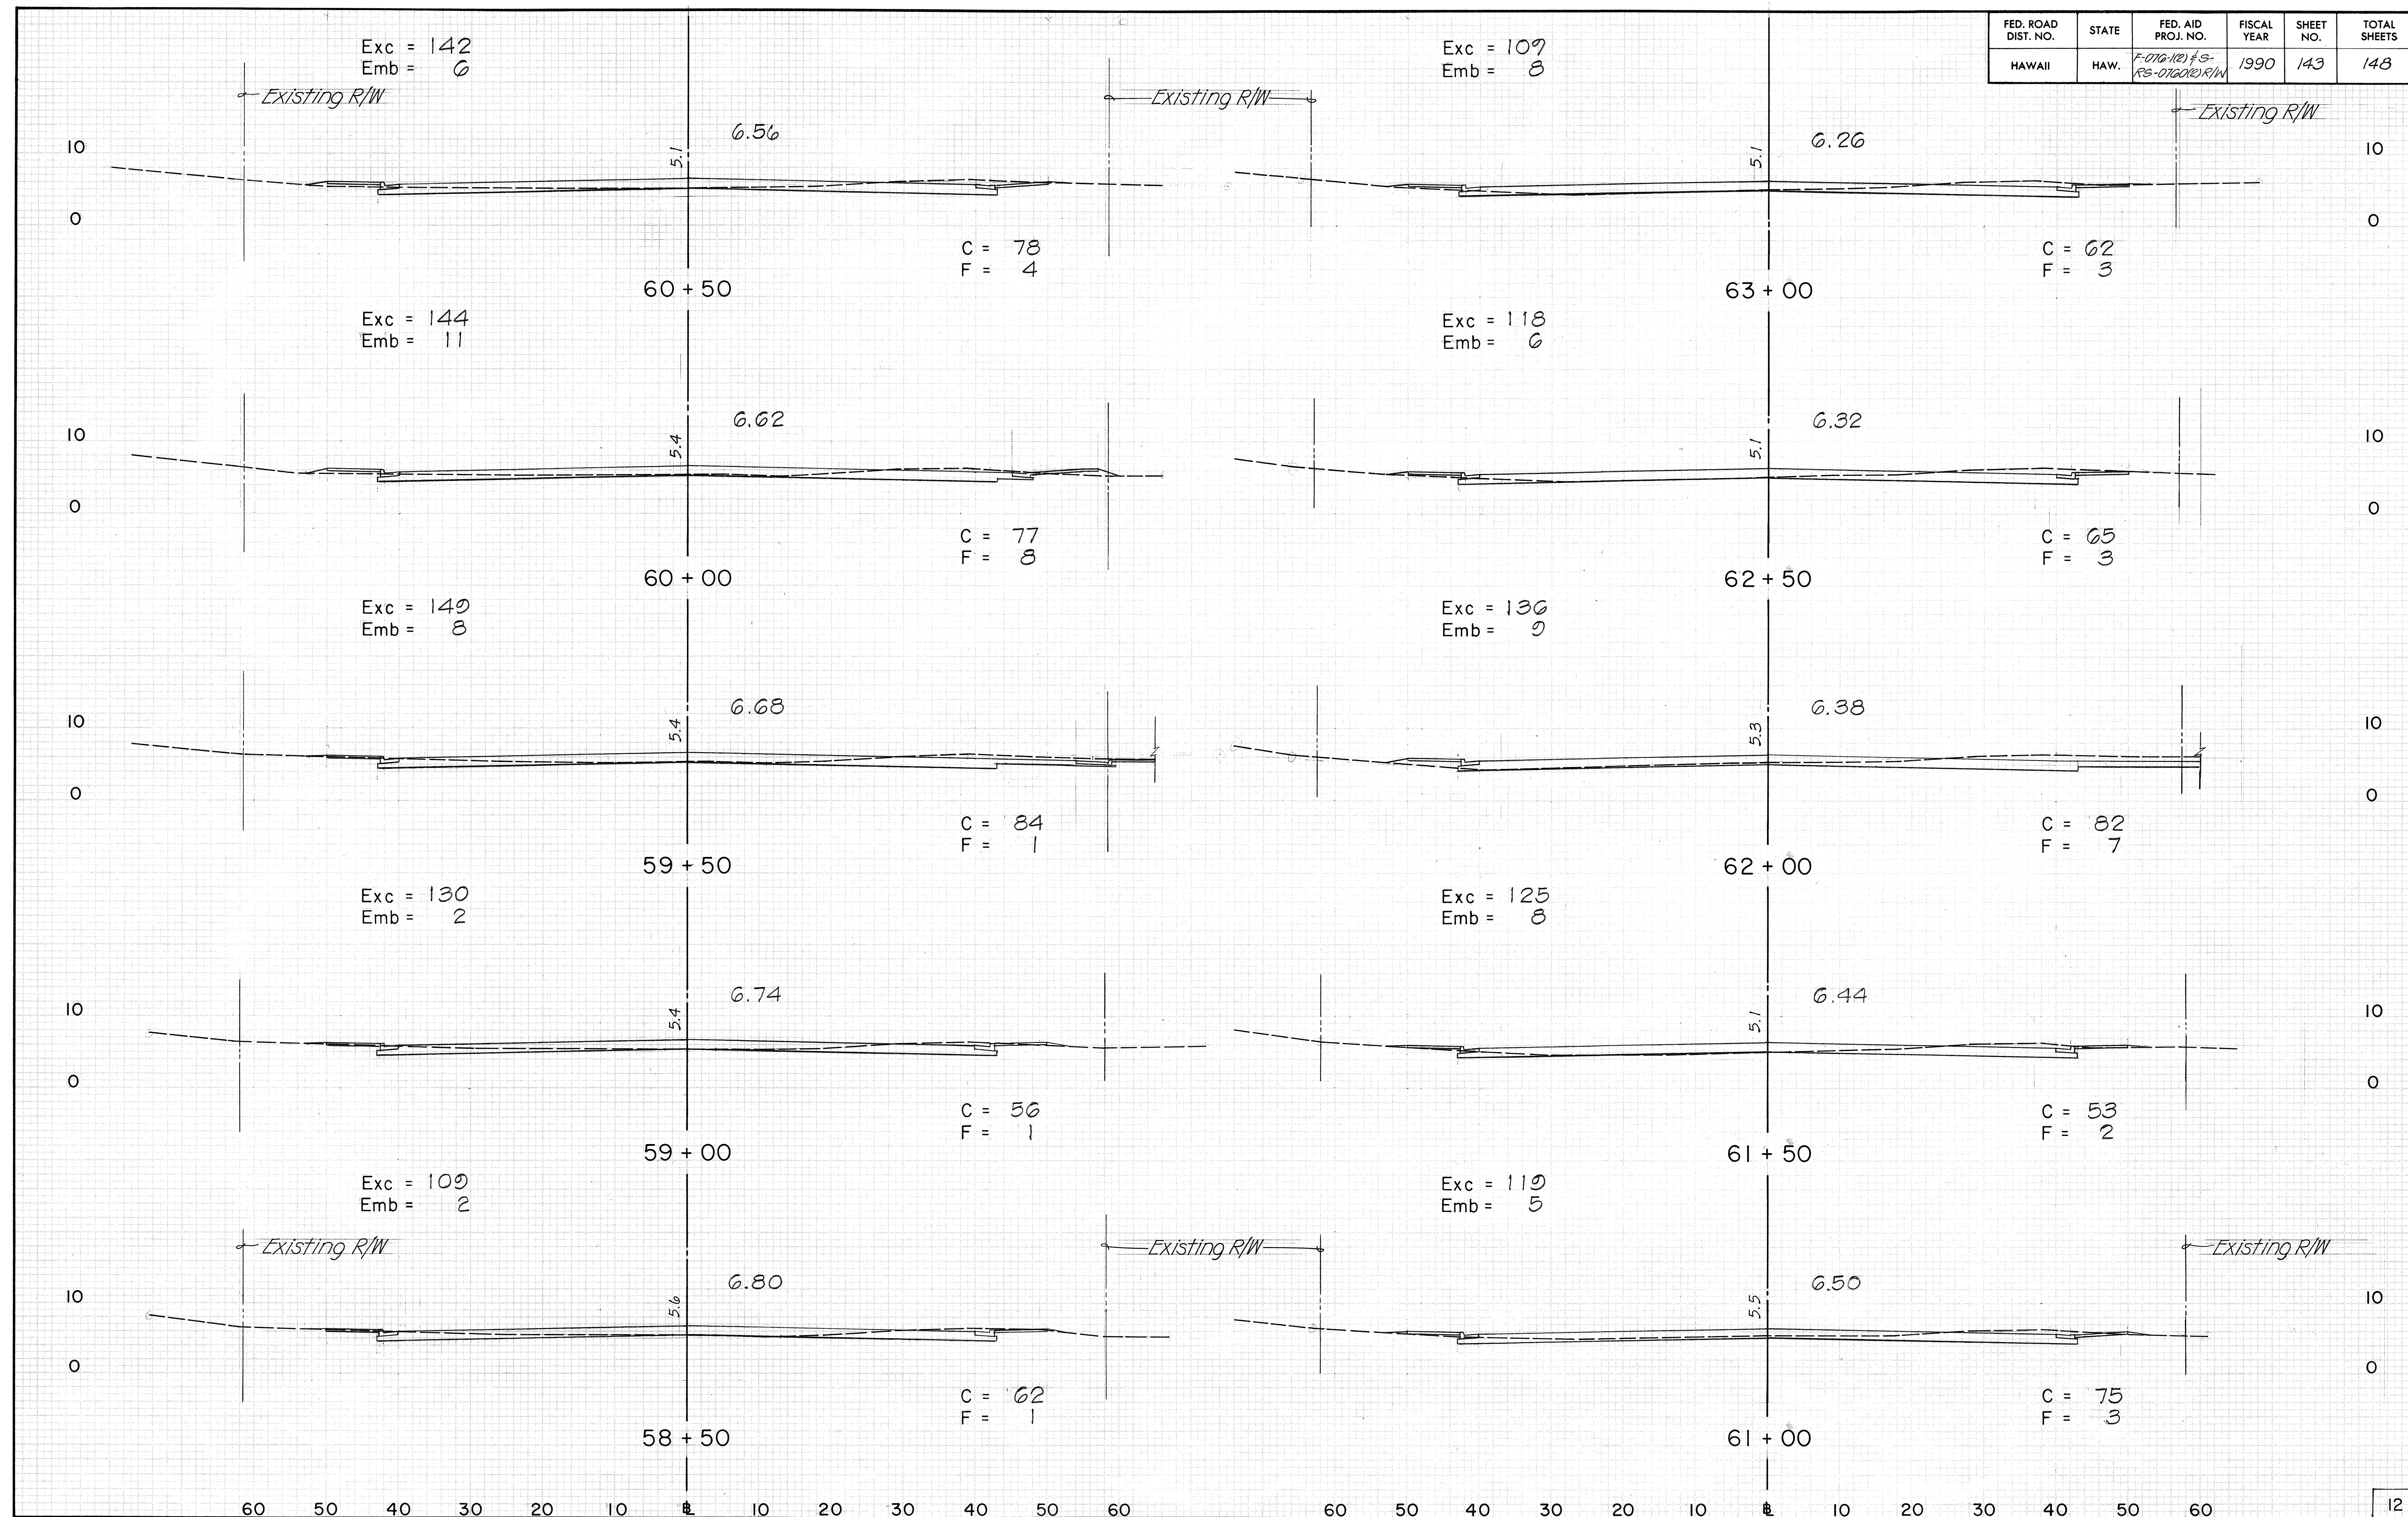


FED. ROAD DIST. NO.	STATE	FED. AID PROJ. NO.	FISCAL YEAR	SHEET NO.	TOTAL SHEETS
HAWAII	HAW.	F-0700-1121-S- RS-0700(2) R/W	1990	144	148

DATE	BY	ORIGINAL SURVEY	SURVEYED	PLOTTED	NOTE BOOK	AREAS CHECKED

DATE	BY	ORIGINAL SURVEY	SURVEYED	PLOTTED	NOTE BOOK	AREAS CHECKED

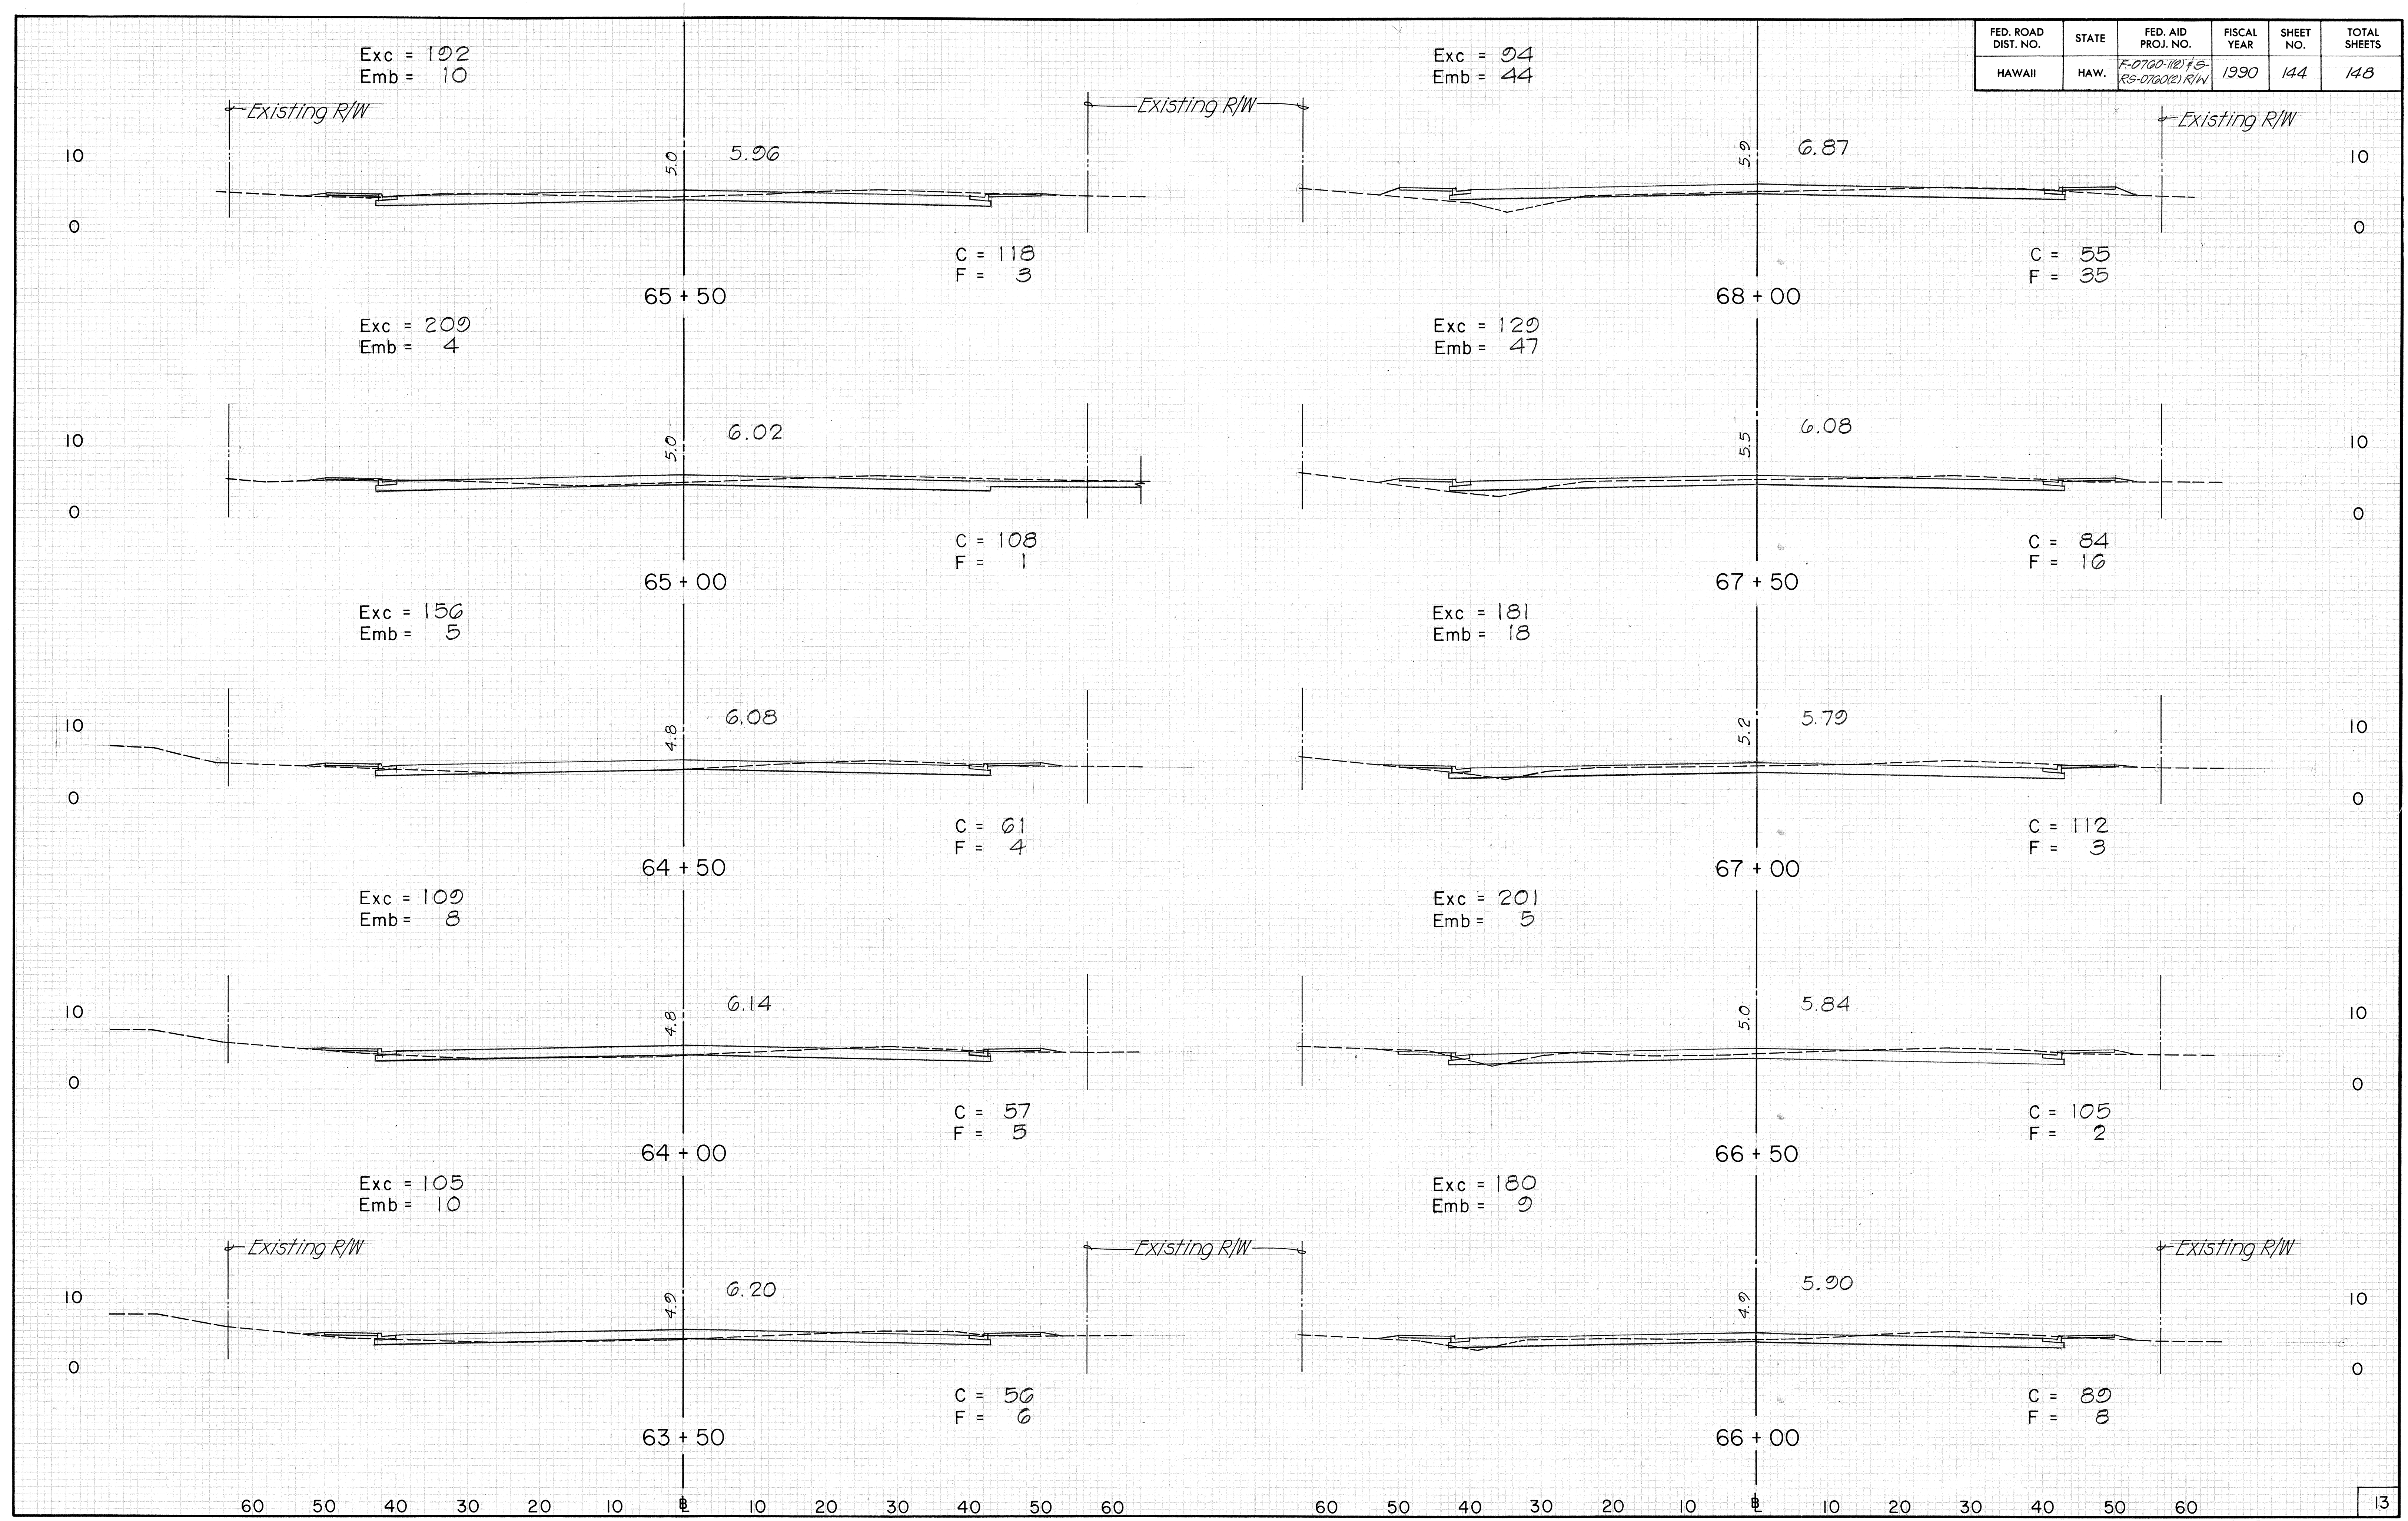

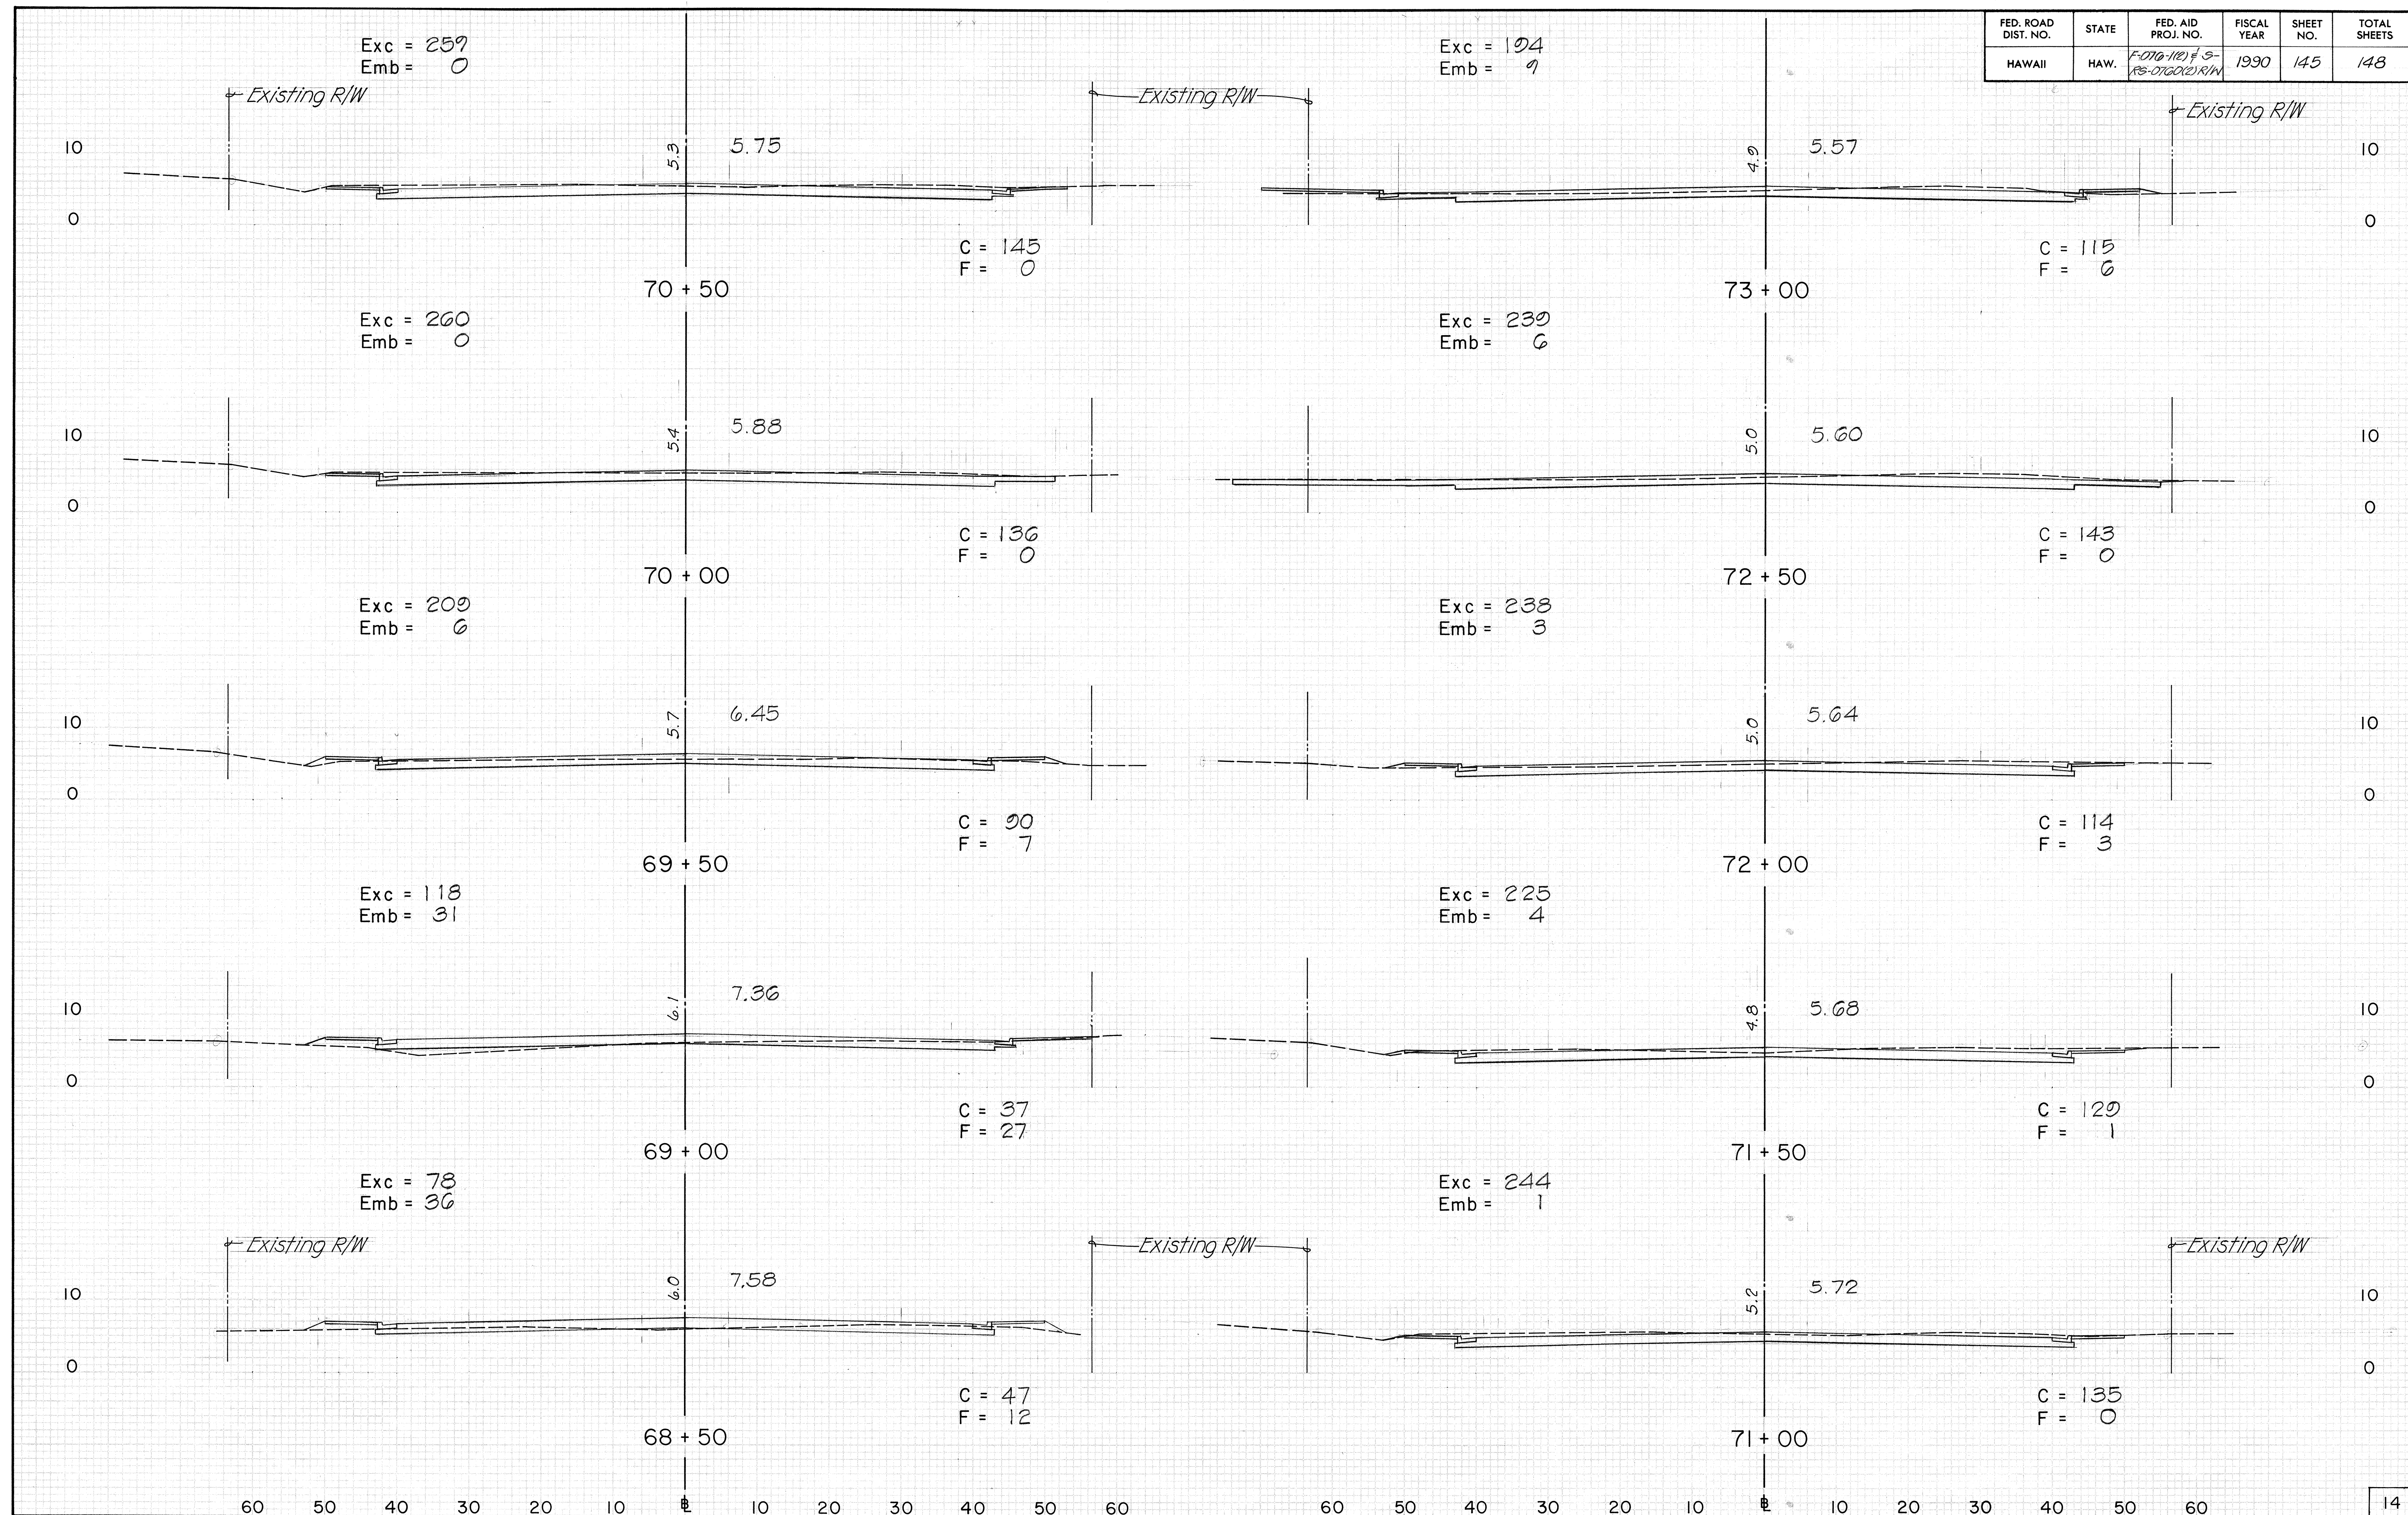

FED. ROAD DIST. NO.	STATE	FED. AID PROJ. NO.	FISCAL YEAR	SHEET NO.	TOTAL SHEETS
HAWAII	HAW.	F-070-1121-S- RS-070022 R/W	1990	146	148

DATE	BY	NO.
ORIGINAL SURVEY	PLOTTED	NO.
NOTE BOOK	TEMPLATE	NO.
AREAS CHECKED		

DATE	BY	NO.
ORIGINAL SURVEY	PLOTTED	NO.
NOTE BOOK	TEMPLATE	NO.
AREAS CHECKED		

