



FED. ROAD DIST. NO.	STATE	FED. AID PROJ. NO.	FISCAL YEAR	SHEET NO.	TOTAL SHEETS
HAWAII	HAW.	F-076-1(2) S-RS-0760 (2) R/W	1990	17	148

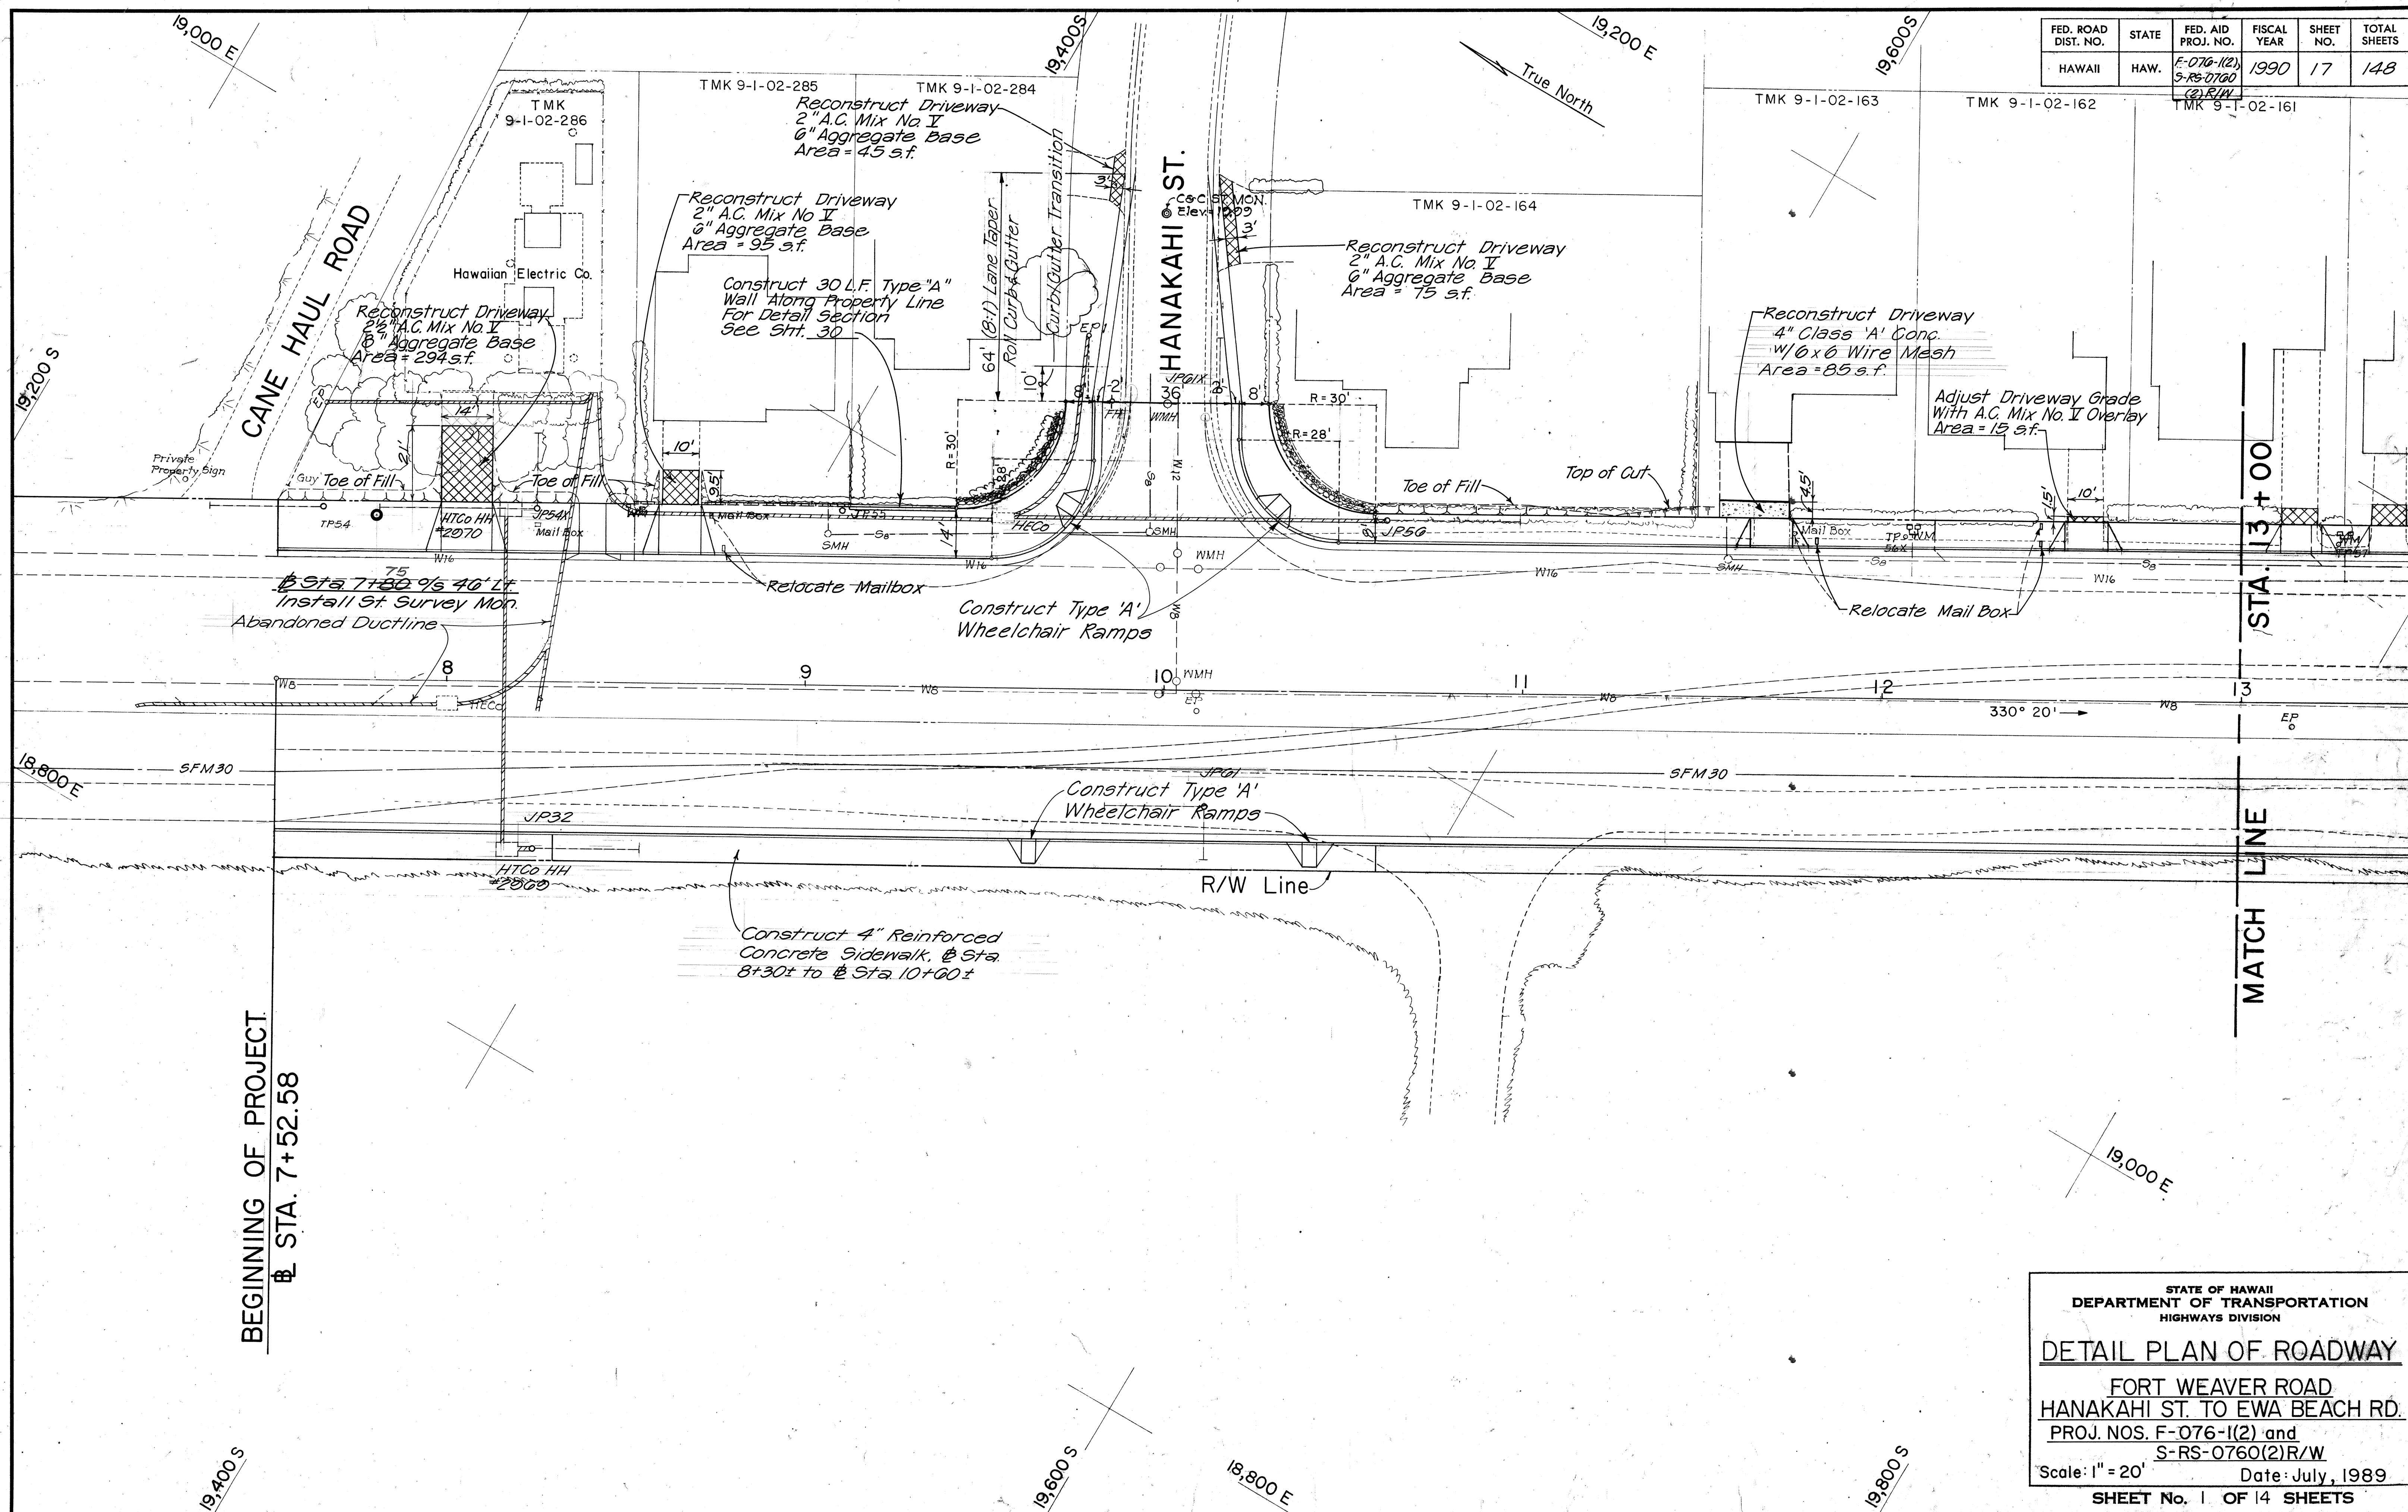

SURVEY PLOTTED BY	DATE
DRAWN BY	
DESIGNED BY	
NOTE BOOK	
CHECKED BY	

FED. ROAD DIST. NO.	STATE	FED. AID PROJ. NO.	FISCAL YEAR	SHEET NO.	TOTAL SHEETS
HAWAII	HAW.	F-076-1(2) S-RS-0760 (2) R/W	1990	18	148

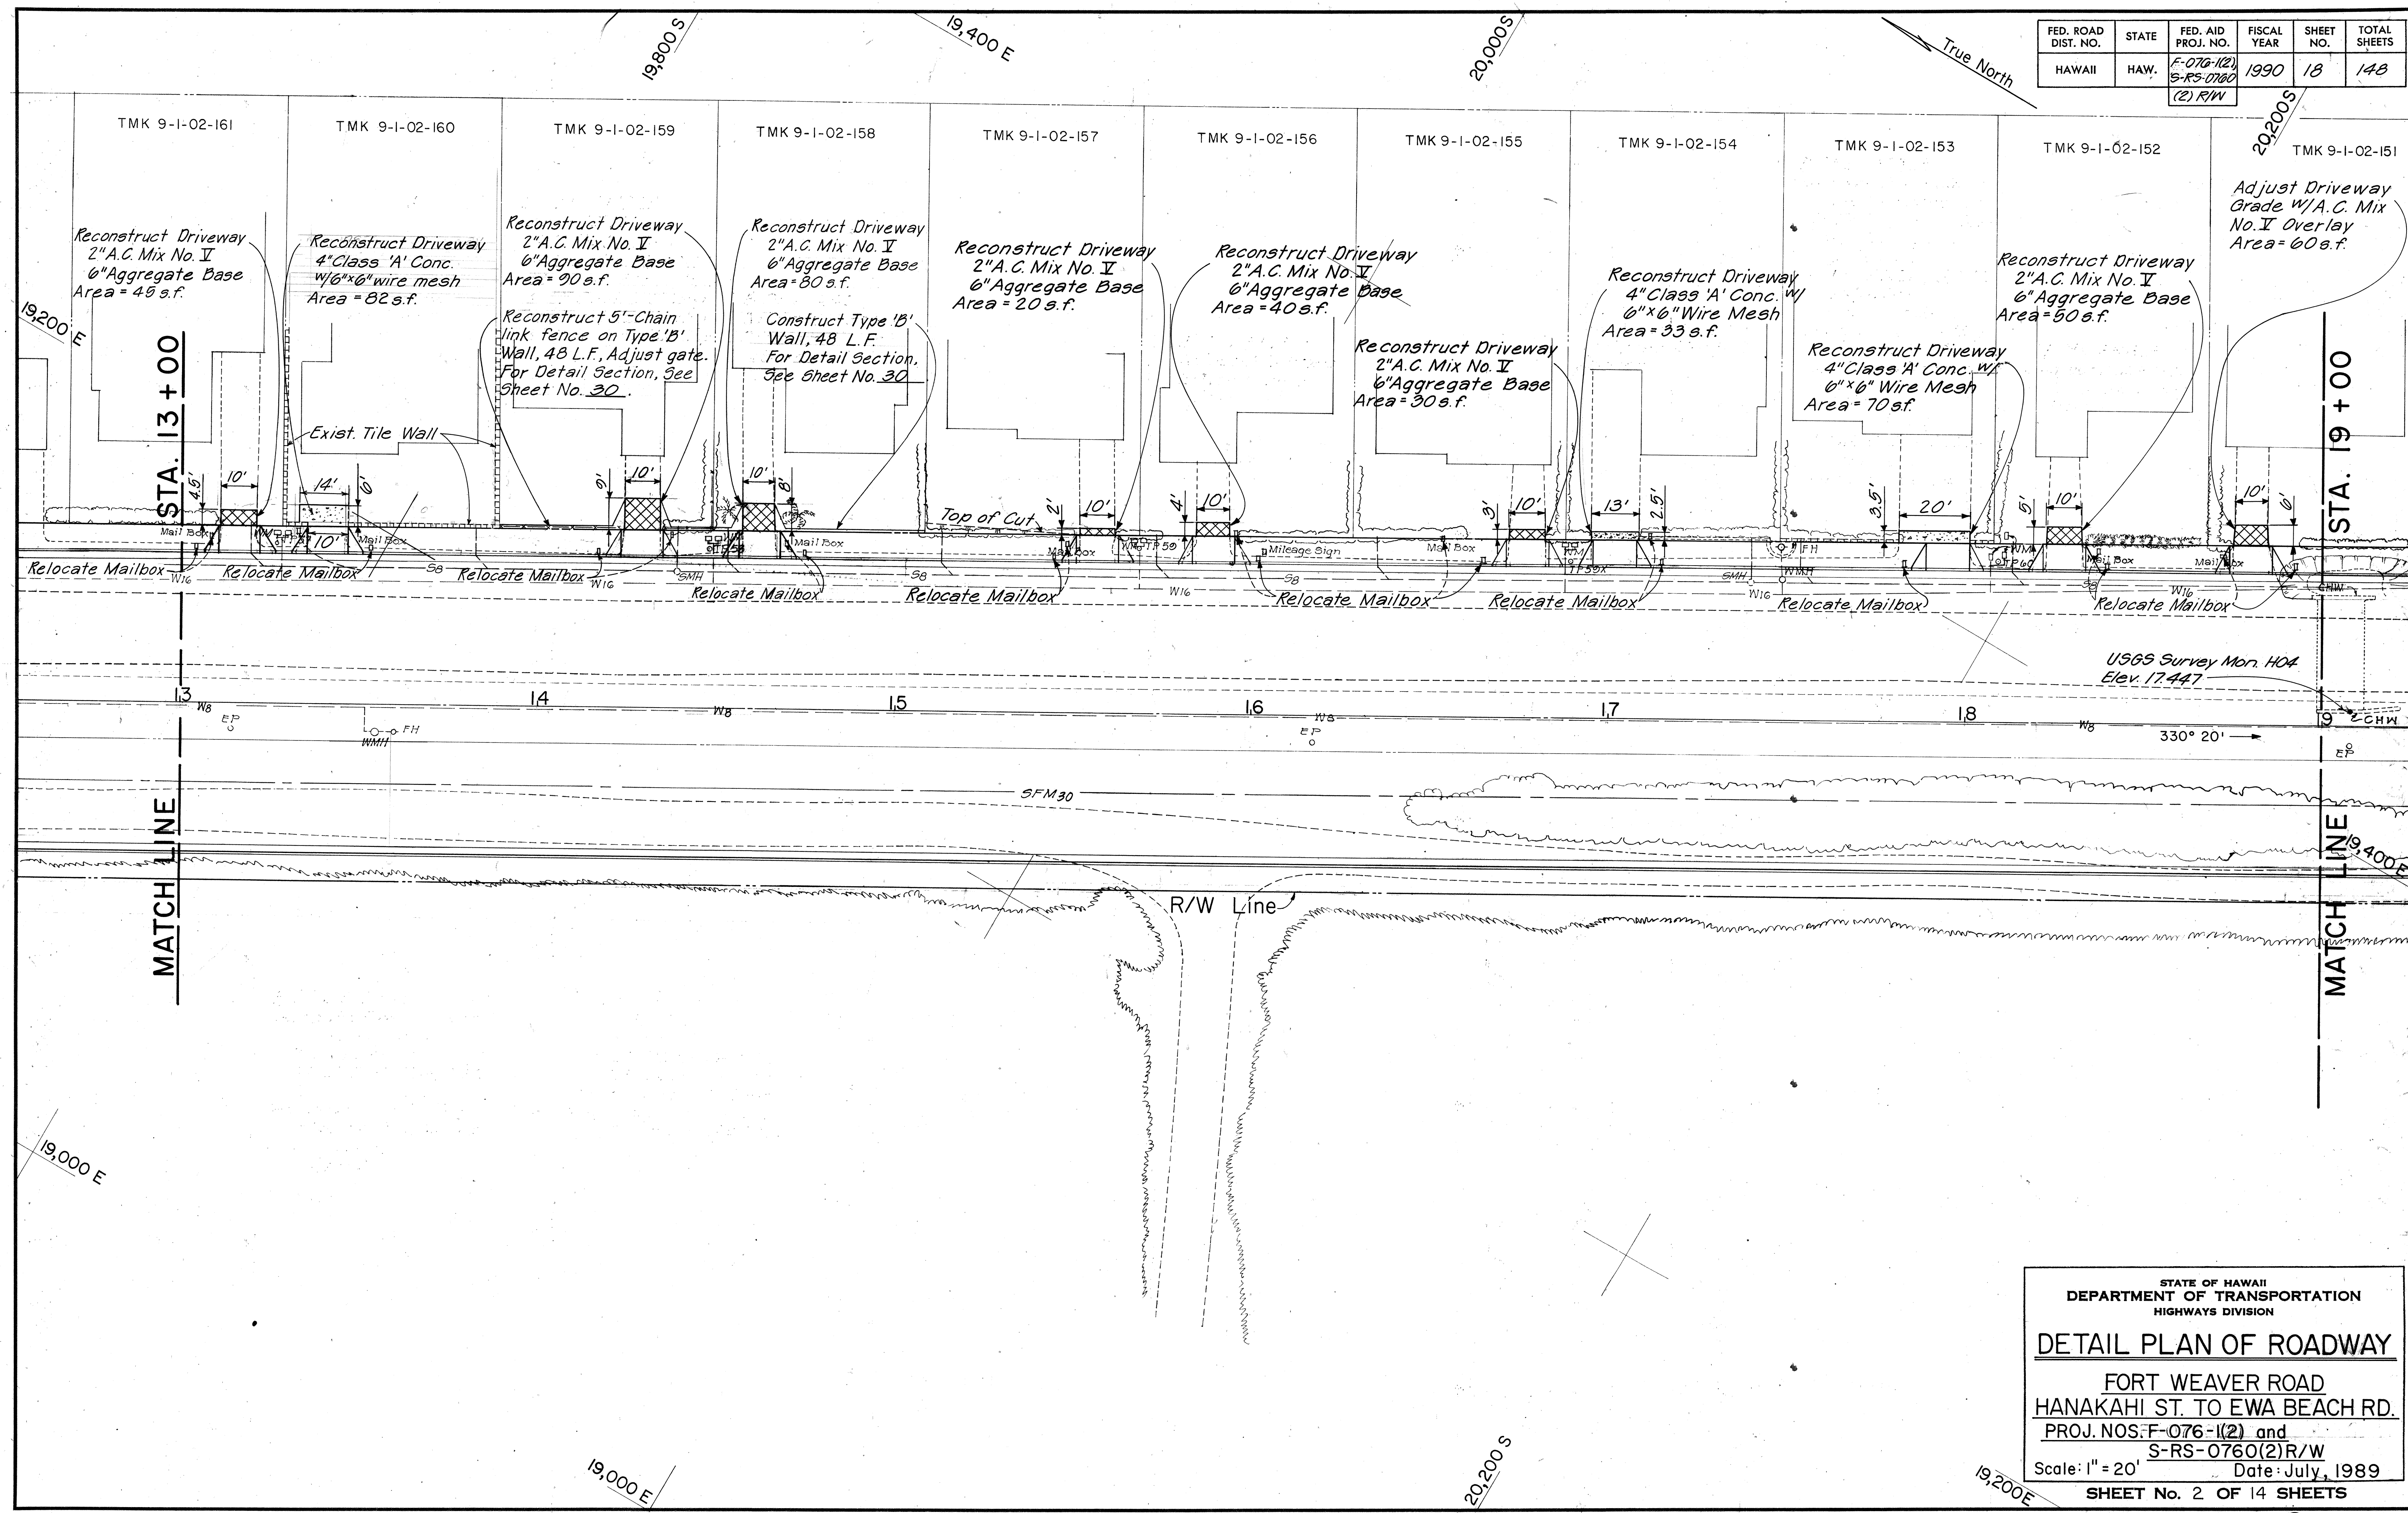

DATE	_____
SURVEY PLOTTED BY	_____
DRAWN BY	_____
TRACED BY	_____
QUANTITIES BY	_____
CHECKED BY	_____
ORIGINAL PLAN	_____
NOTE BOOK	_____
No.	_____


STATE OF HAWAII
DEPARTMENT OF TRANSPORTATION
HIGHWAYS DIVISION

DETAIL PLAN OF ROADWAY

FORT WEAVER ROAD
HANAKAHI ST. TO EWA BEACH RD.
PROJ. NOS. F-076-1(2) and
S-RS-0760(2) R/W
Scale: 1" = 20' Date: July, 1989

SHEET No. 2 OF 14 SHEETS

FED. ROAD DIST. NO.	STATE	FED. AID PROJ. NO.	FISCAL YEAR	SHEET NO.	TOTAL SHEETS
HAWAII	HAW.	F-076-1(2) S-RS-0760 (2) R/W	1990	19	148

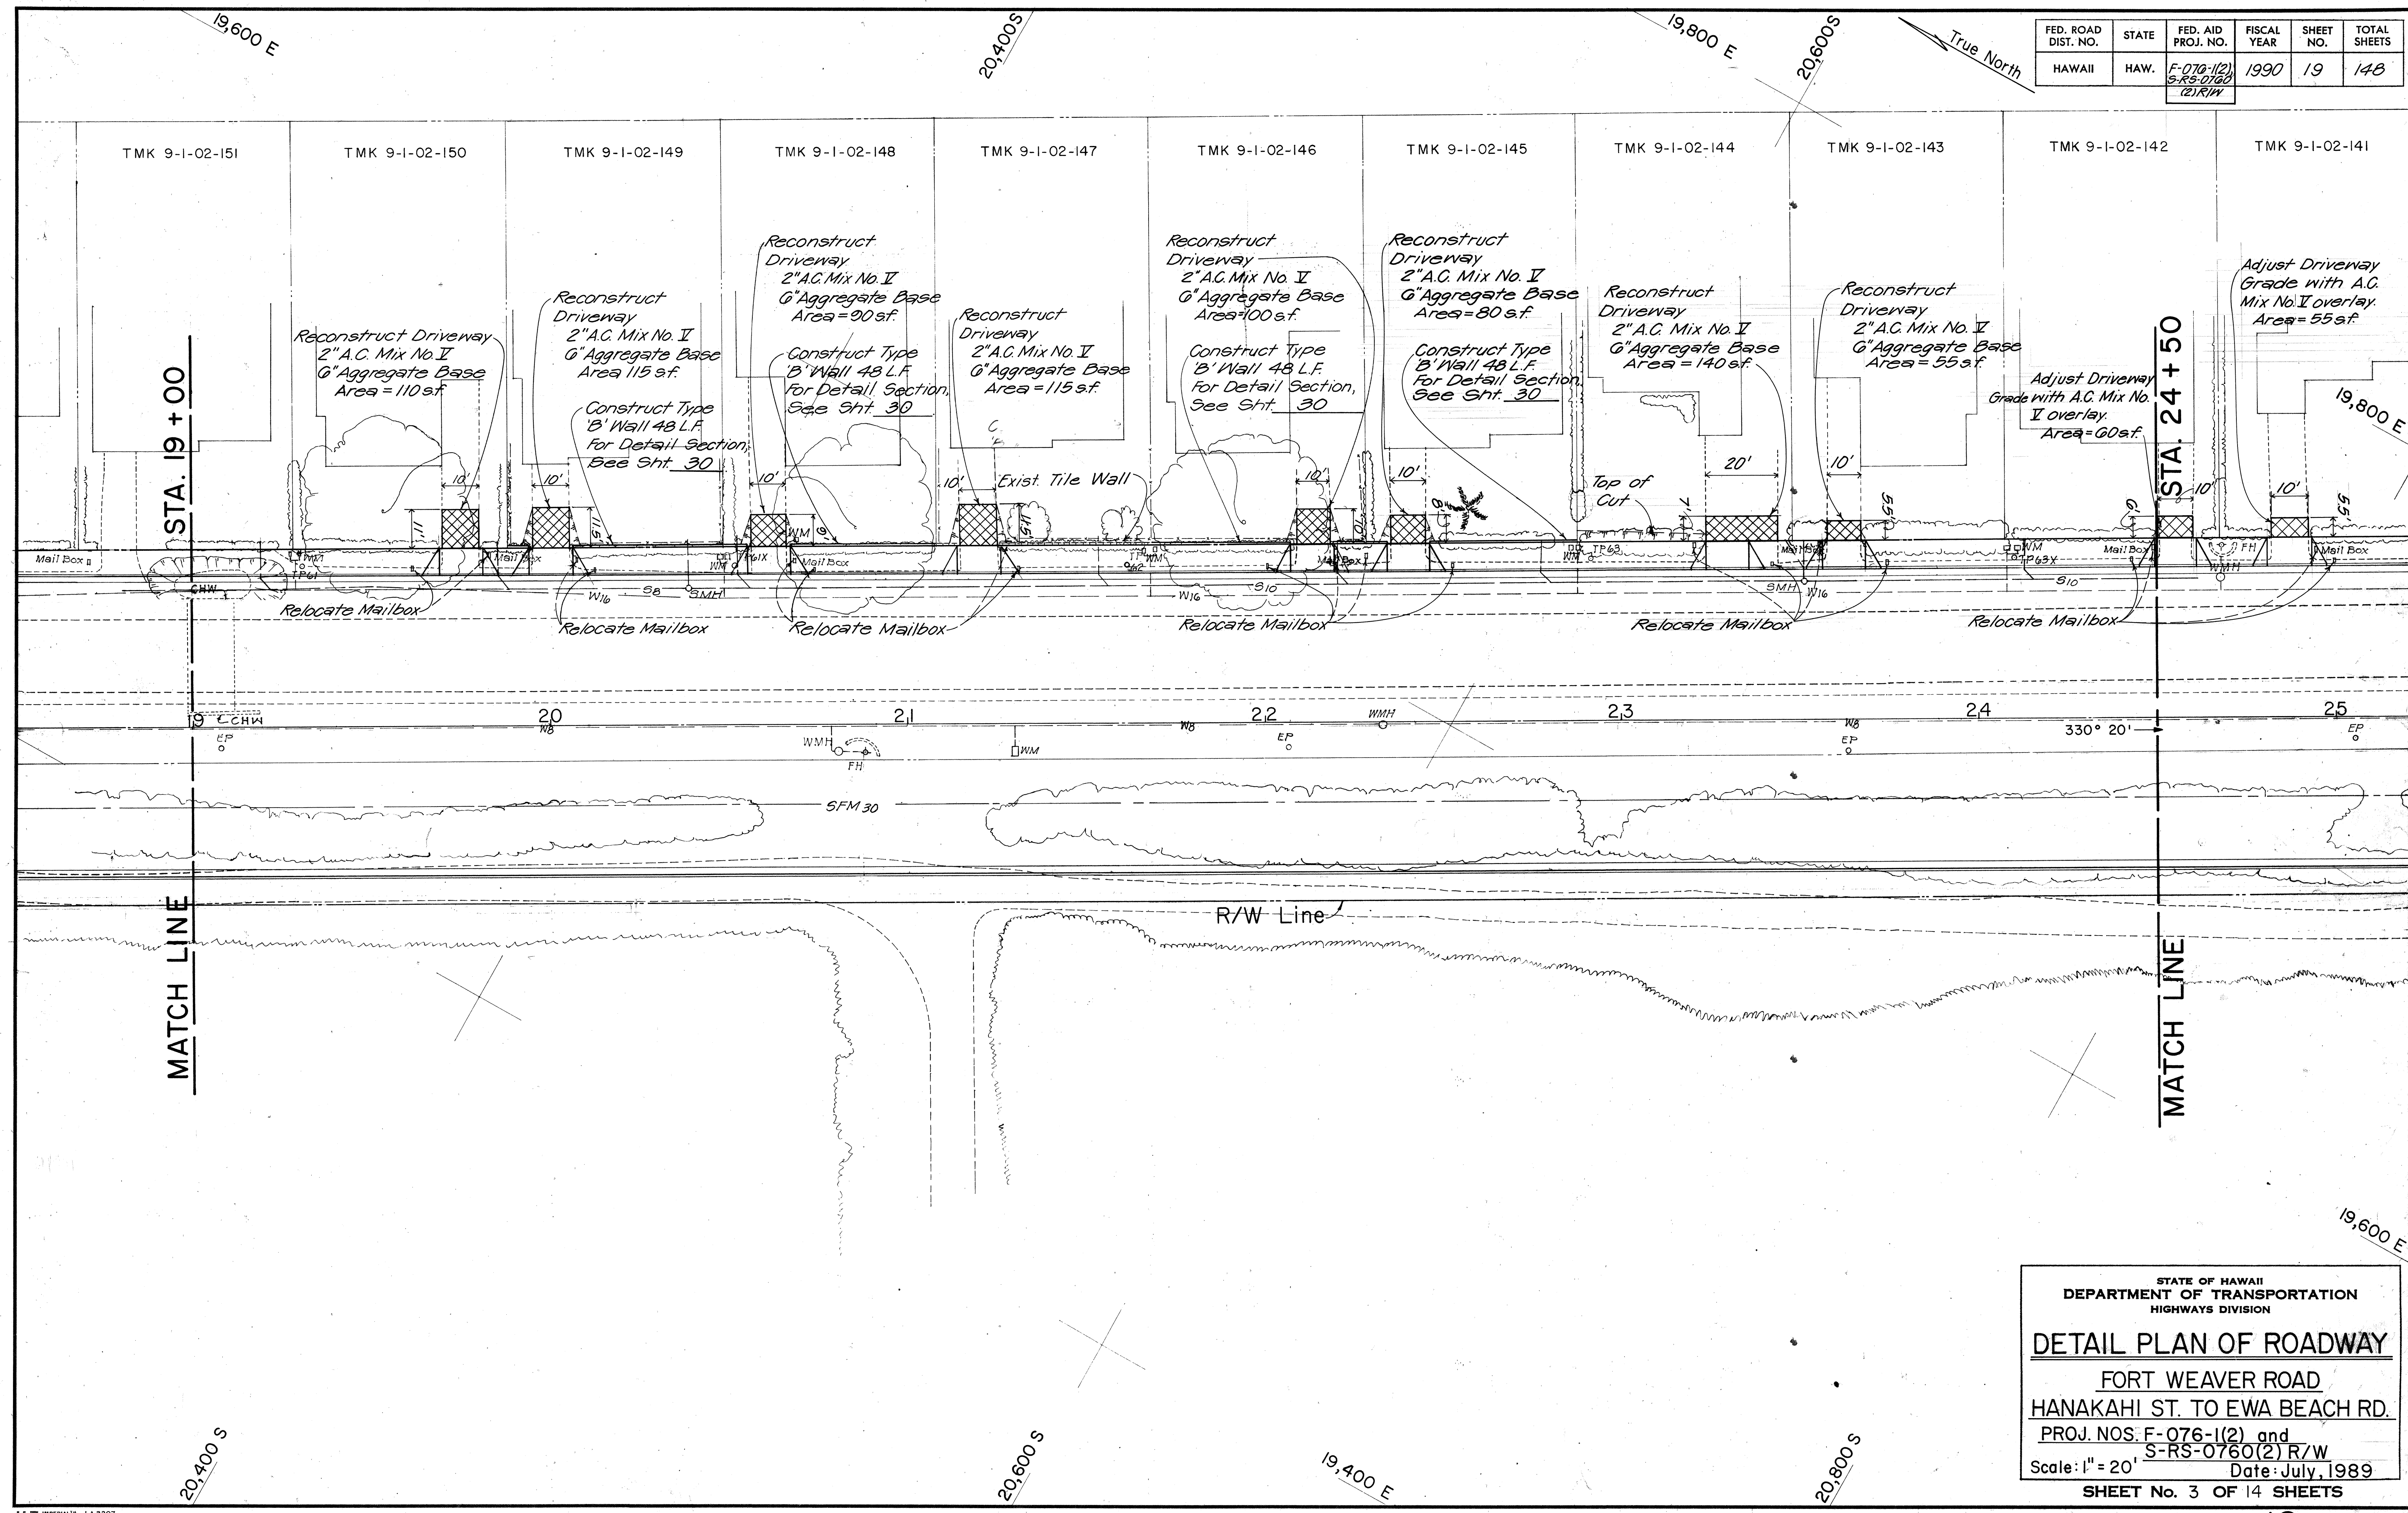

SURVEY PLOTTED BY	DATE
DRAWN BY	
TRACED BY	
QUANTITIES BY	
CHECKED BY	
ORIGINAL PLAN	
NOTE BOOK	
No.	

STATE OF HAWAII
DEPARTMENT OF TRANSPORTATION
HIGHWAYS DIVISION

DETAIL PLAN OF ROADWAY

FORT WEAVER ROAD
HANAKAHI ST. TO EWA BEACH RD.

PROJ. NOS. F-076-1(2) and
S-RS-0760(2) R/W

Scale: 1" = 20' Date: July, 1989

SHEET No. 3 OF 14 SHEETS

FED. ROAD DIST. NO.	STATE	FED. AID PROJ. NO.	FISCAL YEAR	SHEET NO.	TOTAL SHEETS
HAWAII	HAW.	F-076-1(2)	1990	20	148

S-RS-0760(2)R/W

True North

First Baptist Church

STA. 30+50


STA. 24+50

MATCH LINE


MATCH LINE

STATE OF HAWAII
DEPARTMENT OF TRANSPORTATION
HIGHWAYS DIVISION
DETAIL PLAN OF ROADWAY
FORT WEAVER ROAD
HANAKAHI ST. TO EWA BEACH RD.
PROJ. NOS. F-076-1(2) and S-RS-0760(2)R/W
Scale: 1" = 20' Date: July, 1989
SHEET No. 4 OF 14 SHEETS

DATE	_____
SURVEY PLOTTED BY	_____
DRAWN BY	_____
DESIGNED BY	_____
CHECKED BY	_____
NOTE BOOK	_____
No.	_____

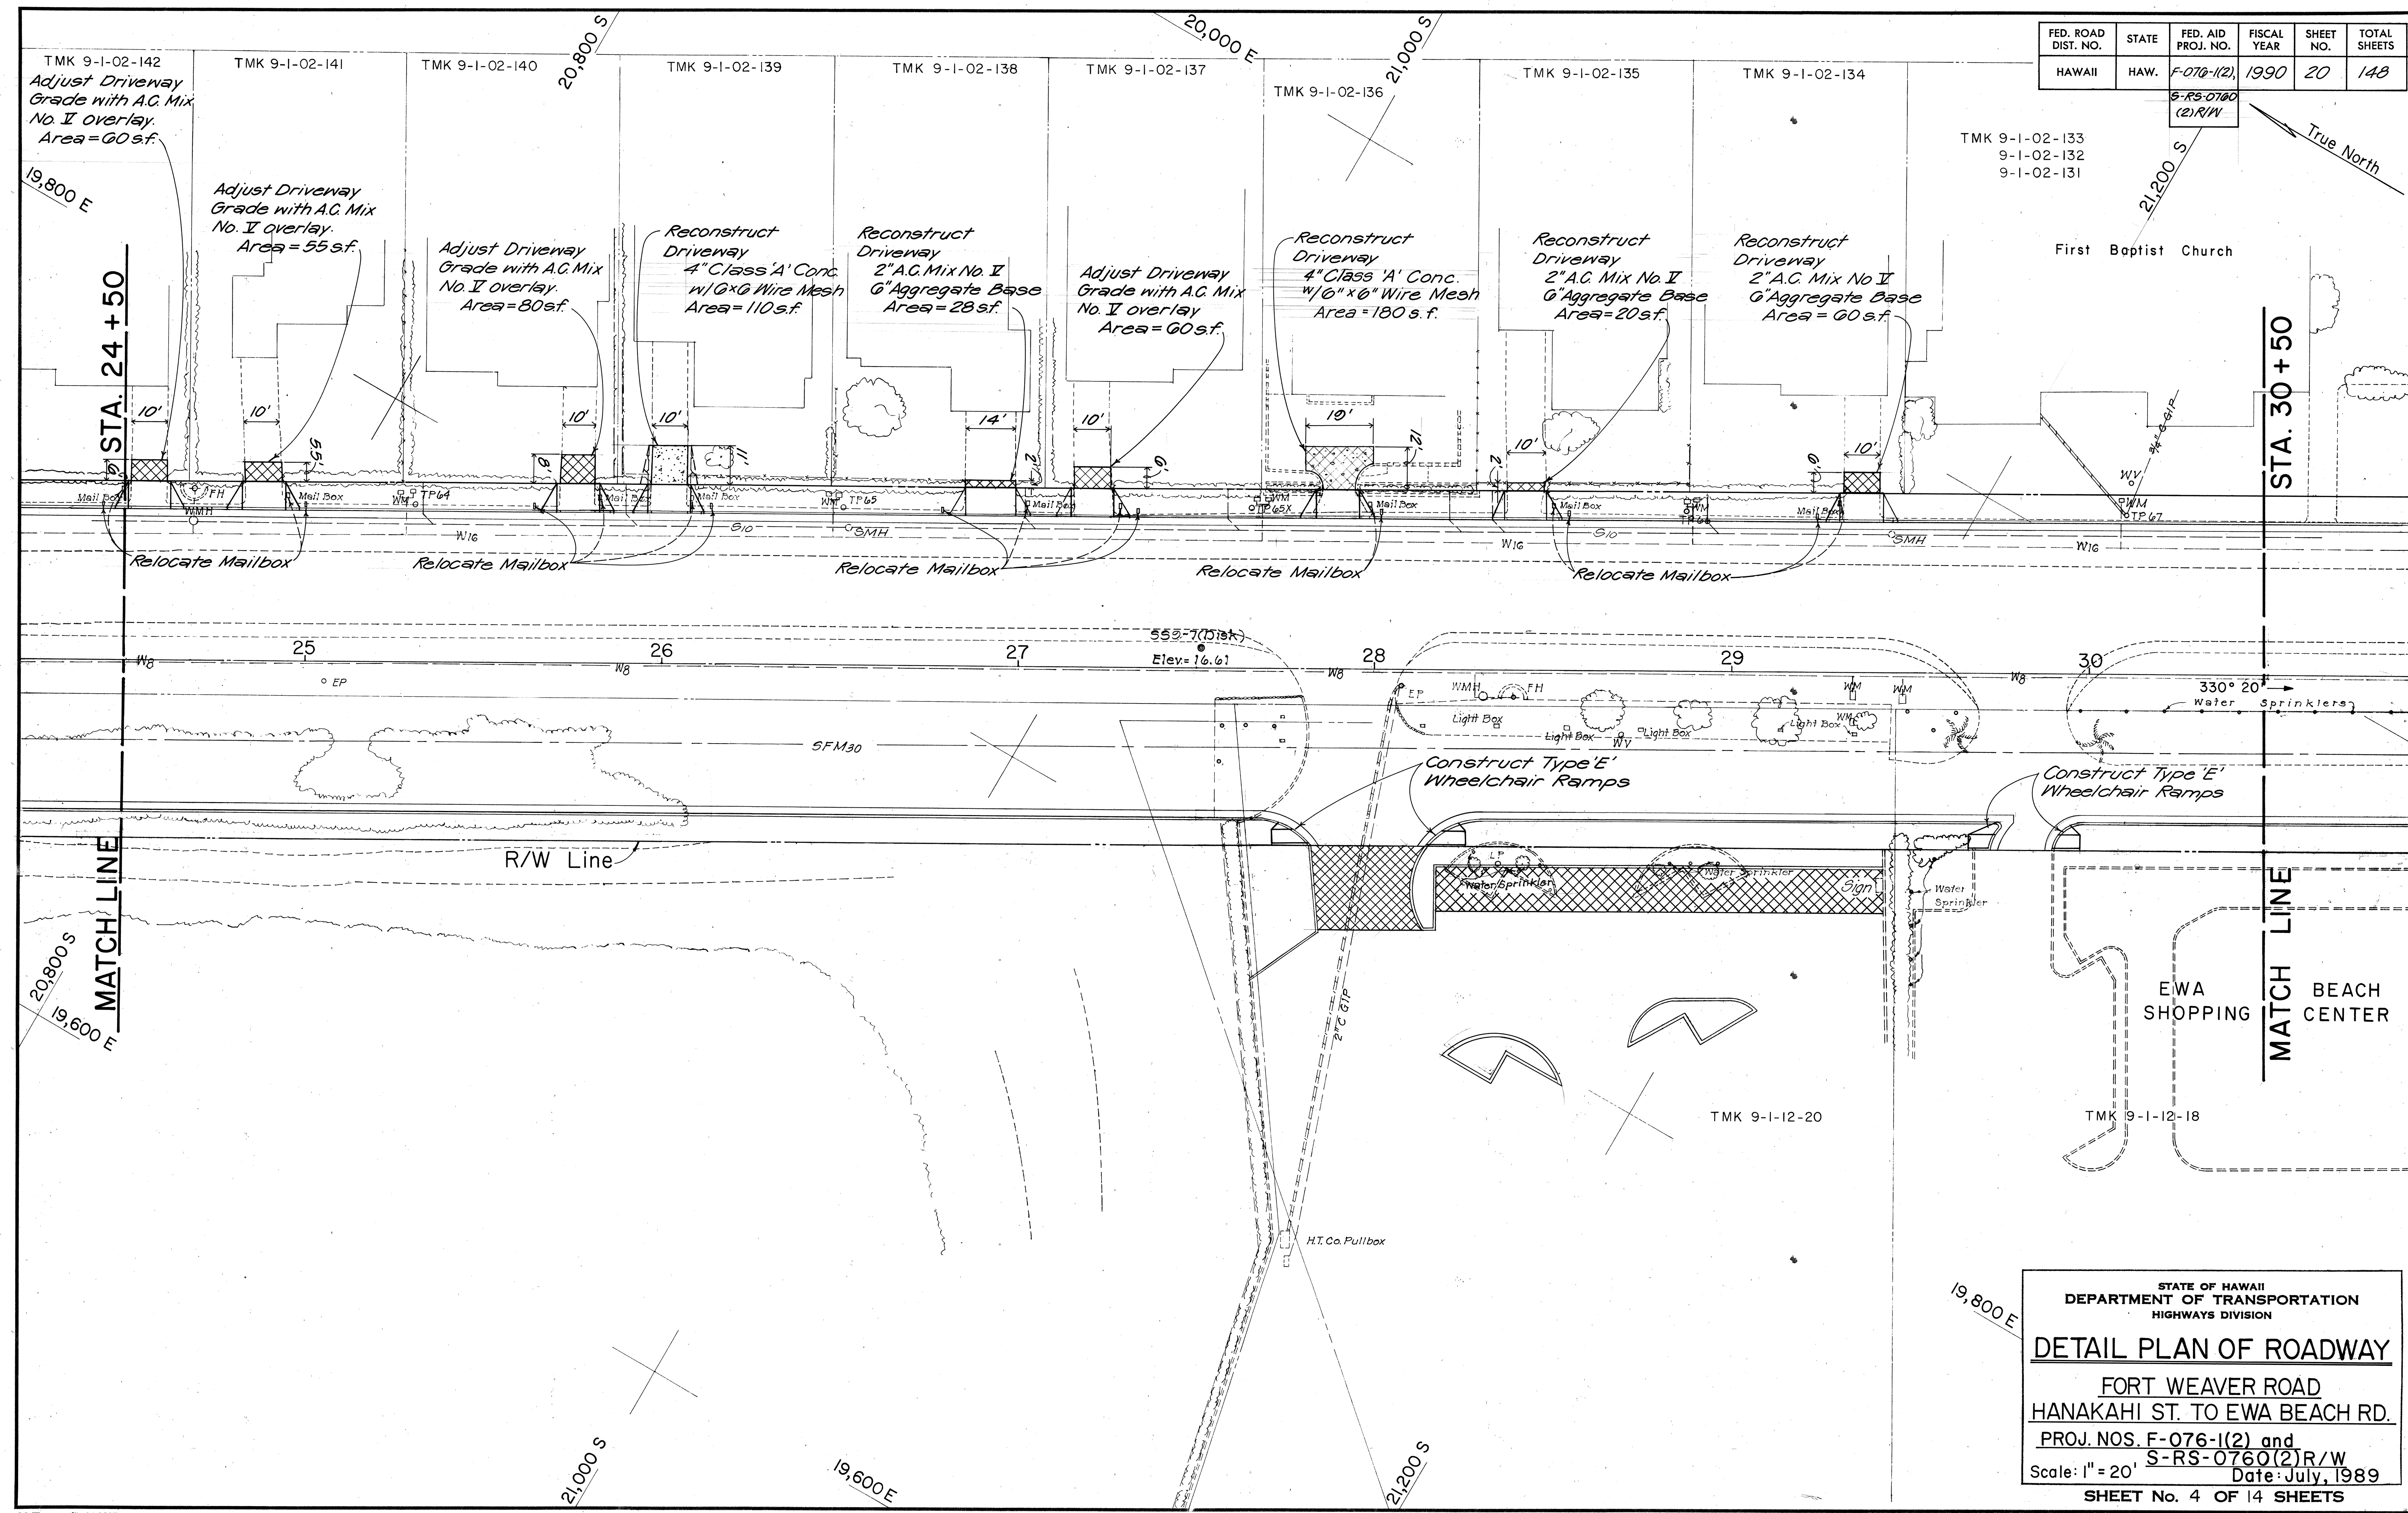

FED. ROAD DIST. NO.	STATE	FED. AID PROJ. NO.	FISCAL YEAR	SHEET NO.	TOTAL SHEETS
HAWAII	HAW.	F-076-1(2) S-RS-0760(2)R/W (2)R/W	1990	21	148

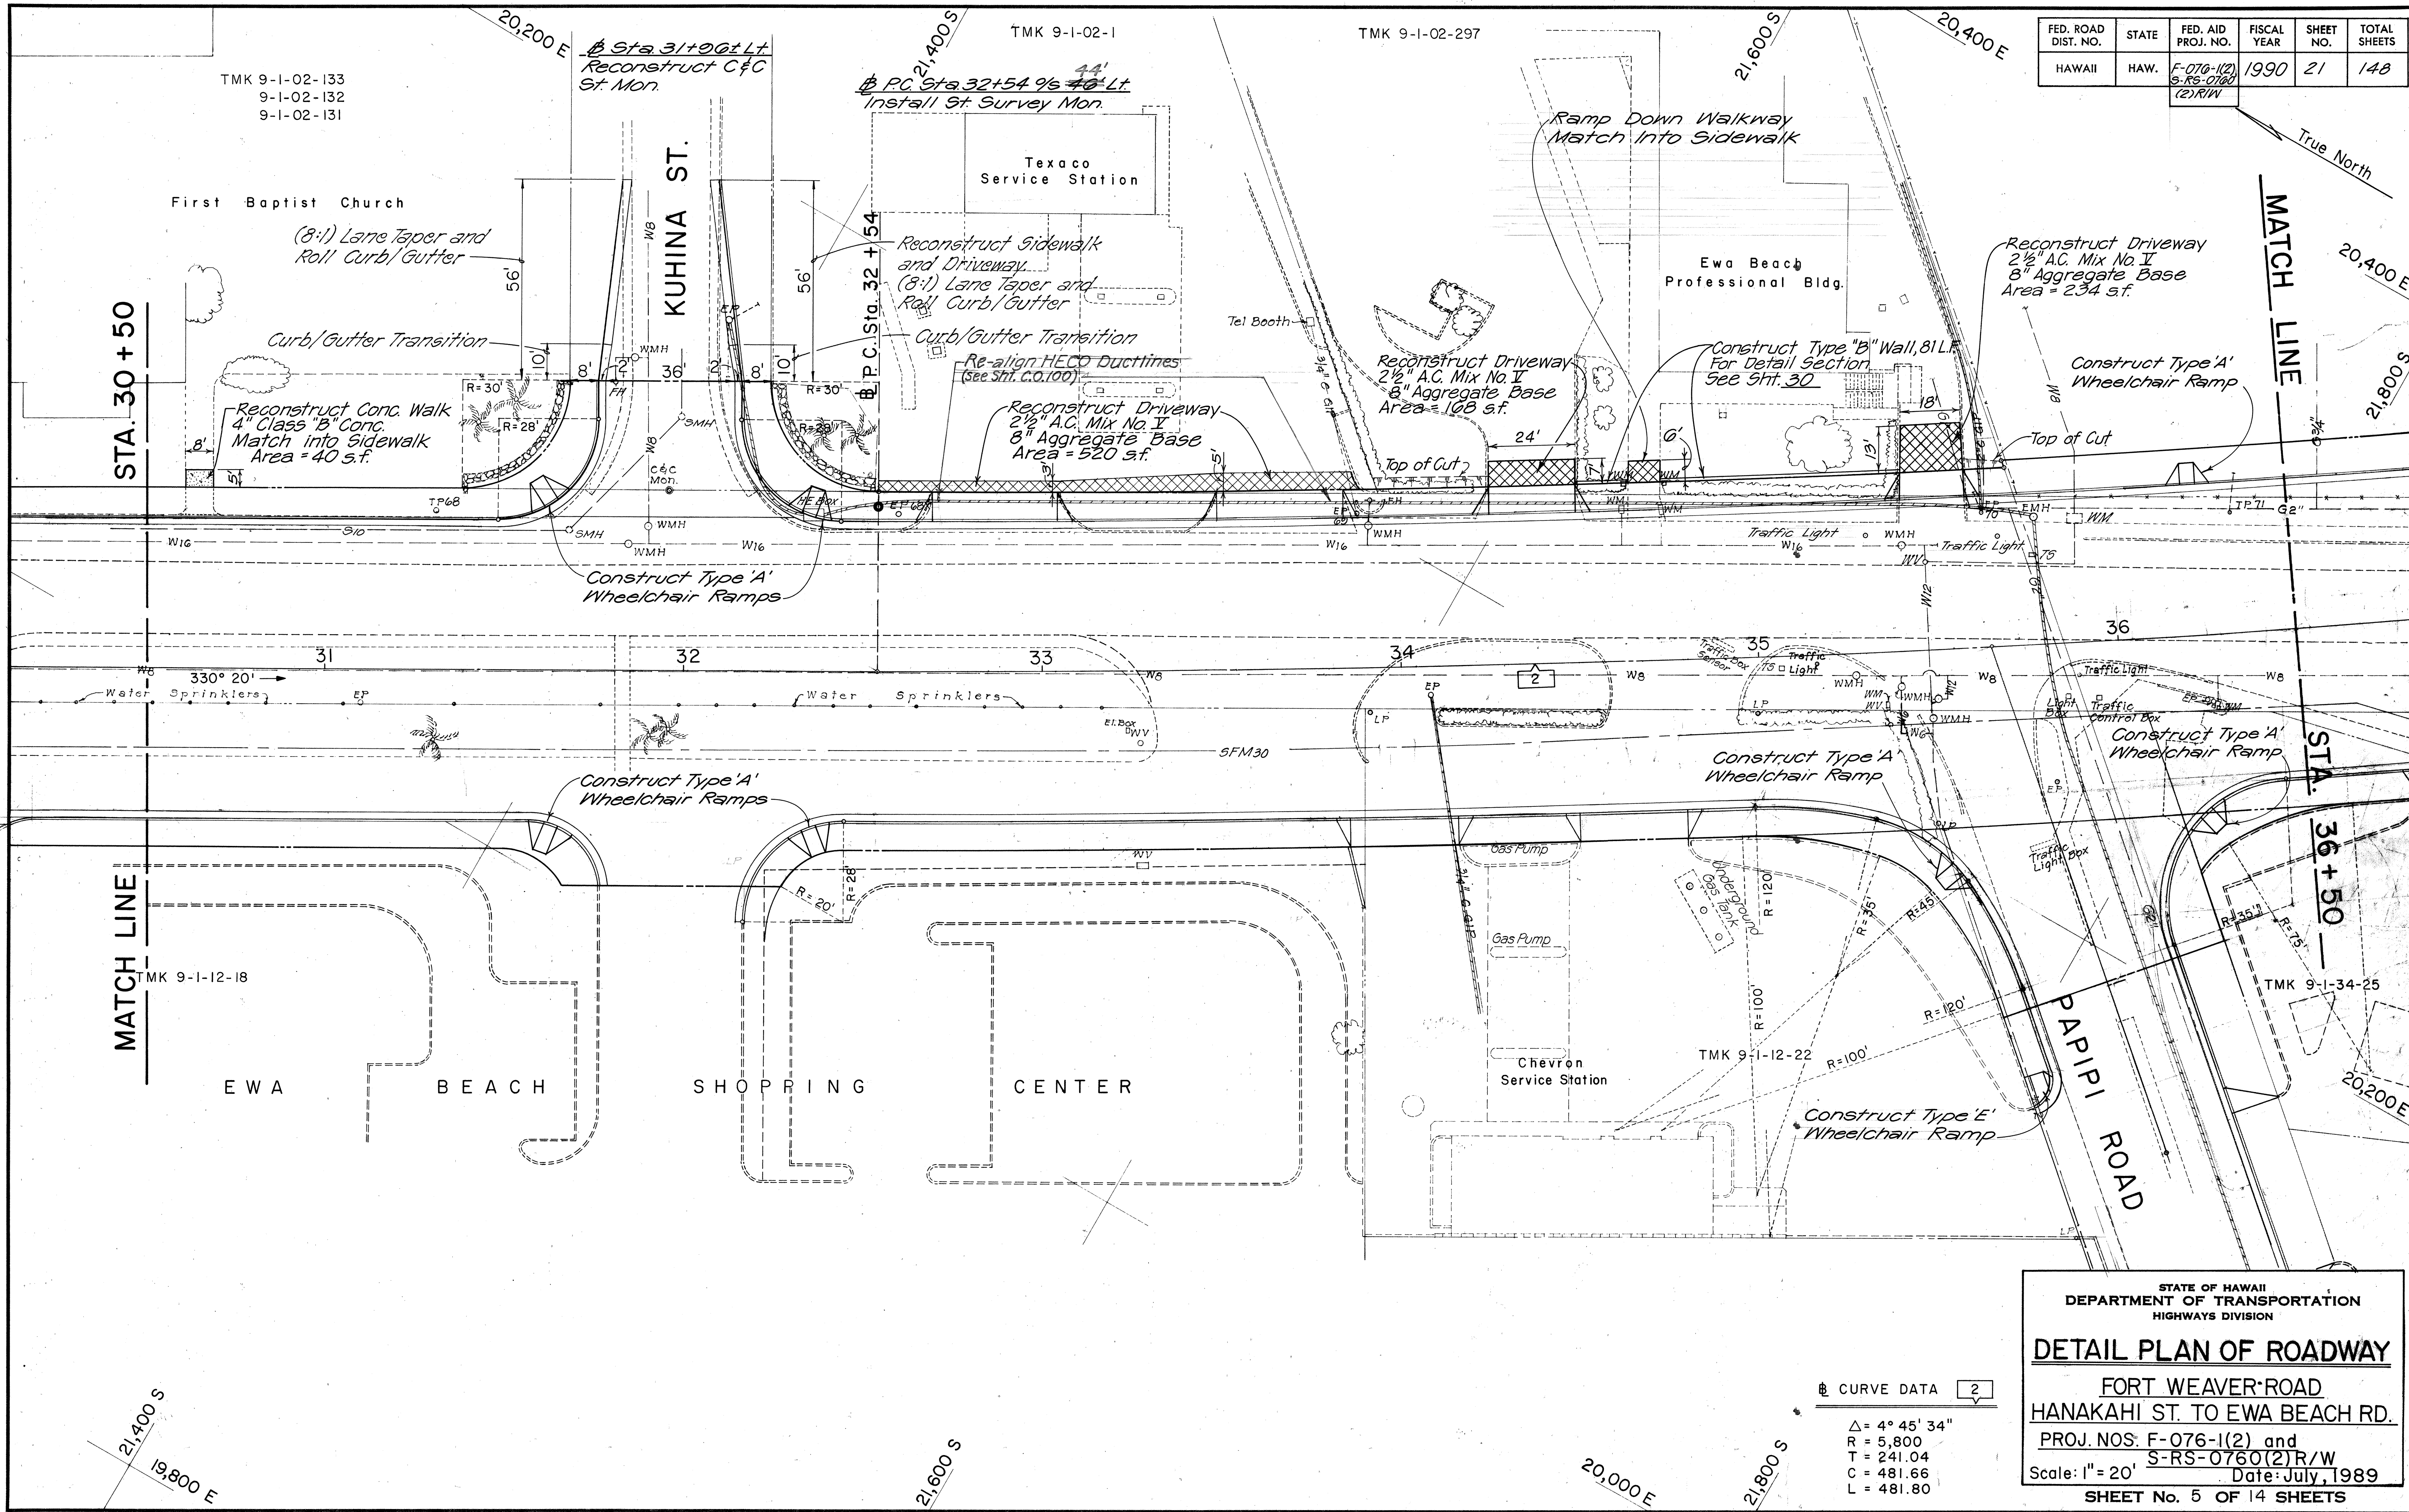

DATE	_____
SURVEY PLOTTED BY	_____
DRAWN BY	_____
TRACED BY	_____
NOTED BY	_____
CHECKED BY	_____
ORIGINAL PLAN	_____
NOTE BOOK	_____
No.	_____

CURVE DATA	
Δ	4° 45' 34"
R	5,800
T	241.04
C	481.66
L	481.80

STATE OF HAWAII
DEPARTMENT OF TRANSPORTATION
HIGHWAYS DIVISION
DETAIL PLAN OF ROADWAY
FORT WEAVER ROAD
HANAKAHI ST. TO EWA BEACH RD.
PROJ. NOS. F-076-1(2) and
S-RS-0760(2)R/W
Scale: 1" = 20'
Date: July, 1989
SHEET No. 5 OF 14 SHEETS

FED. ROAD DIST. NO.	STATE	FED. AID PROJ. NO.	FISCAL YEAR	SHEET NO.	TOTAL SHEETS
HAWAII	HAW.	F-076-1(2)	1990	25	148
S-RS-0760 (2) R/W					

DATE	2-2-89
SURVEY PLOTTED BY	DATE
DRAWN BY	DESIGNED BY
NOTED BY	CHECKED BY
NO.	

C U R V E D A T A							
CURVE No.	4	12	13	15	16	18	19
Δ	73° 51' 30"	68° 39' 13"	87° 18' 10"	119° 05' 11"	36° 52' 12"	129° 19' 03"	26° 31' 31"
R	950	68	28	28	48	22	41
T	714.04	46.43	26.71	47.62	16	46.46	9.66
C	1,141.57	76.69	38.66	48.27	30.36	39.77	18.81
L	1,224.62	81.48	42.66	58.20	30.89	49.65	18.98

STATE OF HAWAII
DEPARTMENT OF TRANSPORTATION
HIGHWAYS DIVISION


DETAIL PLAN OF ROADWAY

FORT WEAVER ROAD
HANAKAHI ST. TO EWA BEACH RD.

PROJ. NOS. F-076-1(2) and
S-RS-0760(2) R/W


Scale: 1" = 20' Date: July, 1989

SHEET No. 9 OF 14 SHEETS

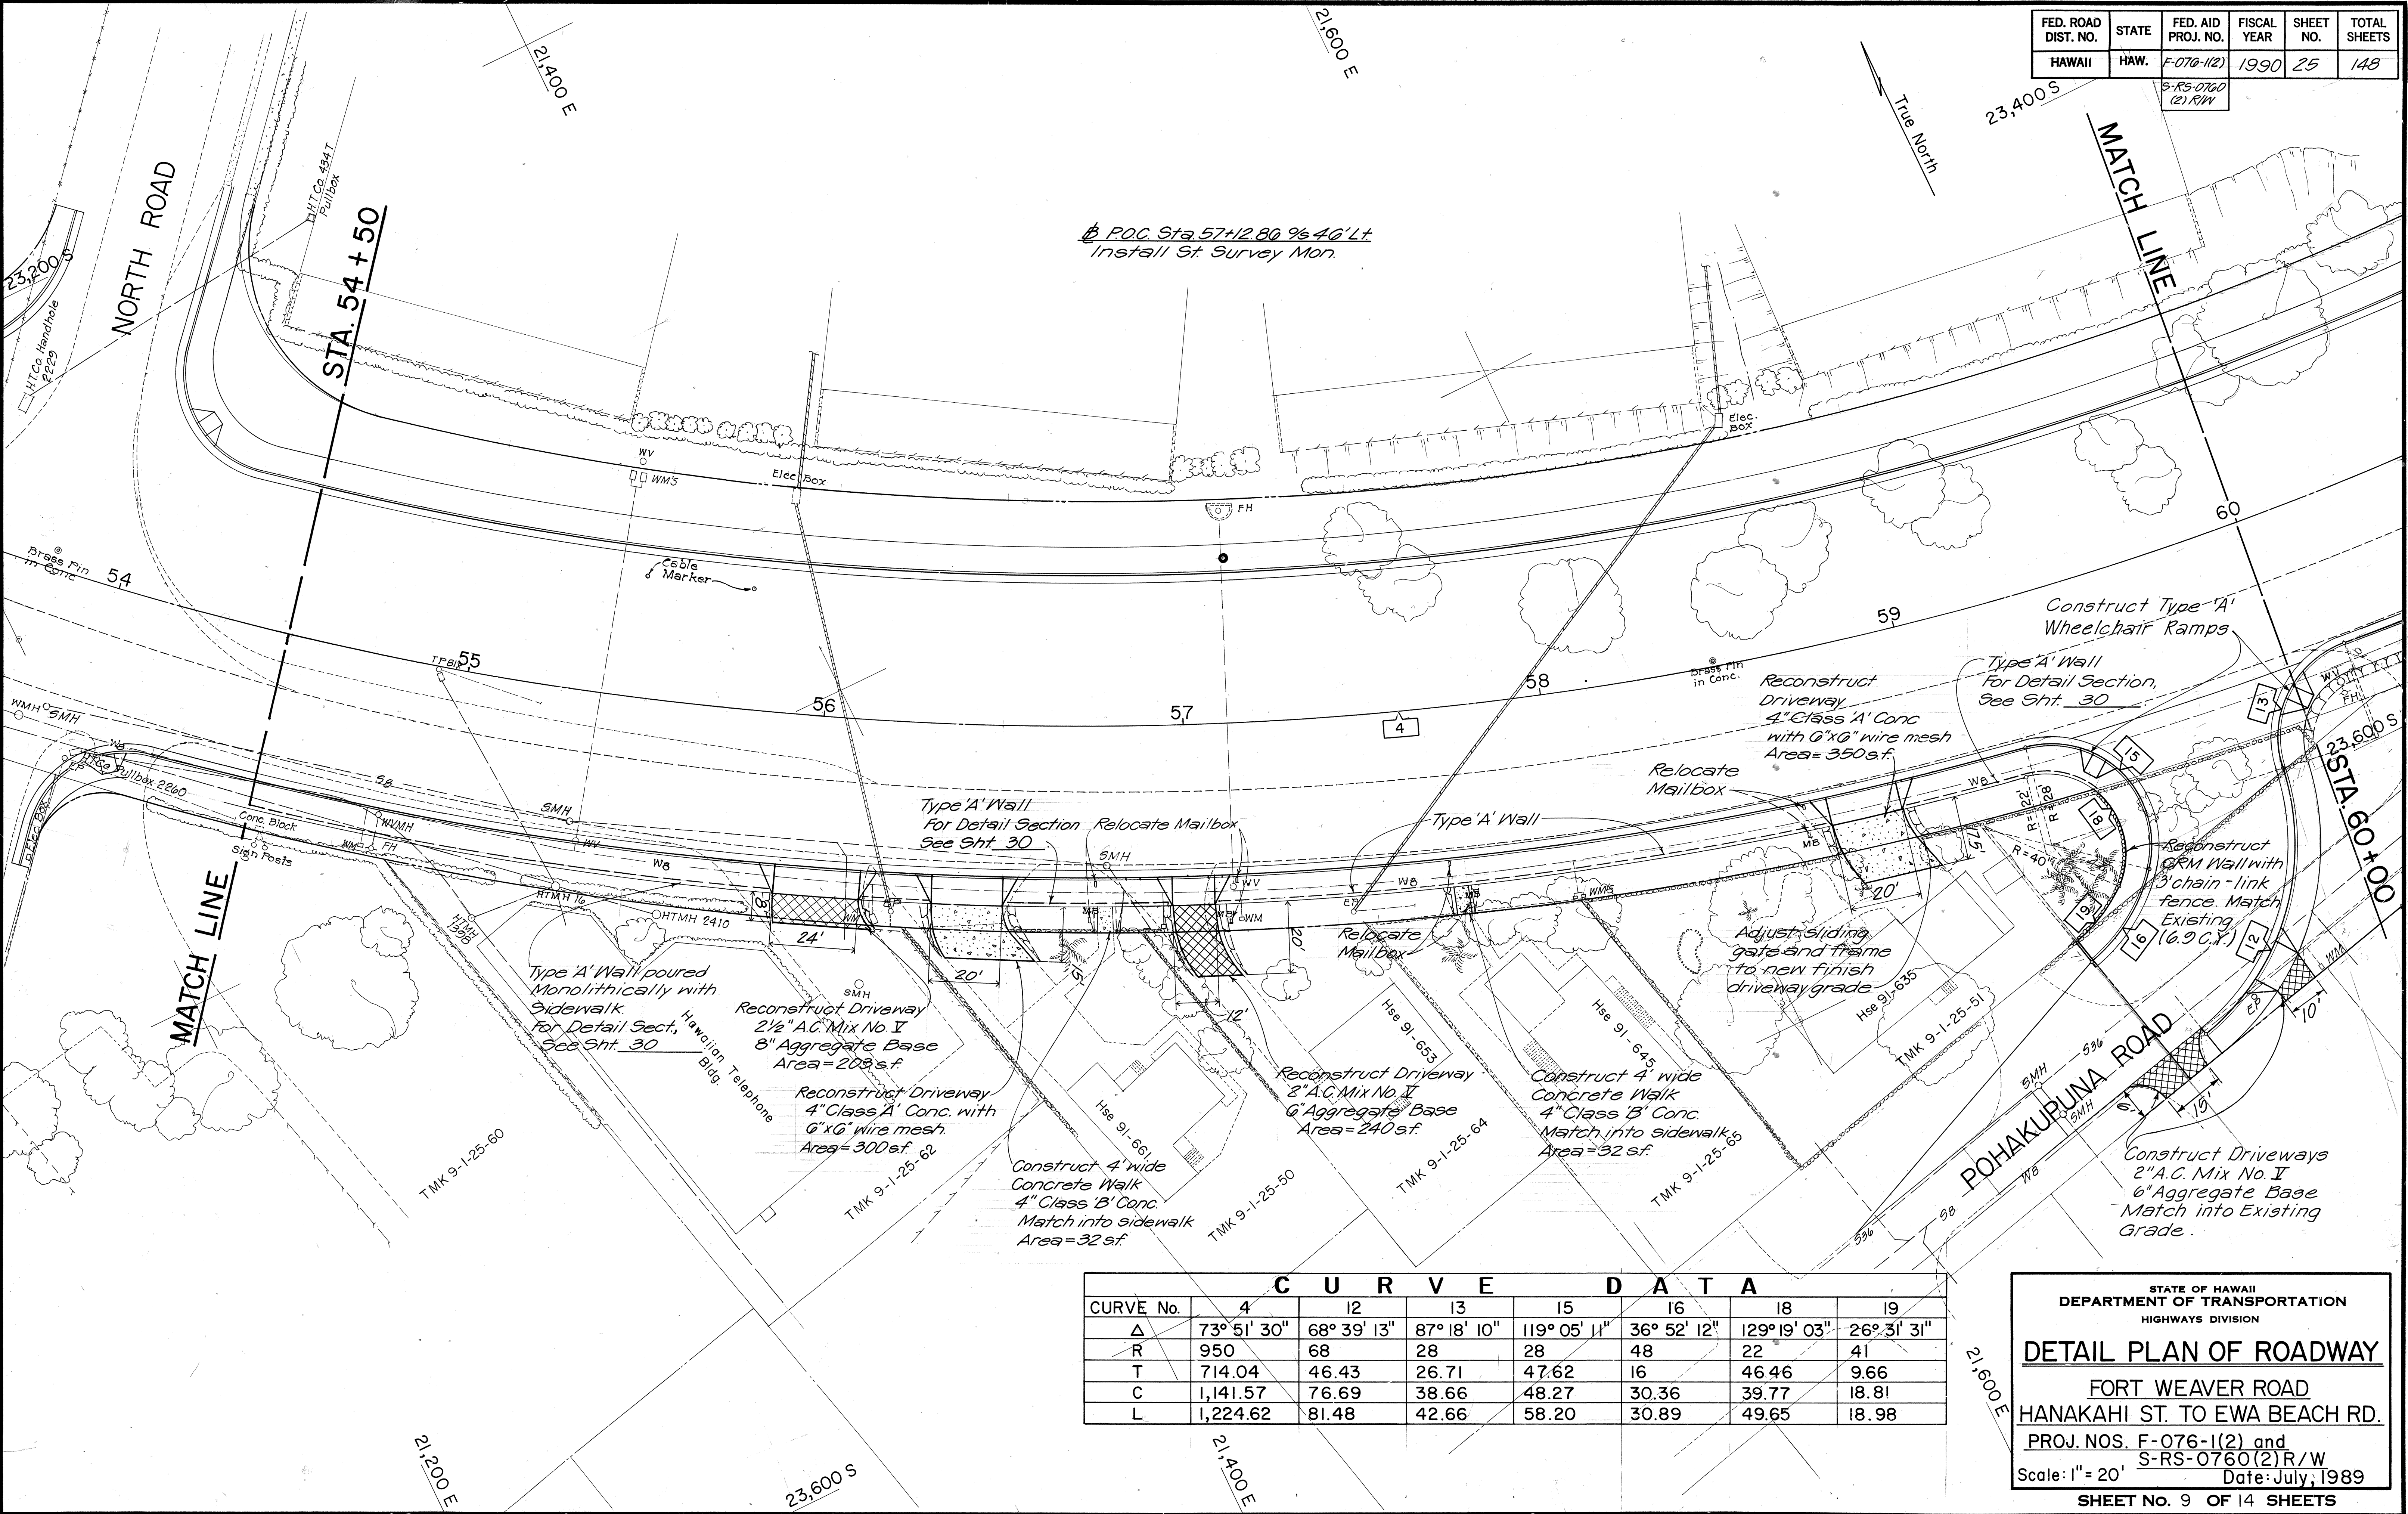

FED. ROAD DIST. NO.	STATE	FED. AID PROJ. NO.	FISCAL YEAR	SHEET NO.	TOTAL SHEETS
HAWAII	HAW.	F-076-1(2) S-RS-0760 (2) R/W	1990	26	148

CURVE DATA 4
 $\Delta = 73^\circ 51' 30''$
 $R = 950$
 $T = 714.04$
 $C = 1,141.57$
 $L = 1,224.62$

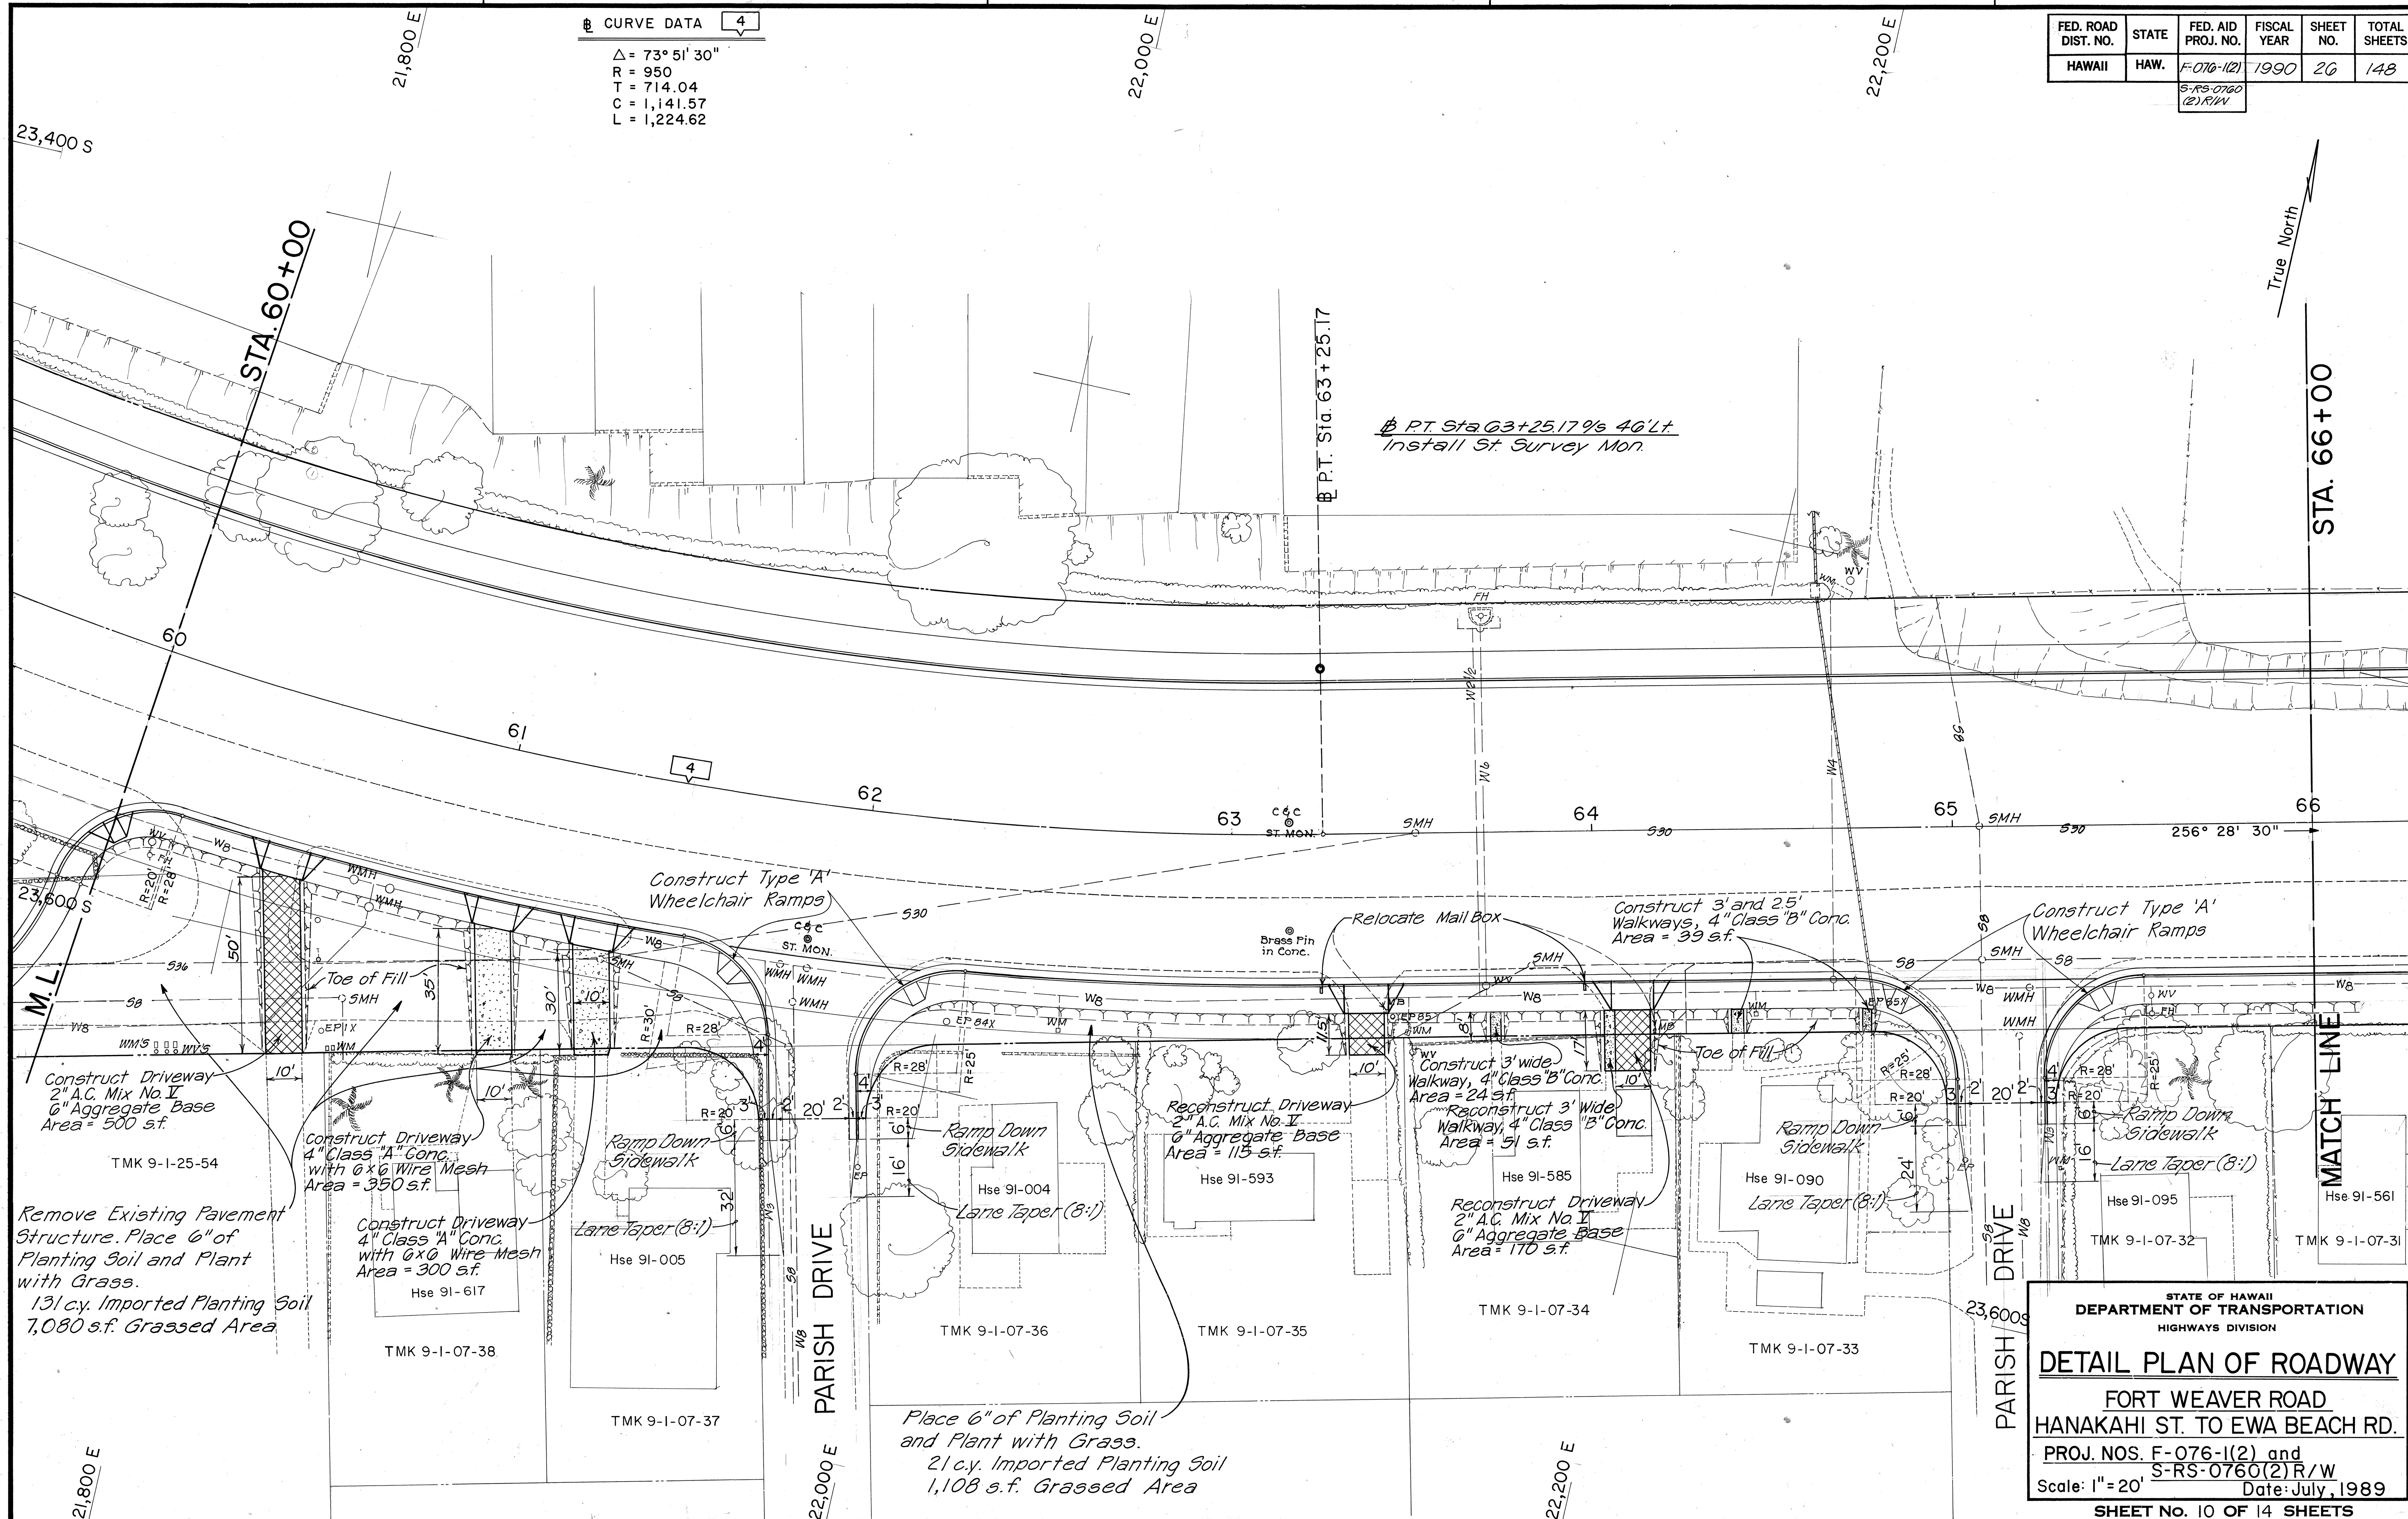

DATE	_____
SURVEY PLOTTED BY	_____
DRAWN BY	_____
TRACED BY	_____
DESIGNED BY	_____
QUANTITIES BY	_____
CHECKED BY	_____
NO.	_____

STATE OF HAWAII
DEPARTMENT OF TRANSPORTATION
HIGHWAYS DIVISION

DETAIL PLAN OF ROADWAY

FORT WEAVER ROAD
HANAKAHI ST. TO EWA BEACH RD.

PROJ. NOS. F-076-1(2) and
S-RS-0760(2) R/W


Scale: 1" = 20' Date: July, 1989

SHEET No. 10 OF 14 SHEETS

FED. ROAD DIST. NO.	STATE	FED. AID PROJ. NO.	FISCAL YEAR	SHEET NO.	TOTAL SHEETS
HAWAII	HAW.	F-076-1(2) S-RS-0760 (2) R/W	1990	27	148

True North

ORIGINAL PLAN	DATE
DRAWN BY	
DESIGNED BY	
QUANTITIES BY	
CHECKED BY	

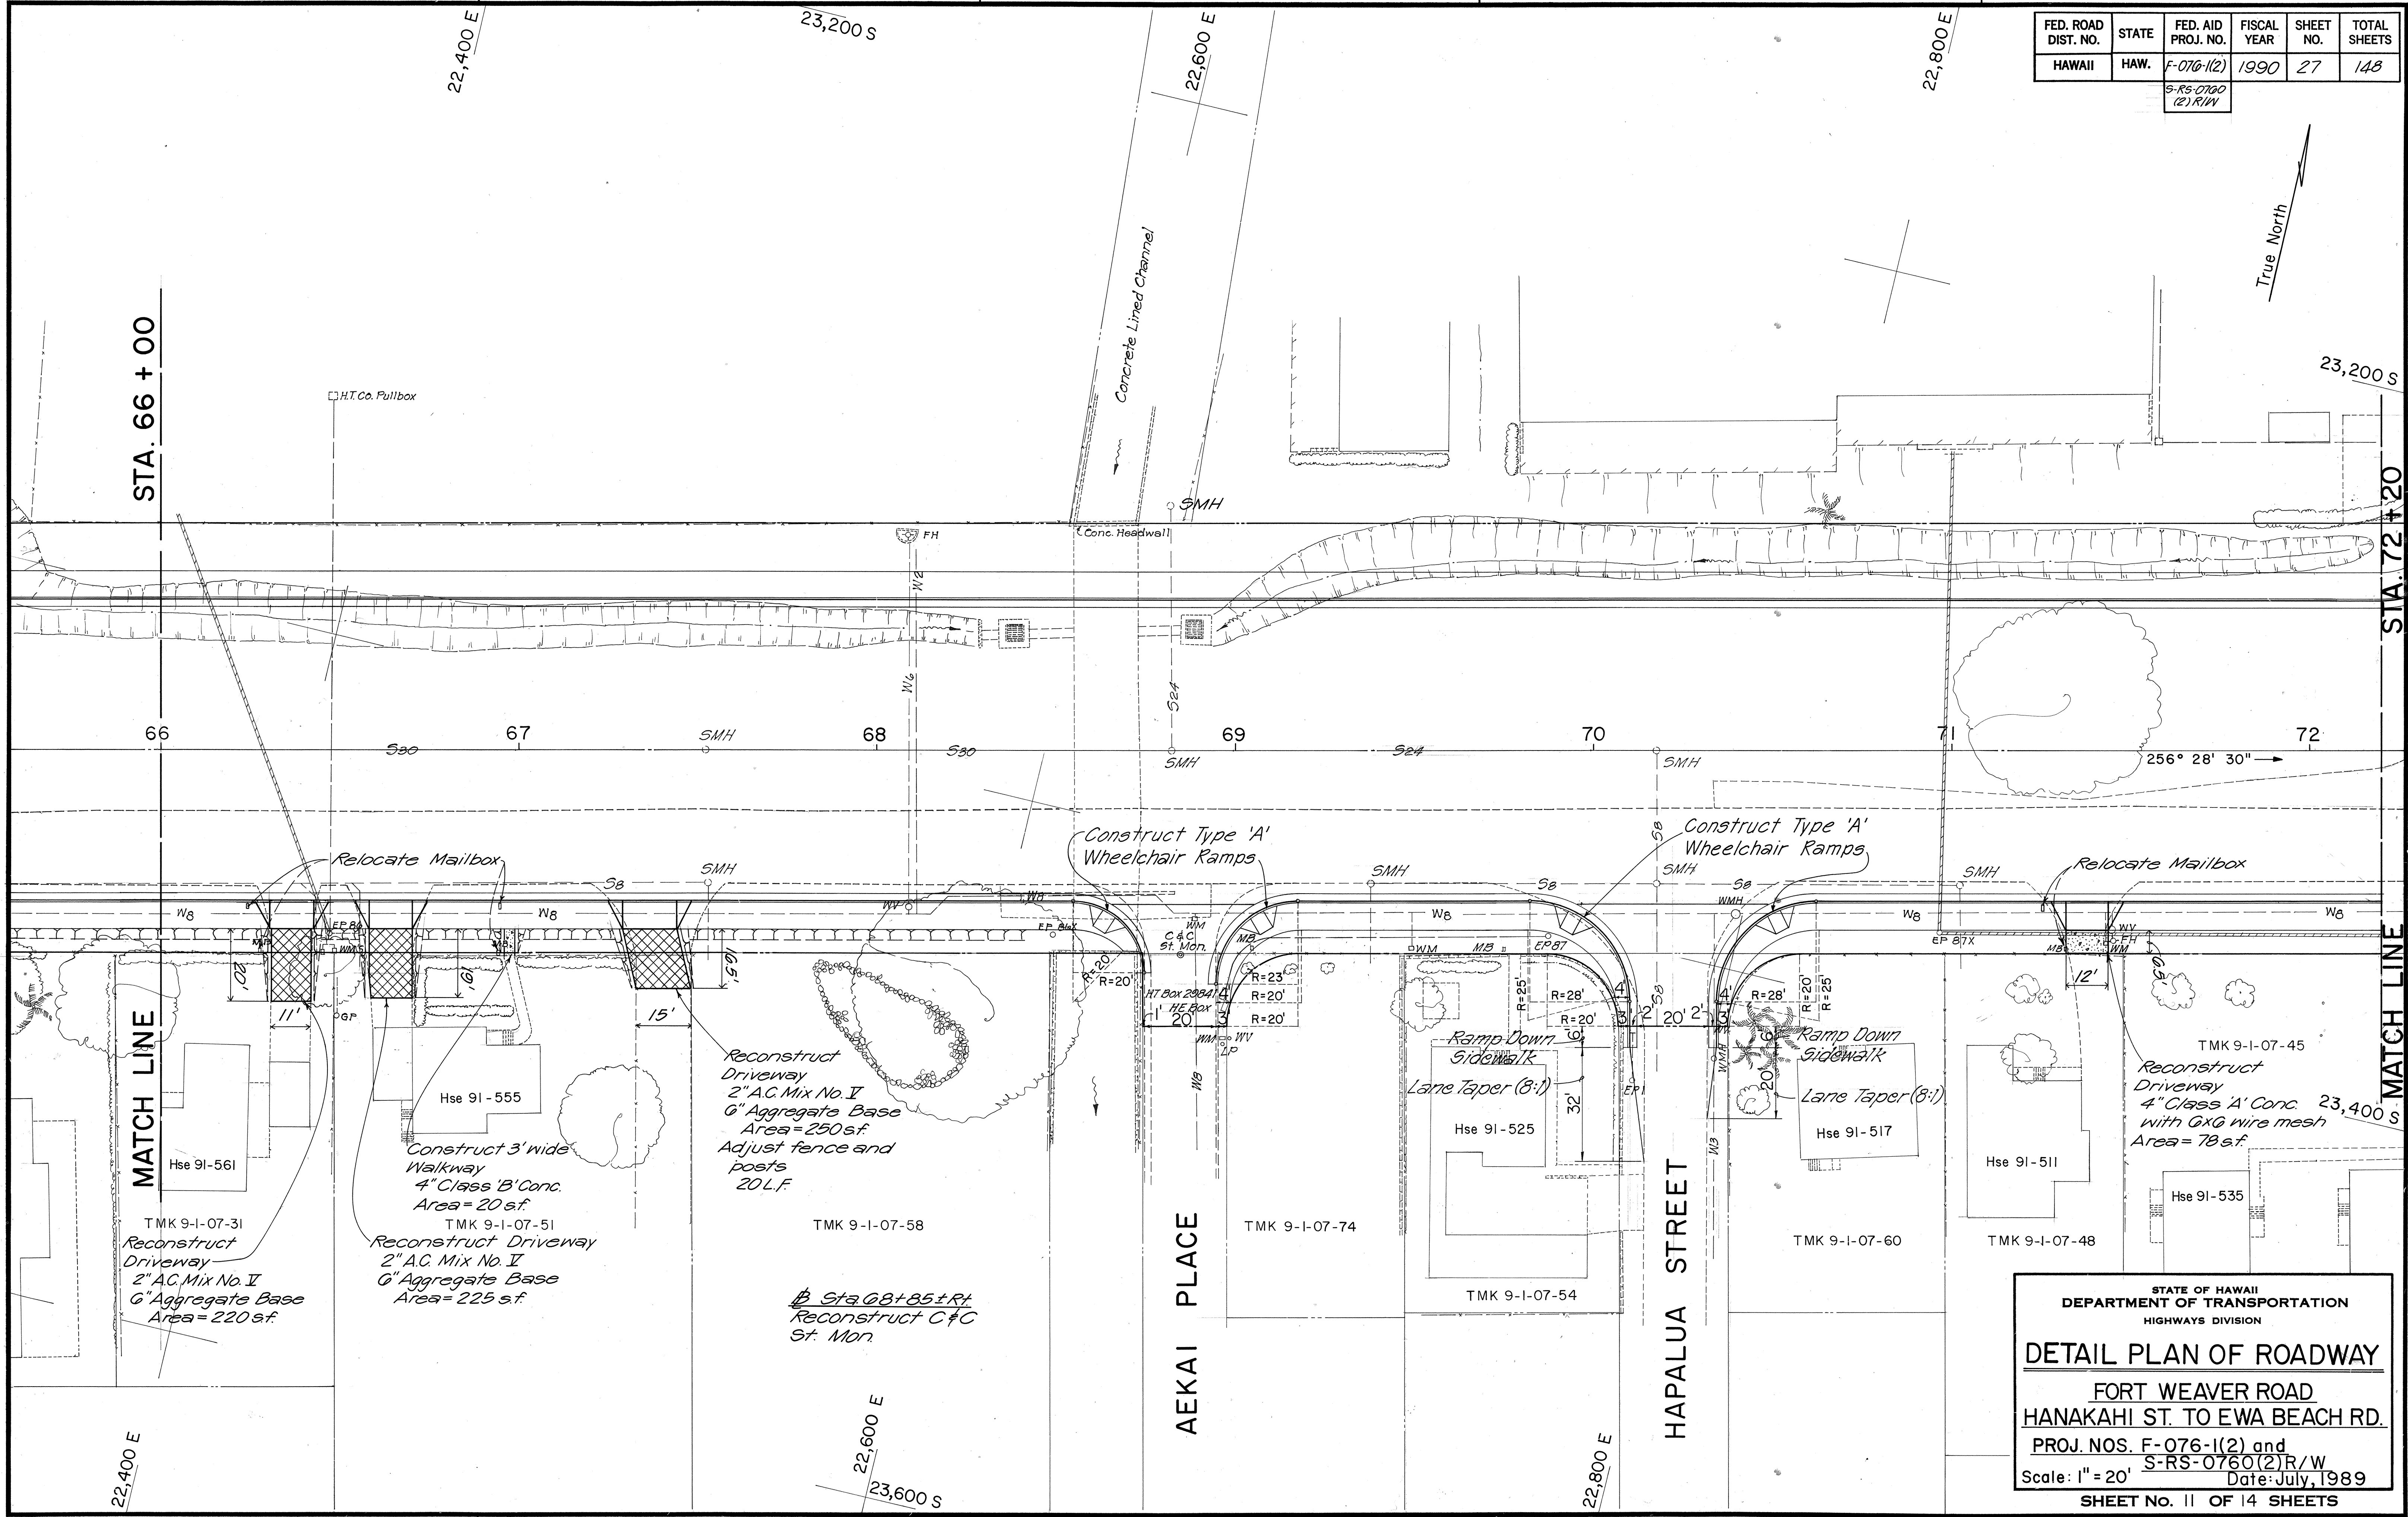

STATE OF HAWAII
DEPARTMENT OF TRANSPORTATION
HIGHWAYS DIVISION

DETAIL PLAN OF ROADWAY

FORT WEAVER ROAD
HANAKAHI ST. TO EWA BEACH RD.



PROJ. NOS. F-076-1(2) and
S-RS-0760(2) R/W

Scale: 1" = 20' Date: July, 1989

SHEET NO. 11 OF 14 SHEETS

FED. ROAD DIST. NO.	STATE	FED. AID PROJ. NO.	FISCAL YEAR	SHEET NO.	TOTAL SHEETS
HAWAII	HAW.	F-076-1(2) S-RS-0760 (2) R/W	1990	28	148

CURVE DATA 5
 $\Delta = 3^\circ 31' 33''$
 $R = 6,000$
 $T = 184.67$
 $C = 369.17$
 $L = 369.23$

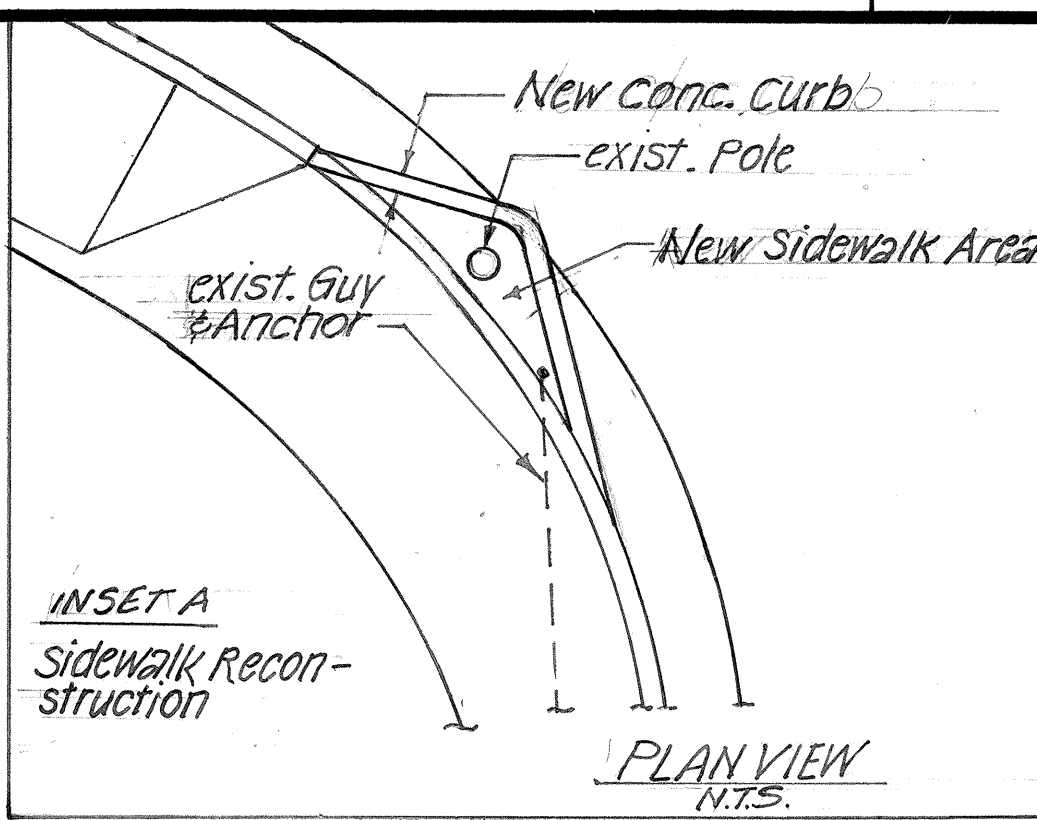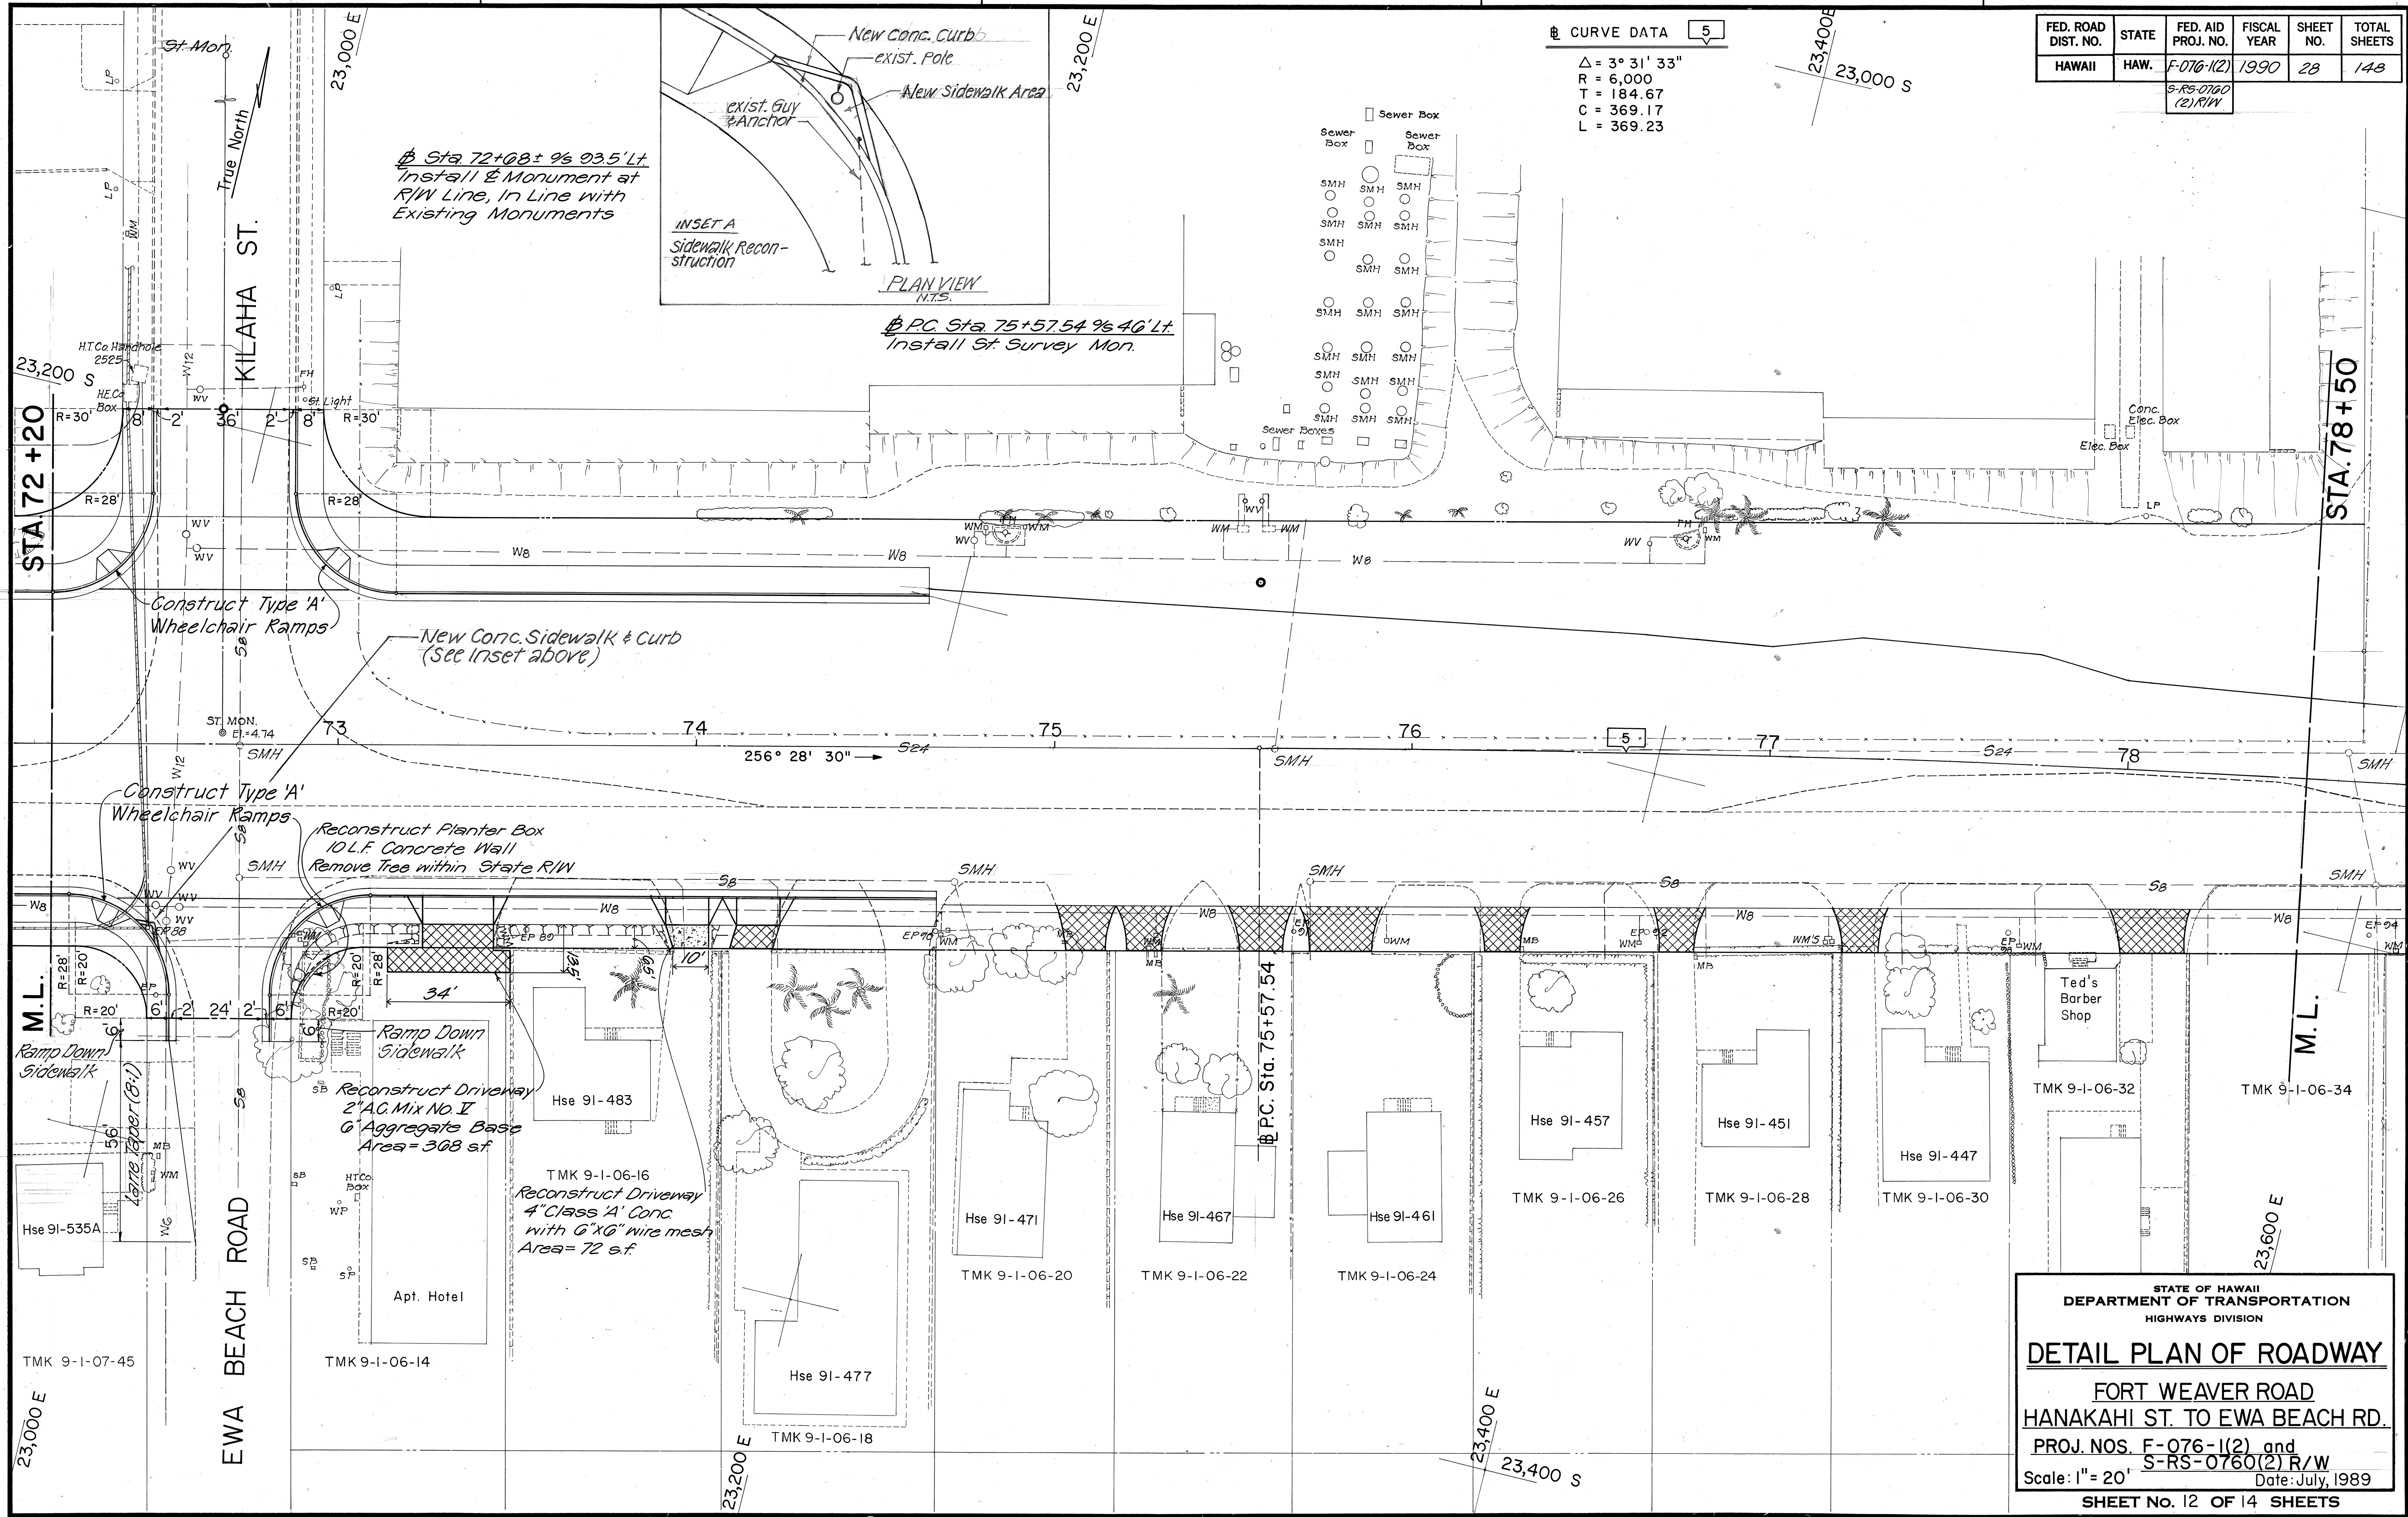

ORIGINAL PLAN	SURVEY PLOTTED BY	DATE
NOTE BOOK	DRAWN BY	
QUANTITIES BY	DESIGNED BY	
CHECKED BY		

STATE OF HAWAII
DEPARTMENT OF TRANSPORTATION
HIGHWAYS DIVISION

DETAIL PLAN OF ROADWAY

FORT WEAVER ROAD
HANAKAHI ST. TO EWA BEACH RD.


PROJ. NOS. F-076-1(2) and
S-RS-0760(2) R/W

Scale: 1" = 20' Date: July, 1989

SHEET NO. 12 OF 14 SHEETS

FED. ROAD DIST. NO.	STATE	FED. AID PROJ. NO.	FISCAL YEAR	SHEET NO.	TOTAL SHEETS
HAWAII	HAW.	F-076-1(2)	1990	29	148
S-RS-0760 (2) R/W					


CURVE DATA 6
 $\Delta = 3^{\circ} 31' 33''$
 $R = 8,000$
 $T = 246.23$
 $C = 492.23$
 $L = 492.30$

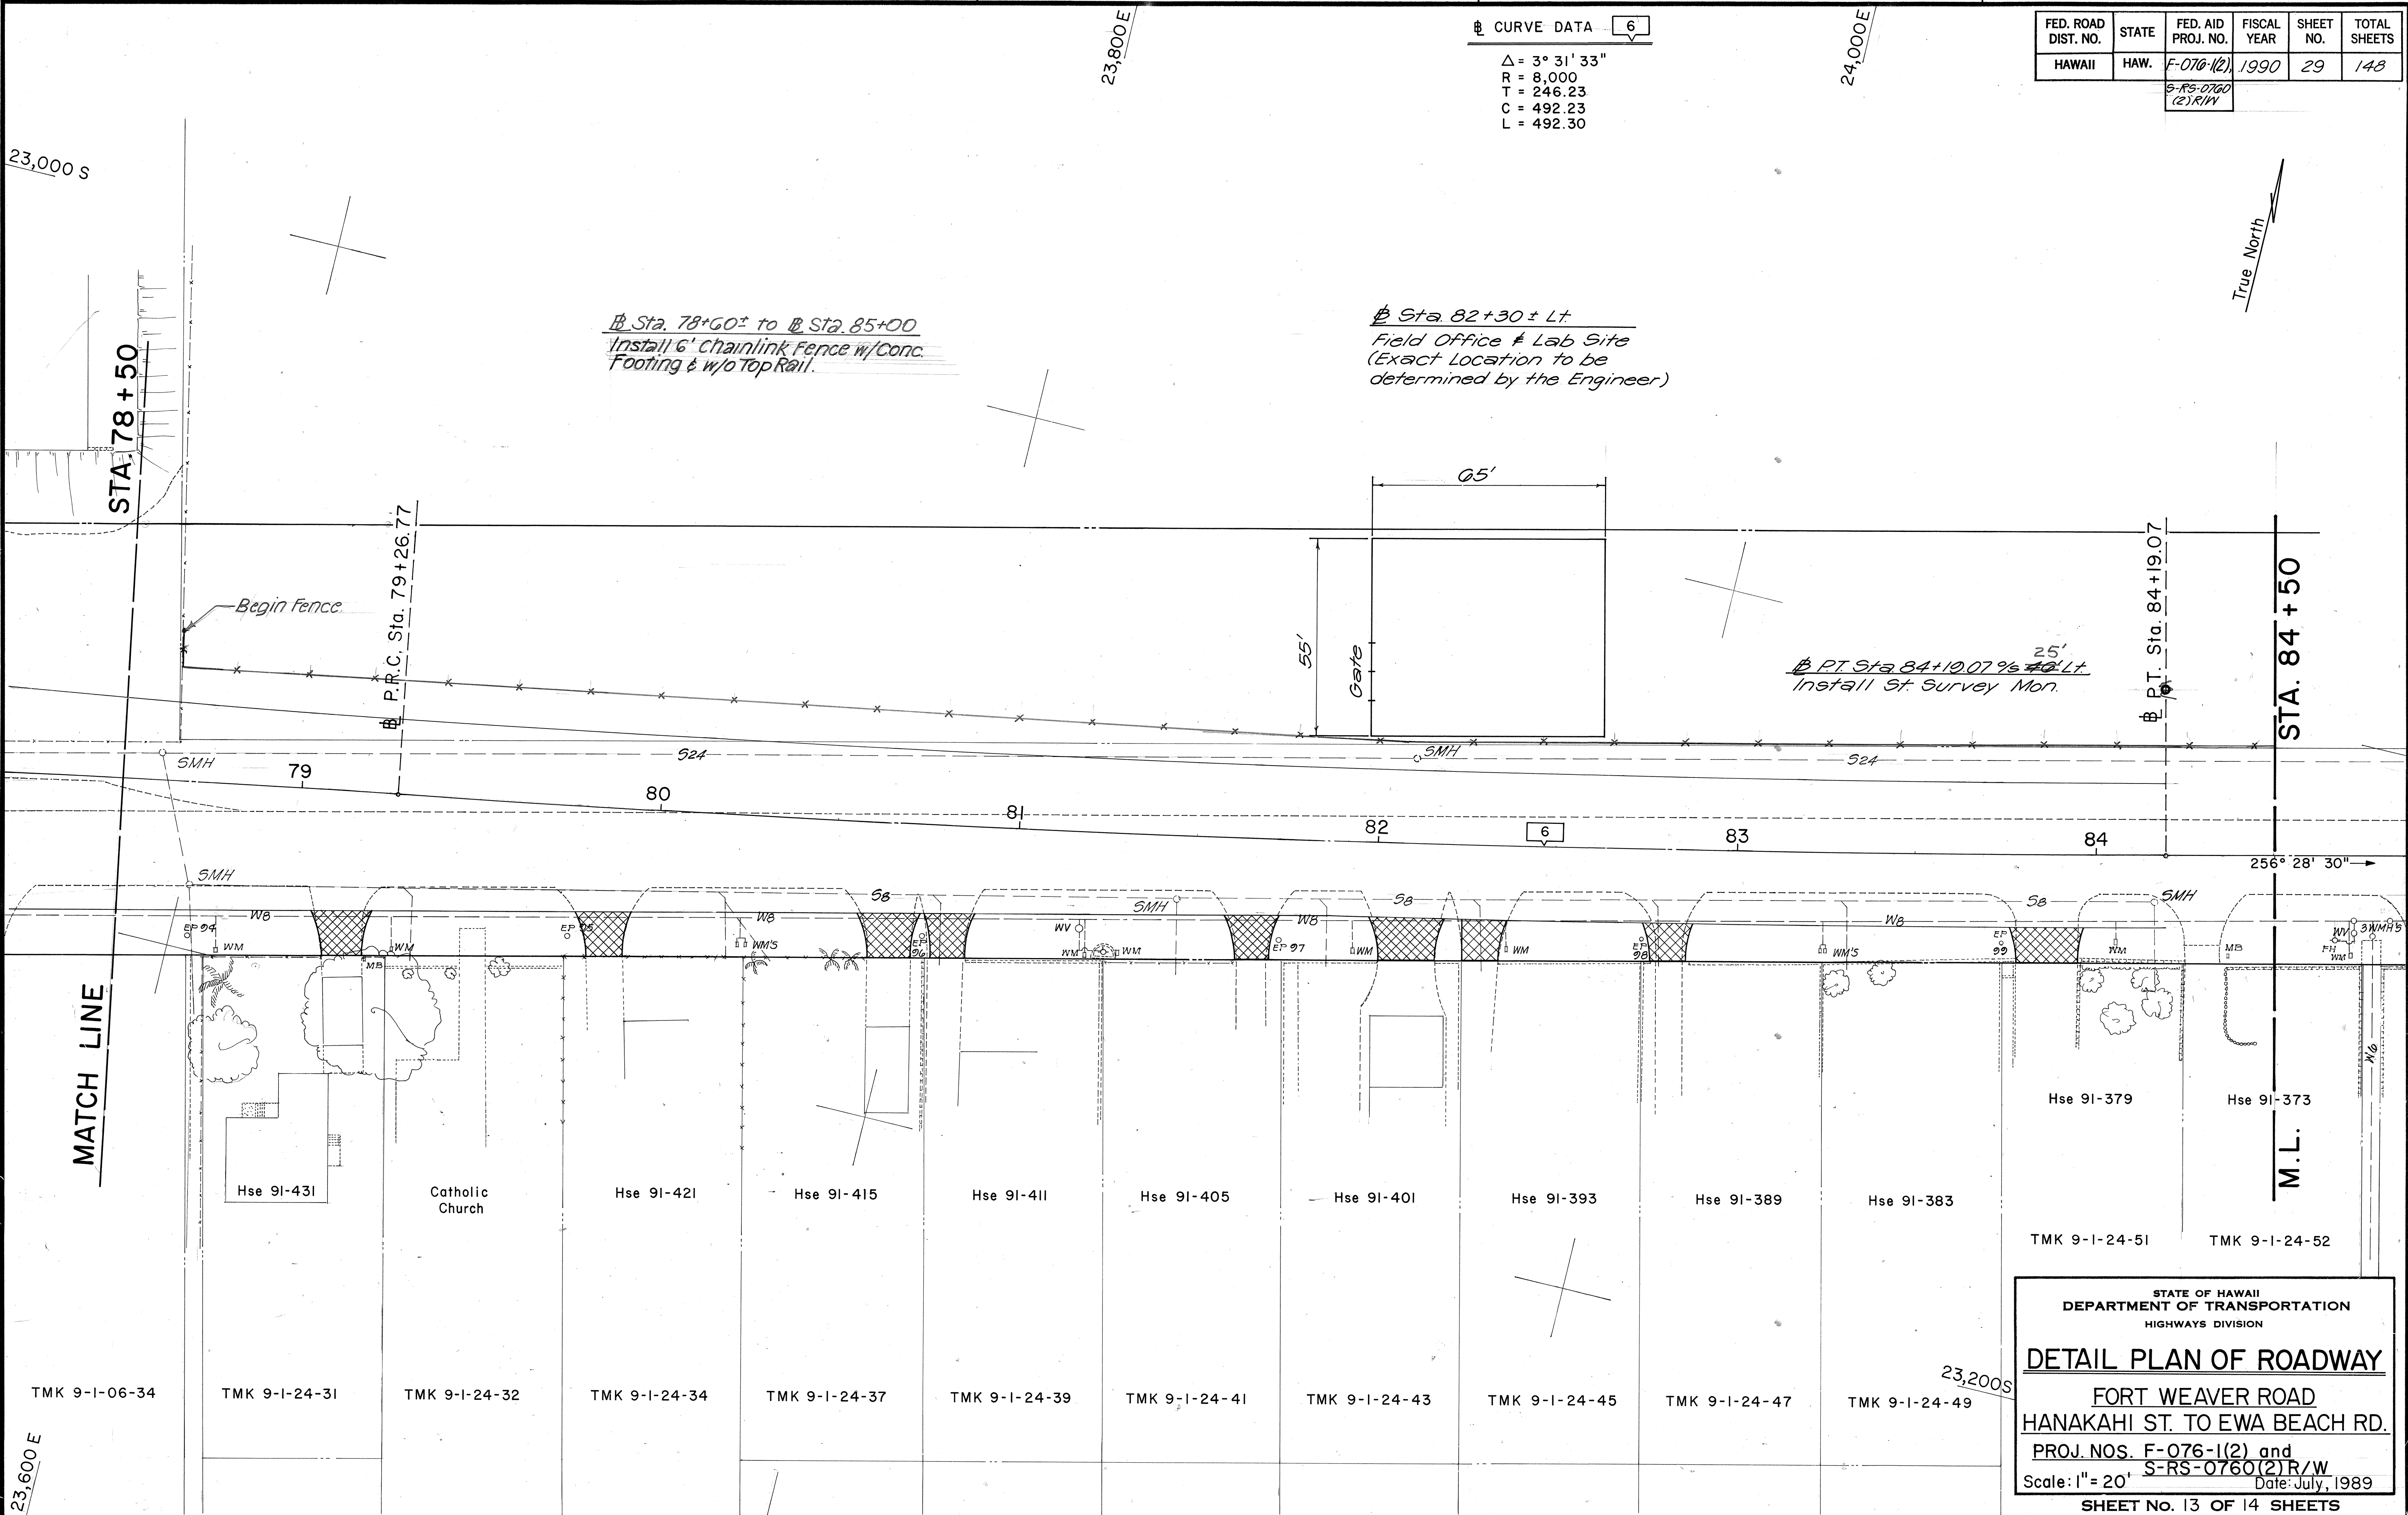


ORIGINAL PLAN	SURVEY PLOTTED BY	DATE
DESIGNED BY	DRAWN BY	
QUANTITIES BY	TRACED BY	
CHECKED BY		

STATE OF HAWAII
 DEPARTMENT OF TRANSPORTATION
 HIGHWAYS DIVISION
DETAIL PLAN OF ROADWAY
 FORT WEAVER ROAD
 HANAKAHI ST. TO EWA BEACH RD.
 PROJ. NOS. F-076-1(2) and S-RS-0760(2) R/W
 Scale: 1" = 20' Date: July, 1989
 SHEET NO. 13 OF 14 SHEETS


FED. ROAD DIST. NO.	STATE	FED. AID PROJ. NO.	FISCAL YEAR	SHEET NO.	TOTAL SHEETS
HAWAII	HAW.	F-076-1(2)	1990	30	148
S-RS-0760(2) R/W					

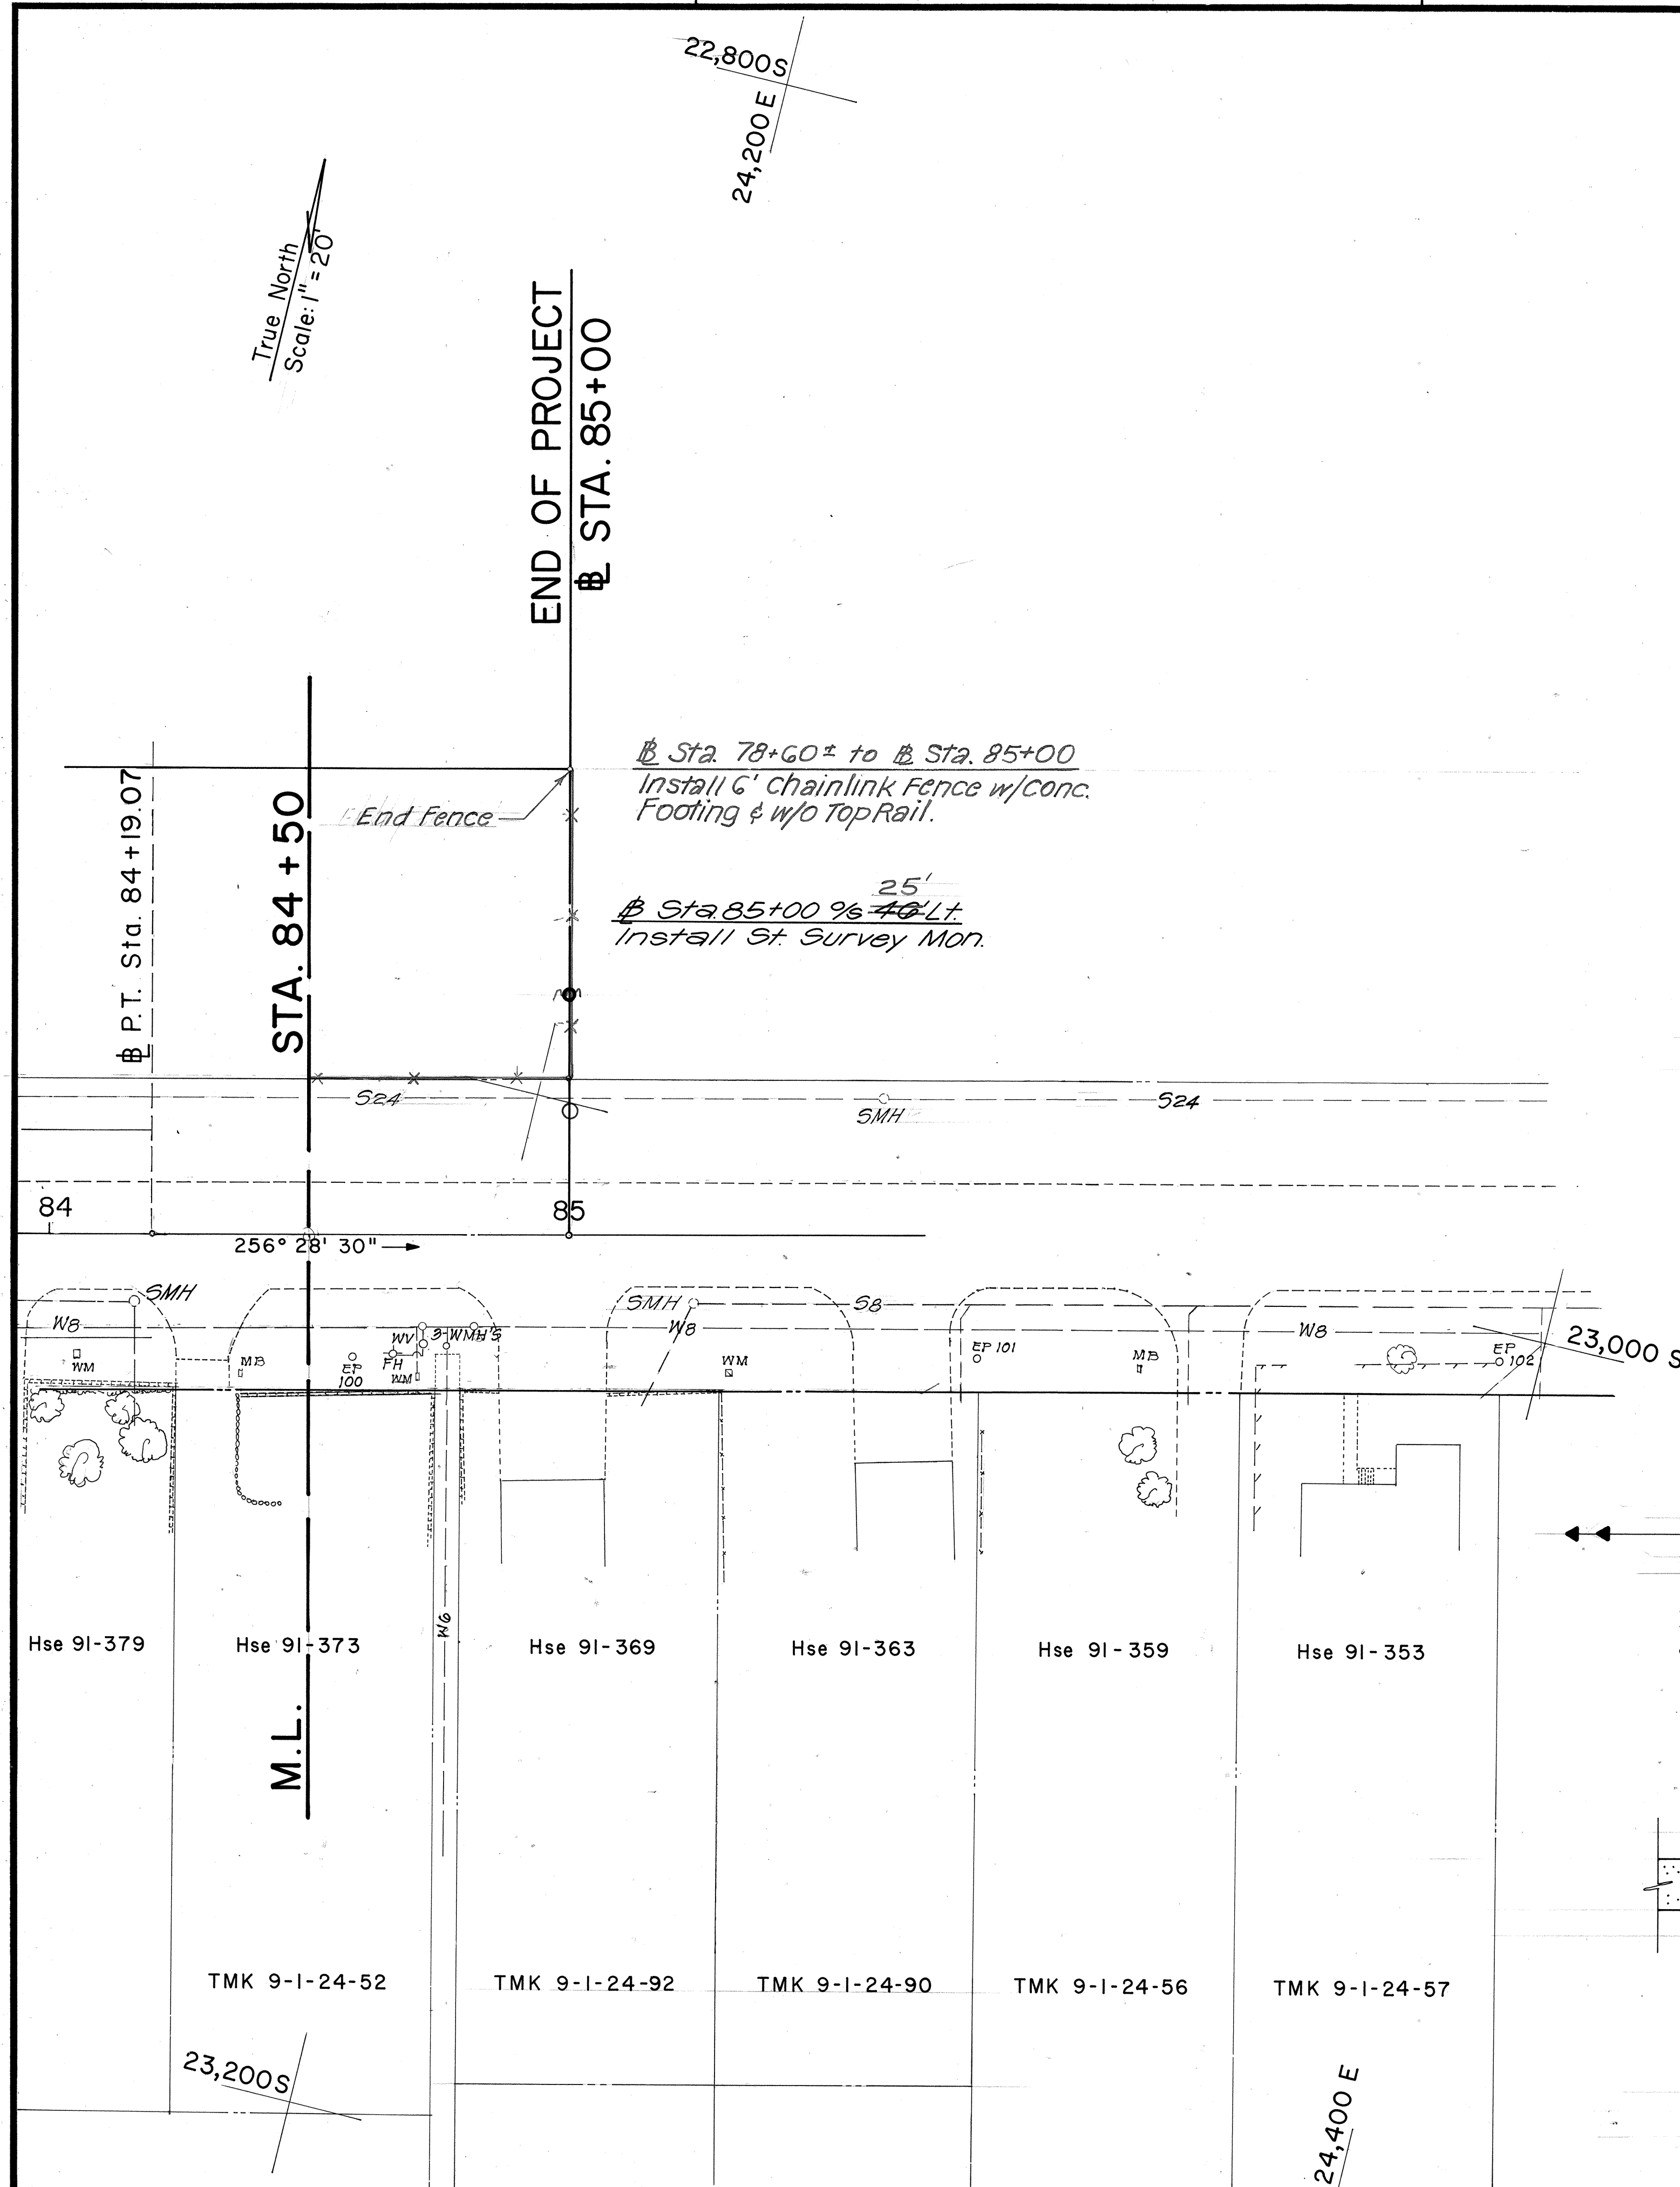


24,400 E
22,800 S

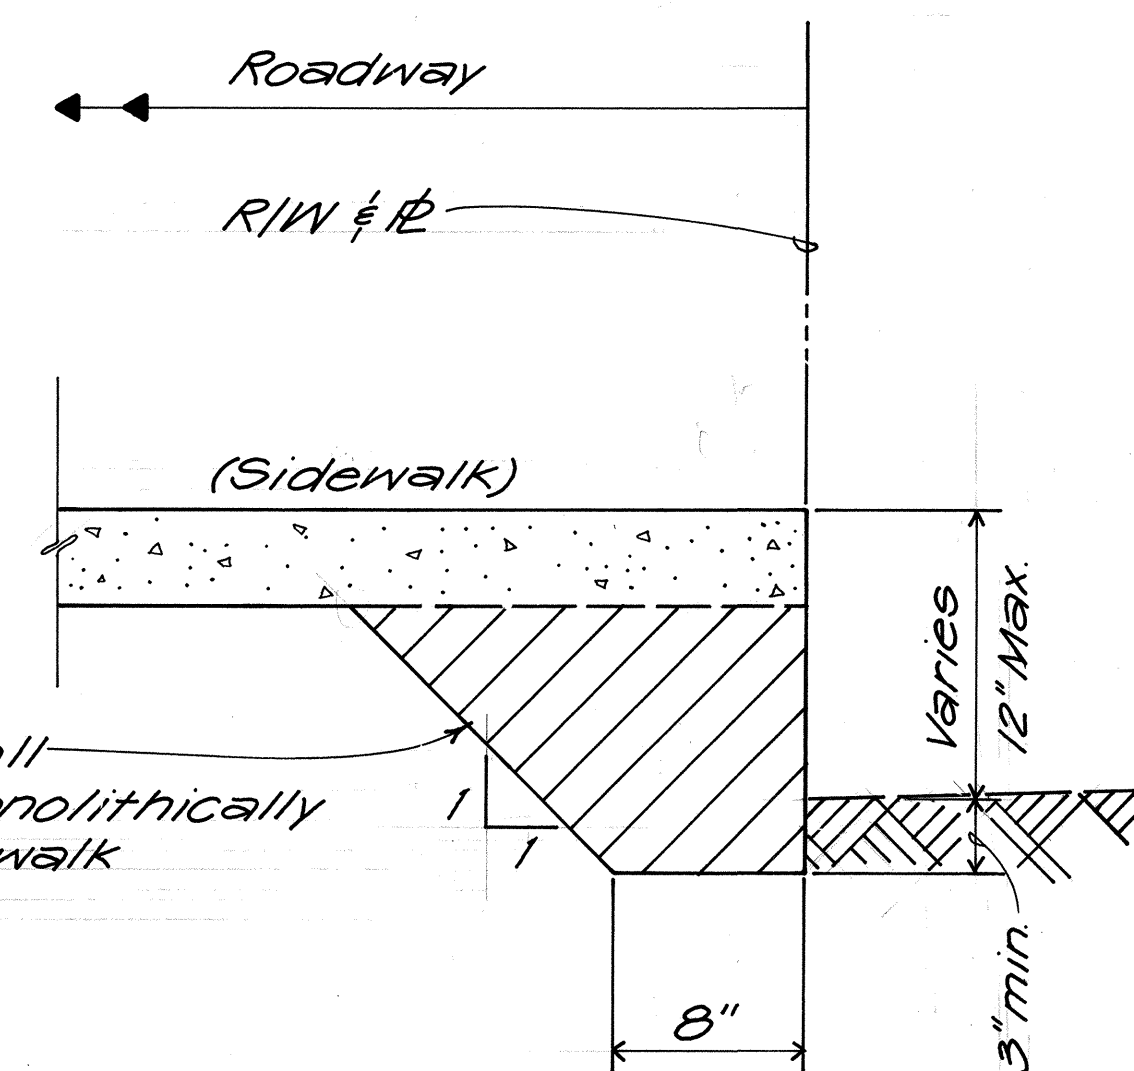

TYPE 'A' WALL DETAIL
Scale: 1 1/2" = 1'-0"

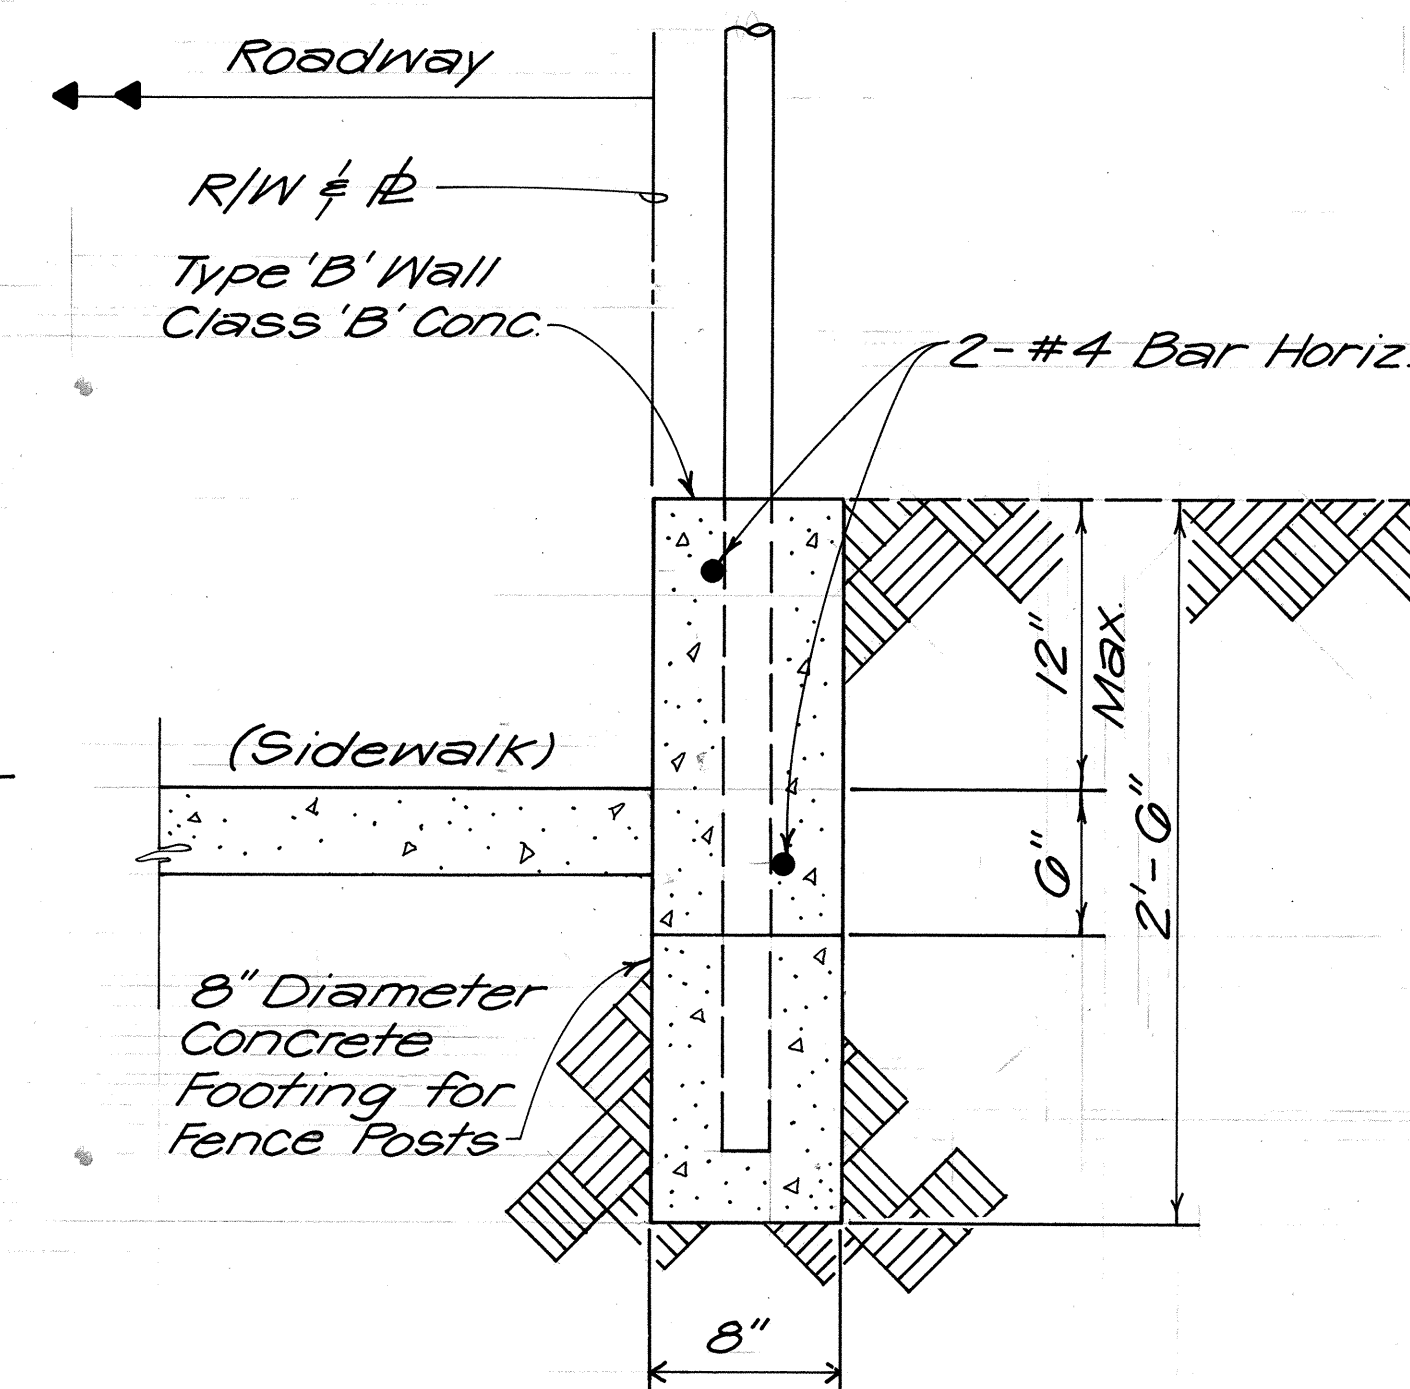

TYPE 'B' WALL DETAIL FOR FENCE POSTS
Scale: 1 1/2" = 1'-0"

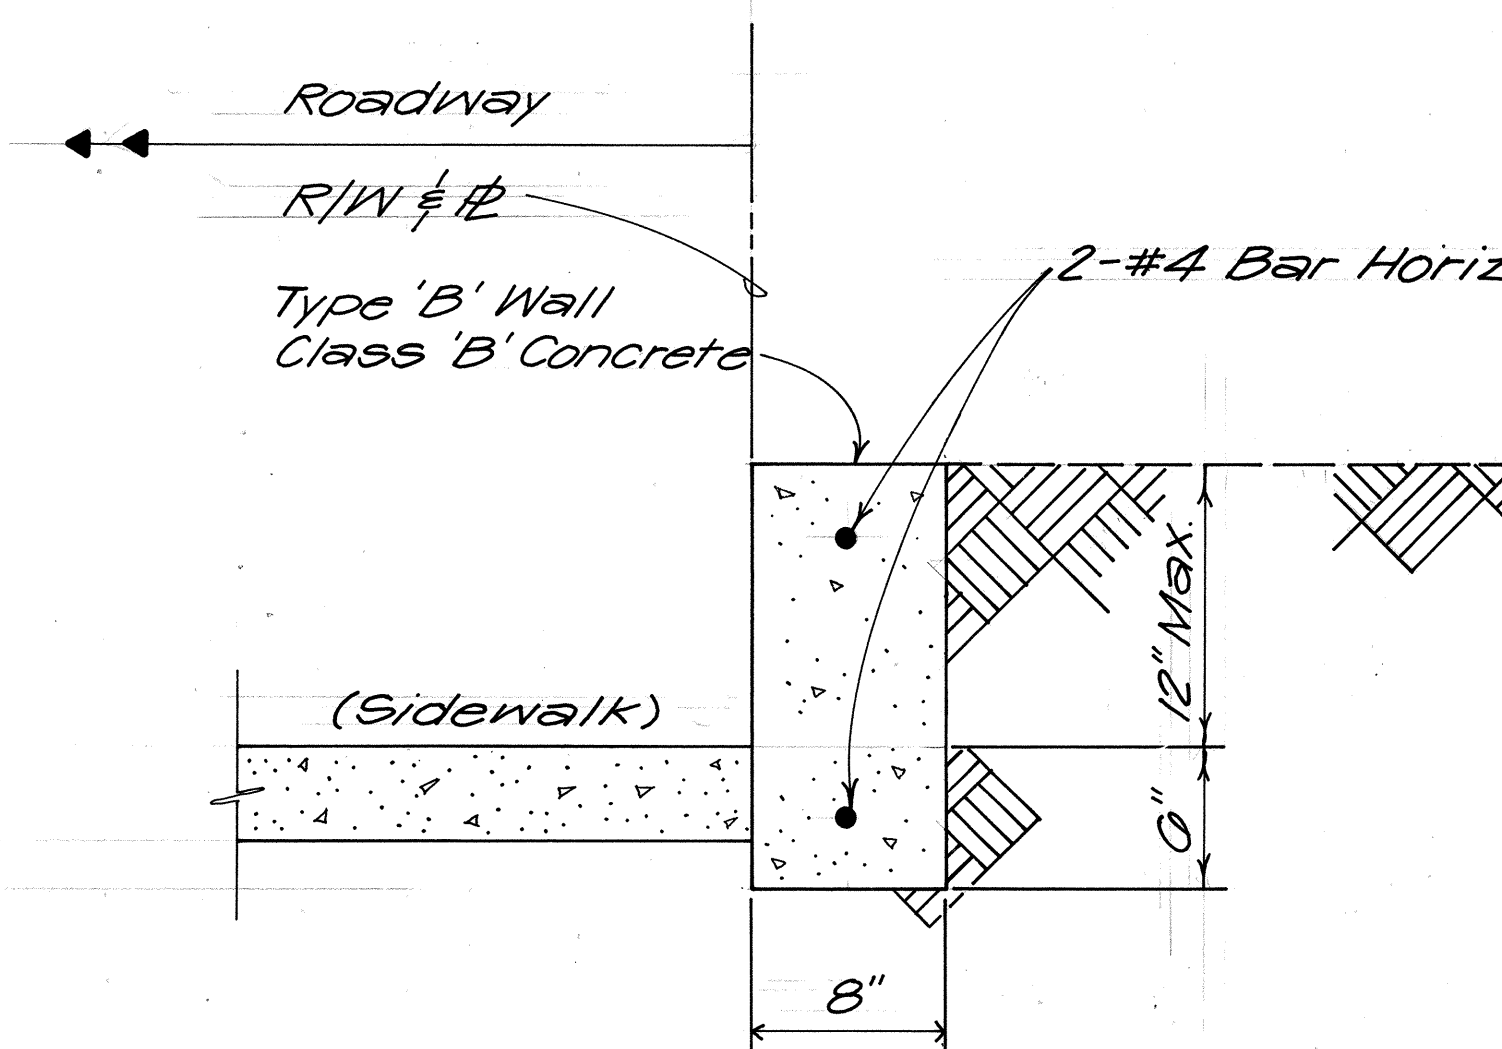

TYPE 'B' WALL DETAIL
Scale: 1 1/2" = 1'-0"

STATE OF HAWAII
DEPARTMENT OF TRANSPORTATION
HIGHWAYS DIVISION

DETAIL PLAN OF ROADWAY

FORT WEAVER ROAD
HANAKAHI ST. TO EWA BEACH RD.

PROJ. NOS. F-076-1(2) and
S-RS-0760(2) R/W


Scale: As Shown Date: July, 1989

SHEET No. 14 OF 14 SHEETS

ORIGINAL PLAN	DATE
SURVEY PLOTTED BY	
DRAWN BY	
DESIGNED BY	
CHECKED BY	
NOTE BOOK	
No.	

FED. ROAD DIST. NO.	STATE	FED. AID PROJ. NO.	FISCAL YEAR	SHEET NO.	TOTAL SHEETS
HAWAII	HAW.	F-076-1(2)	1990	31	148
S-RS-0760(2)R/W					

ORIGINAL PLAN	SURVEY PLOTTED BY	DATE
DESIGNED BY	TRACED BY	
QUANTITY BY	DESIGNED BY	
CHECKED BY	QUANTITY BY	

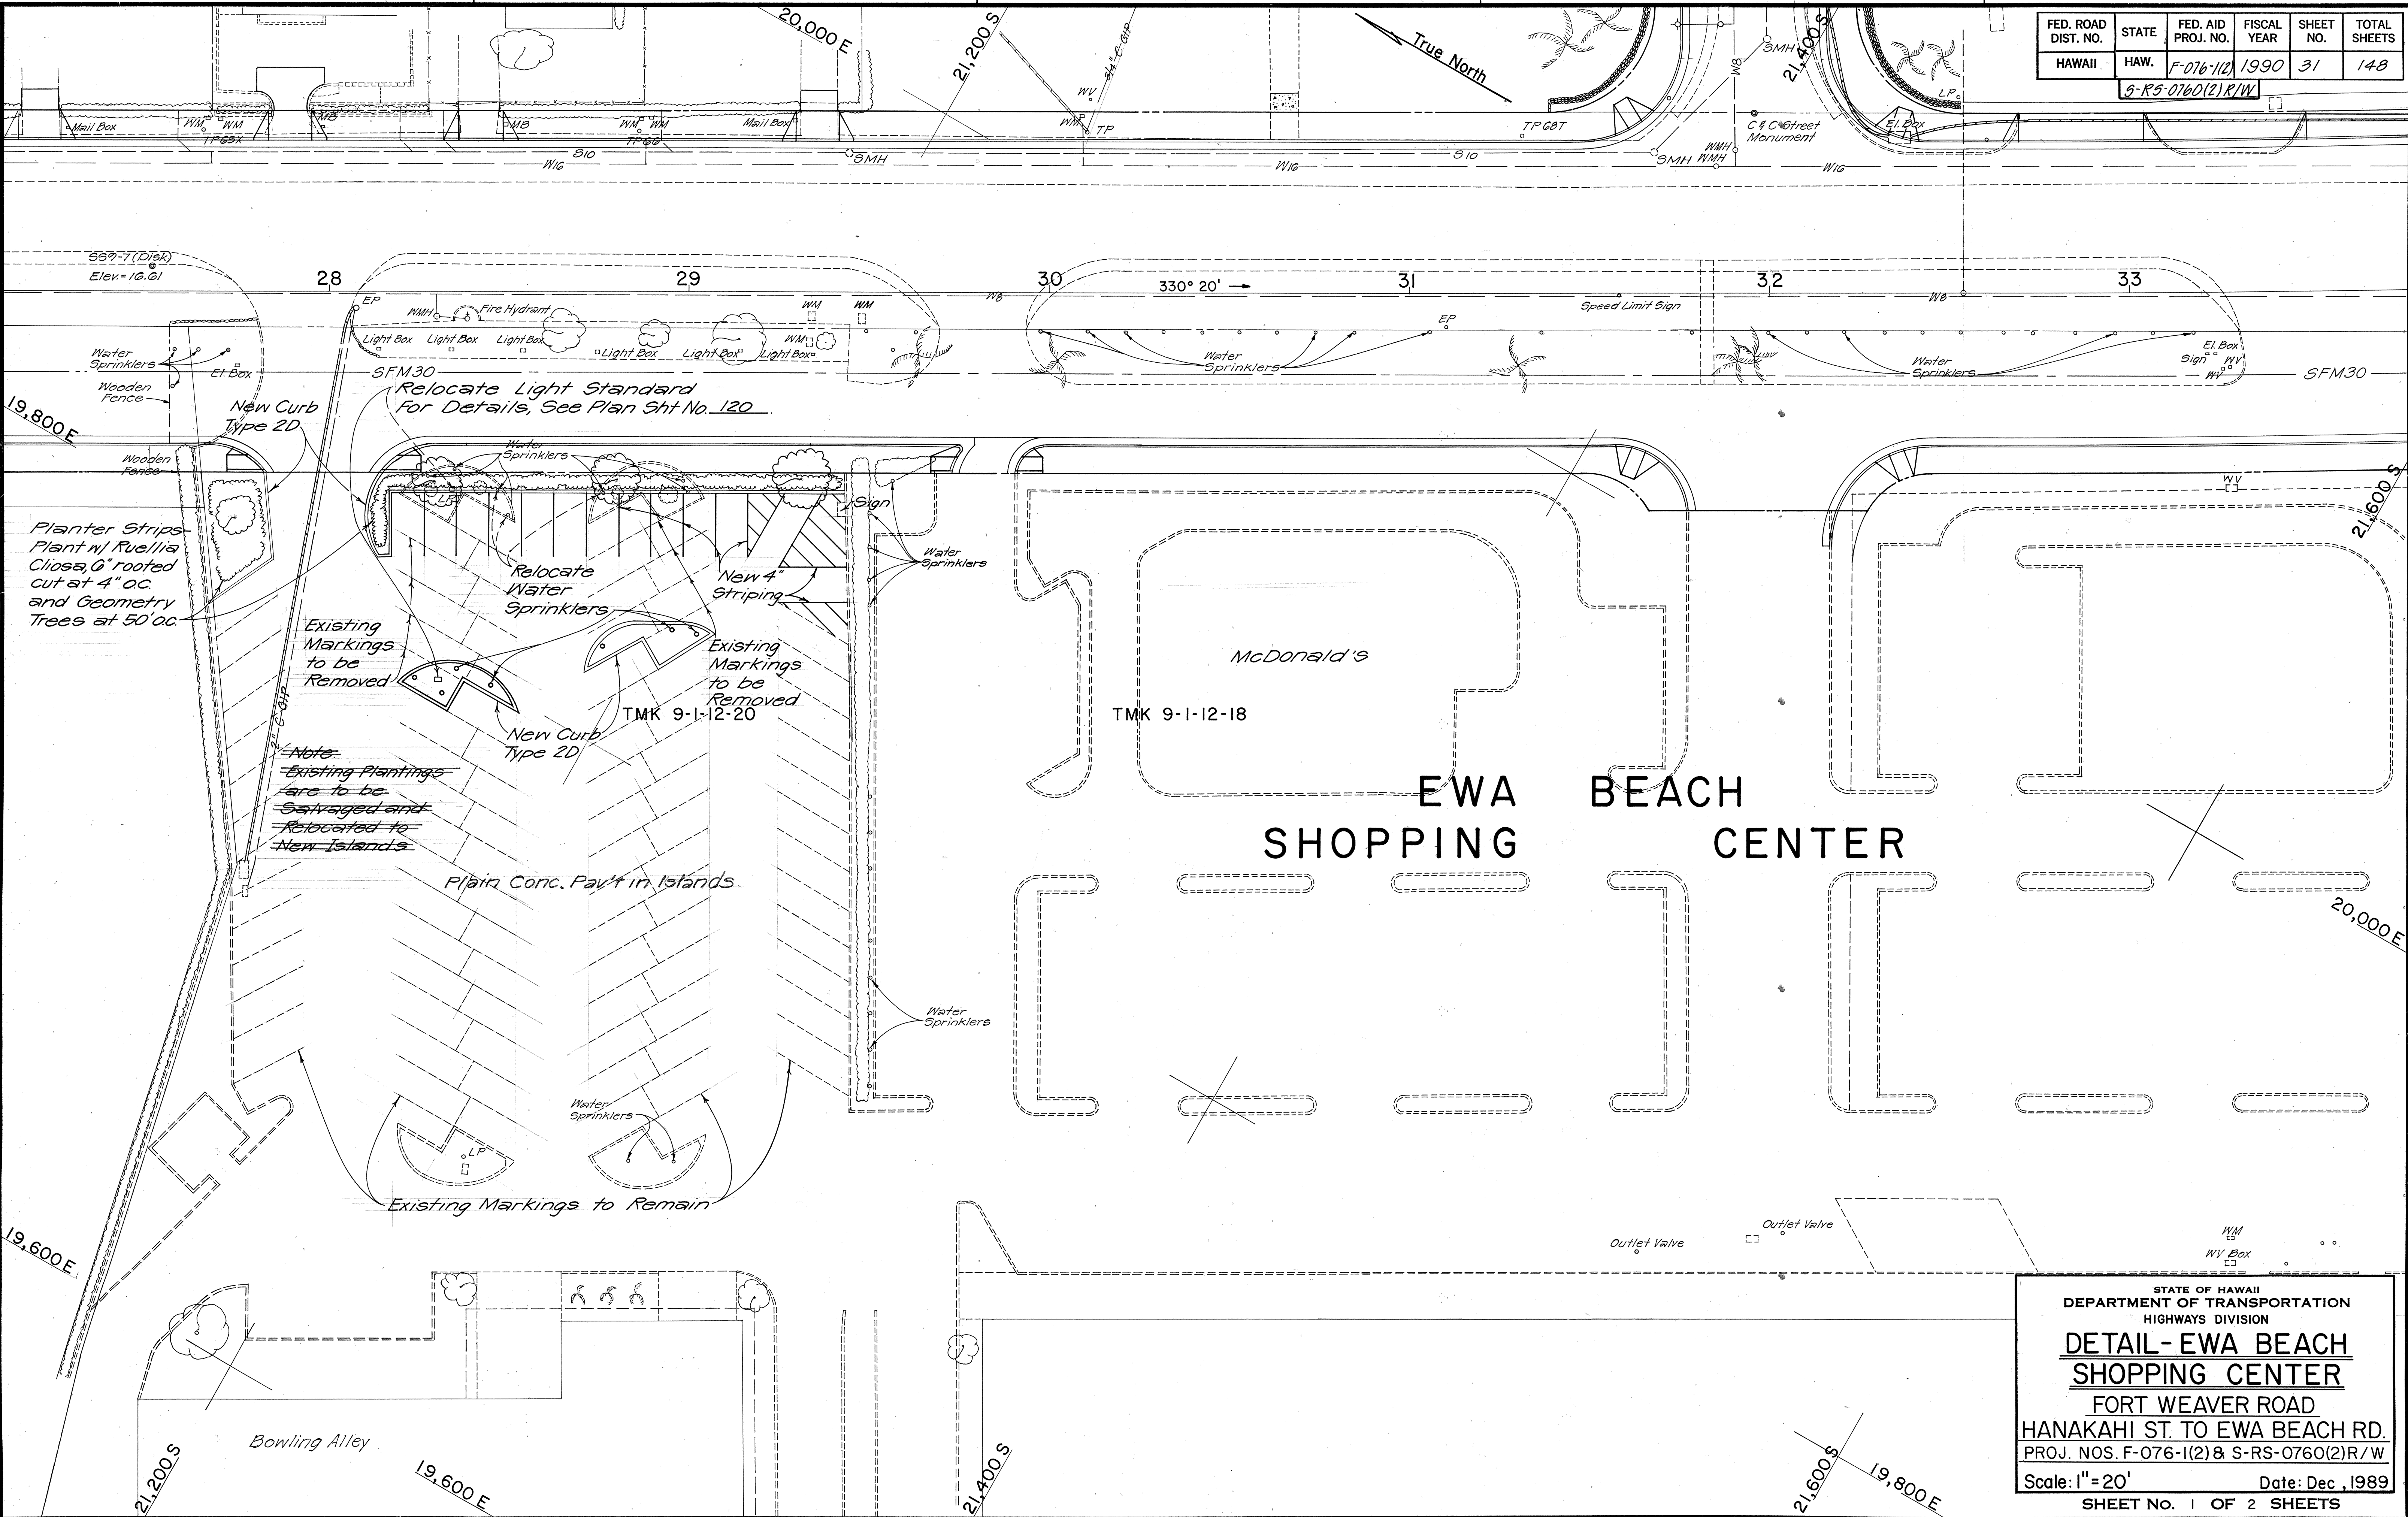

STATE OF HAWAII
DEPARTMENT OF TRANSPORTATION
HIGHWAYS DIVISION

DETAIL - EWA BEACH
SHOPPING CENTER

FORT WEAVER ROAD
HANAKAHI ST. TO EWA BEACH RD.


PROJ. NOS. F-076-1(2) & S-RS-0760(2)R/W

Scale: 1" = 20' Date: Dec., 1989

SHEET NO. 1 OF 2 SHEETS

FED. ROAD DIST. NO.	STATE	FED. AID PROJ. NO.	FISCAL YEAR	SHEET NO.	TOTAL SHEETS
HAWAII	HAW.	F-076-1(2) & S-RS-0760(2)R/W	1990	32	148

ORIGINAL PLAN	SURVEY PLOTTED BY	DATE
NOTE BOOK	DRAWN BY	
	DESIGNED BY	
	QUANTITIES BY	
	CHECKED BY	

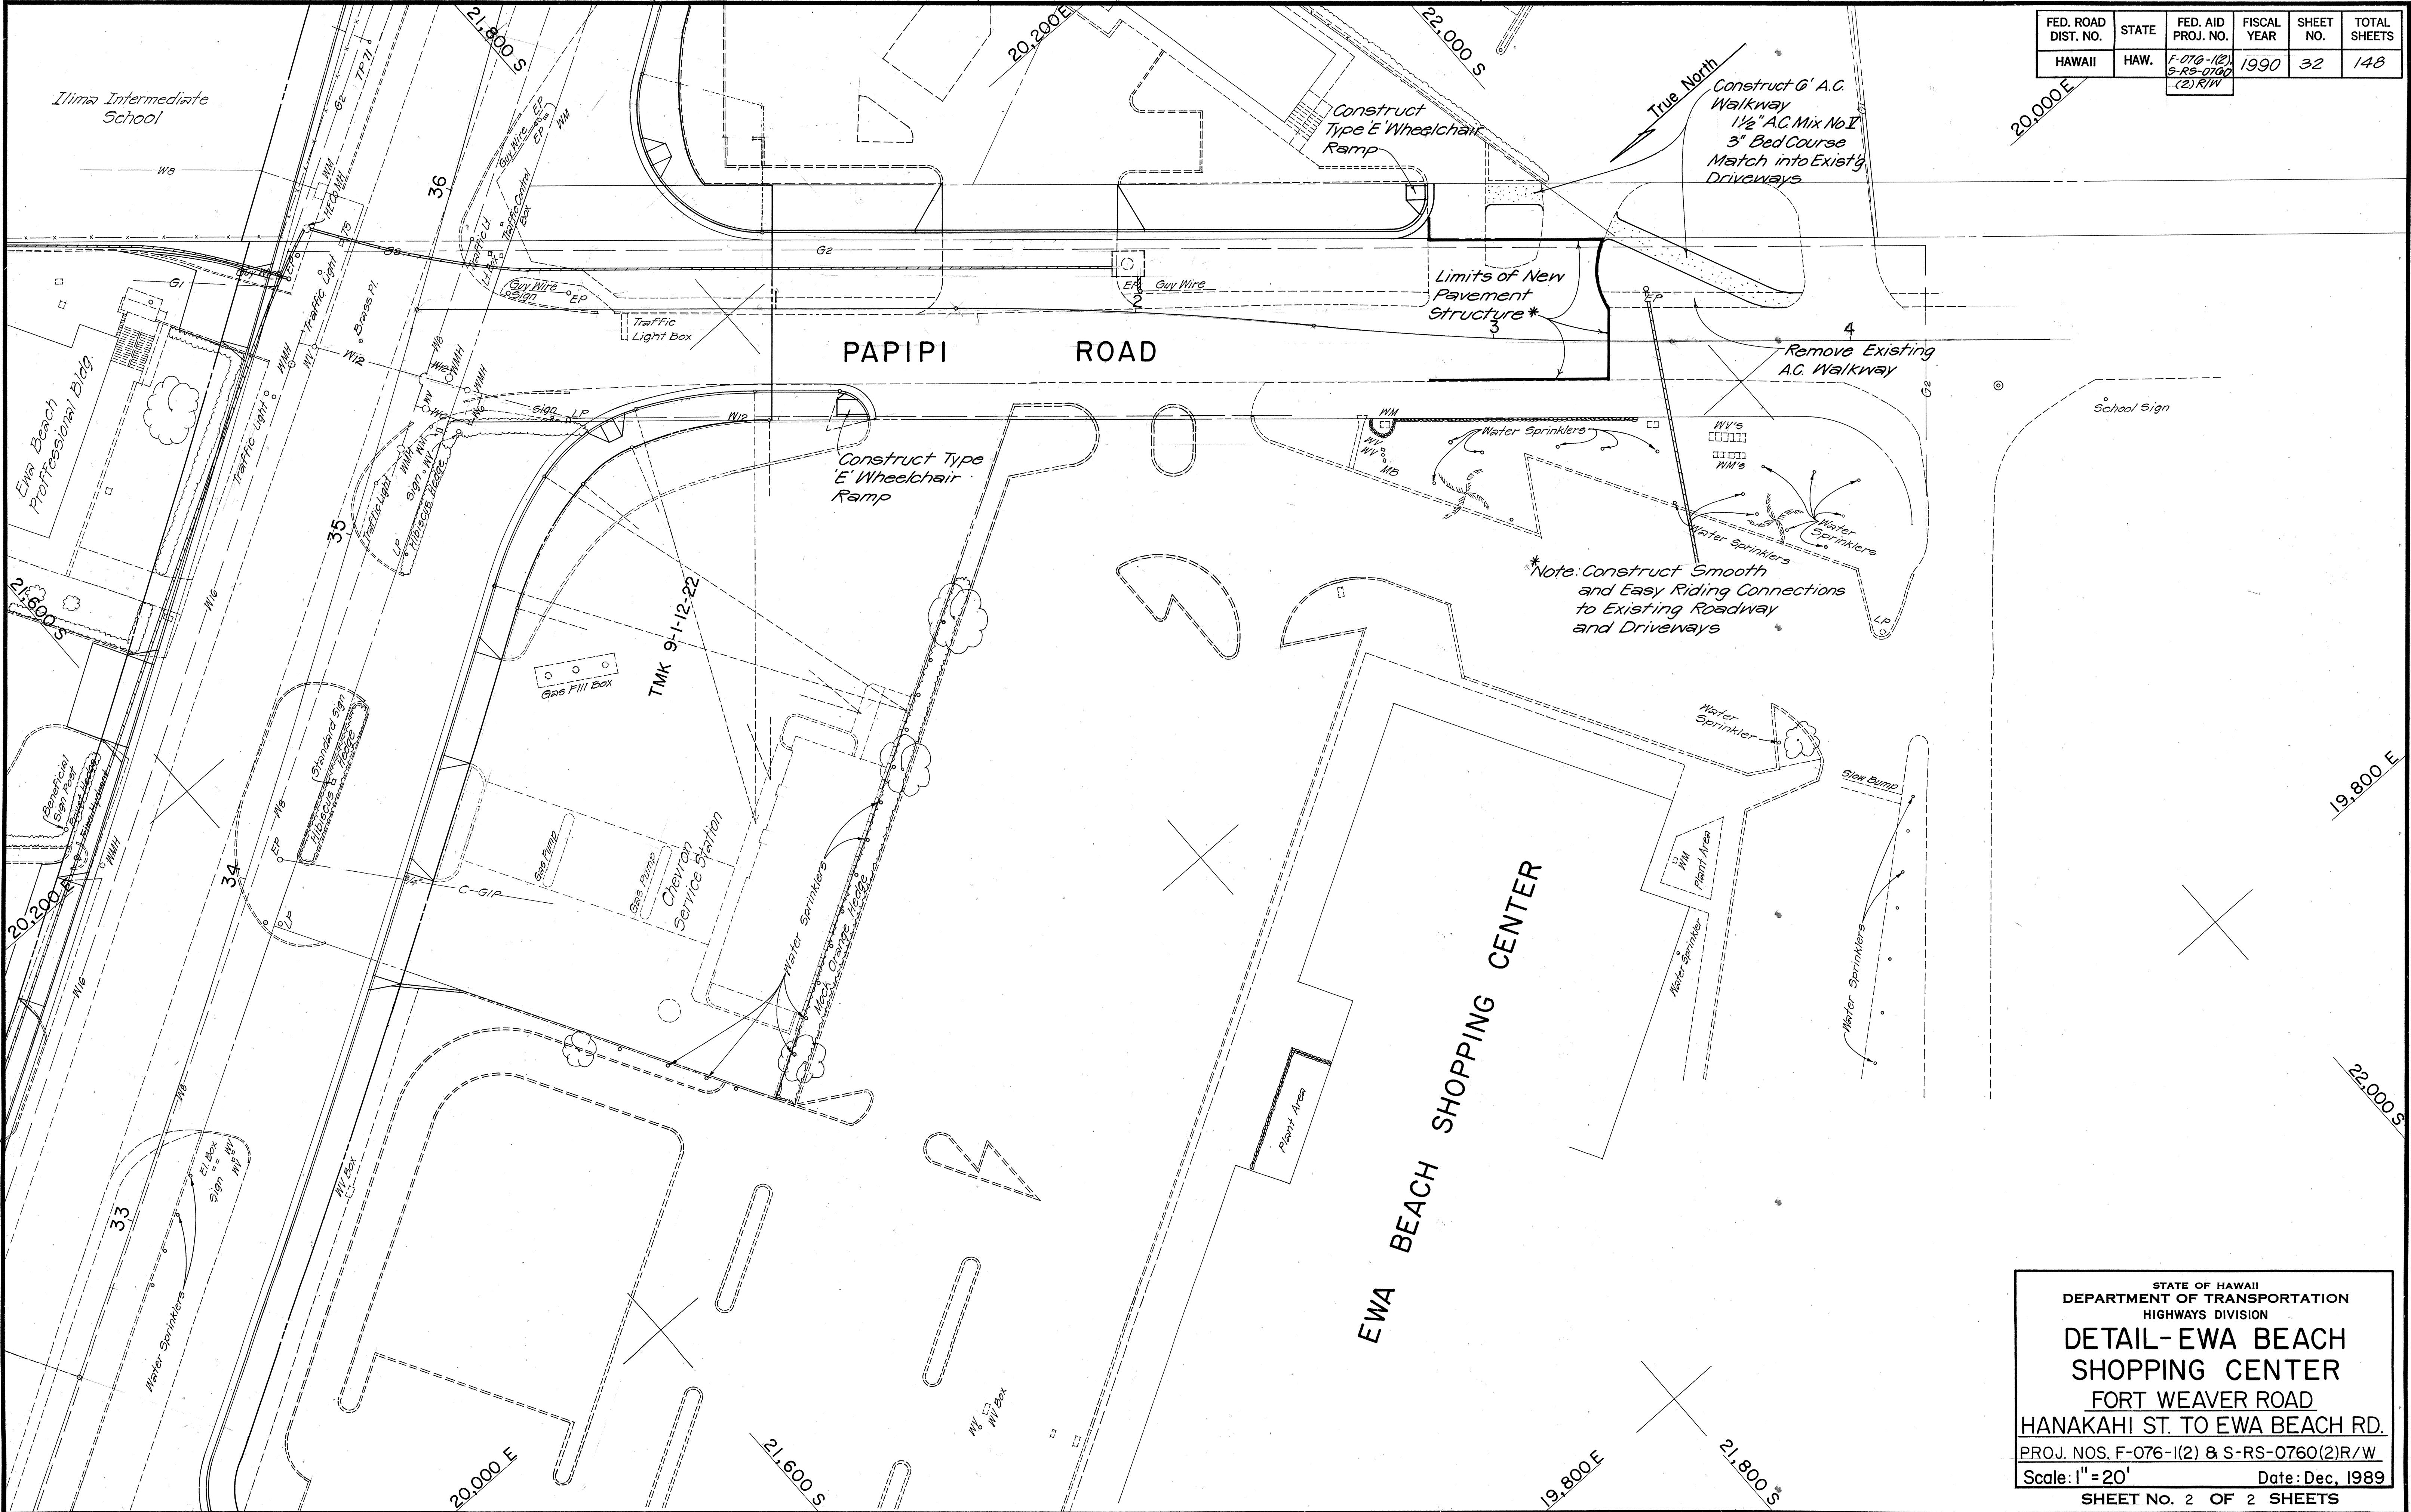

STATE OF HAWAII
DEPARTMENT OF TRANSPORTATION
HIGHWAYS DIVISION

DETAIL-EWA BEACH
SHOPPING CENTER
FORT WEAVER ROAD
HANAKAHI ST. TO EWA BEACH RD.

PROJ. NOS. F-076-1(2) & S-RS-0760(2)R/W
Scale: 1" = 20'
SHEET NO. 2 OF 2 SHEETS

Date: Dec, 1989

