
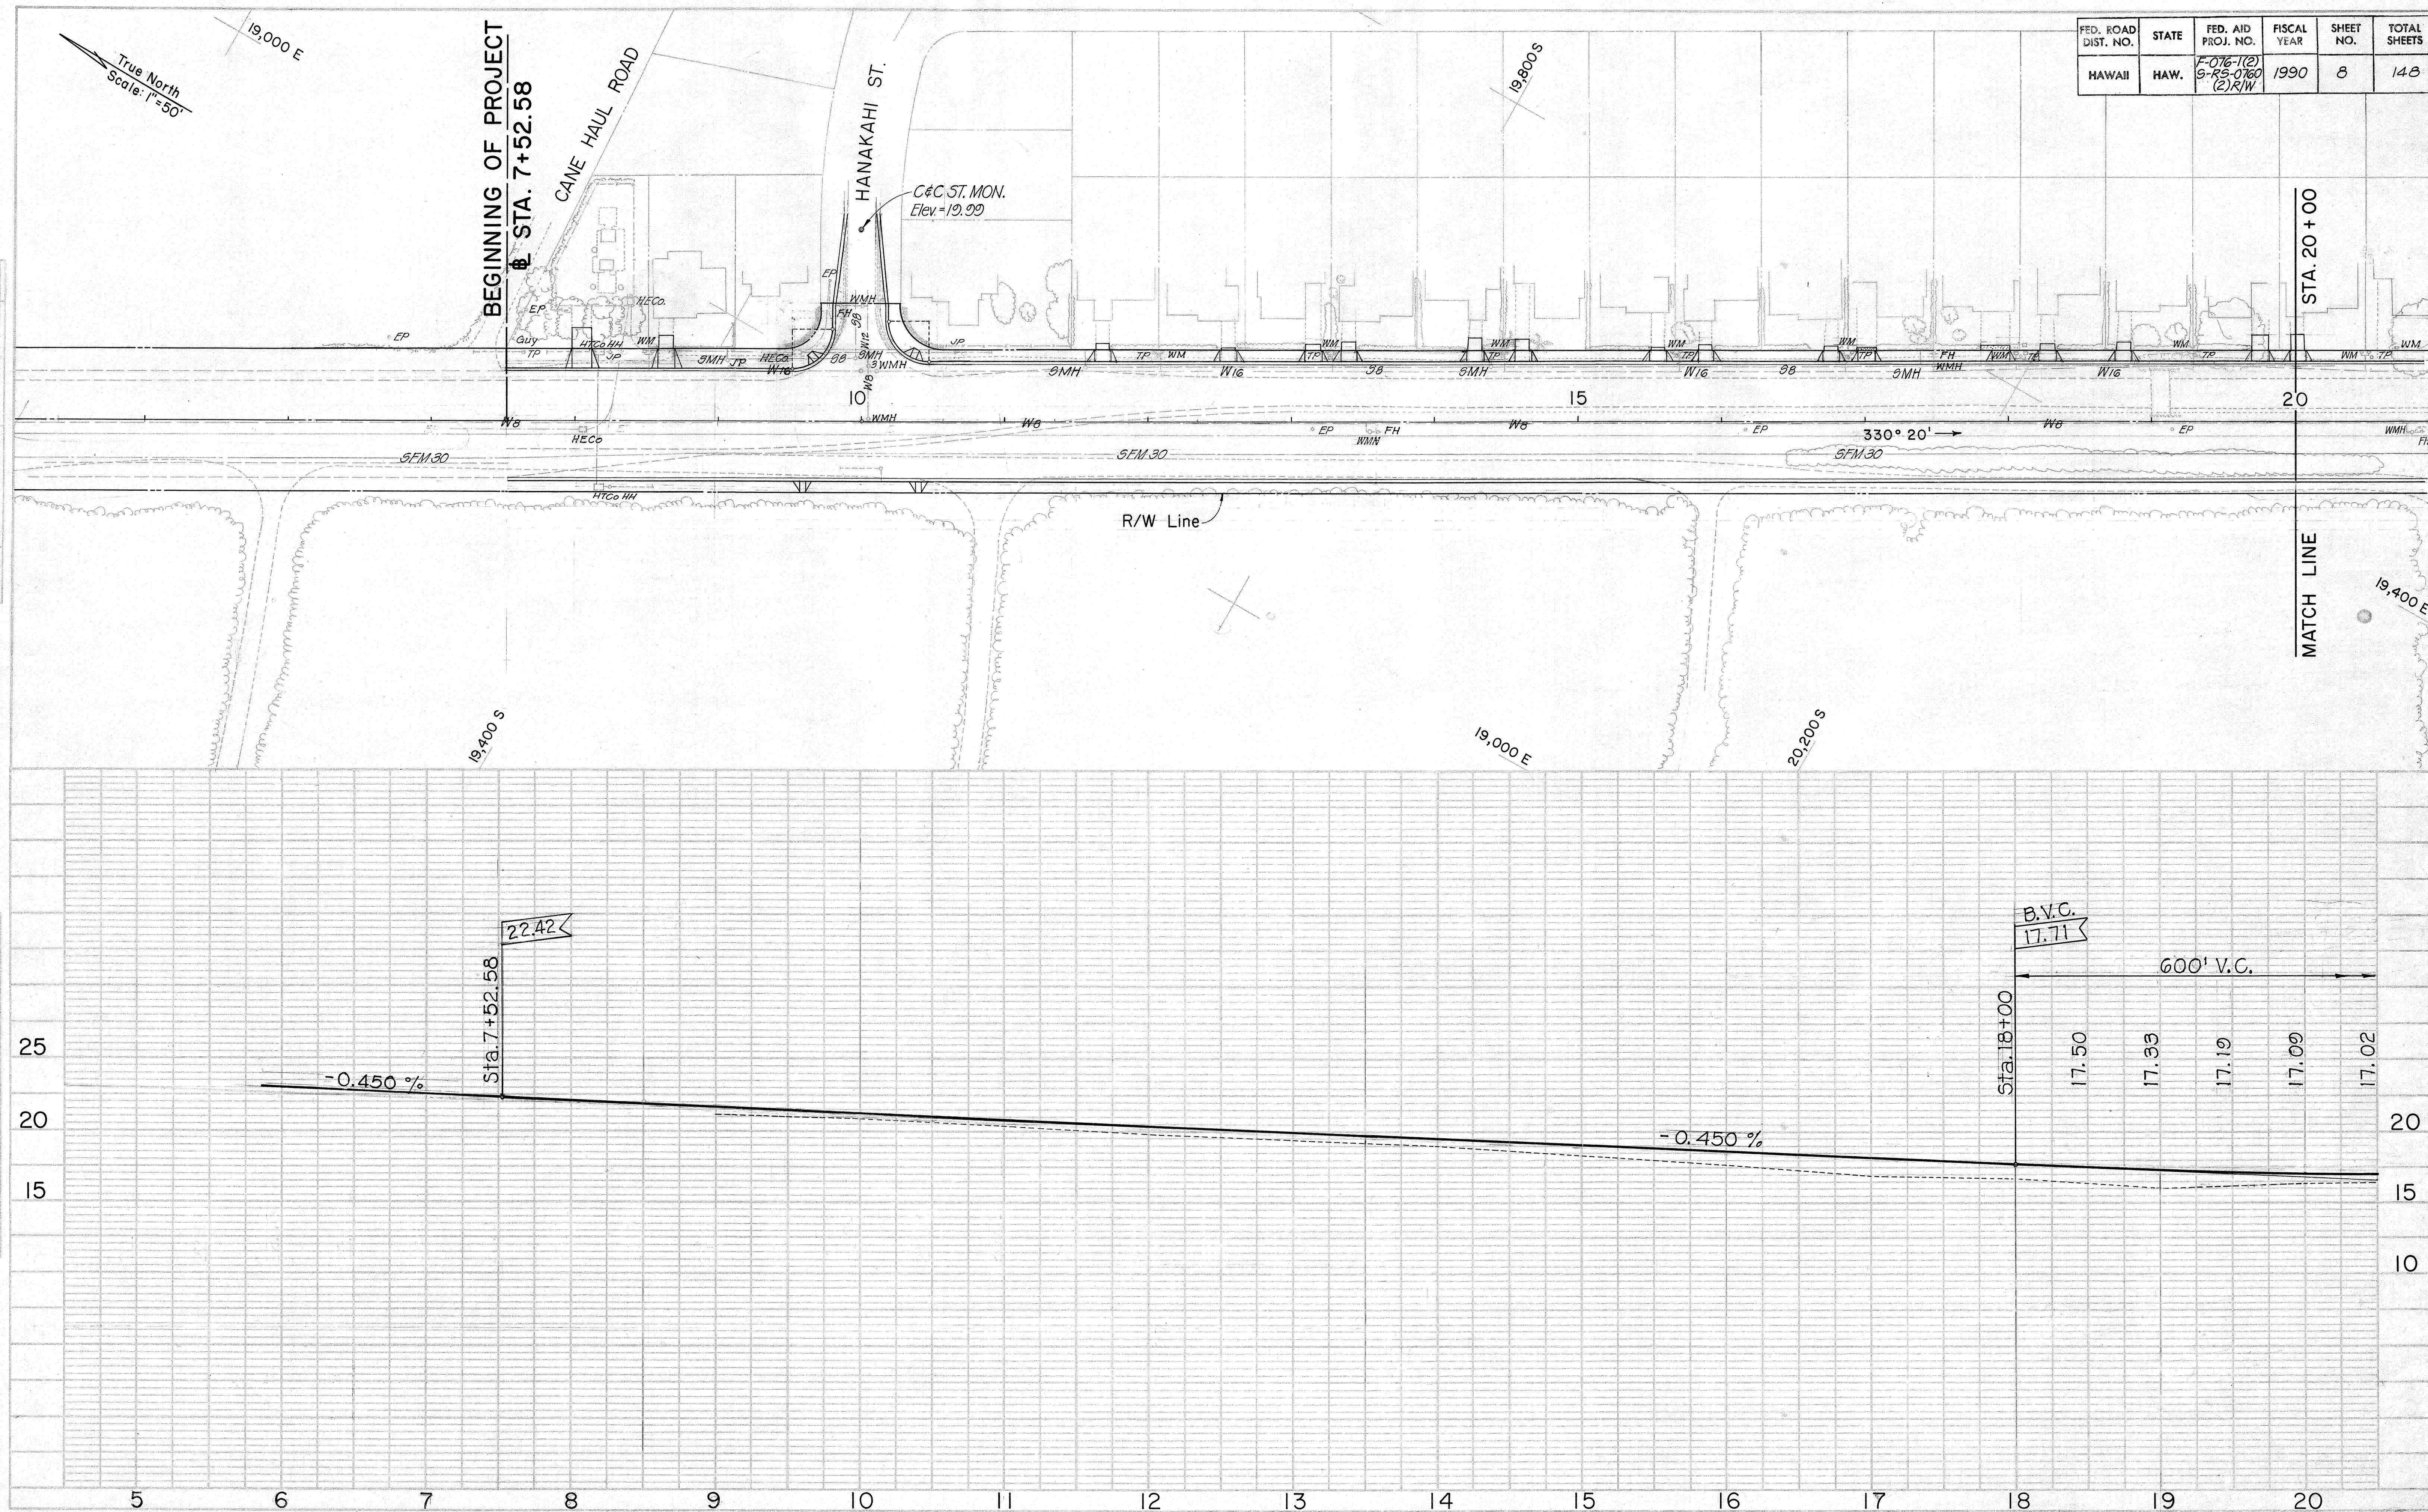
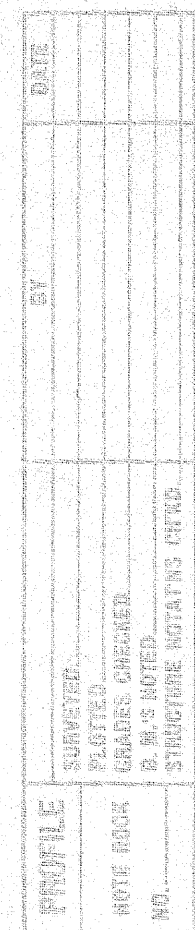


FED. ROAD DIST. NO.	STATE	FED. AID PROJ. NO.	FISCAL YEAR	SHEET NO.	TOTAL SHEETS
HAWAII	HAW.	F-076-1(2) S-RS-0760 (2)R/W	1990	8	148

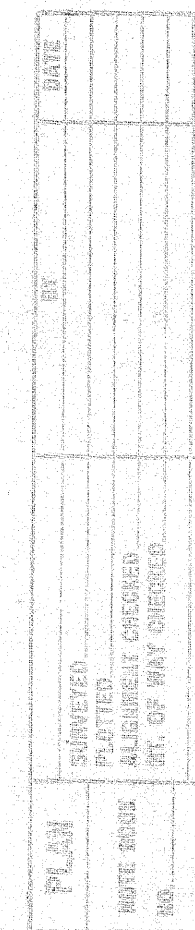


FED. ROAD DIST. NO.	STATE	FED. AID PROJ. NO.	FISCAL YEAR	SHEET NO.	TOTAL SHEETS
HAWAII	HAW.	F-076-1(2) S-RS-0760 (2)R/W	1990	9	148

PLAN	DATE
DESIGNED	
PLANNED	
NOTES	
NO.	

PROFILE	DATE
DESIGNED	
PLANNED	
NOTES	
NO.	




CURVE DATA	2
$\Delta = 4^\circ 45' 34''$	
$R = 5,800$	
$T = 241.04$	
$C = 481.66$	
$L = 481.80$	

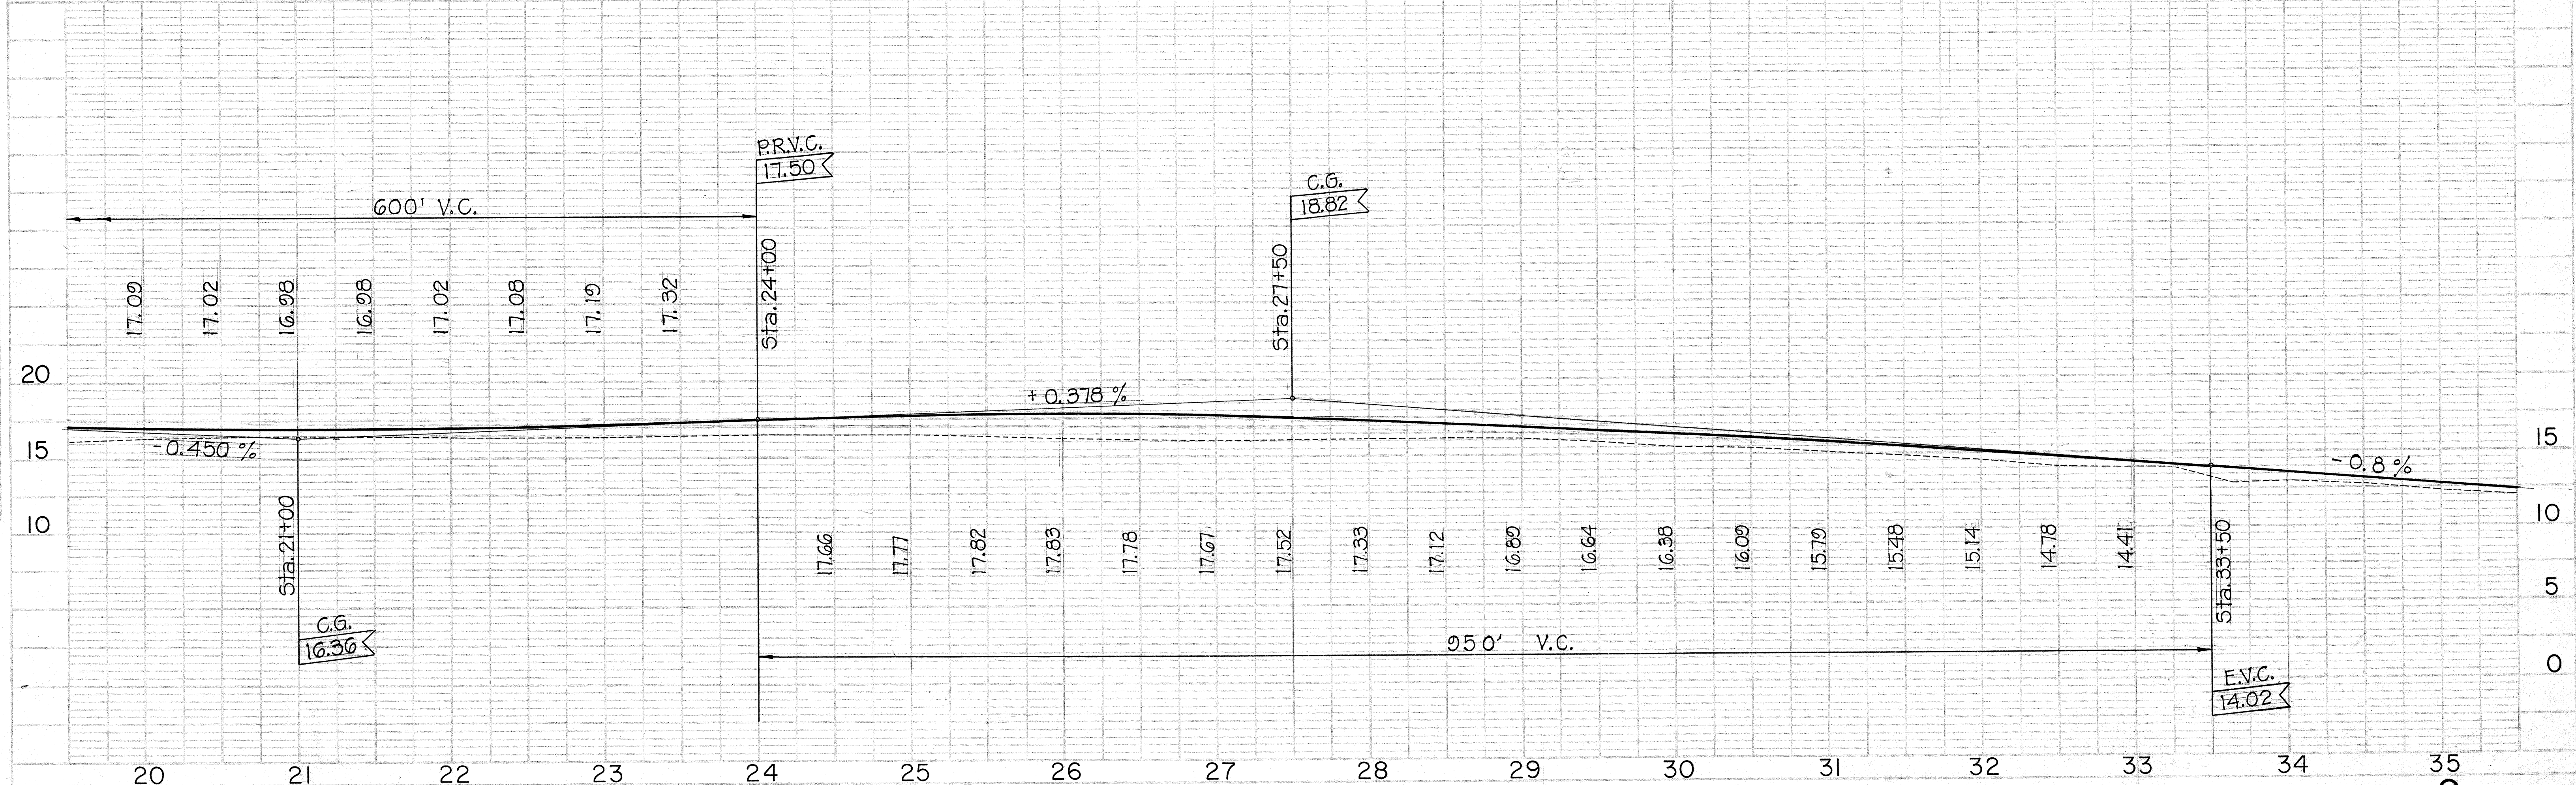



[illegible]

PLANT	SURVEY	97	DATE
NOTE BOOK	PLANTED		
NO.	CHAPES CHIEF		
	A WAS ORDER		
	SHAPURE MOUNTING CARD		

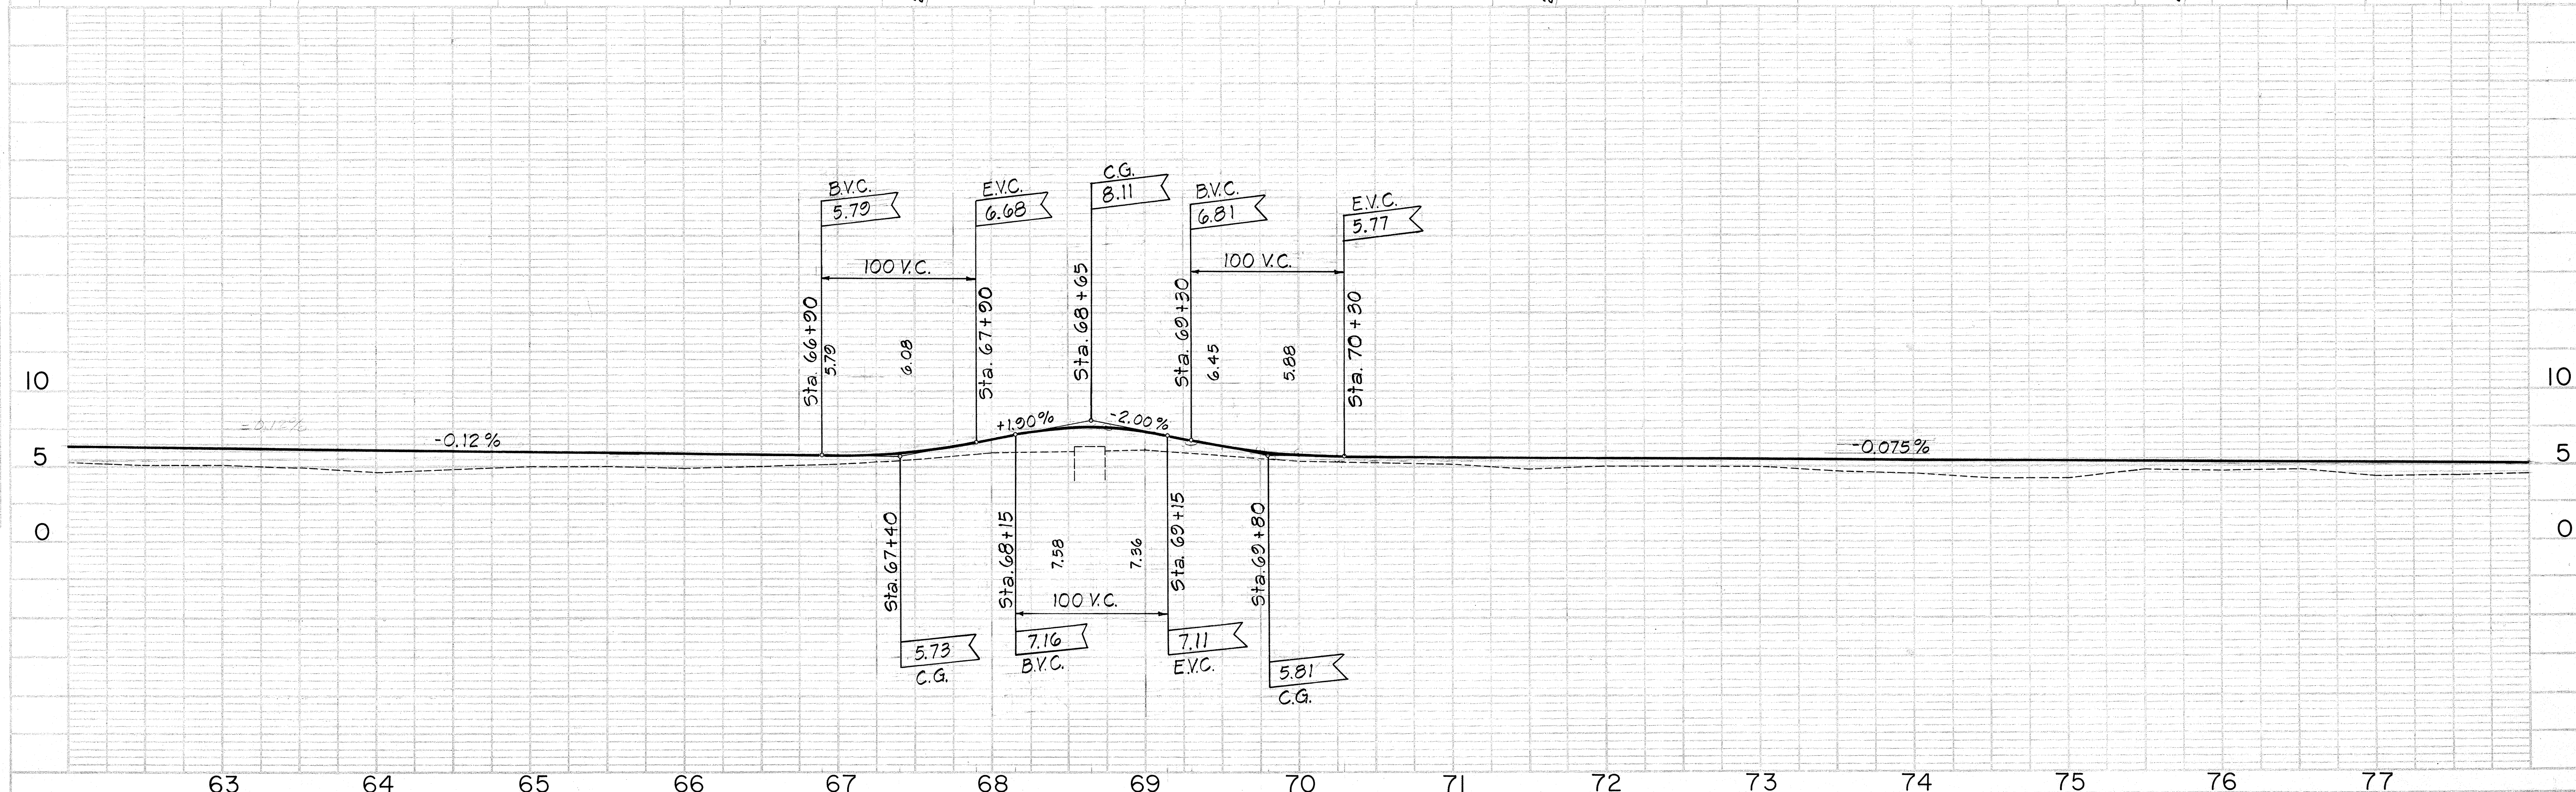

PLAN	DATE	BY	CHKD.
SURVEYED			
PLANNED			
NOTE BOOK			
NO.			

PROFILE	DATE	BY	CHKD.
SURVEYED			
PLANNED			
NOTE BOOK			
NO.			

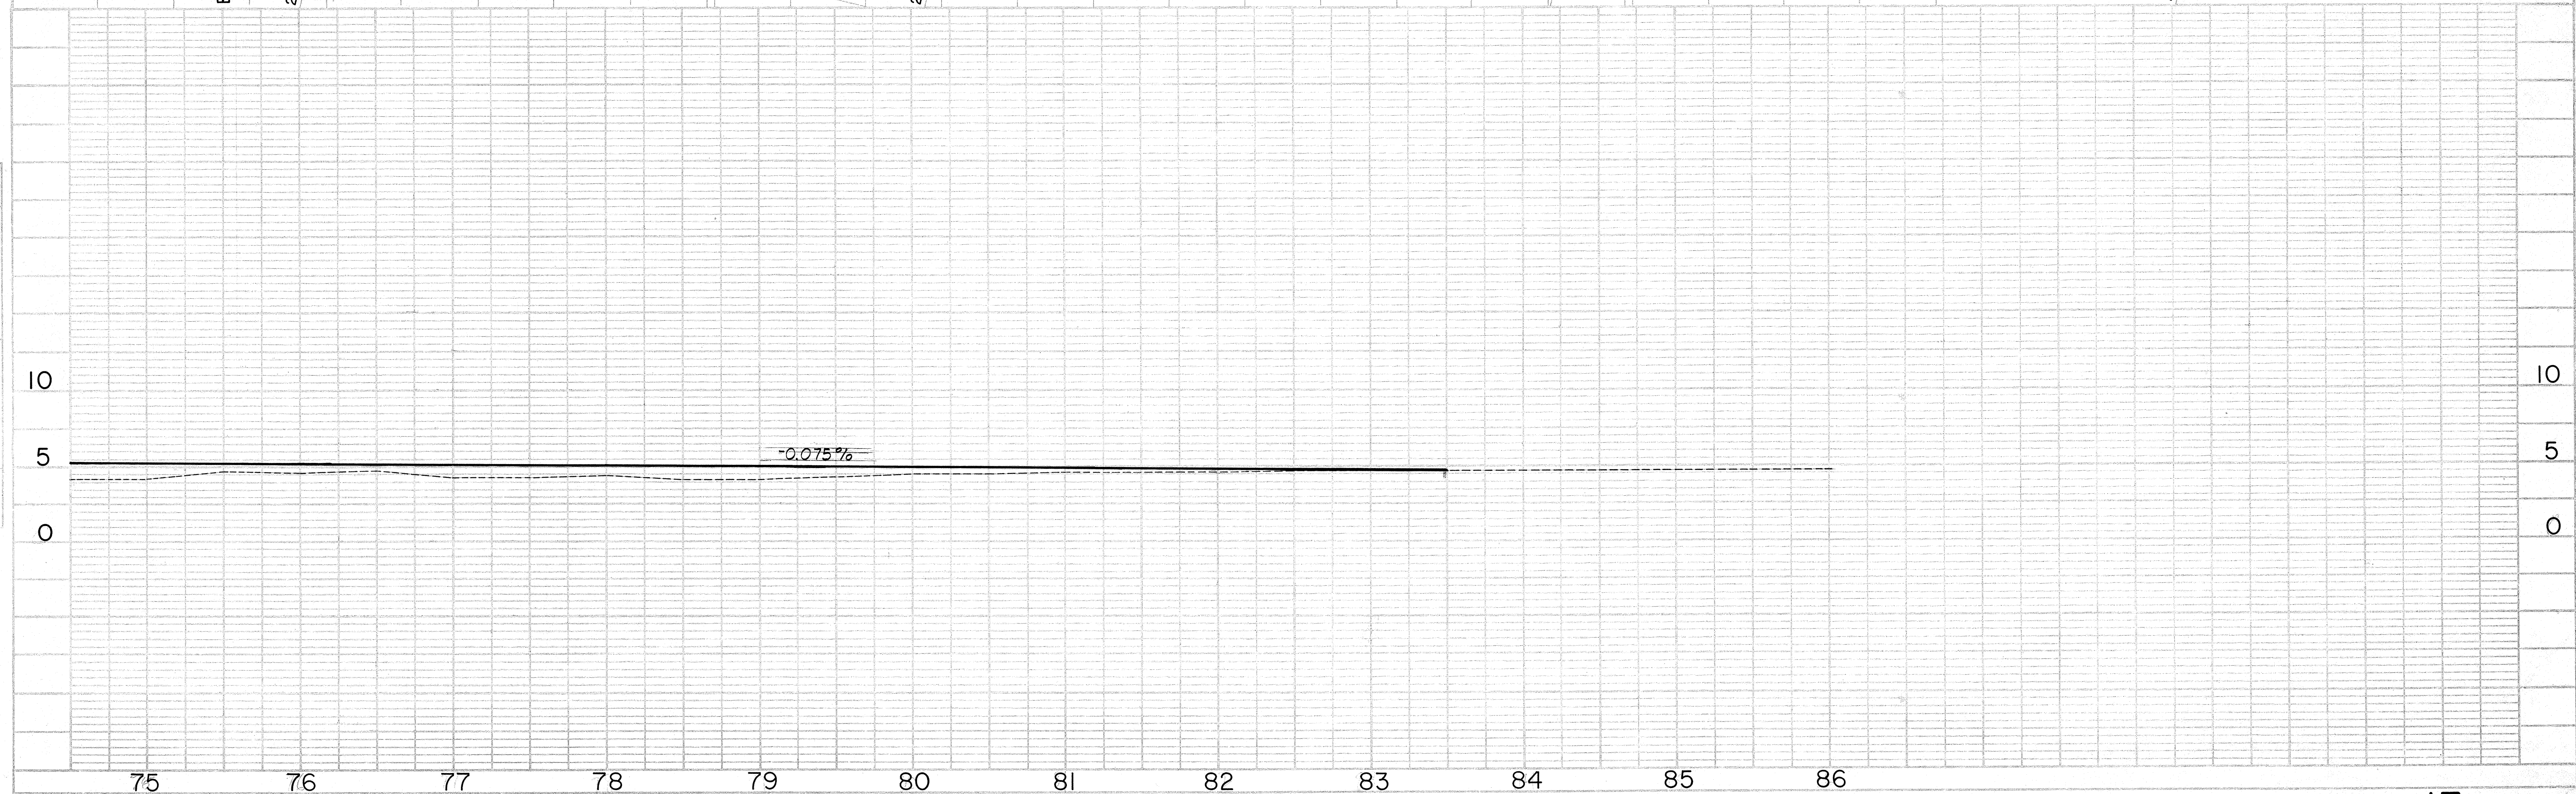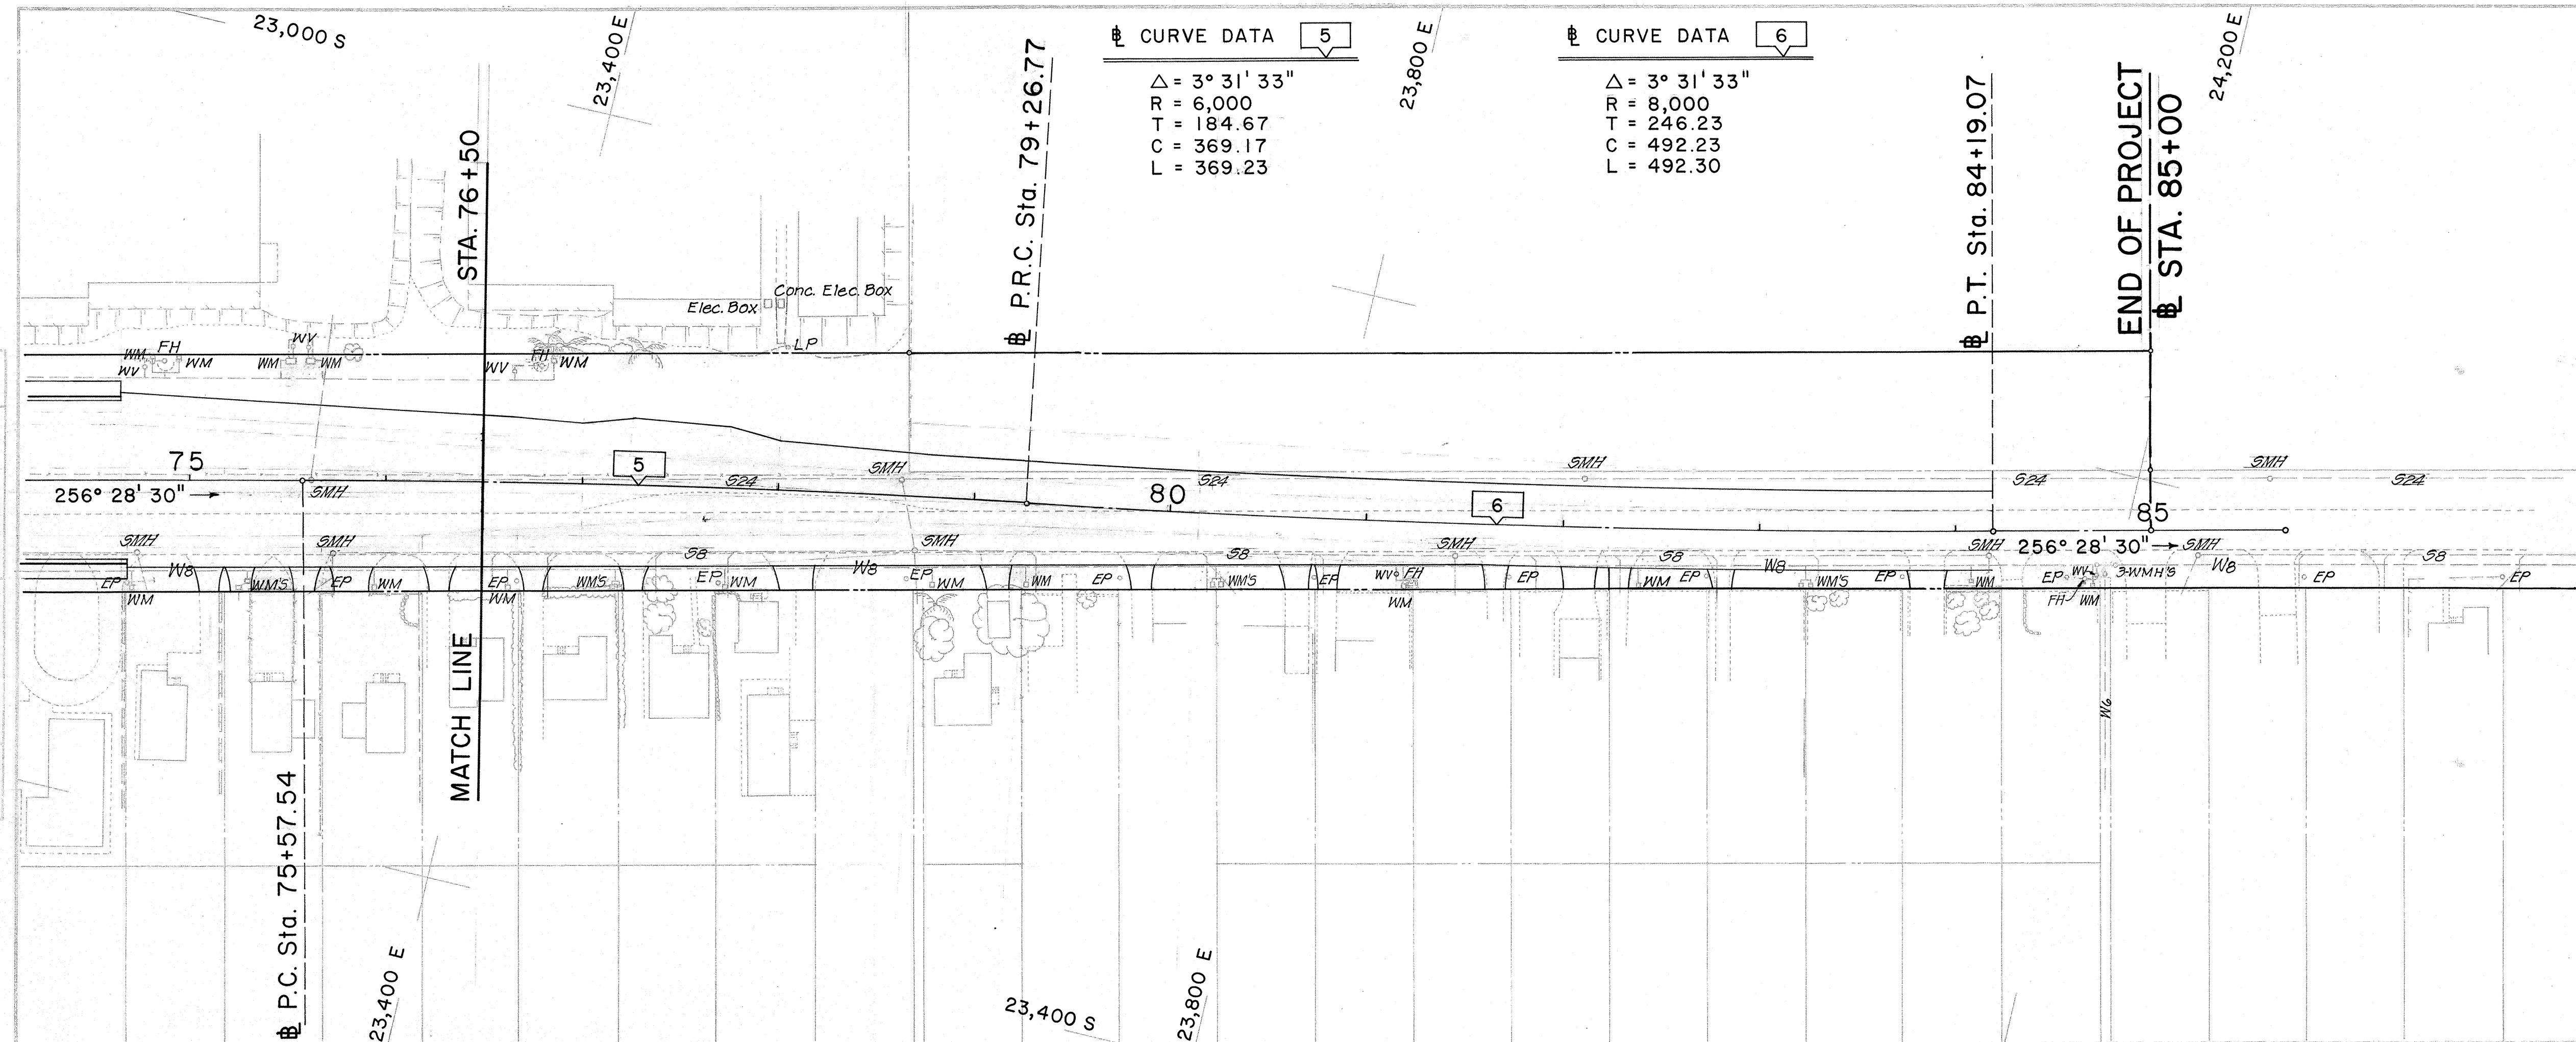

FED. ROAD DIST. NO.	STATE	FED. AID PROJ. NO.	FISCAL YEAR	SHEET NO.	TOTAL SHEETS
HAWAII	HAW.	5-076-1(2) 5-85-0760 (2) RM	1990	13	148

24,600 E

True North
Scale: 1" = 50'

23,000 S

24,600 E