	INDEX TO DRAWINGS
SHEET NO.	DESCRIPTION
*	TITLE SHEET
	STANDARD PLANS SUMMARY
3	LEGEND AND GENERAL NOTES
4-5	UTILITY NOTES
6-7	TYPICAL SECTIONS
8-13	PLAN AND PROFILE
14-16	CONSTRUCTION PHASING
17-33	DETAIL PLAN OF ROADWAY
<sup>(1)</sup> 34-41	SIGNING AND STRIPING
<sup>②</sup> 42-79	DRAINAGE PLANS AND DETAILS
80-95	GAS, SEWER AND WATER
<sup>3</sup> 96-109	ELECTRIC AND TELEPHONE
110-118	TRAFFIC SIGNALS
	HIGHWAY LIGHTING
126-131	BAND ROOM RENOVATION
132-148	CROSS SECTIONS
. * - /	
	6
1	

Plan Sht. Nos. ©C.O.40S-1, C.O.40S-2, ©C.O.55S-1, C.O.55S-2 and ©C.O.104S-1 are supplementary Sheets to this project. Total Sheet Count after "AS-BUILT" postings 153 Sheets.

STATE OF HAWAII

## DEPARTMENT OF TRANSPORTATION

HIGHWAYS DIVISION HONOLULU, HAWAII

"AS-BUILT"


PLANS FOR


## FORT WEAVER ROAD WIDENING AND REALIGNMENT

HANAKAHI ST. TO EWA BEACH RD. FEDERAL AID PROJECT NOS. F-076-I(2)

RAL AID PROJECT NOS. F-076-1(2) AND S-RS-0760(2)R/W

DISTRICT OF EWA ISLAND OF OAHU

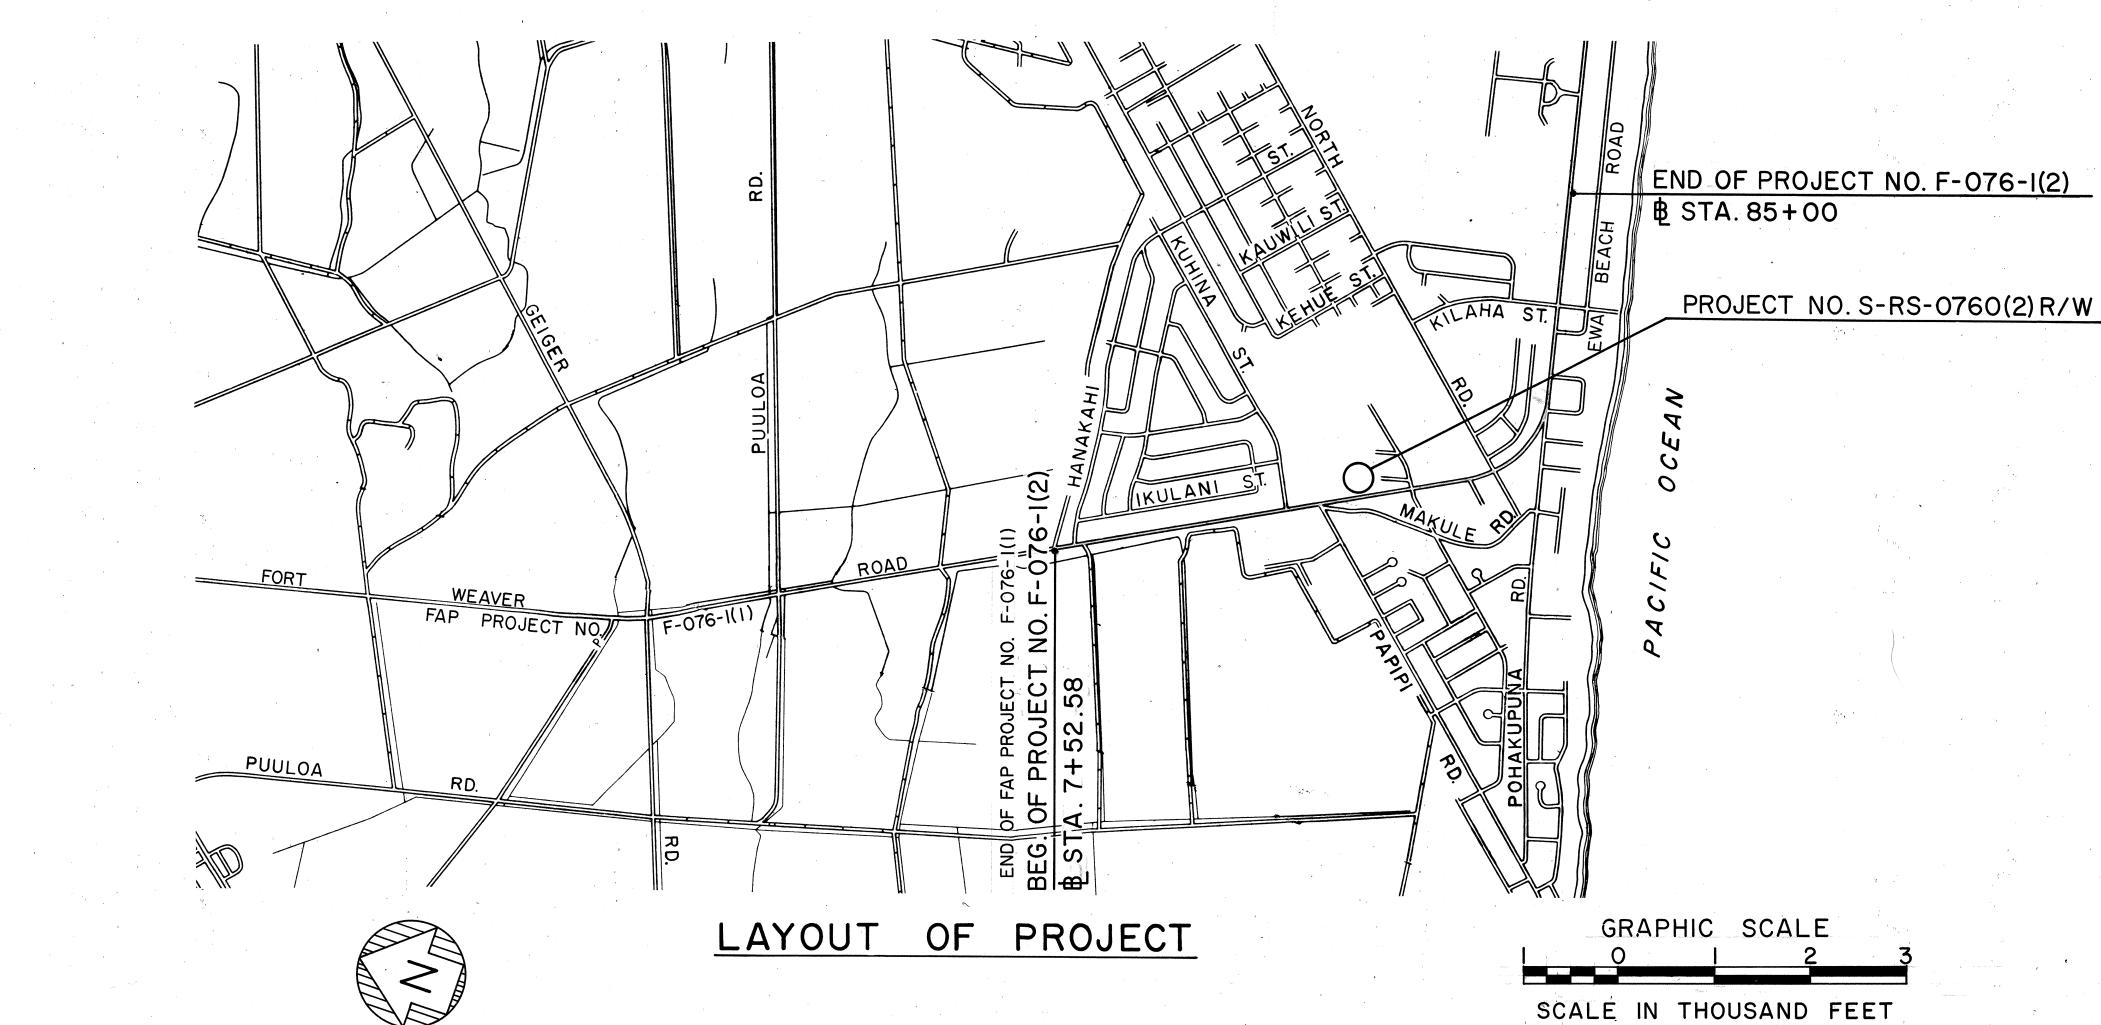

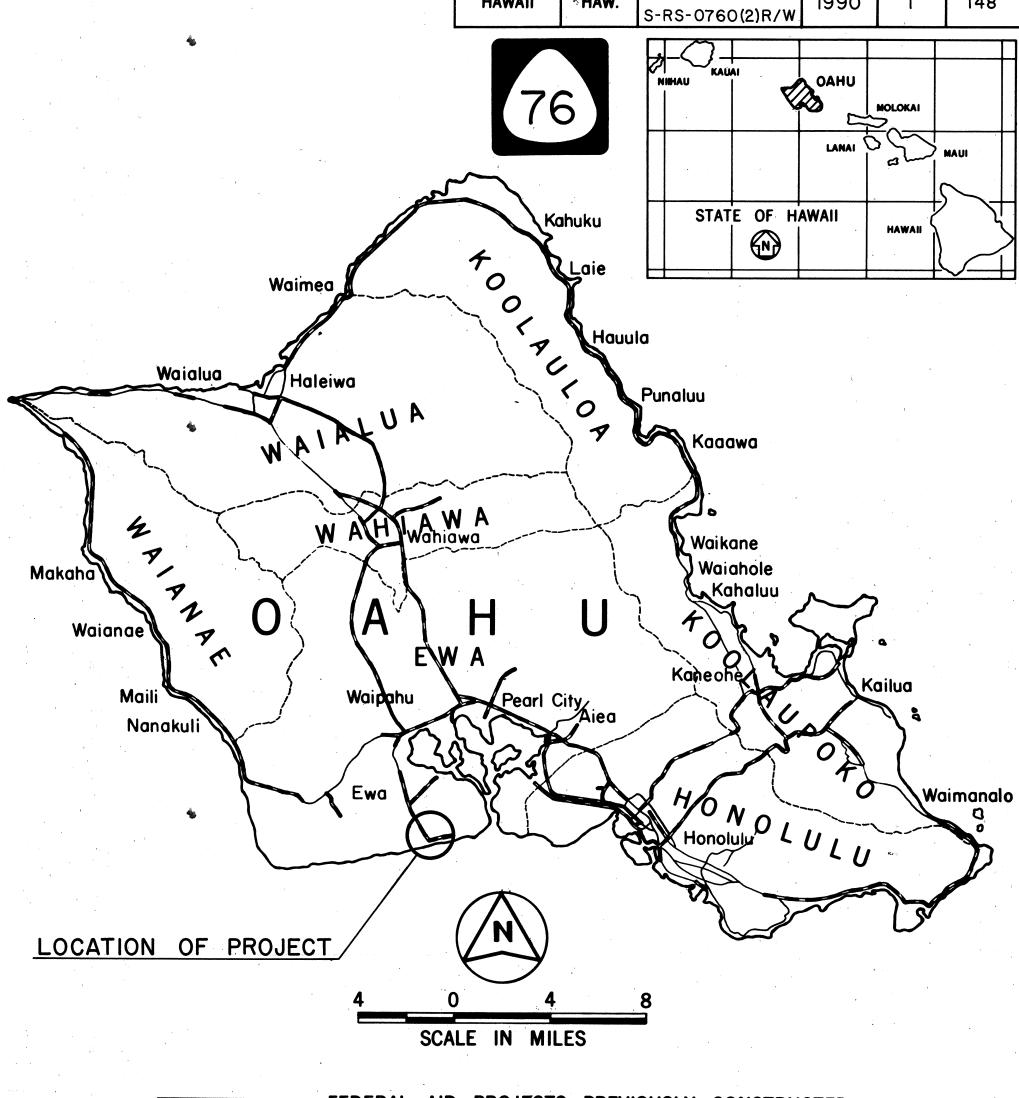

DIST. NO.

FEDERAL AID PROJECTS PREVIOUSLY CONSTRUCTED
OR UNDER CONSTRUCTION

MILE POST 2.16 TO MILE POST 0.69

DESIGN			CLASSIFICATION								
ADT (	(1988)	•	•	•		•	•				16,300
ADT (	2008)	· •	•	•	•					•	20,800
DHV	• • •		•		•	• ,		•	•	•	1,700
D				•	•			•		•	70/30
T				•						•	2.5 %
T <sub>24</sub> .			•								3.0 %
٧			•	•		•	•	•			30 MPH

FISCAL SHEET TOTAL YEAR NO. SHEETS

FED. AID PROJ. NO.

CHANGES MADE DURING CONSTRUCTION HAVEBEEN INCORPORATED ON THESE PLANS EXCEPT CHANGES IN THE ORIGINAL THEORETICAL QUANTITIES. FOR ACTUAL QUANTITIES, REFER TO PROJECT LEDGER AND / OR COMPUTATION BOOK.

Kelvin Akazawa 10/29/99
RESIDENT ENGINEER DATE

ACTINICA

DEPARTMENT OF TRANSPORTATION FEDERAL HIGHWAY ADMINISTRATION

APPROVED:

APPRO

DEPARTMENT OF TRANSPORTATION STATE OF HAWAII

APPROVED:

Lange 2/9/90
DIR. OF TRANSPORTATION DATE