


FED. ROAD DIST. NO.	STATE	PROJ. NO.	FISCAL YEAR	SHEET NO.	TOTAL SHEETS
HAWAII	HAW.	76A-01-91	1991	8	10

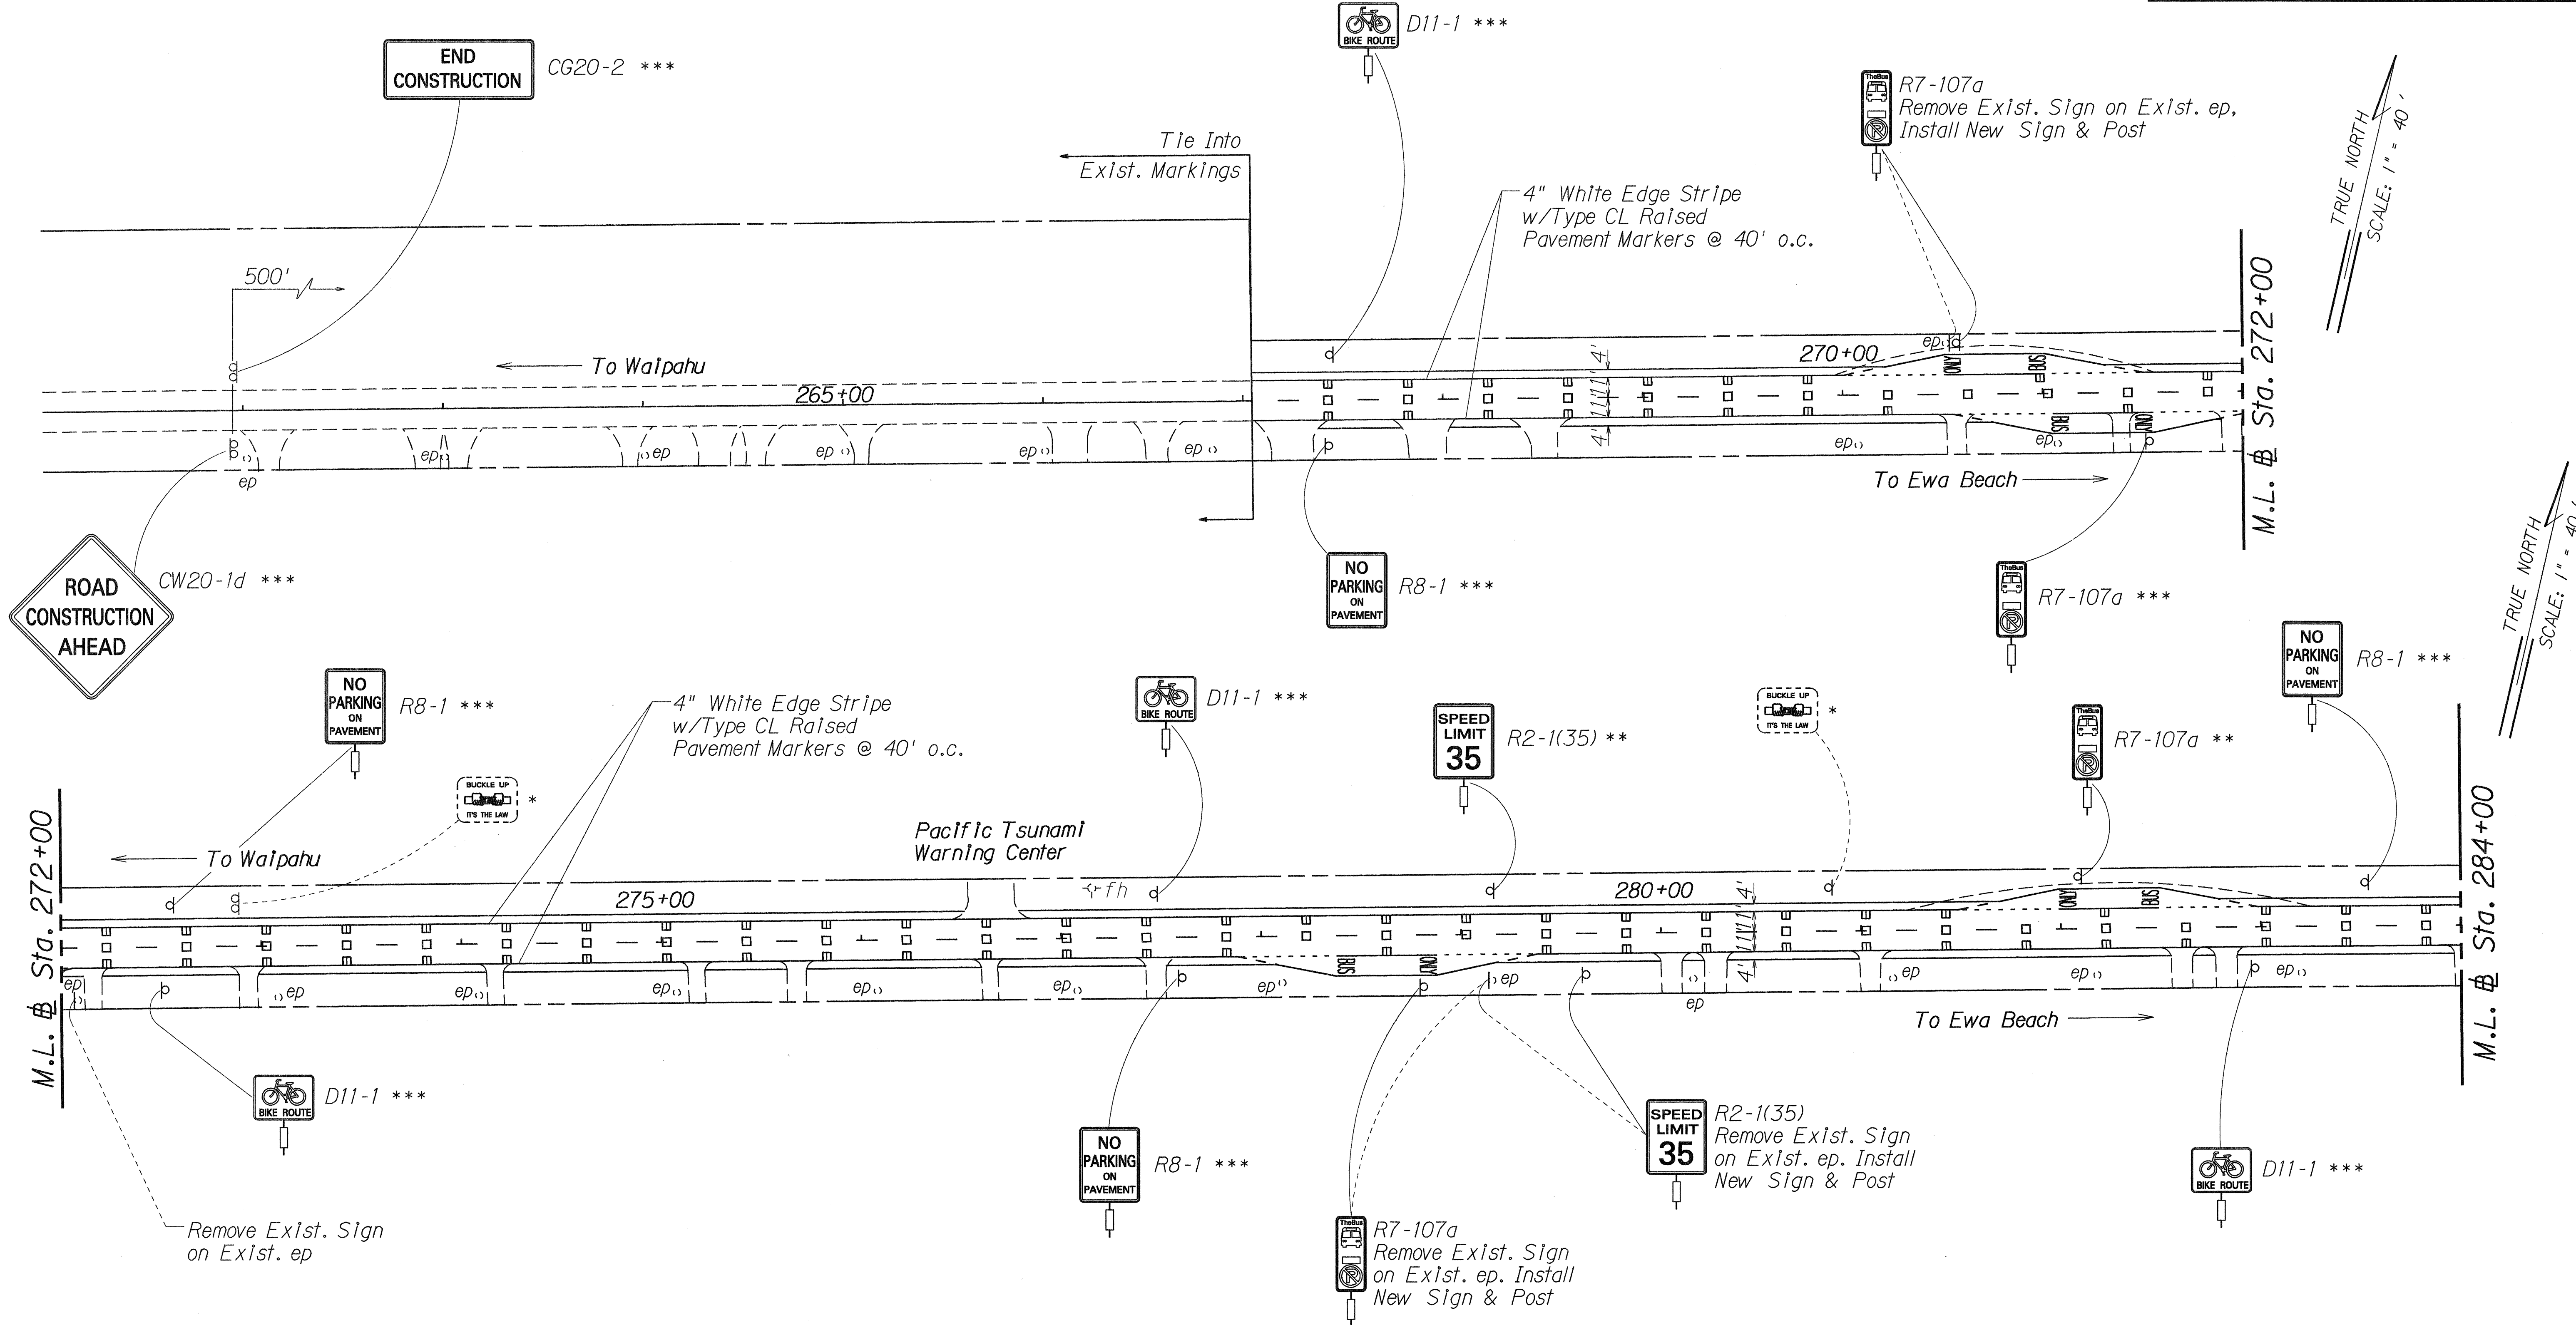

DATE	_____
SURVEY PLOTTED BY	_____
DRAWN BY	_____
DESIGNED BY	_____
CHECKED BY	_____
ORIGINAL PLAN	_____
NOTE BOOK	_____
NO.	_____

- KEY:
- * Exist. Sign(s) & Post(s) to Remain
 - ** Remove Exist. Sign(s) & Post(s), & Install New Sign(s) w/Post(s)
 - *** Install New Sign(s) w/Post(s)

STATE OF HAWAII
DEPARTMENT OF TRANSPORTATION
HIGHWAYS DIVISION

PAVEMENT MARKING & STRIPING PLAN
FORT WEAVER ROAD IMPROVEMENTS
Ewa Beach Road to Fort Weaver Gate
Project No. 76A-01-91

Scale: 1" = 40'
Date: May, 1991

SHEET No. T2 OF 4 SHEETS



FED. ROAD DIST. NO.	STATE	PROJ. NO.	FISCAL YEAR	SHEET NO.	TOTAL SHEETS
HAWAII	HAW.	76A-01-91	1991	9	10

LEGEND FOR AS-BUILT POSTINGS

~~~~~ Squiggly line for as-built deletion

~~100.00~~ Double line for as-built deletion

Roadway Text for as-built posting

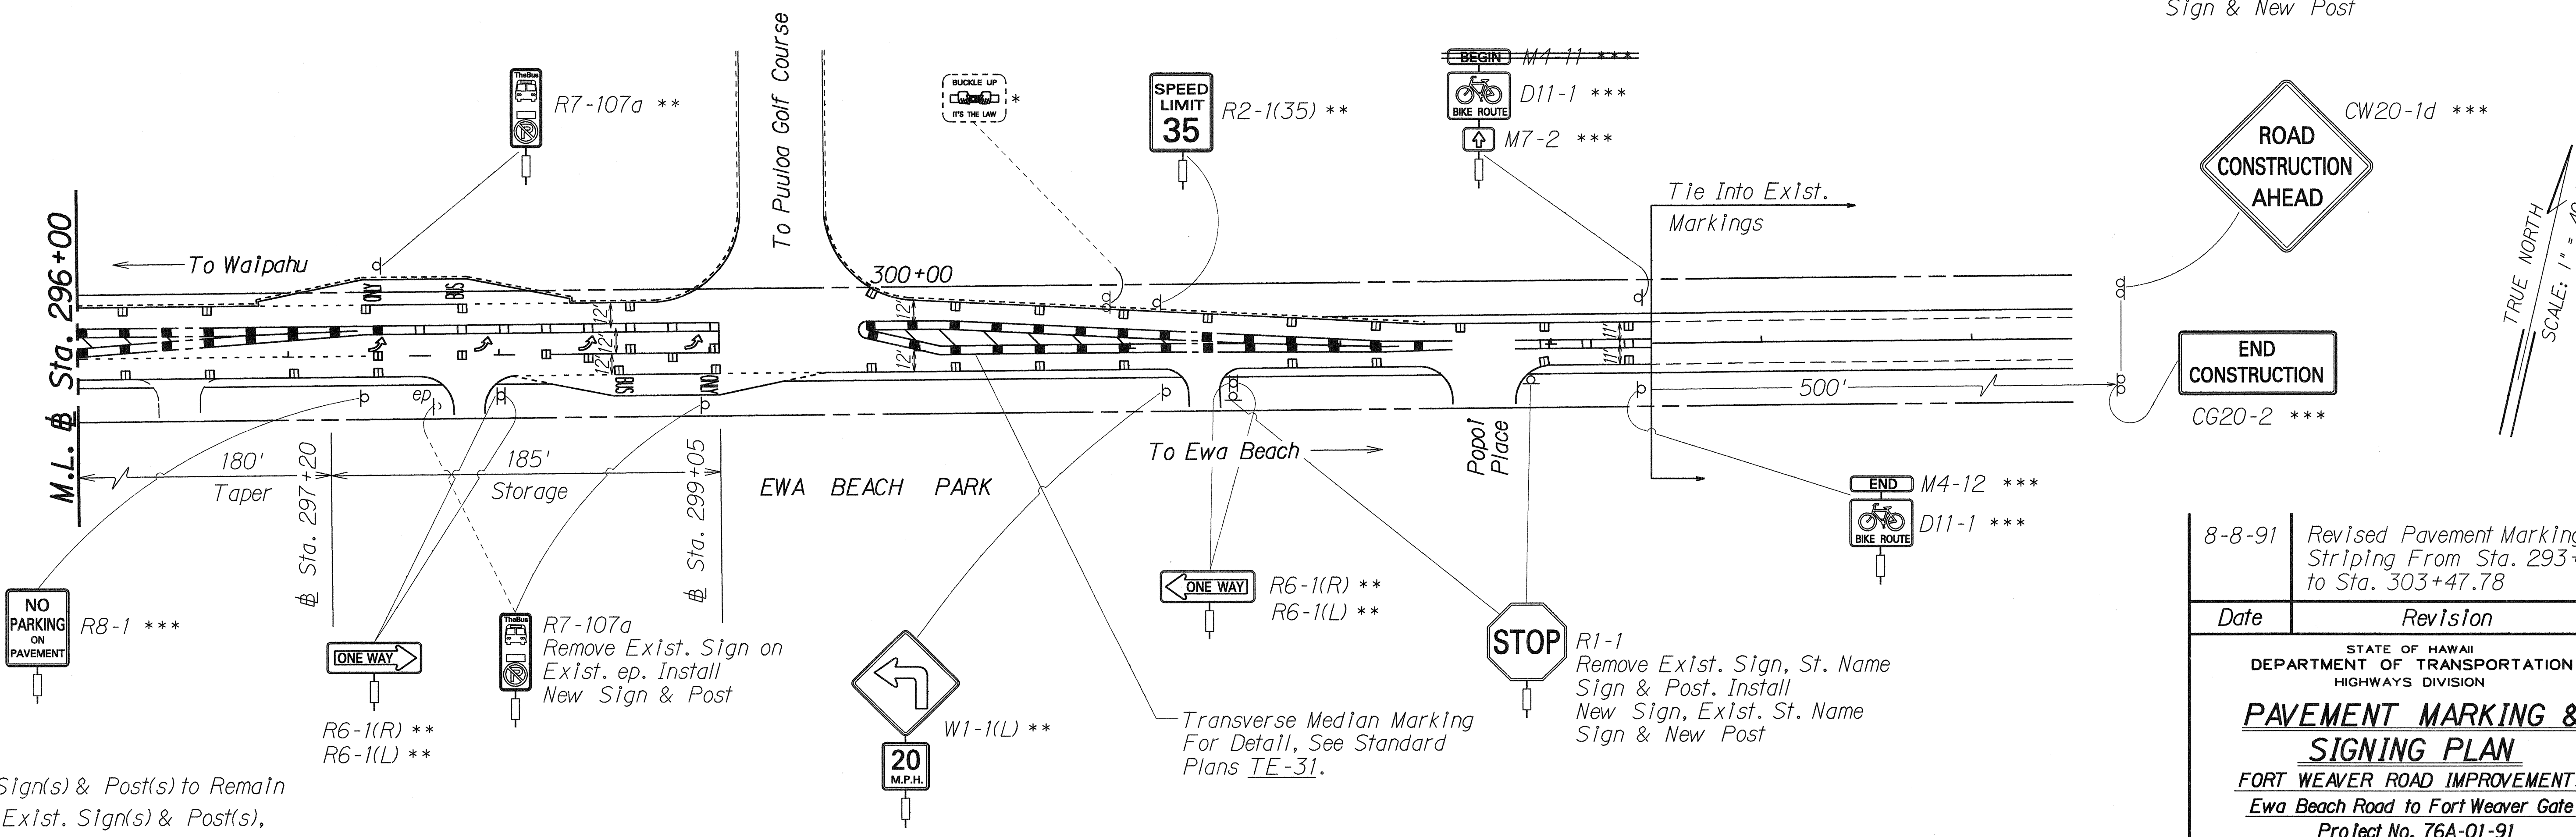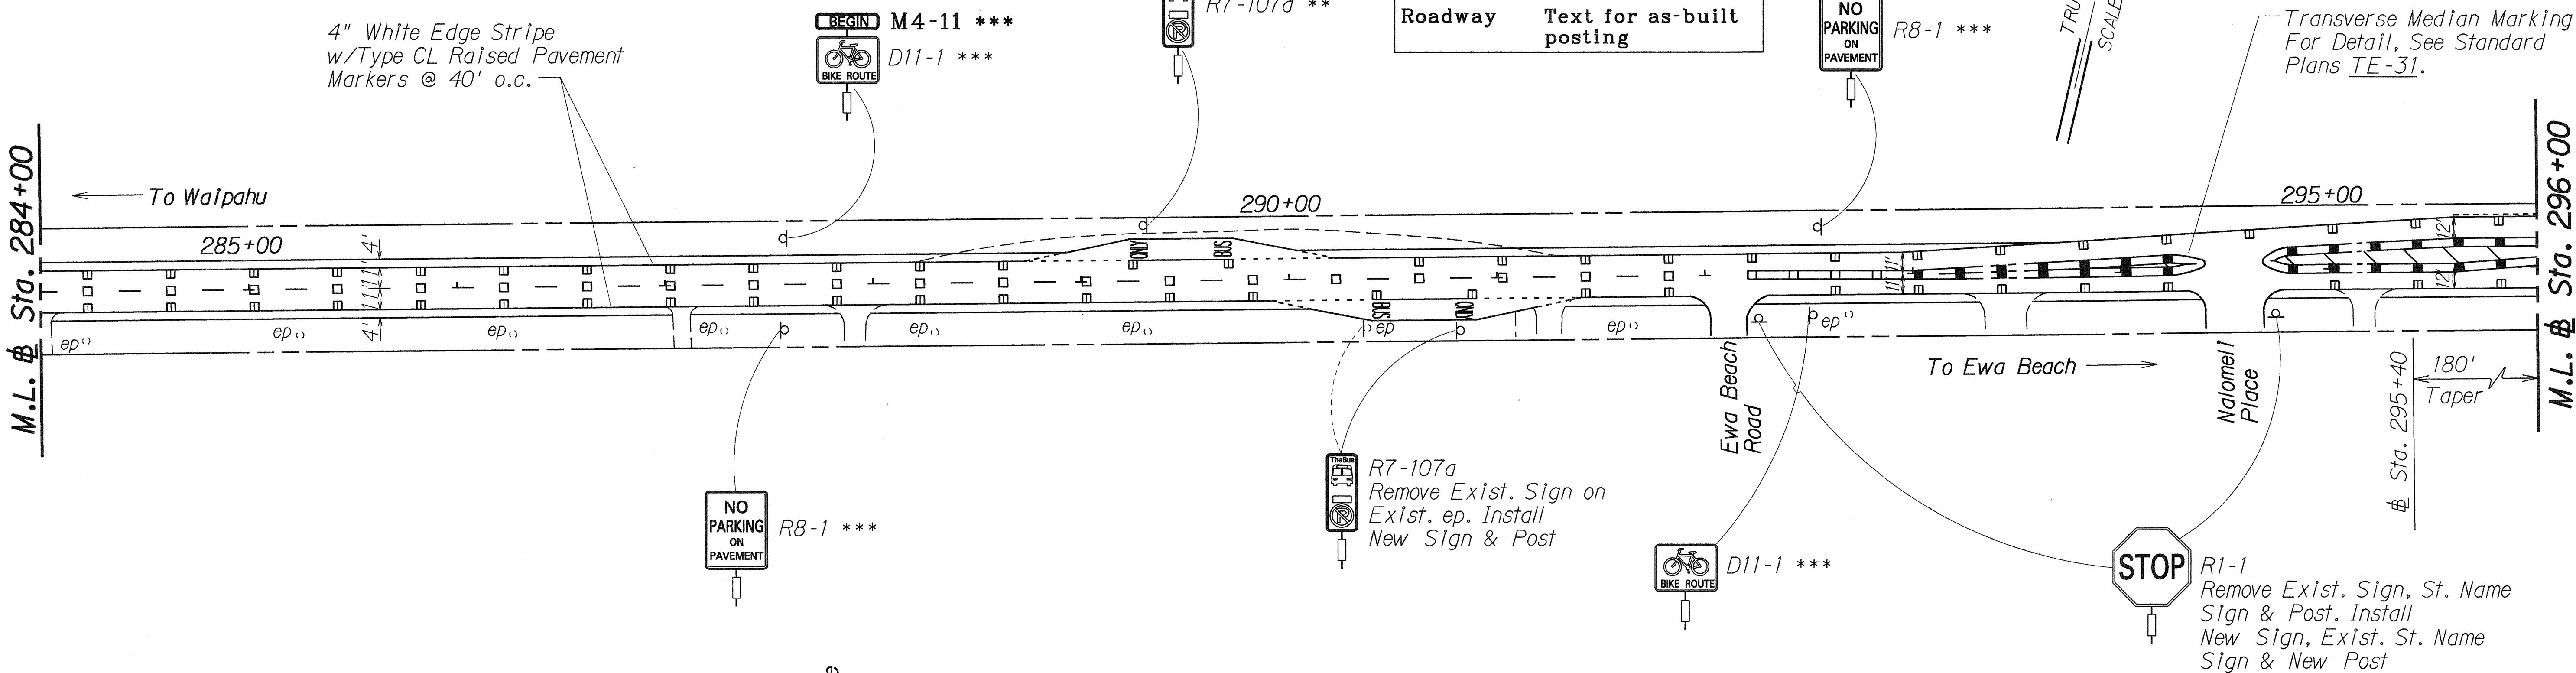

**KEY:**

\* Exst. Sign(s) & Post(s) to Remain

\*\* Remove Exst. Sign(s) & Post(s), & Install New Sign(s) w/Post(s)

\*\*\* Install New Sign(s) w/Post(s)

| 8-8-91                                                                                                                                                                                                                                                                                                 | Revised Pavement Marking & Striping From Sta. 293+00 to Sta. 303+47.78 |
|--------------------------------------------------------------------------------------------------------------------------------------------------------------------------------------------------------------------------------------------------------------------------------------------------------|------------------------------------------------------------------------|
| Date                                                                                                                                                                                                                                                                                                   | Revision                                                               |
| STATE OF HAWAII<br>DEPARTMENT OF TRANSPORTATION<br>HIGHWAYS DIVISION<br><b>PAVEMENT MARKING &amp; SIGNING PLAN</b><br><b>FORT WEAVER ROAD IMPROVEMENTS</b><br><b>Ewa Beach Road to Fort Weaver Gate</b><br><b>Project No. 76A-01-91</b><br>Scale: 1" = 40' Date: May, 1991<br>SHEET No. T3 OF 4 SHEETS |                                                                        |