




FED. ROAD DIST. NO.	STATE	PROJ. NO.	FISCAL YEAR	SHEET NO.	TOTAL SHEETS
HAWAII	HAW.	76A-01-91	1991	4	10

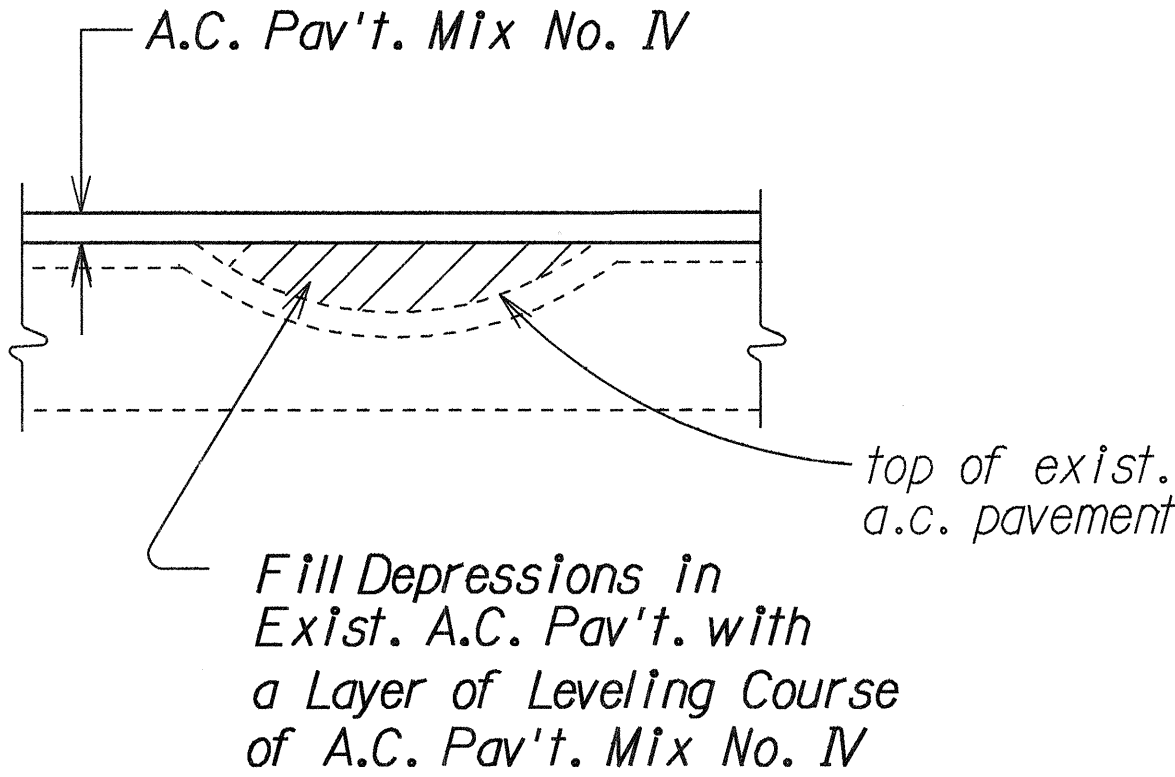


LEVELING COURSE DETAIL
Not to Scale

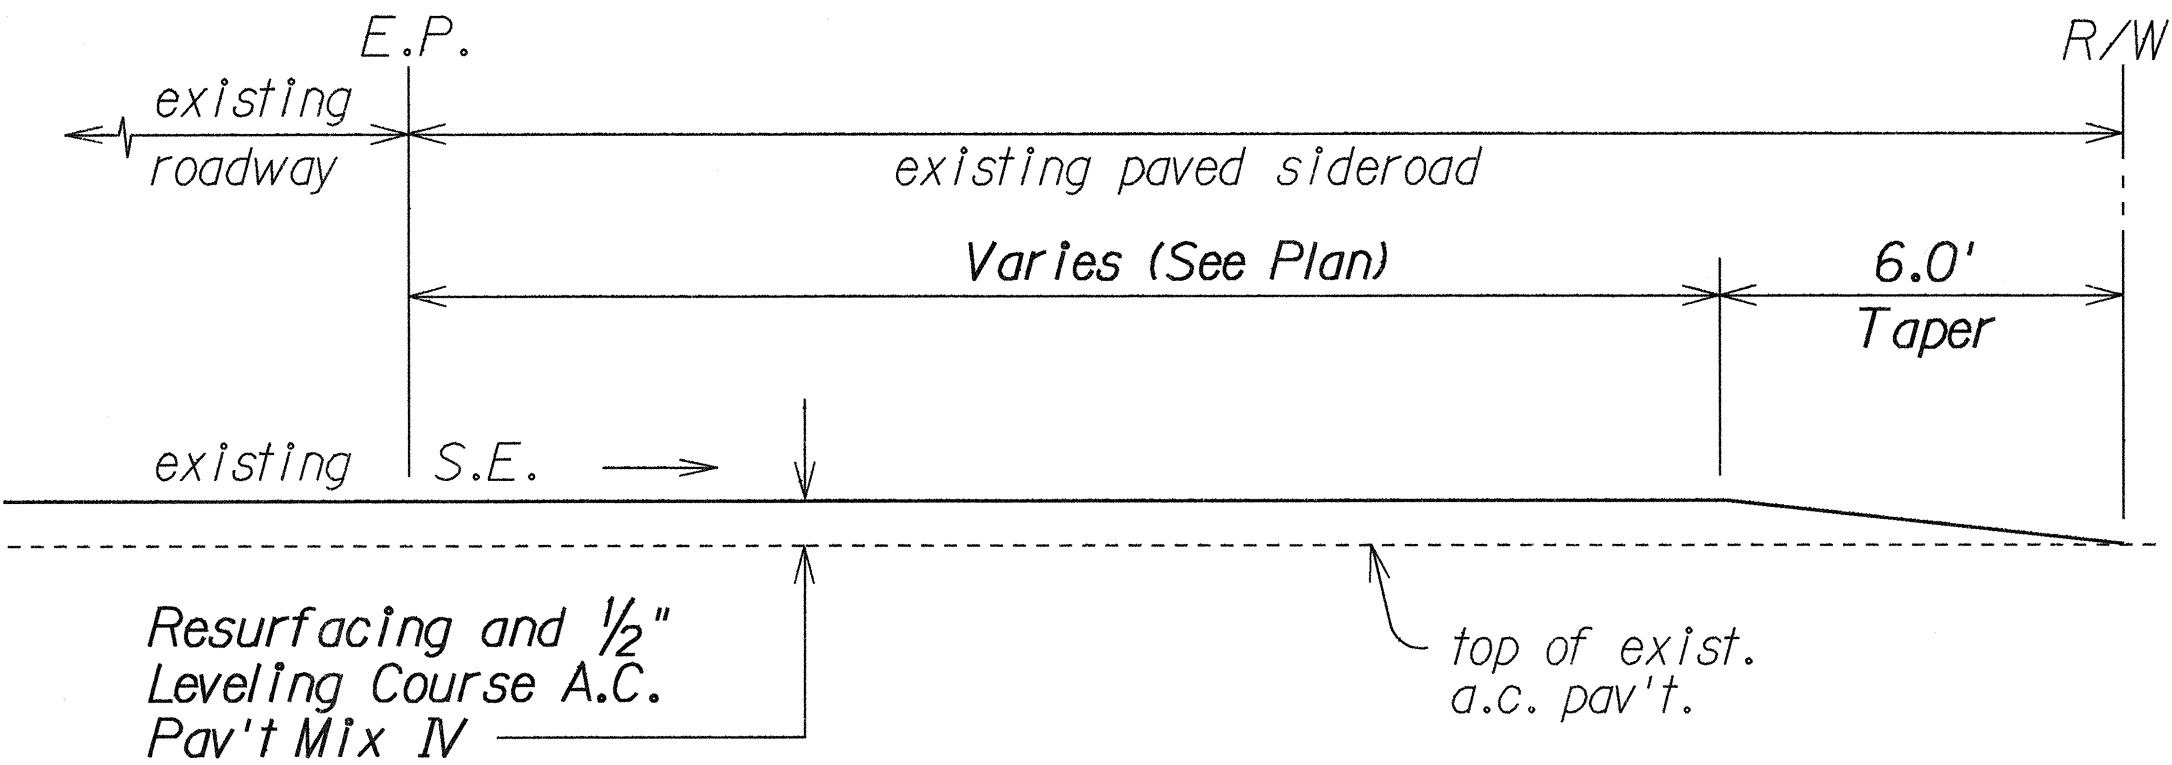


A.C. RESURFACING AT PAVED SIDEROAD DETAIL
Not to Scale

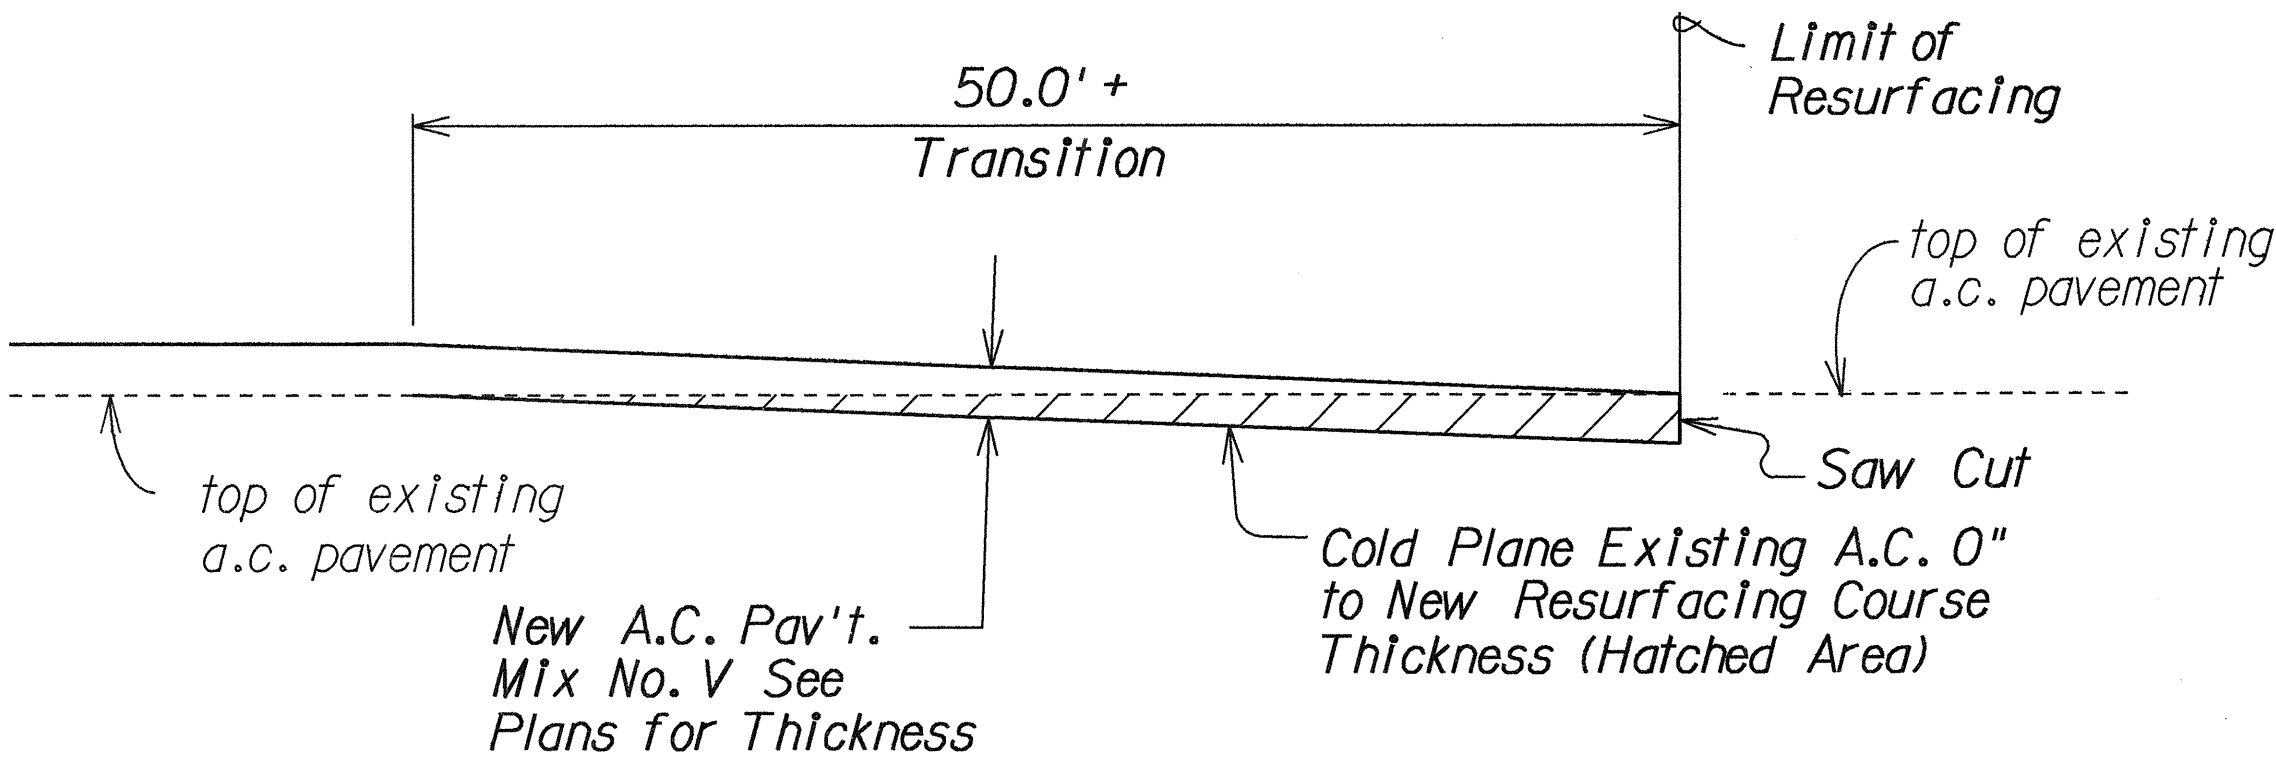

COLD PLANED TRANSITION
TO EXISTING A.C. PAVEMENT DETAIL
BEGINNING AND END OF PROJECT TRANSITION
Not to Scale

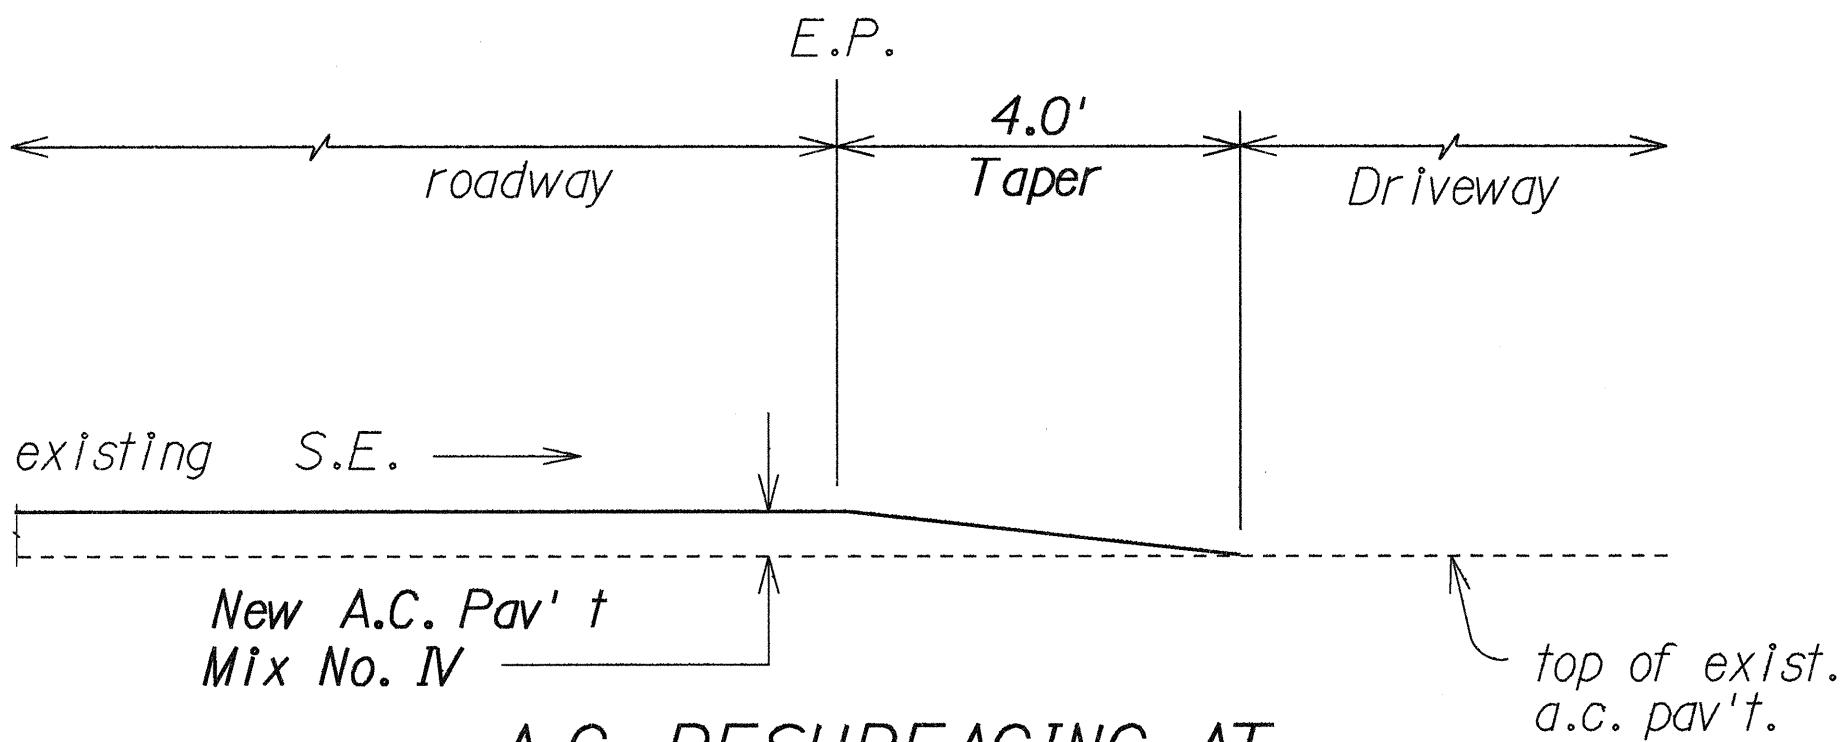

A.C. RESURFACING AT
PAVED DRIVEWAY DETAIL
Not to Scale

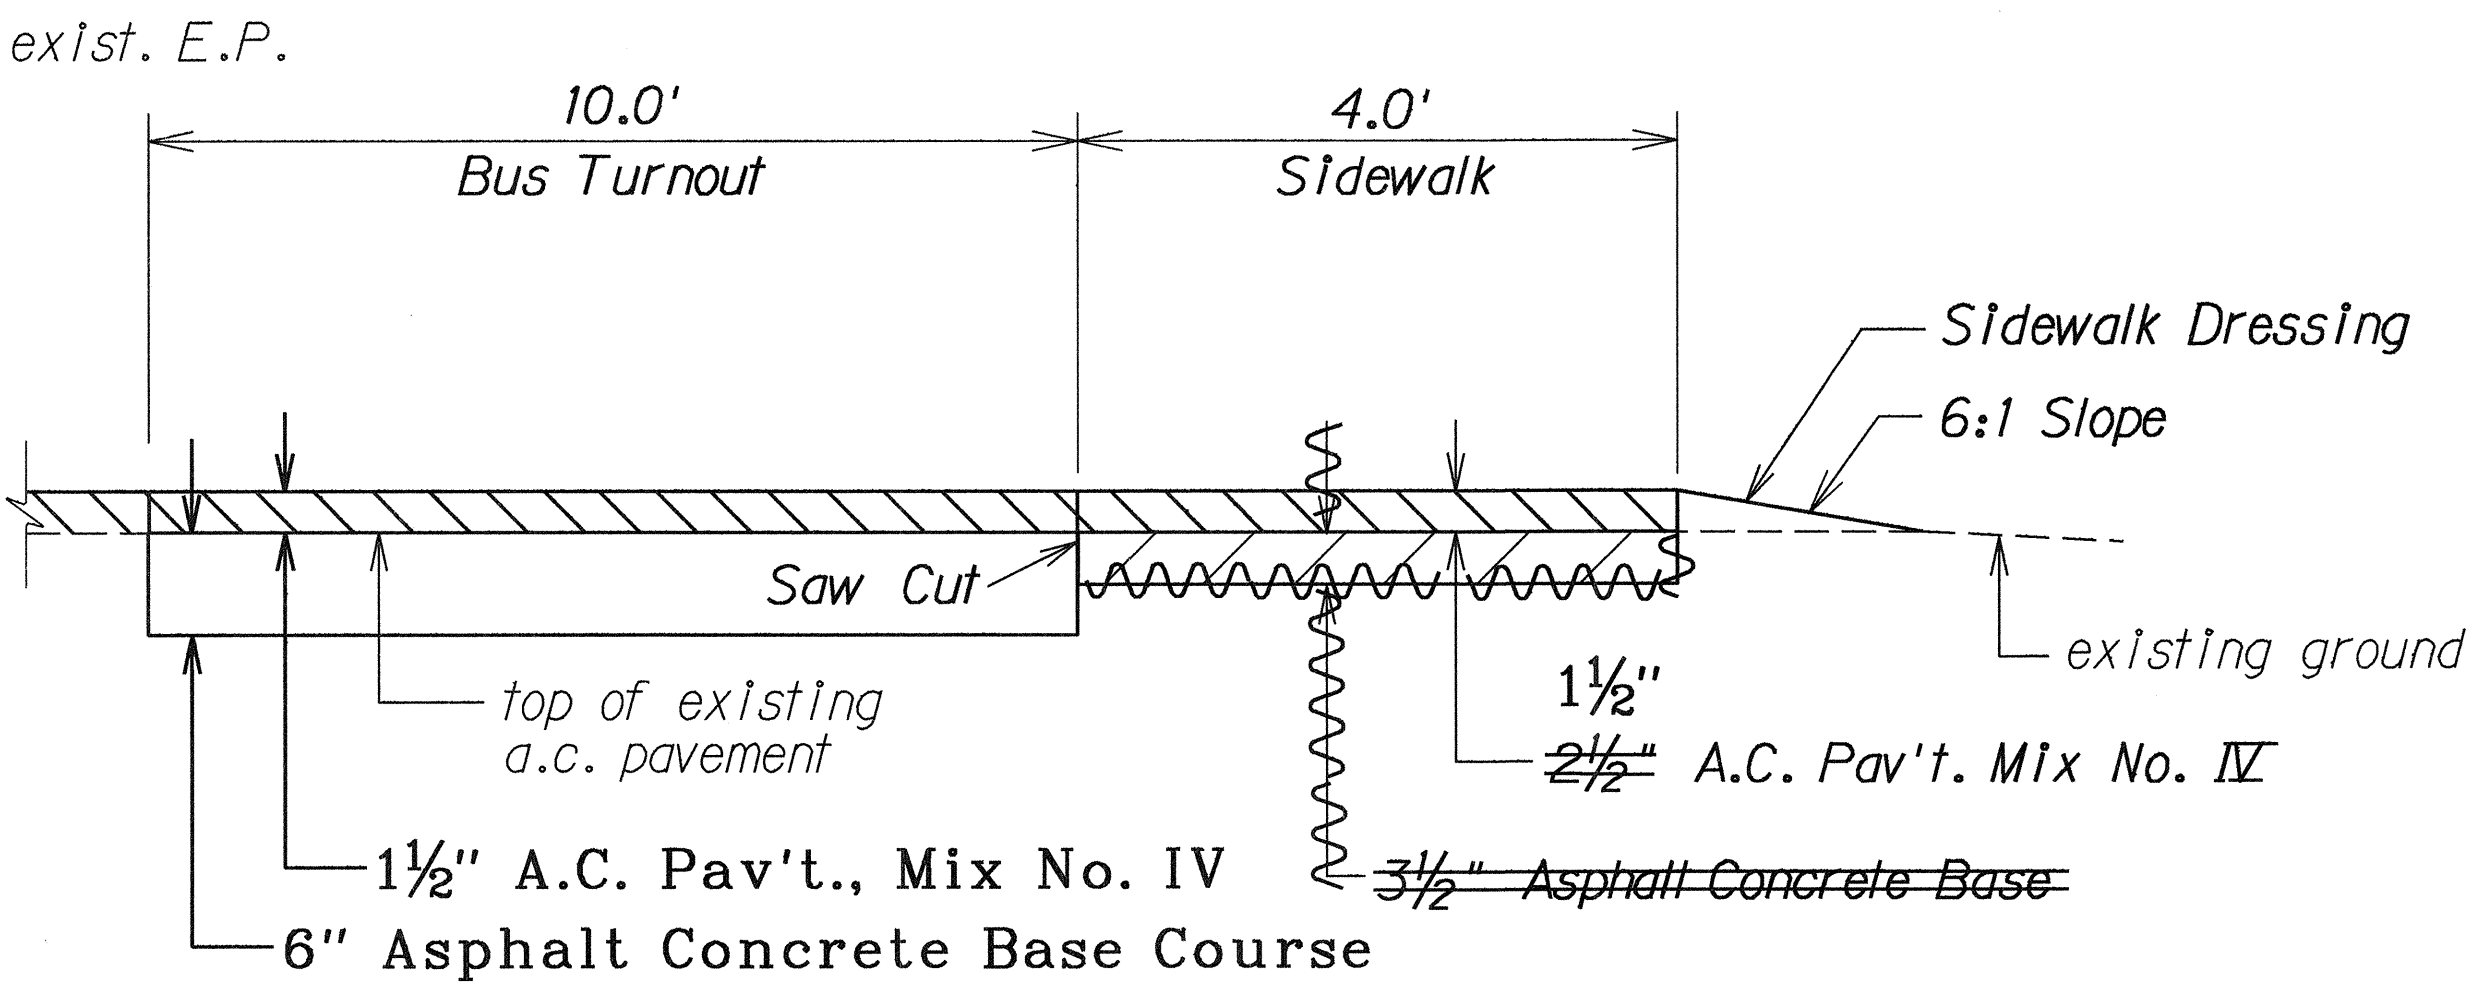

TYPICAL SECTION AT NEW BUS BAY
Not To Scale

LEGEND FOR AS-BUILT POSTINGS	
	Squiggly line for as-built deletion
	Double line for as-built deletion
Roadway	Text for as-built posting

STATE OF HAWAII
DEPARTMENT OF TRANSPORTATION
HIGHWAYS DIVISION

ROADWAY DETAILS
FORT WEAVER ROAD IMPROVEMENTS
Ewa Beach Road to Fort Weaver Gate
Project No. 76A-01-91

Scale: As Noted Date: January, 1991
SHEET No. 1 OF 1 SHEETS

DESIGNED BY	DATE
DRAWN BY	
CHECKED BY	
NOTED BY	
QUANTITIES BY	
FORMS BY	