


FED. ROAD DIST. NO.	STATE	PROJ. NO.	FISCAL YEAR	SHEET NO.	TOTAL SHEETS
HAWAII	HAW.	76A-01-91	1991	5	10

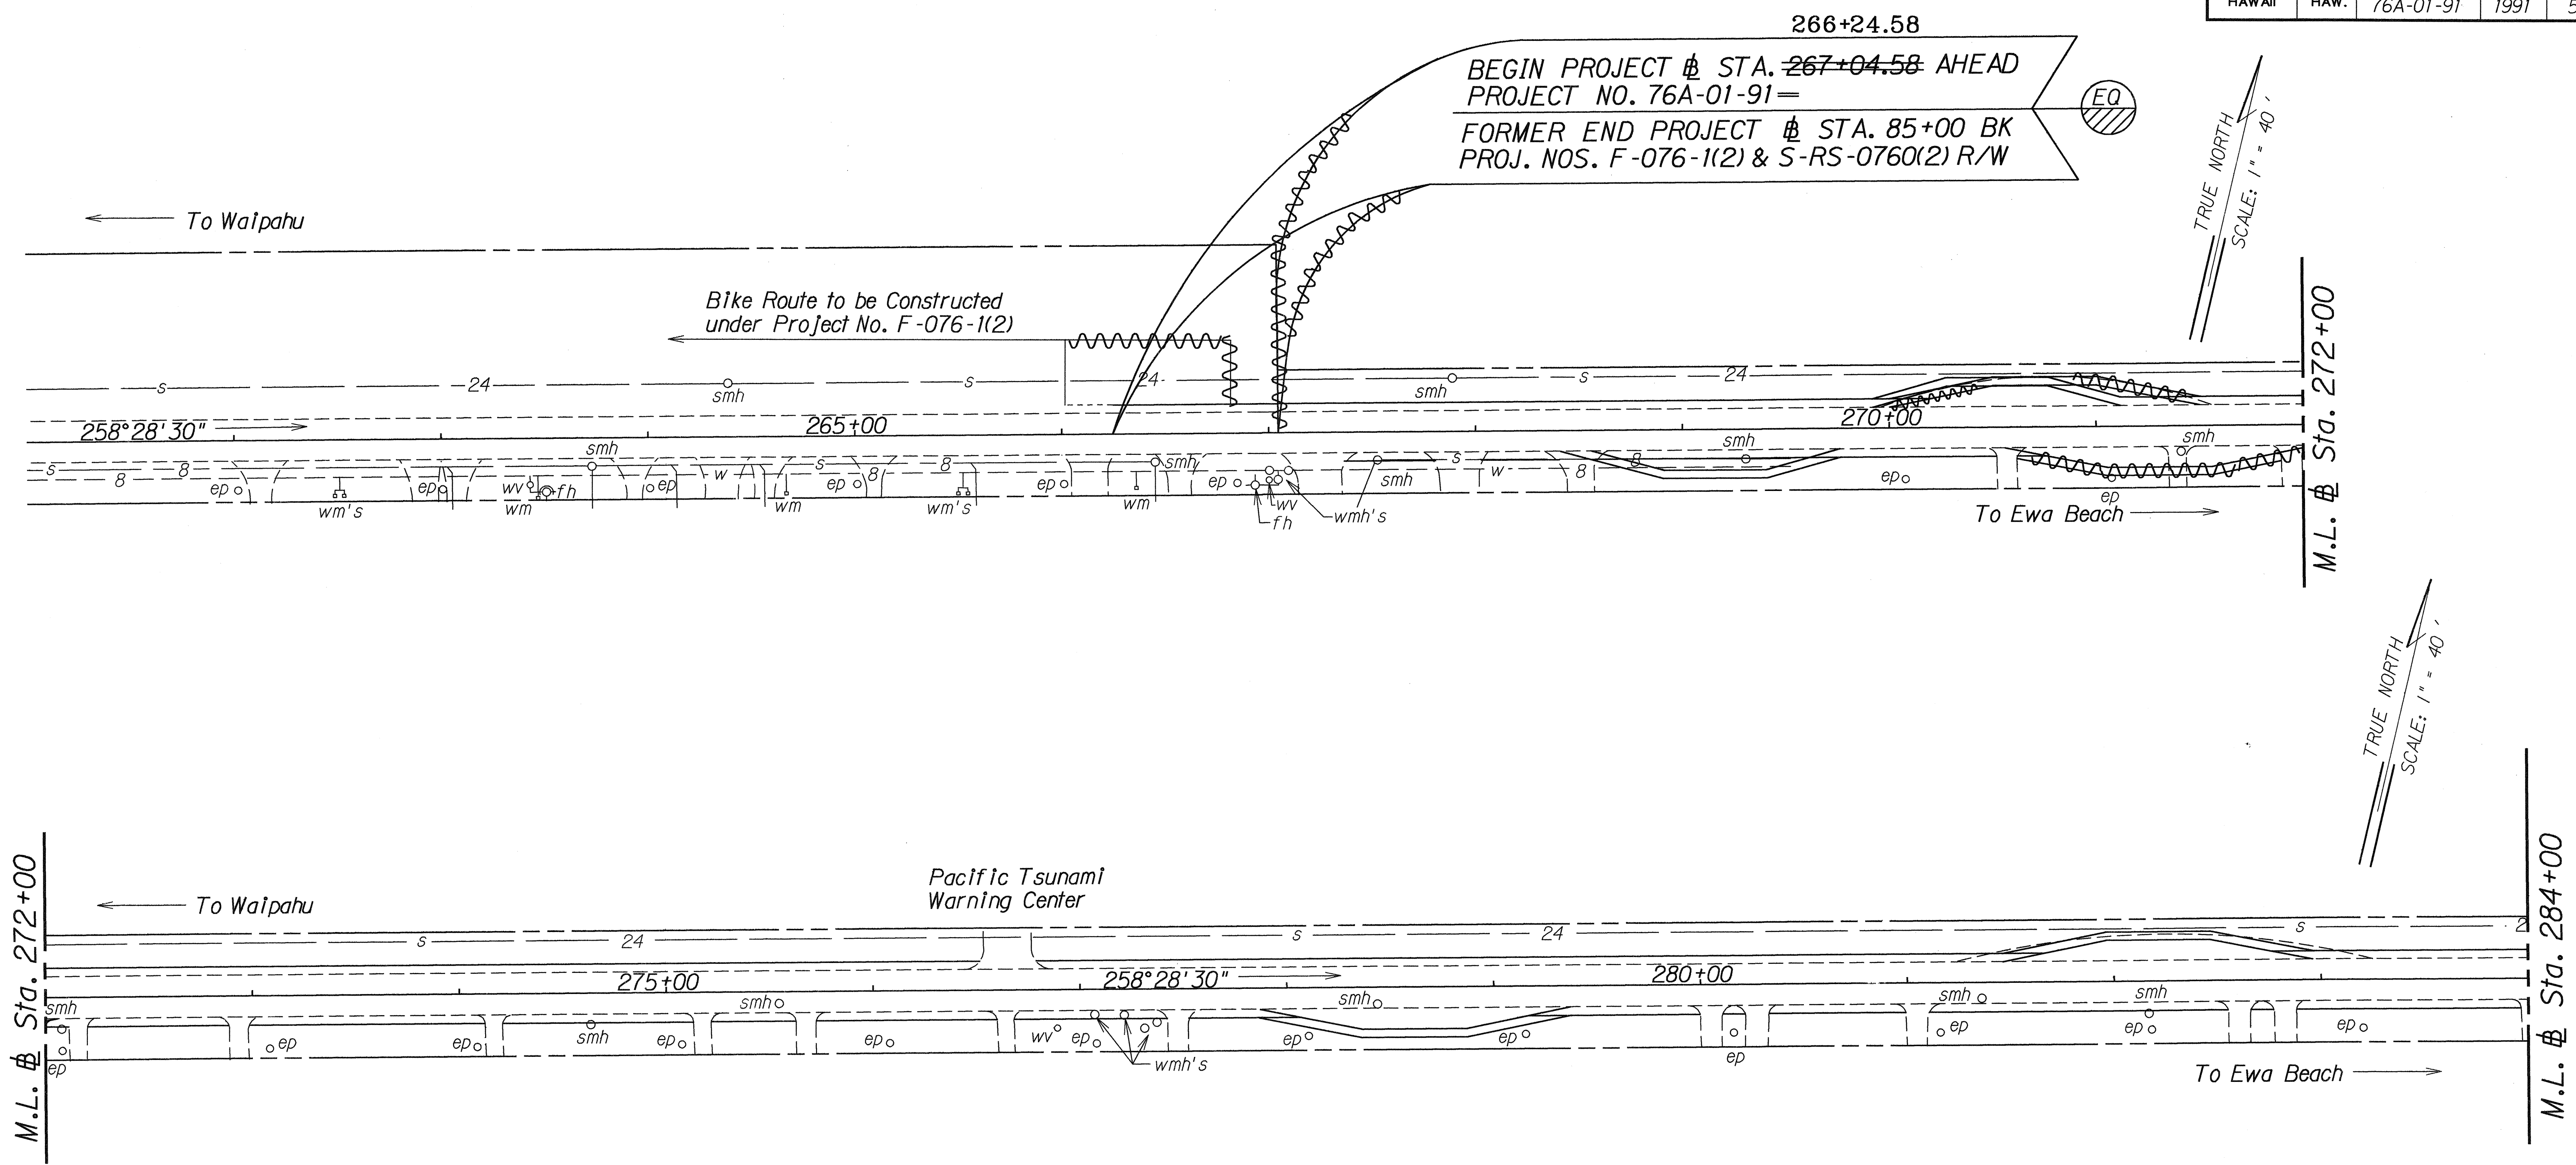

LEGEND FOR AS-BUILT POSTINGS	
	Squiggly line for as-built deletion
	Double line for as-built deletion
Roadway	Text for as-built posting

STATE OF HAWAII
DEPARTMENT OF TRANSPORTATION
HIGHWAYS DIVISION



ROADWAY PLAN
FORT WEAVER ROAD IMPROVEMENTS
Ewa Beach Road to Fort Weaver Gate
Project No. 76A-01-91

Scale: 1" = 40'
Date: January, 1991

SHEET No. 1 OF 2 SHEETS

ORIGINAL PLAN	SURVEY PLOTTED BY	DATE
NOTE BOOK	DRAWN BY	
002 George	TRACED BY	
N. Fort Hdg	CHECKED BY	

FED. ROAD DIST. NO.	STATE	PROJ. NO.	FISCAL YEAR	SHEET NO.	TOTAL SHEETS
HAWAII	HAW.	76A-01-91	1991	6	10

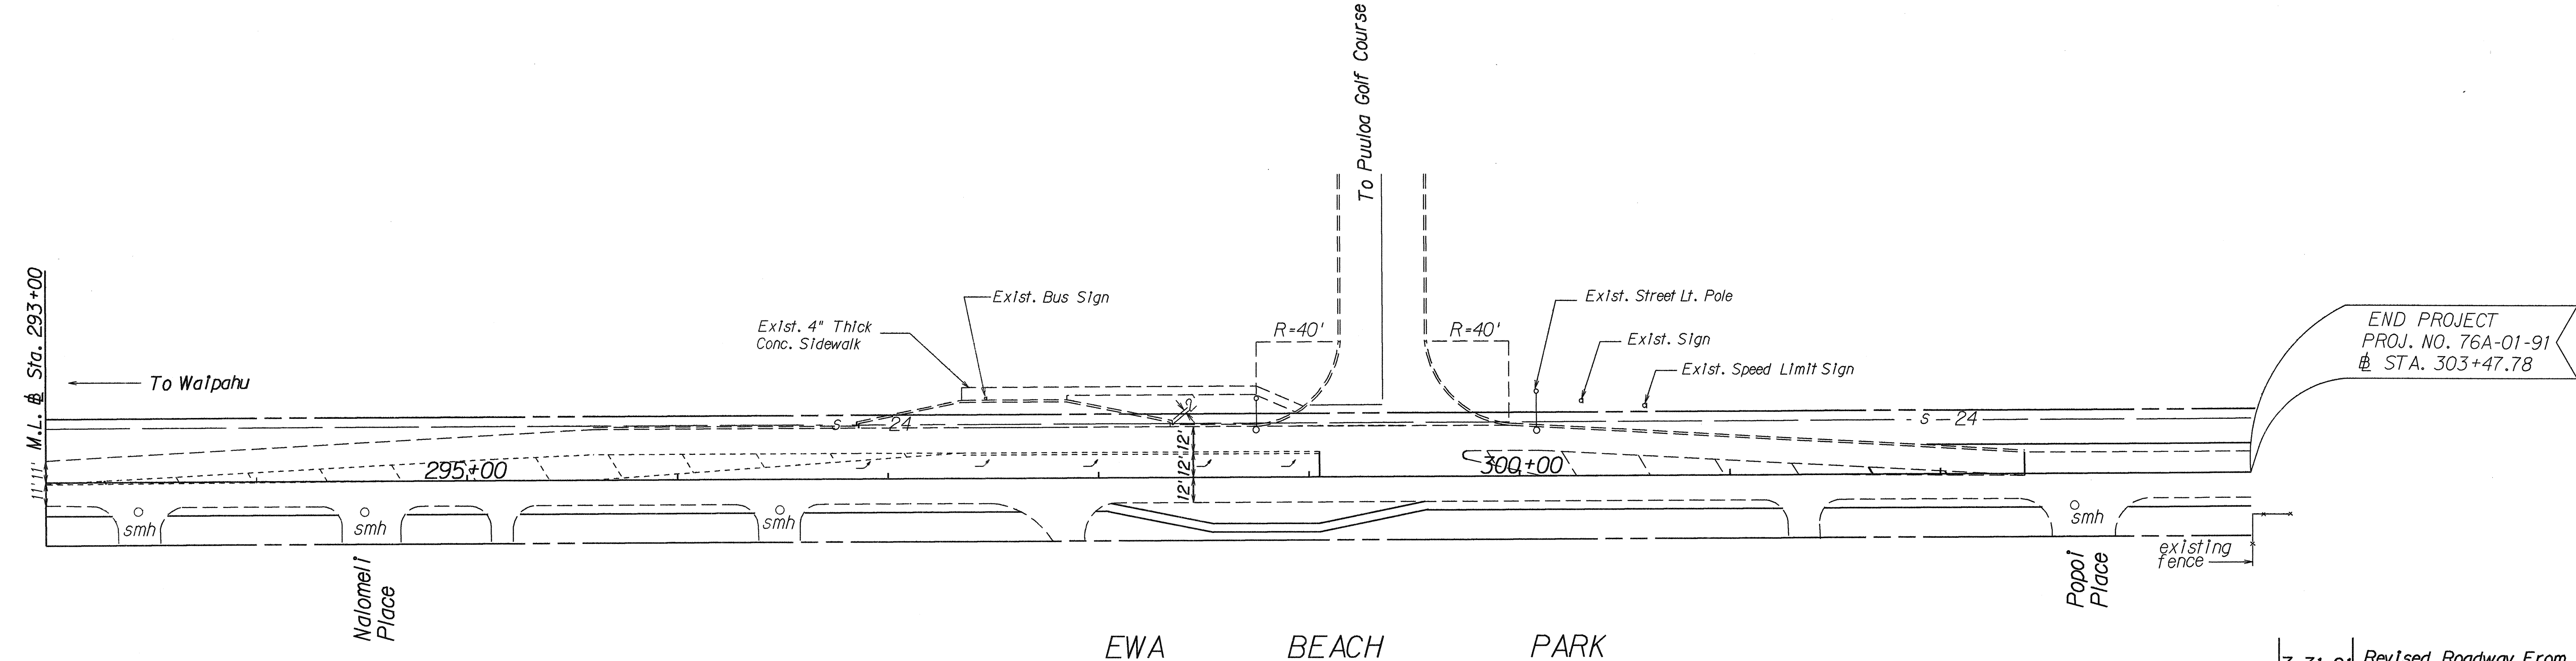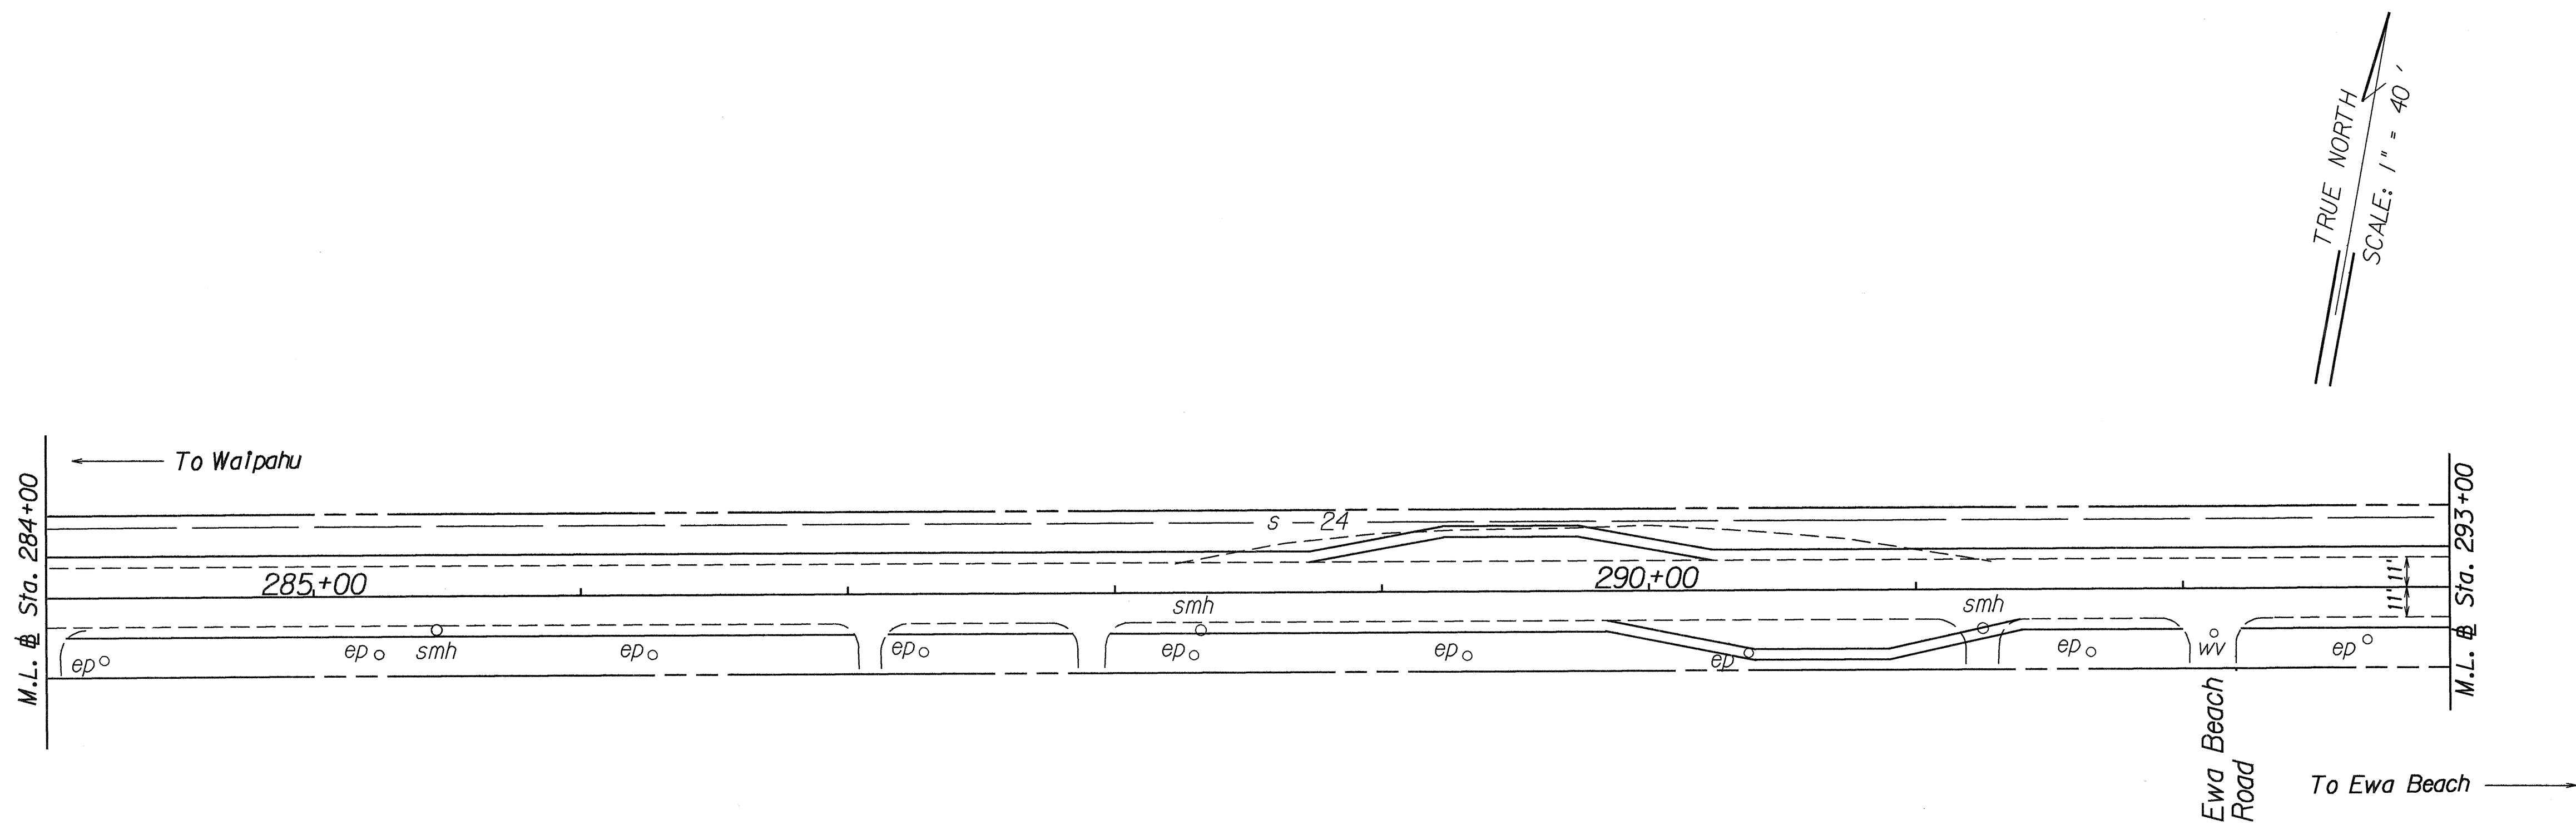

ORIGINAL PLAN	SURVEY PLOTTED BY	DATE
NOTE BOOK	DRAWN BY	
012/09/91	DESIGNED BY	
N. Toribara	CHECKED BY	

7-31-91	Revised Roadway From Sta. 293+00 to Sta. 303+47.78
Date	Revision
STATE OF HAWAII DEPARTMENT OF TRANSPORTATION HIGHWAYS DIVISION ROADWAY PLAN FORT WEAVER ROAD IMPROVEMENTS Ewa Beach Road to Fort Weaver Gate Project No. 76A-01-91	
Scale: 1" = 40'	Date: January, 1991
SHEET No. 2 OF 2 SHEETS	