	INDEX TO DRAWINGS
•	INDEX TO DRAWINGS
SHEET NO.	DESCRIPTION
1	TITLE SHEET
2	STANDARD PLANS SUMMARY
3	LEGEND AND GENERAL NOTES
4	ROADWAY DETAILS
5-6	ROADWAY PLANS
7	PAVEMENT MARKING LEGEND,
	DETAILS AND NOTES
8-9	PAVEMENT MARKING AND STRIPING
	PLANS
10	TRAFFIC SUMMARIES

STATE OF HAWAII

DEPARTMENT OF TRANSPORTATION
HIGHWAYS DIVISION
HONOLULU, HAWAII

"AS-BUILT"


PLANS FOR

## FORT WEAVER ROAD IMPROVEMENTS


EWA BEACH ROAD TO FORT WEAVER GATE

PROJECT NO. 76A-01-91

DISTRICT OF EWA
ISLAND OF OAHU

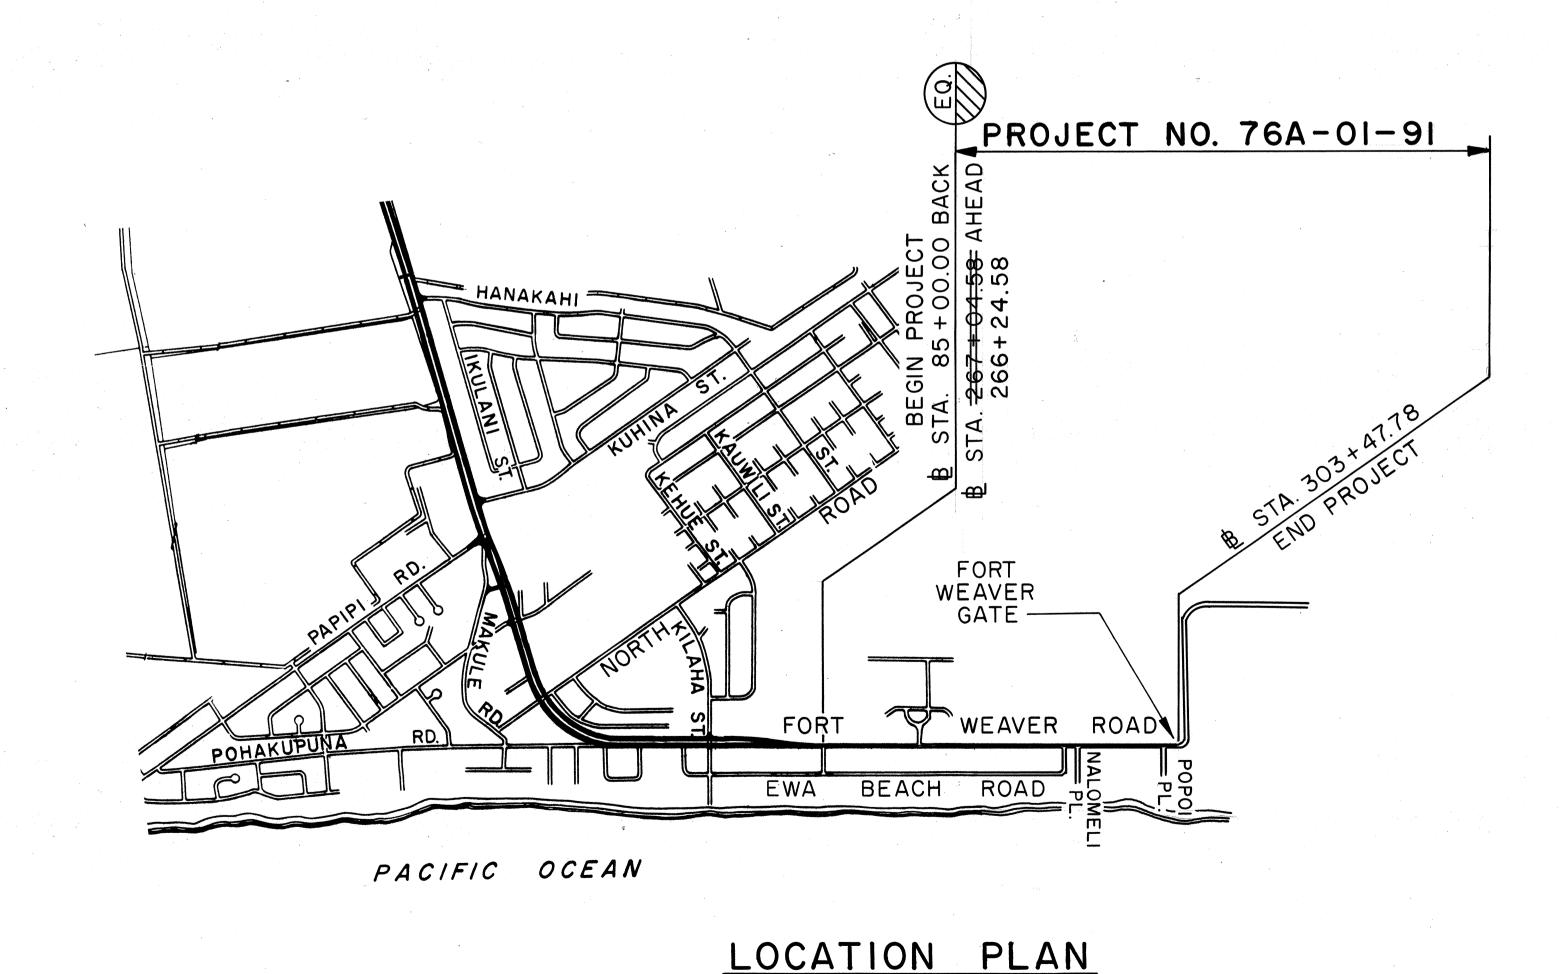

SCALE IN THOUSAND FEET

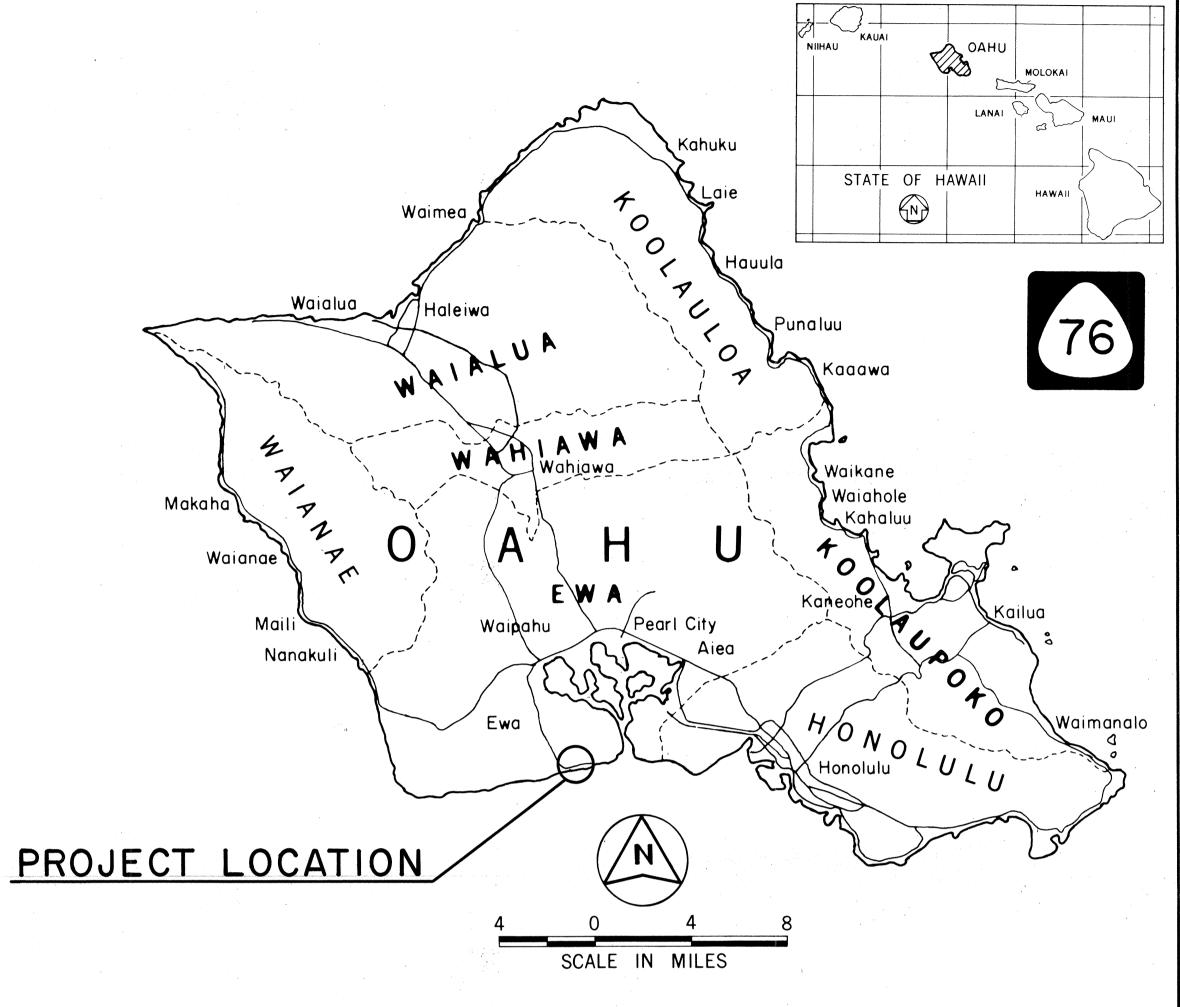

FED. ROAD DIST. NO. FISCAL YEAR

76A-01-91

MILE POST 0.69 TO MILE POST 0.00

CHANGES MADE DURING CONSTRUCTION HAVE BEEN INCORPORATED ON THESE PLANS EXCEPT CHANGES IN THE ORIGINAL THEORETICAL QUANTITIES. FOR ACTUAL QUANTITIES, REFER TO PROJECT LEDGER AND/OR COMPUTATION BOOK.

Michael Duniga RESIDENT ENGINEER

7/2/23 DATE

DEPARTMENT OF TRANSPORTATION
STATE OF HAWAII

APPROVED:

LL. JANAS SPARA

DIR. OF TRANSPORTATION

DATE

0-8-0-00

MAR., 1991 DATE

548-7534 PHONE

<u>a</u>

DESIGN UNIT DESIGNED BY