
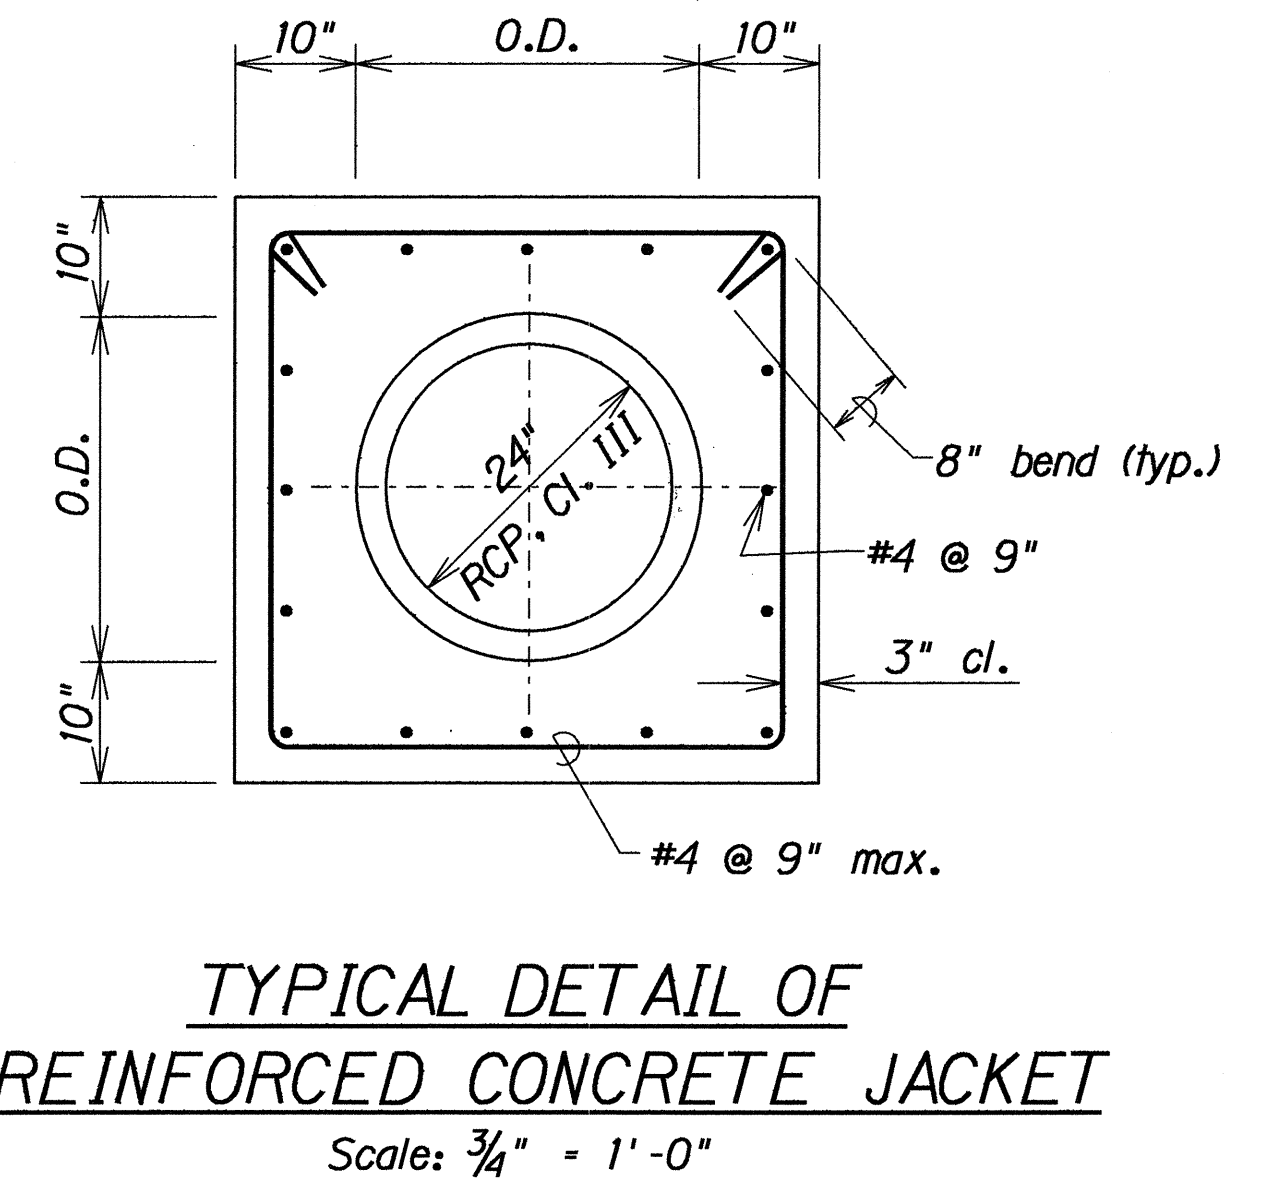
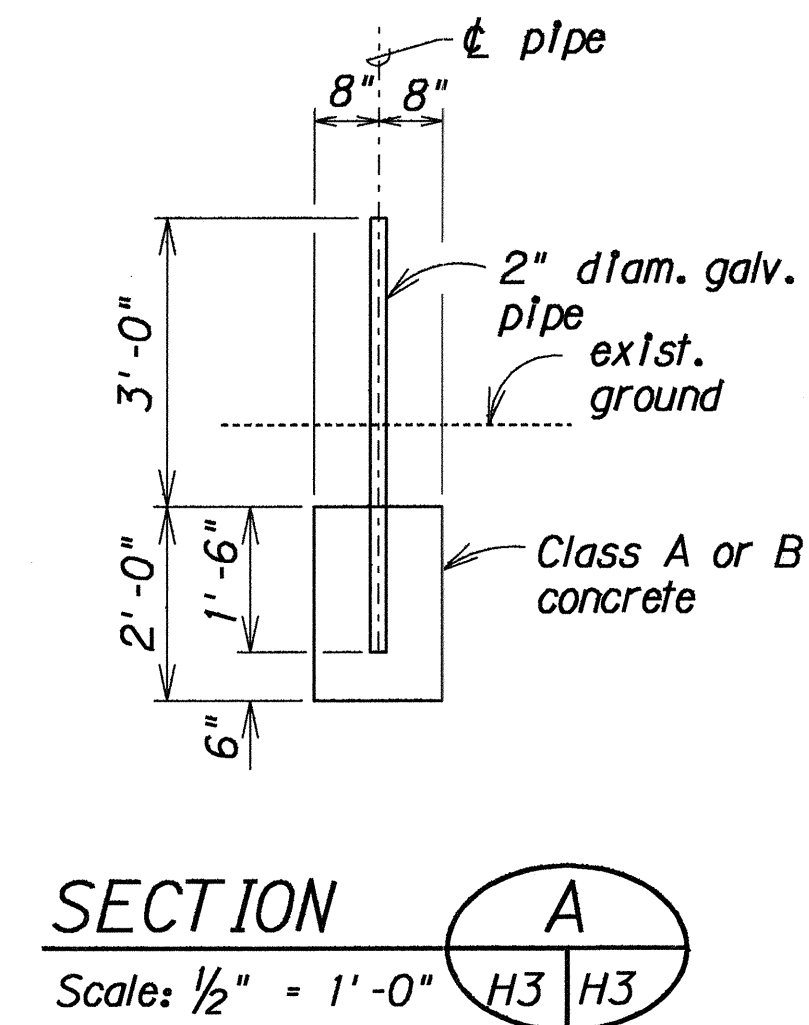
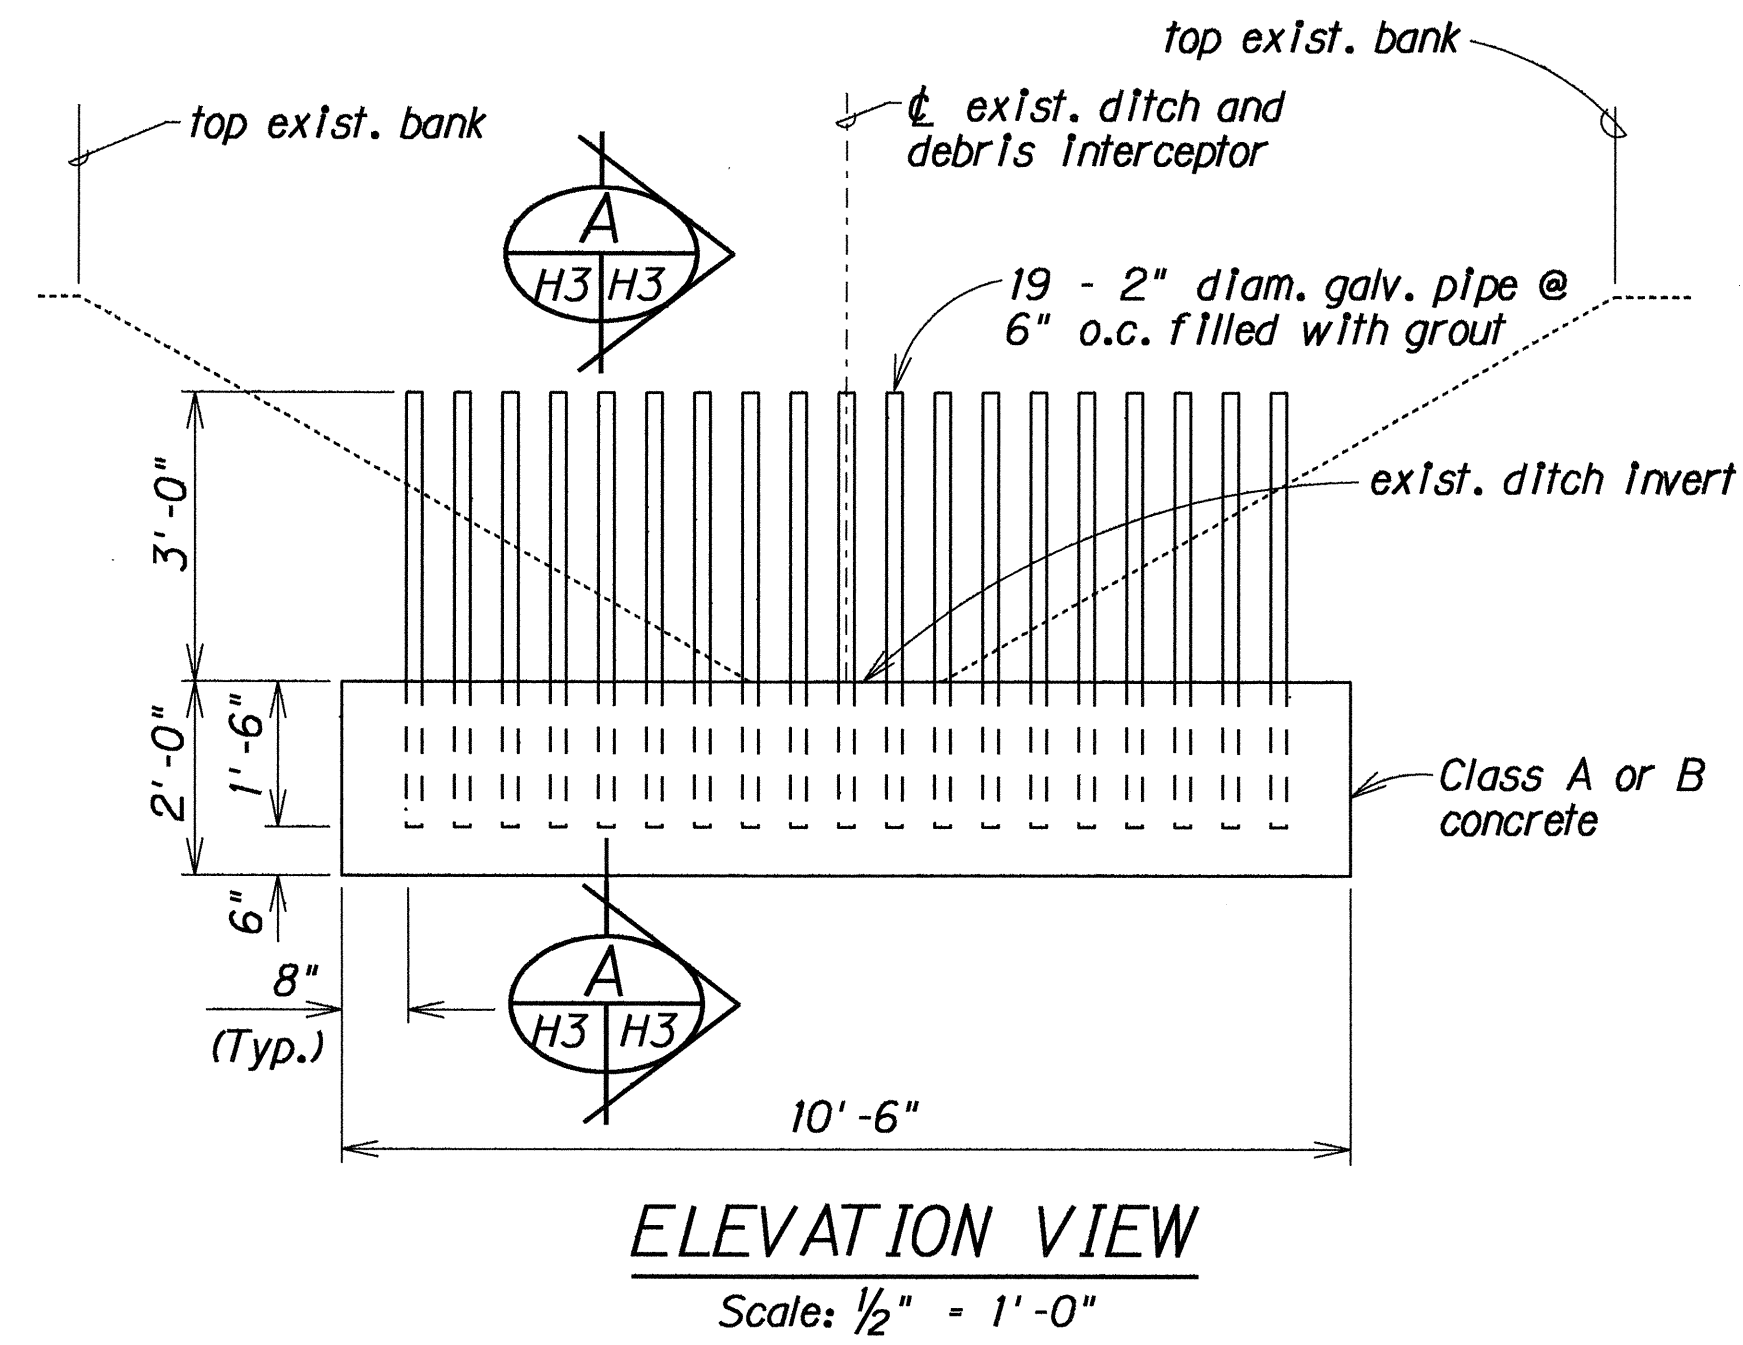





FED. ROAD DIST. NO.	STATE	PROJ. NO.	FISCAL YEAR	SHEET NO.	TOTAL SHEETS
HAWAII	HAW.	76B-01-91	1992	ADD. 5	5

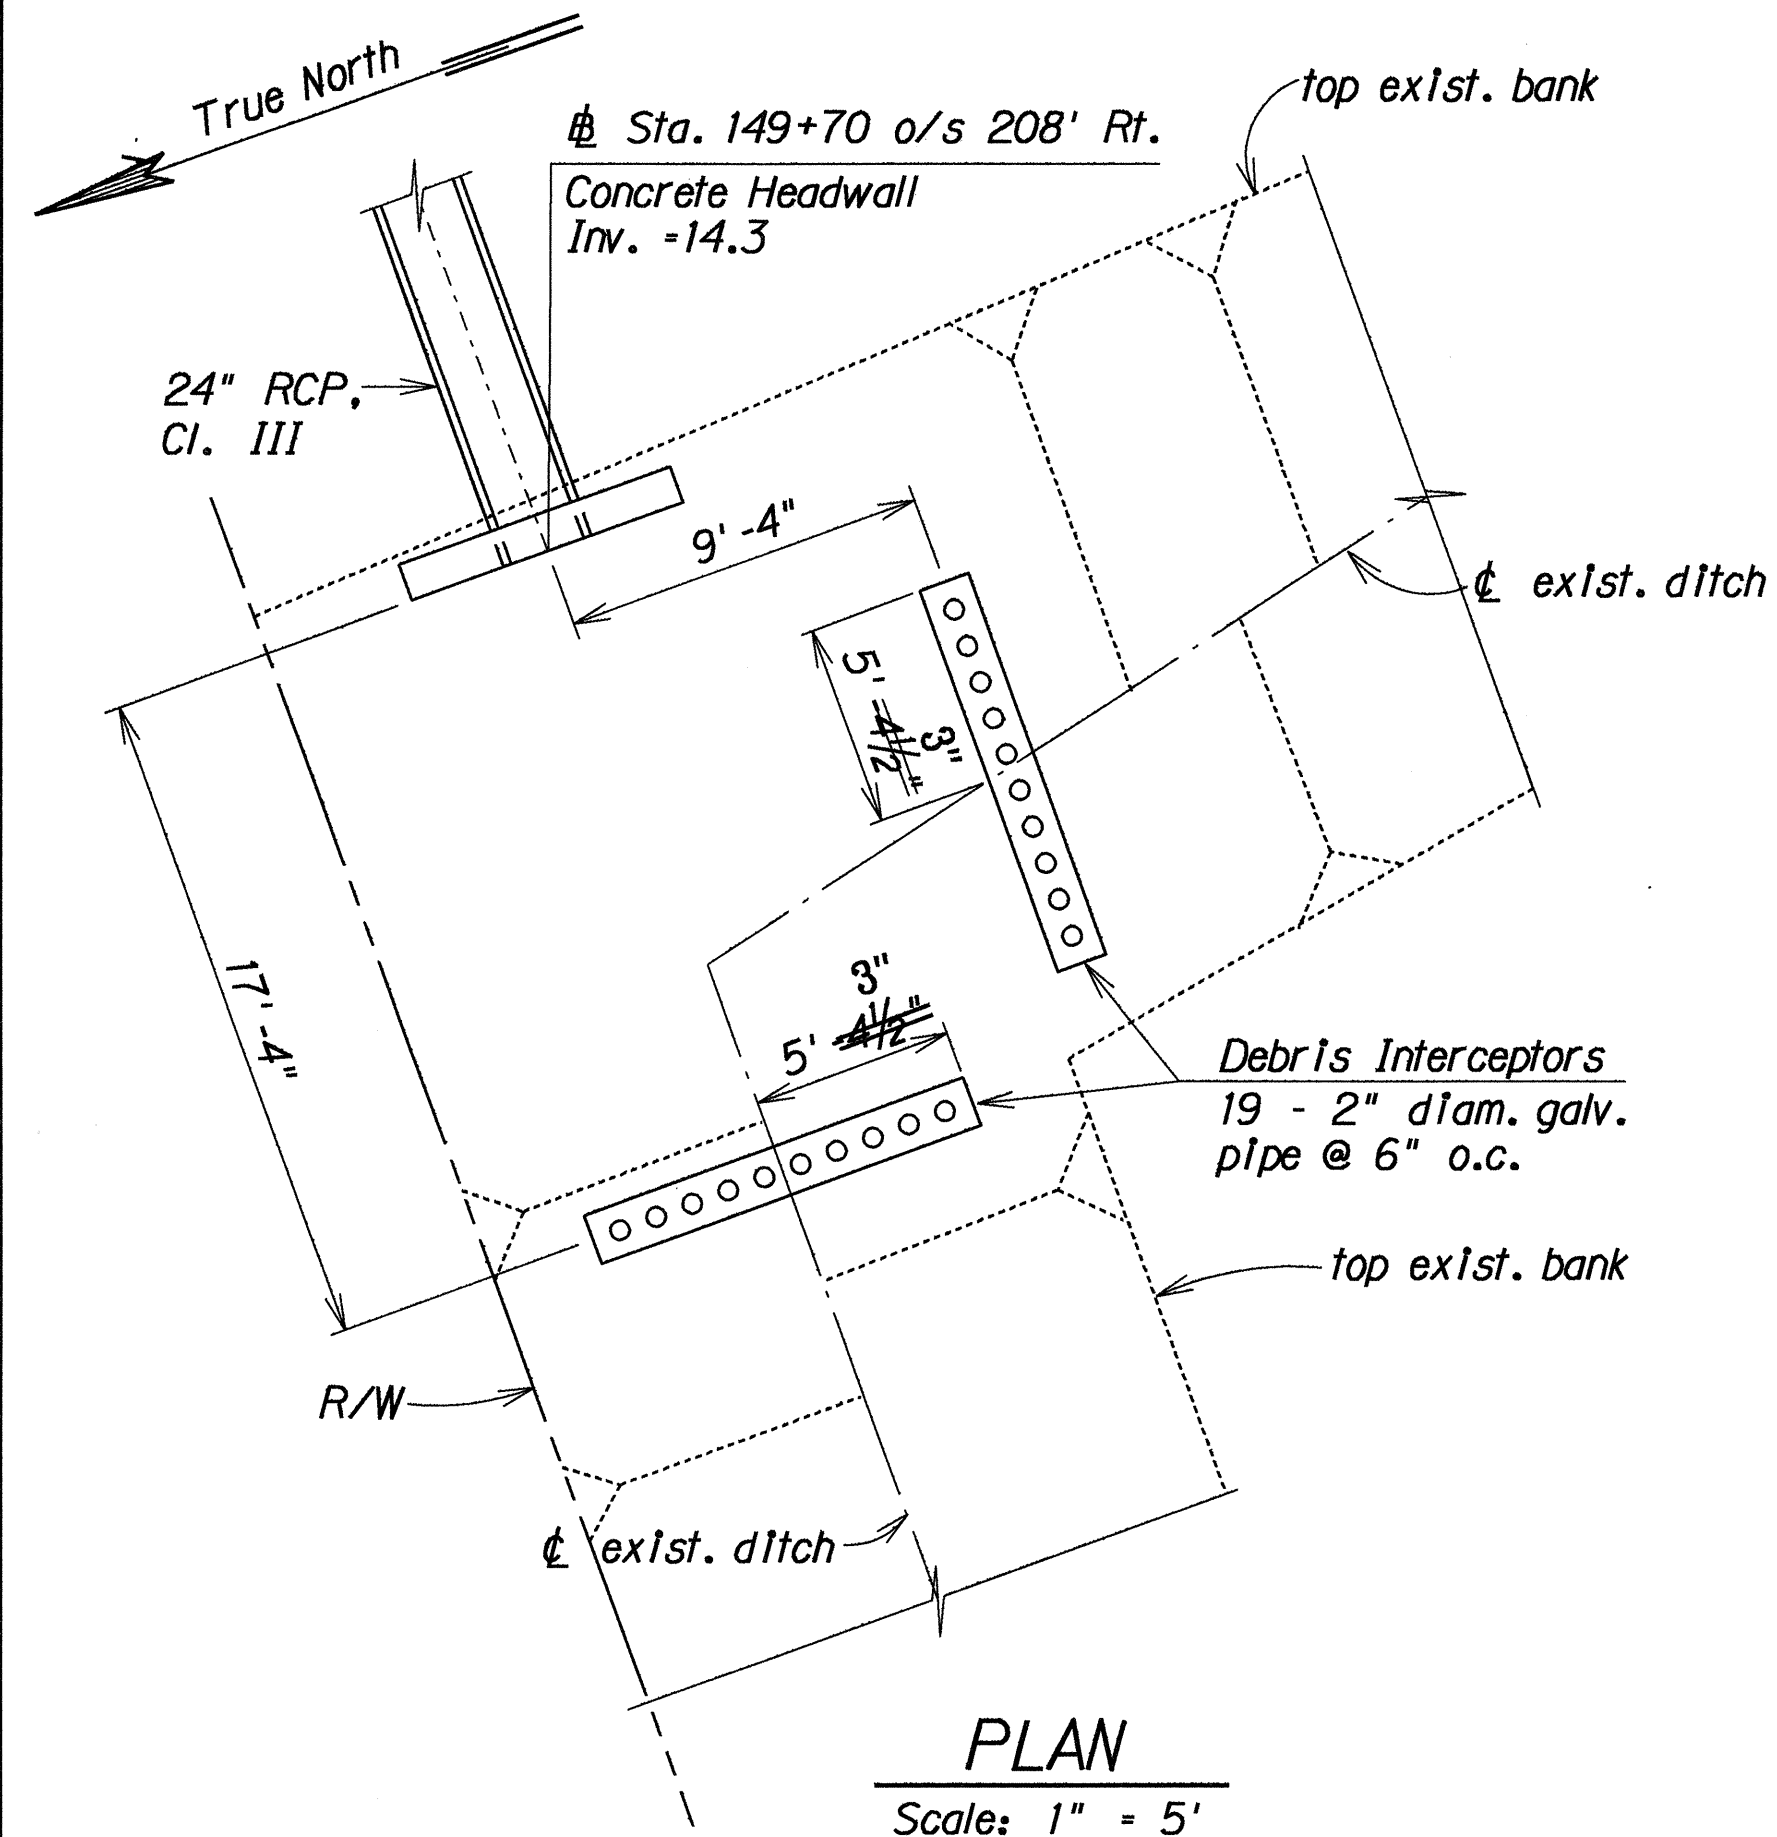

DETAILS OF DEBRIS INTERCEPTOR

DRAINAGE SUMMARY

ITEM NO.		206 2020	304 1100	401 0500	503 0020	503 8700	602 1020	603 0015	603 1010	604 5003
UNIT USED		CY	CY	TON	CY	LF	LB	CY	LF	EA
Station (from)	Station (to)	Structural Excavation for Drainage System	Aggregate Base	Asphalt Concrete Pavement M1x No. V	Class A Concrete for Drainage System	Reinforced Concrete Jacket	Reinforcing Steel for Drainage System	Coarse Aggregate No. 67, AASHTO M43	24" RCP, Cl. III	Type "A" SDMH, 4.00 feet to 5.99 feet
136+60 o/s 82' Rt.	137+42 o/s 63' Rt.	88			1.5	37	43	16	80	1
137+42 o/s 63' Rt.	139+60 o/s 66' Rt.	255						42	212	1
139+60 o/s 66' Rt.	142+09 o/s 67' Rt.	254						49	243	1
142+09 o/s 67' Rt.	144+60 o/s 82' Rt.	253						49	244	1
144+60 o/s 82' Rt.	147+03 o/s 85' Rt.	255						49	244	1
147+03 o/s 85' Rt.	149+42 o/s 107' Rt.	275	15	7				66	244	1
149+42 o/s 107' Rt.	149+70 o/s 208' Rt.	114			1.5		43	20	103	
TOTAL		1494	15	7	3.0	37	86	291	1370	6

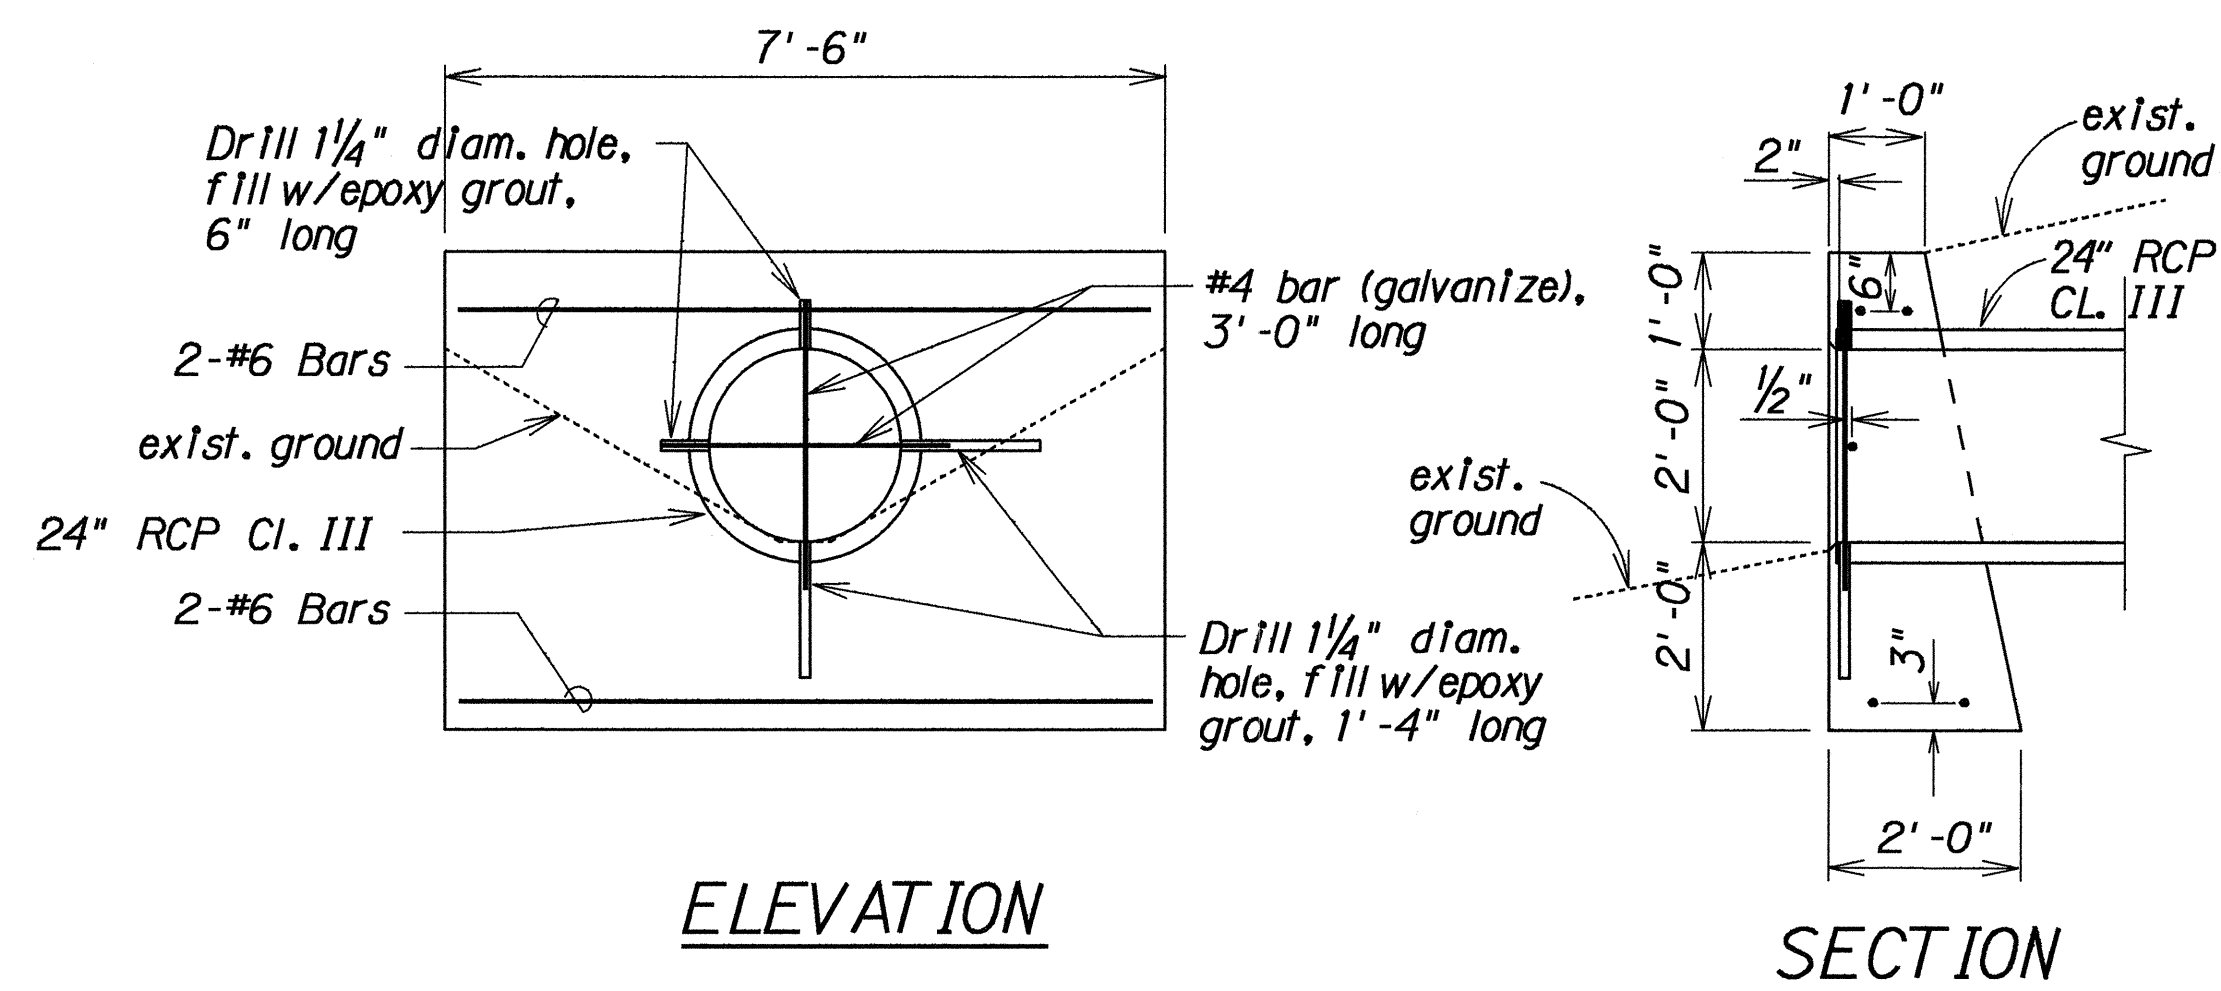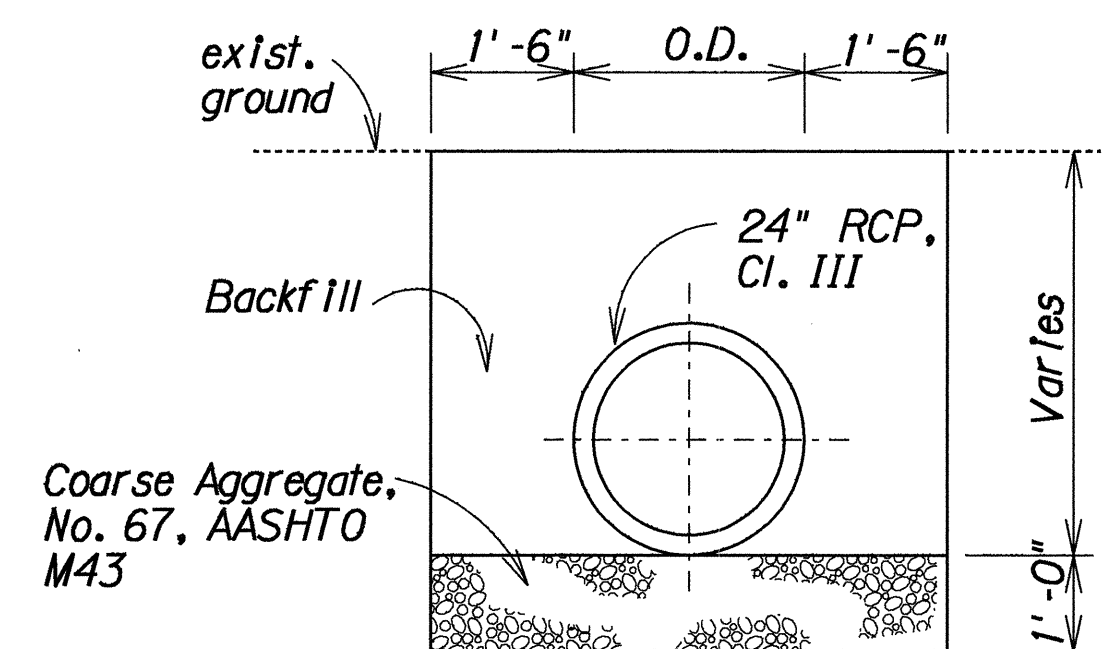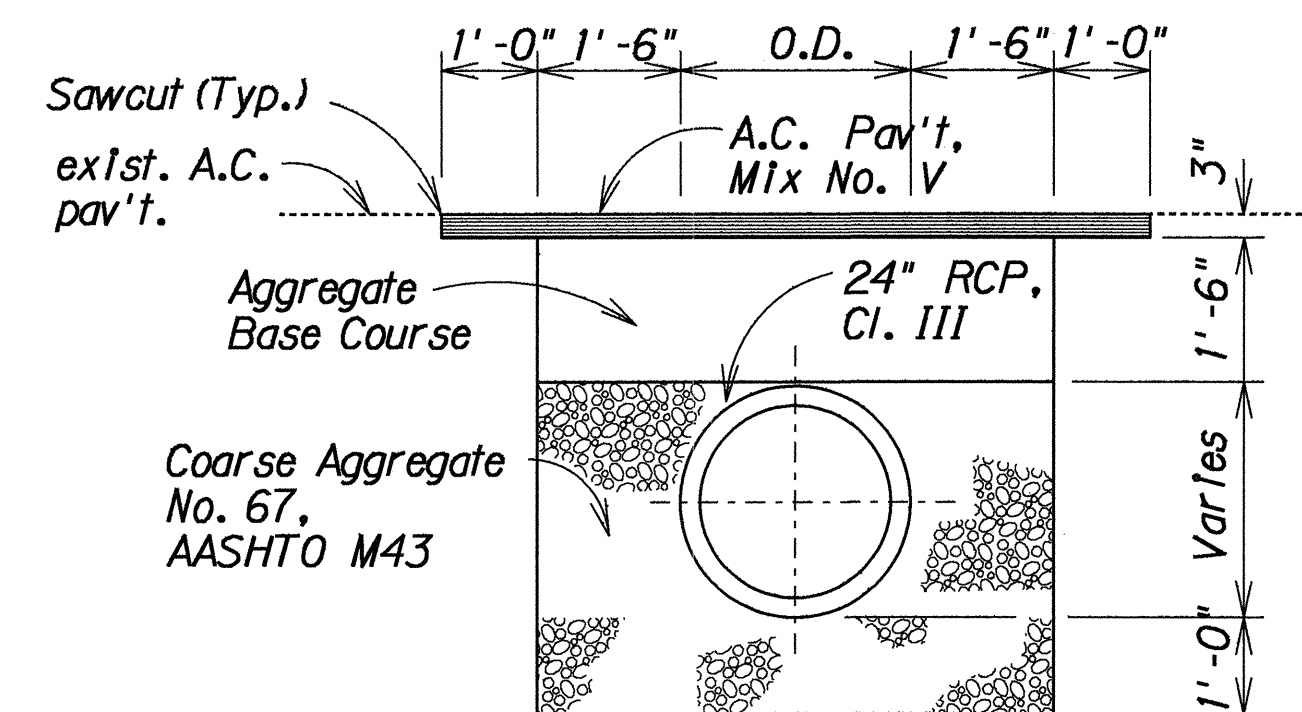

DETAILS OF CONCRETE HEADWALL

LEGEND FOR AS-BUILT POSTINGS	
	Squiggly line for as-built deletion
	Double line for as-built deletion
Roadway	Text for as-built posting

4/15/92	Revised Drainage Summary
Date	Revision

STATE OF HAWAII
DEPARTMENT OF TRANSPORTATION
HIGHWAYS DIVISION

DRAINAGE DETAILS

FORT WEAVER ROAD
Drainage Improvements
Vicinity of Kahua Ranch
PROJECT NO. 76B-01-91

Scale: As Shown Date: Sept., 1991

SHEET No. H3 OF 3 SHEETS

ORIGINAL PLAN	SURVEY PLOTTED BY _____ DATE _____
NOTE BOOK	DRAWN BY _____
	TRACED BY _____
	DESIGNED BY _____
	QUANTITIES BY _____
	CHECKED BY _____
N. _____	