



FED. ROAD DIST. NO.	STATE	PROJ. NO.	FISCAL YEAR	SHEET NO.	TOTAL SHEETS
HAWAII	HAW.	76B-01-91	1992	3	5

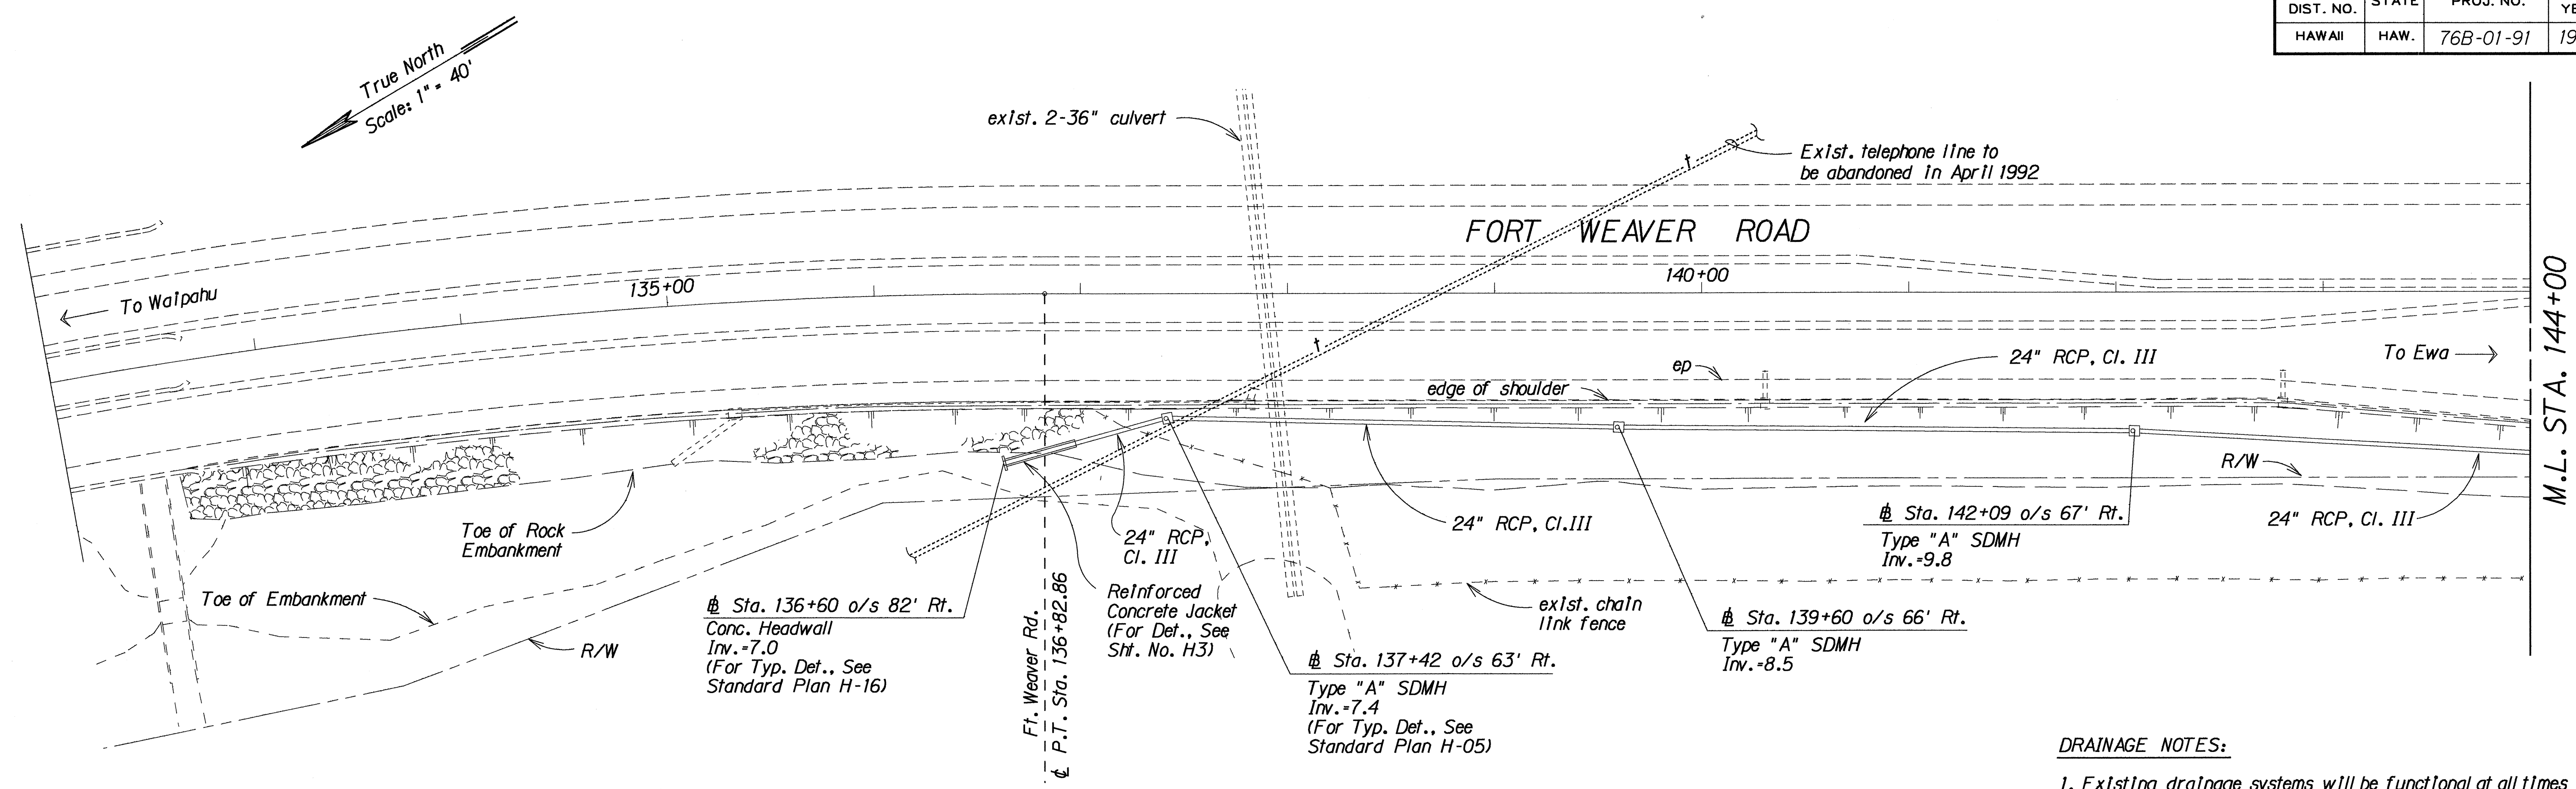

- DRAINAGE NOTES:**
- Existing drainage systems will be functional at all times during construction. The Contractor is to furnish materials, equipment, labor, tools and incidentals necessary to maintain flow. The cost for this work shall be incidental to the various Contract Items.
 - The Contractor shall verify the locations of all existing culverts and utilities in the field. Any existing culverts and utilities damaged during construction shall be repaired or replaced by the Contractor at his own expense.
 - Reinforcing steel for Concrete Jacket shall conform to the requirements of ASTM 615 - Grade 60.
 - For A.C. Pavement Restoration Detail, see Sheet No. H3.
 - The construction cost of the Debris Interceptor shall not be paid for separately, but shall be considered Incidental to Class A Concrete.
 - The Installation of the Safety Bars in Concrete Headwall shall not be paid for separately, but shall be considered Incidental to the various contract items.
 - Pavement markings and striping damaged by construction shall be replaced by the Contractor and approved by the Engineer. This work shall be considered Incidental to the various drainage items.

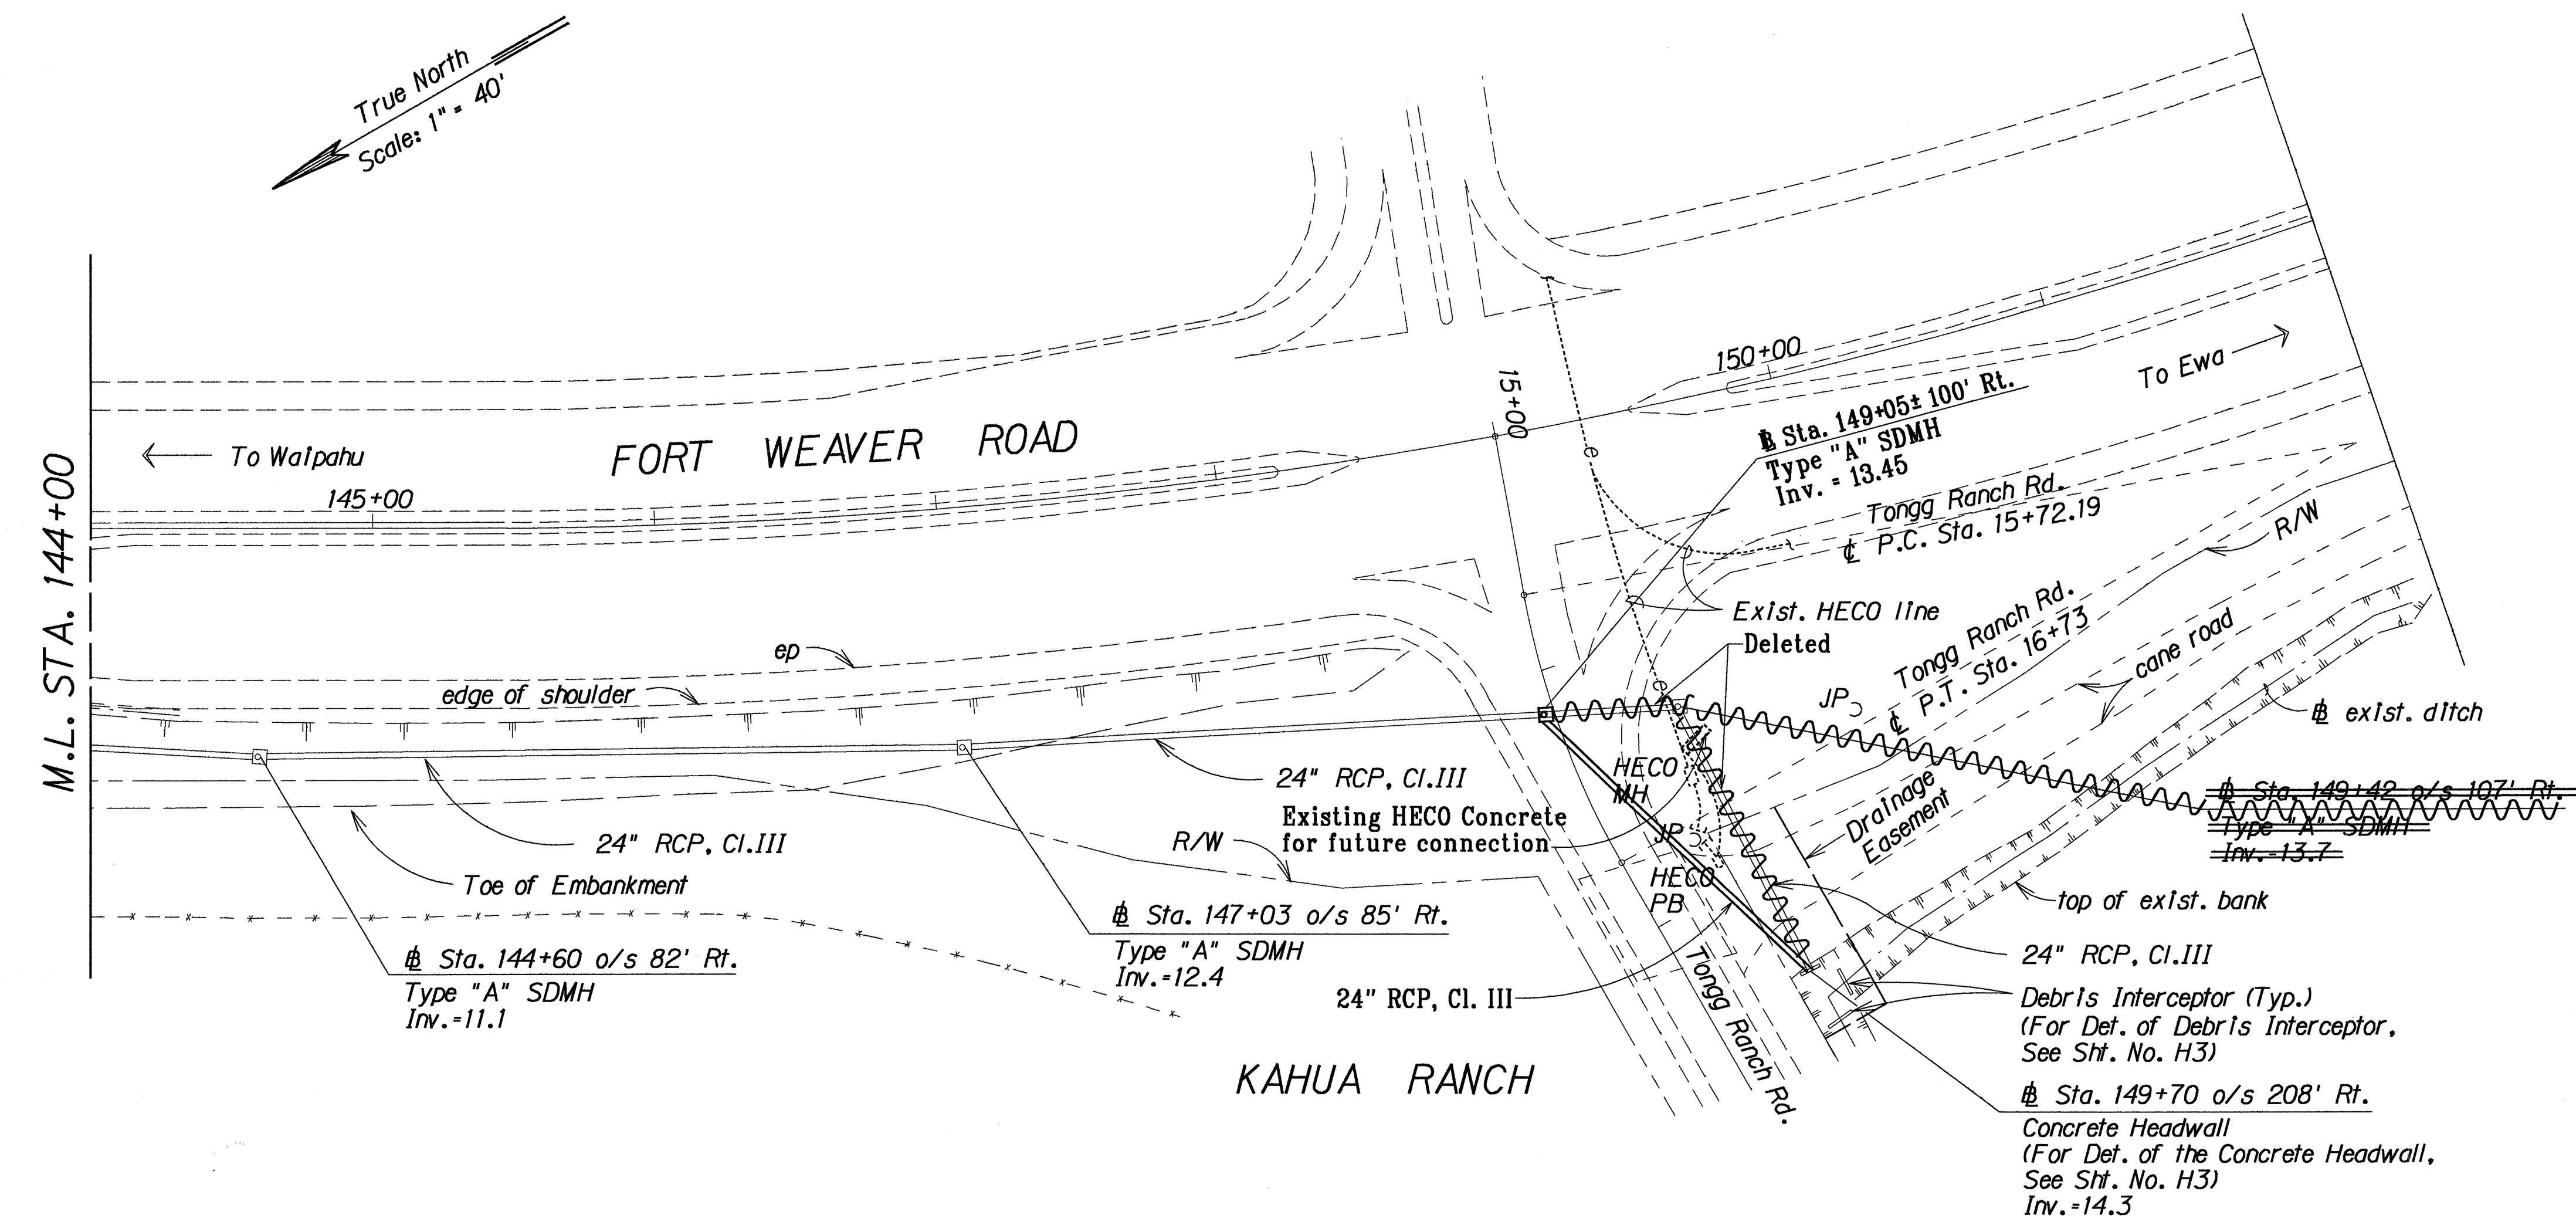

LEGEND FOR AS-BUILT POSTINGS	
	Squiggly line for as-built deletion
	Double line for as-built deletion
Roadway	Text for as-built posting

STATE OF HAWAII
DEPARTMENT OF TRANSPORTATION
HIGHWAYS DIVISION

DRAINAGE PLANS
FORT WEAVER ROAD
Drainage Improvements
Vicinity of Kahua Ranch
PROJECT NO. 76B-01-91

Scale: As Shown Date: Sept., 1991
SHEET No. H1 OF 3 SHEETS