


FED. ROAD DIST. NO.	STATE	PROJ. NO.	FISCAL YEAR	SHEET NO.	TOTAL SHEETS
HAWAII	HAW.	76B-01-91	1992	4	5

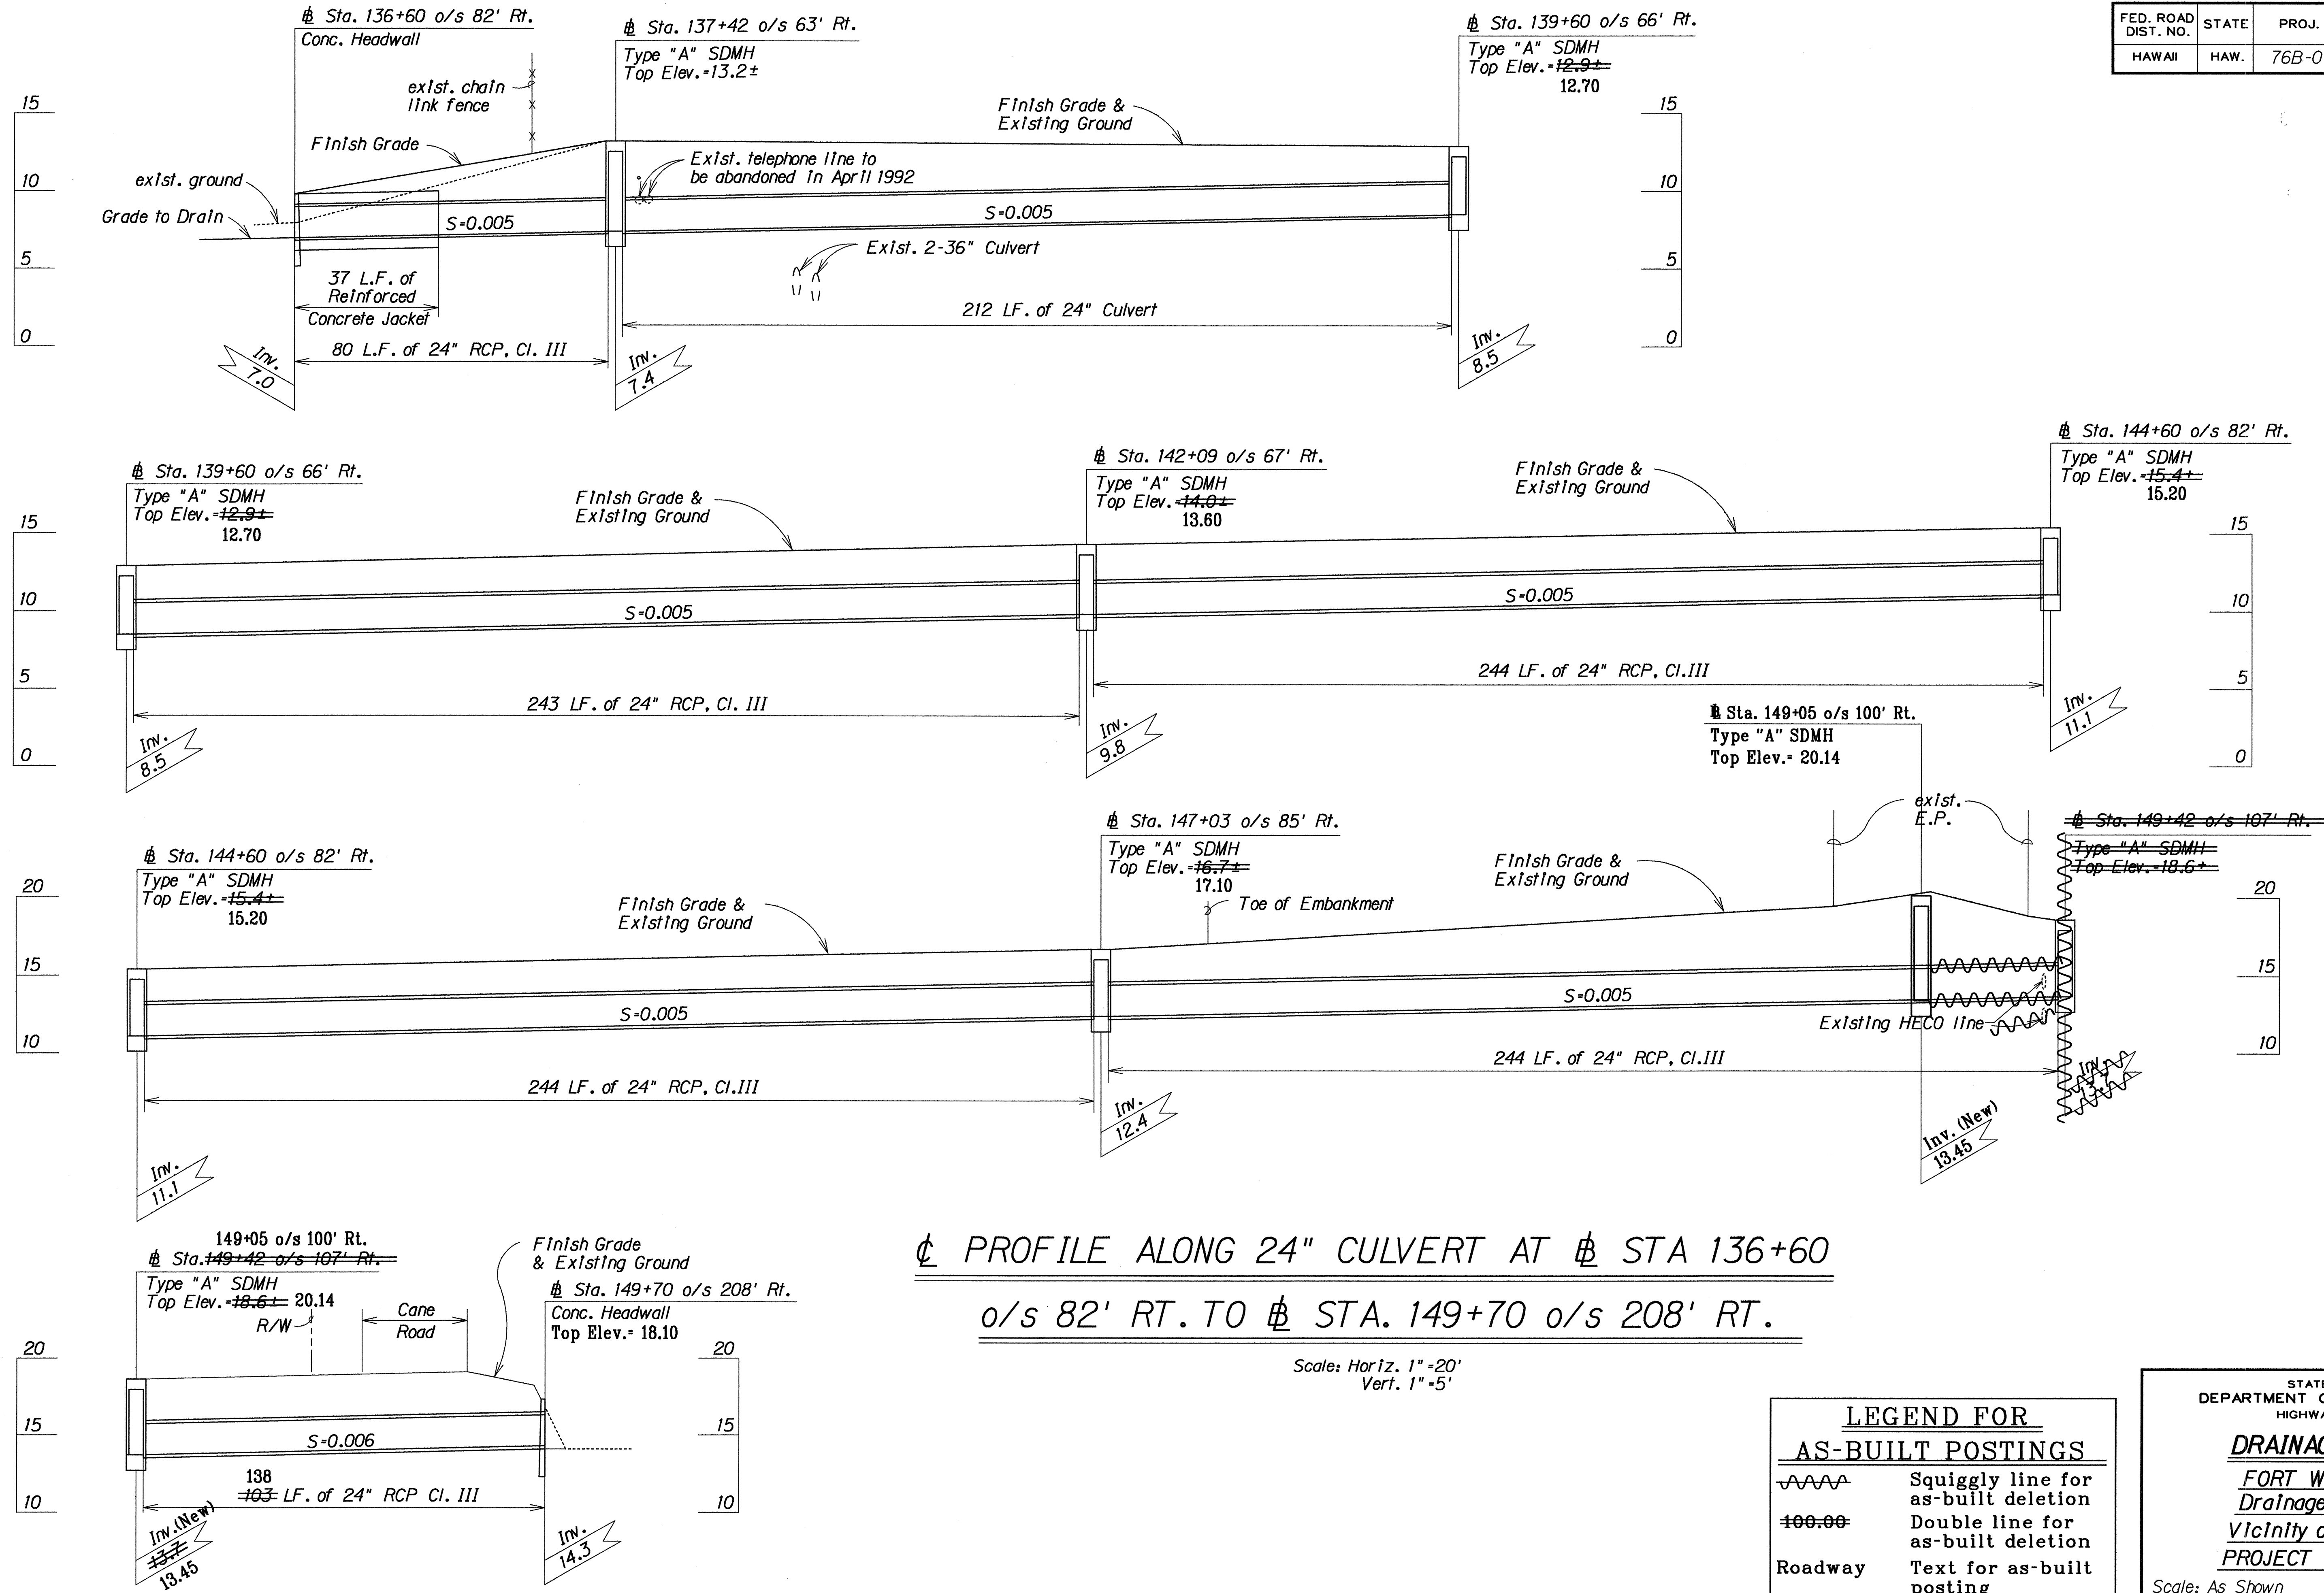

PROFILE ALONG 24" CULVERT AT STA 136+60
o/s 82' RT. TO STA. 149+70 o/s 208' RT.

Scale: Horiz. 1"=20'
Vert. 1"=5'

LEGEND FOR AS-BUILT POSTINGS	
	Squiggly line for as-built deletion
	Double line for as-built deletion
	Text for as-built posting

STATE OF HAWAII
DEPARTMENT OF TRANSPORTATION
HIGHWAYS DIVISION

DRAINAGE PROFILE
FORT WEAVER ROAD
Drainage Improvements
Vicinity of Kahua Ranch
PROJECT NO. 76B-01-91

Scale: As Shown Date: Sept., 1991
SHEET No. H2 OF 3 SHEETS