in the second	INDEX TO DRAWINGS
SHEET NO.	DESCRIPTION
	TITLE SHEET
2	STANDARD PLANS SUMMARY
3	DRAINAGE PLAN
4	DRAINAGE PROFILE
5	DRAINAGE DETAIL
1	
,	*
: : :	·
	N. C.
, , , , , , , , , , , , , , , , , , ,	,

*	
1	

STATE OF HAWAII


DEPARTMENT OF TRANSPORTATION
HIGHWAYS DIVISION
HONOLULU, HAWAII


"AS-BUILT"
PLANS FOR

FORT WEAVER ROAD DRAINAGE IMPROVEMENTS

VICINITY OF KAHUA RANCH PROJECT NO. 76B-01-91

DISTRICT OF EWA ISLAND OF OAHU

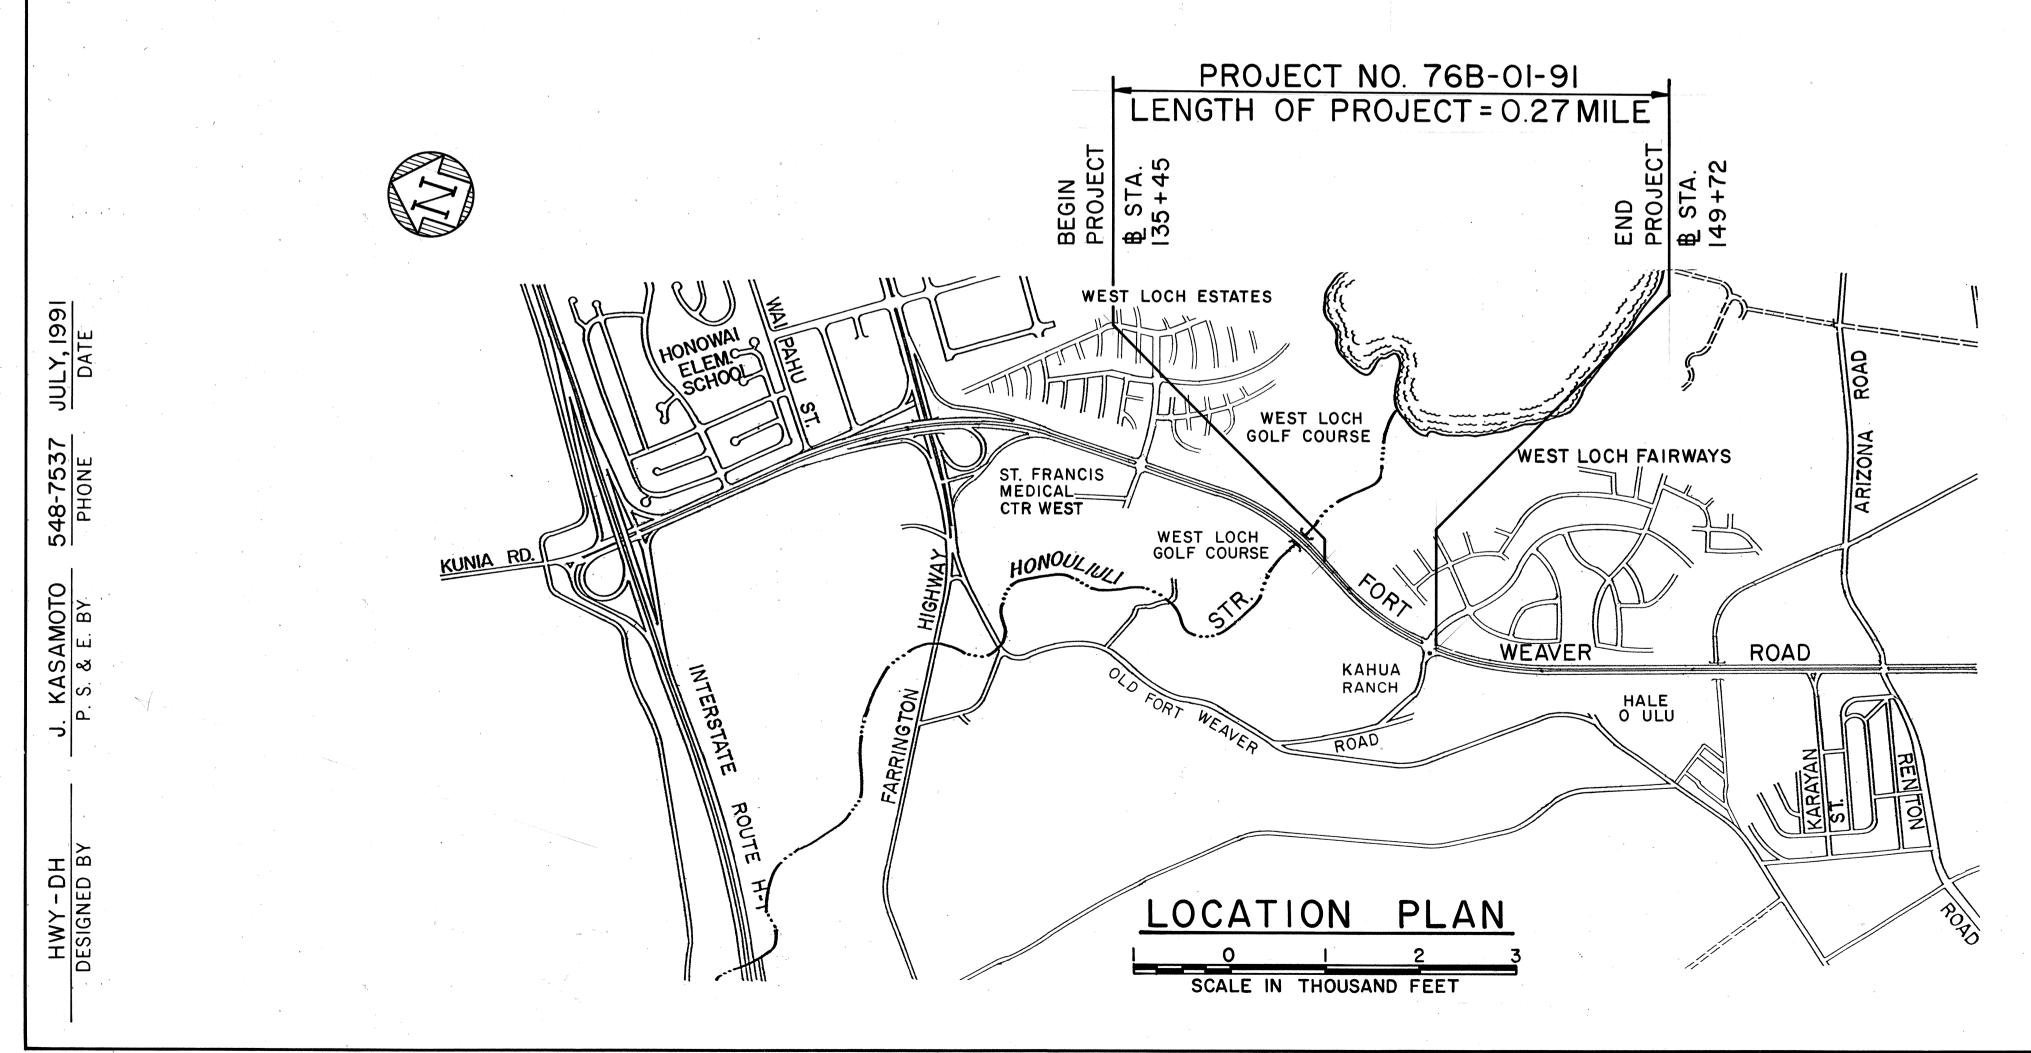

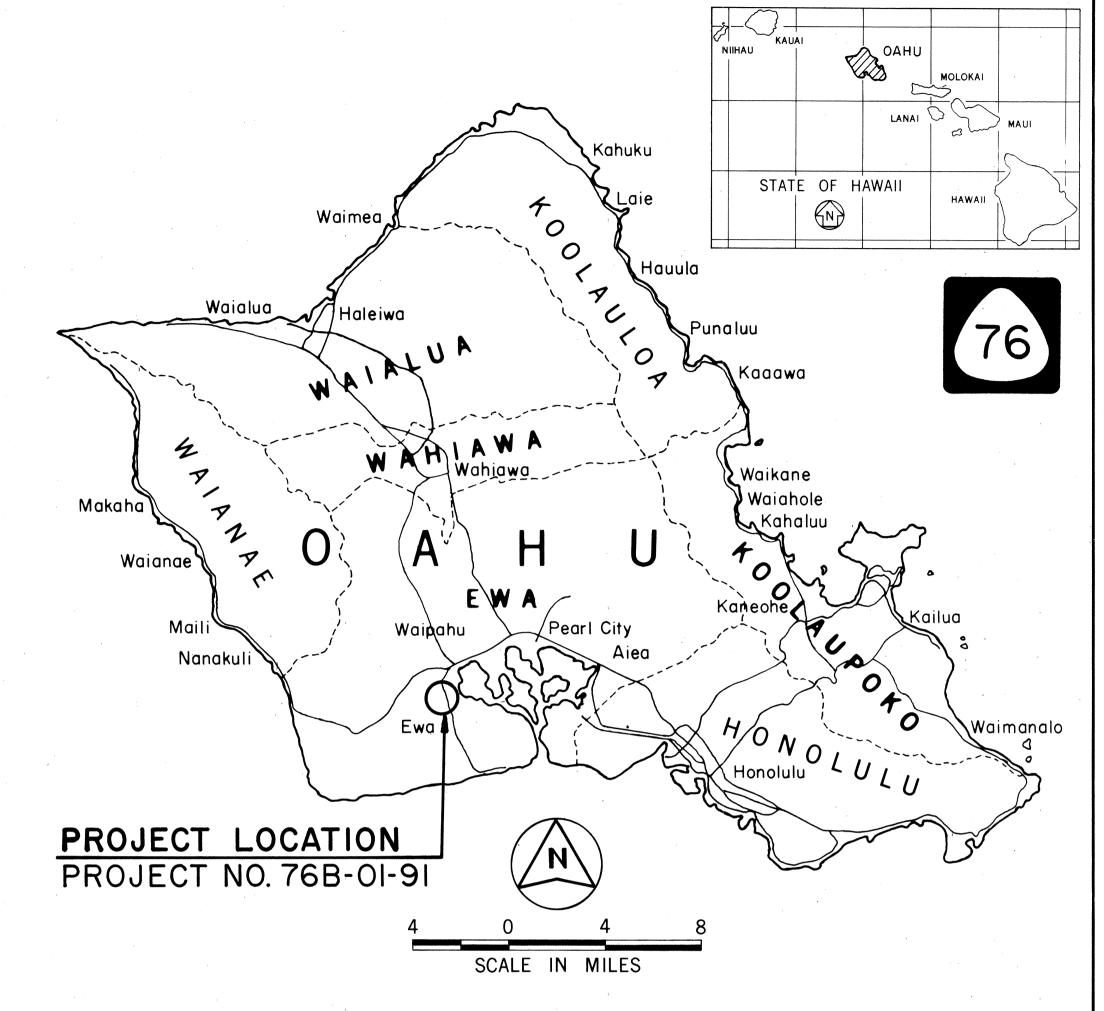

MILE POST 4.55 TO MILE POST 4.82

CHANGES MADE DURING CONSTRUCTION HAVE BEEN INCORPORATED ON THESE PLANS EXCEPT CHANGES IN THE ORIGINAL THEORETICAL QUANTITIES, FOR ACTUAL QUANTITIES, REFER TO PROJECT LEDGER AND/OR COMPUTATION BOOK.

RESIDENT ENGINEER

1/20/94 DATE

FISCAL SHEET TOTAL YEAR NO. SHEETS

PROJ. NO.

76B-01-91

DEPARTMENT OF TRANSPORTATION
STATE OF HAWAII

APPROVED:

3/23/92
DIR. OF TRANSPORTATION

DATE

0-8-0-