


FED. ROAD DIST. NO.	STATE	FED. AID PROJ. NO.	FISCAL YEAR	SHEET NO.	TOTAL SHEETS
HAWAII	HAW.	STP-076-1(3)	1993	8	34

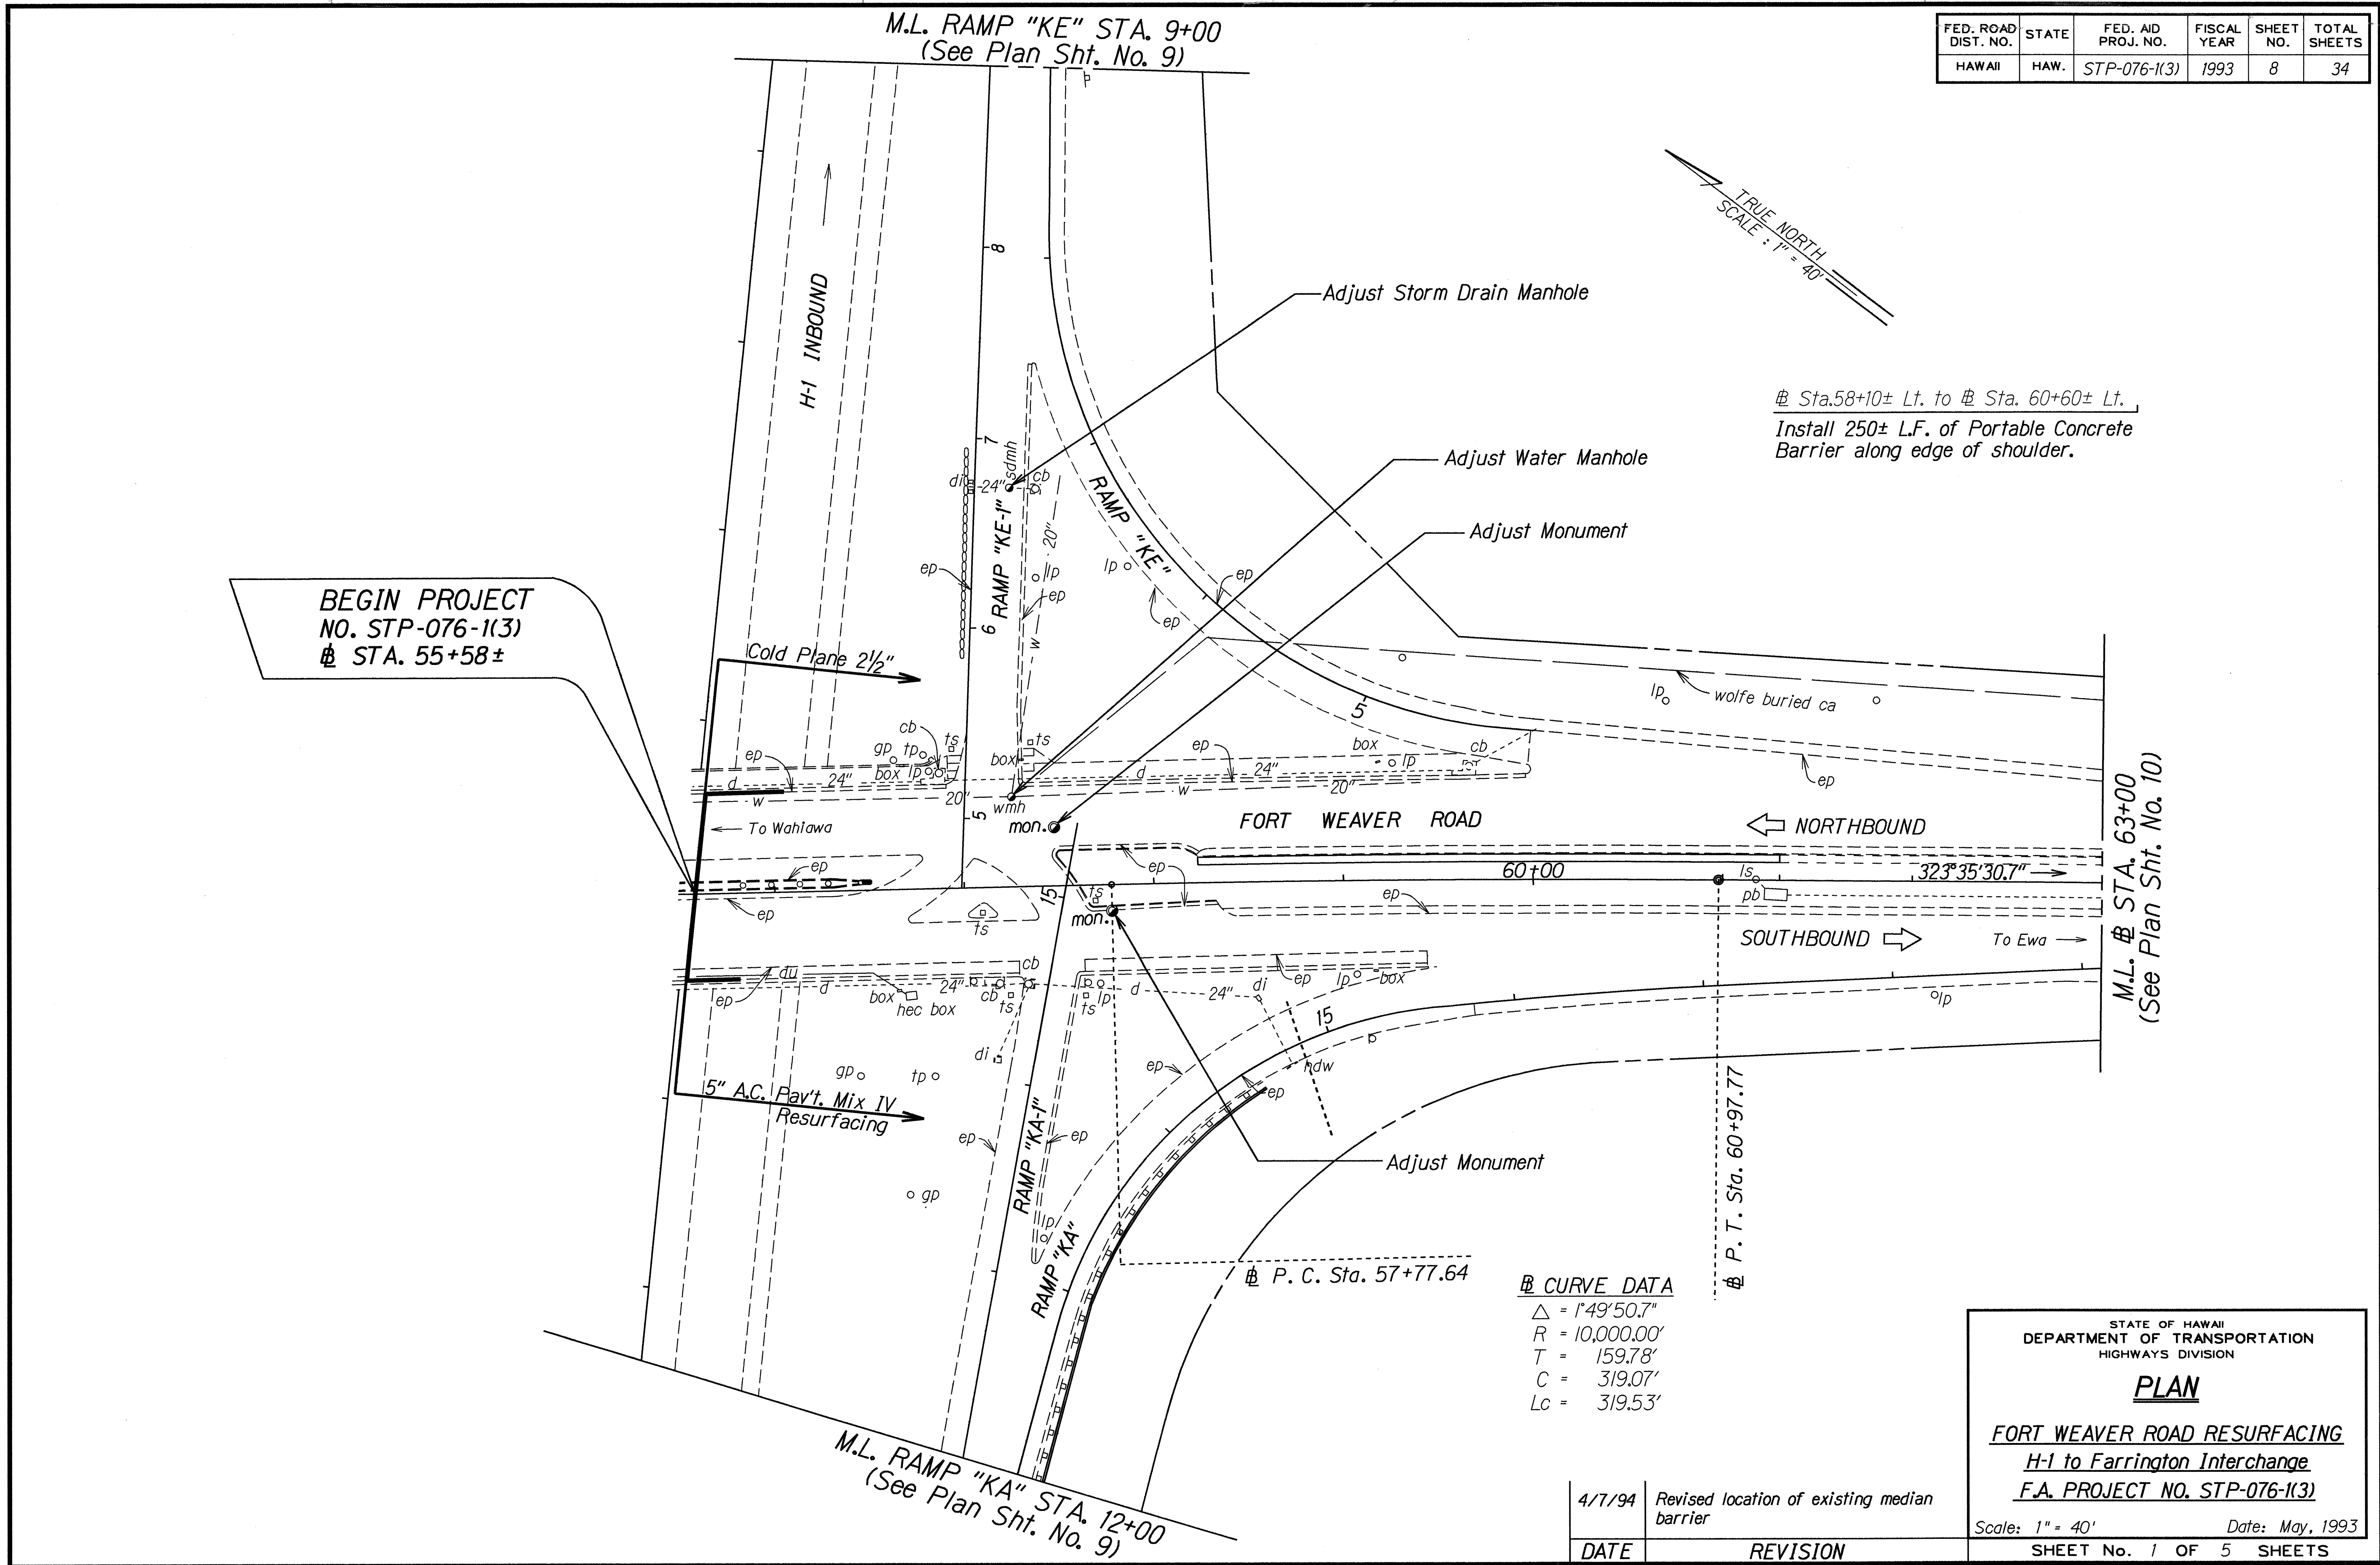

DESIGNED BY	DATE
DRAWN BY	4-7-94
CHECKED BY	
IN CHARGE	
APPROVED BY	
DATE	

4/7/94	Revised location of existing median barrier
DATE	REVISION


STATE OF HAWAII
DEPARTMENT OF TRANSPORTATION
HIGHWAYS DIVISION

PLAN
FORT WEAVER ROAD RESURFACING
H-1 to Farrington Interchange
F.A. PROJECT NO. STP-076-1(3)

Scale: 1" = 40'
Date: May, 1993

SHEET No. 1 OF 5 SHEETS

FED. ROAD DIST. NO.	STATE	FED. AID PROJ. NO.	FISCAL YEAR	SHEET NO.	TOTAL SHEETS
HAWAII	HAW.	STP-076-1(3)	1993	9	34

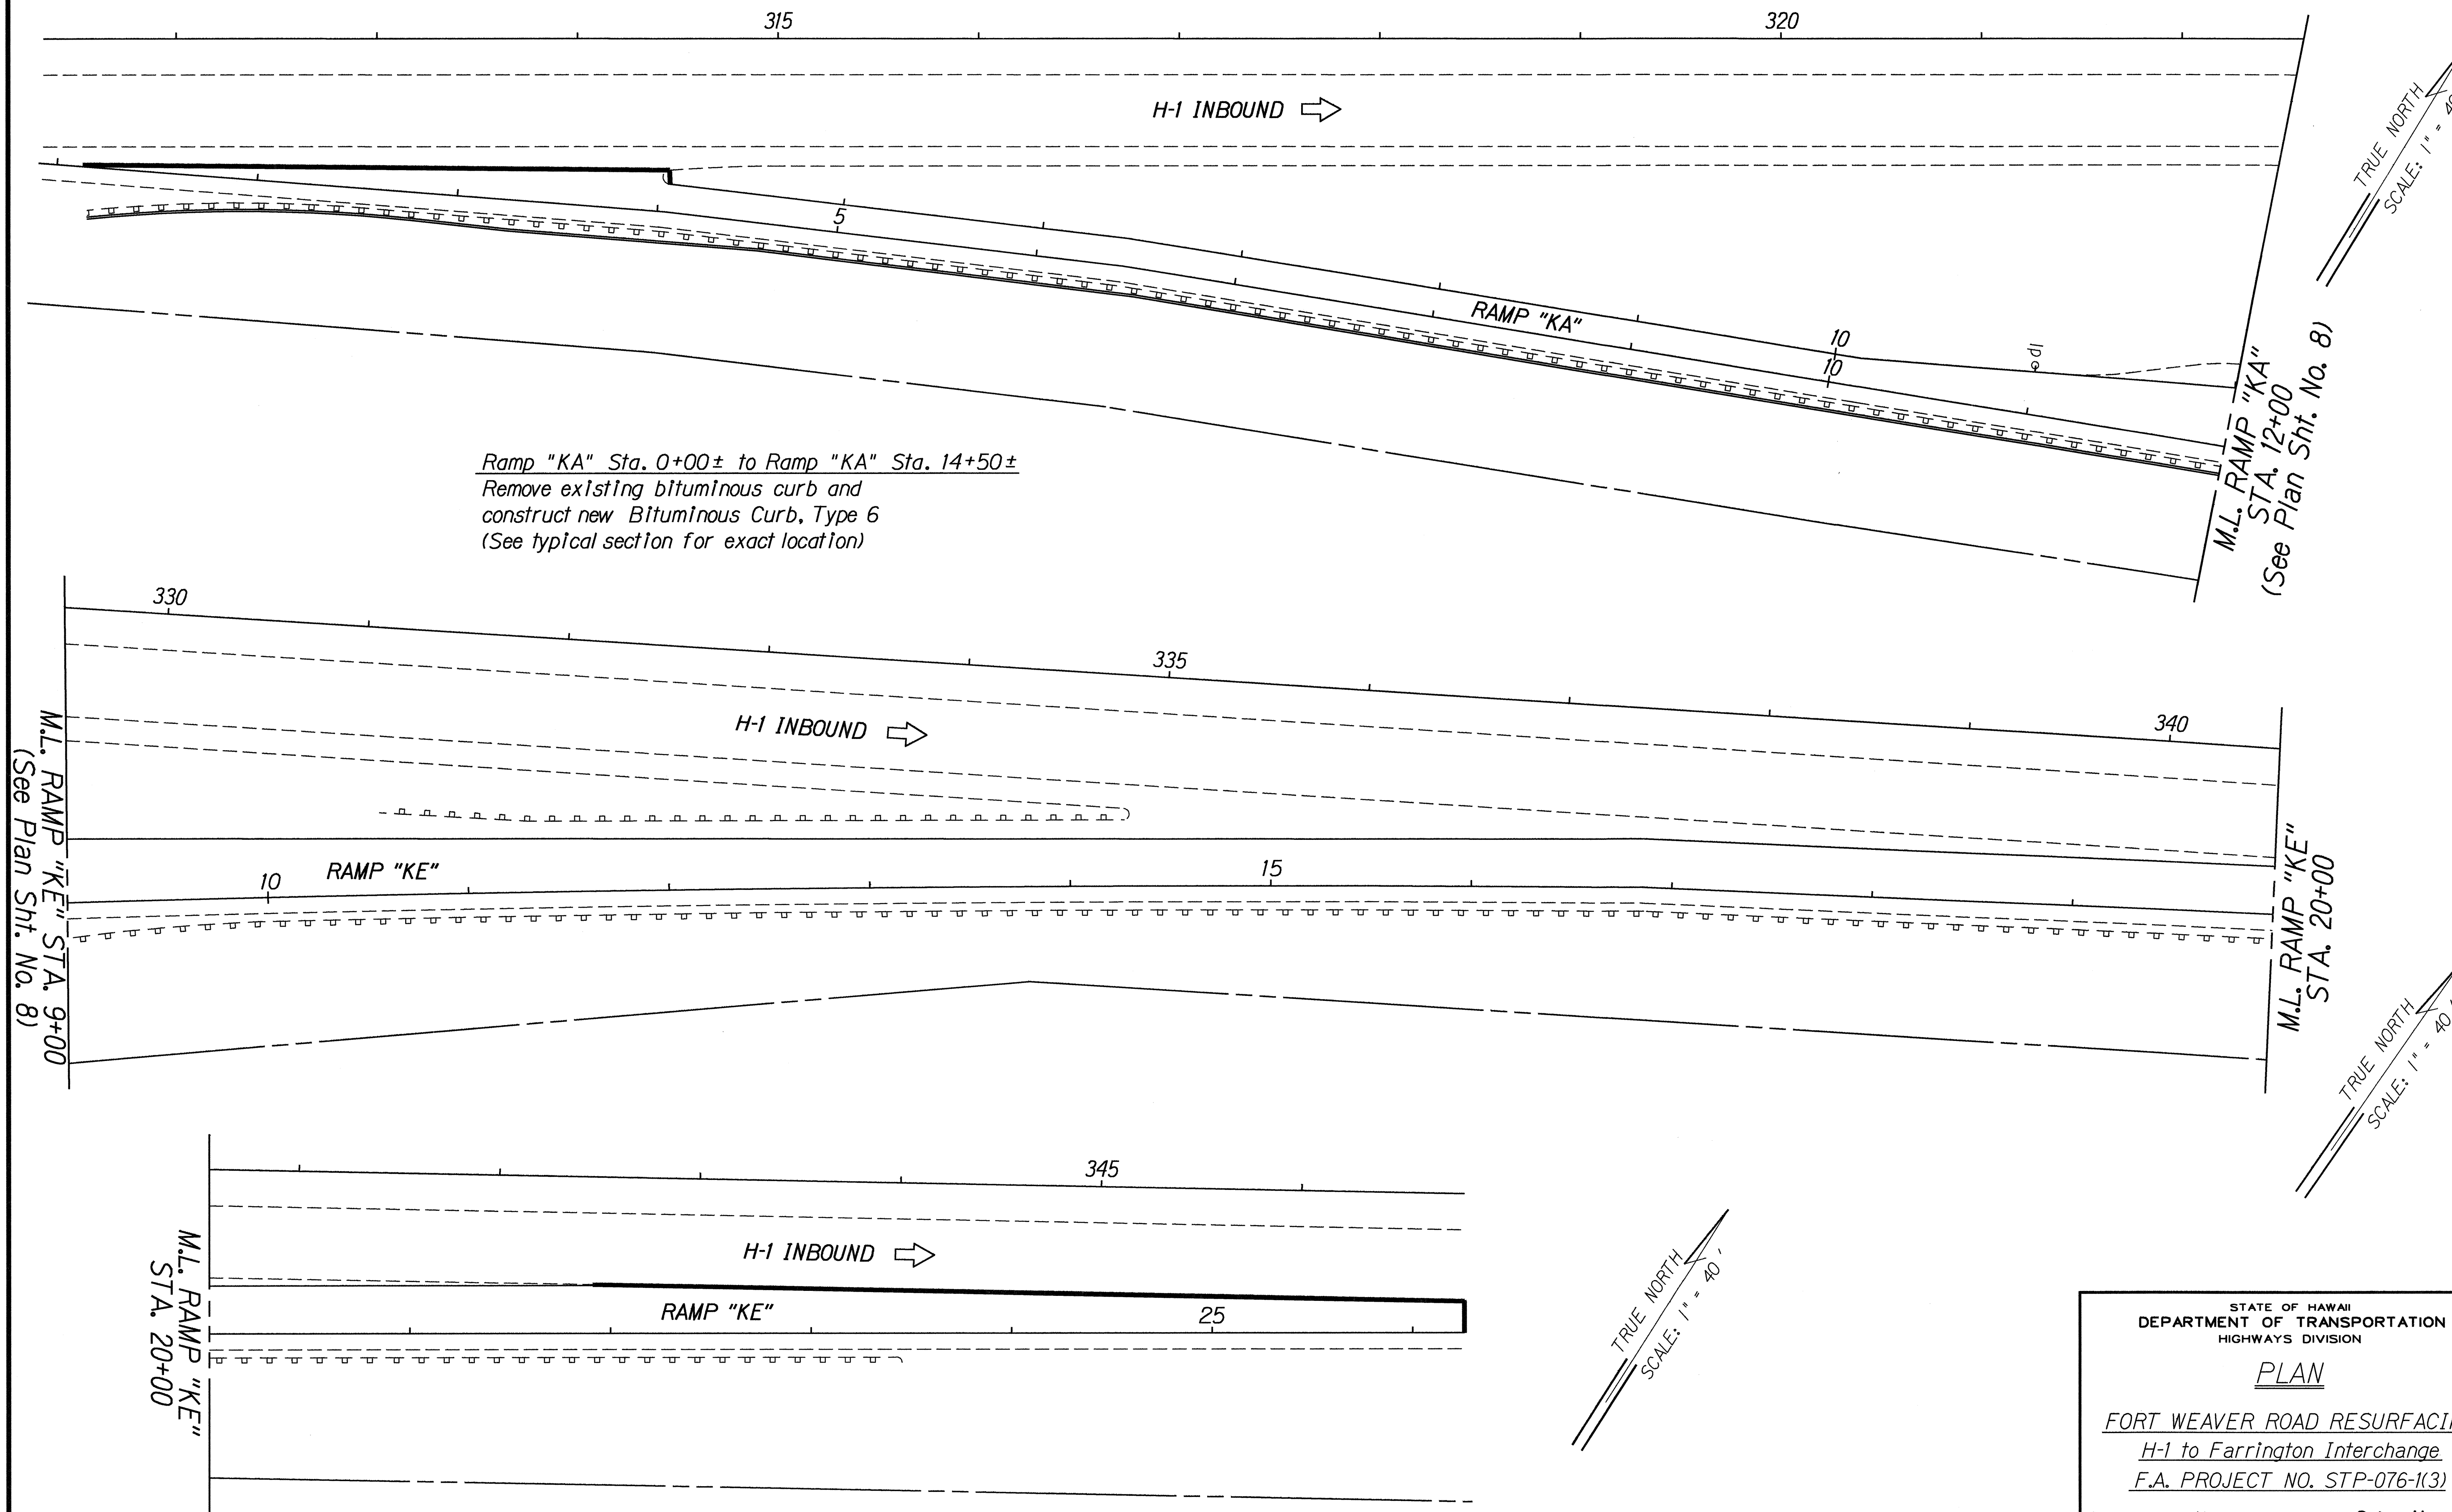

ORIGINAL	DATE
PLANNED	5/1/93
DESIGNED BY	
TRACED BY	
NOTED BY	
CHECKED BY	
DATE	

STATE OF HAWAII
DEPARTMENT OF TRANSPORTATION
HIGHWAYS DIVISION


PLAN

FORT WEAVER ROAD RESURFACING
H-1 to Farrington Interchange
F.A. PROJECT NO. STP-076-1(3)

Scale: 1" = 40' Date: May, 1993

SHEET No. 2 OF 7 SHEETS

FED. ROAD DIST. NO.	STATE	FED. AID PROJ. NO.	FISCAL YEAR	SHEET NO.	TOTAL SHEETS
HAWAII	HAW.	STP-076-1(3)	1993	10	34

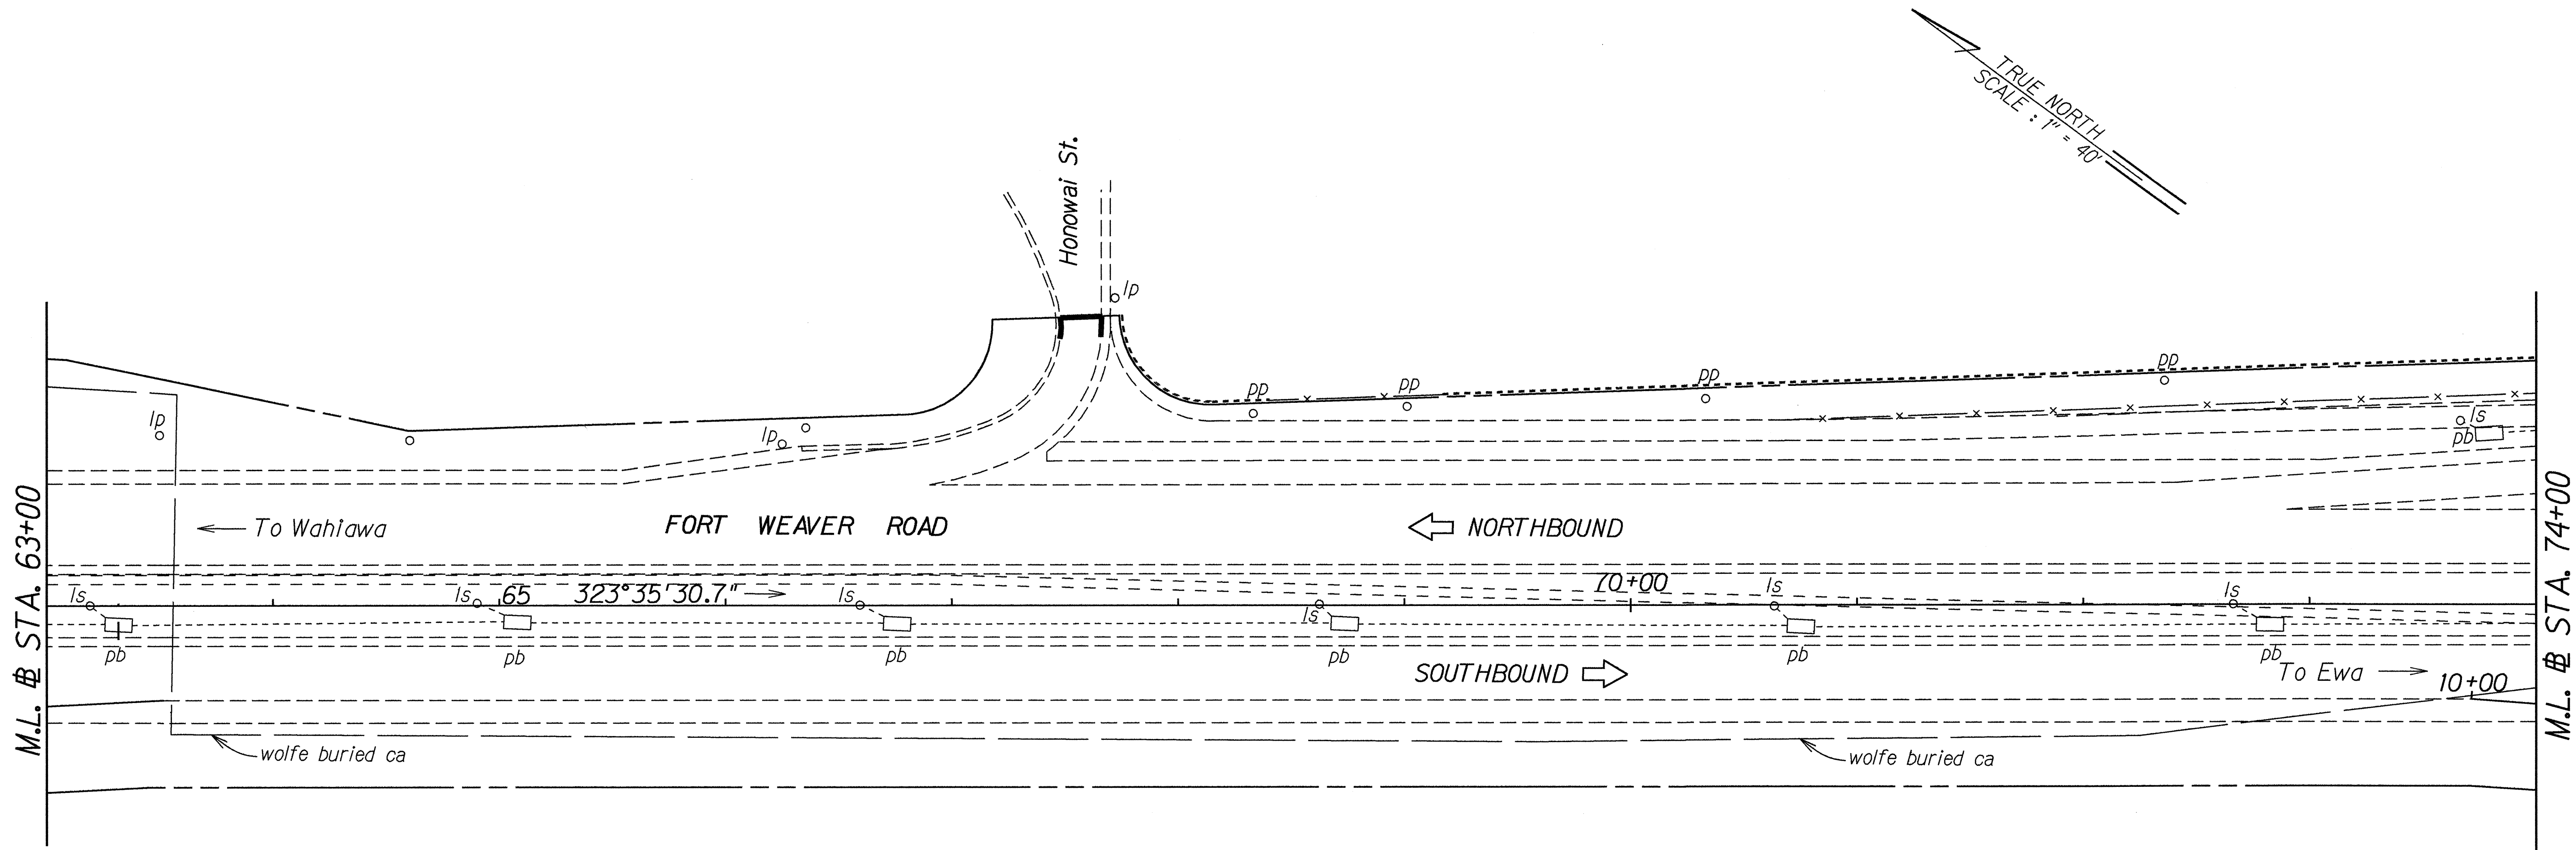

ORIGINAL PLAN	SURVEY PLOTTED BY	DATE 4/7/94
NOTE BOOK	DESIGNED BY	
QUANTITIES BY	CHECKED BY	
2/2/94		


4/7/94	Revised location of existing median barrier	Scale: 1" = 40'	Date: May, 1993
DATE	REVISION	SHEET No. 3 OF 7 SHEETS	

STATE OF HAWAII
DEPARTMENT OF TRANSPORTATION
HIGHWAYS DIVISION

PLAN

FORT WEAVER ROAD RESURFACING
H-1 to Farrington Interchange
F.A. PROJECT NO. STP-076-1(3)

FED. ROAD DIST. NO.	STATE	FED. AID PROJ. NO.	FISCAL YEAR	SHEET NO.	TOTAL SHEETS
HAWAII	HAW.	STP-076-1(3)	1993	11	34

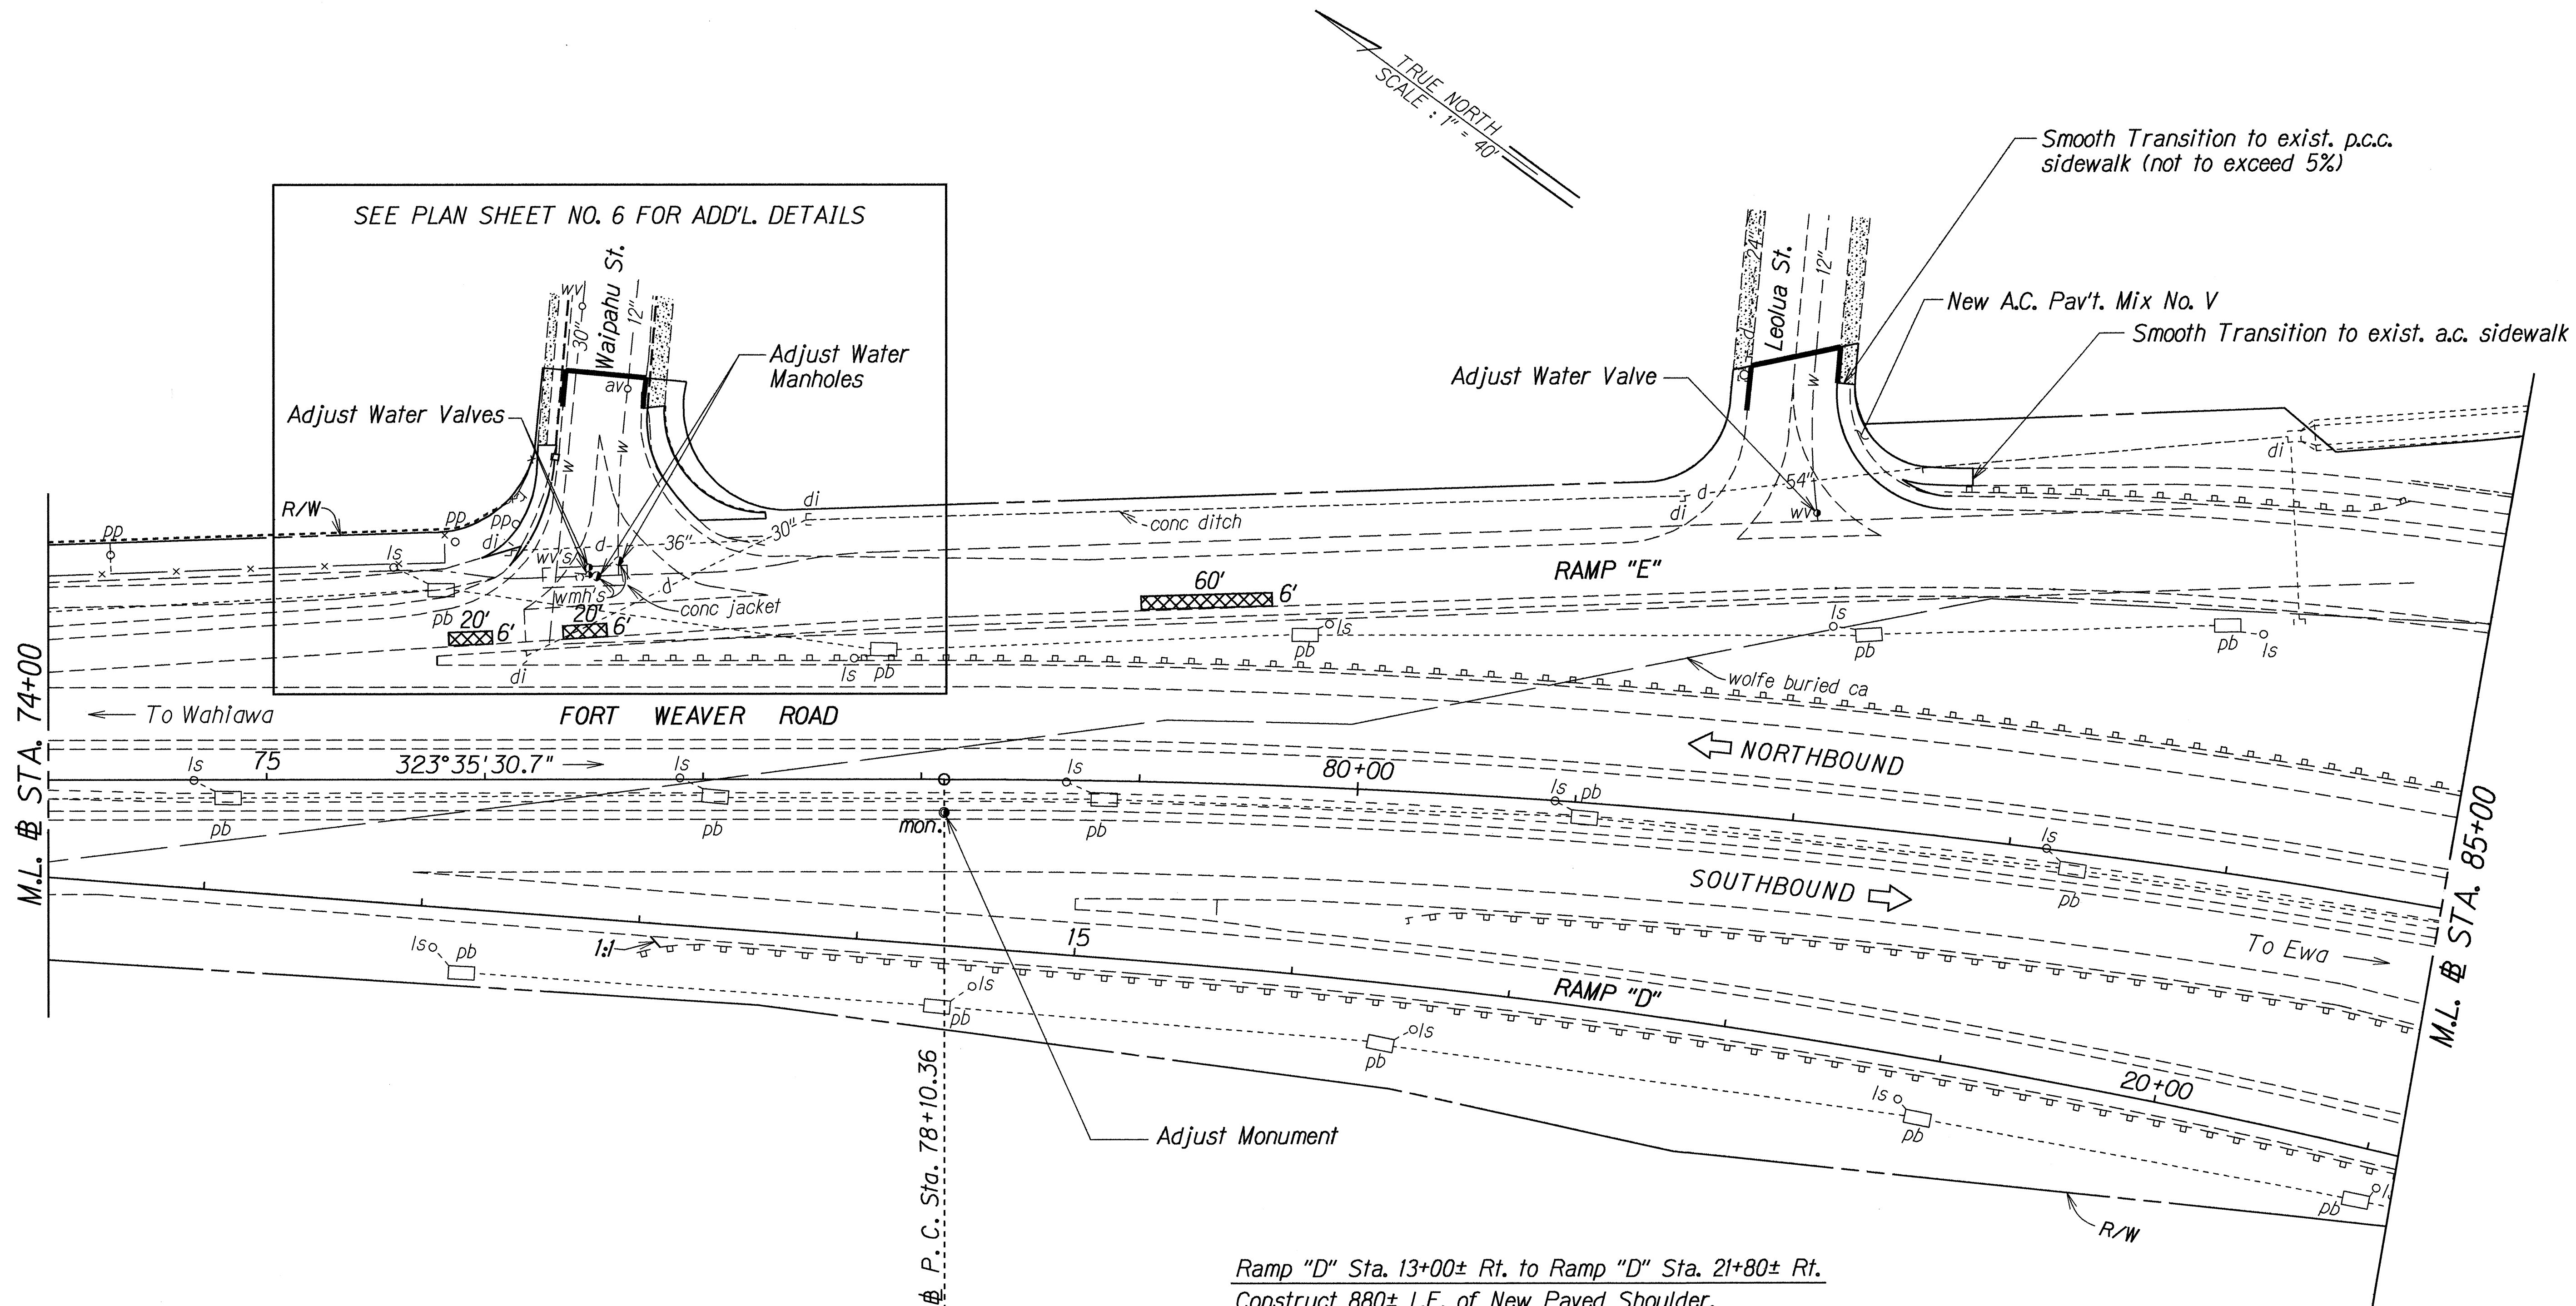

DESIGNED BY	DATE
DRAWN BY	11/1/94
CHECKED BY	
NOTED BY	
QUANTITIES BY	
CHECKED BY	

Ramp "D" Sta. 13+00± Rt. to Ramp "D" Sta. 21+80± Rt.
Construct 880± L.F. of New Paved Shoulder.
See Pav't Detail on Plan Sht. No. ADD. 5


4/7/94	Revised location of existing median barrier.
6/16/93	Added New Paved Shoulder w/Construction Notes
DATE	REVISION

STATE OF HAWAII DEPARTMENT OF TRANSPORTATION HIGHWAYS DIVISION	
PLAN	
FORT WEAVER ROAD RESURFACING	
H-1 to Farrington Interchange	
F.A. PROJECT NO. STP-076-1(3)	
Scale: 1" = 40'	Date: May, 1993
SHEET No. 4 OF 7 SHEETS	


ADD. 11R

FED. ROAD DIST. NO.	STATE	FED. AID PROJ. NO.	FISCAL YEAR	SHEET NO.	TOTAL SHEETS
HAWAII	HAW.	STP-076-1(3)	1993	12	34

Ramp "A" Sta. 16+75± Rt. to Ramp "A" Sta. 18+00± Rt.
Construct 125± L.F. of New Paved Shldr.
See Pav't Detail on Plan Sht. No. ADD. 5

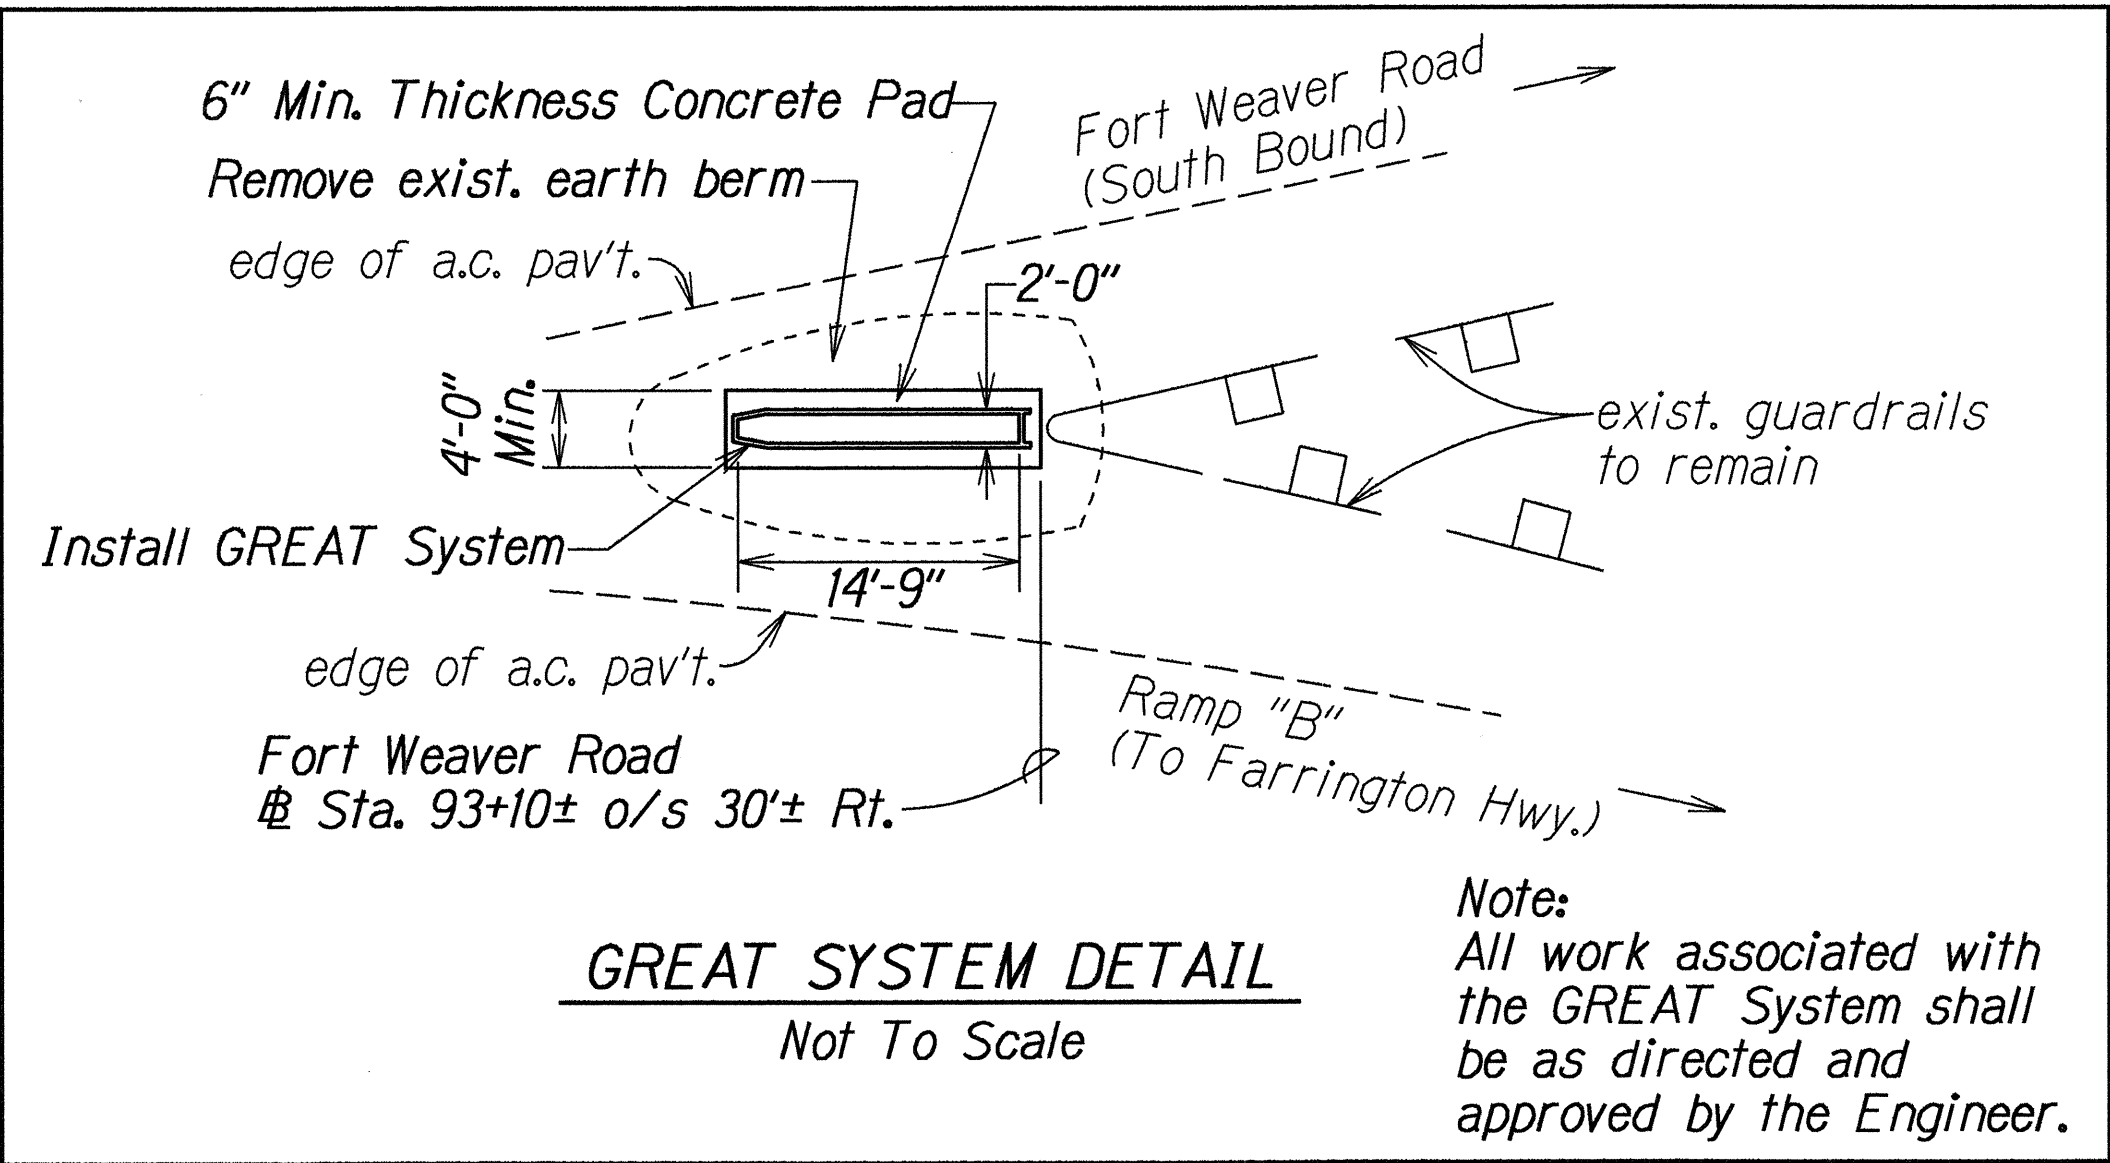

Ramp "A" Sta. 13+50± Rt. to Ramp "A" Sta. 18+00± Rt.
Install 420± L.F. of Guardrail, Type 3-Single w/Steel Post

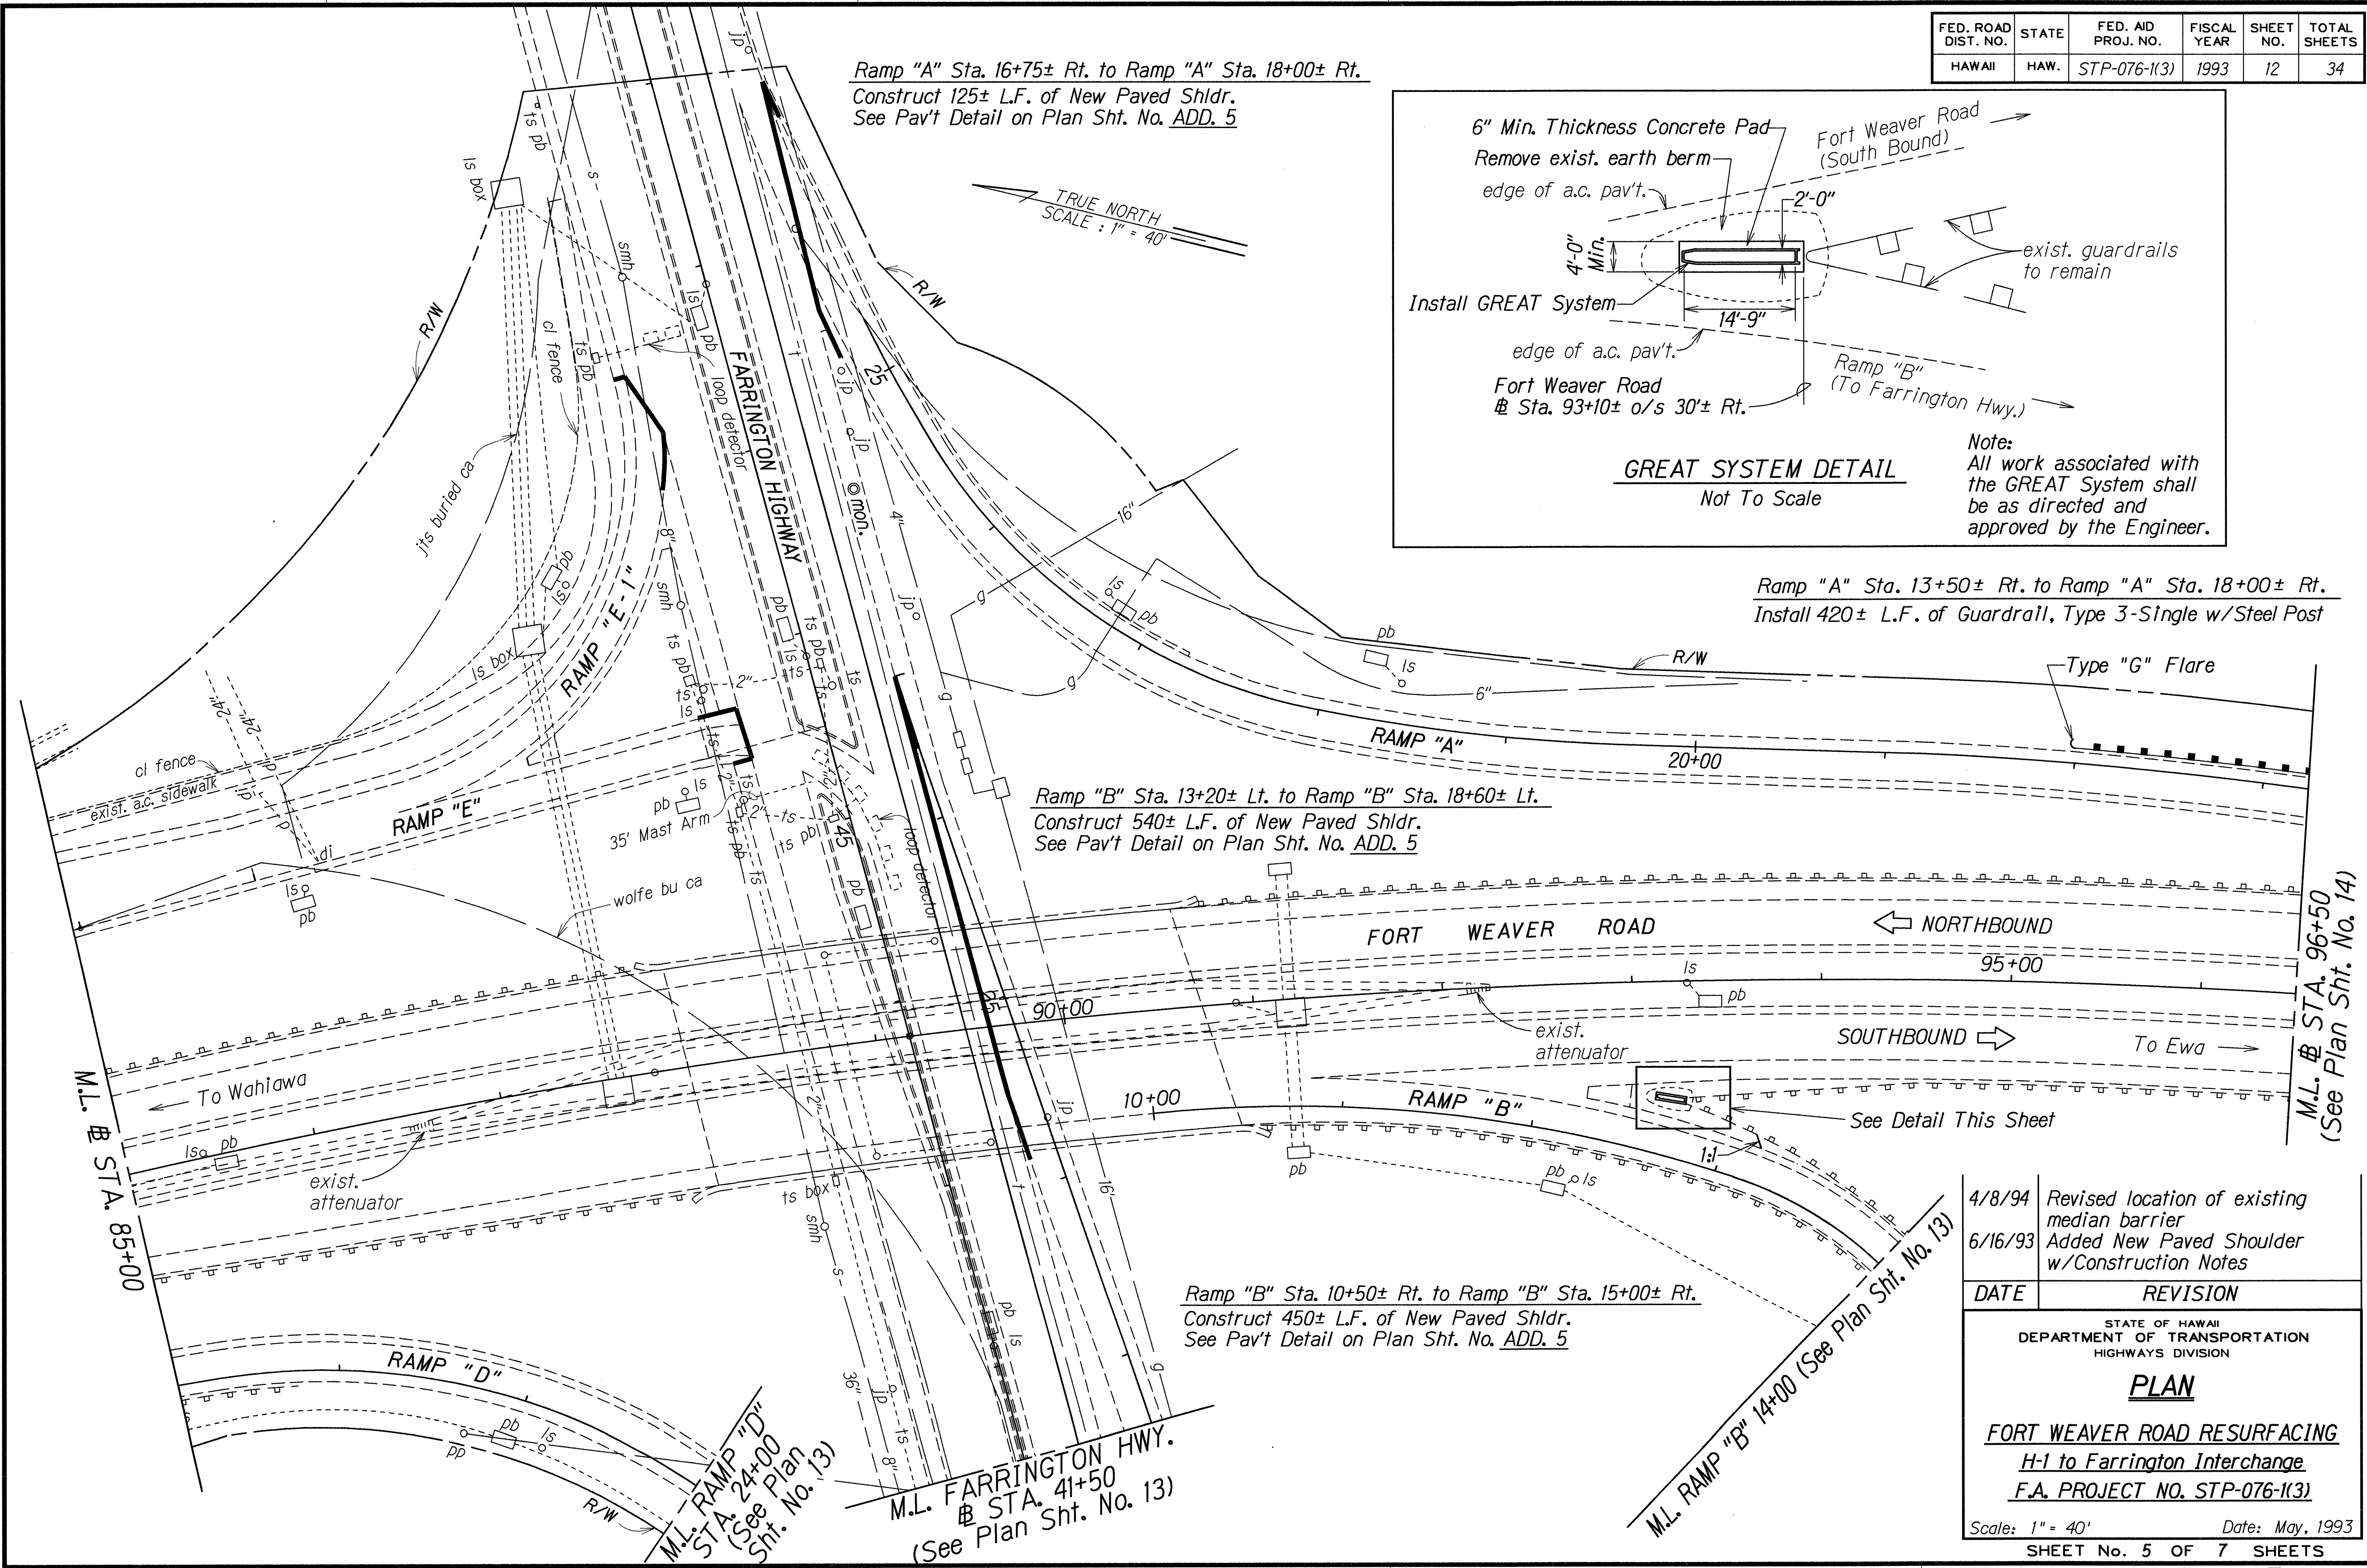

DESIGNED BY	DATE
DRAWN BY	4/8/94
CHECKED BY	
NOTED BY	
QUANTITIES BY	
REVISIONS	

4/8/94	Revised location of existing median barrier
6/16/93	Added New Paved Shoulder w/Construction Notes

DATE	REVISION
STATE OF HAWAII DEPARTMENT OF TRANSPORTATION HIGHWAYS DIVISION	
PLAN	
FORT WEAVER ROAD RESURFACING	
H-1 to Farrington Interchange	
F.A. PROJECT NO. STP-076-1(3)	
Scale: 1" = 40'	Date: May, 1993

SHEET No. 5 OF 7 SHEETS

ADD. 12R


FED. ROAD DIST. NO.	STATE	FED. AID PROJ. NO.	FISCAL YEAR	SHEET NO.	TOTAL SHEETS
HAWAII	HAW.	STP-076-1(3)	1993	13	34

(See Plan Sht. No. 12)
M.L. RAMP "D" STA. 24+00

(See Plan Sht. No. 12)
M.L. FARRINGTON HWY.
B STA. 41+50

(See Plan Sht. No. 12)
M.L. RAMP "B" STA. 14+00

M.L. RAMP "C"
STA. 19+00
(See Plan
Sht. No. 14)

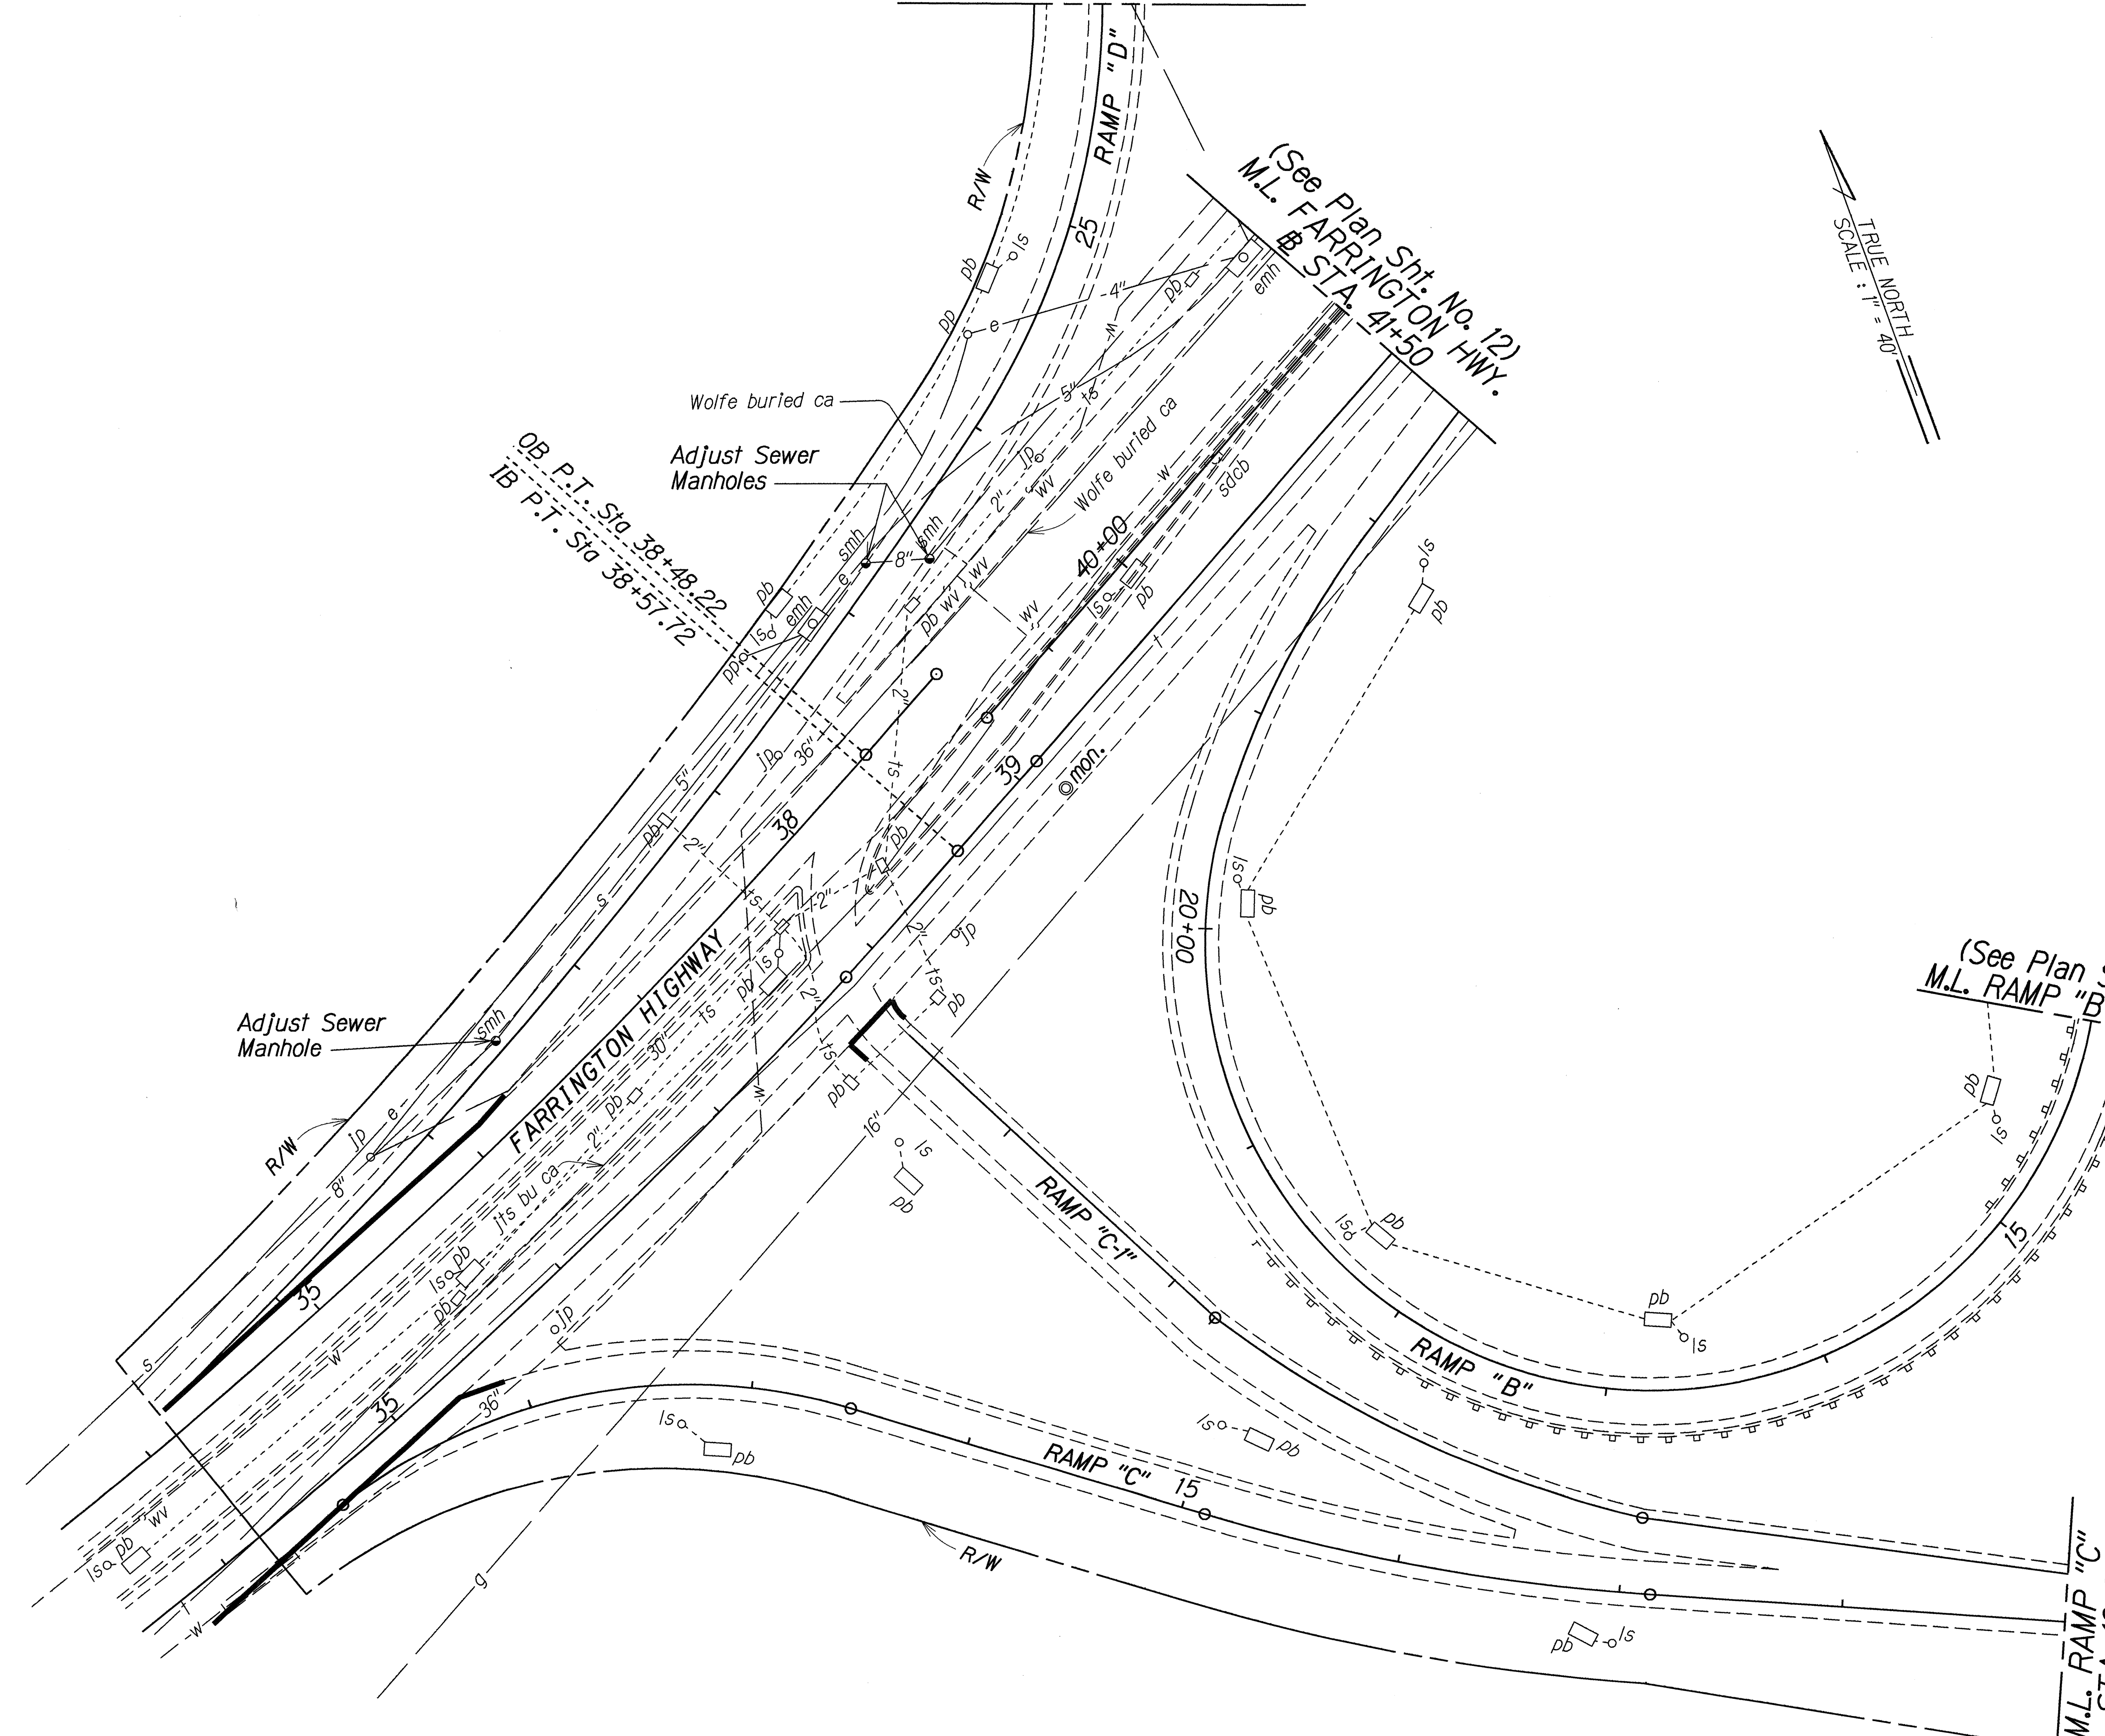

TRUE NORTH
SCALE: 1" = 40'

DESIGNED BY	DATE
DRAWN BY	5/2/93
CHECKED BY	
NOTED BY	
QUANTITIES BY	
REVISIONS	

STATE OF HAWAII
DEPARTMENT OF TRANSPORTATION
HIGHWAYS DIVISION


PLAN

FORT WEAVER ROAD RESURFACING
H-1 to Farrington Interchange
F.A. PROJECT NO. STP-076-1(3)

Scale: 1" = 40'
SHEET No. 6 OF 7 SHEETS

Date: May, 1993

FED. ROAD DIST. NO.	STATE	FED. AID PROJ. NO.	FISCAL YEAR	SHEET NO.	TOTAL SHEETS
HAWAII	HAW.	STP-076-1(3)	1993	14	34

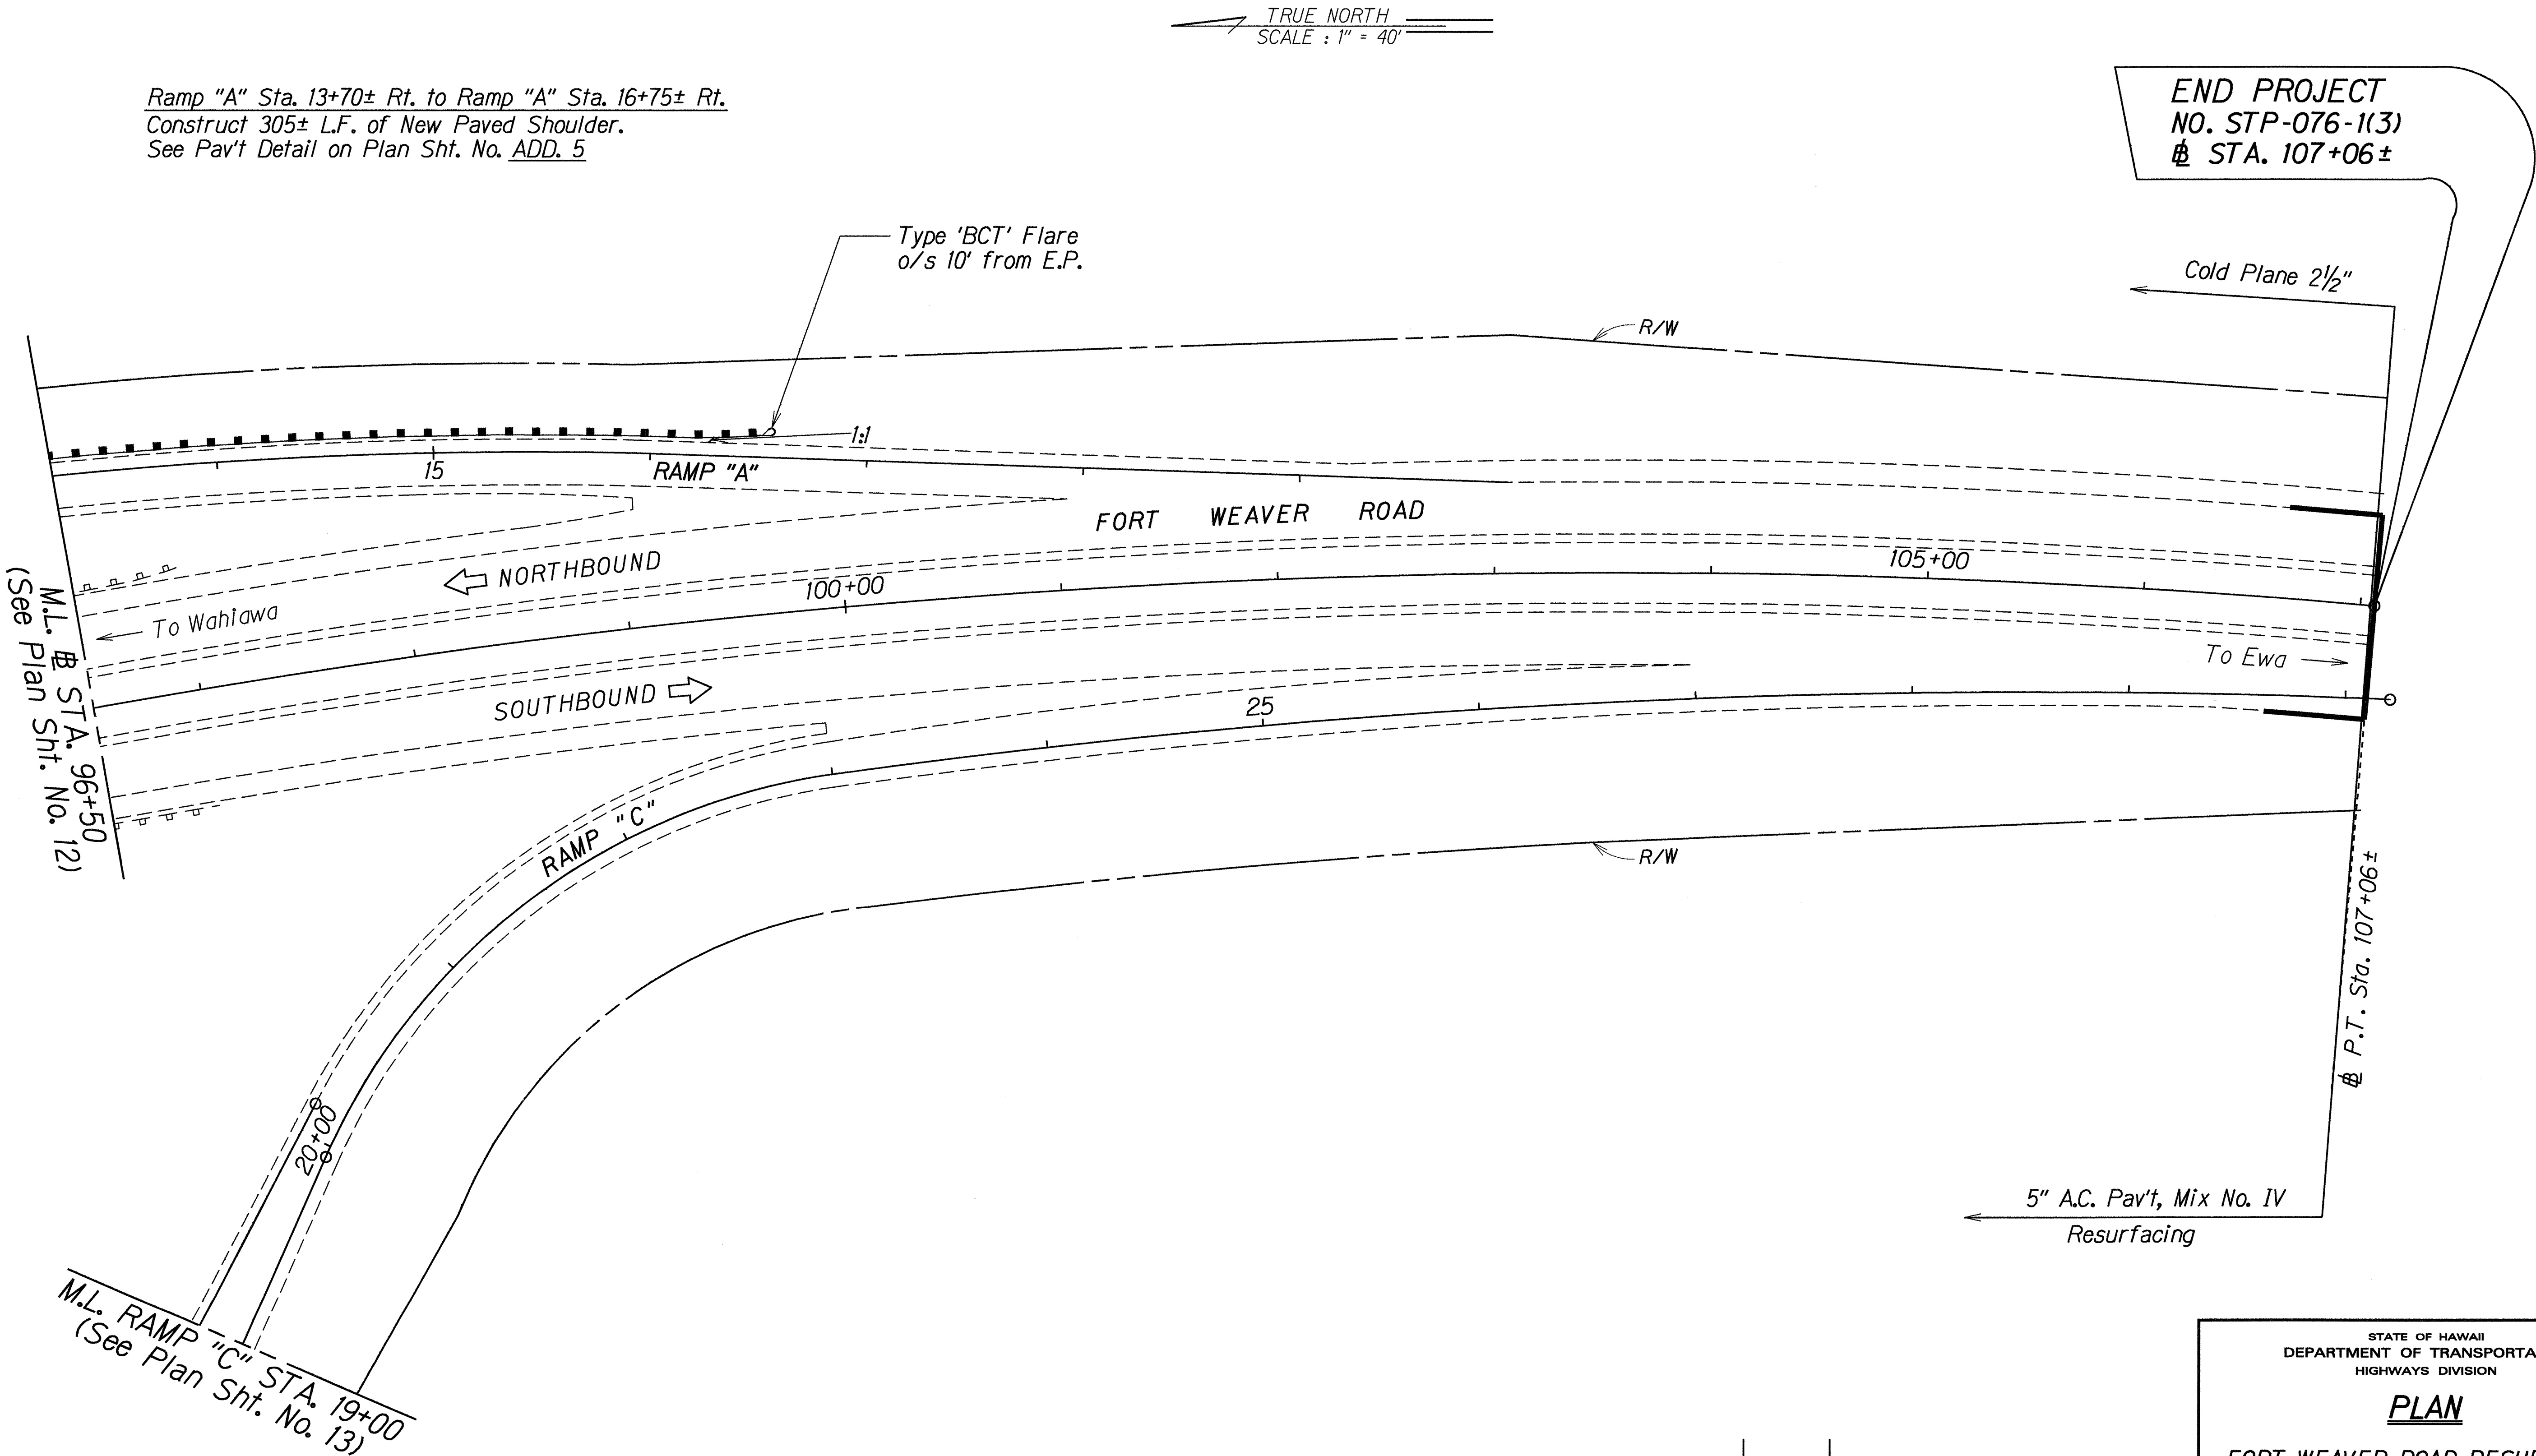

DATE	4/8/94
DESIGNED BY	NOTED
DRAWN BY	NOTED
CHECKED BY	NOTED
APPROVED BY	NOTED

4/8/94	Removed existing median barrier this sheet
6/16/93	Added New Paved Shoulder w/Construction Notes
DATE	REVISION

STATE OF HAWAII
DEPARTMENT OF TRANSPORTATION
HIGHWAYS DIVISION

PLAN

FORT WEAVER ROAD RESURFACING
H-1 to Farrington Interchange
F.A. PROJECT NO. STP-076-1(3)
Scale: 1" = 40' Date: May, 1993

SHEET No. 7 OF 7 SHEETS