

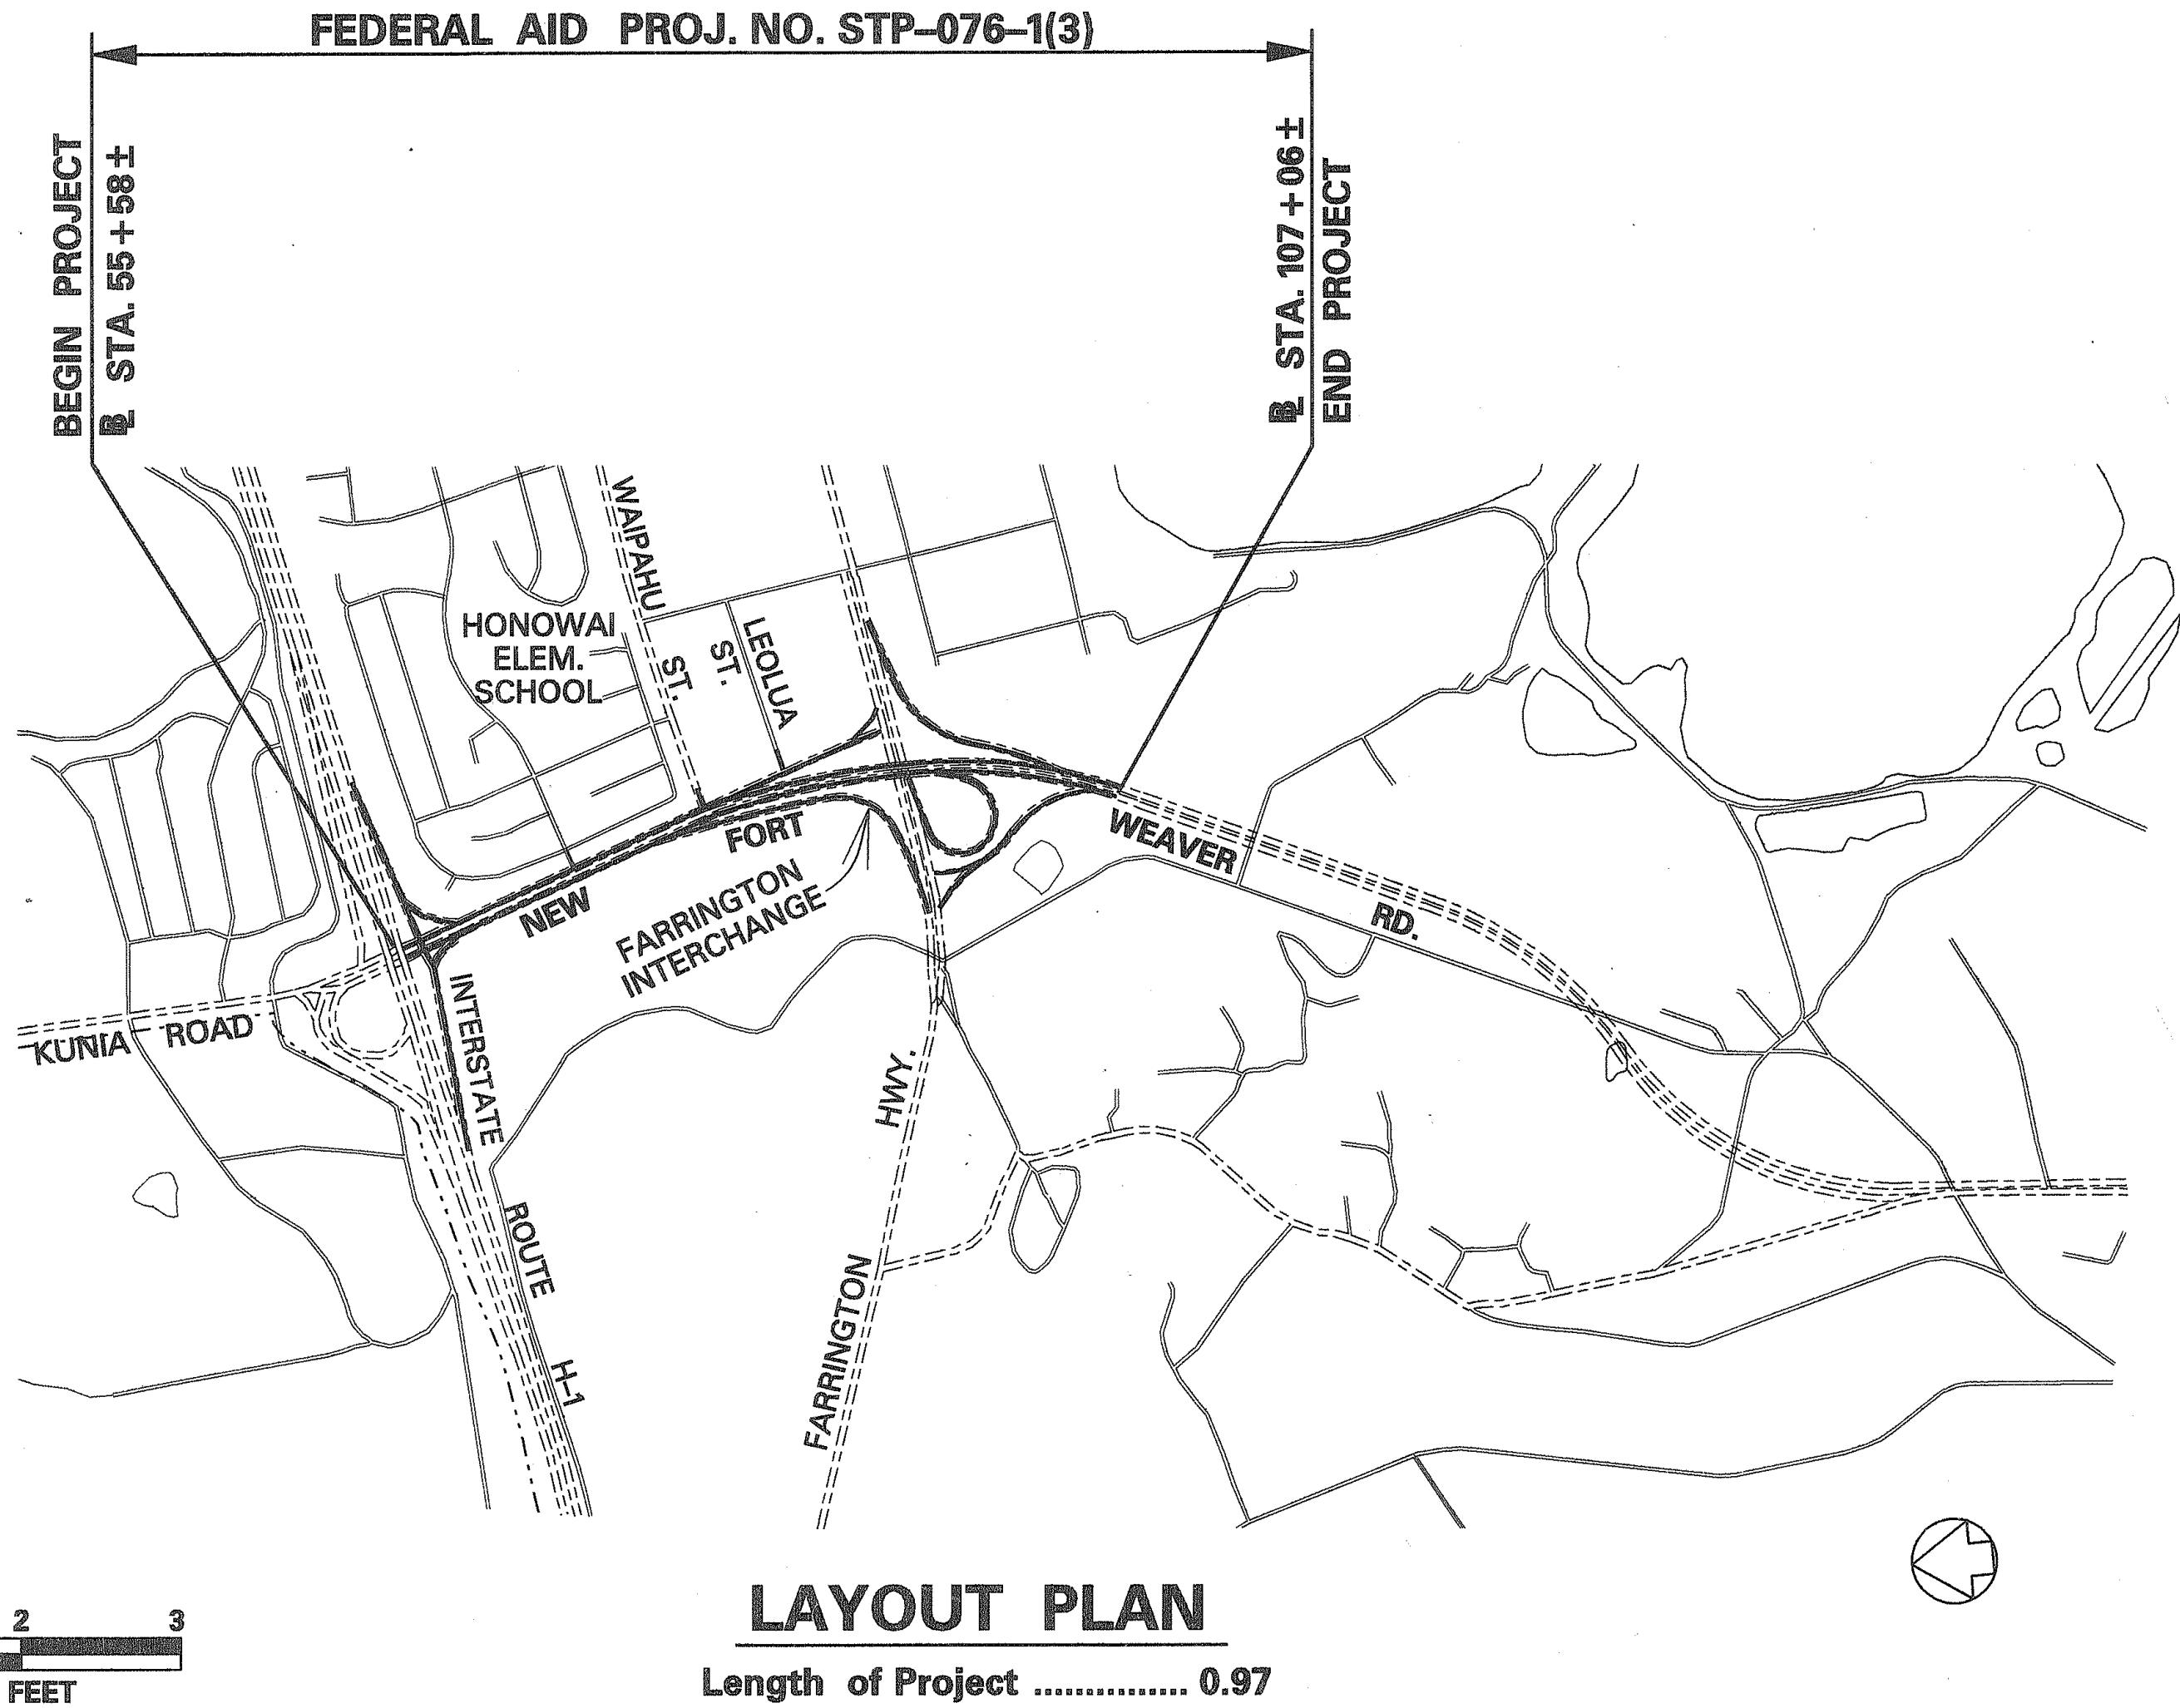


INDEX TO DRAWINGS	
SHEET NO.	DESCRIPTION
1	TITLE SHEET
2	STANDARD PLANS SUMMARY
3	GENERAL NOTES AND LEGEND
4-5	TYPICAL SECTIONS
6	MISCELLANEOUS DETAILS
7	WAIPAHU STREET DETAIL PLAN
8-14	PLANS
15-19	DRAINAGE PLAN AND DETAILS
20	TRAFFIC LEGEND AND DETAILS
21	TRAFFIC NOTES
22-28	PAVEMENT MARKING & SIGNING PLANS
29-30	SIGN DETAILS
31	FRAME LAYOUT
32	LOOP DETECTOR DETAILS
33-34	TRAFFIC SUMMARIES

STATE OF HAWAII
DEPARTMENT OF TRANSPORTATION
HIGHWAYS DIVISION
HONOLULU, HAWAII
"AS-BUILT"
PLANS FOR
FORT WEAVER ROAD RESURFACING
H-1 TO FARRINGTON INTERCHANGE
FEDERAL AID PROJECT NO. STP-076-1(3)
DISTRICT OF EWA
ISLAND OF OAHU

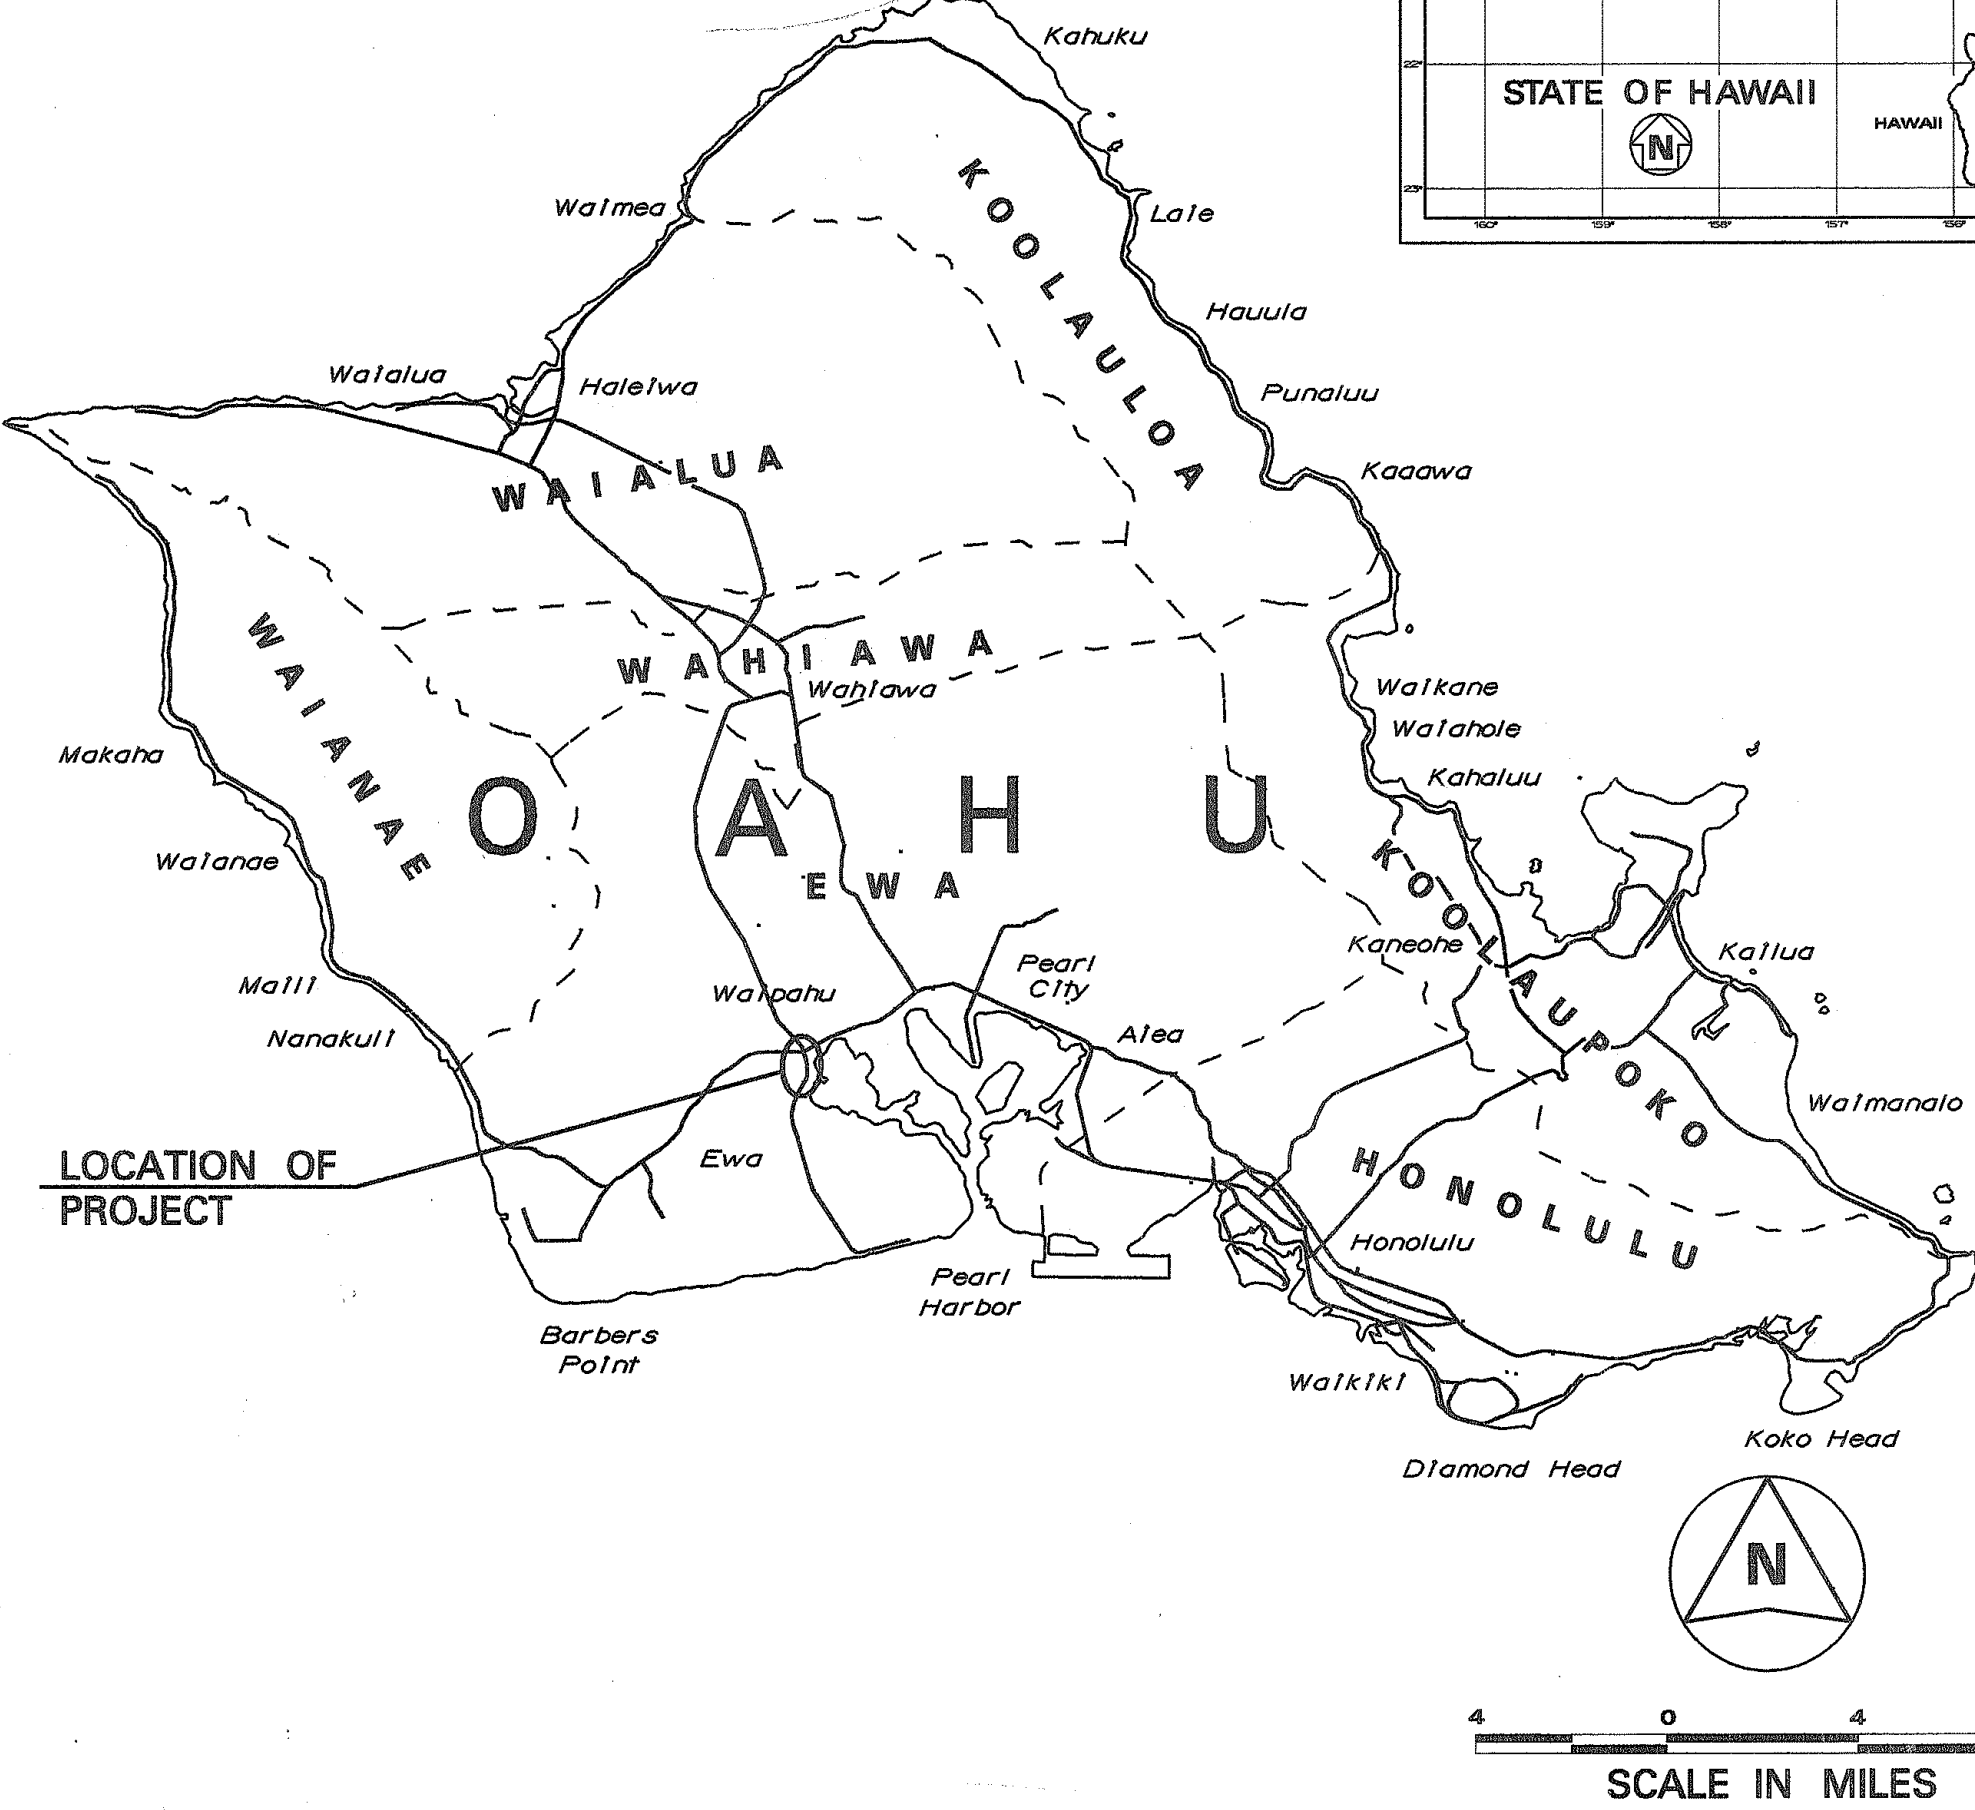

FED. ROAD DIST. NO.	STATE	FED. AID PROJ. NO.	FISCAL YEAR	SHEET NO.	TOTAL SHEETS
HAWAII	HAW.	STP-076-1(3)	1993	1	34

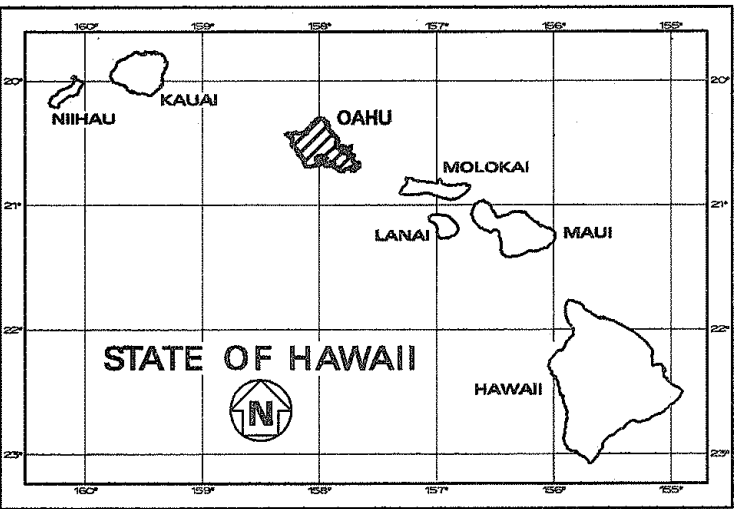

MILE POST 6.64 TO MILE POST 5.67

DESIGN DESIGNATION	
ADT (1992)	44,800
ADT (2002)	70,500
V	50

CHANGES MADE DURING CONSTRUCTION HAVE BEEN INCORPORATED ON THESE PLANS EXCEPT CHANGES IN THE ORIGINAL THEORETICAL QUANTITIES. FOR ACTUAL QUANTITIES, REFER TO PROJECT LEDGER AND/OR COMPUTATION BOOK.

RESIDENT ENGINEER DATE

DEPARTMENT OF TRANSPORTATION
FEDERAL HIGHWAY ADMINISTRATION

APPROVED: *Abraham Wong* 5/29/93
FOR DIVISION ADMINISTRATOR DATE

DEPARTMENT OF TRANSPORTATION
STATE OF HAWAII

APPROVED: *Sharon* 5/24/93
FOR DIR. OF TRANSPORTATION DATE

UNIT 'D' DESIGNED BY ALLAN NISHIMURA P.S. & E. BY MAY, 1993 DATE 587-2244 PHONE