
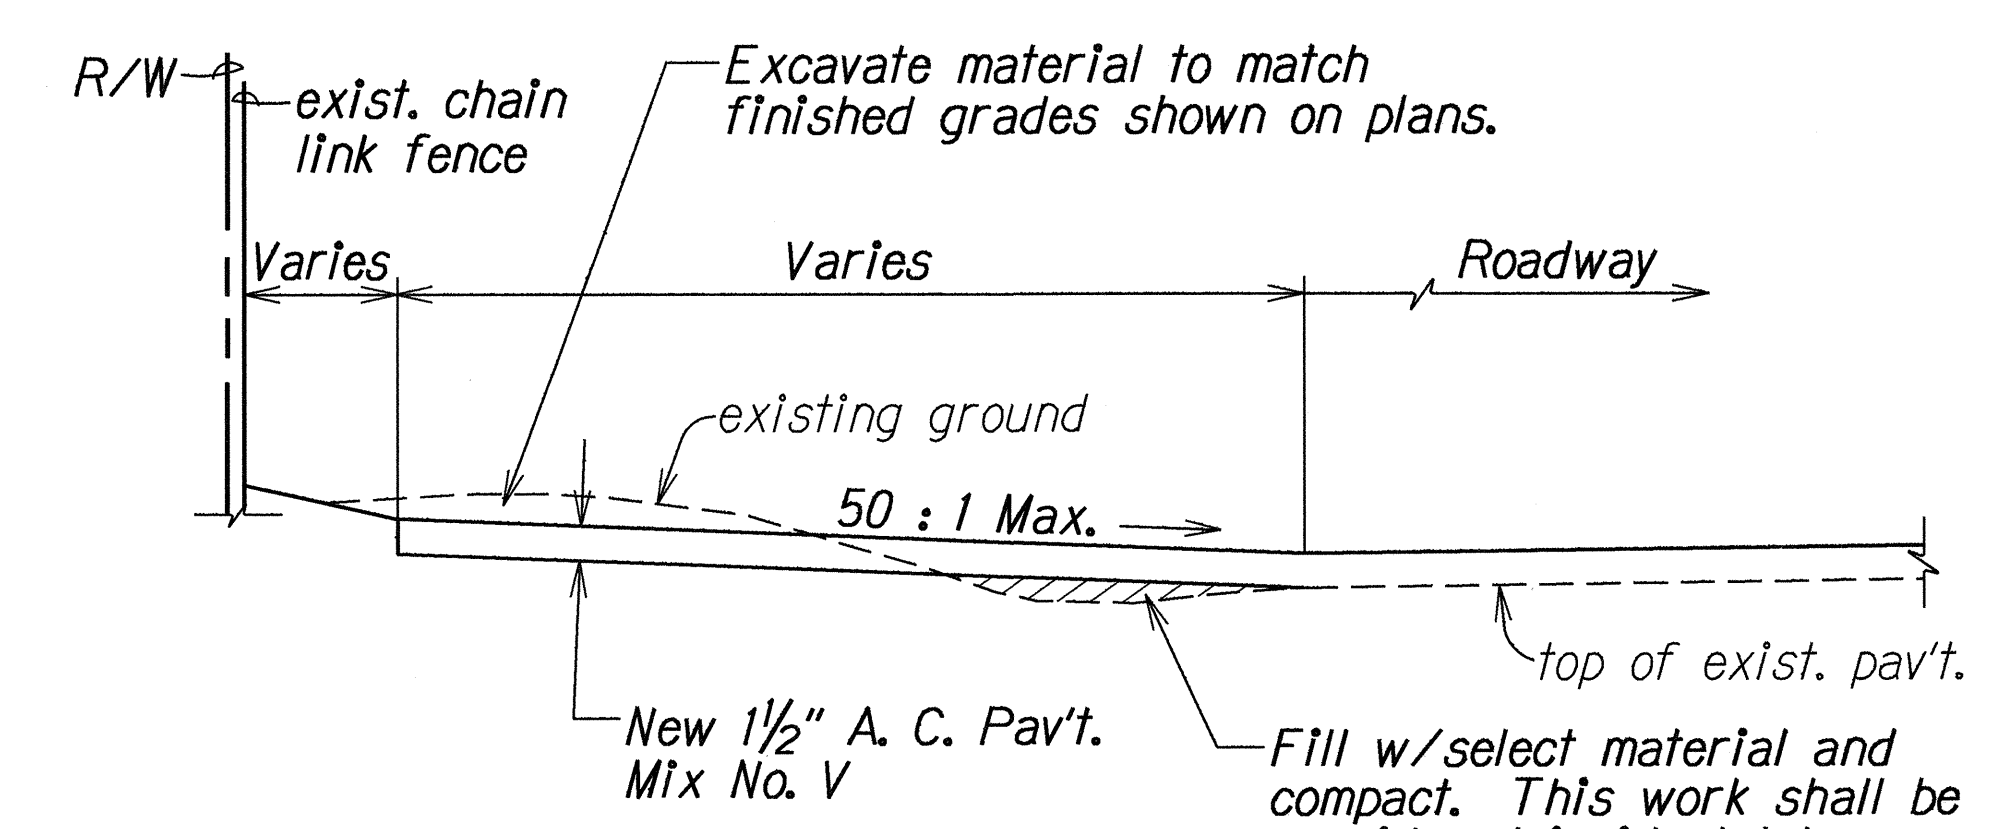
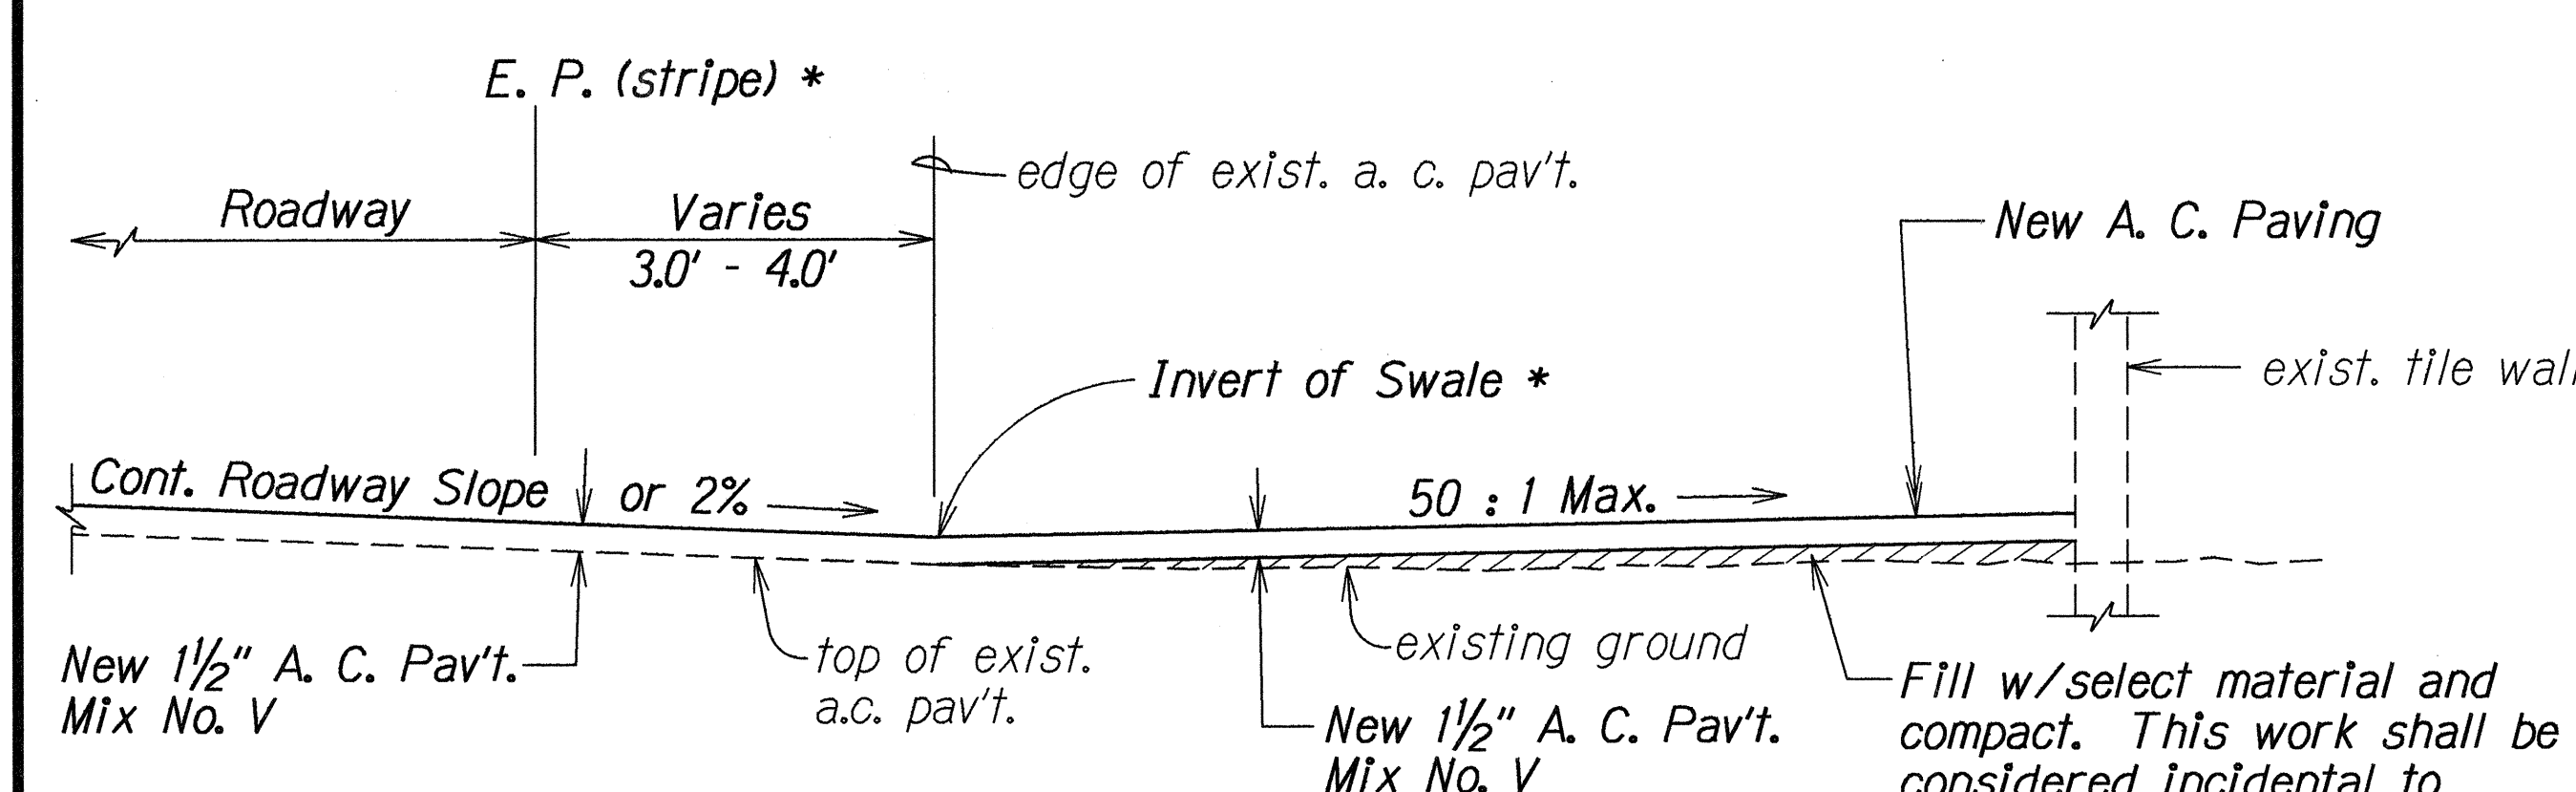


FED. ROAD DIST. NO.	STATE	FED. AID PROJ. NO.	FISCAL YEAR	SHEET NO.	TOTAL SHEETS
HAWAII	HAW.	STP-076-1(3)	1993	7	34

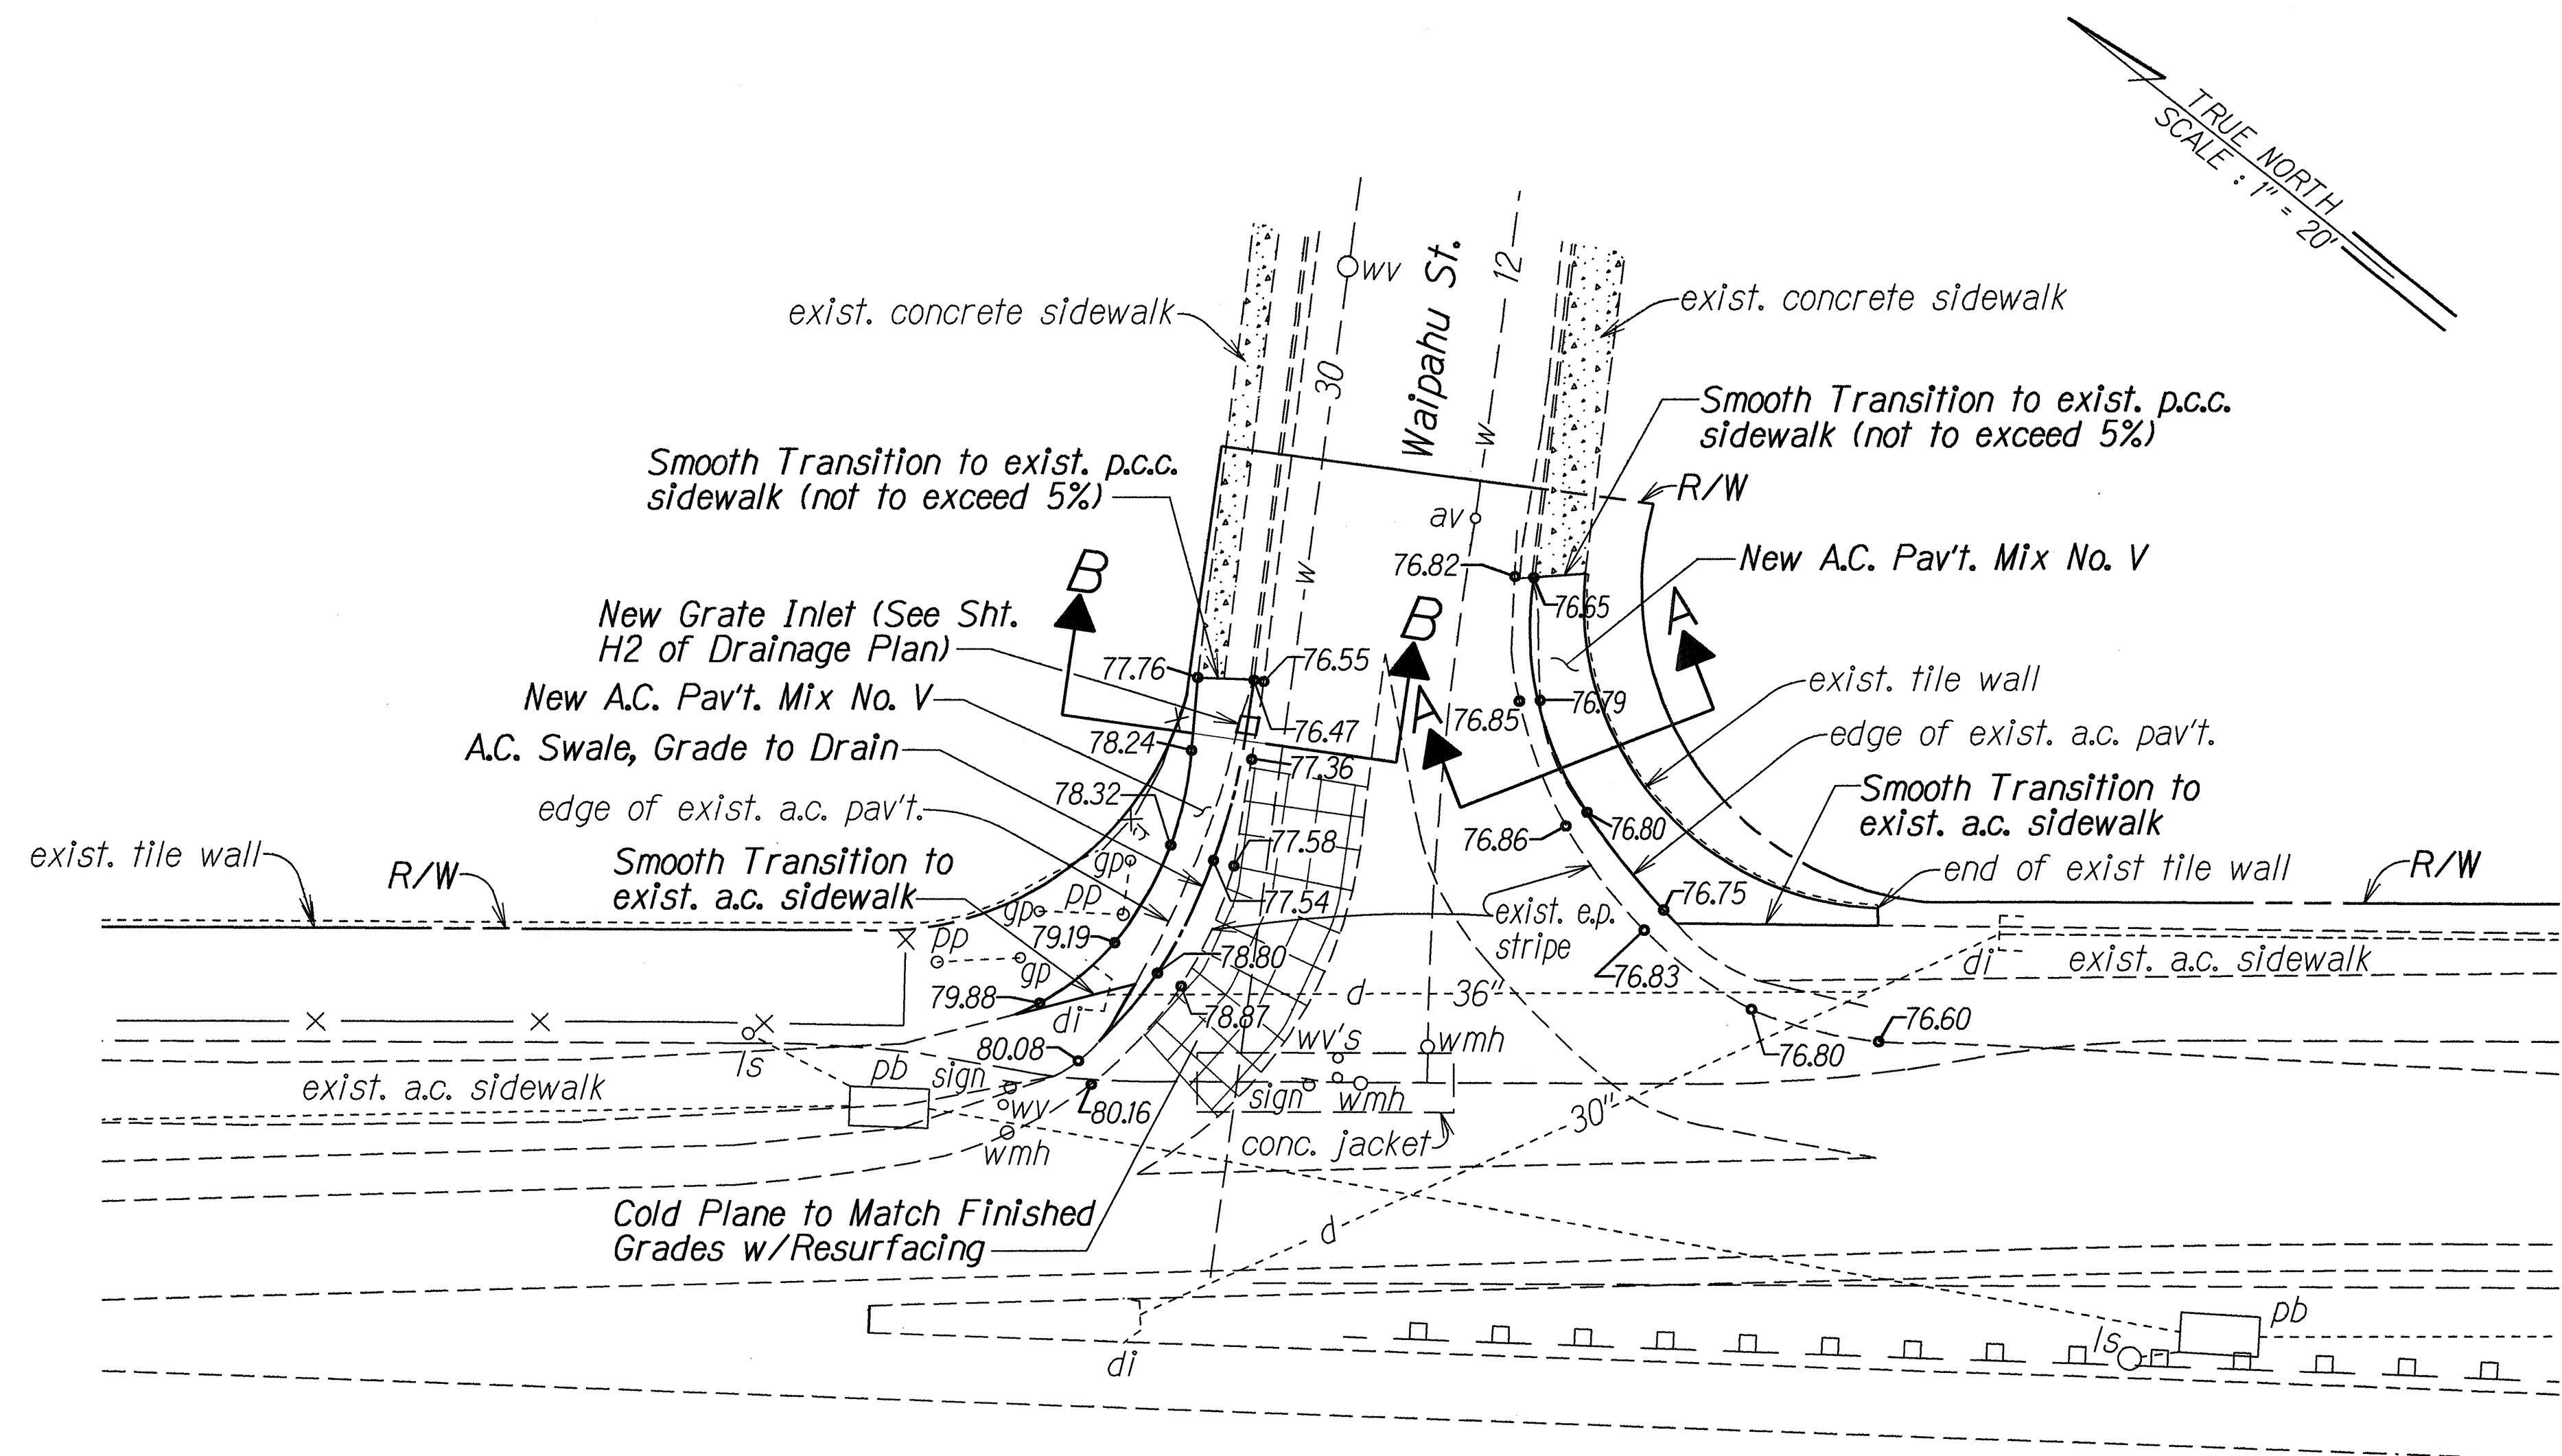

DESIGNED BY	DATE
DRAWN BY	5/27/93
CHECKED BY	
NOTED BY	
QUANTITIES BY	
REVISIONS	

STATE OF HAWAII
DEPARTMENT OF TRANSPORTATION
HIGHWAYS DIVISION

WAIPAHU STREET DETAIL PLAN
FT. WEAVER ROAD RESURFACING
H-1 to Farrington Interchange
F.A. PROJECT NO. STP-076-1(3)

Scale: 1" = 20'
Date: May, 1993

SHEET No. 1 OF 1 SHEETS