


GENERAL NOTES



- GENERAL SPECIFICATIONS:** HAWAII DEPARTMENT OF TRANSPORTATION, STANDARD SPECIFICATIONS FOR ROAD AND BRIDGE CONSTRUCTION, 1985, TOGETHER WITH SPECIAL PROVISIONS PREPARED FOR THIS CONTRACT, AND THE C&C OF HONOLULU STANDARD SPECIFICATIONS FOR PUBLIC WORKS CONSTRUCTION, SEE SEWER NOTES SHEET C-3.
- LOADS:**
 - LIVE LOAD: HS20-44
- MATERIALS:**
 - ALL CONCRETE SHALL BE CLASS A UNLESS OTHERWISE NOTED. SEE SPECIAL PROVISIONS FOR ADDITIONAL REQUIREMENTS.
 - ALL REINFORCING STEEL SHALL BE A.S.T.M. A615 GRADE 40, UNLESS OTHERWISE NOTED. BAR SIZED #6 OR LARGER: CONTRACTOR OPTION TO USE GRADE 60 BARS IF PROVIDING SAME NUMBER, SIZE AND SPACING AS GRADE 40.
 - MANHOLE RUNGS SHALL BE HOT DIP GALVANIZED AFTER FABRICATION.
- DESIGN STRESSES:** SHALL FOLLOW A.A.S.H.T.O. STANDARD SPECIFICATIONS FOR HIGHWAY BRIDGES IN ADDITION TO THOSE LISTED BELOW.

CONCRETE	CLASS	PRECAST RISER/RING
f_c	3,000 P.S.I.	4,000
f_c	1,200 P.S.I.	1,600
N	9	8
- REINFORCEMENT:**
 - THE MINIMUM COVERING MEASURED FROM THE SURFACE OF THE CONCRETE TO THE FACE OF ANY REINFORCING BARS SHALL BE AS FOLLOWS:
 - WALLS & SLABS = 3", U.O.N.
 - REINFORCING BARS SHALL BE DETAILED IN ACCORDANCE WITH A.C.I. MANUAL OF STANDARD PRACTICE FOR DETAILING REINFORCED CONCRETE HIGHWAY STRUCTURES UNLESS OTHERWISE NOTED.
 - MINIMUM CLEAR SPACING BETWEEN PARALLEL BARS SHALL BE 1-1/2 TIMES THE DIAMETER OF BARS (FOR NON BUNDLED BARS). BUT IN NO CASE SHALL THE CLEAR DISTANCE BETWEEN THE BARS BE LESS THAN 1-1/2 TIMES THE MAXIMUM SIZE OF THE COARSE AGGREGATE.
 - ALL DIMENSIONS RELATING TO REINFORCING BARS (E.G., SPACING OF BARS ETC.) ARE TO CENTERS OF BARS UNLESS OTHERWISE NOTED.
 - REINFORCING BARS SHALL BE SECURELY TIED AT ALL INTERSECTIONS AND LAP SPLICES.
- CONSTRUCTION METHODS:**
 - SEE STANDARD SPECIFICATIONS AND SPECIAL PROVISIONS.
 - EXCEPT AS OTHERWISE NOTED, ALL VERTICAL DIMENSIONS ARE MEASURED PLUMB.
- GENERAL:**
 - THE CONTRACTOR SHALL VERIFY THE LOCATION OF ALL UTILITY LINES AND NOTIFY THE RESPECTIVE OWNERS BEFORE COMMENCING THE WORK OF EXCAVATION.
 - FOR CONCRETE FINISH SEE STANDARD SPECIFICATIONS AND OTHER DRAWINGS.
 - STANDARD DETAIL DRAWINGS REFER TO ALL STRUCTURES IN GENERAL, EXCEPT FOR MODIFICATIONS AS MAY BE REQUIRED FOR SPECIAL CONDITIONS. FOR SUCH MODIFICATIONS, REFER TO THE CORRESPONDING DETAILED DRAWINGS.
 - ALL EXPOSED EDGES SHALL HAVE A 3/4" CHAMFER.
- WHERE REFERENCE IS MADE TO NOTE 8, FOLLOW THE "STANDARD PLANS", STATE OF HAWAII, DEPARTMENT OF TRANSPORTATION, HIGHWAYS DIVISION, HONOLULU, HAWAII, 1986.
- PROVIDE MEANS TO KEEP DIRT, CONCRETE, DEBRIS, ETC. FROM DROPPING INTO THE EXISTING SEWERLINE.

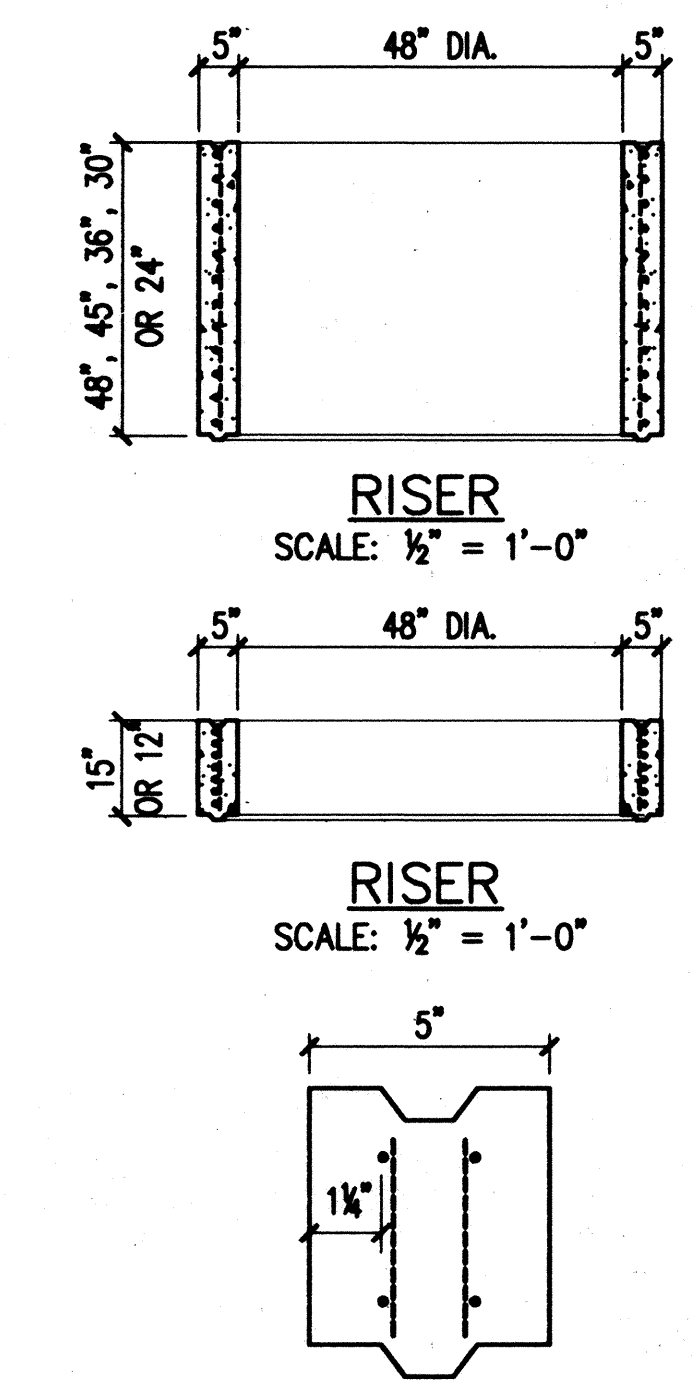


SECTION	A _s / L.F.
48" x 48" RISER	0.15
48" x 45" RISER	0.15
48" x 36" RISER	0.15
48" x 30" RISER	0.15
48" x 24" RISER	0.15
48" x 15" RISER	0.15
48" x 12" RISER	0.15
22" x 4" GRADE RING	0.12
22" x 2 1/2" GRADE RING	0.12





NOTE:
PRECAST SECTIONS SHALL CONFORM TO ASTM C478.

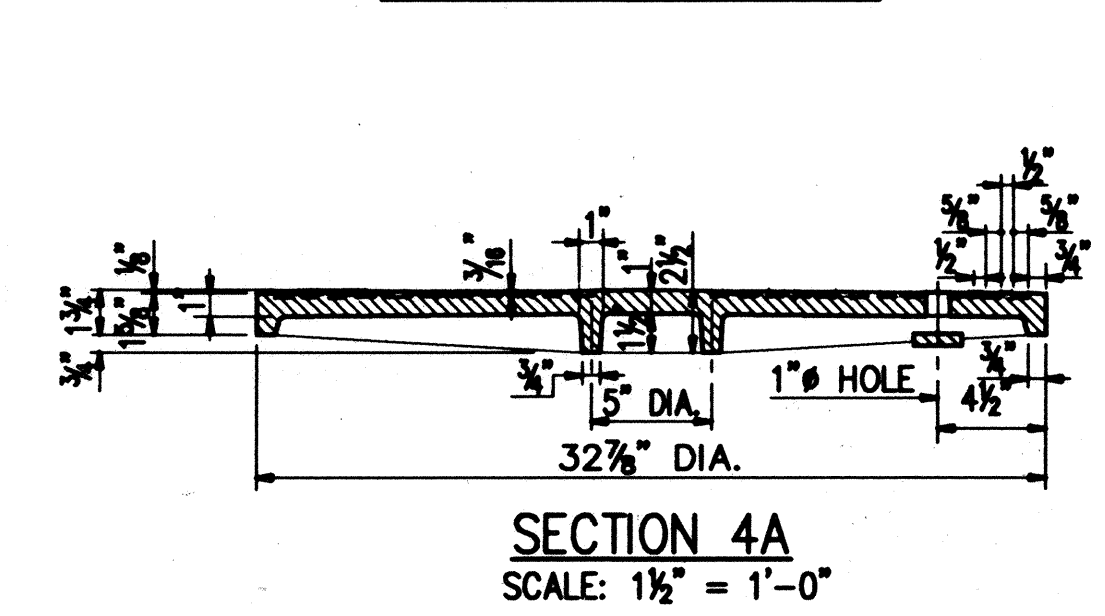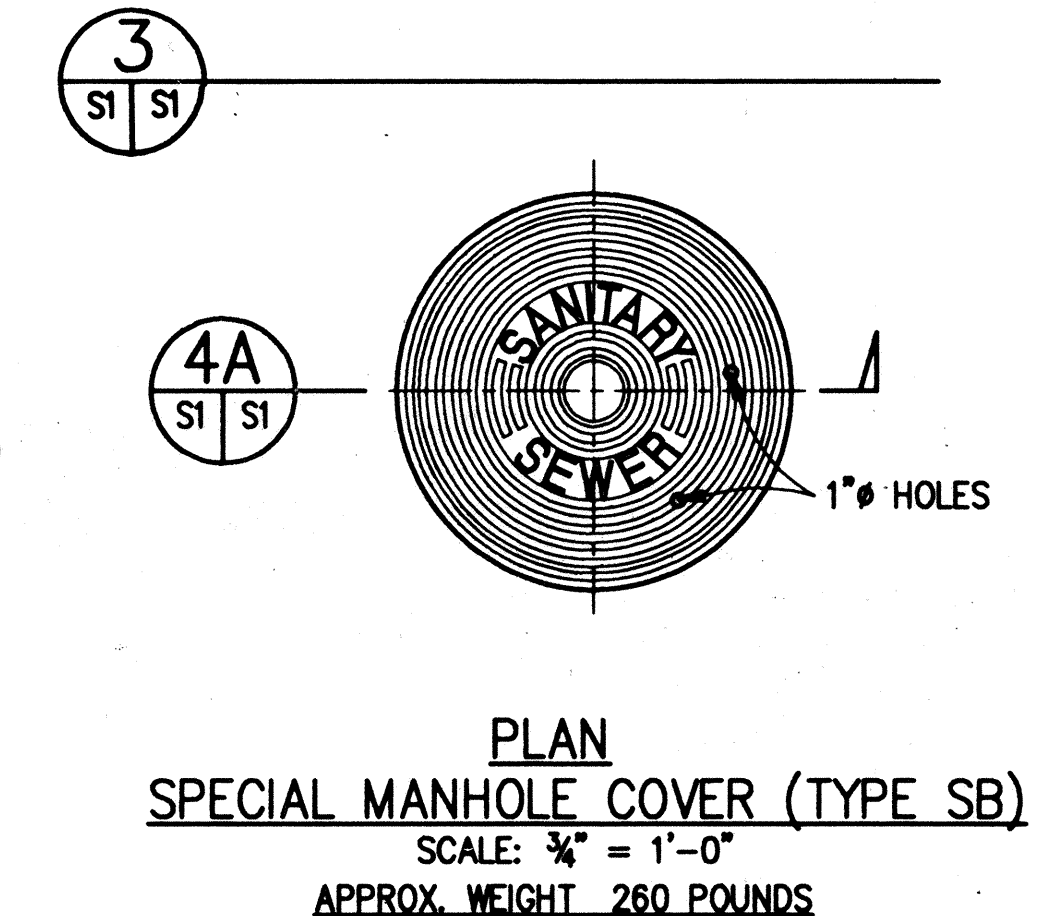


4
MANHOLE

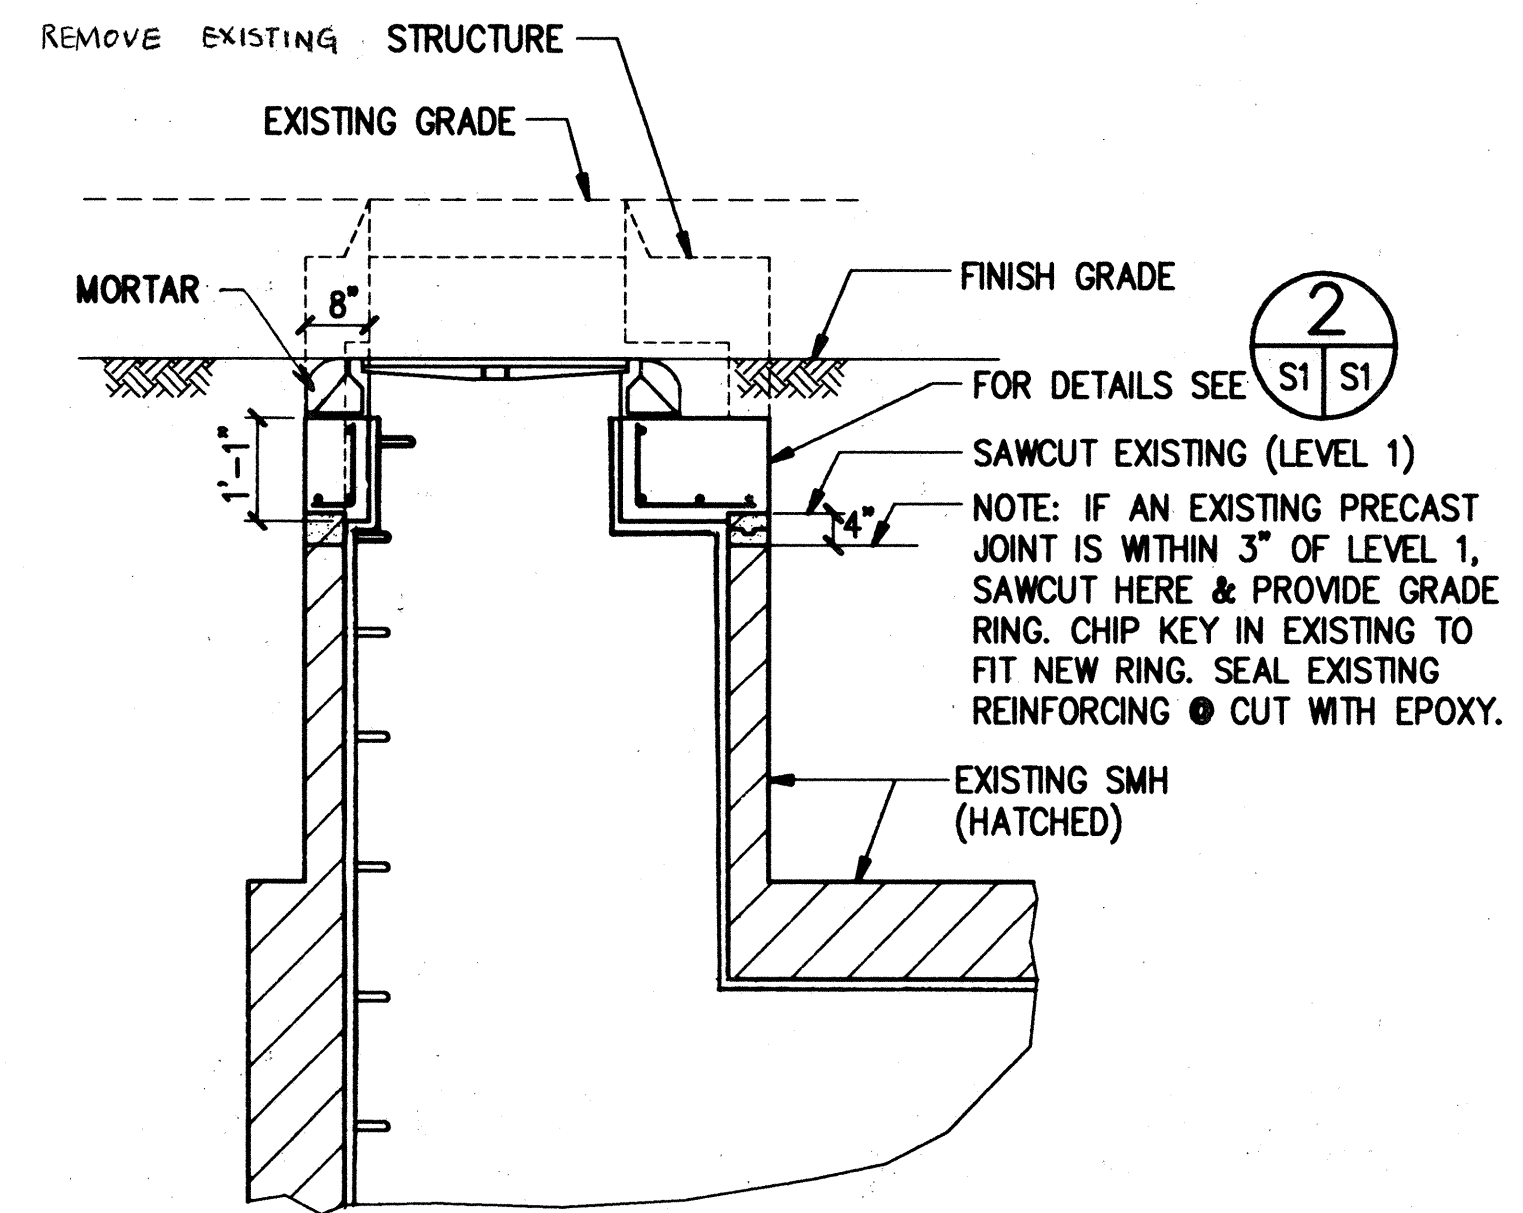

1
LOWER EXISTING SMH #8 (9 SIM.)
SCALE: 1/2" = 1'-0"

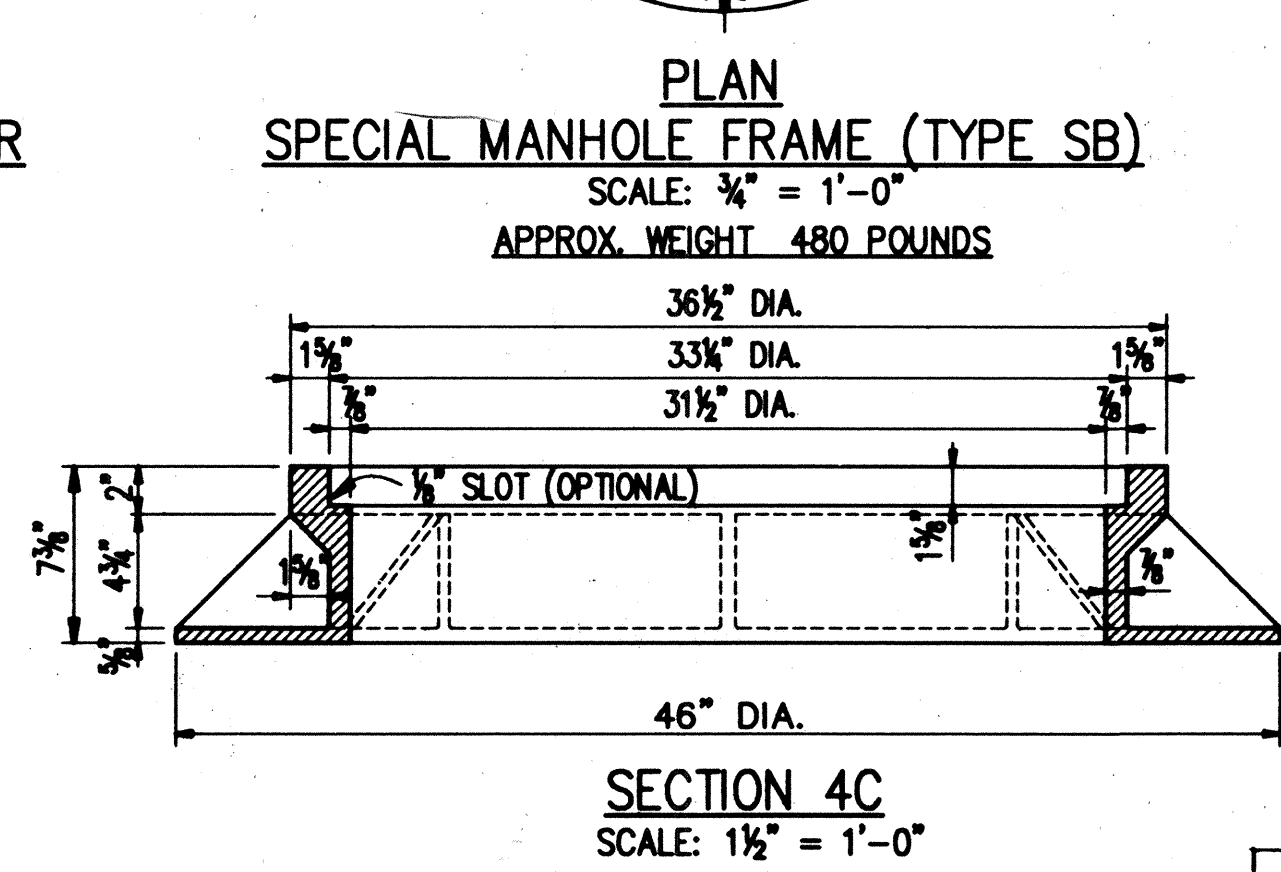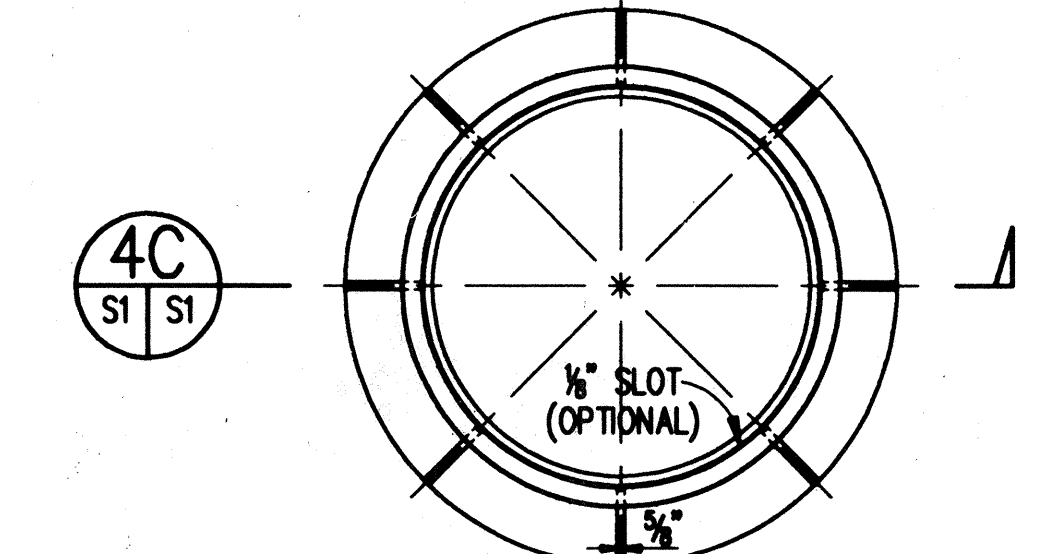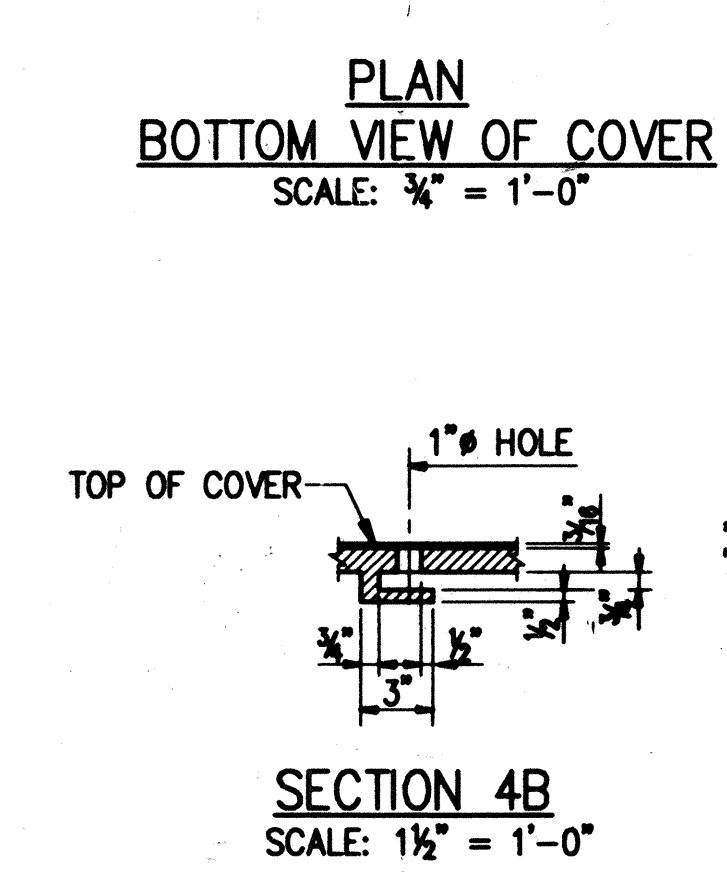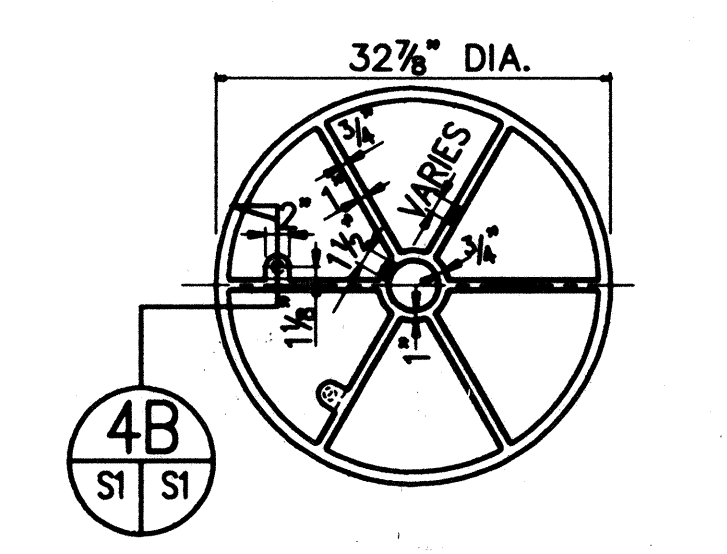

2
EXTEND EXISTING SMH #11, 12, 13, 14, 15 (10 SIM.)
SCALE: 1/2" = 1'-0"

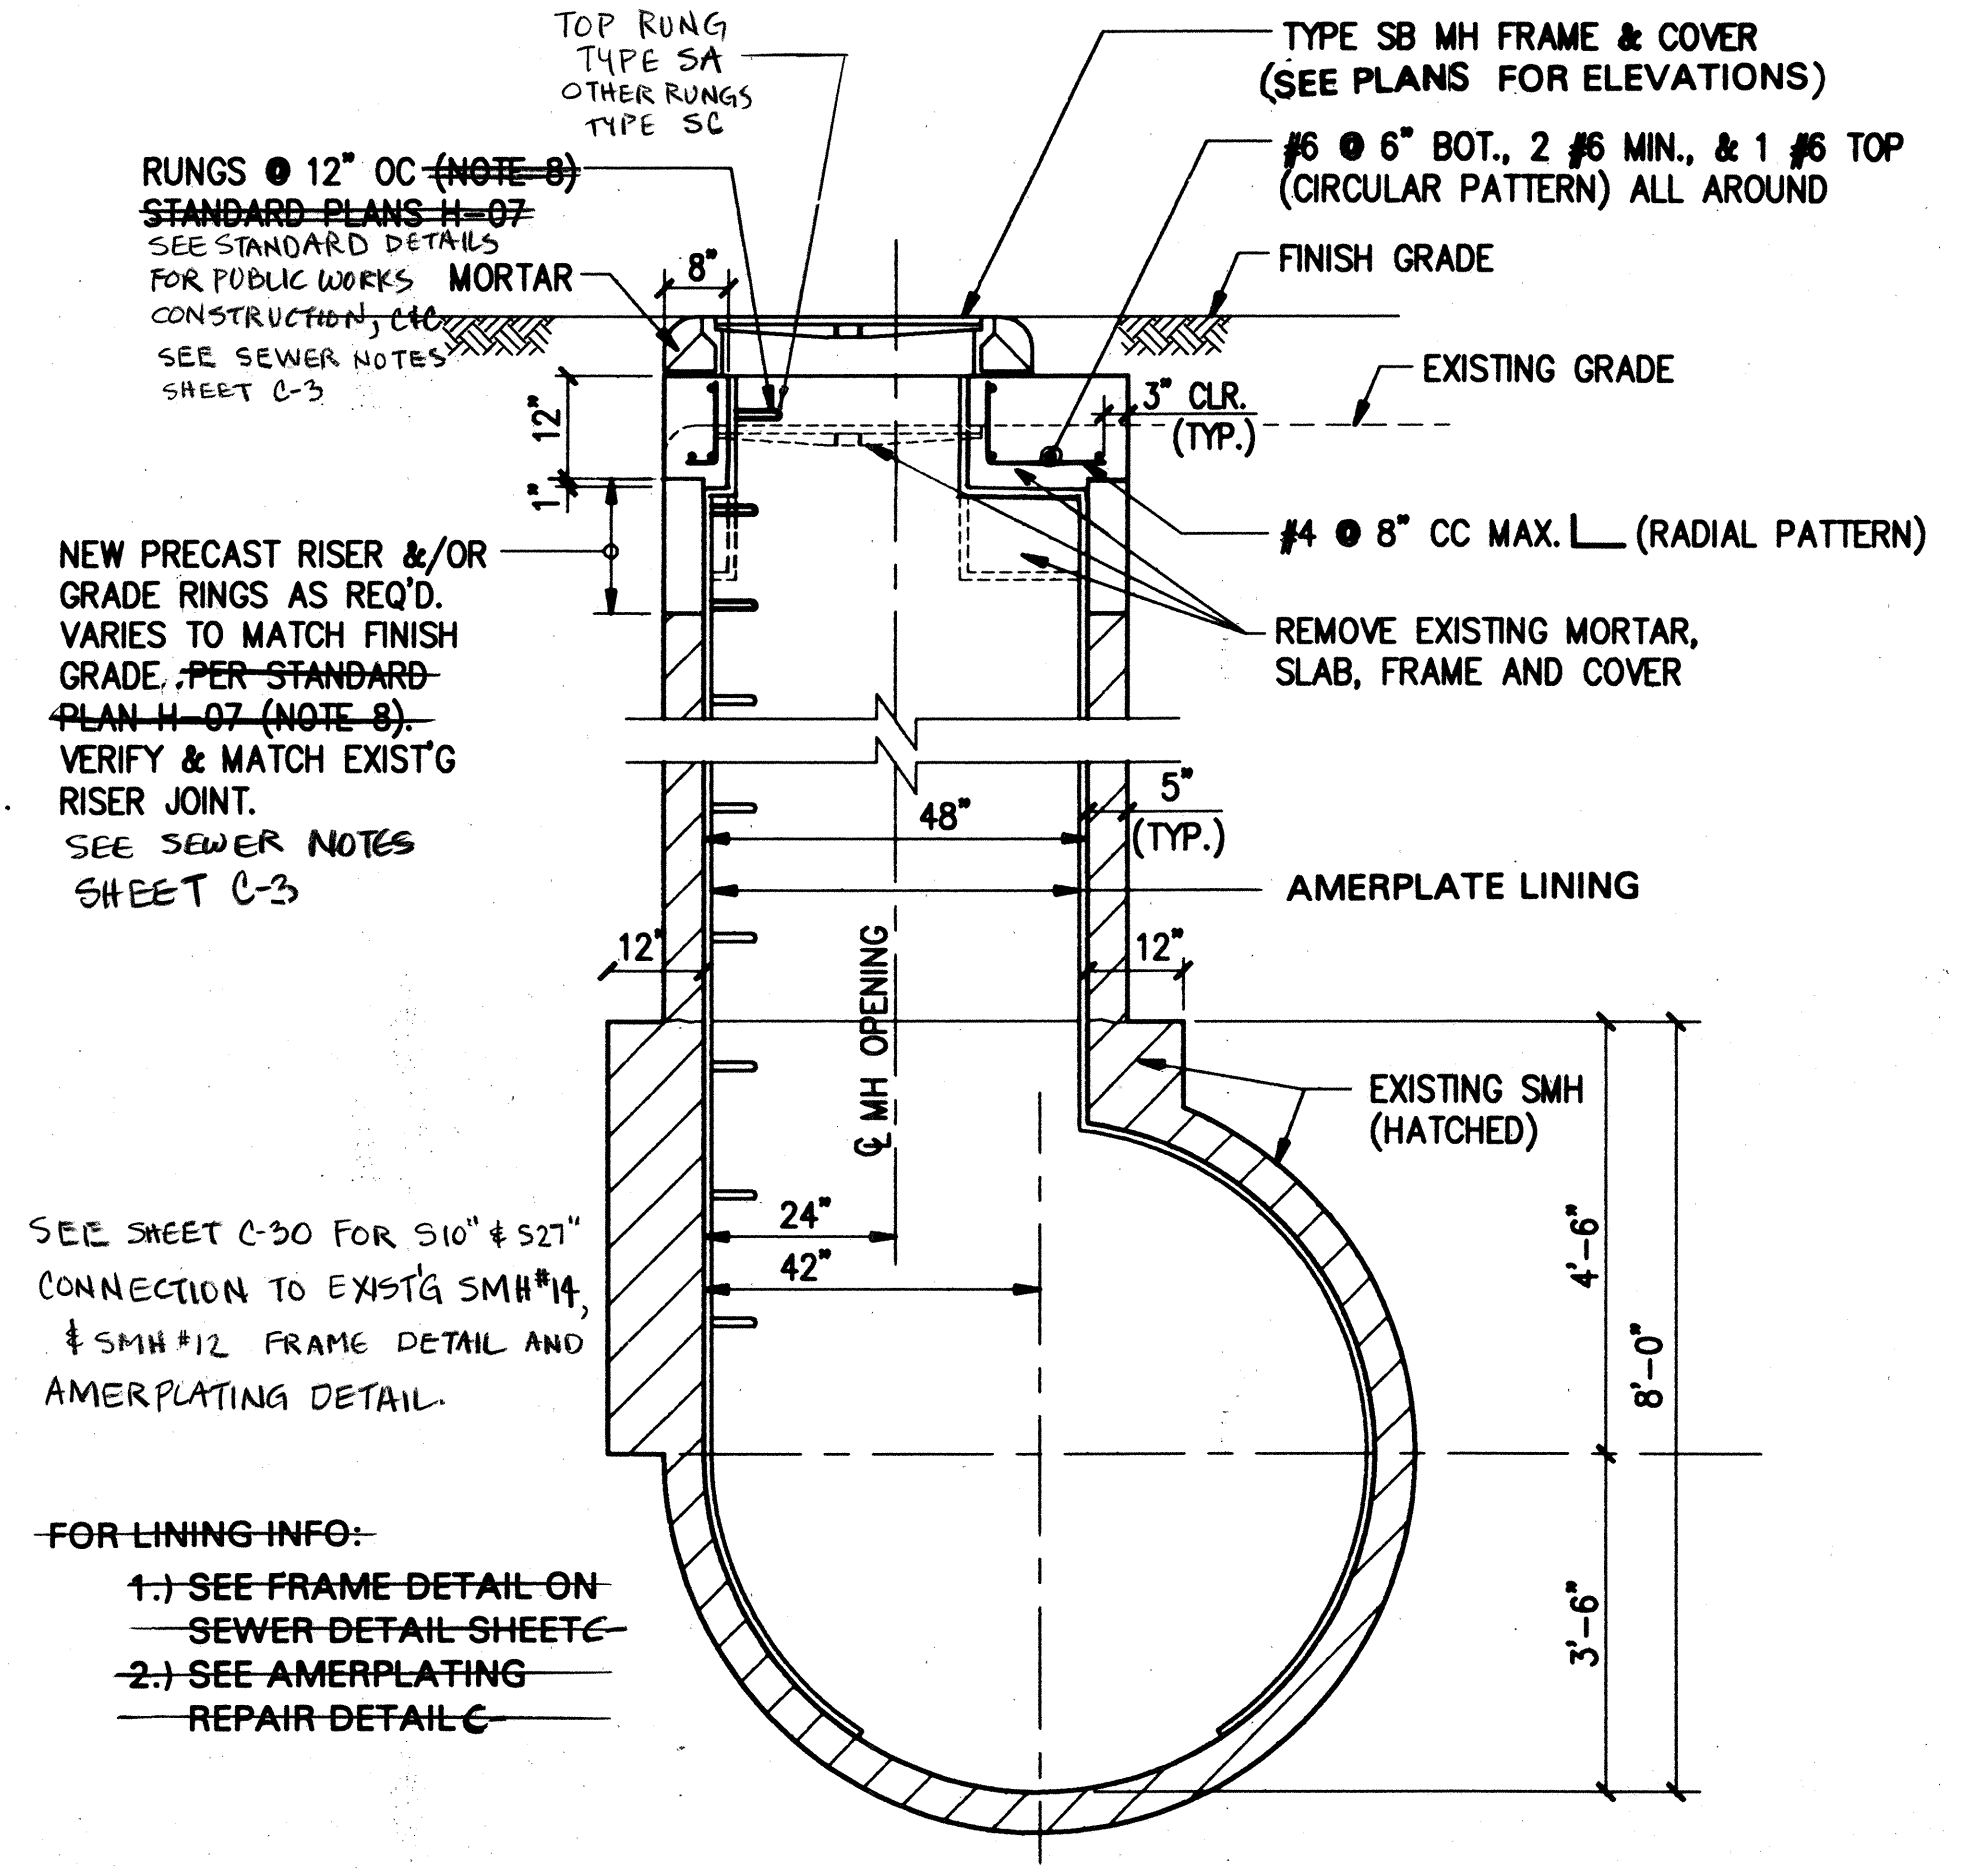

FOR LINING INFO:-
1-) SEE FRAME DETAIL ON SEWER DETAIL SHEET C-
2-) SEE AMERPLATING REPAIR DETAIL C-

SEE SHEET C-30 FOR 510" #52" CONNECTION TO EXIST'G SMH #14, & SMH #12 FRAME DETAIL AND AMERPLATING DETAIL.

PMT-76A-01-97


BELT COLLINS & ASSOCIATES
Engineering · Planning · Landscape Architecture
880 Ala Moana Boulevard Suite 200 Honolulu, Hawaii 96813
Phone: (808) 521-5361 Telex: BELTH 7430474 Fax: (808) 536-7819

Consultant: NAGAMINE ENGINEERS INC.
STRUCTURAL ENGINEERS
TEL 536-2626 FAX 536-3926

Client: GENTRY DEVELOPMENT CO., A HAWAII LIMITED PARTNERSHIP
P.O. BOX 208 HONOLULU, HAWAII 96808
FORT WEAVER ROAD INTERSECTION AND IROQUOIS POINT ROAD IMPROVEMENTS

MANHOLE DETAILS

Designed by: NN Date: JANUARY 1994
Drawn by: DR Proj. no.: (BCA)233.1900
Approved: [Signature] Date: 8/26/94
This work was prepared by me or under my supervision

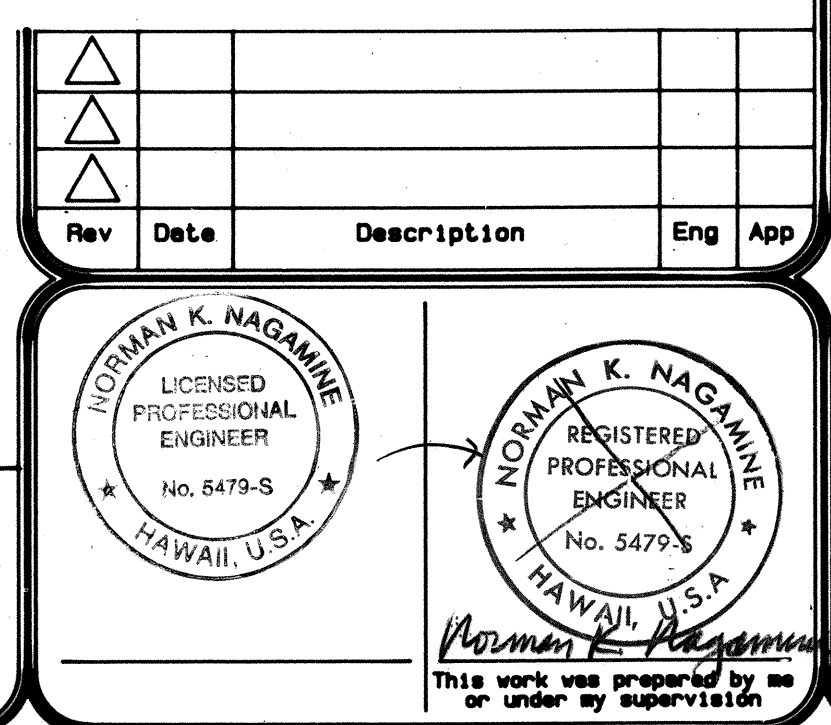

1. GENERAL SPECIFICATIONS: HAWAII DEPARTMENT OF TRANSPORTATION, STANDARD SPECIFICATIONS FOR ROAD, BRIDGE, AND PUBLIC WORKS CONSTRUCTION, 1994, TOGETHER WITH SPECIAL PROVISIONS PREPARED FOR THIS CONTRACT.

(A) LIVE LOAD: HS20-44

(A) ALL CONCRETE SHALL BE CLASS A UNLESS OTHERWISE NOTED. SEE SPECIAL PROVISIONS FOR ADDITIONAL REQUIREMENTS.

(B) ALL REINFORCING STEEL SHALL BE A.S.T.M. A615 GRADE 40, UNLESS OTHERWISE NOTED. BAR SIZED #6 OR LARGER: CONTRACTOR OPTION TO USE GRADE 60 BARS IF PROVIDING SAME NUMBER, SIZE AND SPACING AS GRADE 40.

(C) MANHOLE RUNGS SHALL BE HOT DIP GALVANIZED AFTER FABRICATION.

5. REINFORCEMENT

(A) THE MINIMUM COVERING MEASURED FROM THE SURFACE OF THE CONCRETE TO THE FACE OF ANY REINFORCING BARS SHALL BE AS FOLLOWS:

(1) WALLS & FOOTING = 3", UON.

(B) REINFORCING BARS SHALL BE DETAILED IN ACCORDANCE WITH A.C.I. MANUAL OF STANDARD PRACTICE FOR DETAILING REINFORCED CONCRETE HIGHWAY STRUCTURES UNLESS OTHERWISE NOTED.

(C) MINIMUM CLEAR SPACING BETWEEN PARALLEL BARS SHALL BE 1-1/2 TIMES THE DIAMETER OF BARS (FOR NON BUNDLED BARS). BUT IN NO CASE SHALL THE CLEAR DISTANCE BETWEEN THE BARS BE LESS THAN 1-1/2 TIMES THE MAXIMUM SIZE OF THE COARSE AGGREGATE.

(D) ALL DIMENSIONS RELATING TO REINFORCING BARS (EG, SPACING OF BARS ETC) ARE TO CENTERS OF BARS UNLESS OTHERWISE NOTED.

(E) REINFORCING BARS SHALL BE SECURELY TIED AT ALL INTERSECTIONS AND LAP SPLICES.



(A) SEE STANDARD SPECIFICATIONS AND SPECIAL PROVISIONS.

(B) EXCEPT AS OTHERWISE NOTED, ALL VERTICAL DIMENSIONS ARE MEASURED PLUMB.

(A) THE CONTRACTOR SHALL VERIFY THE LOCATION OF ALL UTILITY LINES AND NOTIFY THE RESPECTIVE OWNERS BEFORE COMMENCING THE WORK OF EXCAVATION.

(B) FOR CONCRETE FINISH SEE STANDARD SPECIFICATIONS AND OTHER DRAWINGS.

8. WHERE REFERENCE IS MADE TO NOTE 8, FOLLOW THE "STANDARD PLANS", STATE OF HAWAII, DEPARTMENT OF TRANSPORTATION, HIGHWAYS DIVISION, HONOLULU, HAWAII, 1986.

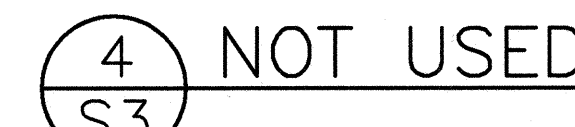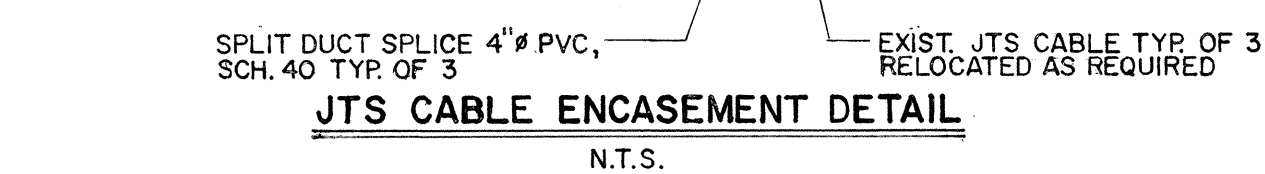

PMT-76A-01-97

B | BELT COLLINS & ASSOCIATES

C
A

Engineering Planning Landscape Architecture

680 Ala Moana Boulevard Suite 200 Honolulu, Hawaii 96813
Phone:(808)521-5361 Telex:BELTH 7430474 Fax:(808)538-7819

Consultant:
NAGAMINE ENGINEERS INC.
1001 BISHOP STREET
PAUAAHI TOWER, SUITE 725
HONOLULU, HAWAII 96813

Client: **GENTRY DEVELOPMENT Co.
A HAWAII LIMITED PARTNERSHIP
P.O. BOX 295
HONOLULU, HAWAII 96809**

EWA BY GENTRY
FORT WEAVER ROAD INTERSECTION AND
IROQUOIS POINT ROAD IMPROVEMENTS


SPECIAL CATCH BASIN

Designed by: XY Date: MAY 1995
 Drawn by: JW Proj. no.: (BCA)233.1901.12

Approved: _____




_____ Date _____ Date


NO. 07



Norman K. Nagamine

FILE	POCKET	FOLDER
------	--------	--------

				
				
				
Rev	Date	Description	Eng	App



Norman K. Nagamine

This work was prepared by me
or under my supervision

FILE	POCKET	FOLDER
------	--------	--------

Trim: 22" x 36"

RECORD DRAWINGS

SHEET S3 of Sheet s