


CONSTRUCTION PLANS FOR:
EWA BY GENTRY
FORT WEAVER ROAD
INTERSECTION AND IROQUOIS
POINT ROAD IMPROVEMENTS

LOCATED AT:

HONOLULU, EWA, OAHU, HAWAII

TAX MAP KEY: 9-01-10: PORTIONS OF 18, 20

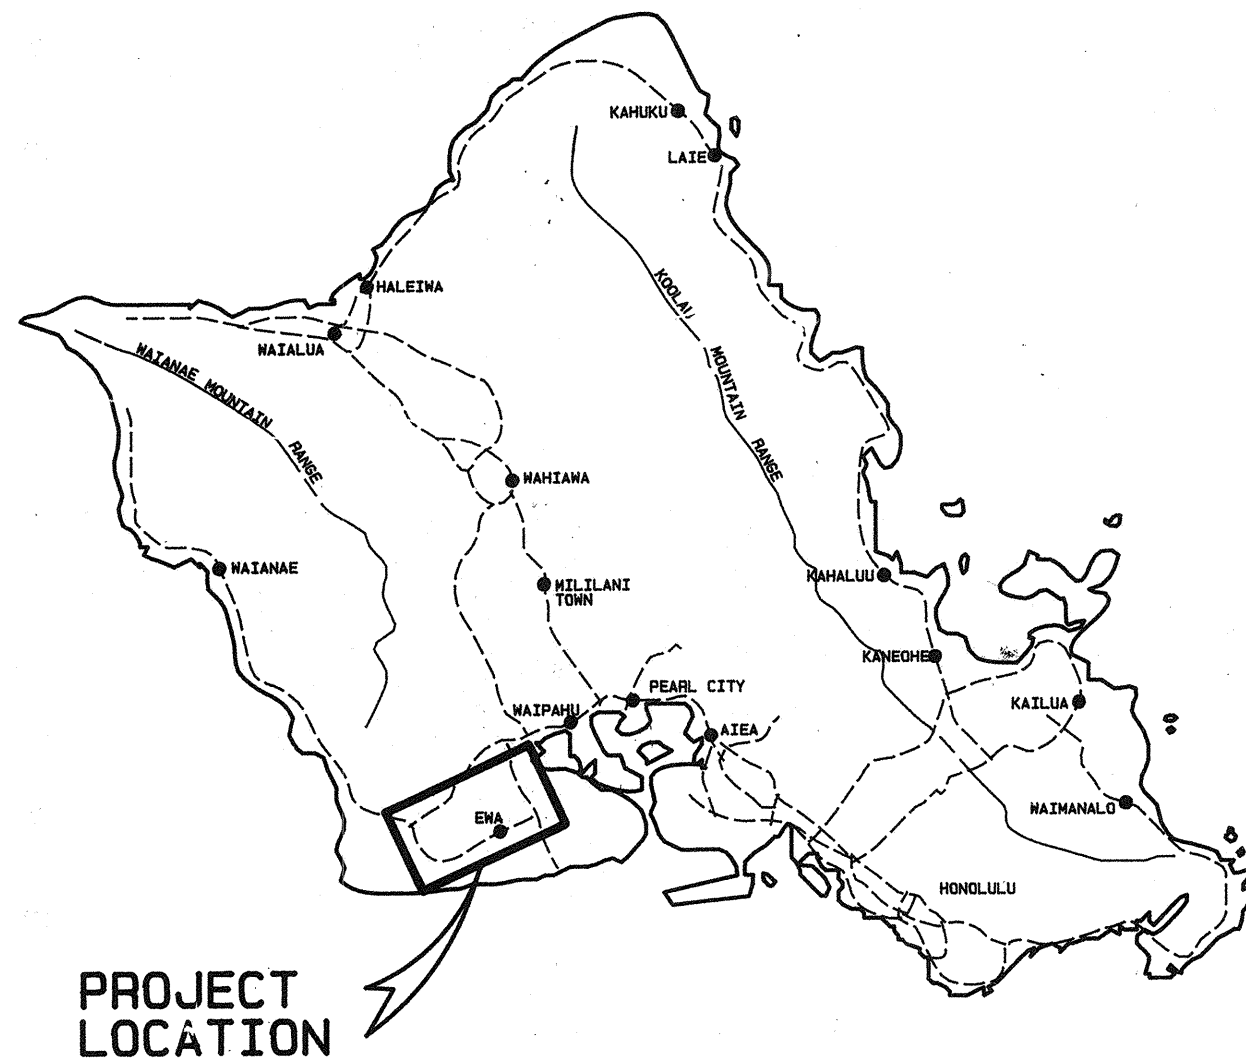

PREPARED FOR:
GENTRY DEVELOPMENT Co.,
A HAWAII LIMITED PARTNERSHIP
P.O. BOX 295
HONOLULU, HAWAII 96809

PREPARED BY:
BELT COLLINS & ASSOCIATES
ENGINEERING • PLANNING • LANDSCAPE ARCHITECTURE
680 ALA MOANA BOULEVARD, SUITE 200
HONOLULU, HAWAII 96813

INDEX OF DRAWINGS:

SHEET No. DESCRIPTION

SHEET No. DESCRIPTION

CIVIL

- C-1 TITLE SHEET
- C-2 GENERAL SITE PLAN
- C-3 CONSTRUCTION NOTES - 1
- C-4 CONSTRUCTION NOTES - 2
- C-5 HYDRAULIC DATA PLAN
- C-6 PLAN & PROFILE GEIGER ROAD
- C-7 PLAN & PROFILE IROQUOIS POINT ROAD - 1
(1+24.19 TO 4+00)
- C-8 PLAN & PROFILE IROQUOIS POINT ROAD - 2
(4+00 TO 9+00)
- C-9 PLAN & PROFILE IROQUOIS POINT ROAD - 3
(9+00 TO 13+50)
- C-10 PLAN & PROFILE IROQUOIS POINT ROAD - 4
(13+50 TO 18+00)
- C-11 PLAN & PROFILE IROQUOIS POINT ROAD - 5
(18+00 TO 22+50)
- C-12 PLAN & PROFILE IROQUOIS POINT ROAD - 6
(22+50 TO 27+00)
- C-13 PLAN & PROFILE IROQUOIS POINT ROAD - 7
(27+00 TO 31+00)
- C-14 PLAN & PROFILE FORT WEAVER ROAD - 1
(BEGIN OF PROJECT TO 247+00)
- C-15 PLAN & PROFILE FORT WEAVER ROAD - 2
(247+00 TO 258+50)
- C-16.1 FORT WEAVER ROAD INTERSECTION PLAN
- C-17 TYPICAL ROAD SECTIONS
- C-18 CURB RETURN GRADES
- C-19 GRADING & DRAINAGE PLAN 1 & 2
GEIGER ROAD/IROQUOIS POINT ROAD
- C-20 GRADING & DRAINAGE PLAN 3 & 4
IROQUOIS POINT ROAD
- C-21 GRADING & DRAINAGE PLAN 5 & 6
IROQUOIS POINT ROAD
- C-22 GRADING & DRAINAGE PLAN 7 & 8
IROQUOIS POINT ROAD
- C-23 SIGNING AND STRIPING PLAN
GEIGER ROAD/IROQUOIS POINT ROAD - 1
- C-24 SIGNING & STRIPING PLAN - IROQUOIS POINT ROAD - 2
- C-25 SIGNING & STRIPING PLAN - FORT WEAVER ROAD
- C-26 WATER LINE AND DRAIN LINE PROFILES
- C-27 DRAIN LINE PROFILES - 1
- C-28 DRAIN LINE PROFILES - 2
- C-29 SEWER LINE STUBOUT PROFILES
- C-30 SEWER DETAILS
- C-31 MISCELLANEOUS DETAILS
FUEL LINE DETAILS & MISCELLANEOUS DETAILS
- C-32 CROSS SECTIONS - GEIGER ROAD
- C-33 CROSS SECTIONS - 1 IROQUOIS POINT ROAD
- C-34 CROSS SECTIONS - 2 IROQUOIS POINT ROAD
- C-35 CROSS SECTIONS - 3 IROQUOIS POINT ROAD
- C-36 CROSS SECTIONS - 4 IROQUOIS POINT ROAD
- C-37 CROSS SECTIONS - 5 IROQUOIS POINT ROAD
- C-38 CROSS SECTIONS - 6 IROQUOIS POINT ROAD
- C-39 CROSS SECTIONS - 7 IROQUOIS POINT ROAD
- C-40 CROSS SECTIONS - 8 IROQUOIS POINT ROAD
- C-41 CROSS SECTIONS - 1 FORT WEAVER ROAD
- C-42 CROSS SECTIONS - 2 FORT WEAVER ROAD
- C-43 CROSS SECTIONS - 3 FORT WEAVER ROAD
- C-44 CROSS SECTIONS - 4 FORT WEAVER ROAD
- C-45 SIGHT LINE PROFILES AT FORT WEAVER ROAD
& DRAIN LINE PROFILES 1A & 1B
- C-46 IRRIGATION CROSSING PROFILES
- C-10A PHASE - A PLAN & PROFILE IROQUOIS POINT ROAD - 1
(13+50 TO 18+00)
- C-11A PHASE - A PLAN & PROFILE IROQUOIS POINT ROAD - 2
(18+00 TO 22+50)
- C-24A PHASE - A SIGNING & STRIPING PLAN - 2
IROQUOIS POINT ROAD
- A CONSTRUCTION PLAN PHASE - A FORT WEAVER ROAD
- A1 CONSTRUCTION PLAN PHASE - A1
- A2 CONSTRUCTION PLAN PHASE - A2
- A3 CONSTRUCTION PLAN PHASE - A3
- A4 CONSTRUCTION PLAN PHASE - A4
- A5 CONSTRUCTION PLAN PHASE - A5
- A6 TRAFFIC NOTES, PROFILE &
TYPICAL ROAD SECTIONS PHASE - A

CONSTRUCTION PHASE-B

- C-10B PHASE - B PLAN & PROFILE IROQUOIS POINT ROAD - 1
(13+50 TO 18+00)

- B1 CONSTRUCTION PLAN PHASE - B1
- B2 CONSTRUCTION PLAN PHASE - B2
- B3 CONSTRUCTION PLAN PHASE - B3
- B4 CONSTRUCTION PLAN PHASE - B4
- B5 TYPICAL ROAD SECTIONS PHASE - B5
- B6 TYPICAL ROAD SECTIONS PHASE - B6

STRUCTURAL

- S-1 STRUCTURAL DETAILS FOR SEWER MANHOLES
- S-2 MODIFIED TYPE "D" CATCH BASIN
- S-3 SPECIAL CATCH BASIN
- T-1 TRAFFIC SIGNAL LEGEND, NOTES AND DETAILS
- T-2 TRAFFIC SIGNAL PLAN
- T-3 TRAFFIC SIGNAL DETAILS

CATHODIC PROTECTION

- CP-1 MISCELLANEOUS CATHODIC PROTECTION DETAILS
- CP-2 SPLICE CONNECTION DETAILS STEPS 1-5
- CP-3.1 CATHODIC PROTECTION NOTES AND SITE PLANS
- CP-5 MISCELLANEOUS CATHODIC PROTECTION DETAILS-II

ELECTRICAL

- E-1 LOCATION MAP, ELECTRICAL SITE PLAN
- E-2 EQUIPMENT SCHEDULE, ELECTRICAL SYMBOLS, GENERAL NOTES
- E-3 ELECTRICAL DISTRIBUTION PARTIAL PLAN "I"
- E-4 ELECTRICAL DISTRIBUTION PARTIAL PLAN "II"
- E-5 ELECTRICAL DISTRIBUTION PARTIAL PLAN "III"
- E-6 ELECTRICAL DISTRIBUTION PARTIAL PLAN "IV"
- E-7 ELECTRICAL DISTRIBUTION PARTIAL PLAN "V"
- E-8 MISCELLANEOUS ELECTRICAL DETAILS
- E-9 ELECTRICAL DUCTLINE PROFILE 8 - PLAN "A"
- E-10 ELECTRICAL DUCTLINE PROFILE 8 - PLAN "B"
- E-11 MISCELLANEOUS ELECTRICAL DETAILS
- E-12 DUCT SECTIONS - STATE
- E-13 DUCT SECTIONS - CITY & COUNTY
- E-14 MISC. STREET LIGHT DETAILS
- E-15 MISC. STREET LIGHT DETAILS
- E-16 STREET LIGHT STANDARD SLIP BASE DETAIL,
MISC. STREET LIGHT DETAILS
- E-17 PULLBOX DETAILS, MISC. STREET LIGHT DETAILS
- E-18 PULLBOX DETAILS, MISCELLANEOUS STREET LIGHT DETAILS,
CONDUIT SCHEDULE
- E-19 GEIGER/IROQUOIS POINT ROAD STREET LIGHT CONNECTION
DIAGRAM
- E-20 ELECTRICAL REFERENCE DETAILS
- E-21 ELECTRICAL REFERENCE DETAILS
- E-22 ELECTRICAL REFERENCE DETAILS

LANDSCAPE

- LA-1 LANDSCAPE & IRRIGATION PLAN
GEIGER ROAD
- L-1 LANDSCAPE PLAN
- L-2 LANDSCAPE PLAN
- L-3 LANDSCAPE PLAN
- L-4 LANDSCAPE PLAN
- L-5 LANDSCAPE PLAN
- L-6 LANDSCAPE PLAN
- L-7 PLANT LIST AND DETAILS
- L-8 IRRIGATION PLAN
- L-9 IRRIGATION PLAN
- L-10 IRRIGATION PLAN
- L-11 IRRIGATION PLAN
- L-12 IRRIGATION PLAN
- L-13 IRRIGATION NOTES AND LEGEND
- L-14 IRRIGATION DETAILS
- L-15 IRRIGATION DETAILS
- L-16 IRRIGATION DETAILS

RECORD DRAWING TRACINGS

Certified By: *[Signature]* Date: 3/8/97
Contractor
KIEWIT PACIFIC CO.
Submitted By: *[Signature]* Date: 4-1-97
Belt Collins & Associates
Approved By: _____ Date: _____

APPROVED BY:

[Signature] 7/14/94
DIRECTOR AND CHIEF ENGINEER, DEPT. OF PUBLIC WORKS
CITY AND COUNTY OF HONOLULU
[Signature] 11/13/94
MANAGER & CHIEF ENGINEER, BOARD OF WATER SUPPLY,
CITY AND COUNTY OF HONOLULU
[Signature] 3-14-95
CHIEF, ENVIRONMENTAL MANAGEMENT DIVISION,
DEPARTMENT OF HEALTH,
STATE OF HAWAII
[Signature] 03 Mar 95
CHIEF, HIGHWAYS DIVISION, STATE DEPARTMENT OF TRANSPORTATION
(APPROVAL GRANTED FOR WORK WITHIN STATE RIGHT-OF-WAY ONLY,
ID NO. LETTER OF APPROVAL NO. HWY-CM DATED)
[Signature] 8/27/94
DIRECTOR, DEPARTMENT OF WASTEWATER MANAGEMENT
CITY AND COUNTY OF HONOLULU
(FOR SEWER WORK WITHIN PUBLIC ROAD R/W ONLY)
[Signature] 8/22/94
DIRECTOR, DEPARTMENT OF TRANSPORTATION SERVICES,
CITY AND COUNTY OF HONOLULU
(FOR WORK WITHIN
CITY ONLY)
[Signature] 4-6-95
DIRECTOR, DEPARTMENT OF LAND UTILIZATION,
CITY AND COUNTY OF HONOLULU

PMT - 76A-01-97

RECORD DRAWINGS

Project No. 233.1900 Date: FEBRUARY 1995
SHEET C-1 of 1 Sheets