

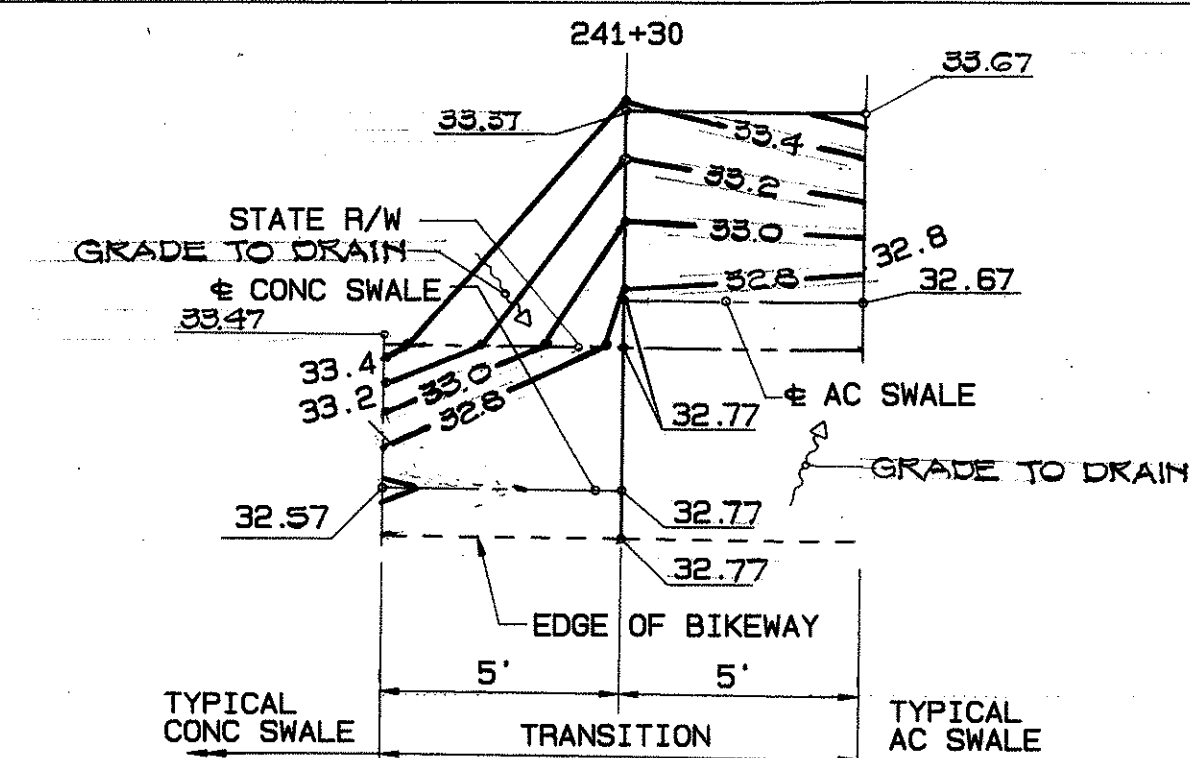


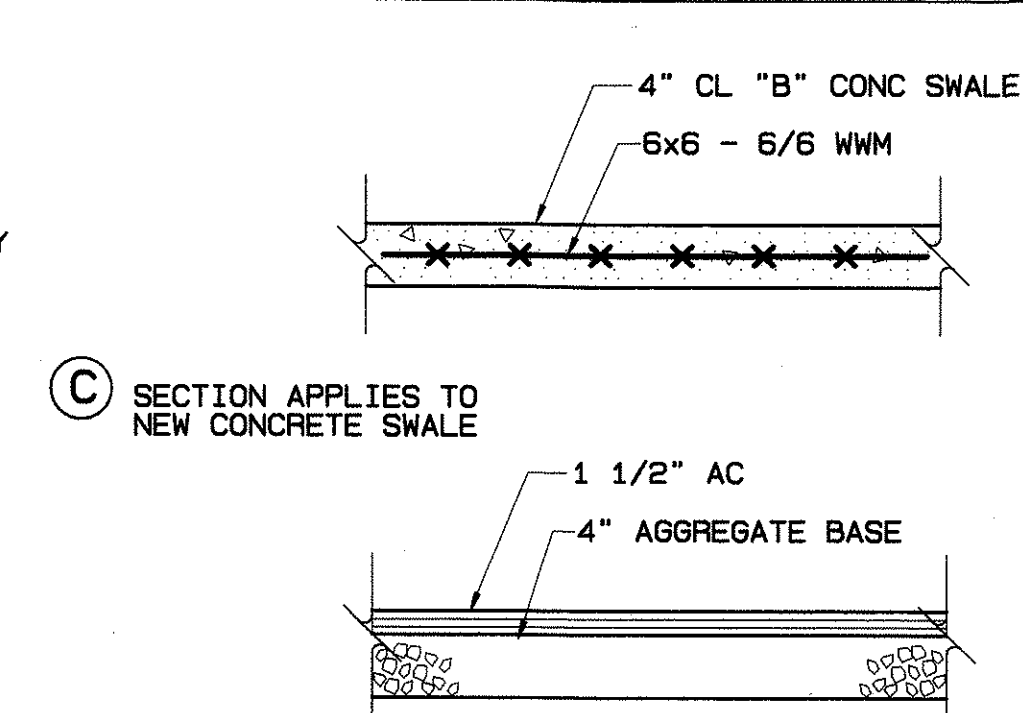


AT **SECTIONS**
SCALE: 1"=1'

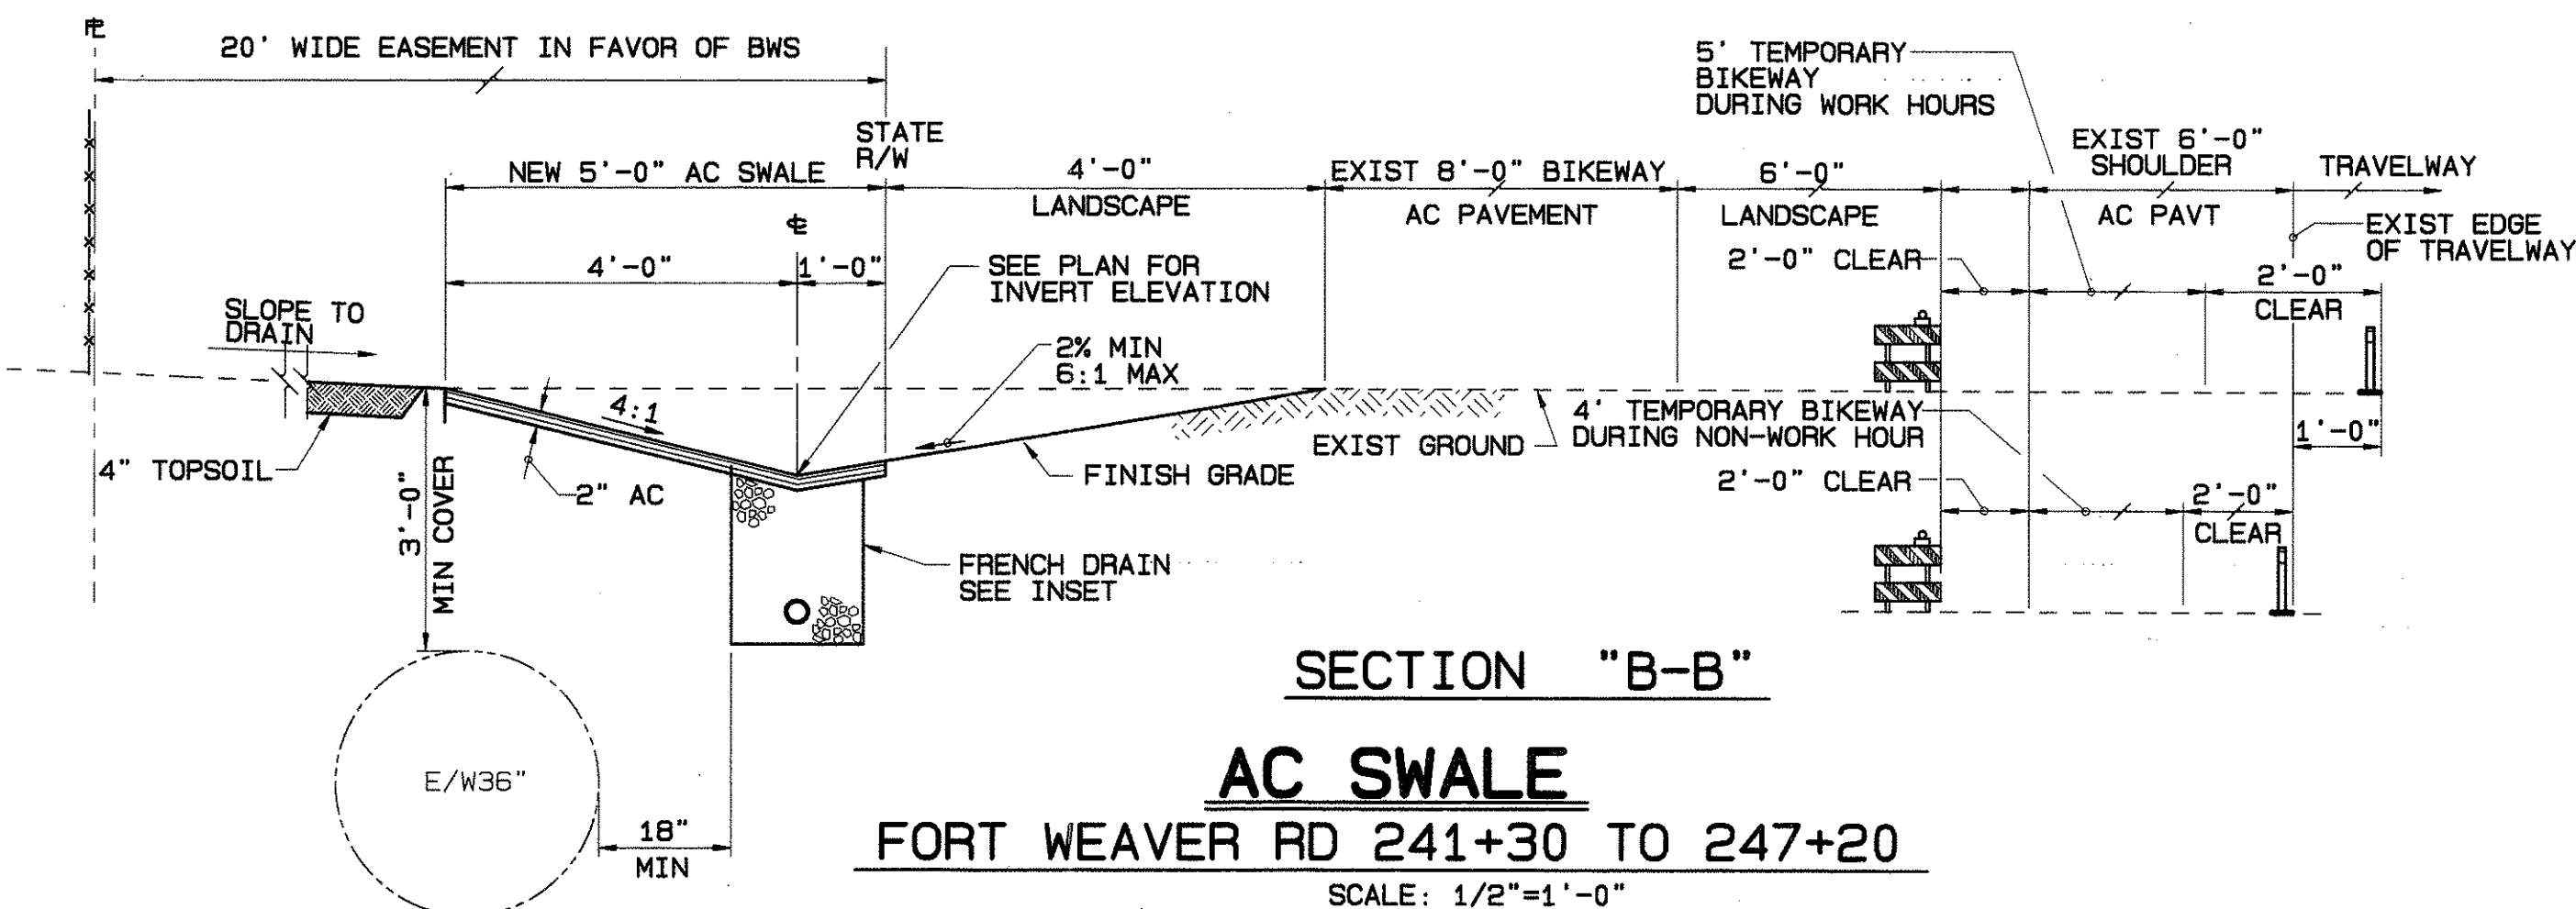

AC SWALE

FORT WEAVER RD 241+30 TO 247+20

SCALE: 1/2"=1'-0"

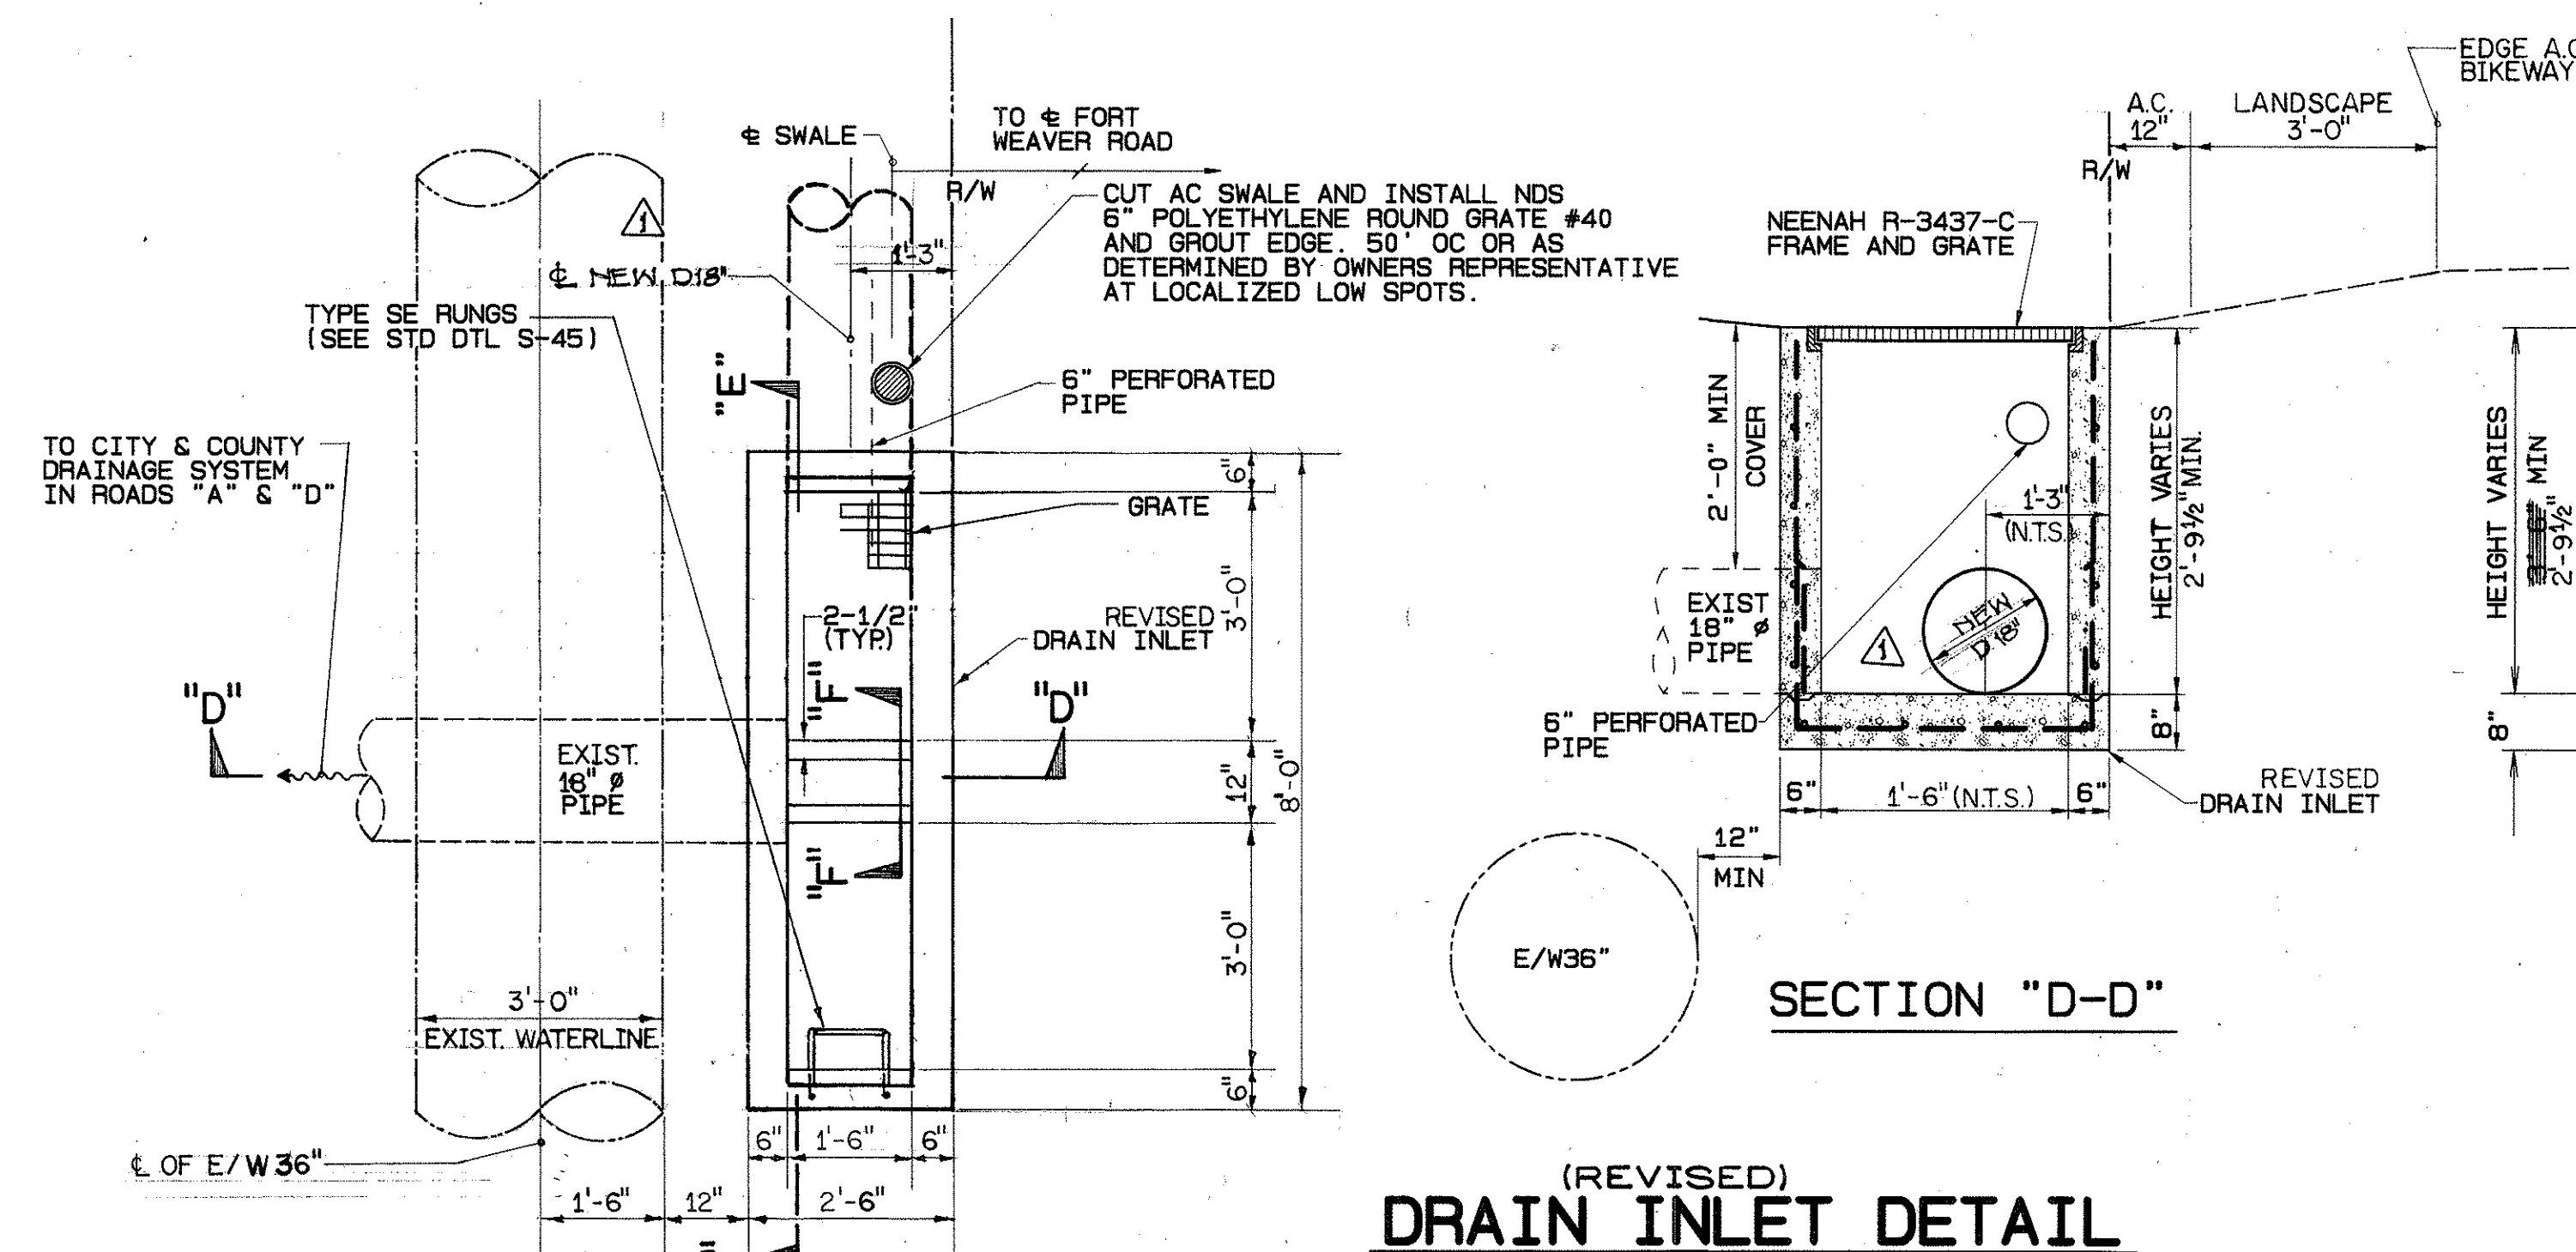


SECTION "D-D"

(REVISED)
DRAIN INLET DETAIL

(DRAIN INLET & 18" DIA. DRAIN PIPE @ RD A & D)

FORT WEAVER RD 241+30 TO 247+20

SCALE: 1/2"=1'-0"

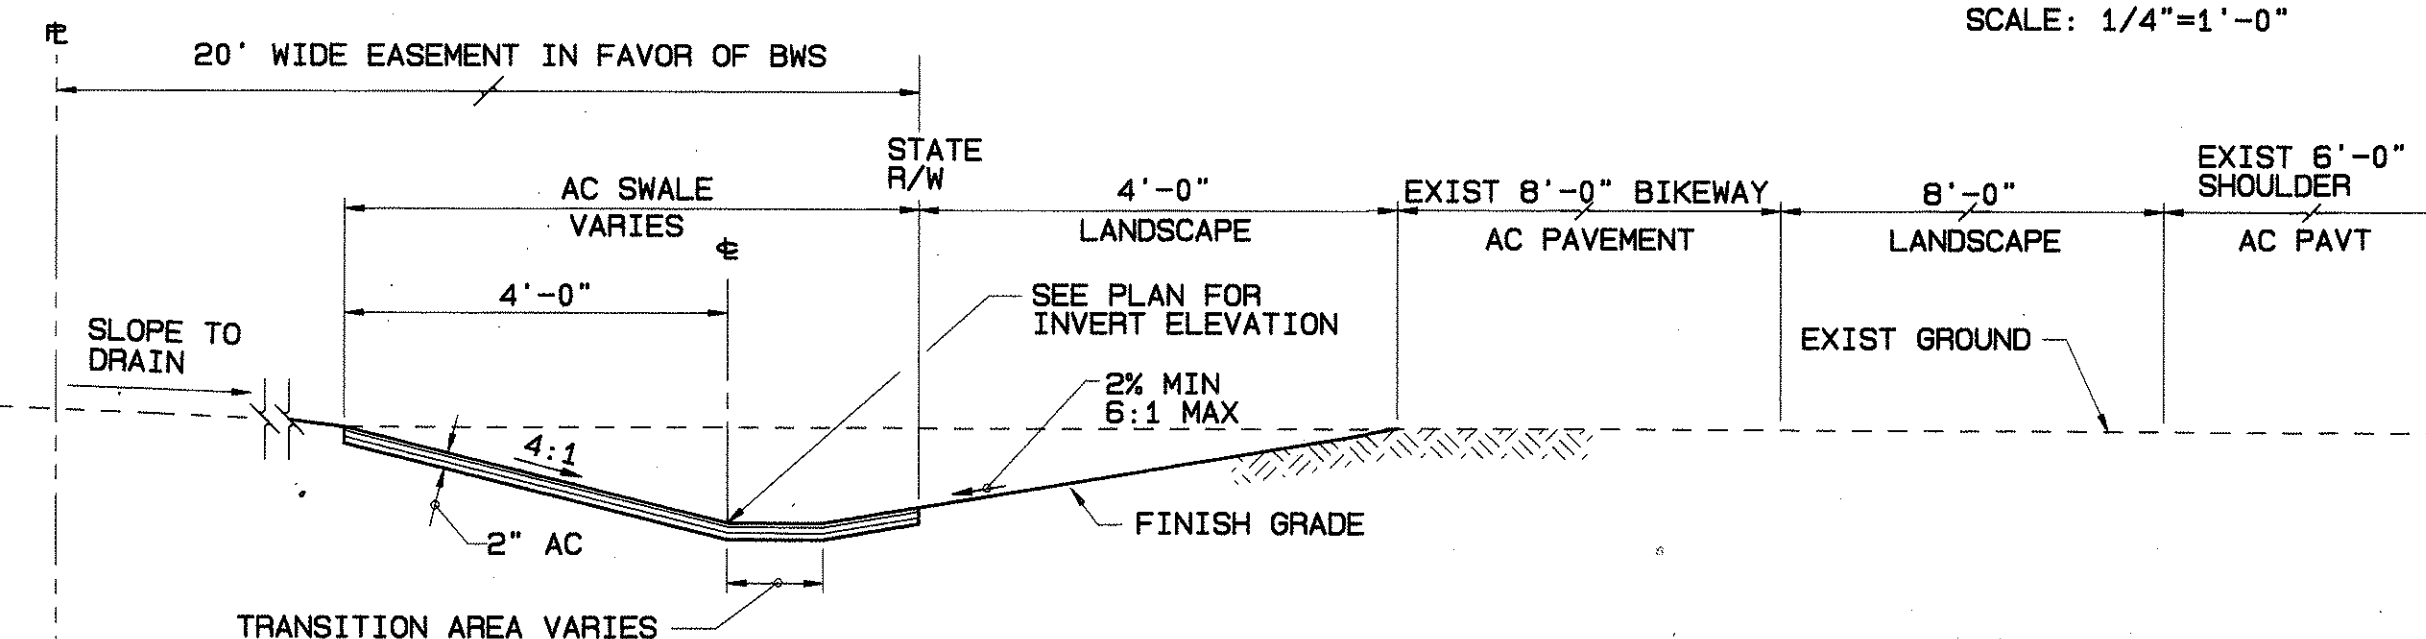


SECTION "C-C"

AC SWALE TRANSITION

FORT WEAVER RD 242+49.42 TO 242+69.42

FORT WEAVER RD 244+49.97 TO 244+69.97


SCALE: 1/2"=1'-0"

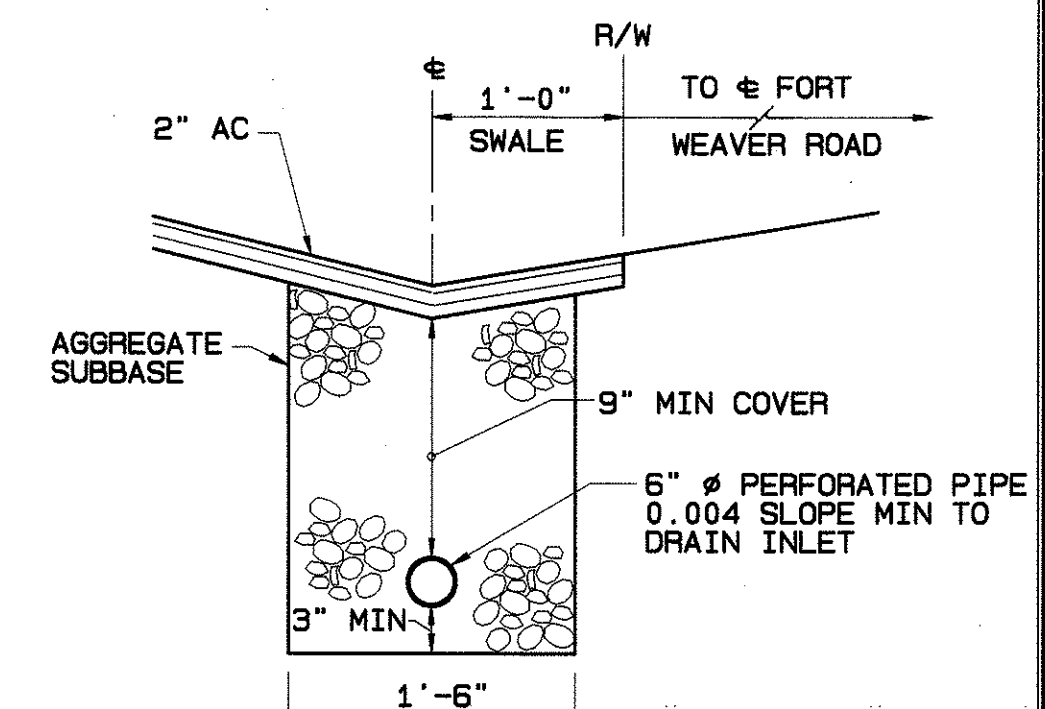

INSET - FRENCH DRAIN

SCALE: 1"=1'-0"

△				
△				
△	6/5/86	REV. AC/CONC. SNAIL TRANSITION AND ADDED NEW D/S TO DRAIN INLET.	EM	JOT
Rev	Date	Description	Eng	App

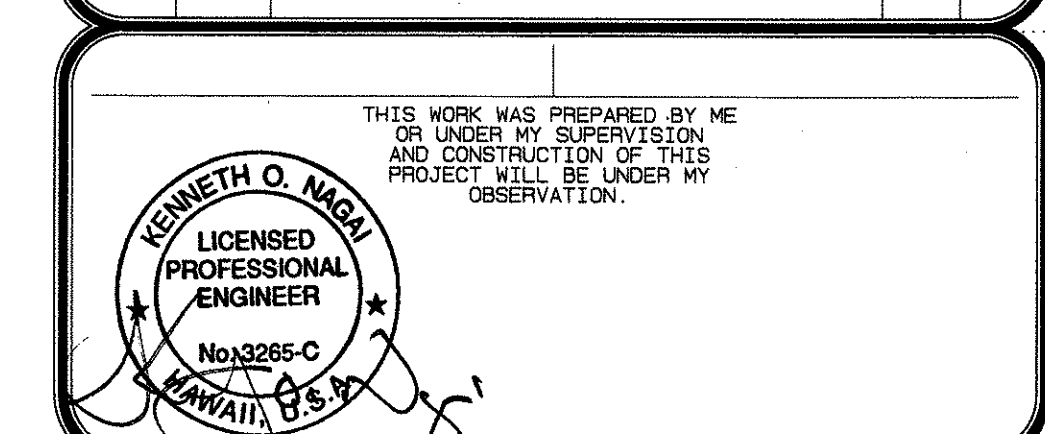

BELT COLLINS ENGINEERING
PLANNING
LANDSCAPE

H A W A I I LANDSCAPE ARCHITECTURE
680 Ala Moana Blvd. First Floor Honolulu, Hawaii 96813 **ENVIRONMENTAL**
Phone: (808) 521-5361 Fax: (808) 538-7819 **CONSULTING**

Consultant:

Client: **GENTRY DEVELOPMENT CO.,
A HAWAII LIMITED PARTNERSHIP
P.O. BOX 295
HONOLULU, HAWAII 96809**

FORT WEAVER DRAINAGE
DRAINAGE DETAILS

Designed By: TO Drawn By: DA
Project No. 233.0601.2 Date: SEPTEMBER 1995

Approved By: *D. D. Smith* 10/4/95
CHIEF, DIVISION OF ENGINEERING, DEPARTMENT OF PUBLIC WORKS Date
(FOR GRADING ONLY) 65

for W. W. W. W. W. 9/28/95
CHIEF PLANNING & ENGINEER, BOARD OF WATER SUPPLY, City and County of Honolulu, HI Date

Date _____

_____ Date _____

FILE	POCKET	FOLDER	NO.

AC SWALE TRANSITION

FORT WEAVER RD 242+49.42 TO 242+69.42
FORT WEAVER RD 244+49.97 TO 244+69.97

SCALE: 1/4"=1'-0"

Project No. PMT-76A-02-98

RECORD DRAWINGS

SHEET C-4 of 5 Sheets

FILE	POCKET	FOLDER	NO.