


FED. ROAD DIST. NO.	STATE	FED. AID PROJ. NO.	FISCAL YEAR	SHEET NO.	TOTAL SHEETS
HAWAII	HAW.	STP-076-1(4)	1999	C.O. 13	31

PLANT LIST & MISCELLANEOUS


QUANTITY	COMMON / BOTANICAL NAME	SIZE & REMARKS
120	GEIGER TREE / CORDIA SEBESTENA	25 GAL. CAN, 8-10' HT., 3-4' SPD., 2" CAL.
8	HAWAIIAN KOU / CORDIA SUBCORDATA	25 GAL. CAN, 8-10' HT., 3-4' SPD., 2" CAL.
32	KALAMONA / CASSIA GLAUCA	25 GAL. CAN, 8-10' HT., 3-4' SPD., 2" CAL.
178	MANILA PALM / VEITCHIA MERRILLII	25 GAL. CAN, 8' OVERALL HT.
121	SILVER BUTTONWOOD / CONOCARPUS ERECTUS 'SERICEUS'	25 GAL. CAN, 8-10' HT., 3-4' SPD., 2" CAL.
537	SPIDER LILY / CRINUM ASIATICUM	5 GAL. CAN, 36" HT., 30" SPD.
1,200	BEACH NAUPAKA / SCAEVOLA FRUTESCENS	2 GAL. CAN, 24" HT., 18" SPD., @ 2' O.C.
205	'HULA GIRL' HIBISCUS / HIBISCUS SP.	2 GAL. CAN, 24" HT., 18" SPD., @ 2' O.C.
1,640	'SALMON' HIBISCUS / HIBISCUS SP.	2 GAL. CAN, 24" HT., 18" SPD., @ 2' O.C.
130	'NAIROBI' HIBISCUS / HIBISCUS SP.	2 GAL. CAN, 24" HT., 18" SPD., @ 2' O.C.
416	PLUMBAGO / PLUMBAGO CAPENSIS	2 GAL. CAN, 24" HT., 18" SPD., @ 2' O.C.
255	STAR JASMINE / JASMINUM MULTIFLORUM	2 GAL. CAN, 24" HT., 18" SPD., @ 2' O.C.
38,260	GOLDEN GLORY/ ARACHIS PINTOI	4" POTS @ 1'-0" O.C.
196,400 S.F.	COMMON BERMUDA GRASS / CYNODON DACTYLON	SEED WITH HYDROMULCH
150,000 S.F.	WEDELIA / WEDELIA TRILOBATA	CUTTINGS @ 12" O.C.
3,914 C.Y.	IMPORTED SCREENED SOIL	4" DEPTH
36 C.Y.	IMPORTED SCREENED SOIL	2.5' HIGH EARTH BERM
790 L.F.	POLY DIVIDER	

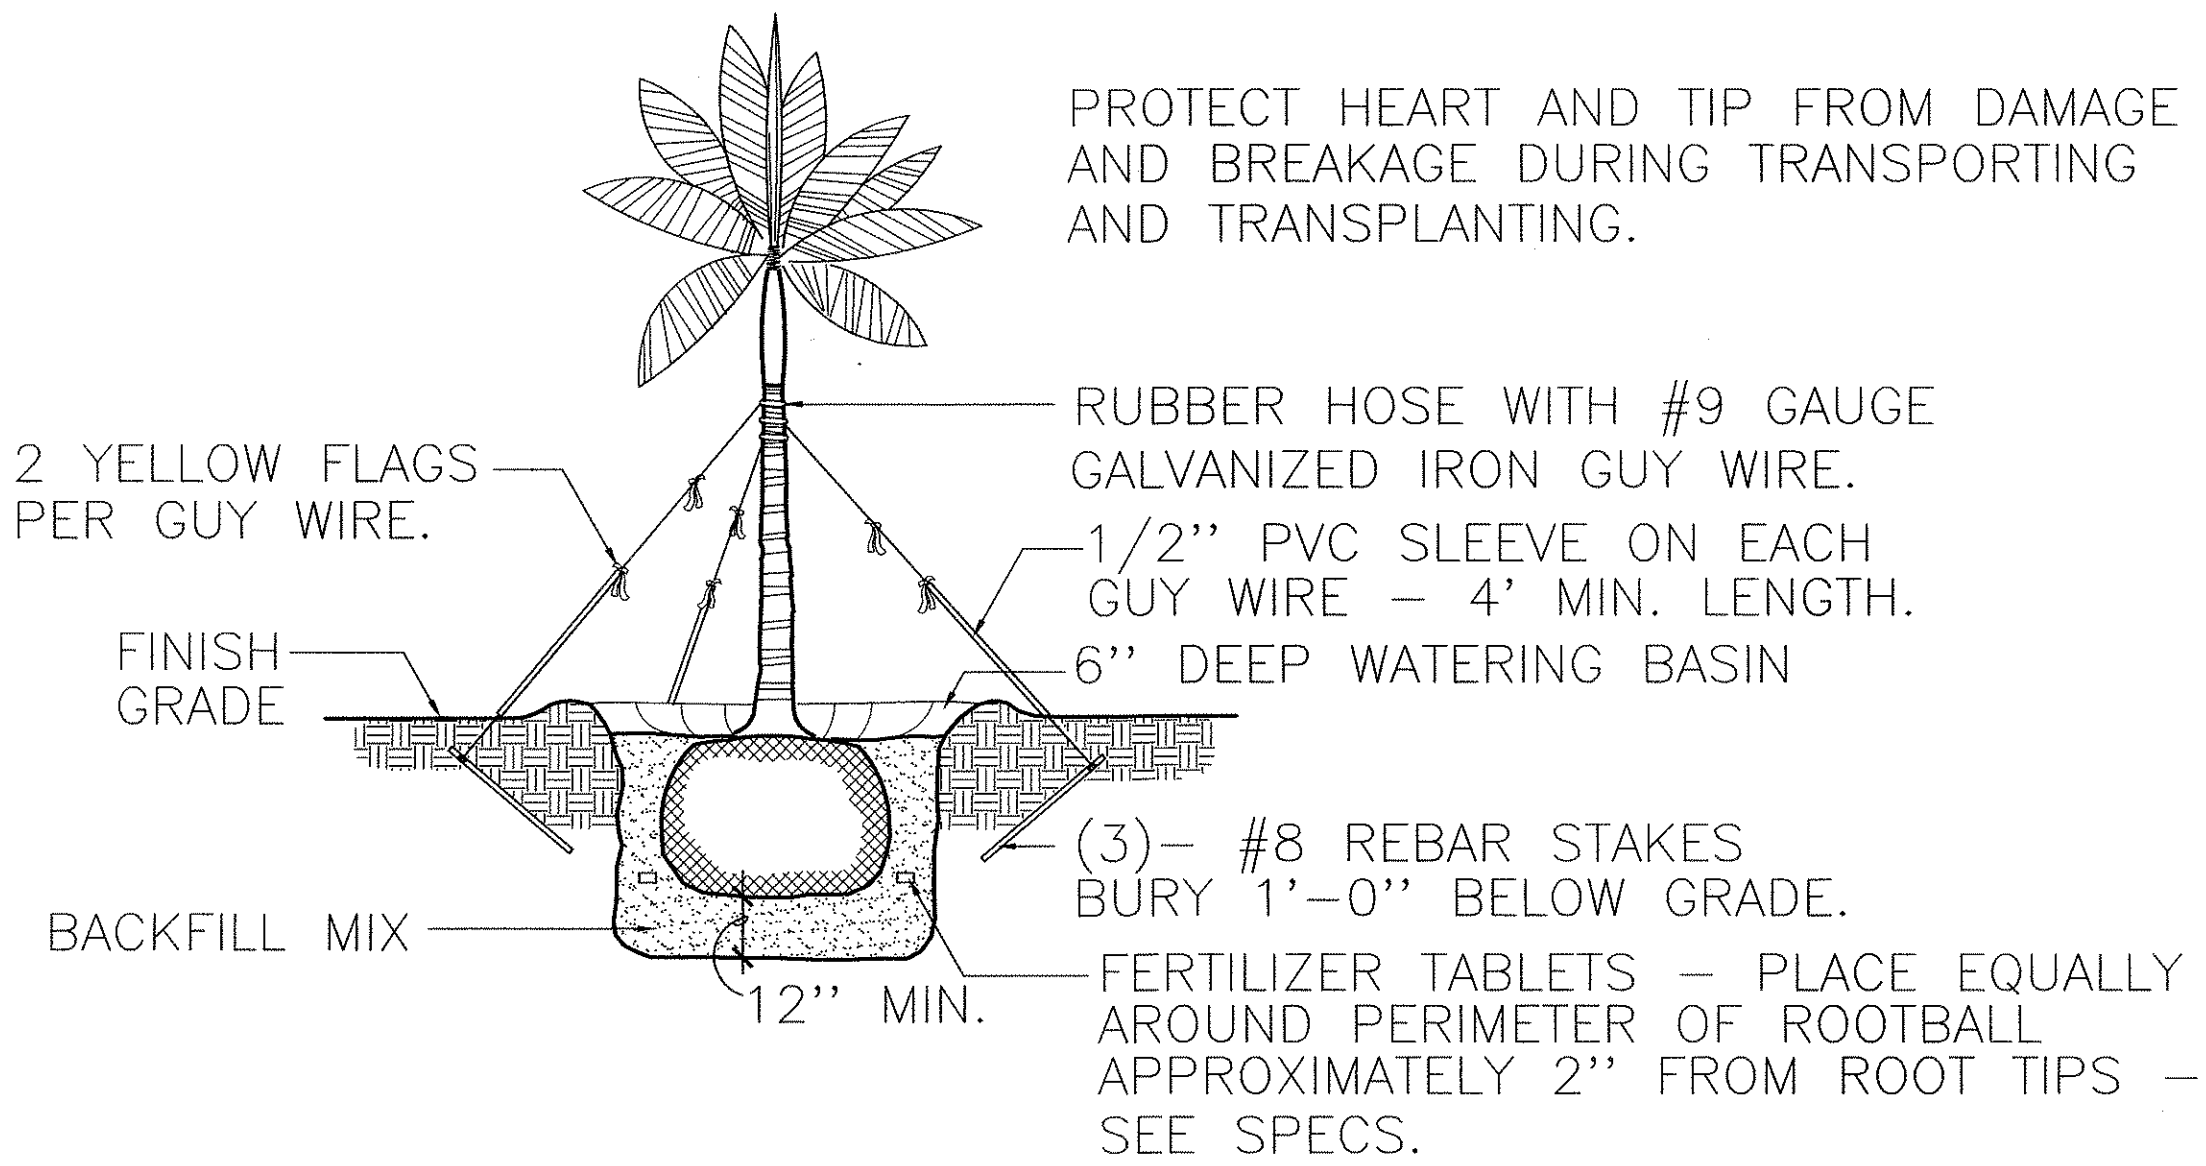

4 25 GALLON PALM PLANTING

L-13


NOT TO SCALE

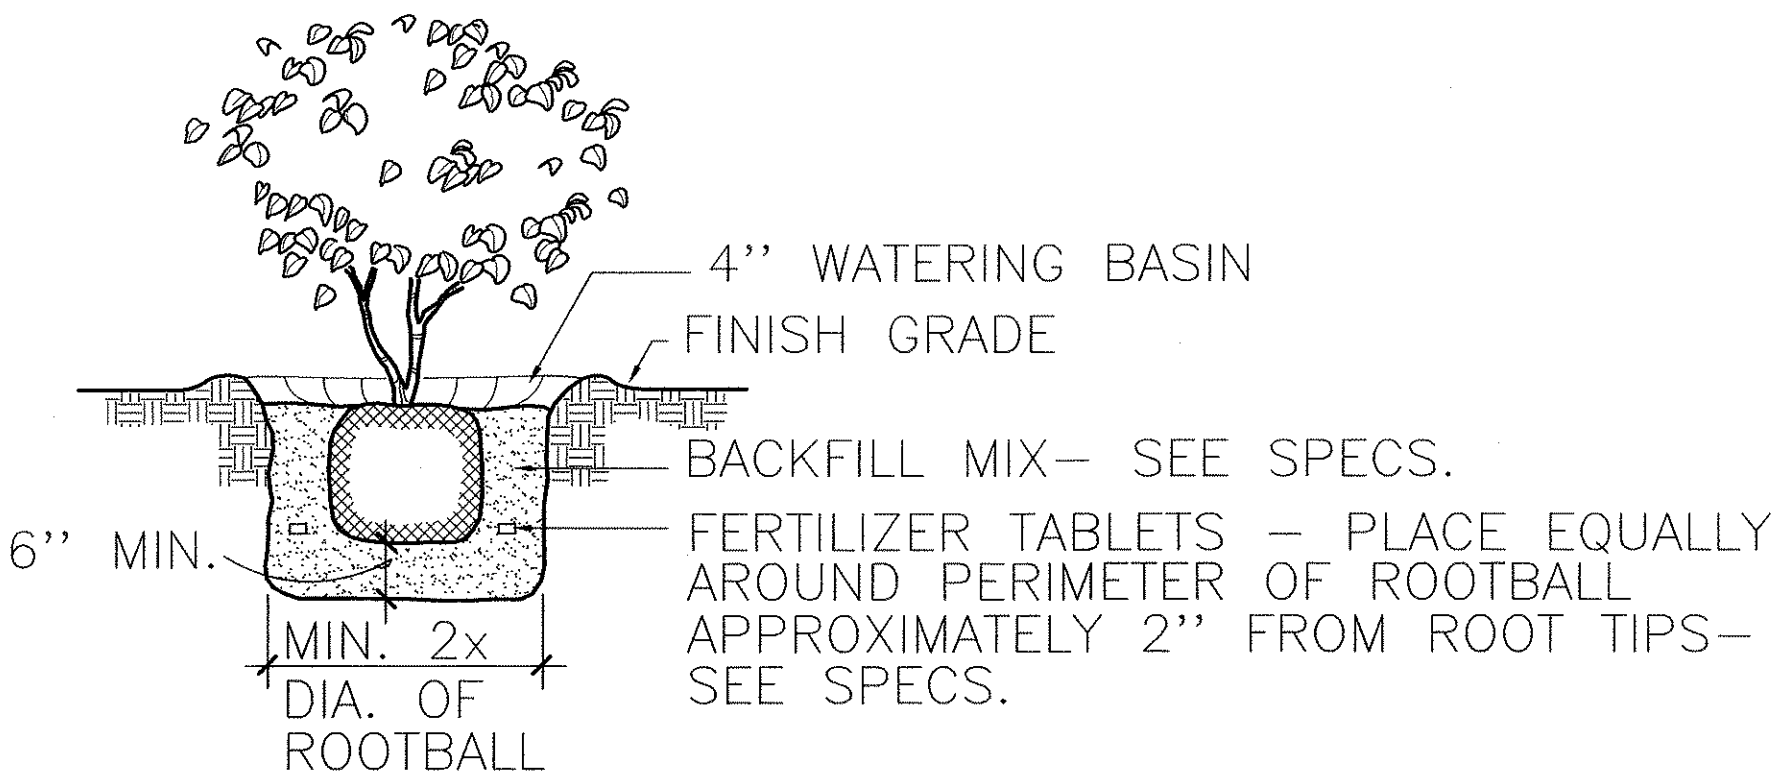

3 SHRUB PLANTING

L-13


NOT TO SCALE

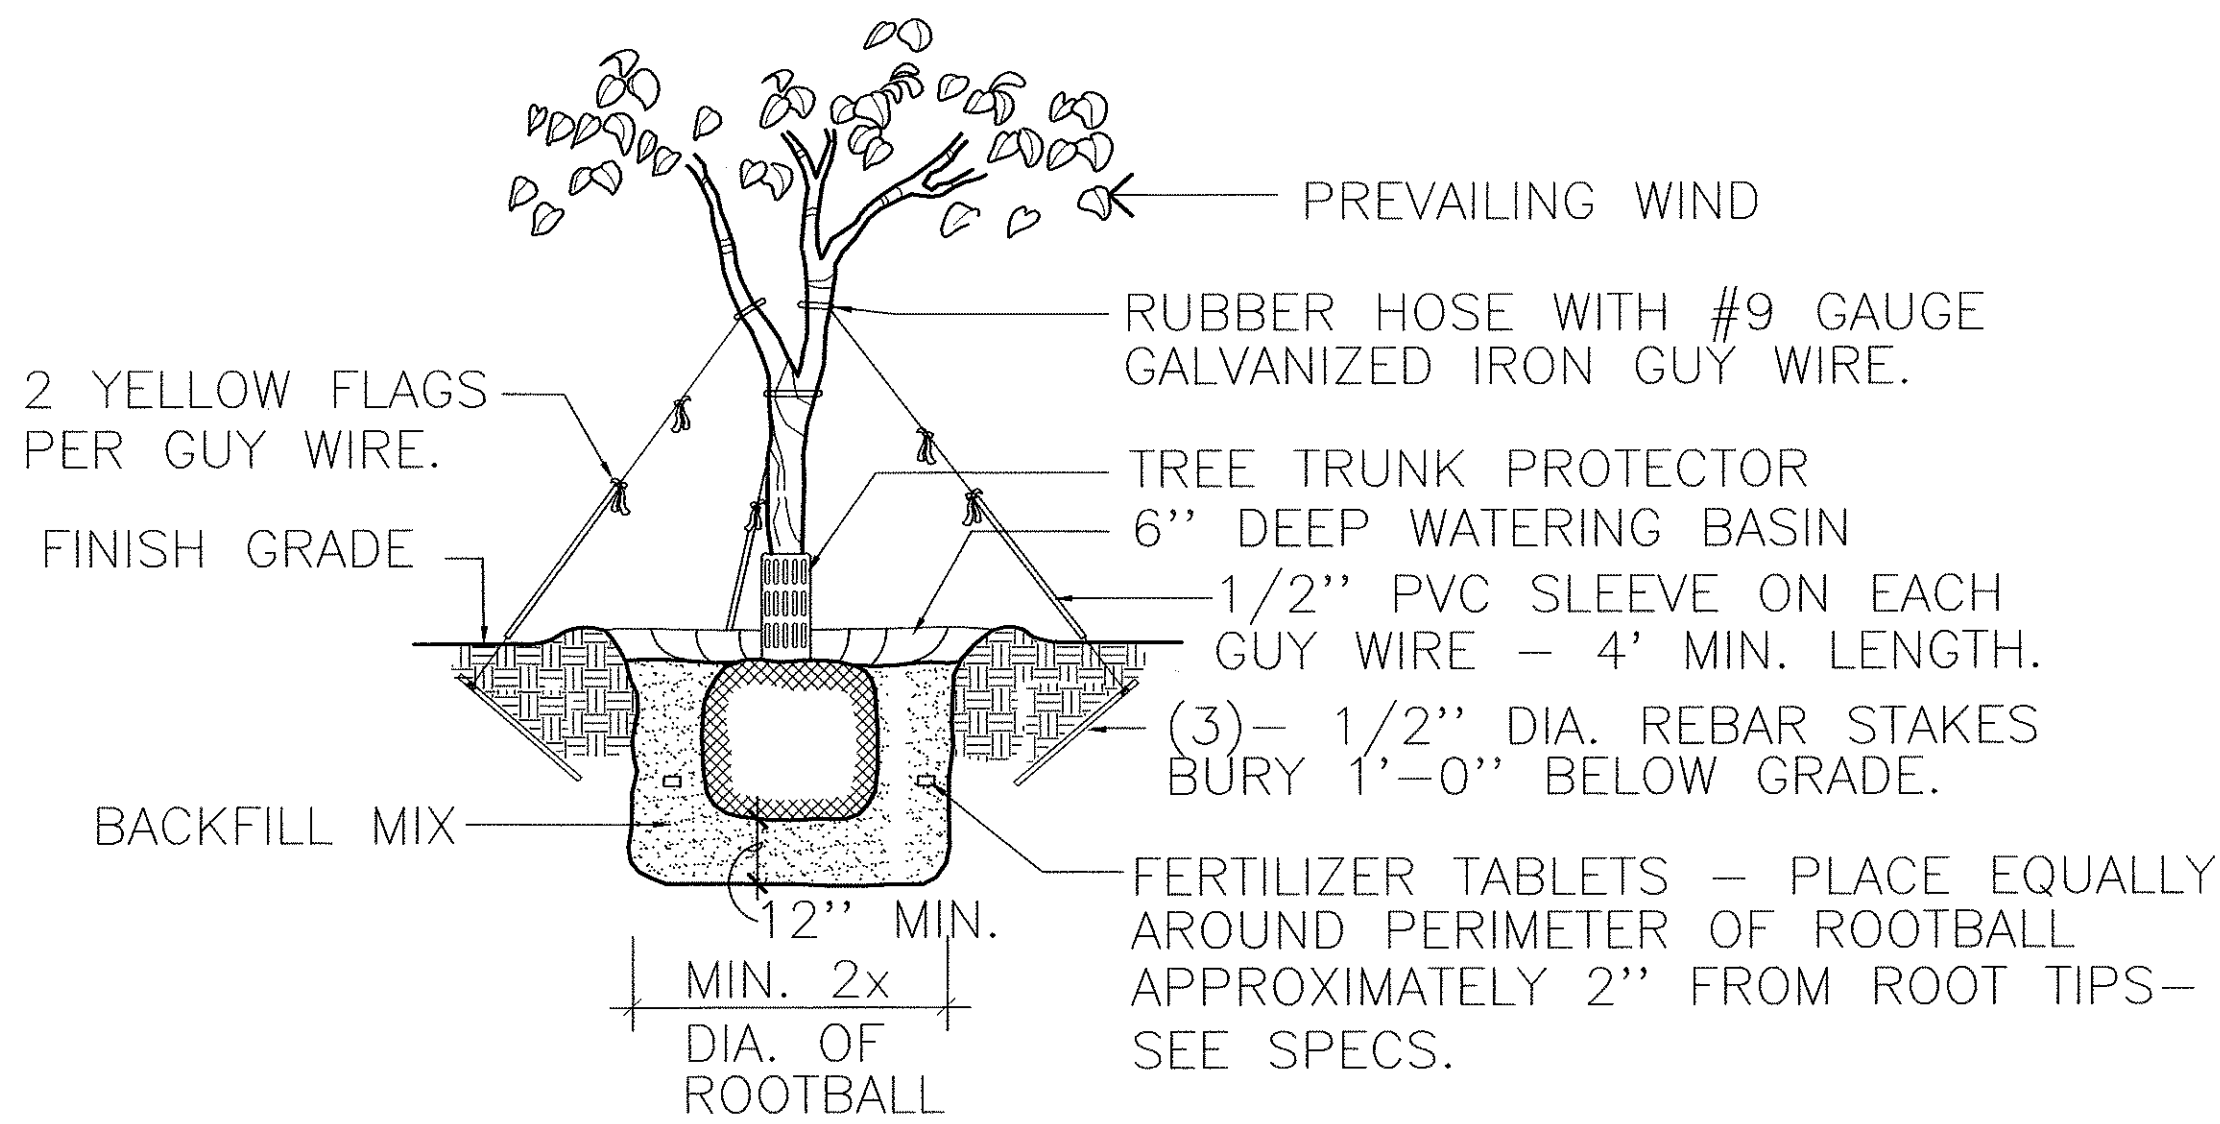

1 25 GALLON TREE PLANTING

L-13


NOT TO SCALE

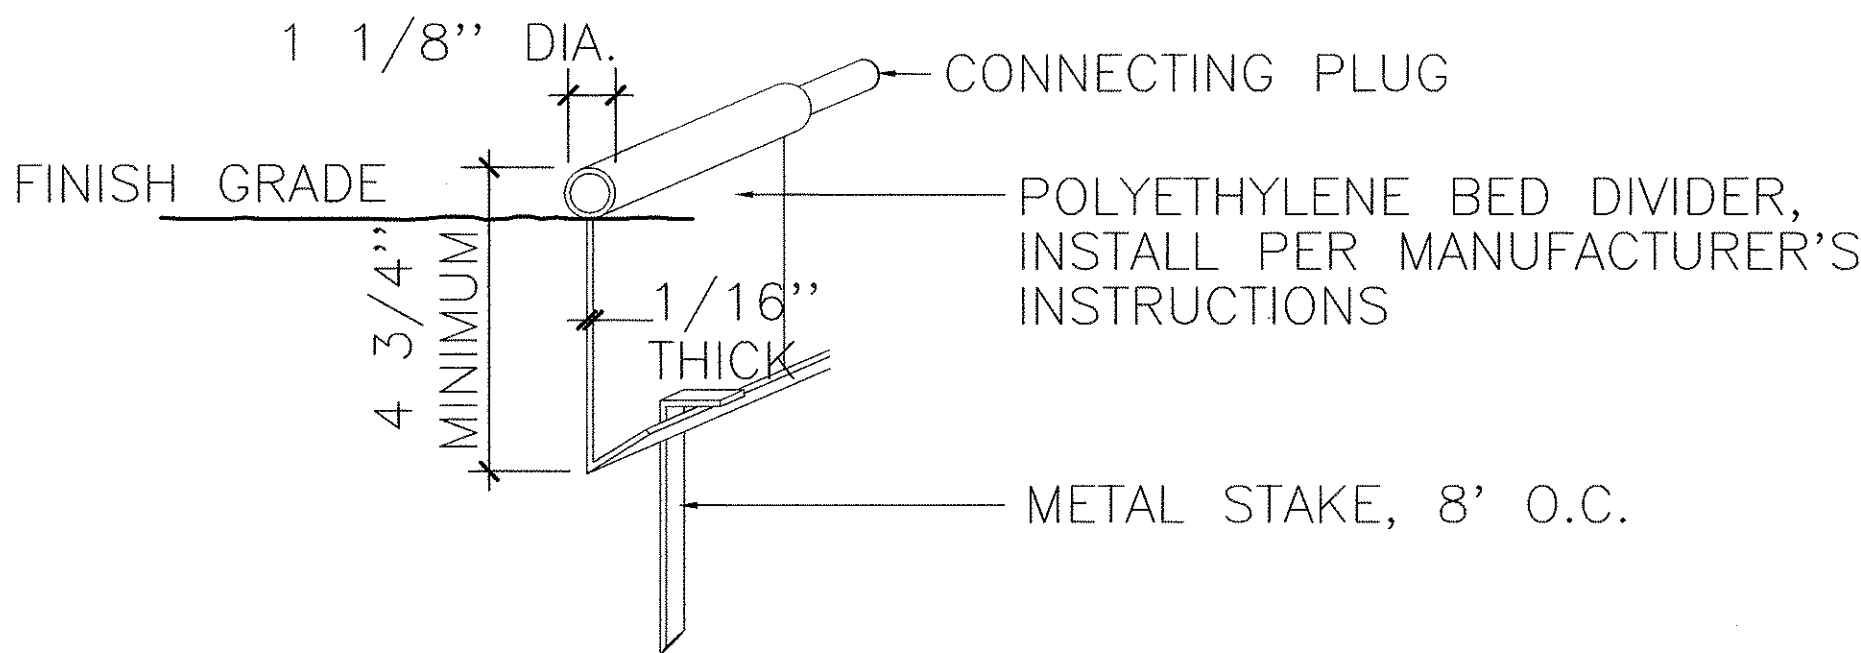

2 POLY DIVIDER

L-13

NOT TO SCALE

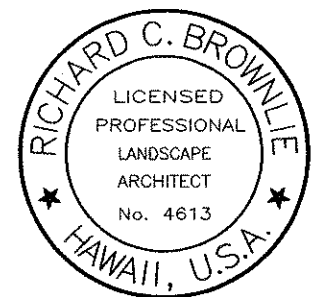

THIS WORK WAS PREPARED BY ME OR UNDER MY SUPERVISION.

1/18/2000	REVISED PLANT LIST
DATE	REVISION
STATE OF HAWAII DEPARTMENT OF TRANSPORTATION HIGHWAYS DIVISION	
LANDSCAPE PLANT LIST AND DETAILS	
FORT WEAVER ROAD LANDSCAPING VICINITY OF FARRINGTON HWY. TO HANAKAHI ST. PROJECT NO. STP-076-1(4)	
SCALE: N/A	DATE: AUGUST 10, 1998
SHEET No. 3 OF 5 SHEETS	