

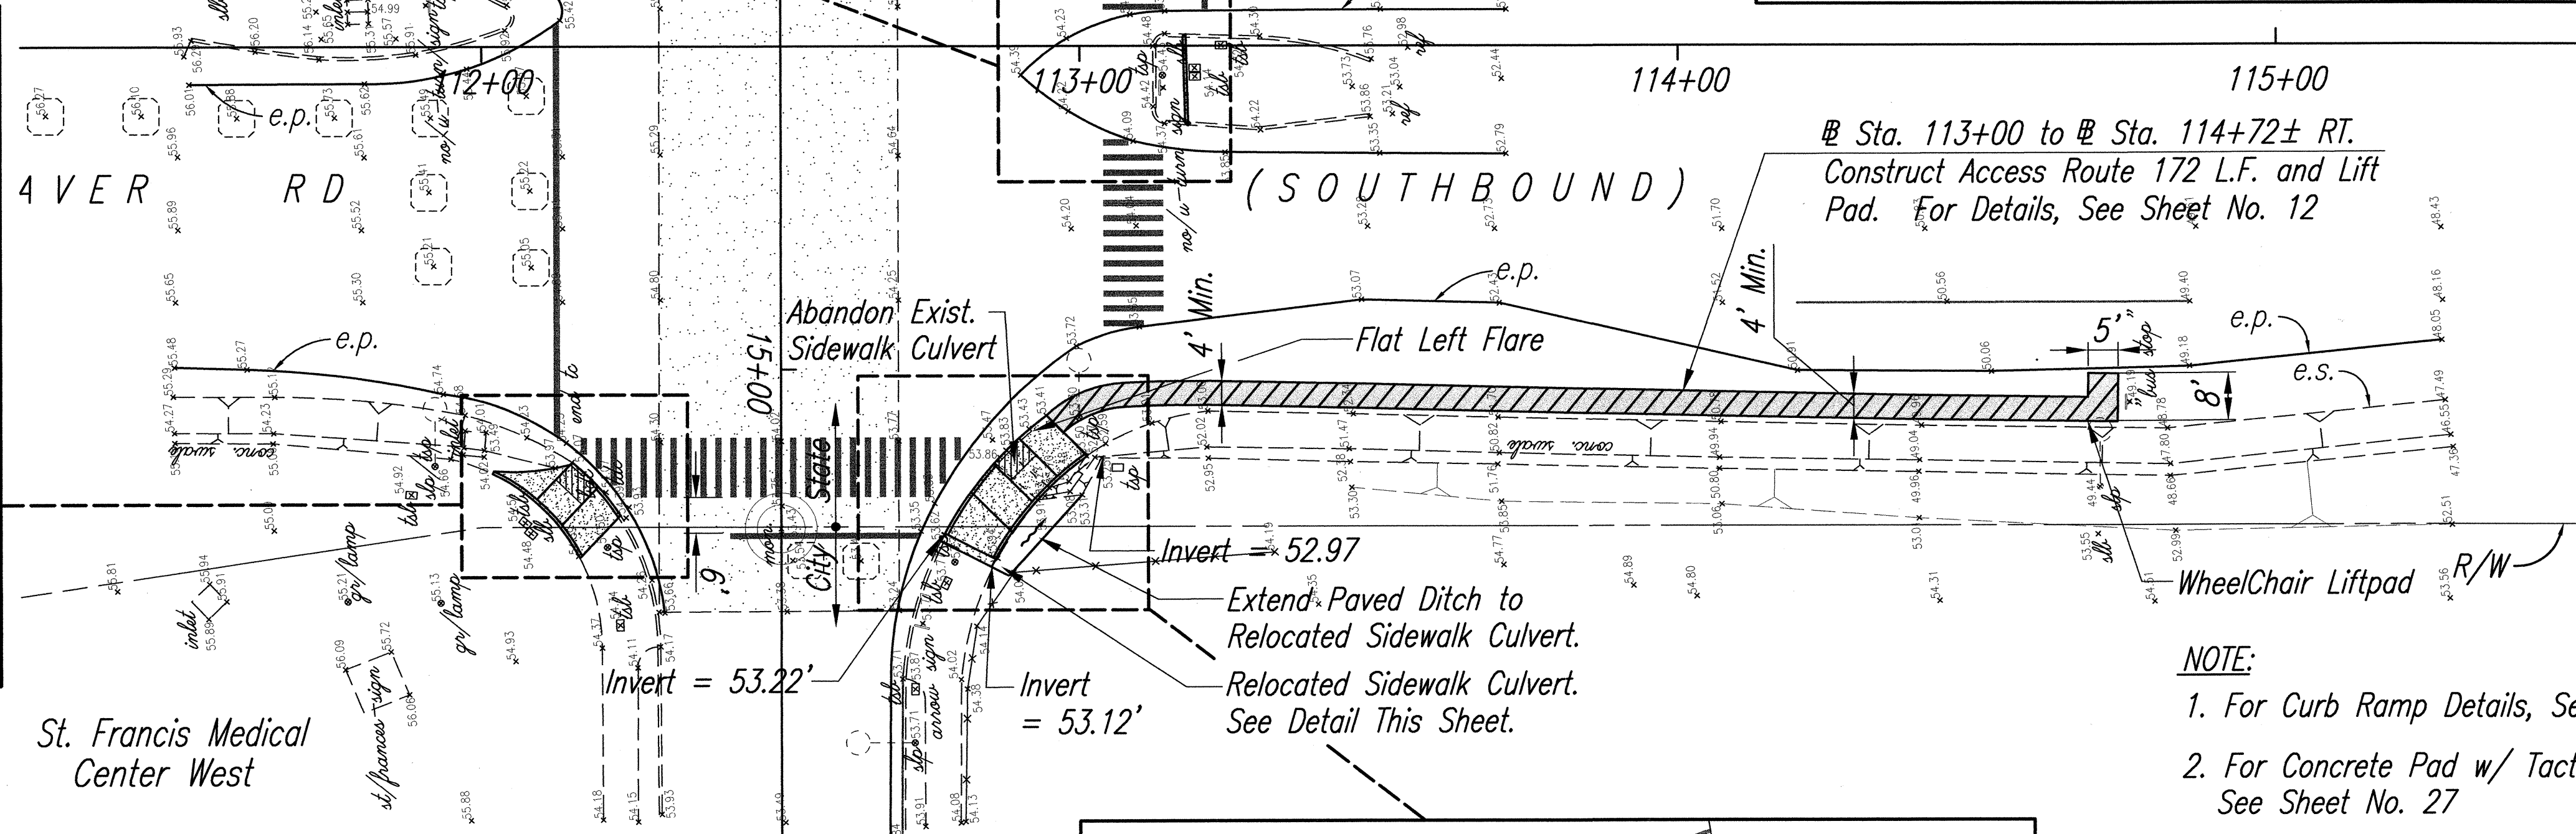
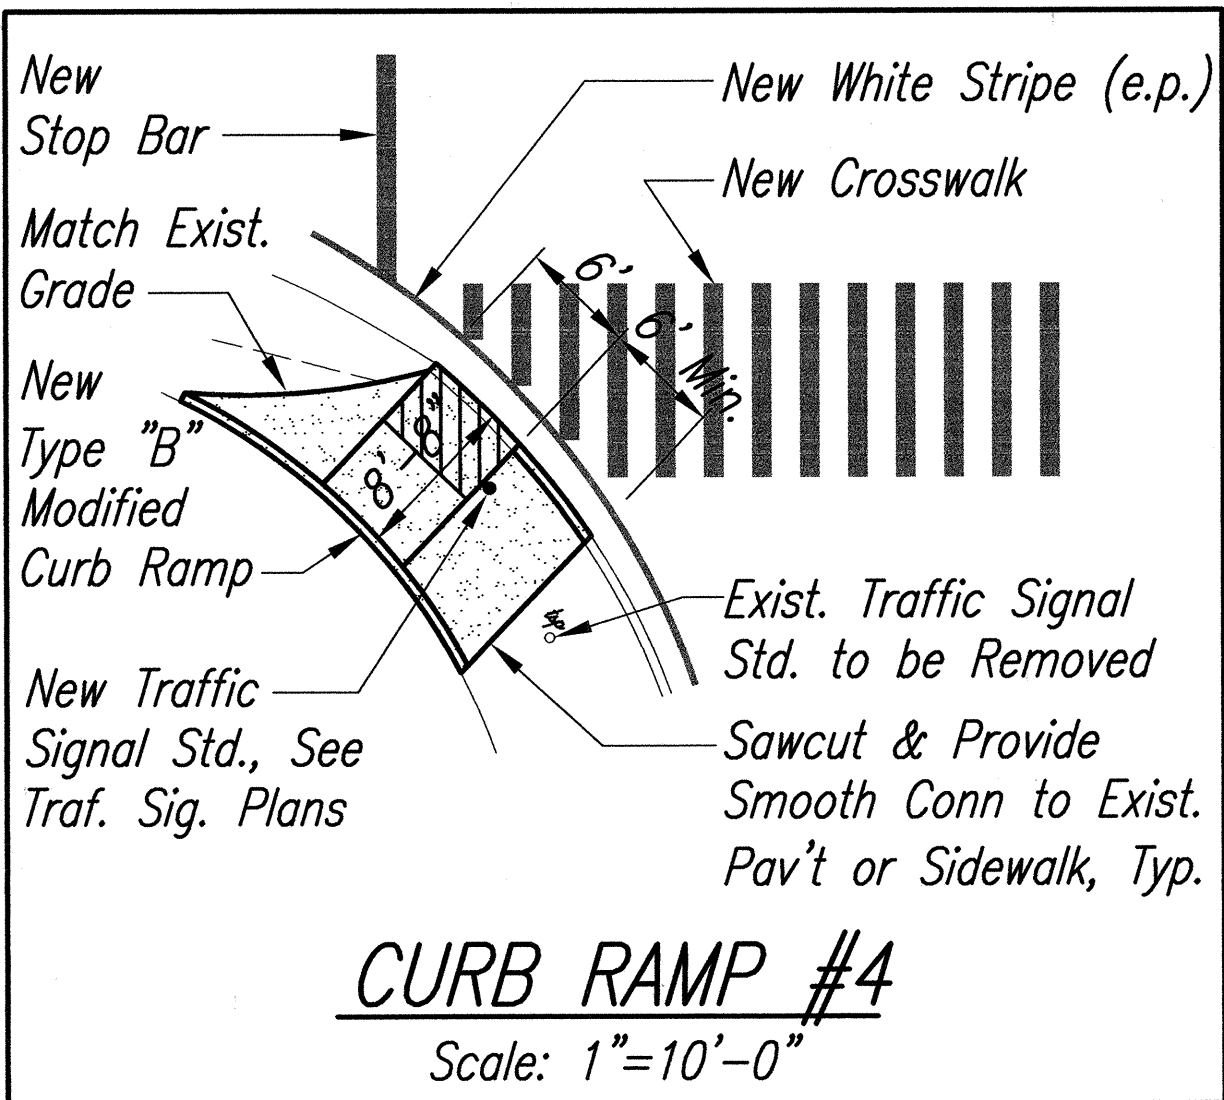
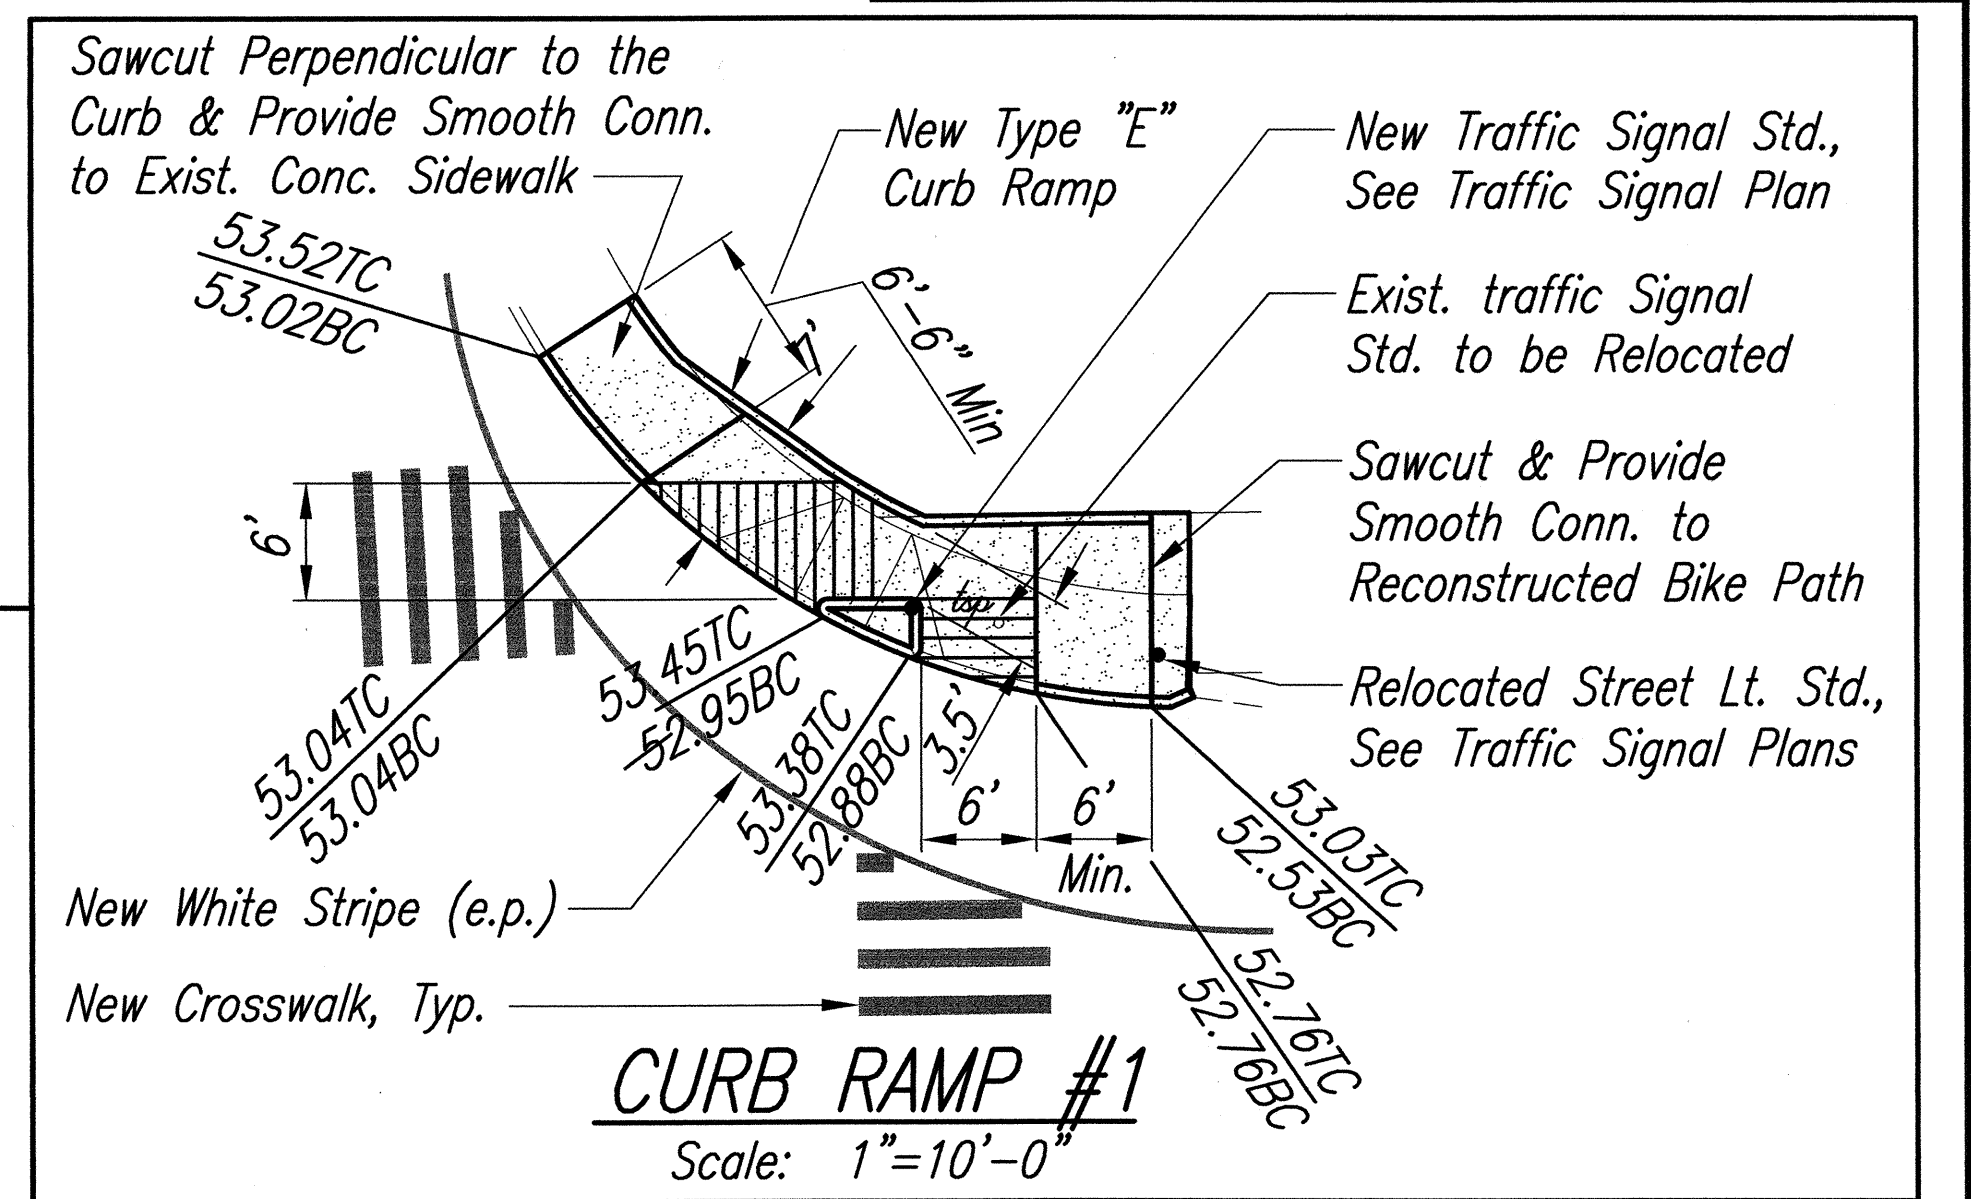
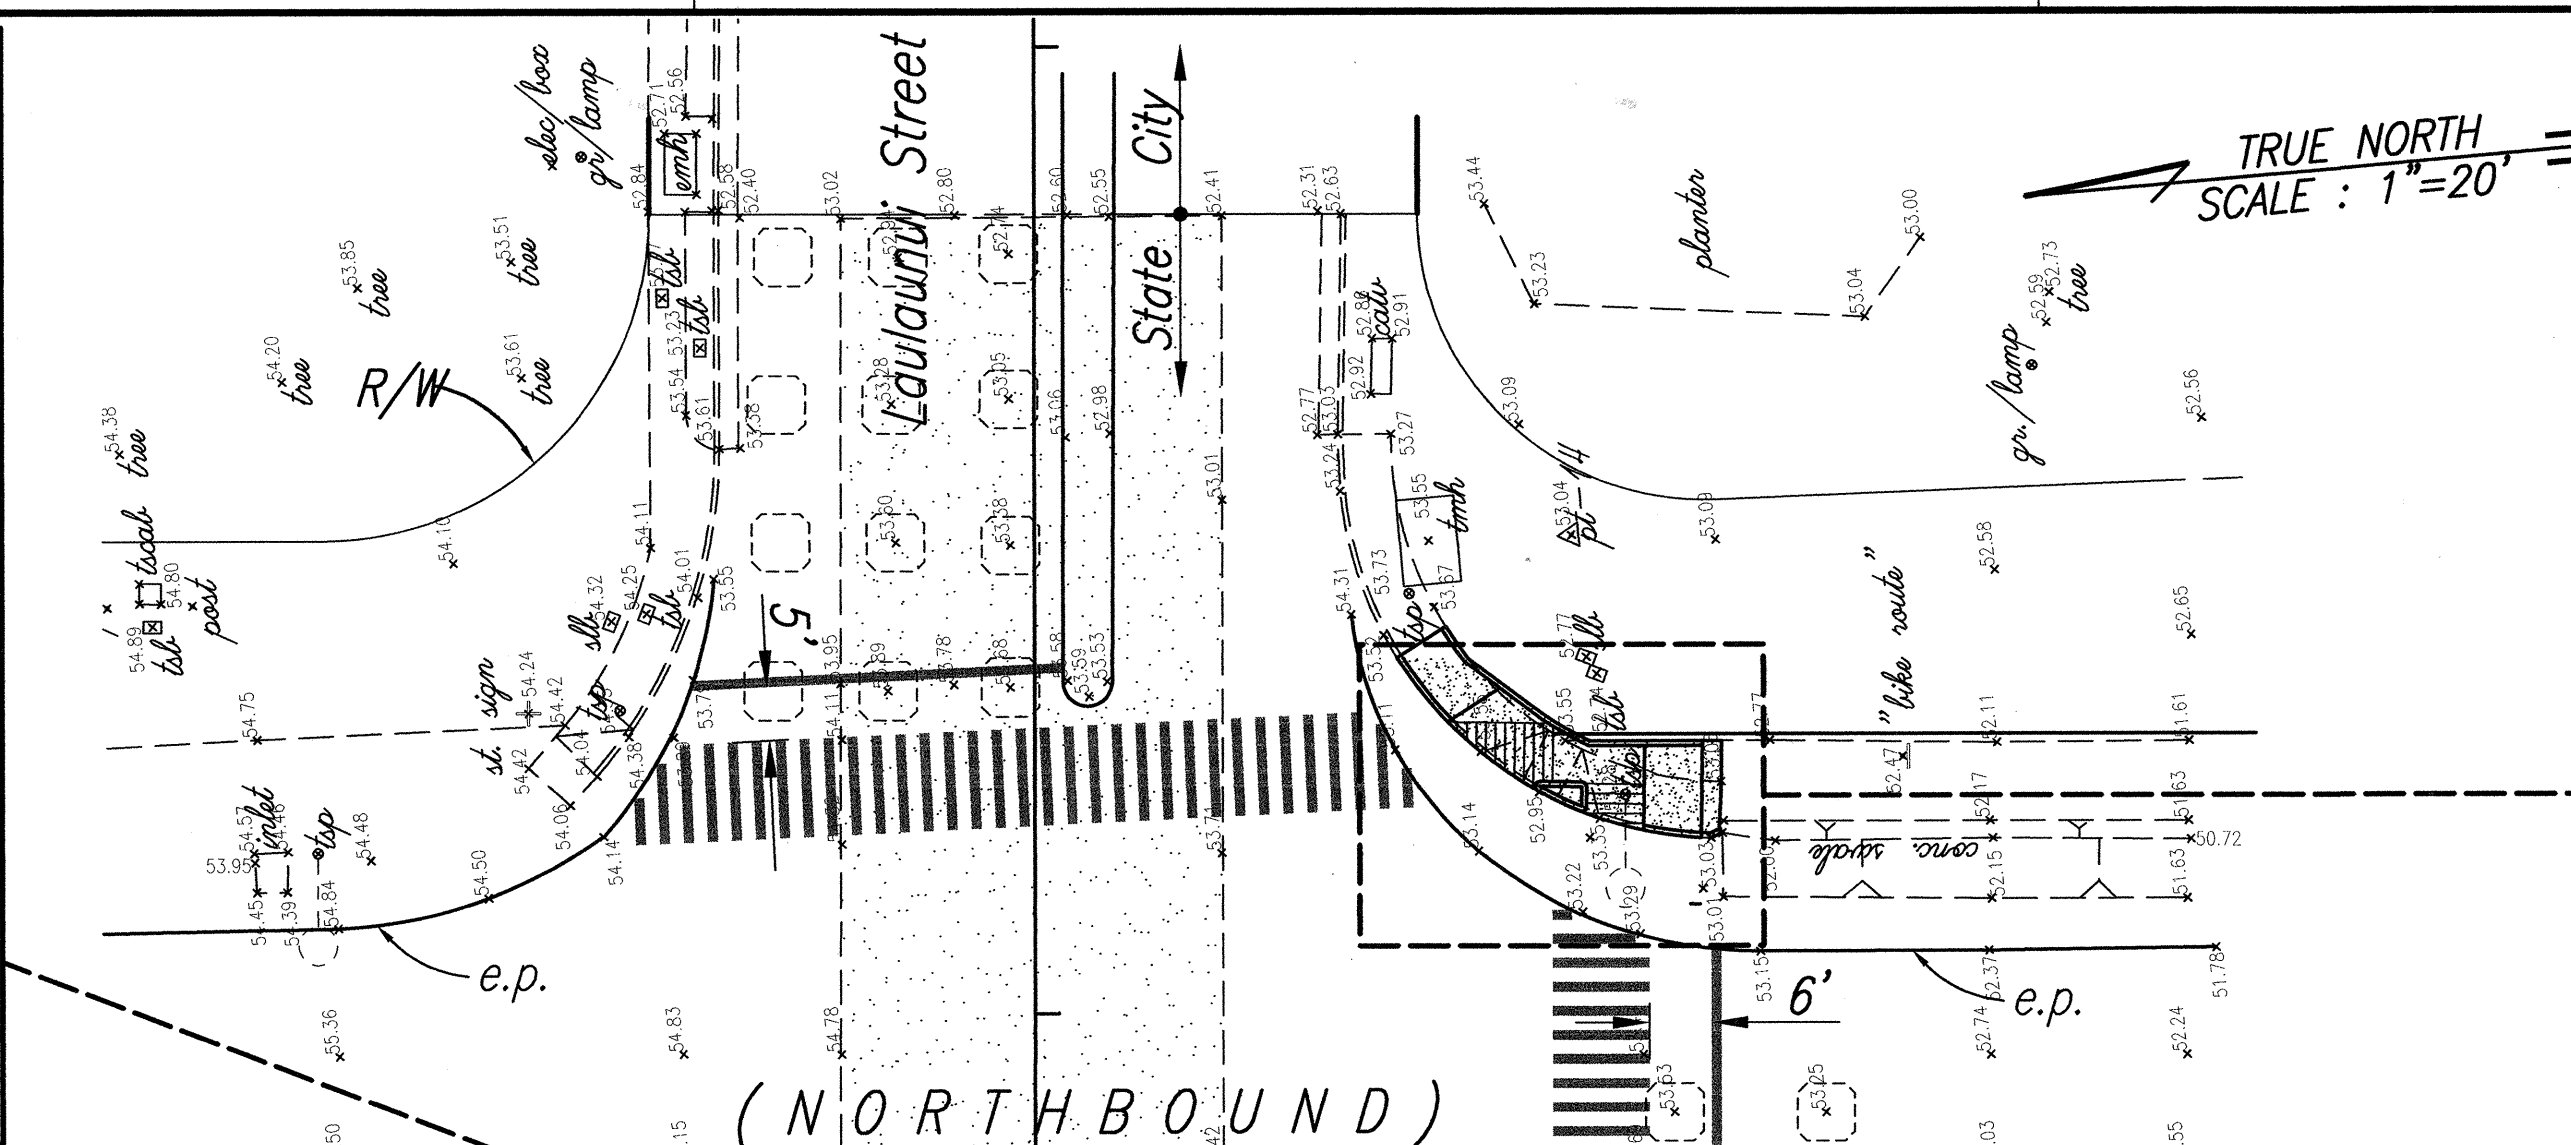
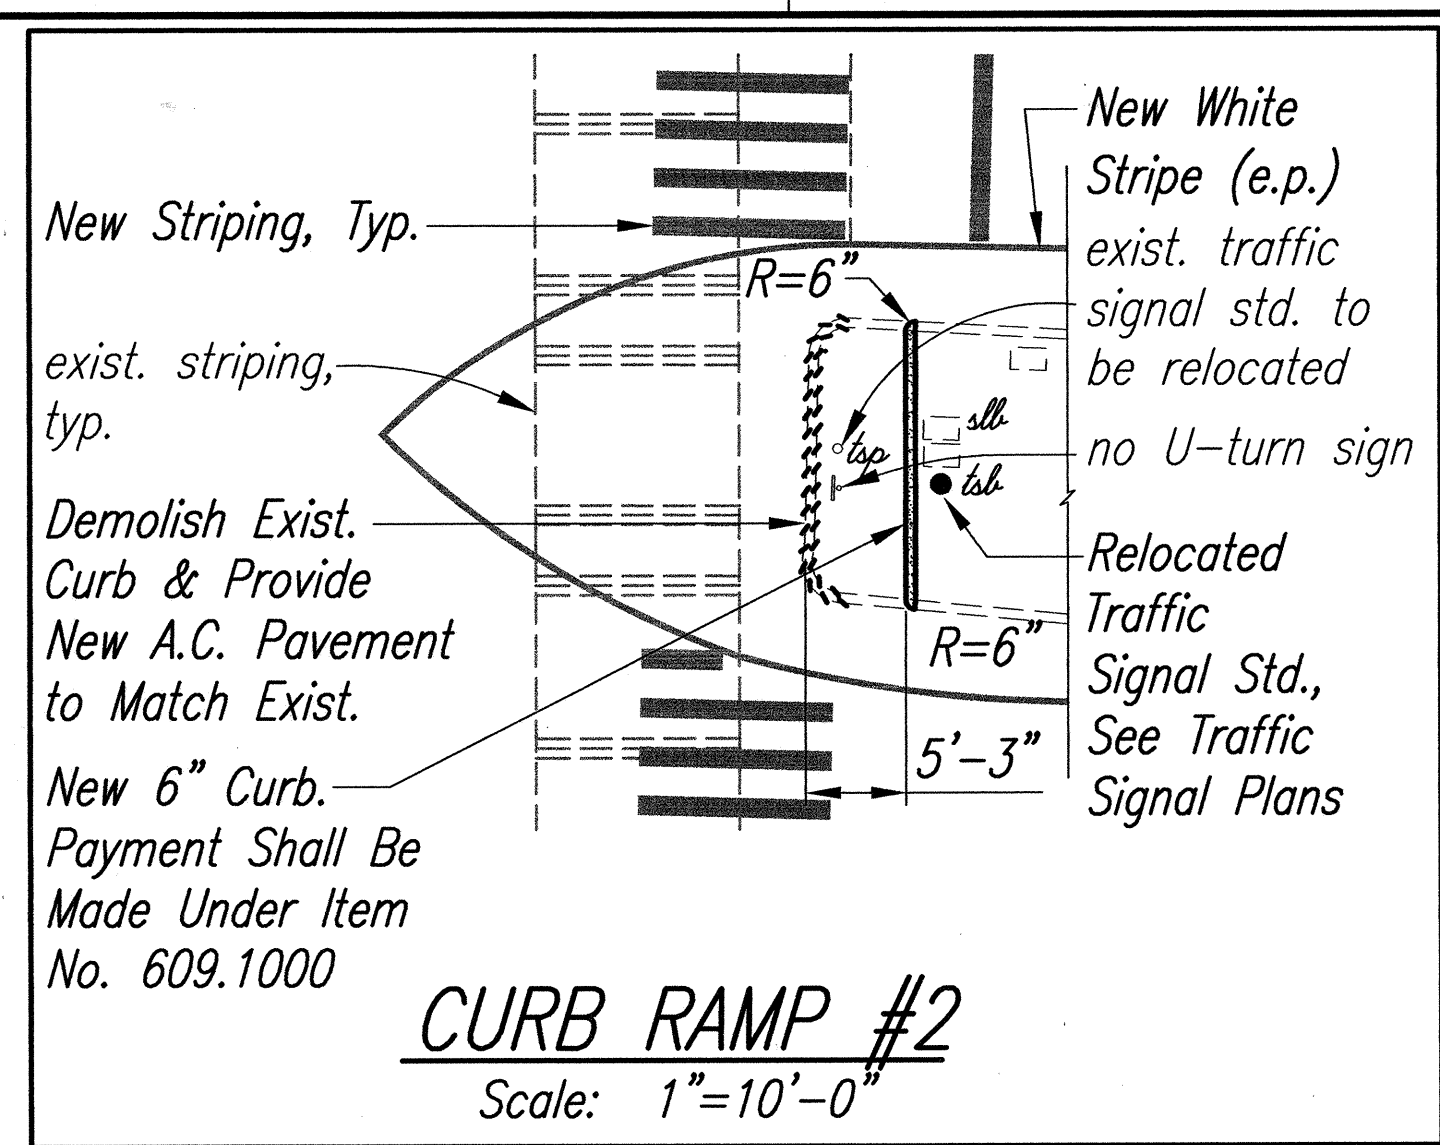
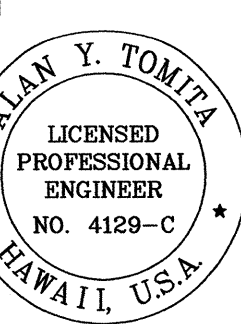
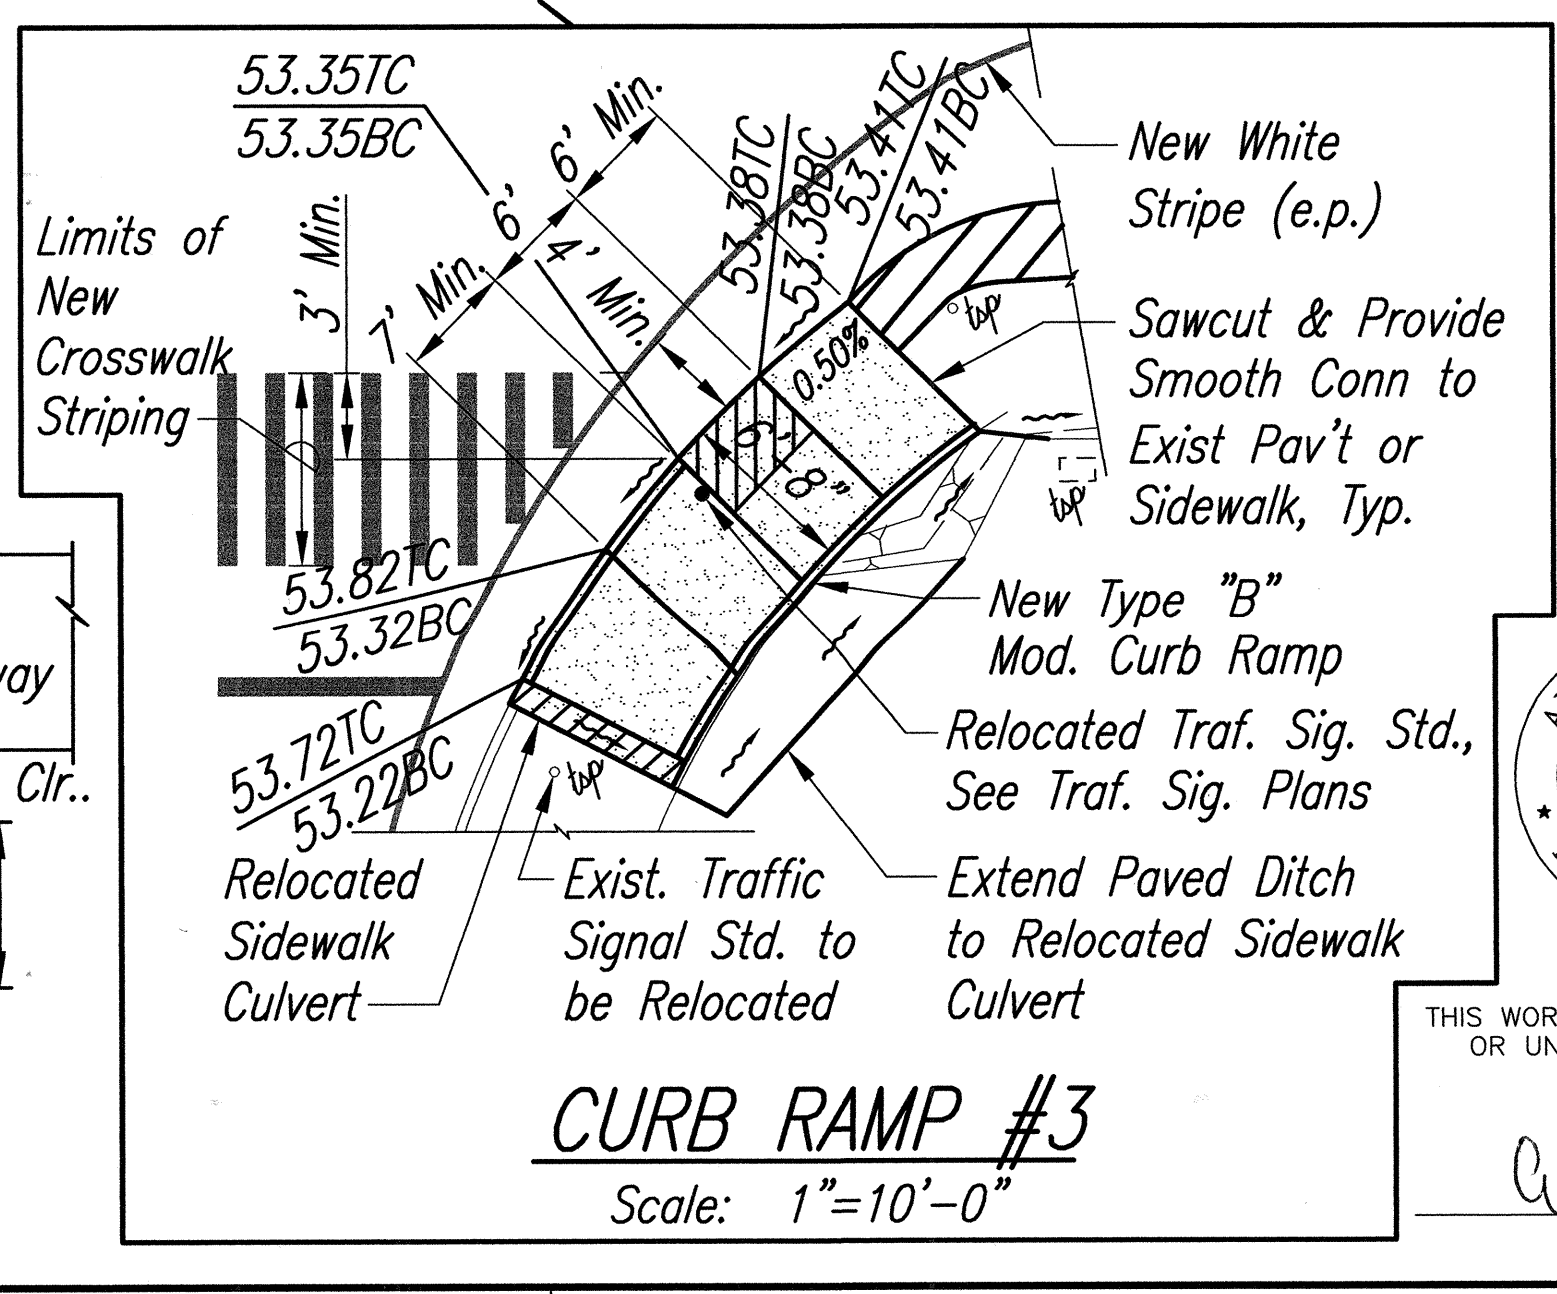


FED. ROAD DIST. NO.	STATE	PROJ. NO.	FISCAL YEAR	SHEET NO.	TOTAL SHEETS
HAWAII	HAW.	STP-076-1(5)	2000	22	83

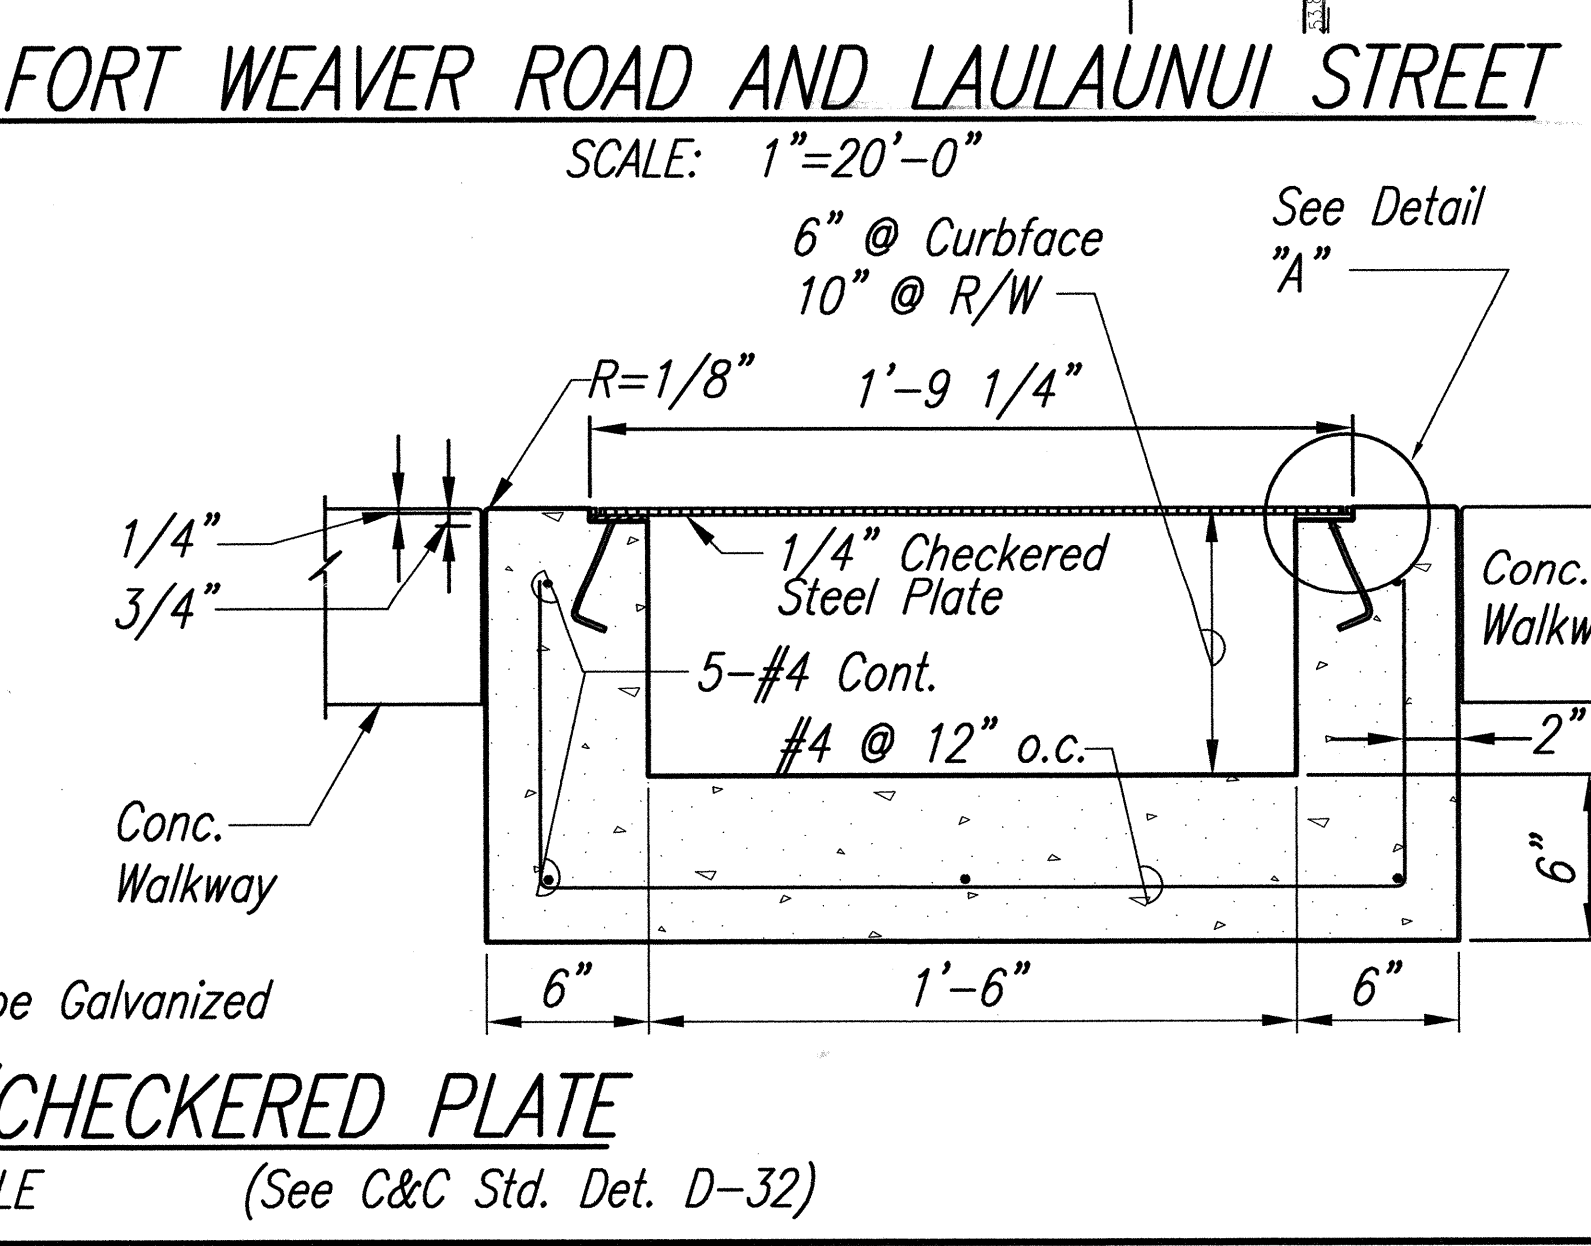

- NOTE:**
- For Curb Ramp Details, See Sheets No. 28 to 32.
 - For Concrete Pad w/ Tactile Lines Details, See Sheet No. 27
 - For Concrete Walkway Connection Details, See Sheet No. 27
 - For New A.C. Pavement Details, See Sheet No. 12.

Approved _____ 11/4/99
Chief, Civil Engineering Branch, DPP

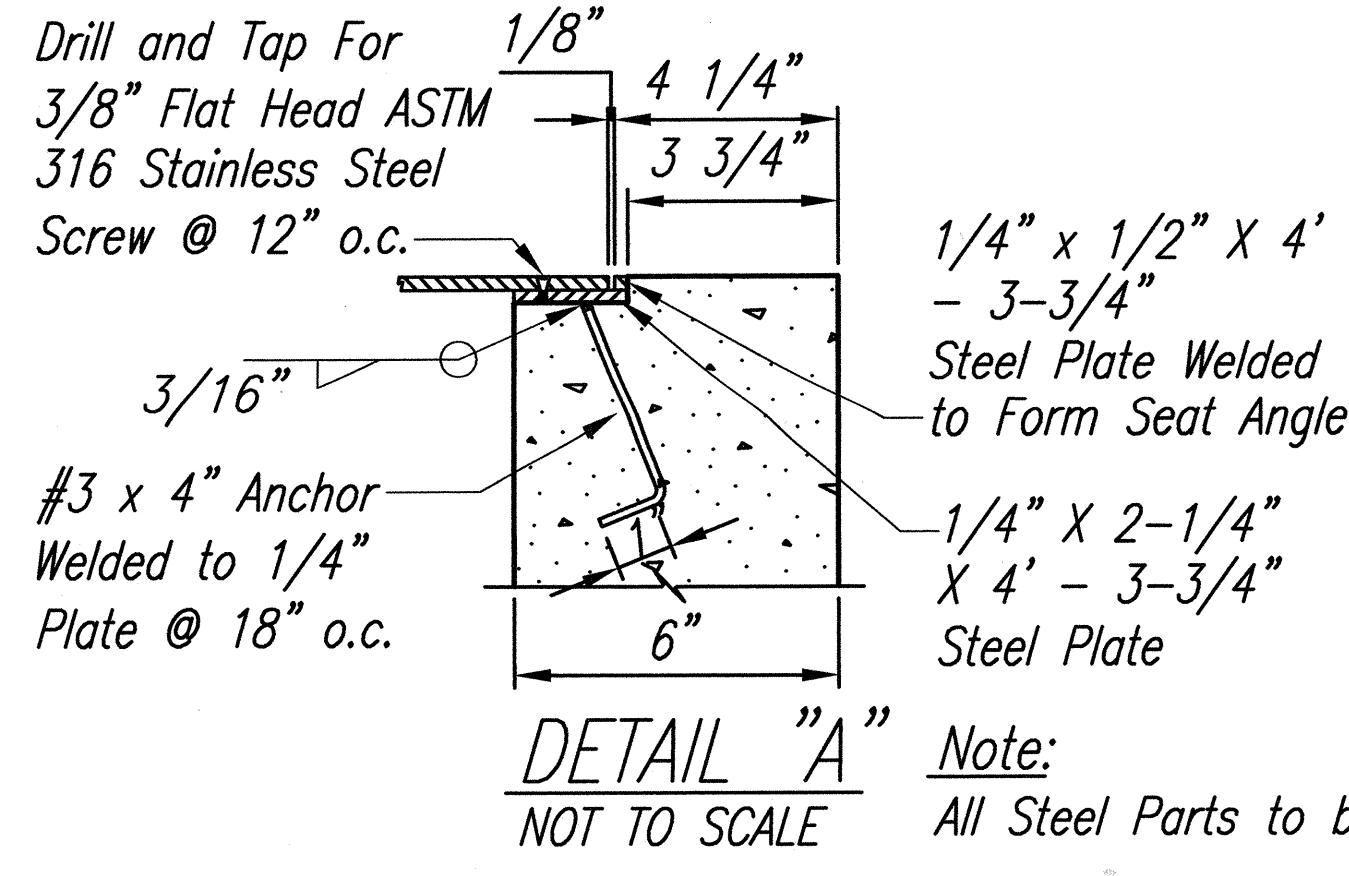








THIS WORK WAS PREPARED BY ME OR UNDER MY SUPERVISION.

STATE OF HAWAII
DEPARTMENT OF TRANSPORTATION
HIGHWAYS DIVISION
INTERSECTION PLAN
FORT WEAVER ROAD RESURFACING
N. of Laulaunui St. to the Vicinity of Hanakahi St.
F. A. Project No. STP-076-1(5)
Scale: As Shown Date: July, 1999
SHEET No. 1 OF 6 SHEETS


11/4/99
Date

ORIGINAL PLAN	DATE
NO. 1	11/4/99
NO. 2	
NO. 3	
NO. 4	
NO. 83	

FED. ROAD DIST. NO.	STATE	PROJ. NO.	FISCAL YEAR	SHEET NO.	TOTAL SHEETS
HAWAII	HAW.	STP-076-1(5)	2000	23	83

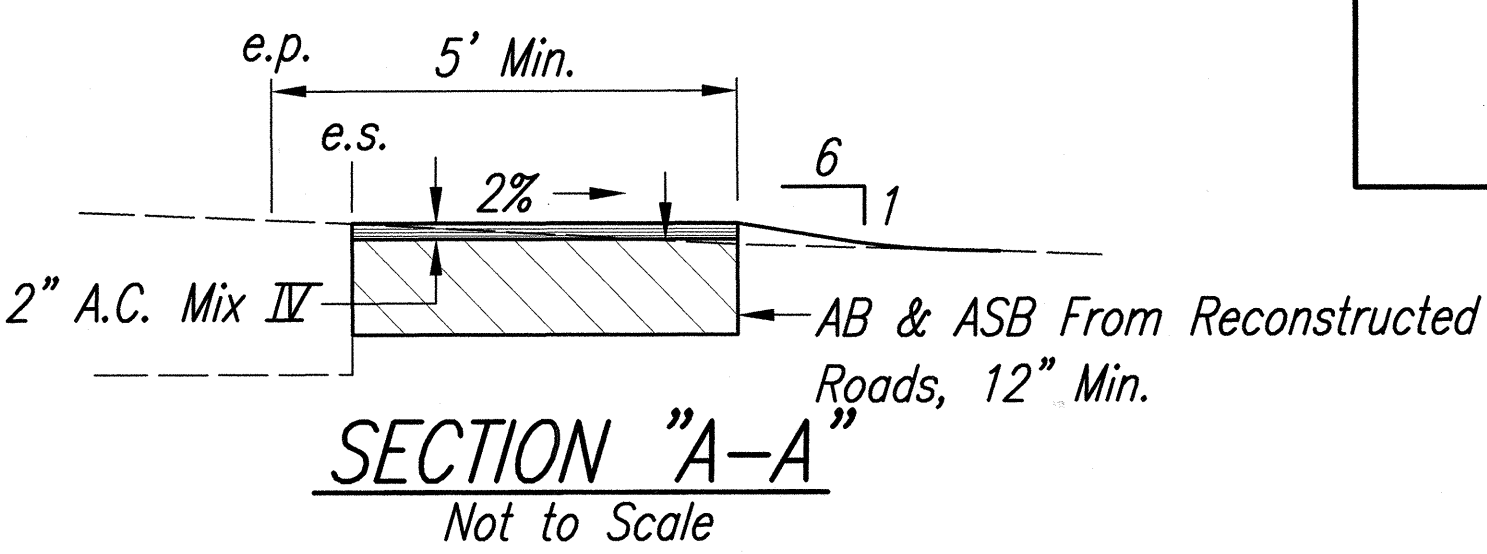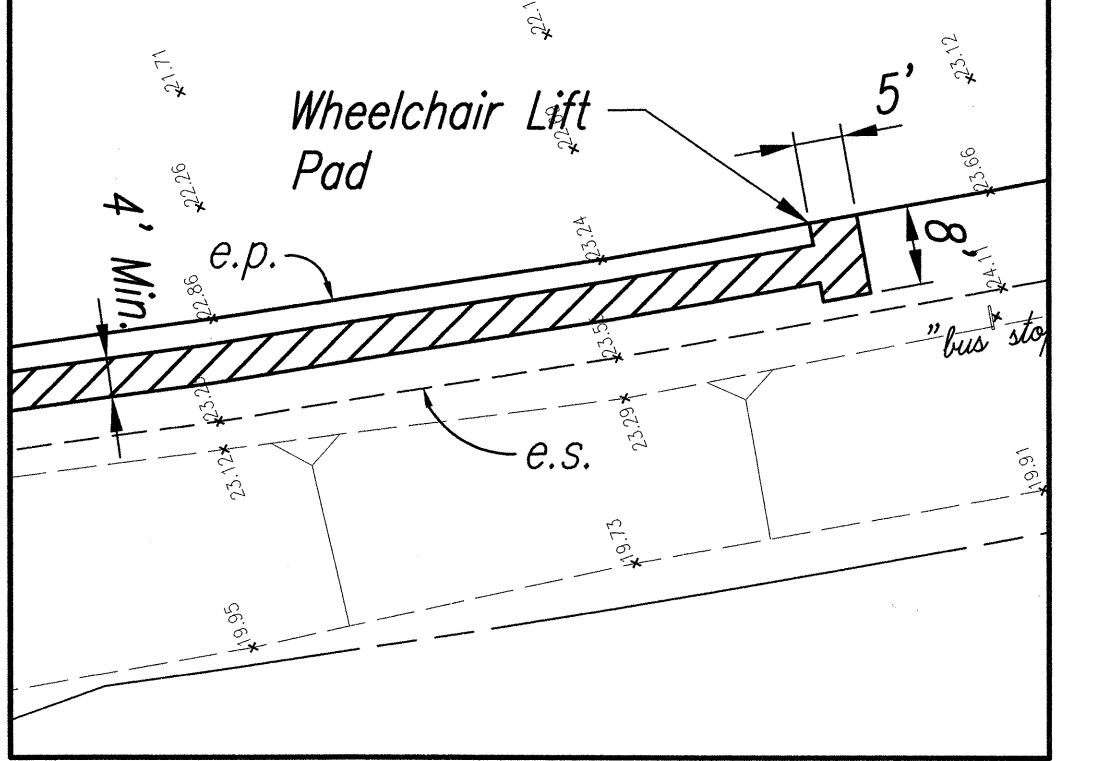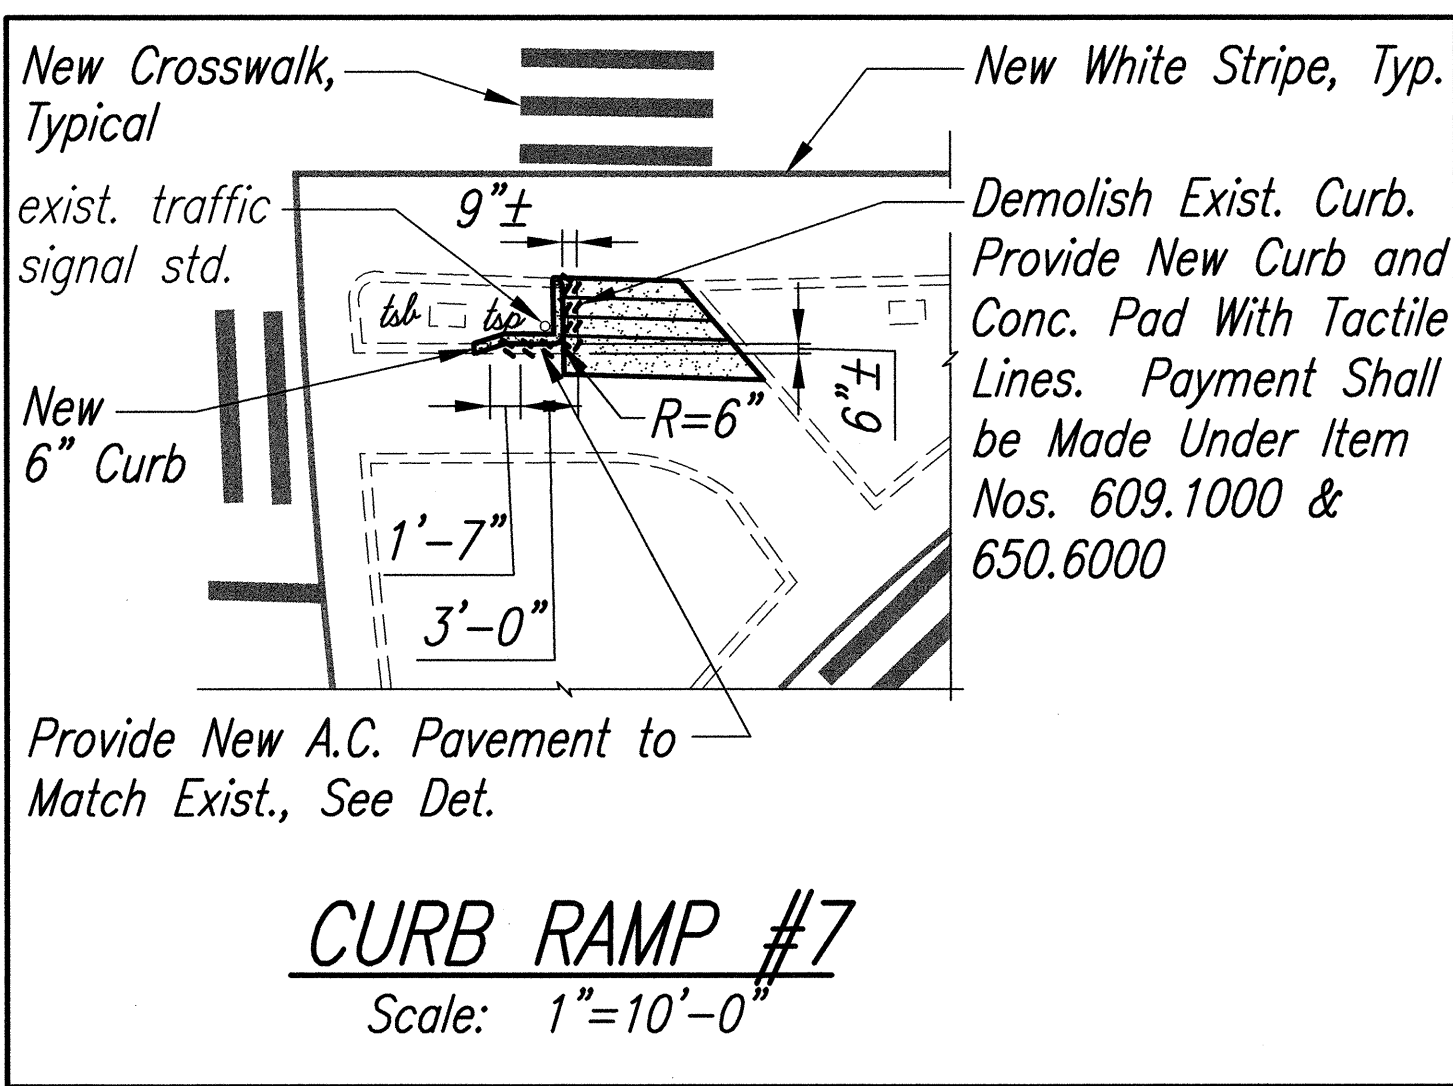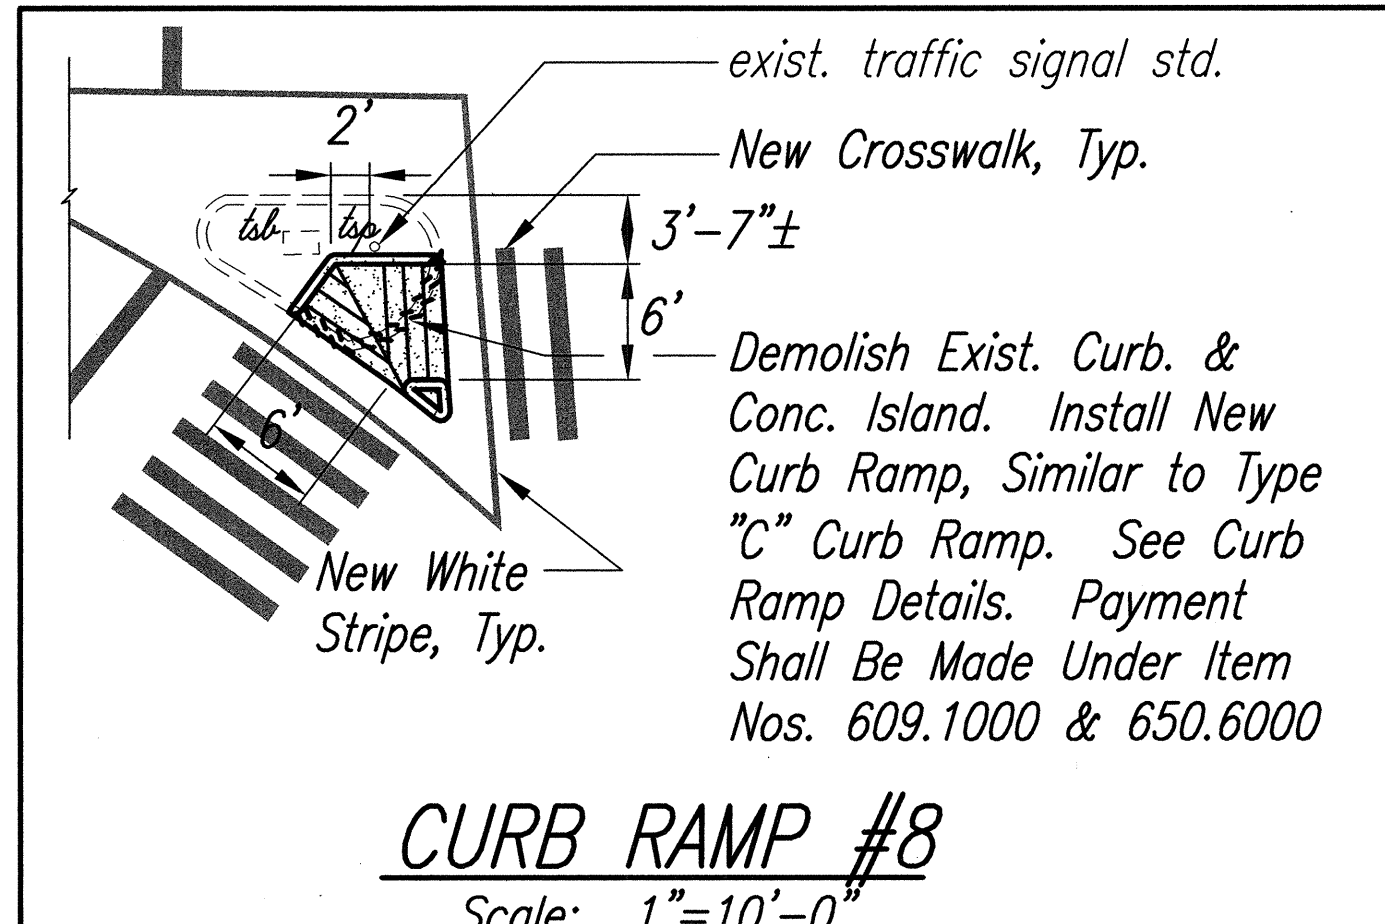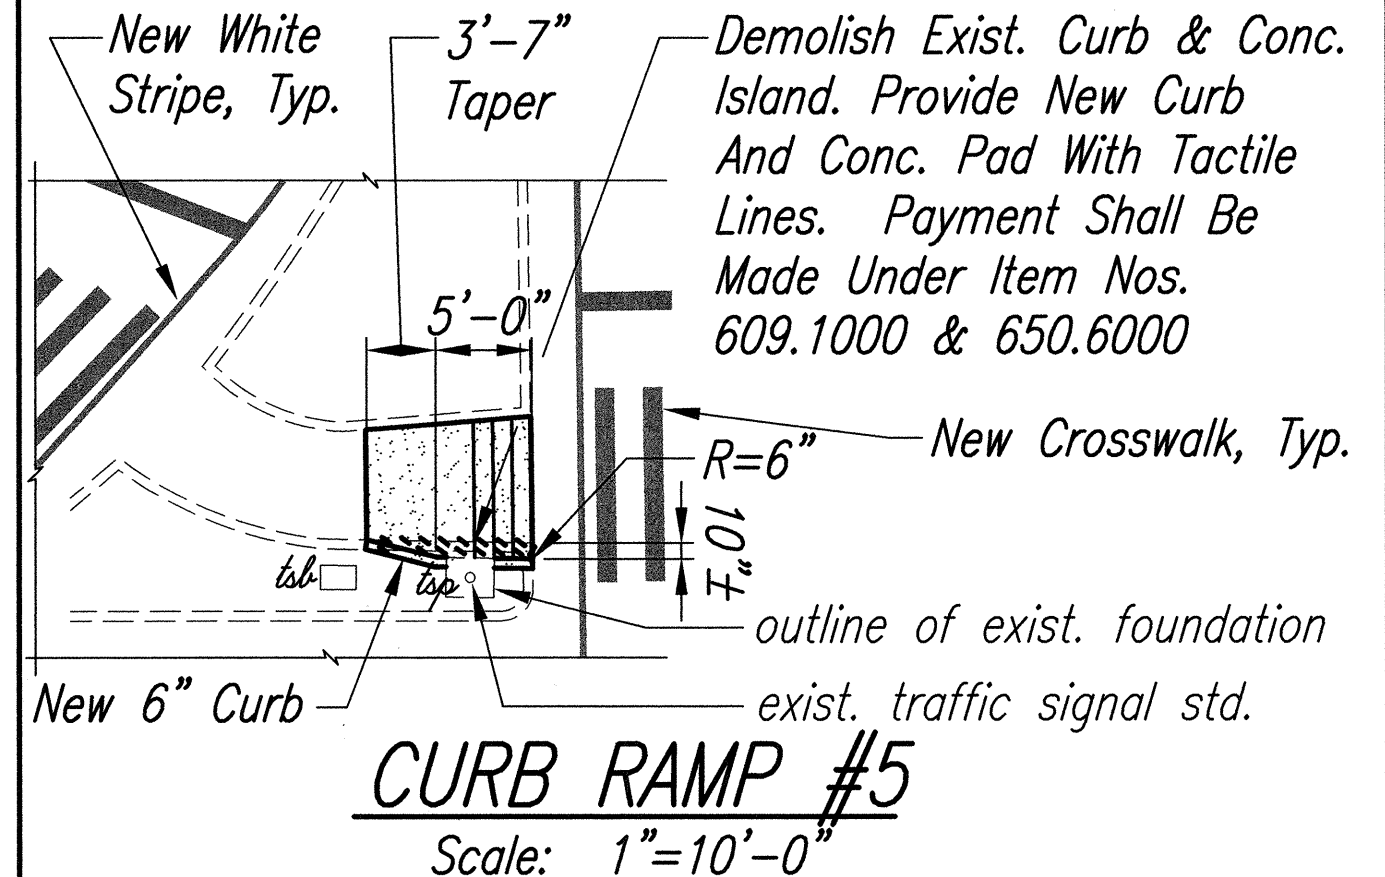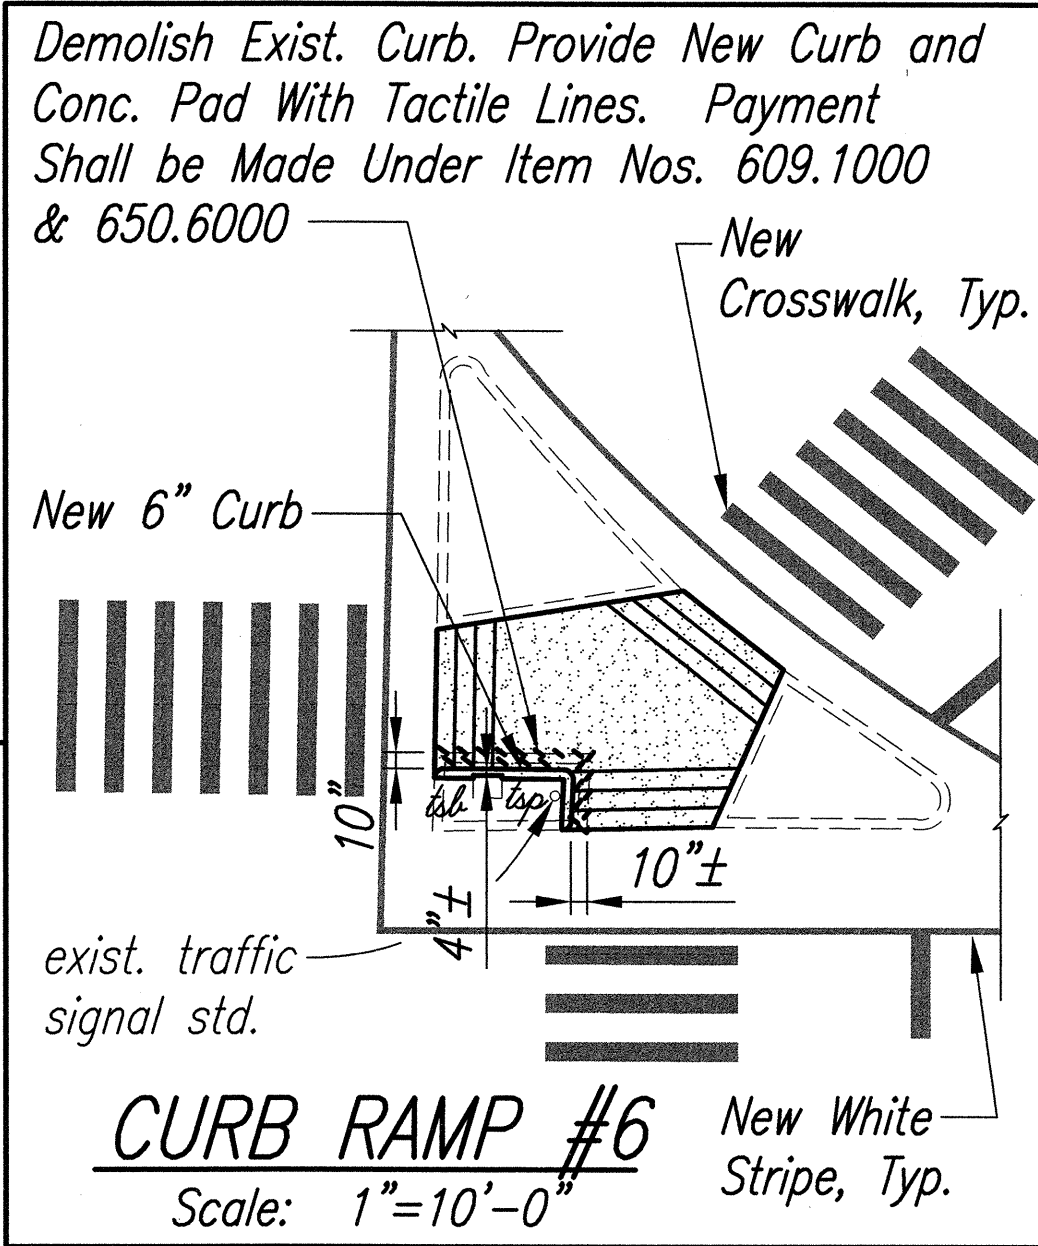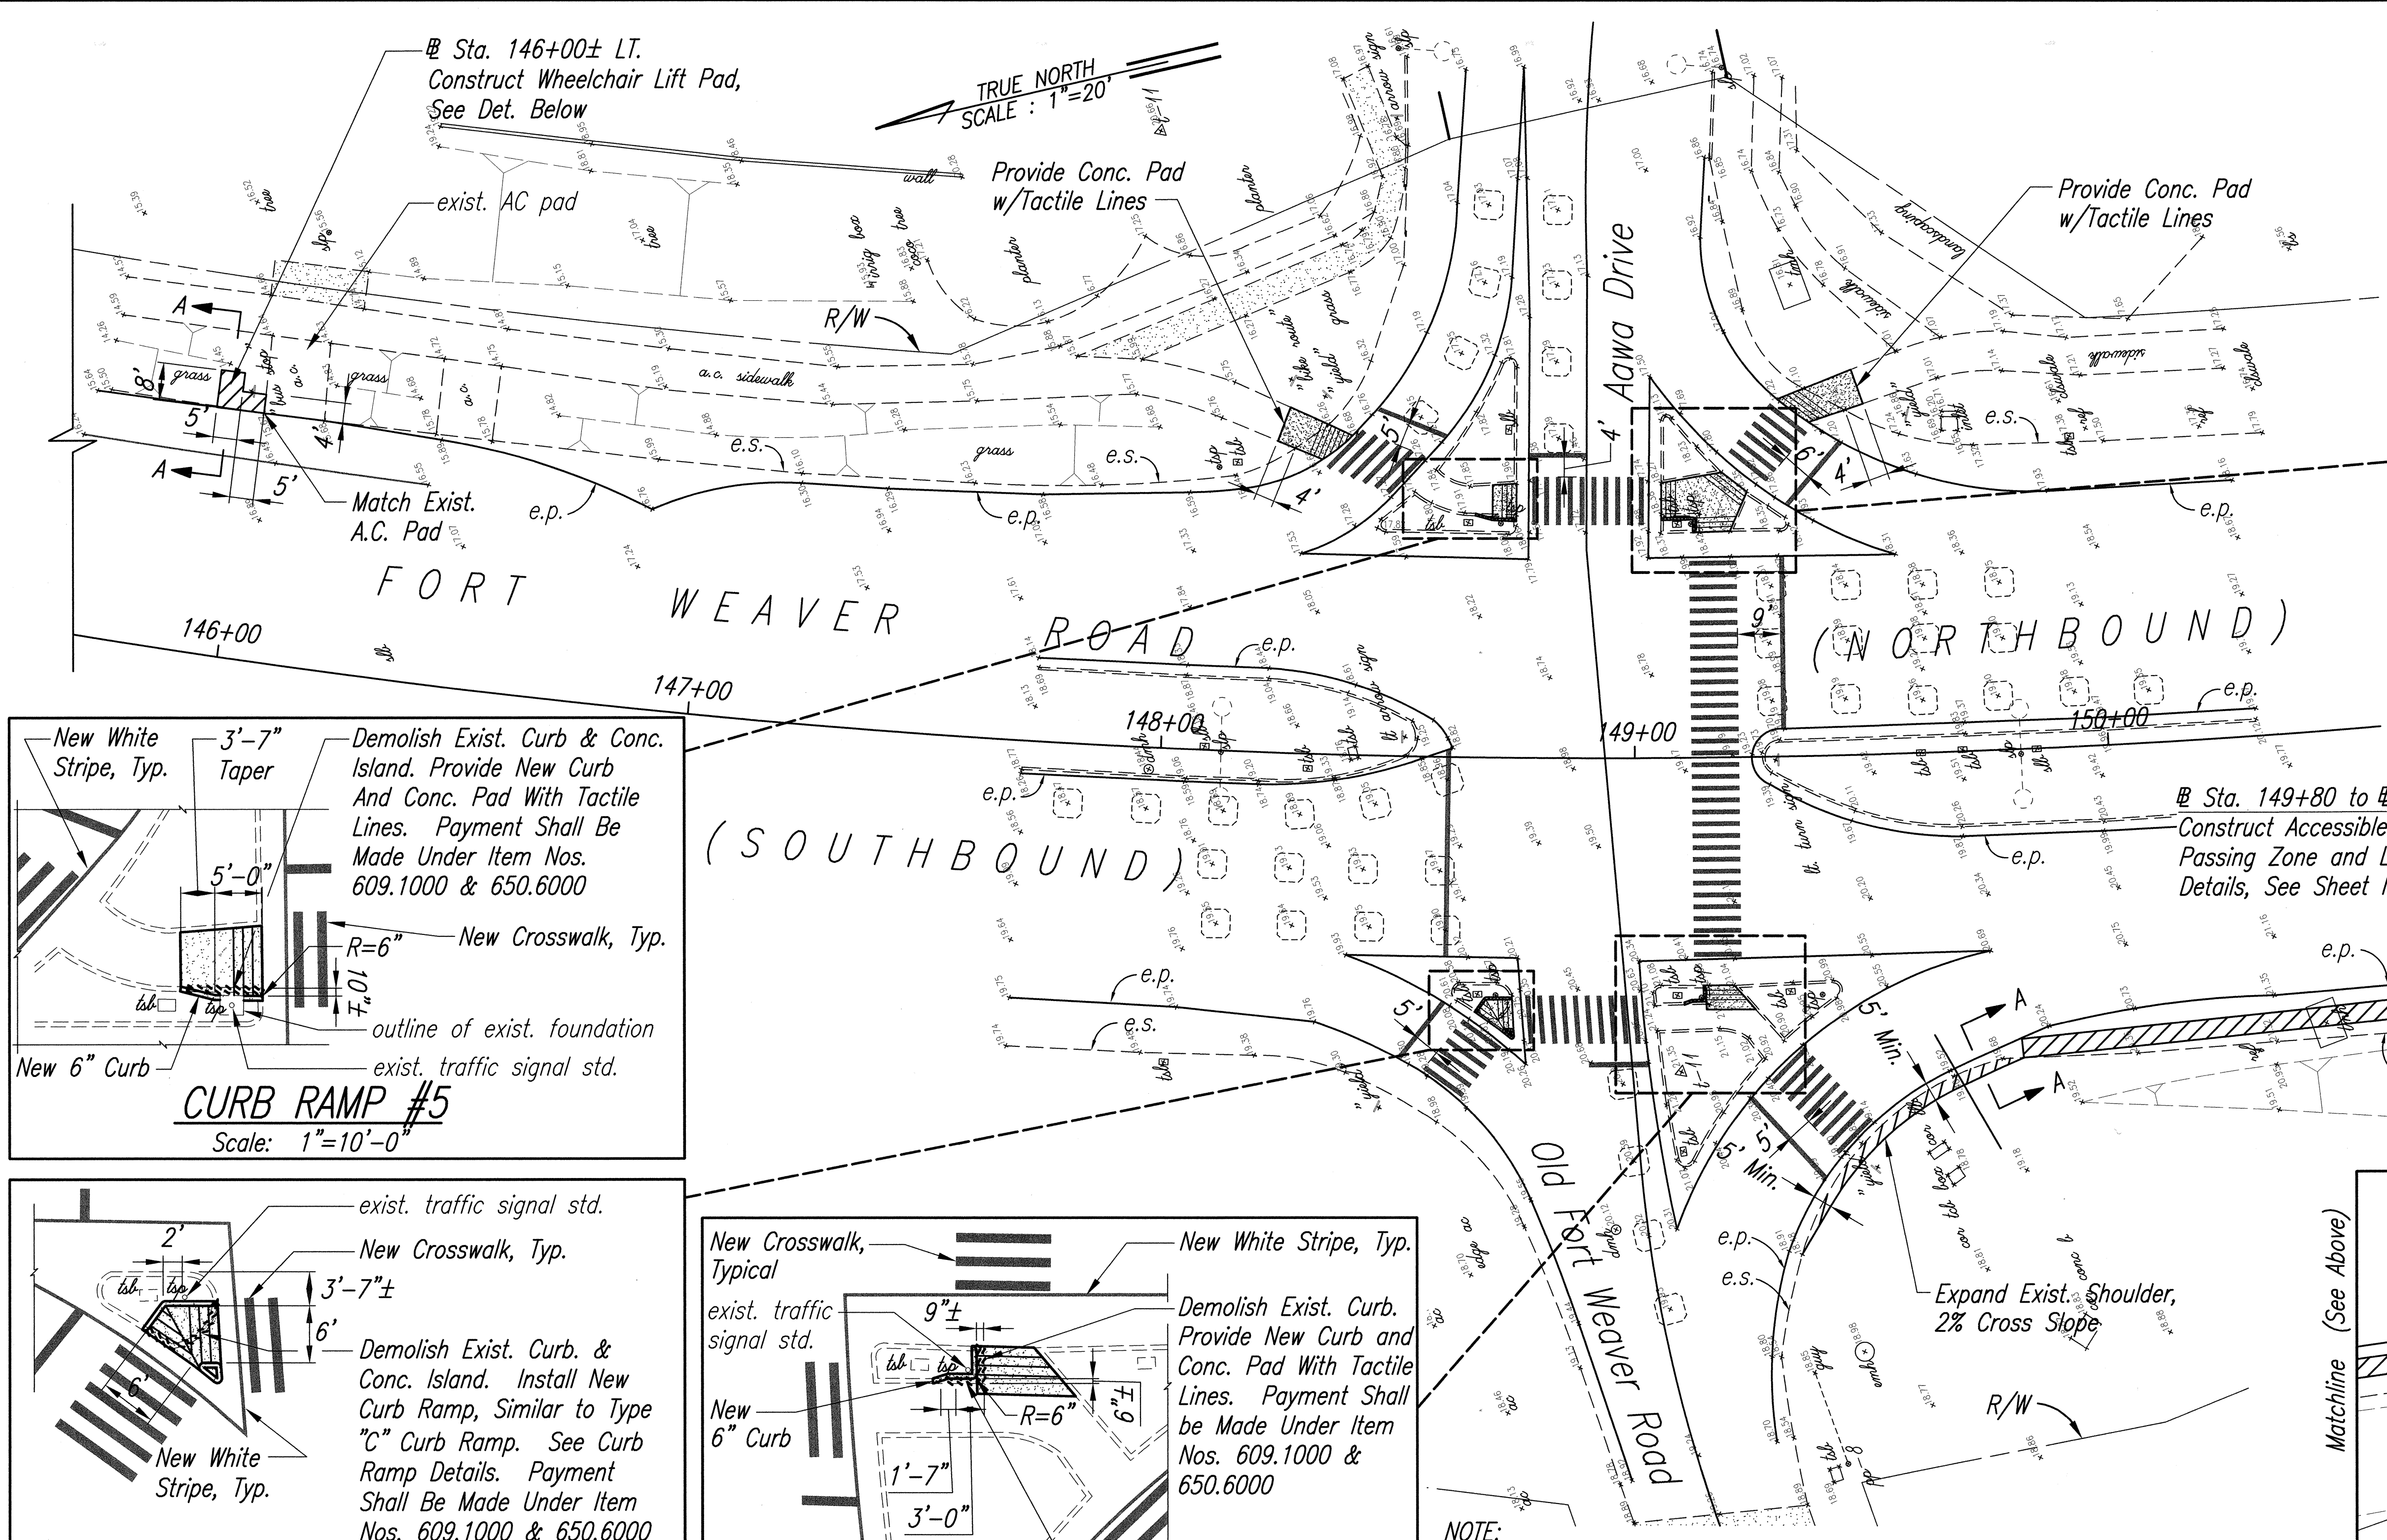

- NOTE:**
1. For Curb Ramp Details, See Sheets No. 28 to 32.
 2. For Concrete Pad w/ Tactile Lines Details, See Sheet No. 27
 3. For Concrete Walkway Connection Details, See Sheet No. 27
 4. For New A.C. Pavement Details. See Sheet No. 12

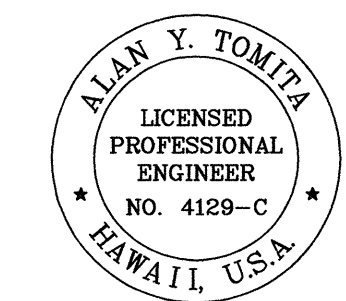

THIS WORK WAS PREPARED BY ME OR UNDER MY SUPERVISION.

Alan Y. Tomita





STATE OF HAWAII
DEPARTMENT OF TRANSPORTATION
HIGHWAYS DIVISION
INTERSECTION PLAN
FORT WEAVER ROAD RESURFACING
N. of Laulauui St. to the Vicinity of Hanakahi St.
F. A. Project No. STP-076-1(5)
Scale: As Shown Date: July, 1999
SHEET No. 2 OF 6 SHEETS

SCALE: 1"=20'-0"

23

ORIGINAL PLAN	DATE
DRAWN BY	
DESIGNED BY	
QUANTITIES BY	
CHECKED BY	
NO.	

FED. ROAD DIST. NO.	STATE	PROJ. NO.	FISCAL YEAR	SHEET NO.	TOTAL SHEETS
HAWAII	HAW.	STP-076-1(5)	2000	24	83

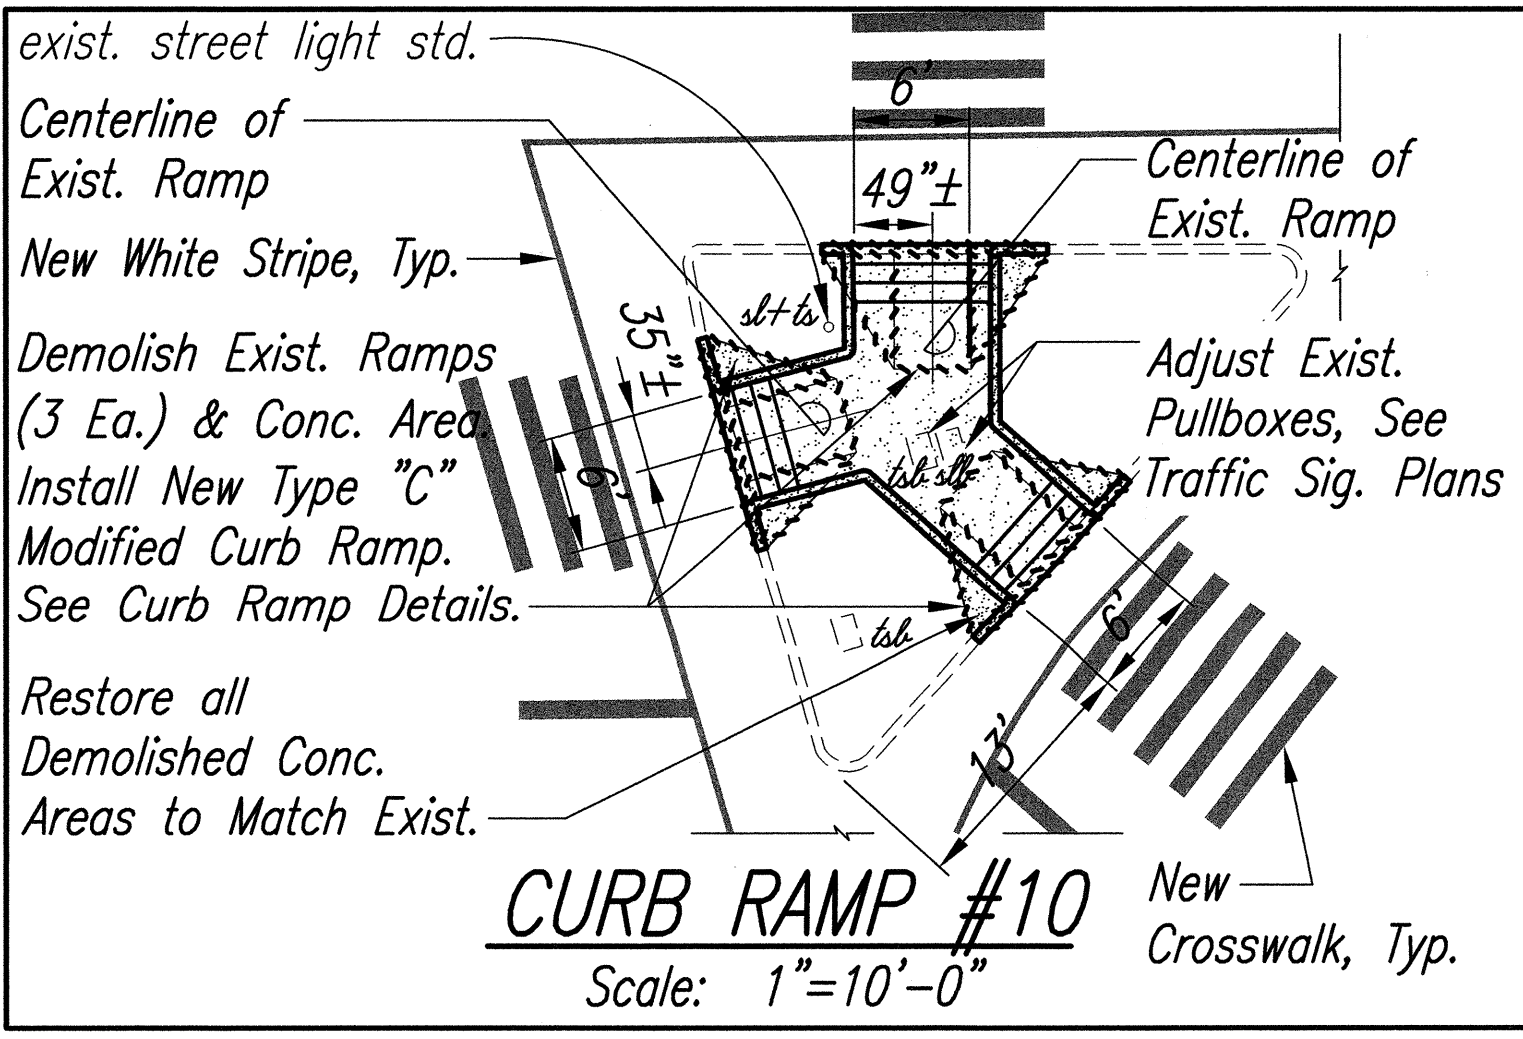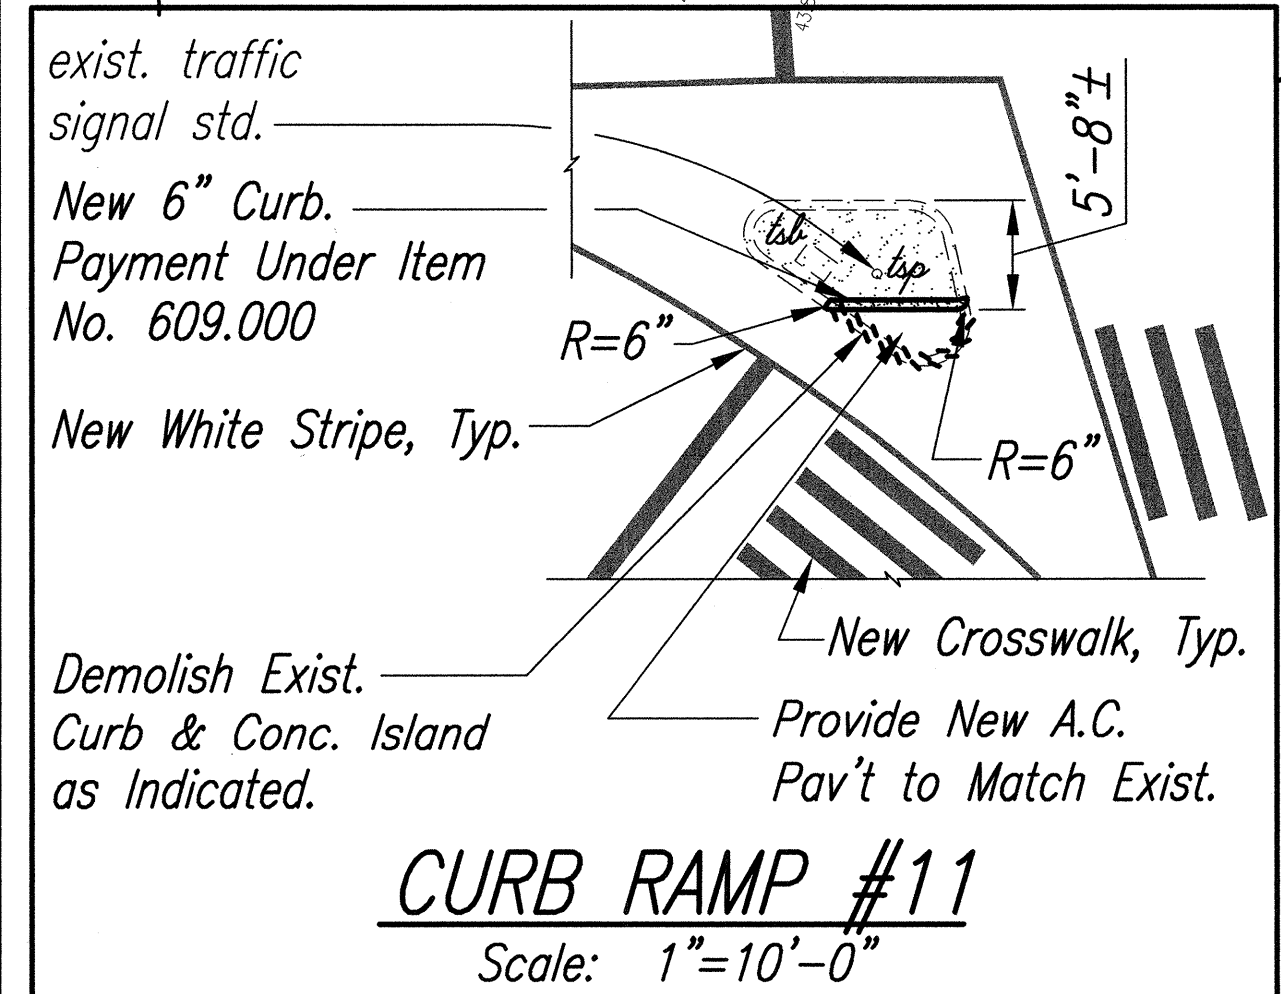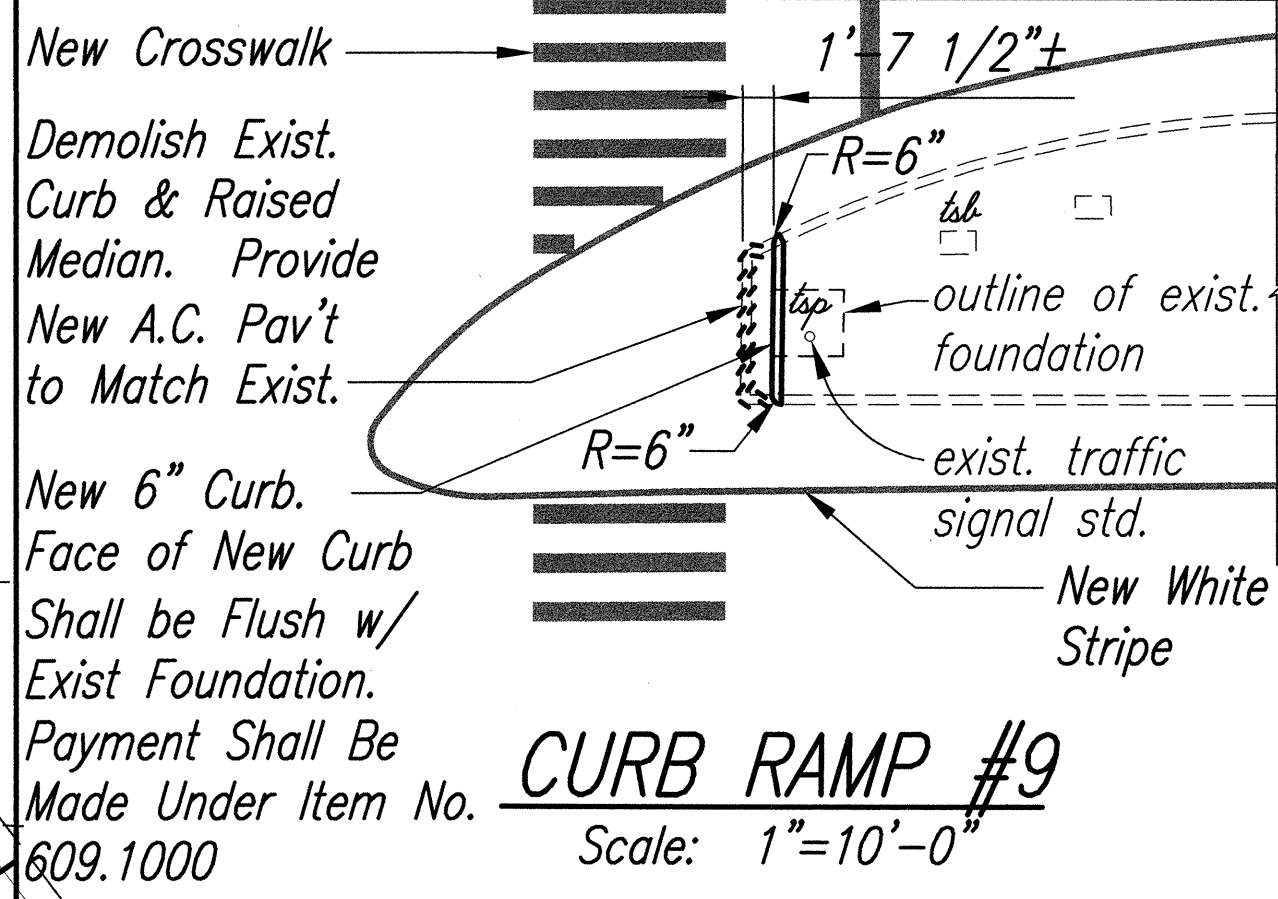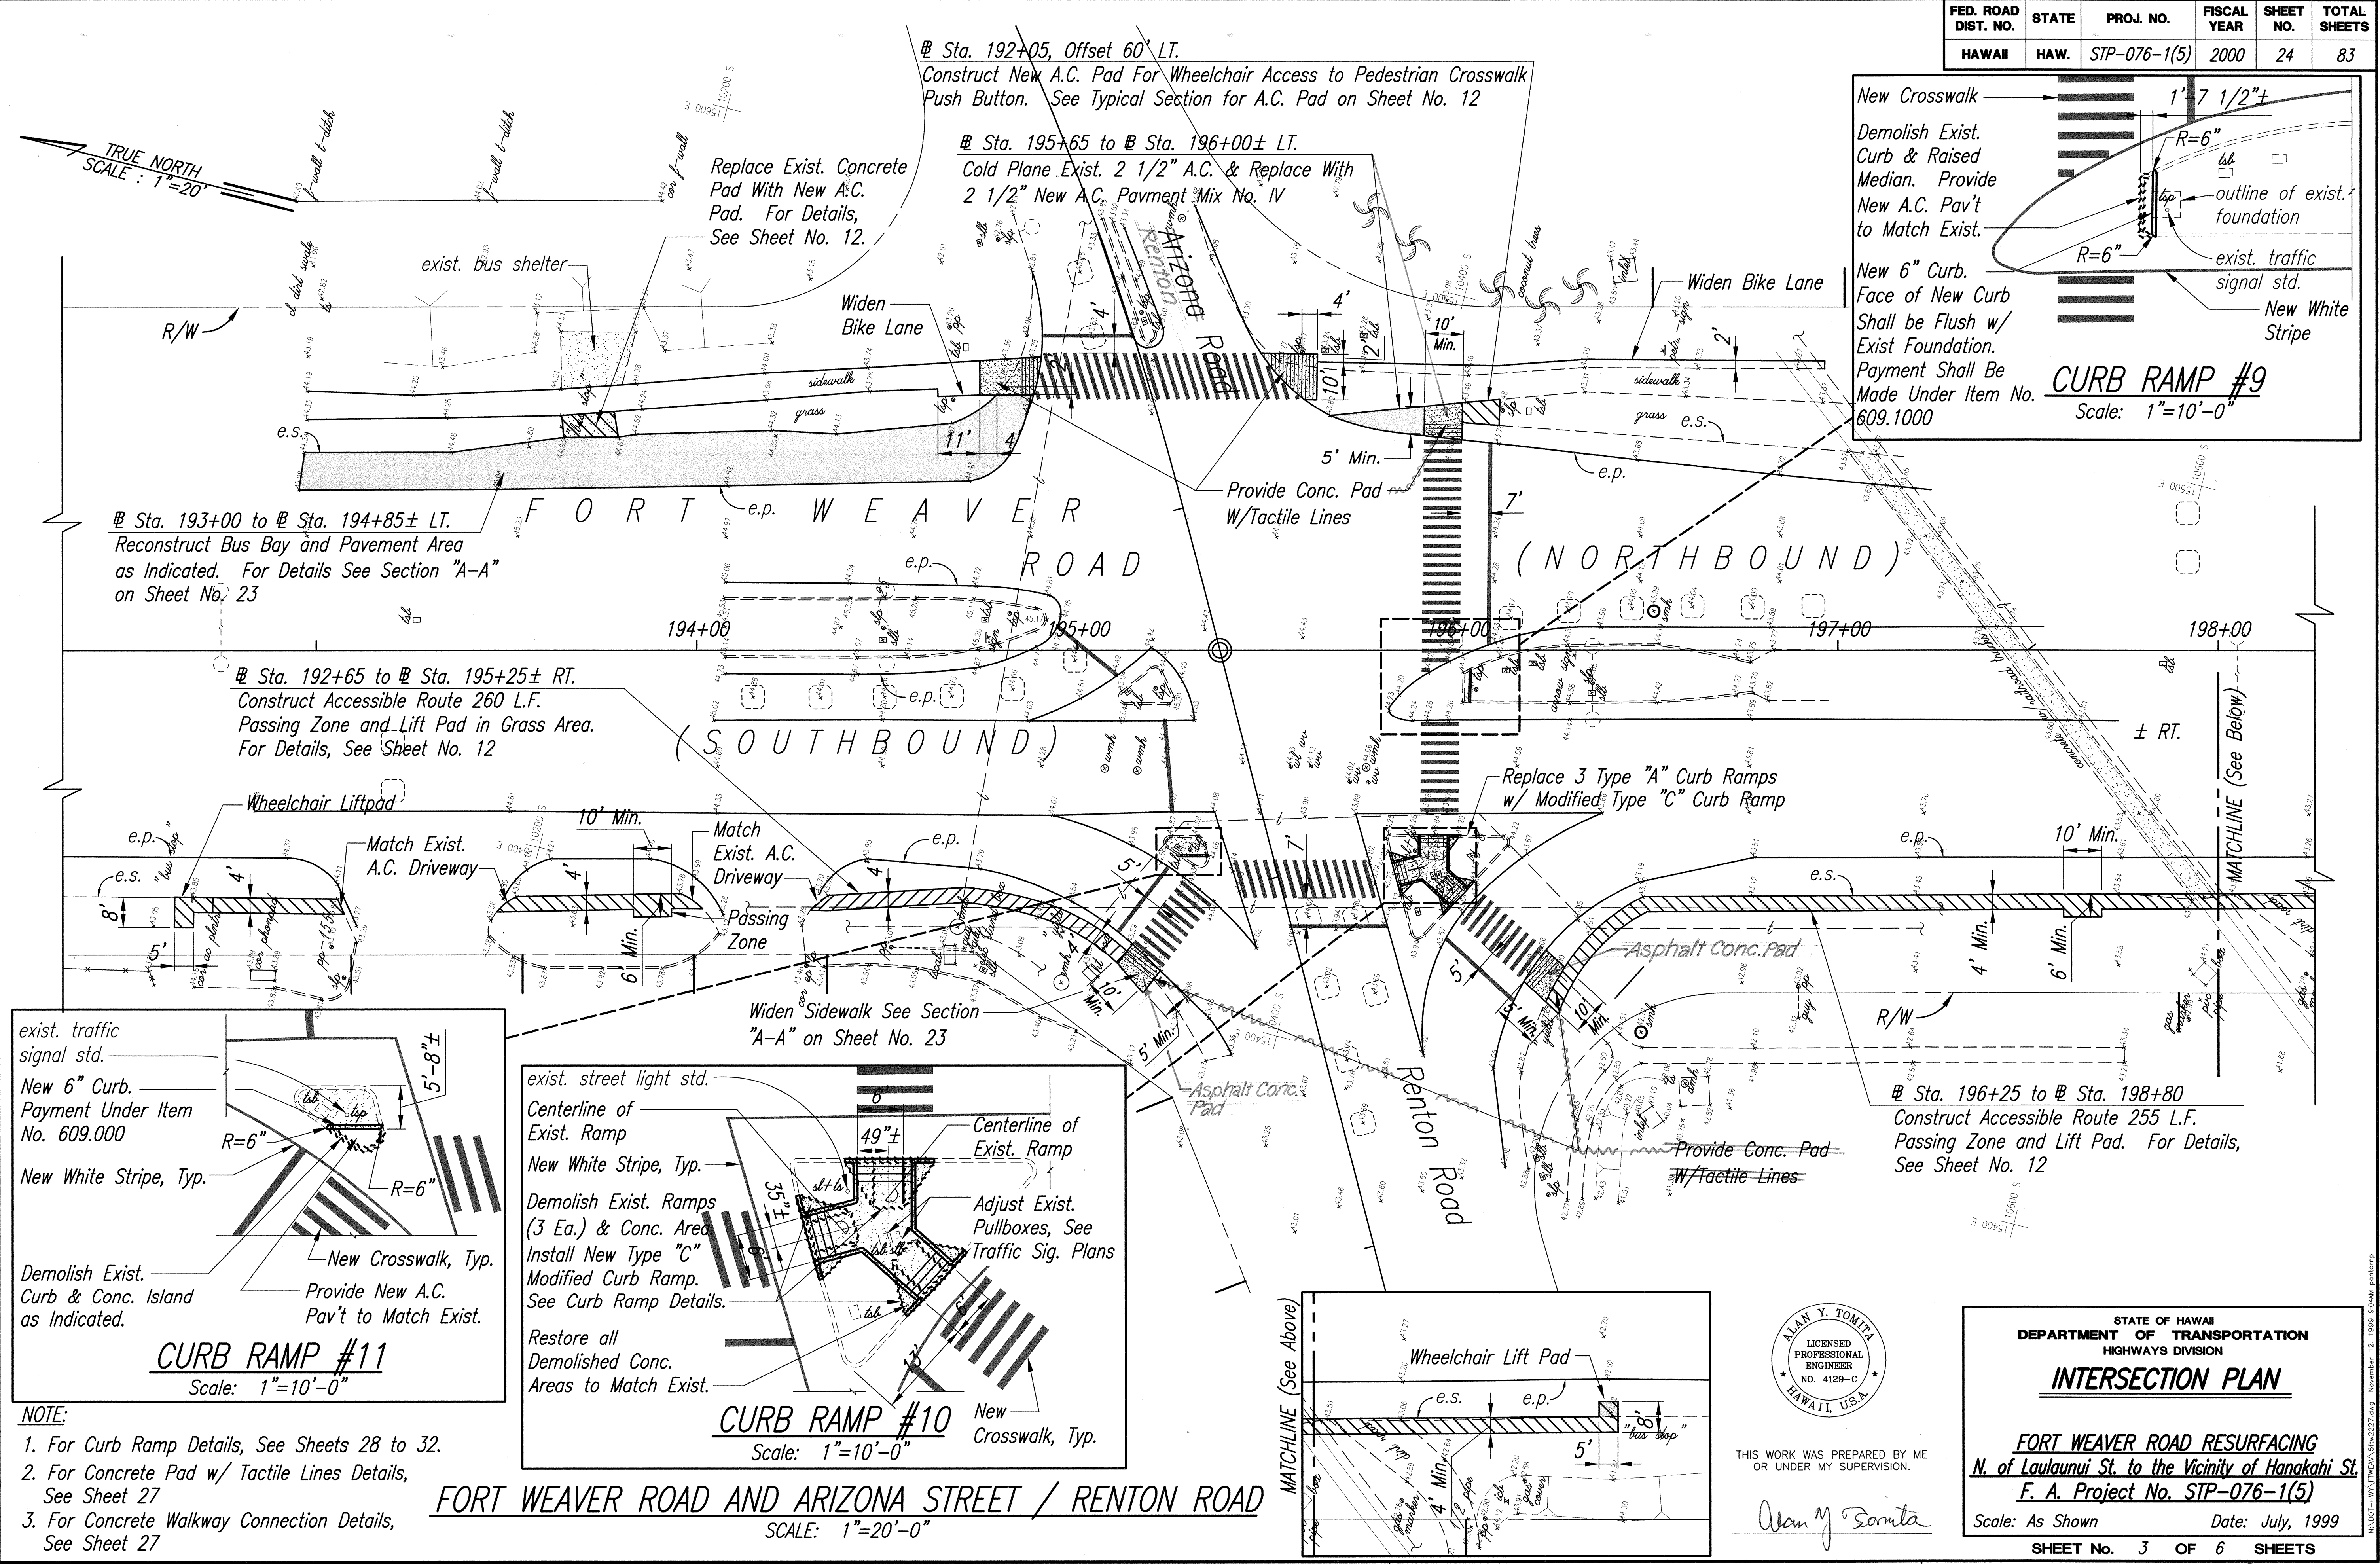

- NOTE:**
1. For Curb Ramp Details, See Sheets 28 to 32.
 2. For Concrete Pad w/ Tactile Lines Details, See Sheet 27
 3. For Concrete Walkway Connection Details, See Sheet 27

FORT WEAVER ROAD AND ARIZONA STREET / RENTON ROAD
SCALE: 1"=20'-0"

DATE	
SURVEY PLOTTED BY	
ORIGINAL PLAN	
DRAWN BY	
DESIGNED BY	
QUANTITIES BY	
CHECKED BY	
NO.	

ALAN Y. TOMITA
LICENSED PROFESSIONAL ENGINEER
NO. 4129-C
HAWAII, USA

THIS WORK WAS PREPARED BY ME OR UNDER MY SUPERVISION.



Alan Y. Tomita

STATE OF HAWAII
DEPARTMENT OF TRANSPORTATION
HIGHWAYS DIVISION
INTERSECTION PLAN

FORT WEAVER ROAD RESURFACING
N. of Laulauui St. to the Vicinity of Hanakahi St.
F. A. Project No. STP-076-1(5)
Scale: As Shown Date: July, 1999
SHEET No. 3 OF 6 SHEETS

"AS-BUILT"

FED. ROAD DIST. NO.	STATE	PROJ. NO.	FISCAL YEAR	SHEET NO.	TOTAL SHEETS
HAWAII	HAW.	STP-076-1(5)	2000	25	83

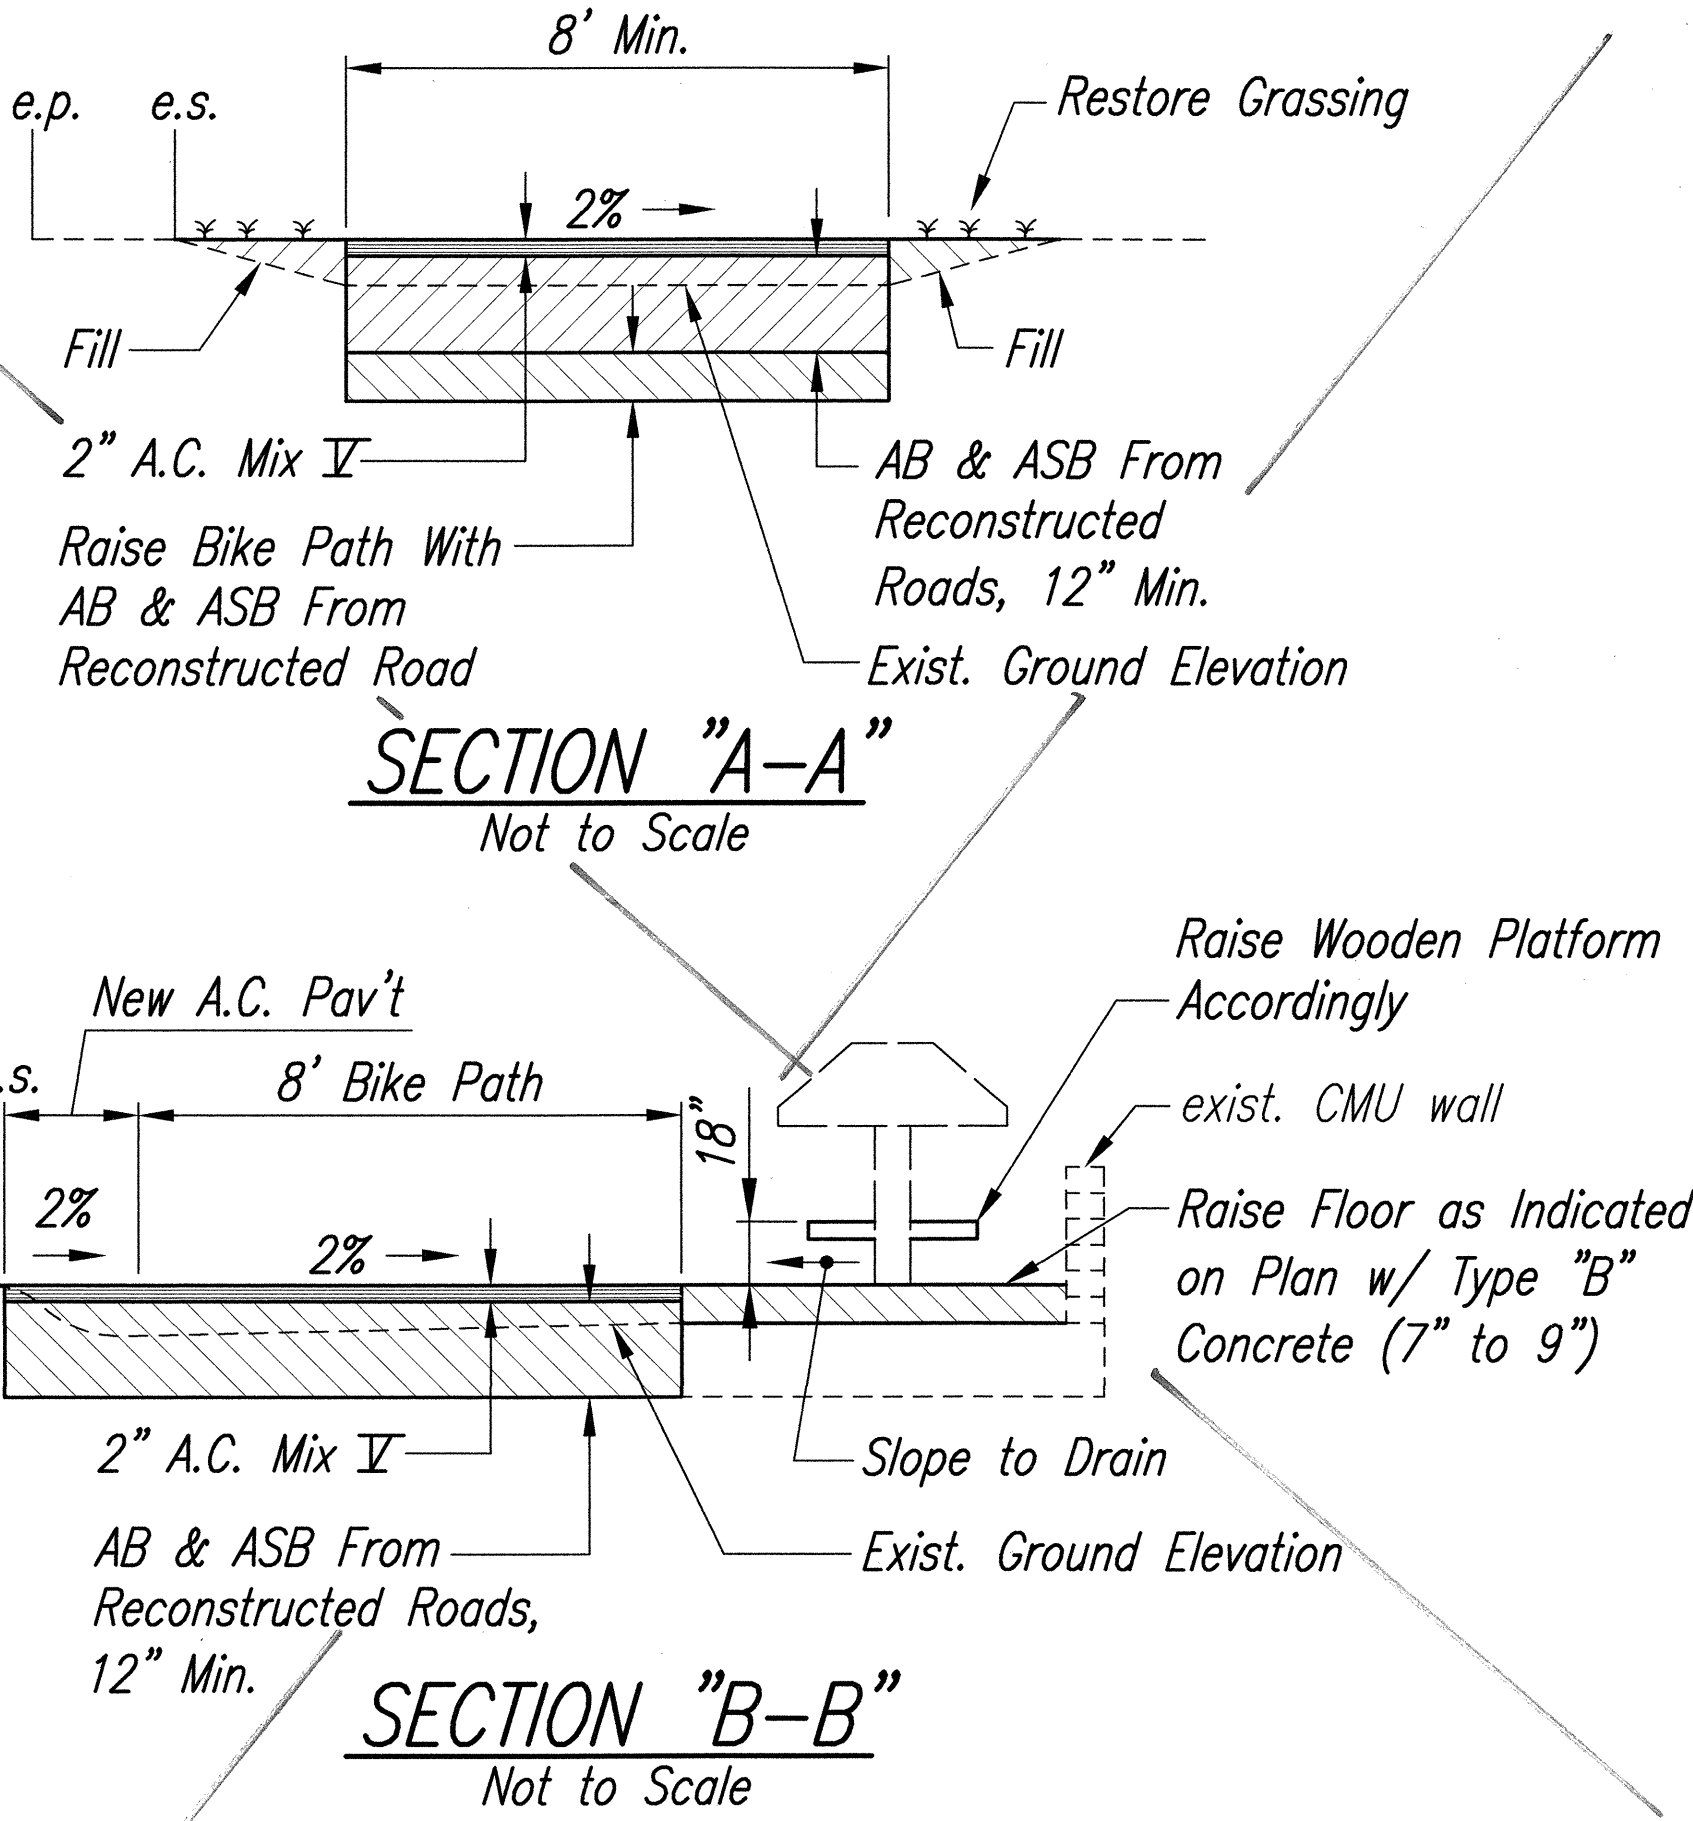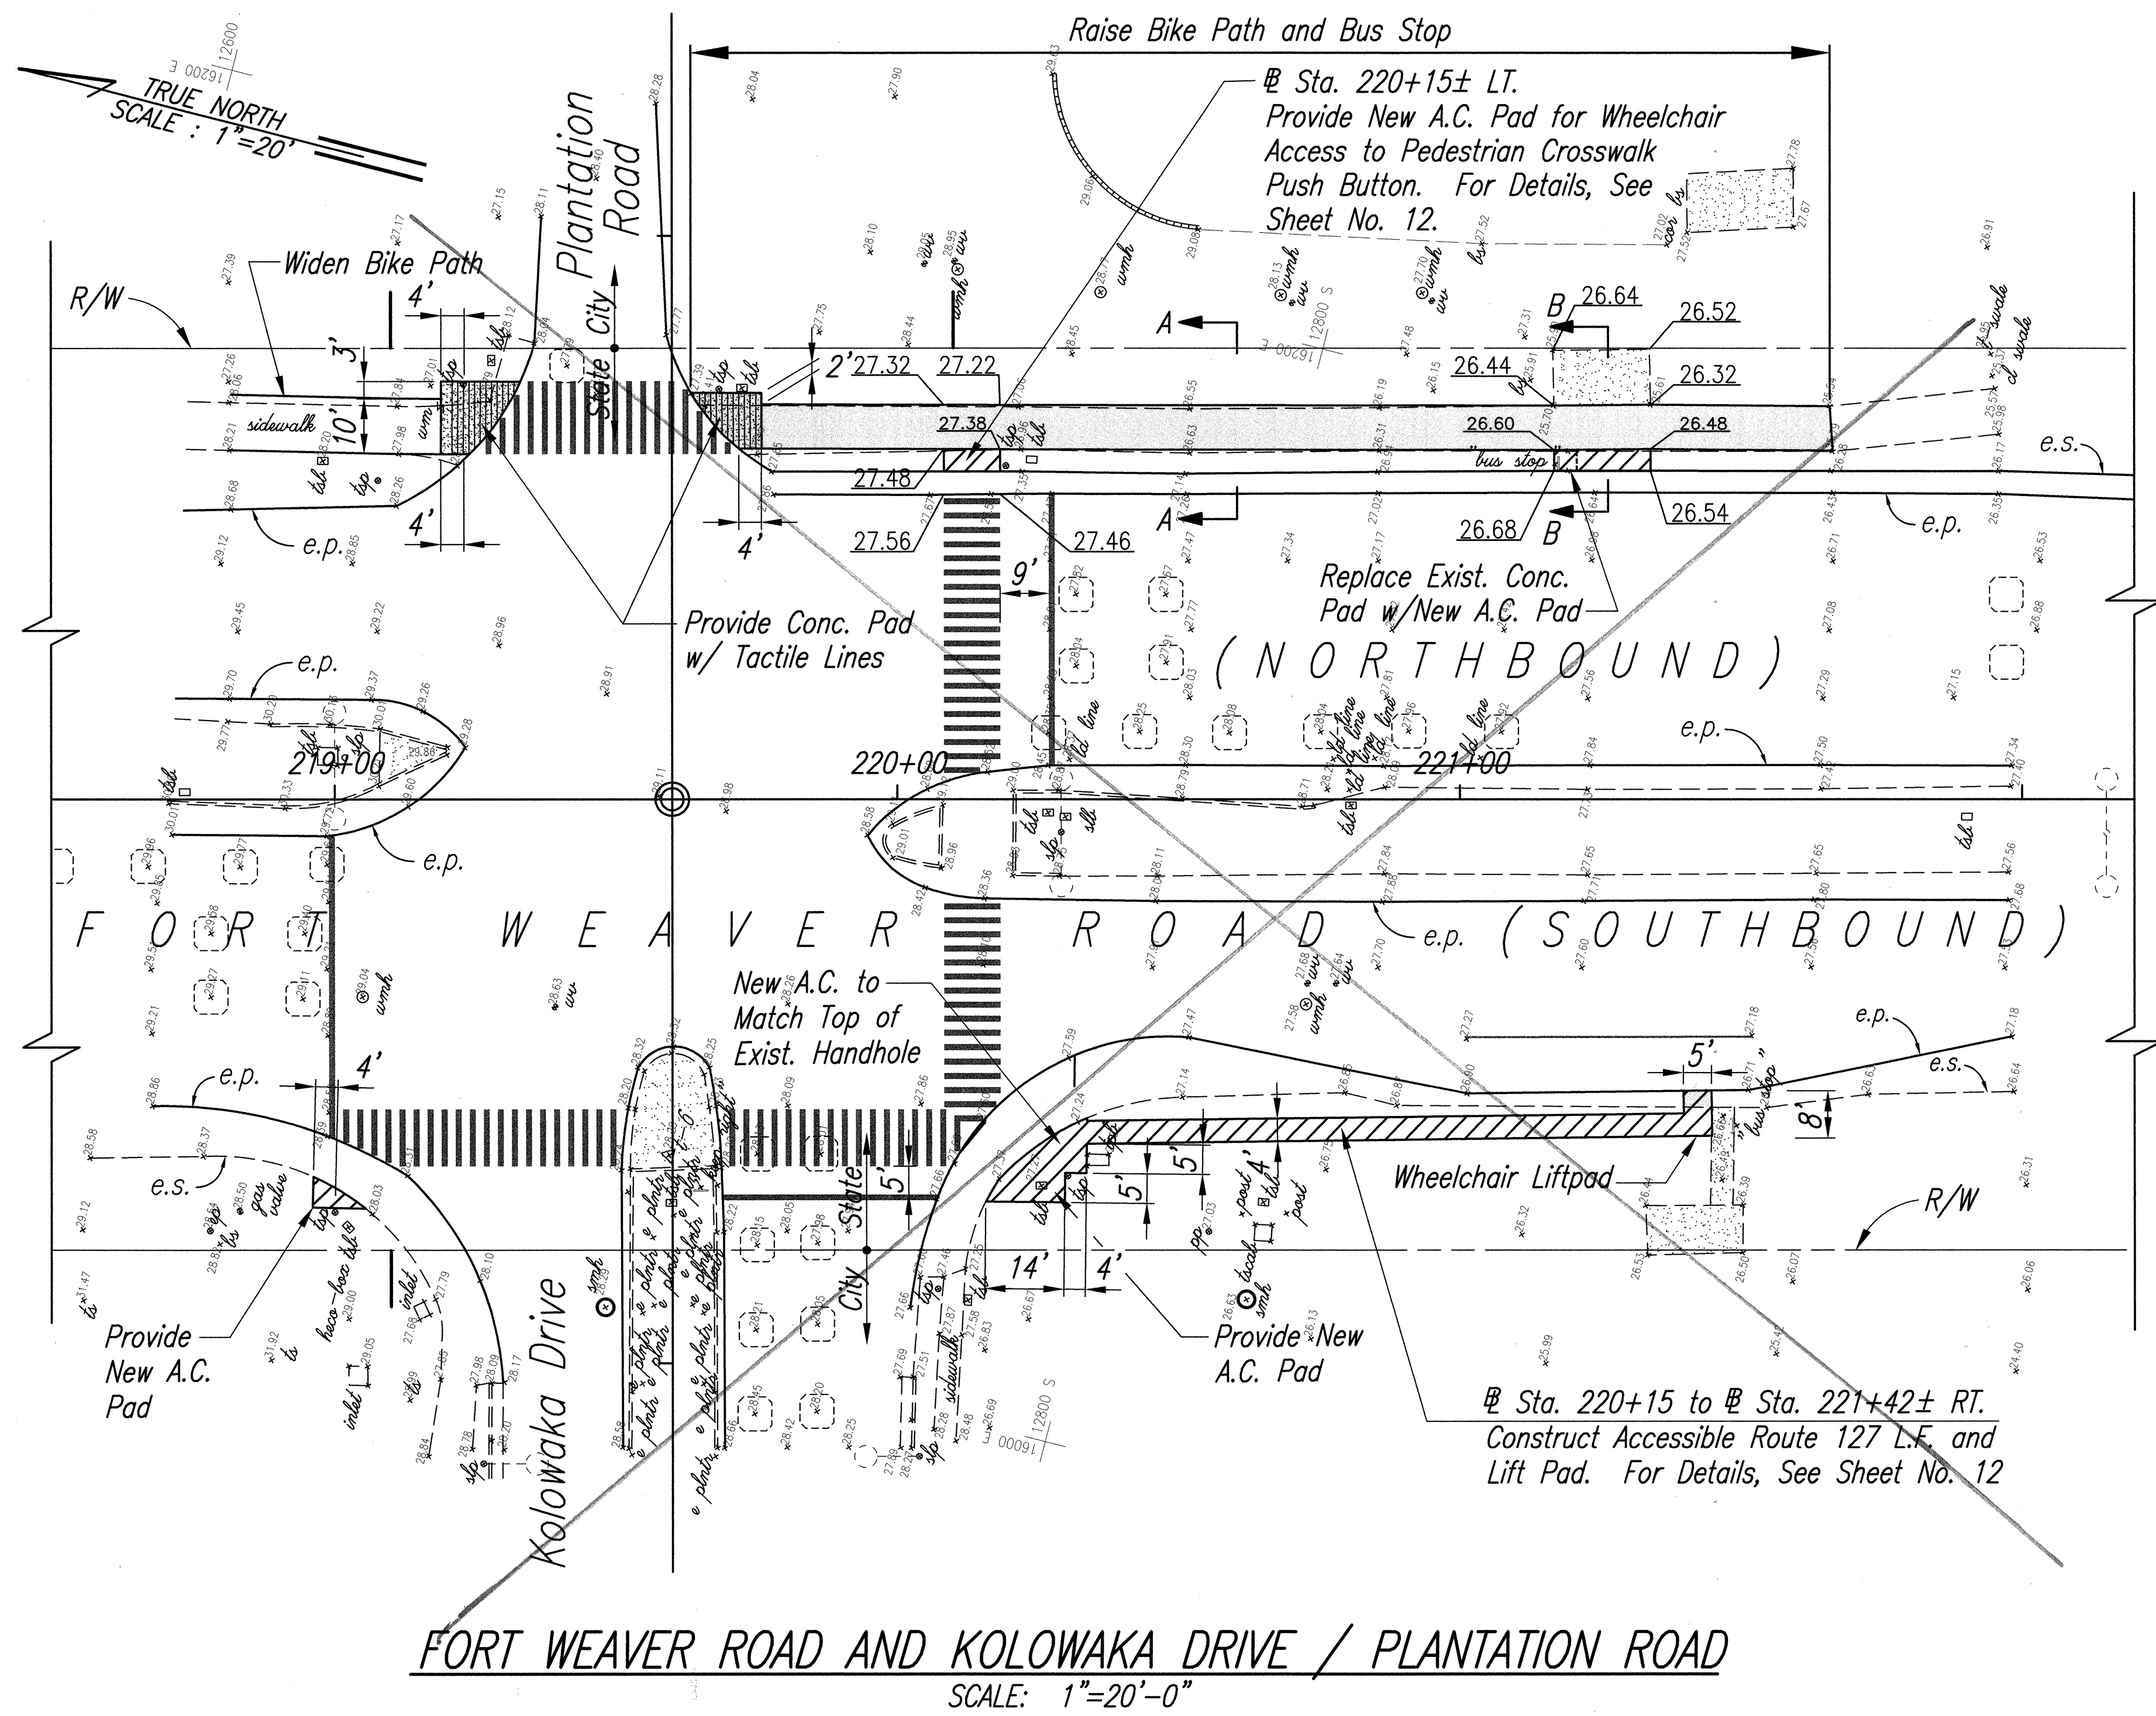

- NOTE:
1. For Curb Ramp Details, See Sheets No. 28 to 32.
 2. For Concrete Pad w/ Tactile Lines Details, See Sheet No. 27
 3. For Concrete Walkway Connection Details, See Sheet No. 27

ORIGINAL PLAN	DATE
SURVEY PLOTTED BY	
DESIGNED BY	
QUANTITIES BY	
CHECKED BY	
NO.	

Work done by Others
Per Permit No. 0-93-76, 9-26-95

ALAN Y. TOMITA
LICENSED PROFESSIONAL ENGINEER
NO. 4129-C
HAWAII, U.S.A.

THIS WORK WAS PREPARED BY ME
OR UNDER MY SUPERVISION.

Alan Y. Tomita

STATE OF HAWAII
DEPARTMENT OF TRANSPORTATION
HIGHWAYS DIVISION


INTERSECTION PLAN

FORT WEAVER ROAD RESURFACING
N. of Lualunui St. to the Vicinity of Hanakahi St.
F. A. Project No. STP-076-1(5)

Scale: As Shown Date: July, 1999


SHEET No. 4 OF 6 SHEETS

FED. ROAD DIST. NO.	STATE	PROJ. NO.	FISCAL YEAR	SHEET NO.	TOTAL SHEETS
HAWAII	HAW.	STP-076-1(5)	2000	26	83

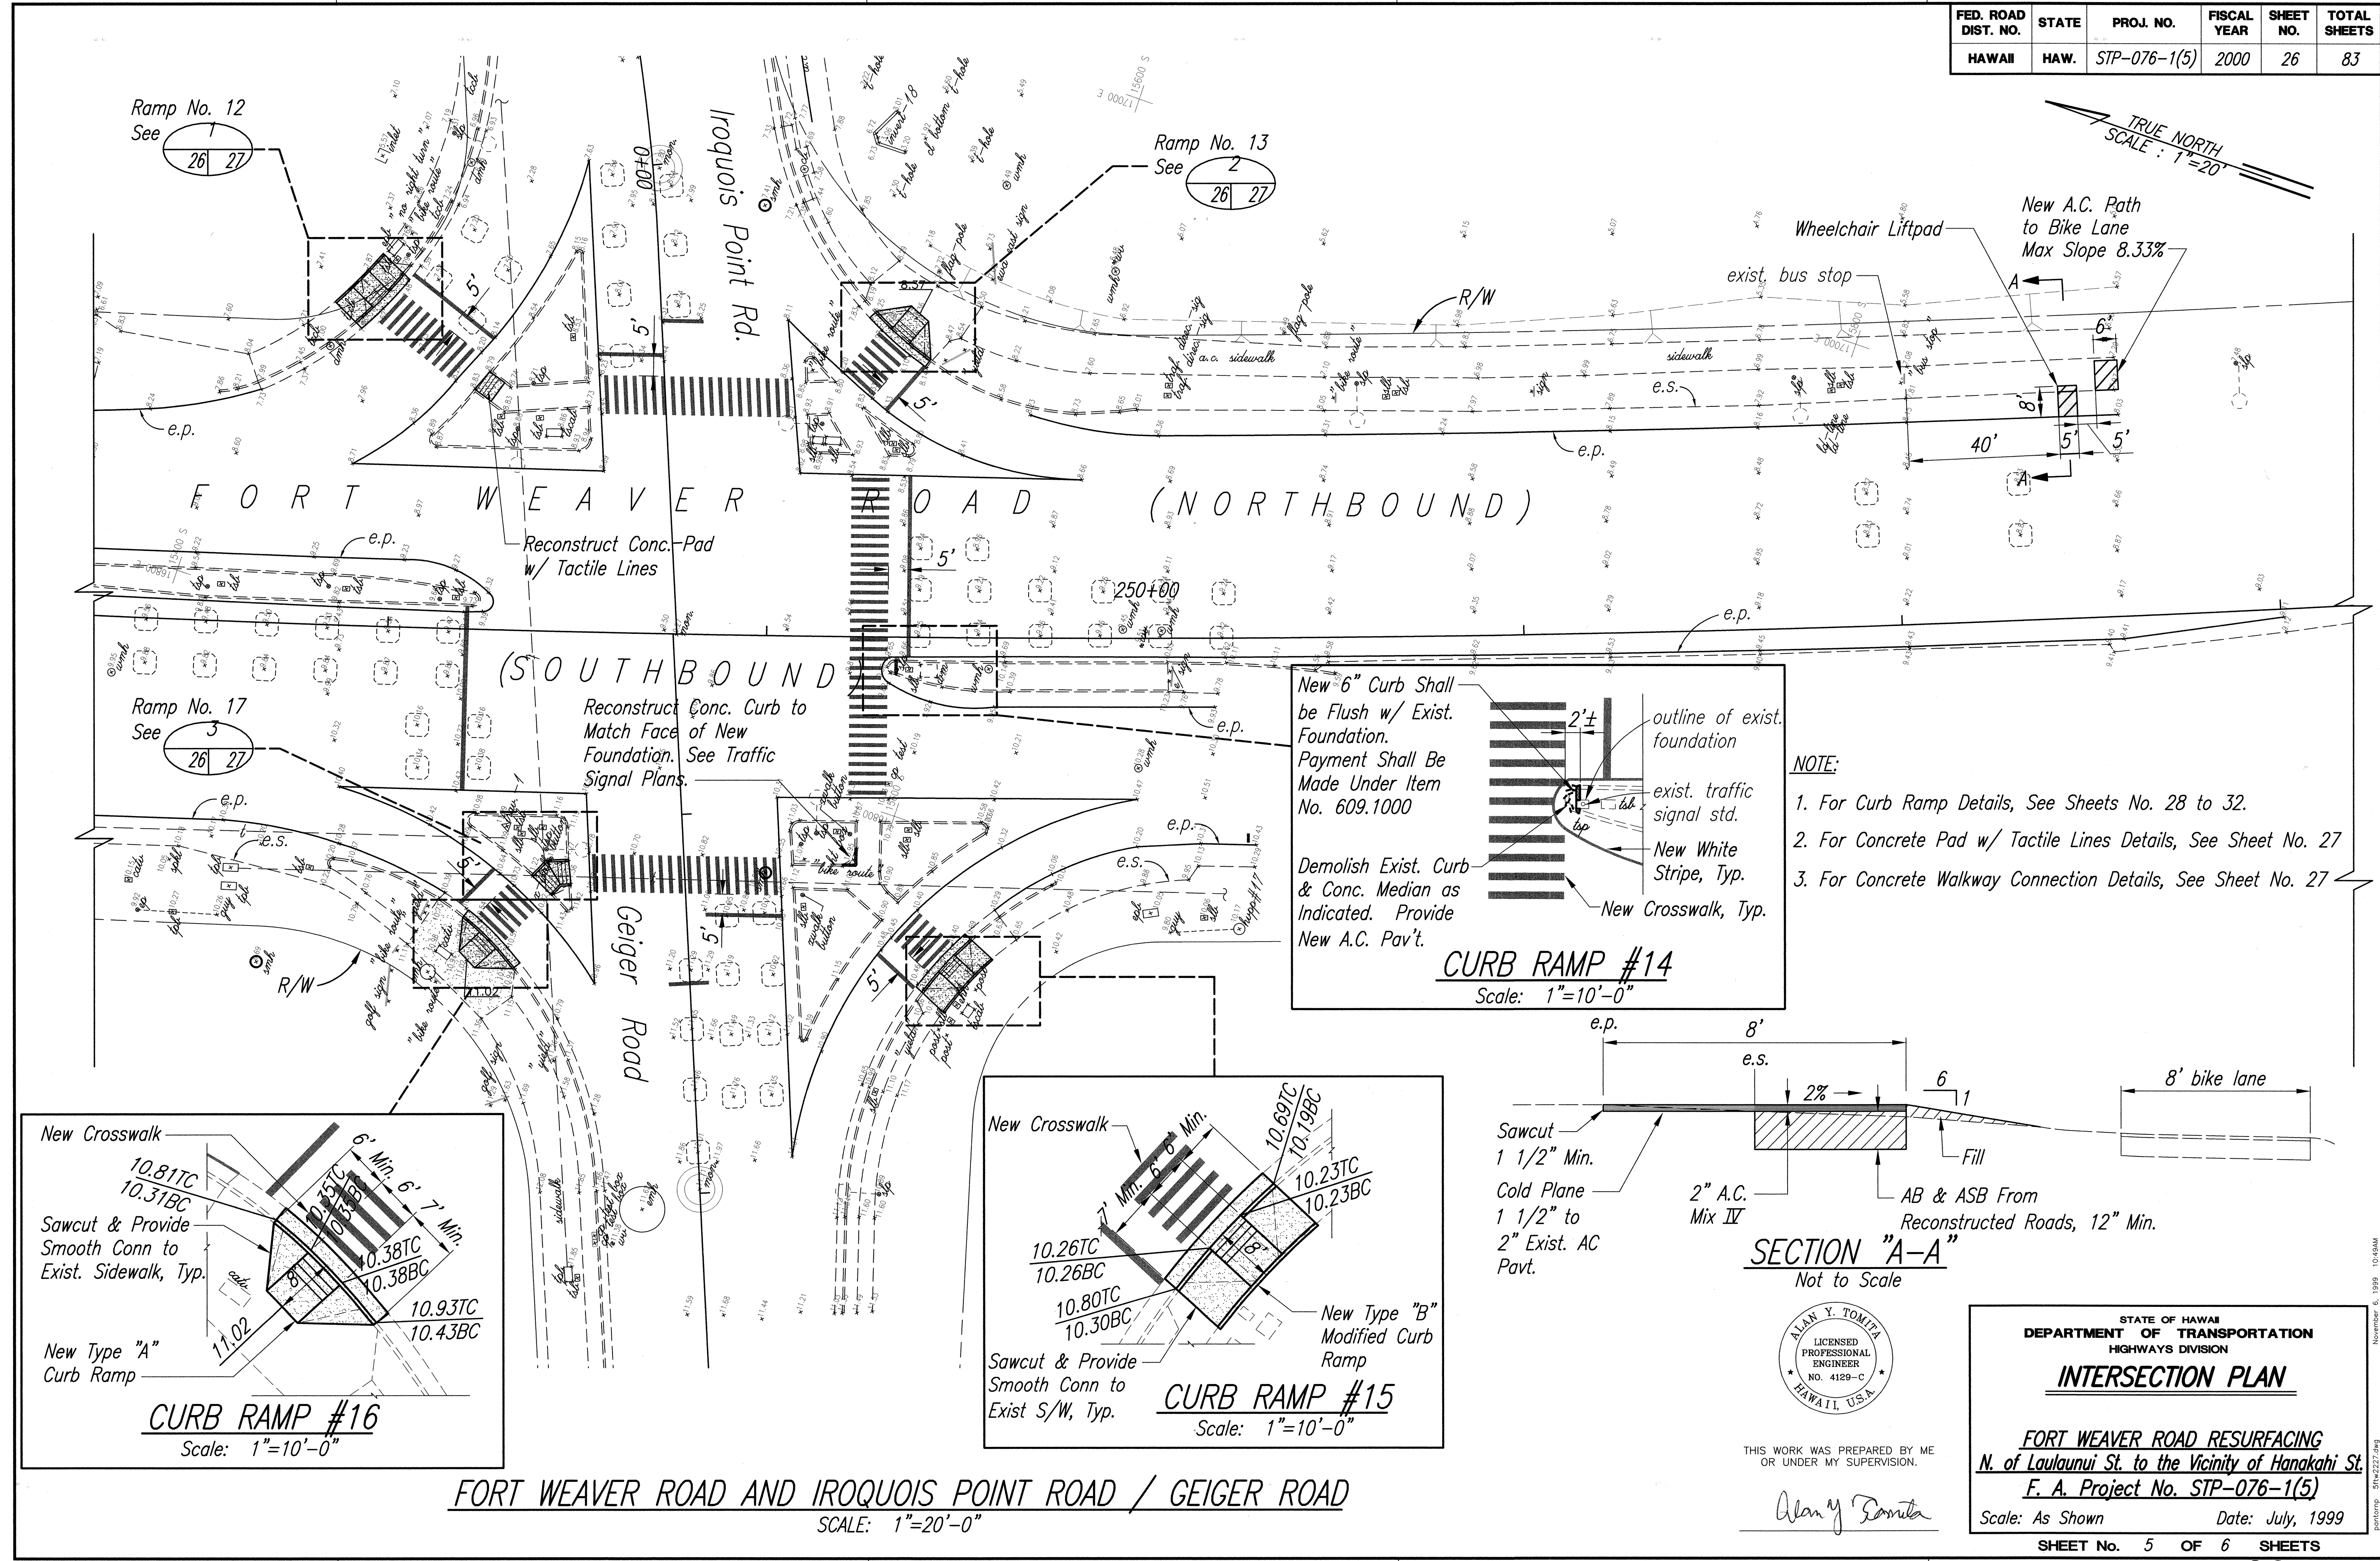


ORIGINAL PLAN	DATE
DRAWN BY	
CHECKED BY	
NOTED BY	
QUANTITIES BY	
CHECKED BY	
No.	


FED. ROAD DIST. NO.	STATE	PROJ. NO.	FISCAL YEAR	SHEET NO.	TOTAL SHEETS
HAWAII	HAW.	STP-076-1(5)	2000	27	83

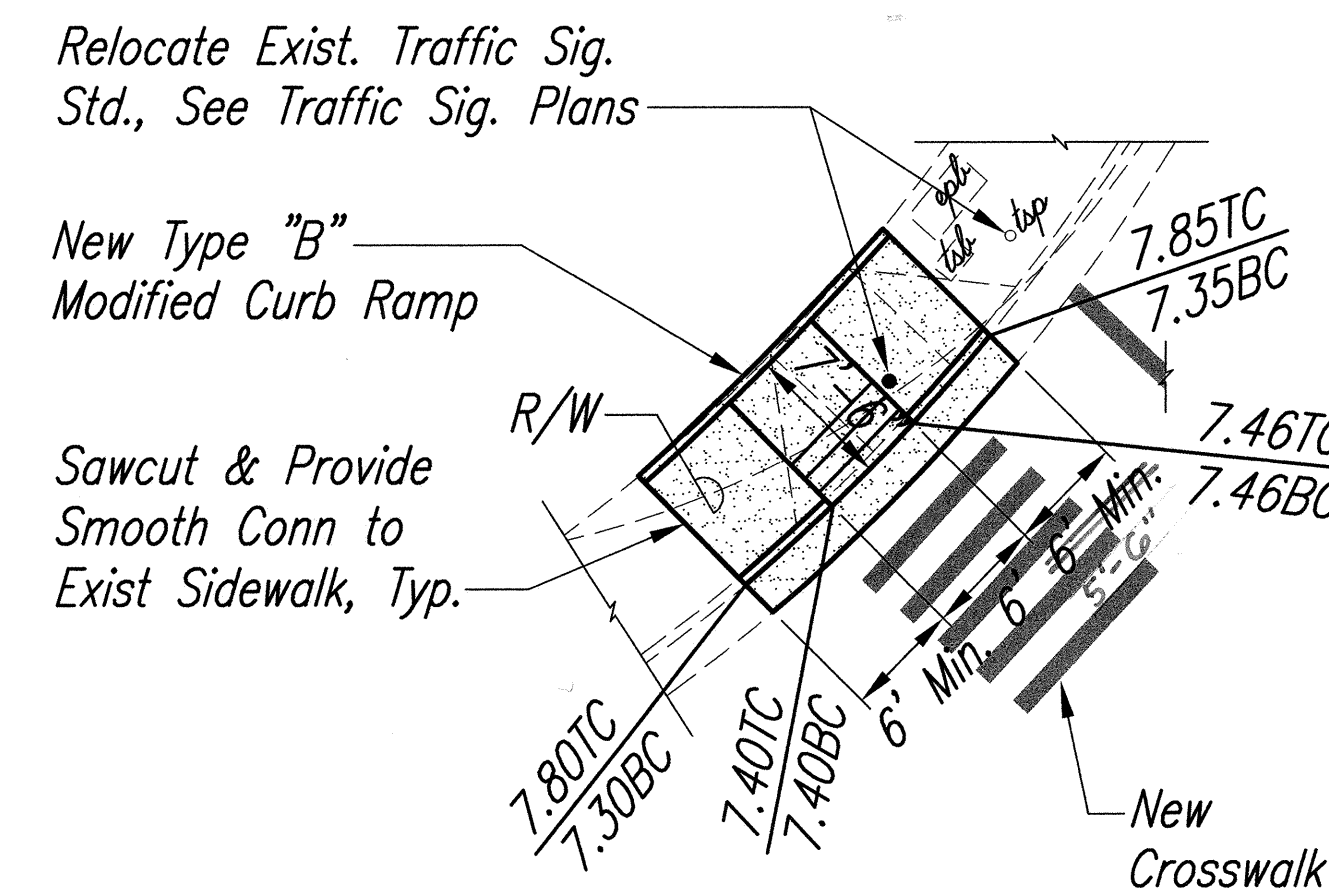


1 CURB RAMP #12
Scale: 1"=10'-0"

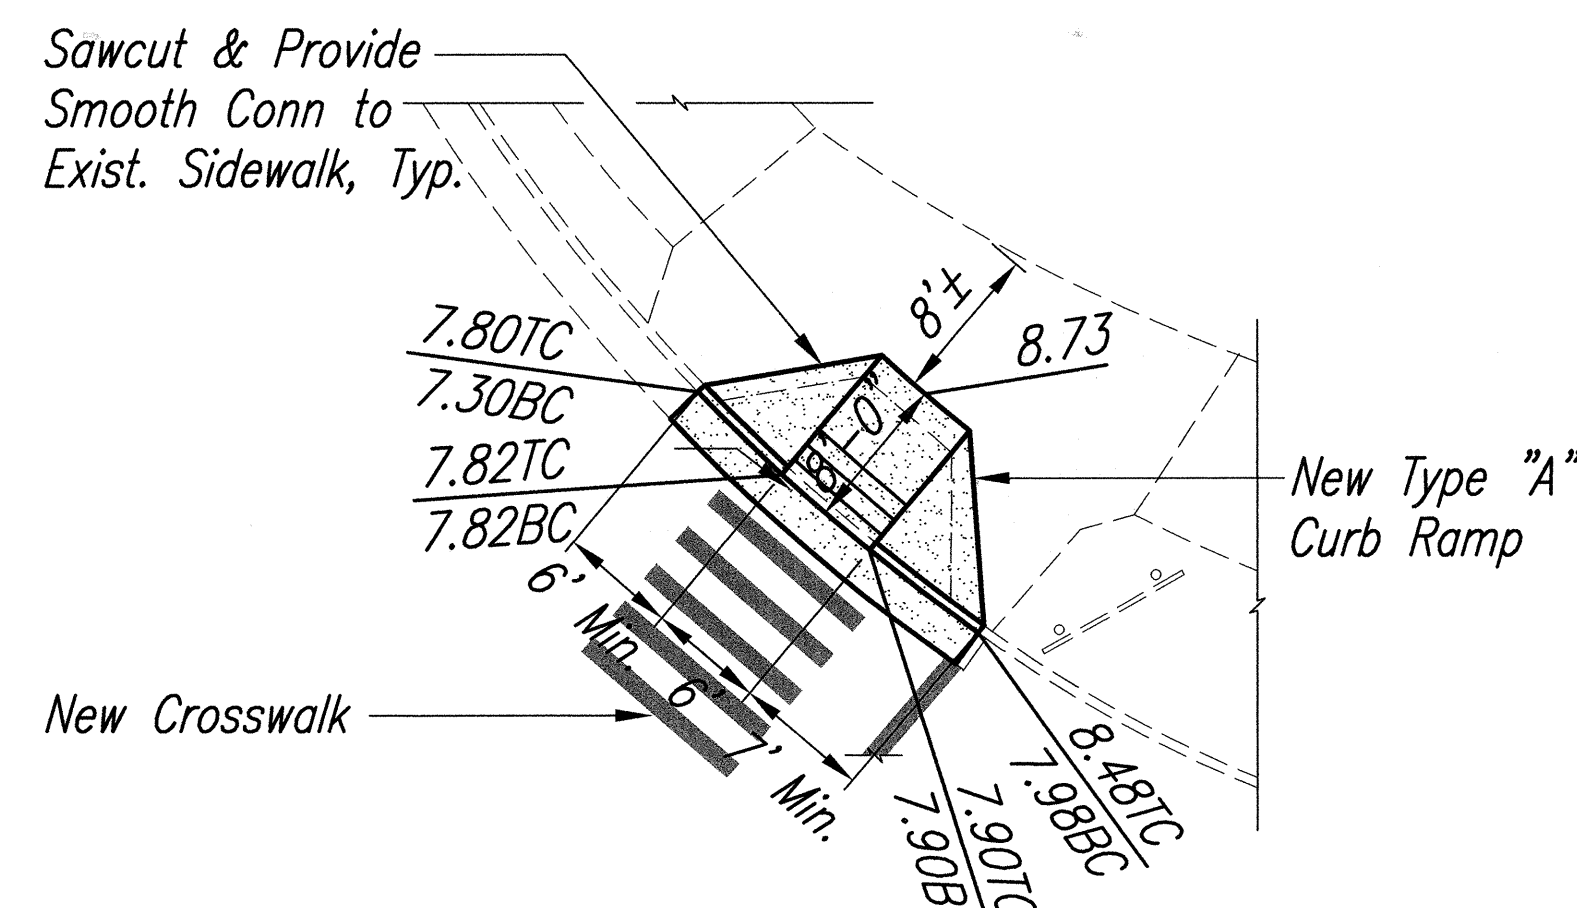


2 CURB RAMP #13
Scale: 1"=10'-0"

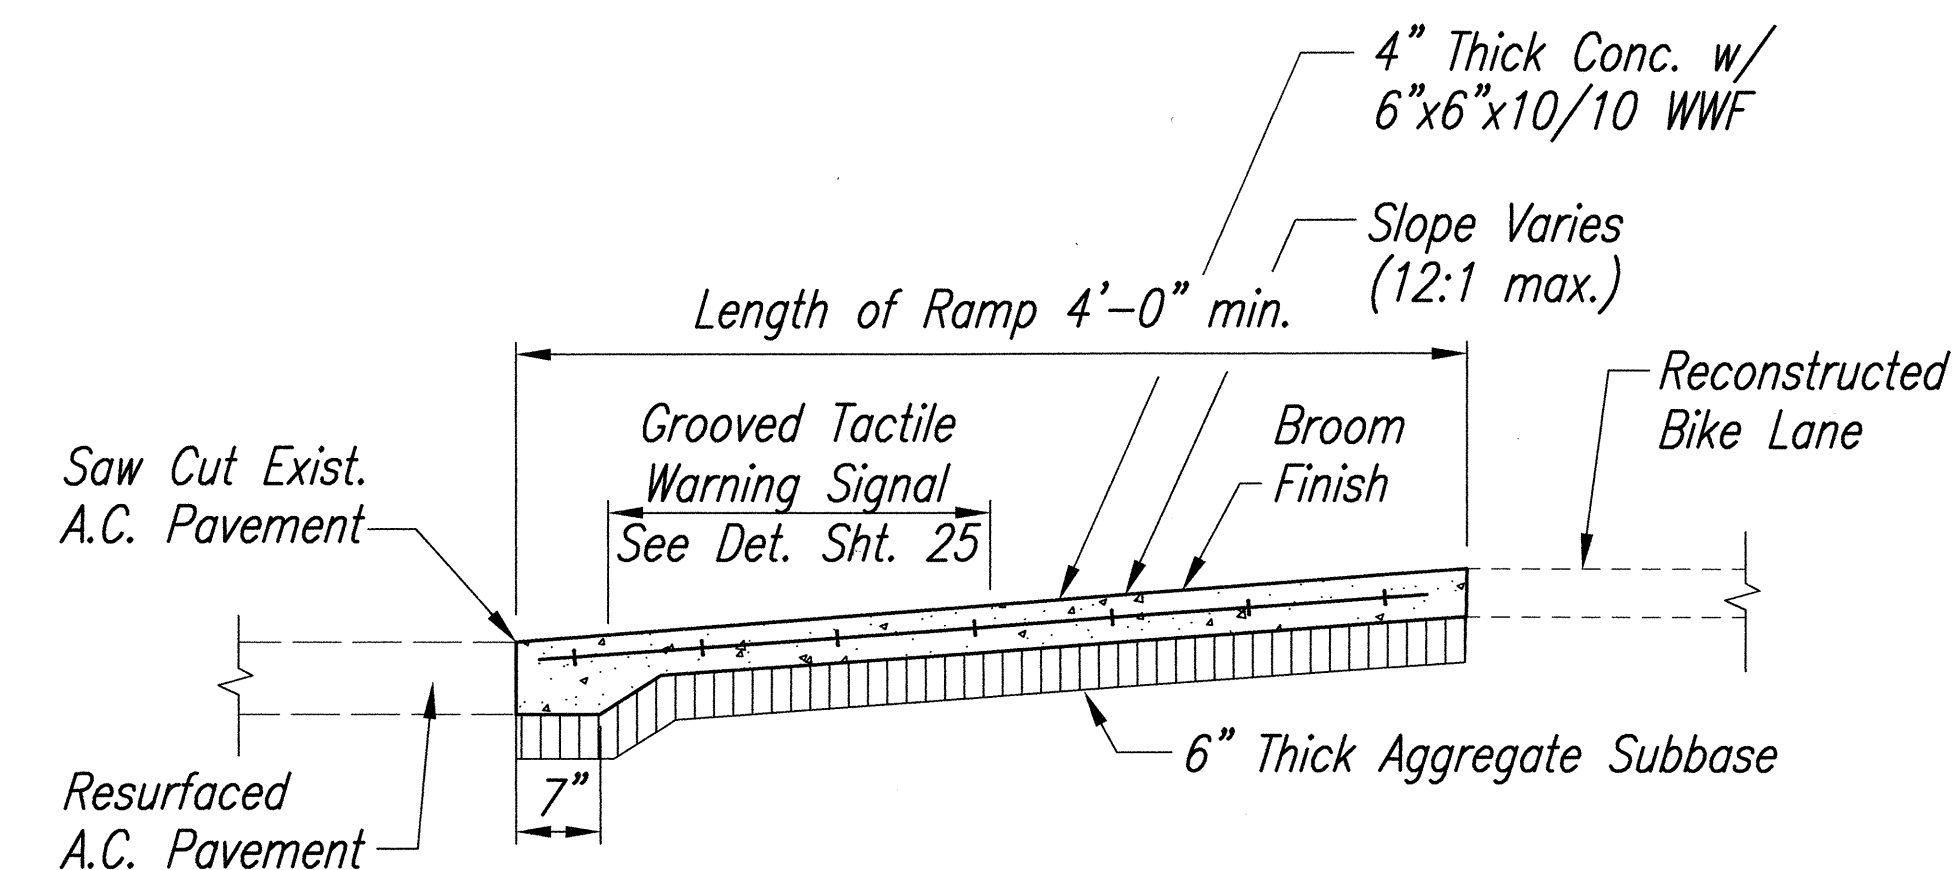

CONCRETE PAD W/TACTILE LINES
Not To Scale

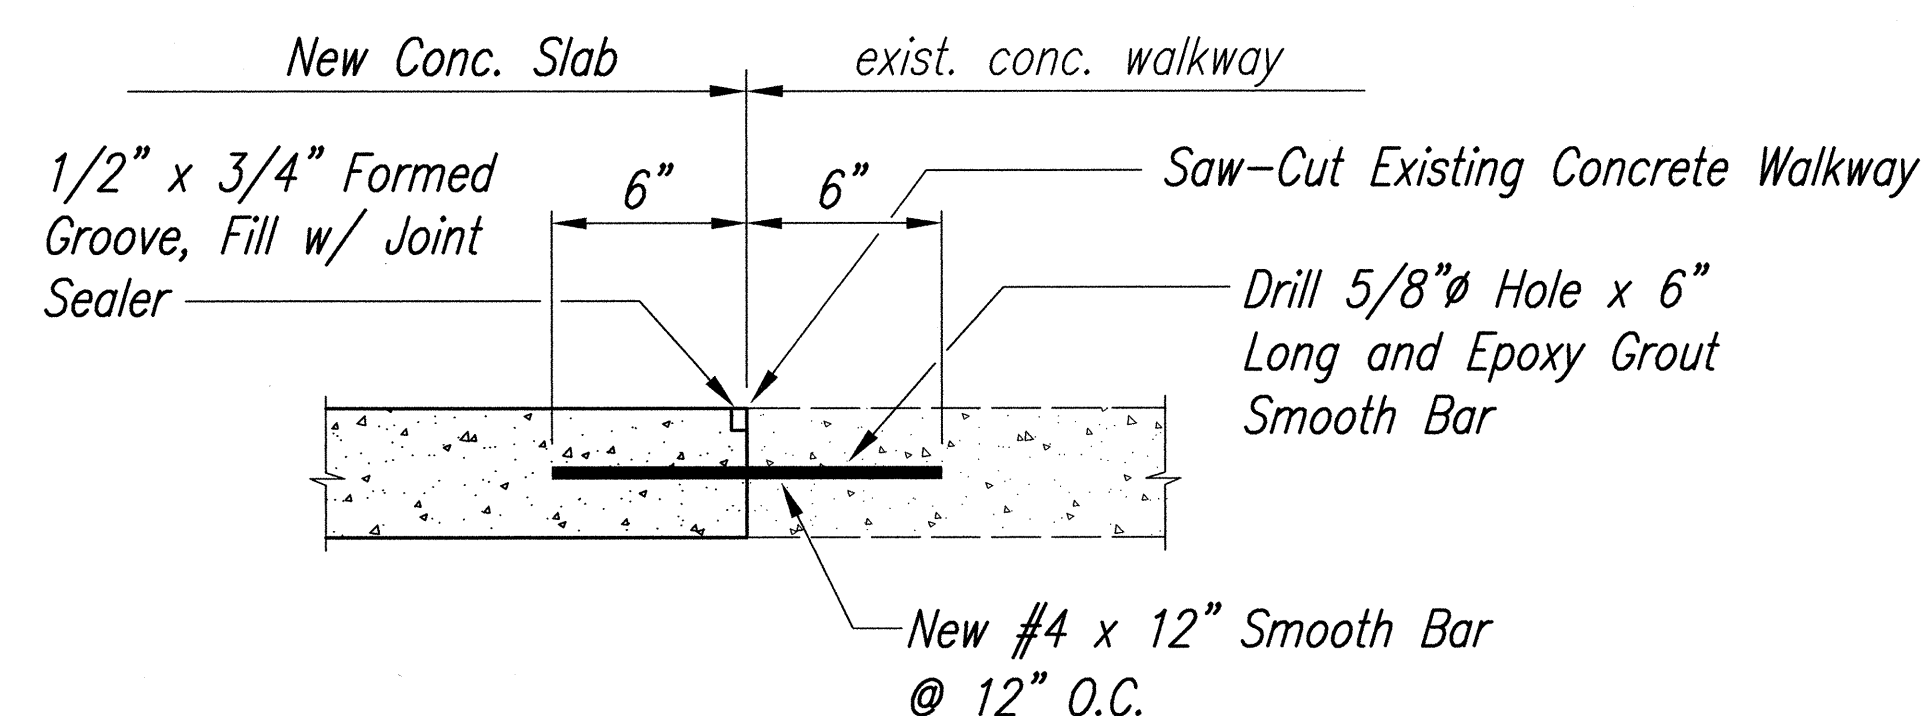


TYP. CONNECTION DETAIL WHERE NEW
SLAB ABUTS EXIST. CONC. WALKWAY
Not To Scale

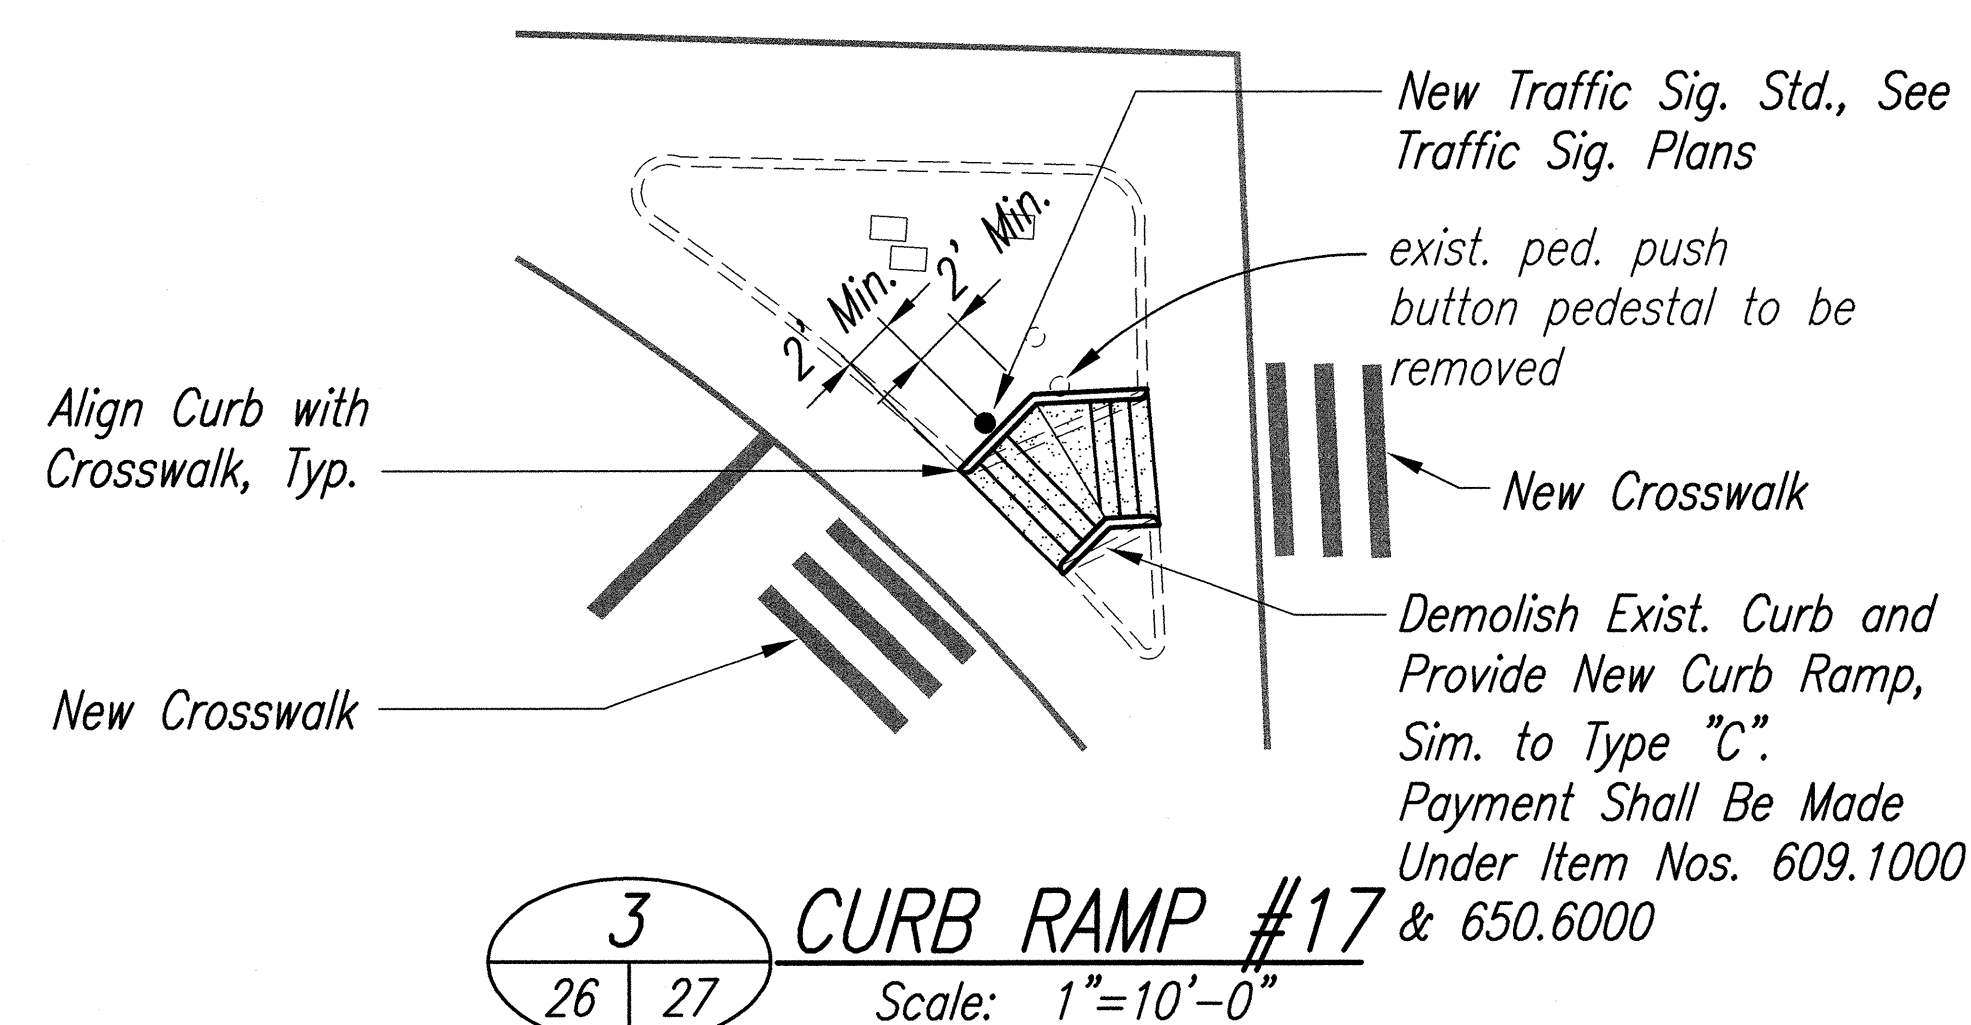

3 CURB RAMP #17
Scale: 1"=10'-0"

ORIGINAL PLAN	DATE
DRAWN BY	
CHECKED BY	
NOTED BY	
QUANTITIES BY	
CHECKED BY	
No.	

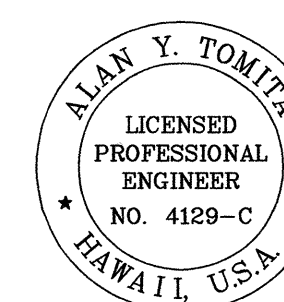

THIS WORK WAS PREPARED BY ME
OR UNDER MY SUPERVISION.

Alan Y. Tomita

STATE OF HAWAII
DEPARTMENT OF TRANSPORTATION
HIGHWAYS DIVISION
INTERSECTION PLAN

FORT WEAVER ROAD RESURFACING
N. of Lualunui St. to the Vicinity of Hanakahi St.
F. A. Project No. STP-076-1(5)
Scale: As Shown Date: July, 1999
SHEET No. 6 OF 6 SHEETS

27

"AS-BUILT"