

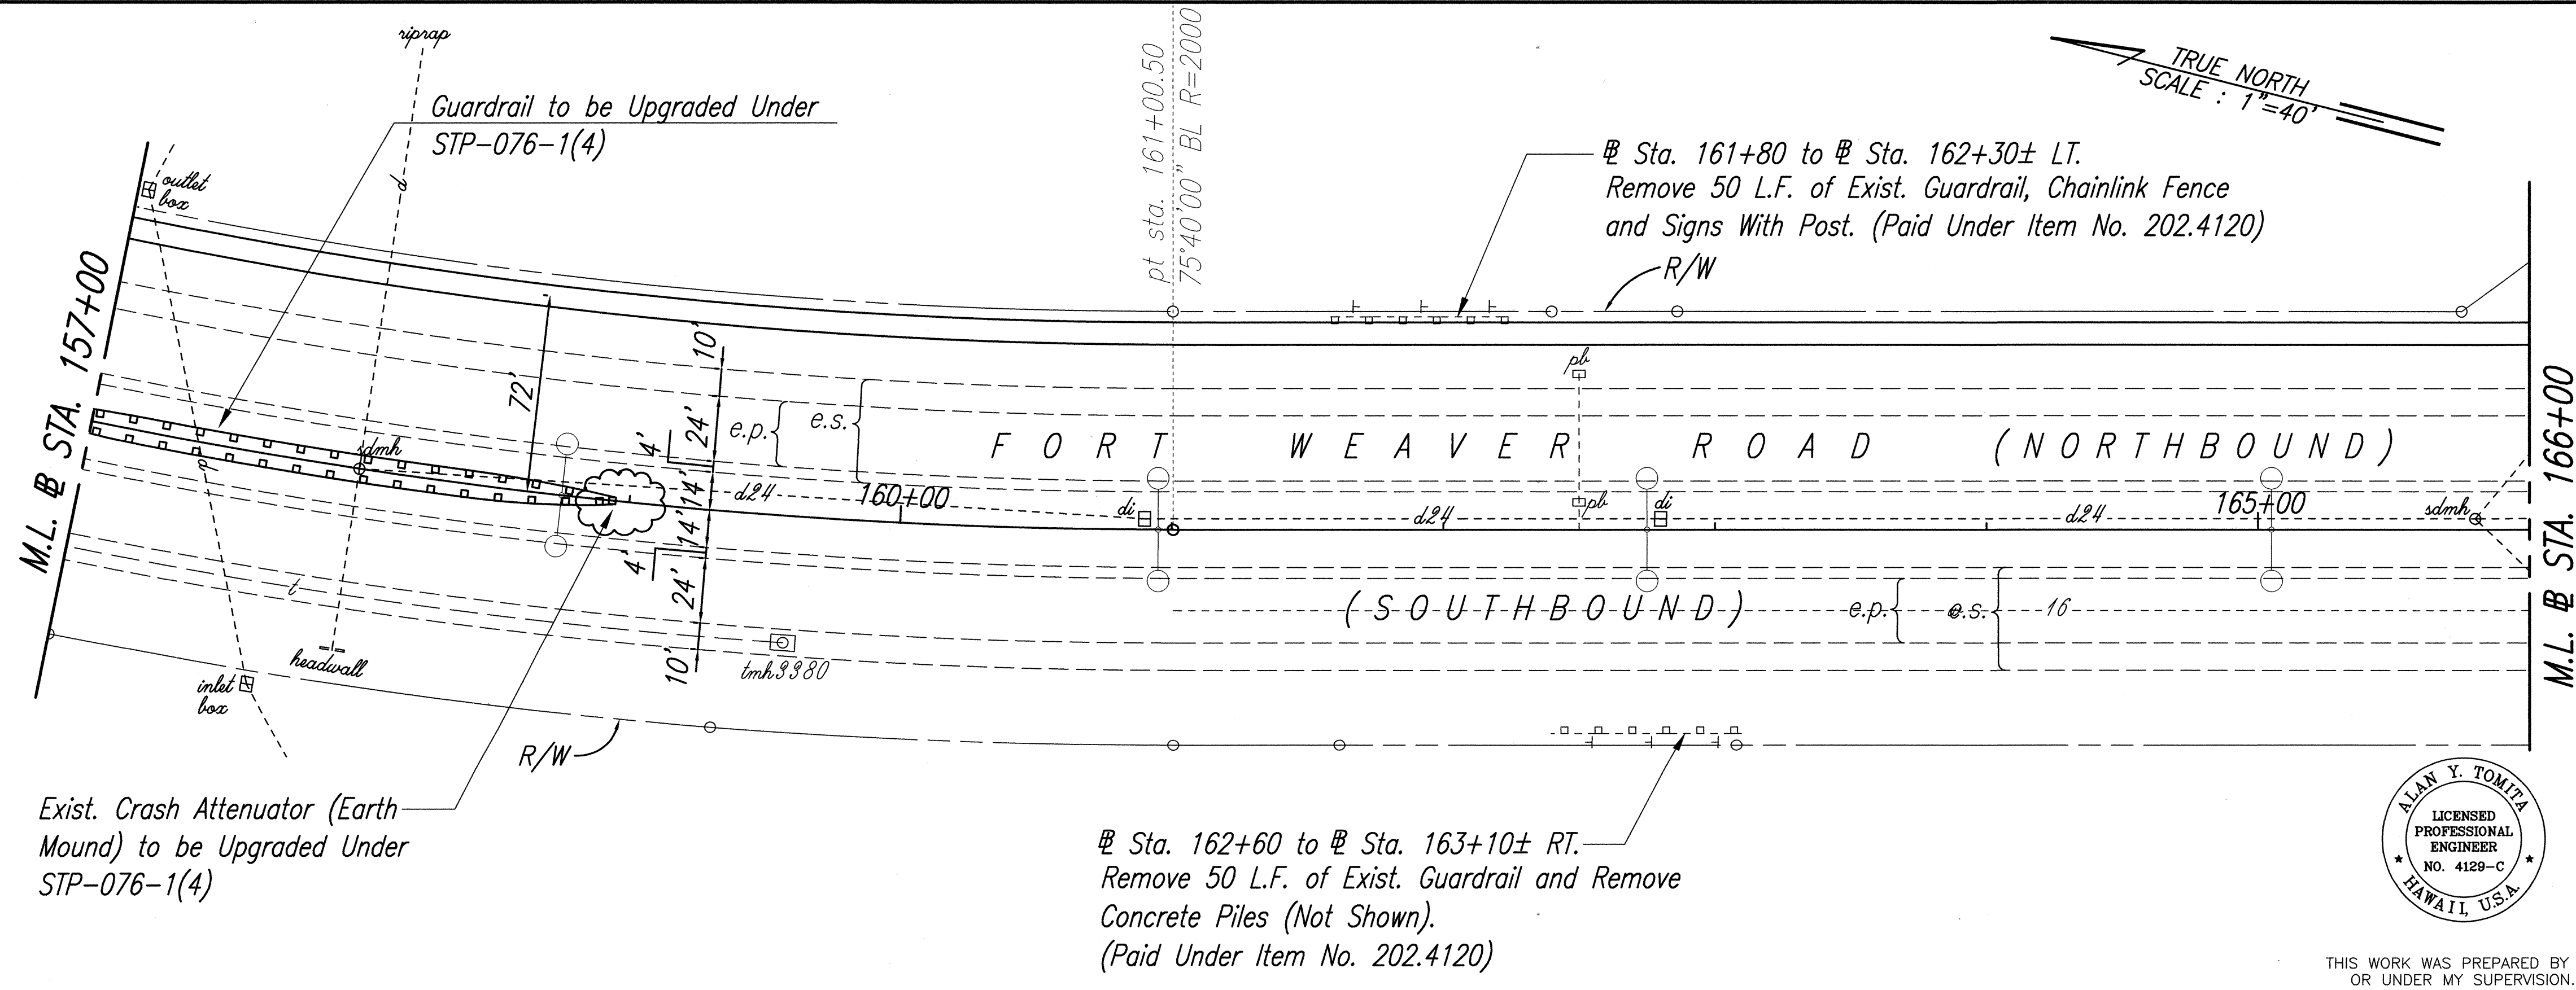


FED. ROAD DIST. NO.	STATE	PROJ. NO.	FISCAL YEAR	SHEET NO.	TOTAL SHEETS
HAWAII	HAW.	STP-076-1(5)	2000	15	83

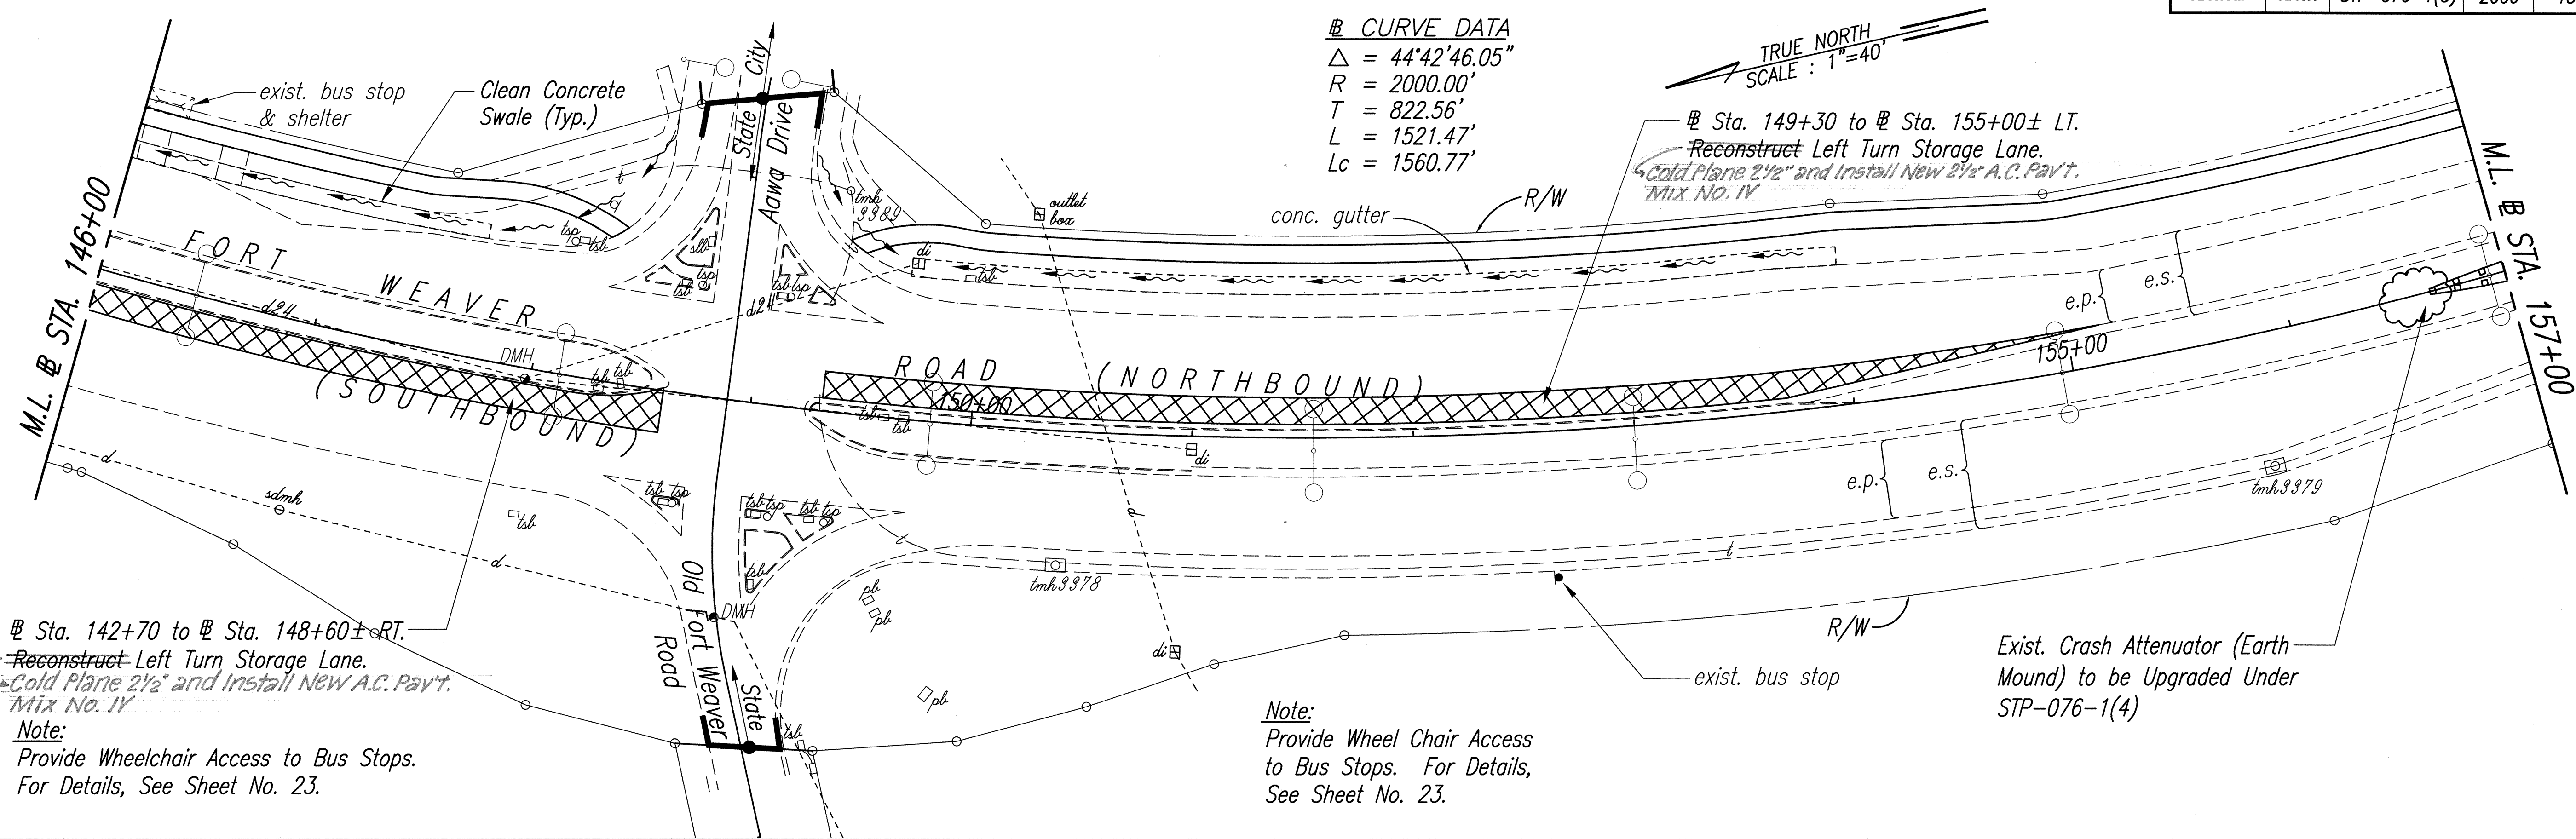

ORIGINAL PLAN	SURVEY PLOTTED BY	DATE
TRACED BY		
QUANTITIES BY		
CHECKED BY		
No.		

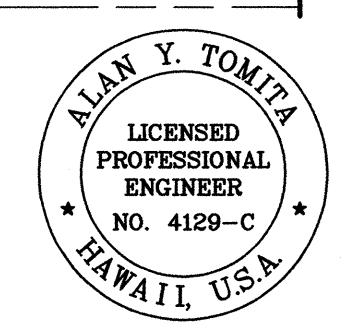

THIS WORK WAS PREPARED BY ME
OR UNDER MY SUPERVISION.





Alan Y. Tomita

STATE OF HAWAII
DEPARTMENT OF TRANSPORTATION
HIGHWAYS DIVISION
ROADWAY PLAN

FORT WEAVER ROAD RESURFACING
N. of Lualuani St. to the Vicinity of Hanakahi St.
F. A. Project No. STP-076-1(5)
Scale: As Shown Date: July, 1999
SHEET No. 3 OF 9 SHEETS

"AS-BUILT"

FED. ROAD DIST. NO.	STATE	PROJ. NO.	FISCAL YEAR	SHEET NO.	TOTAL SHEETS
HAWAII	HAW.	STP-076-1(5)	2000	C.O. 16	83

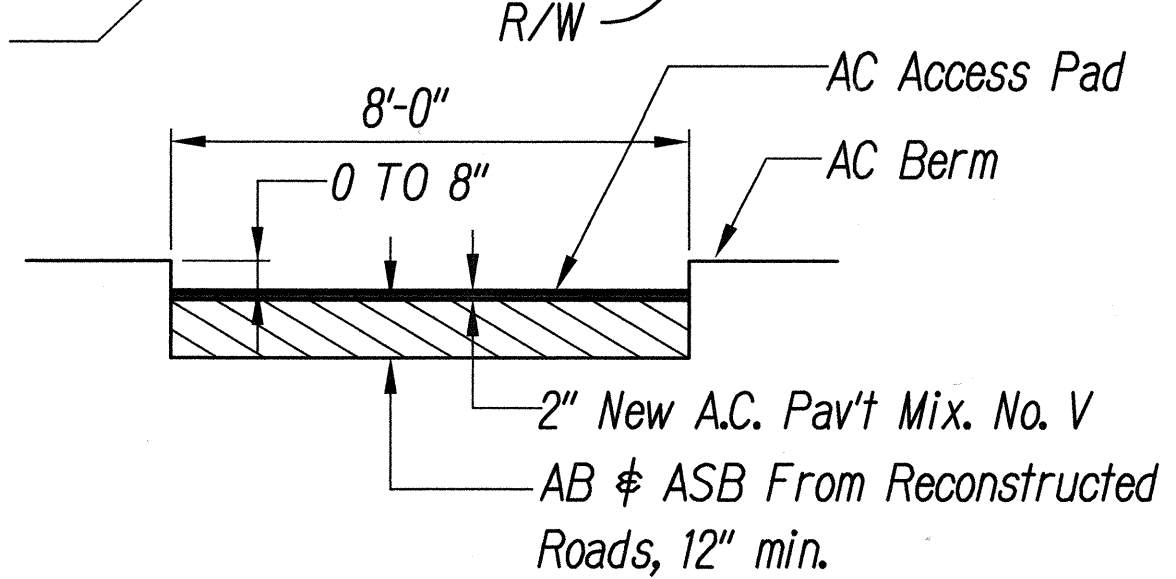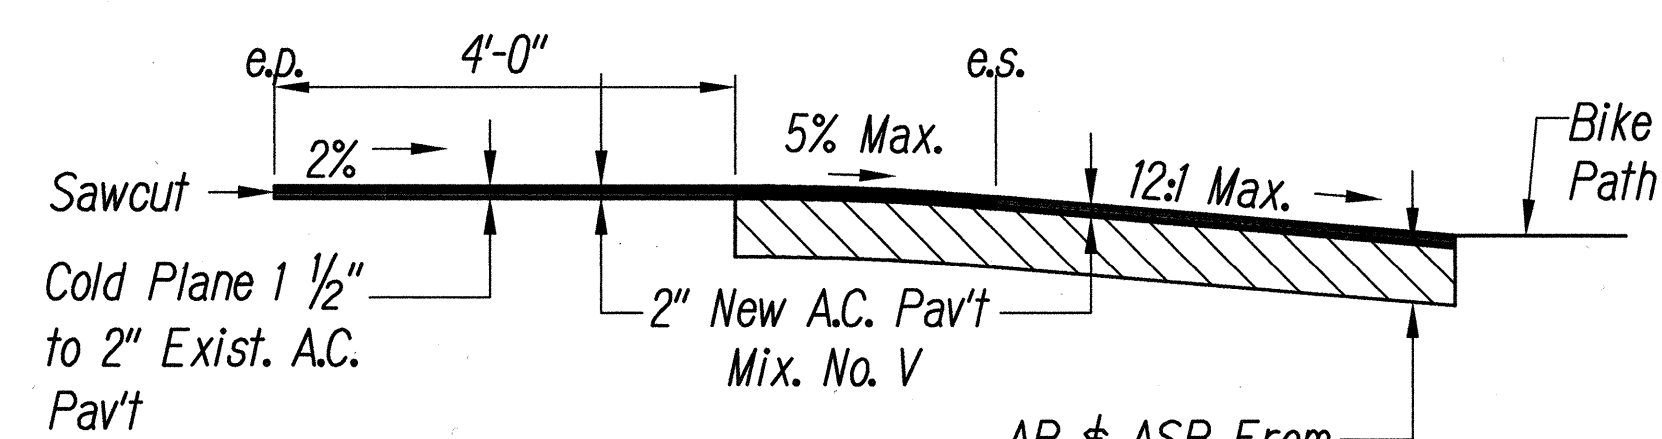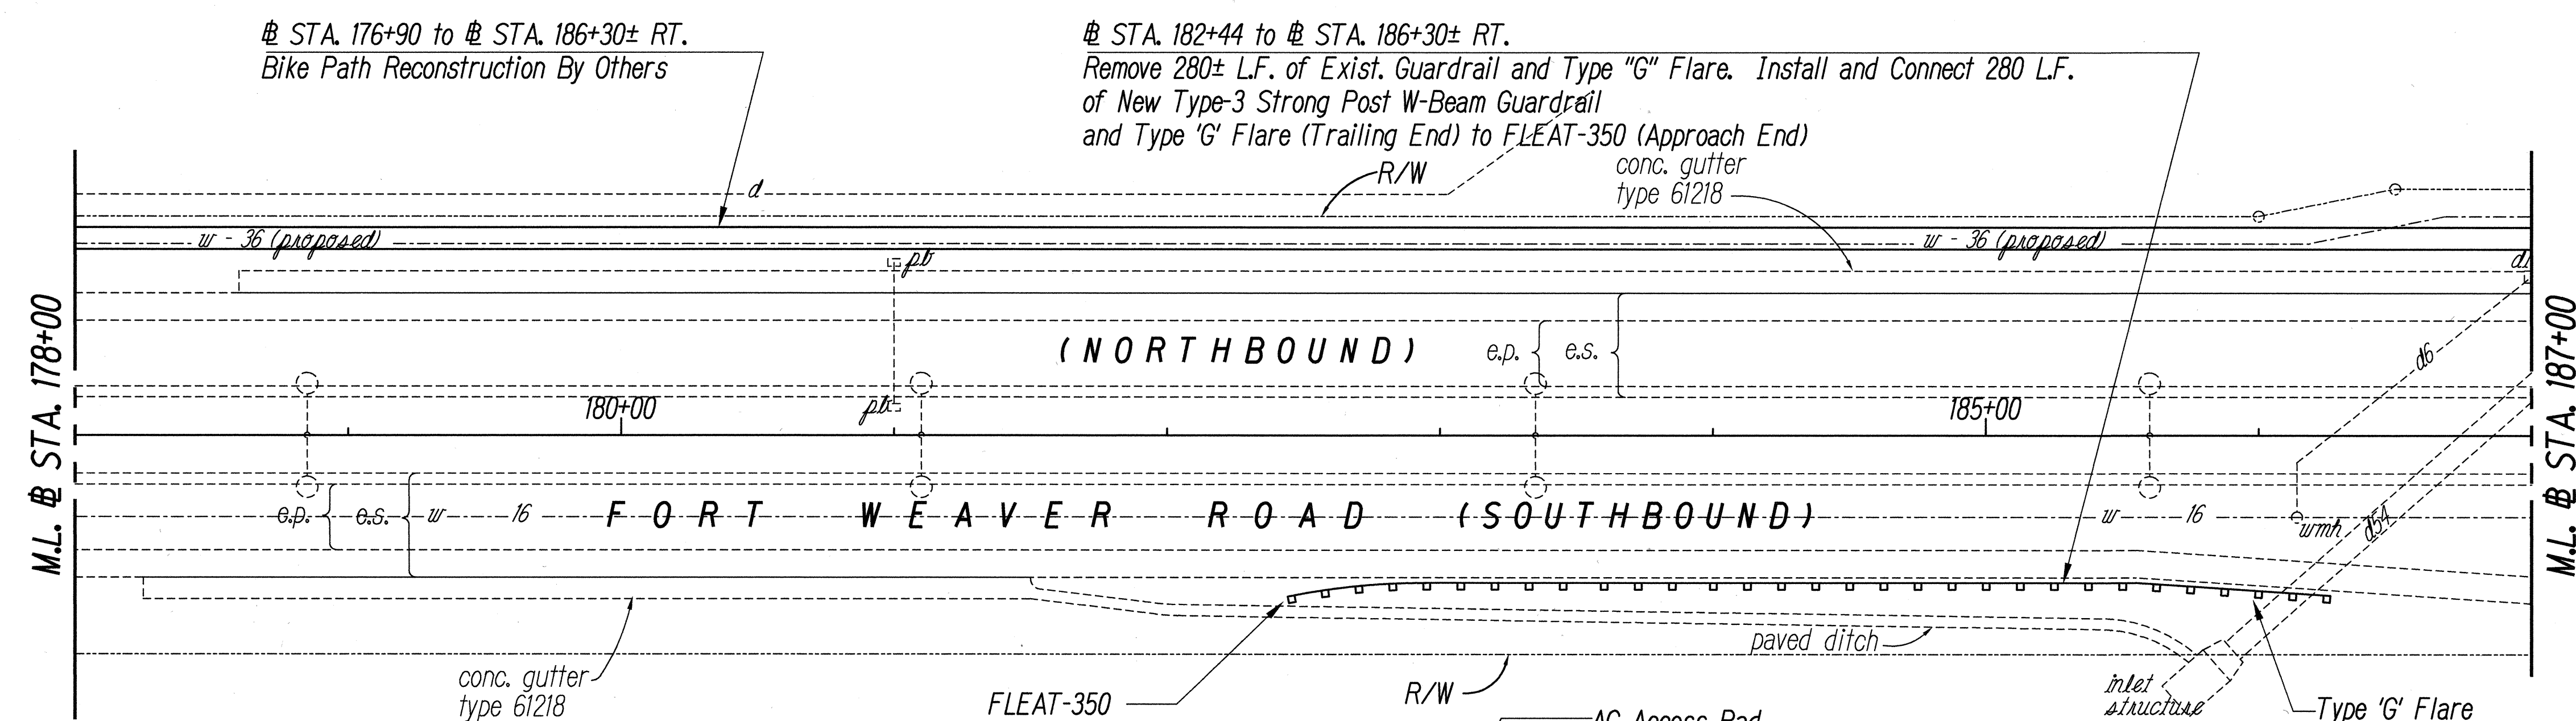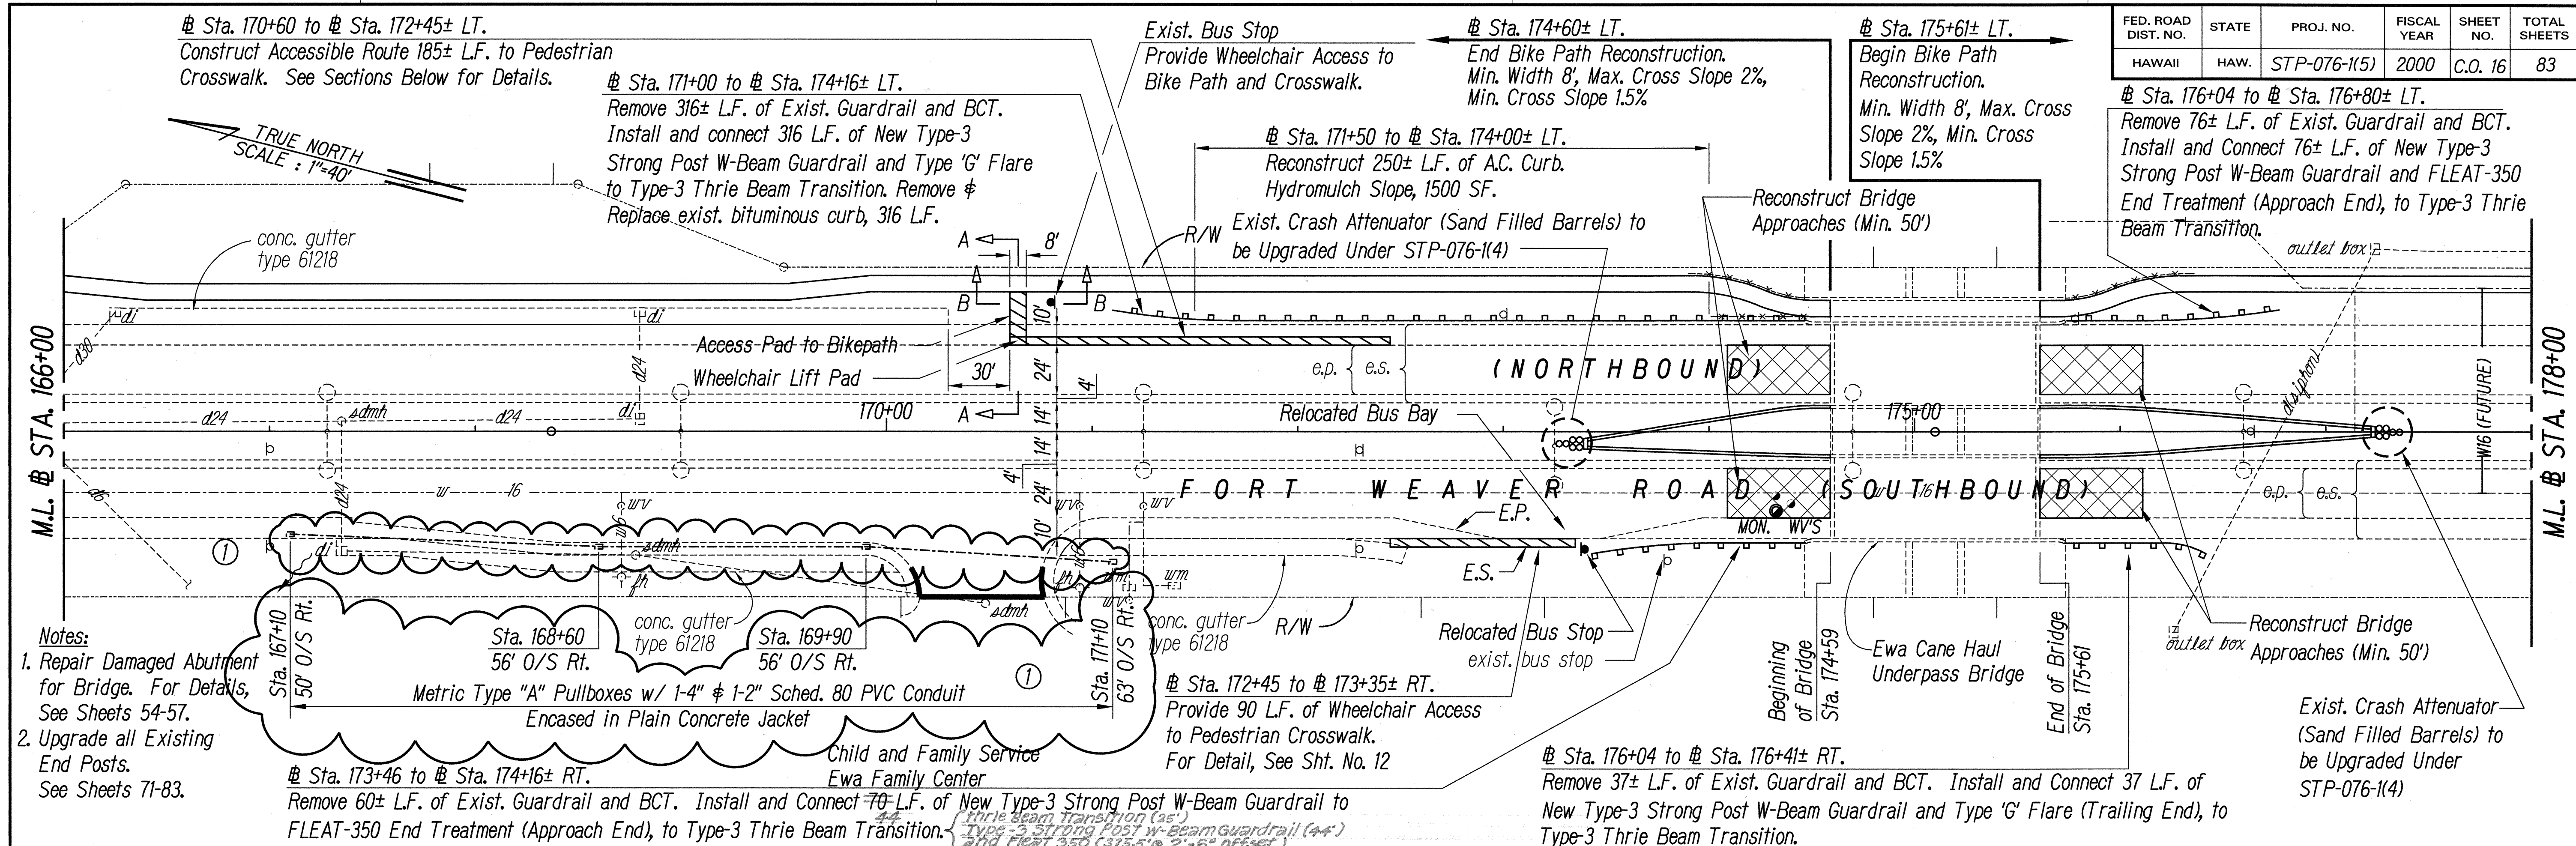

ALAN Y. TOMITA

LICENSED
PROFESSIONAL
ENGINEER

NO. 4129-C



HAWAII, U.S.A.

THIS WORK WAS PREPARED BY ME
OR UNDER MY SUPERVISION.


Alan Y. Tomita

7/13/01	Added Traffic Signal Pullboxes w/ Conduits
①	
Date	Revision
STATE OF HAWAII DEPARTMENT OF TRANSPORTATION HIGHWAYS DIVISION <u>ROADWAY PLAN</u> <u>FORT WEAVER ROAD RESURFACING</u> <u>N. of Laulaunui St. to the Vicinity of Hanakahi St.</u> <u>E. A. Project No. STP-076-1(5)</u> Scale: As Shown Date: July, 1999	
SHEET No. 4 OF 9 SHEETS	

FED. ROAD DIST. NO.	STATE	PROJ. NO.	FISCAL YEAR	SHEET NO.	TOTAL SHEETS
HAWAII	HAW.	STP-076-1(5)	2000	18	83

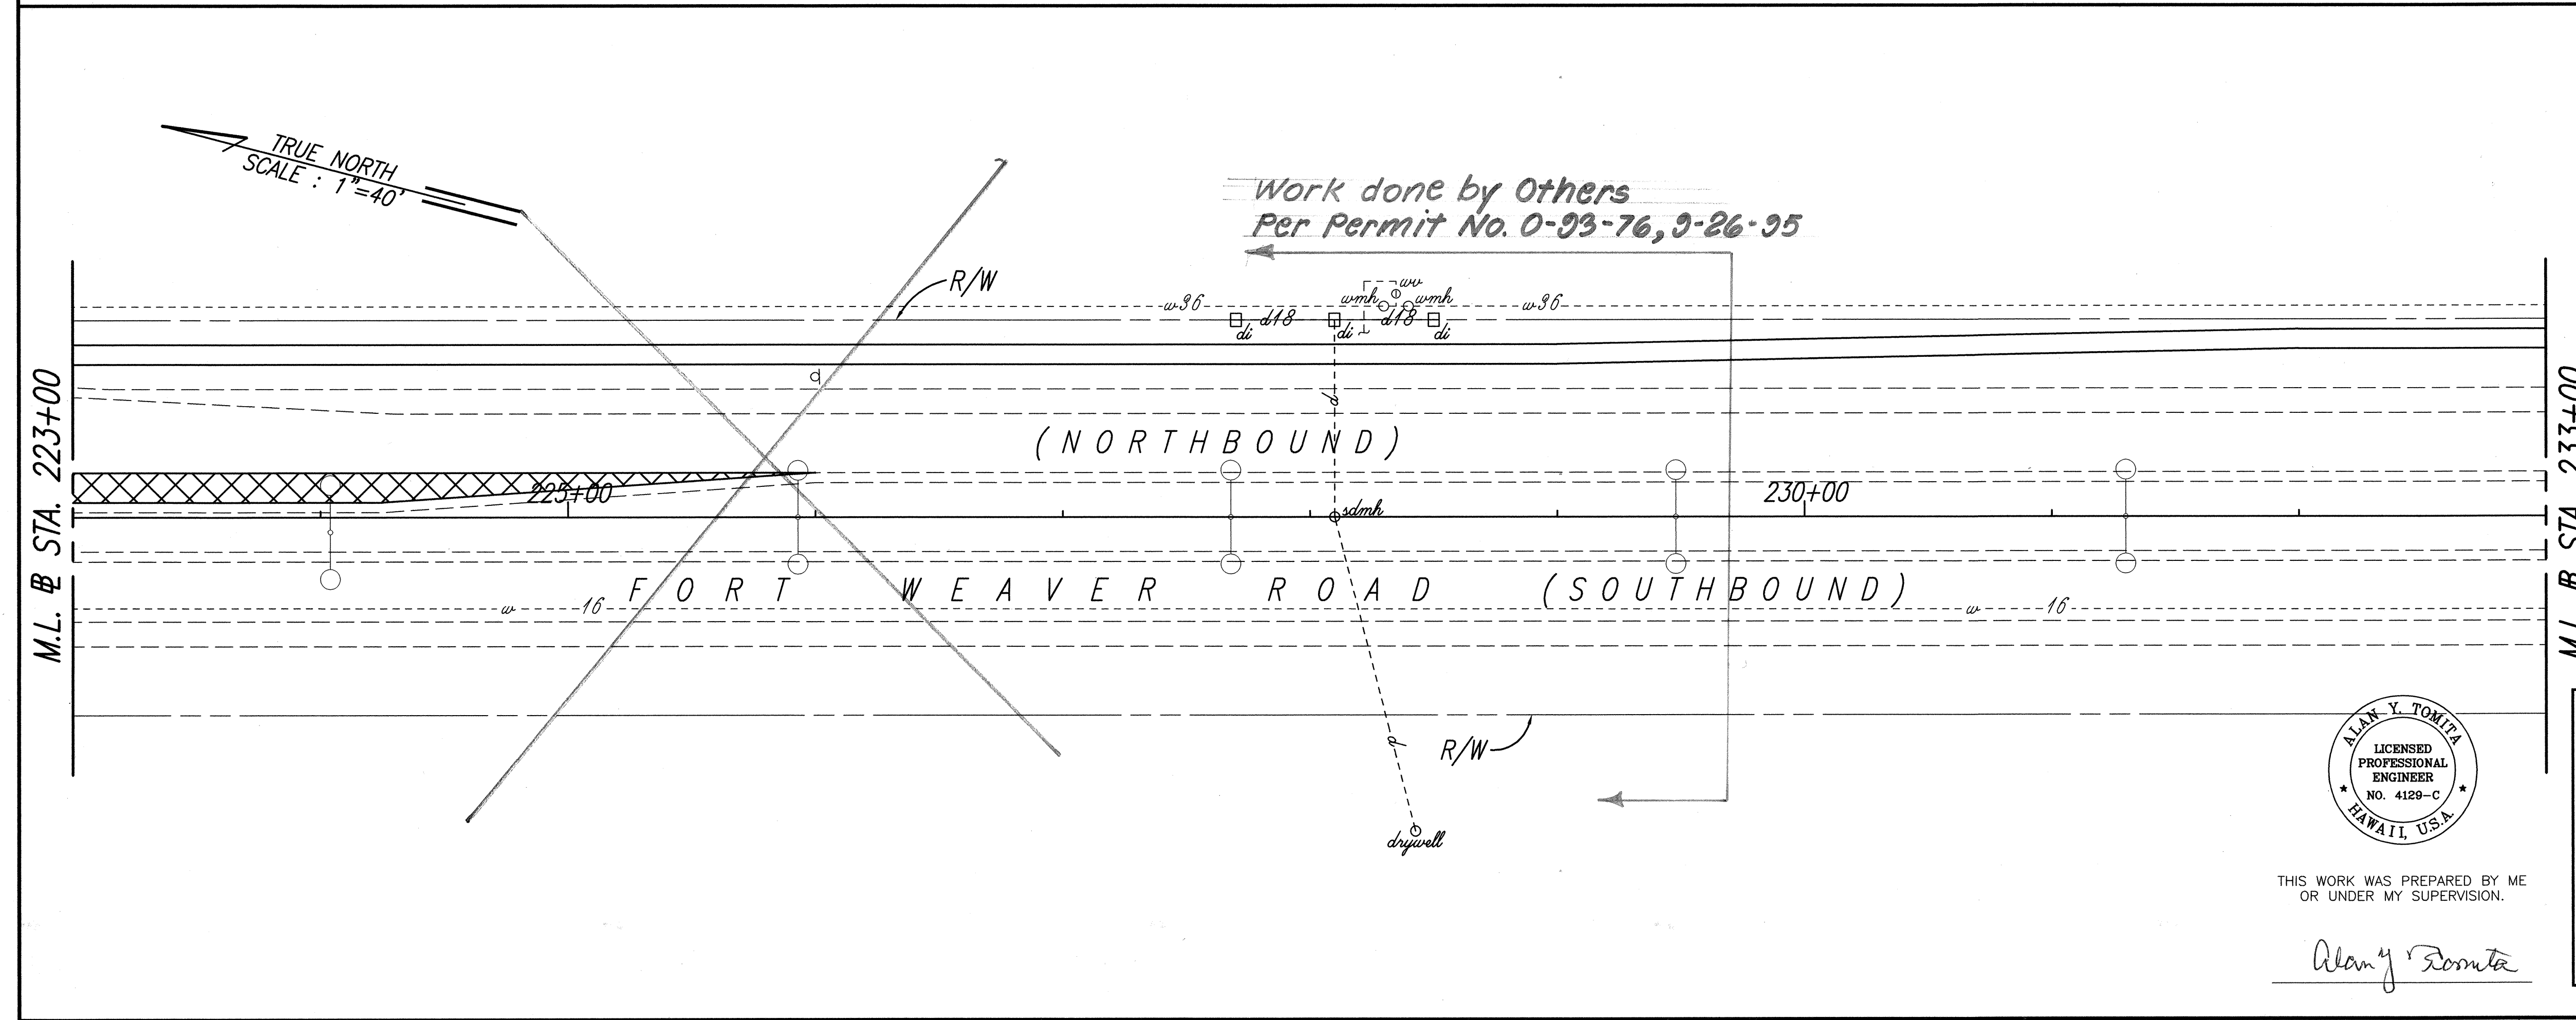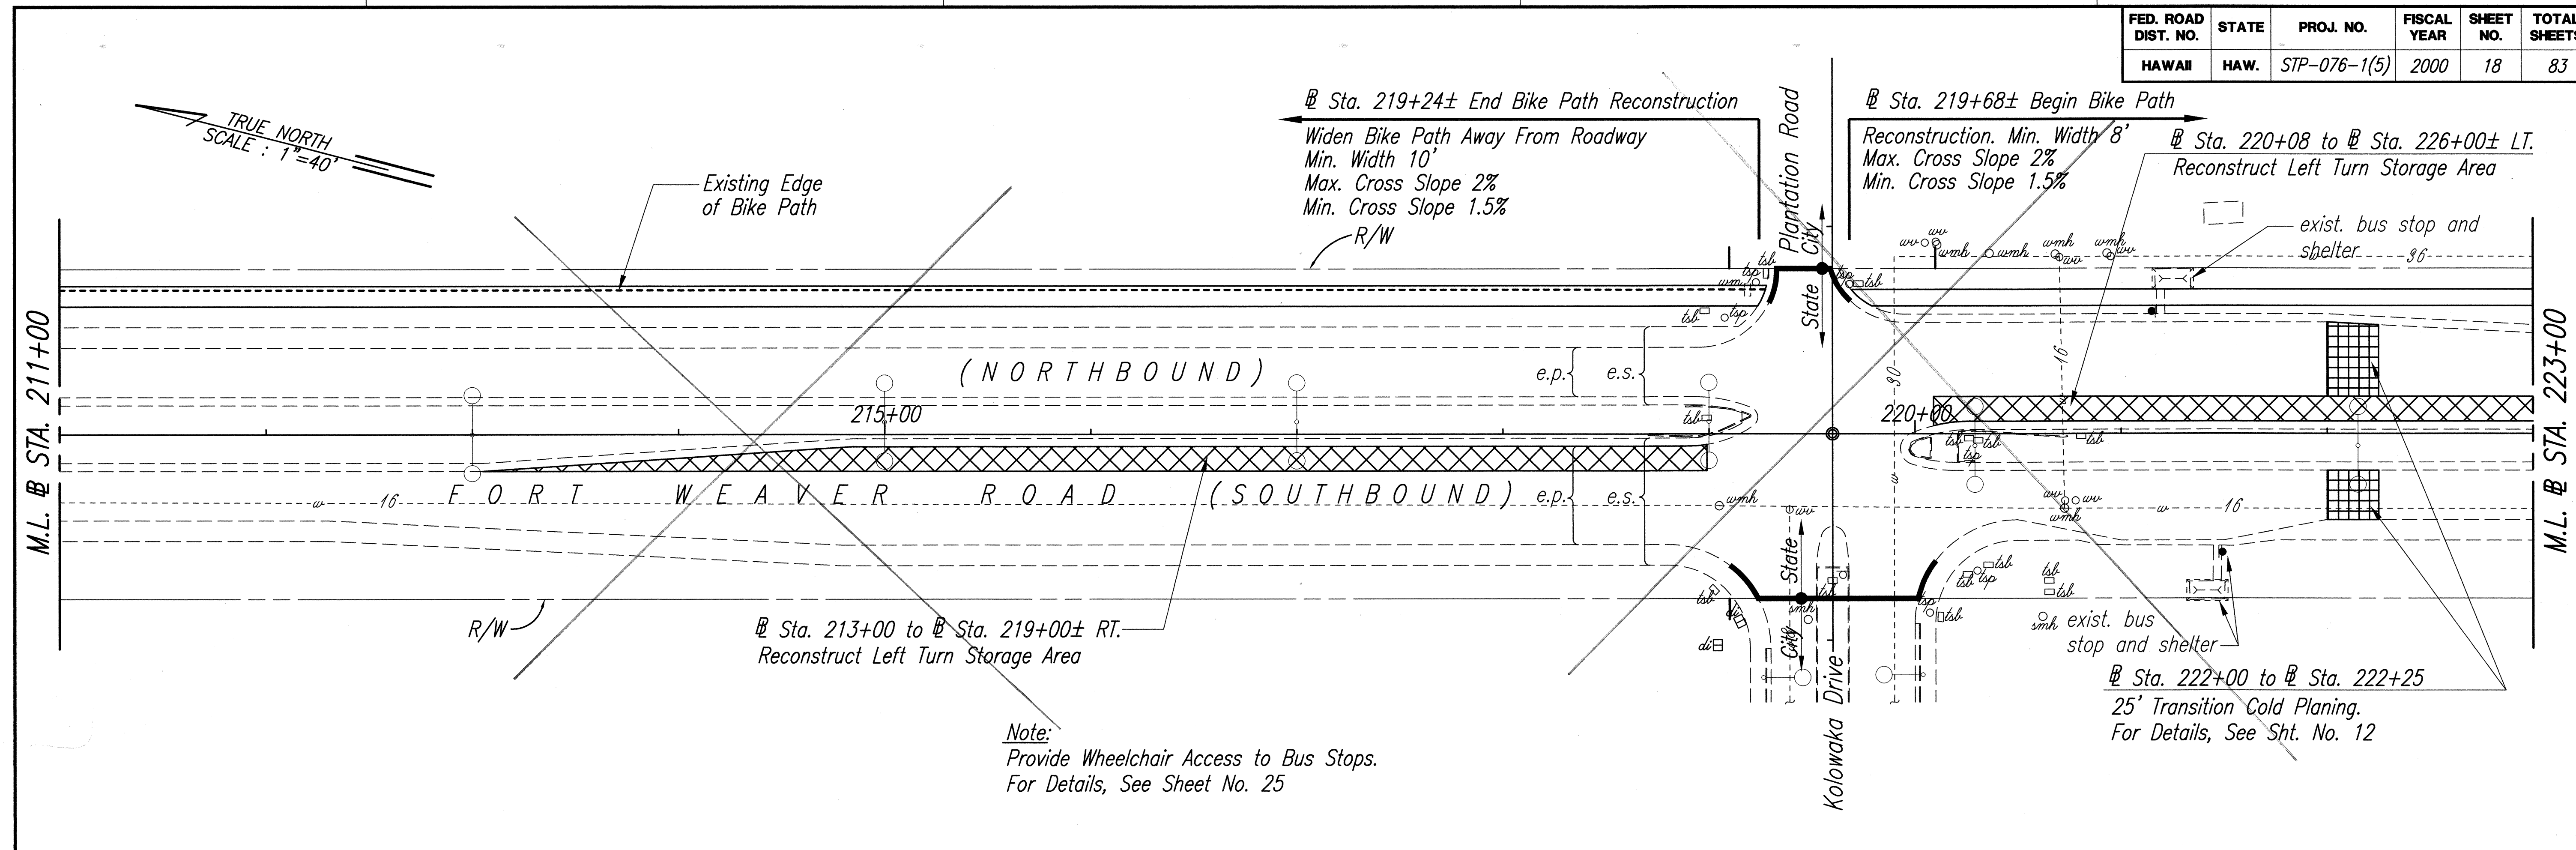

ORIGINAL PLAN	SURVEY PLOTTED BY	DATE
TRACED BY		
QUANTITIES BY		
CHECKED BY		
No.		

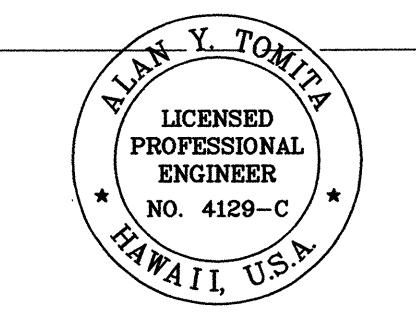

THIS WORK WAS PREPARED BY ME OR UNDER MY SUPERVISION.

Alan Y. Tomita

STATE OF HAWAII
DEPARTMENT OF TRANSPORTATION
HIGHWAYS DIVISION

ROADWAY PLAN



FORT WEAVER ROAD RESURFACING
N. of Laulauui St. to the Vicinity of Hanakahi St.
F. A. Project No. STP-076-1(5)

Scale: As Shown Date: July, 1999

SHEET No. 6 OF 9 SHEETS

"1/2" BUILT"

FED. ROAD DIST. NO.	STATE	PROJ. NO.	FISCAL YEAR	SHEET NO.	TOTAL SHEETS
HAWAII	HAW.	STP-076-1(5)	2000	19	83

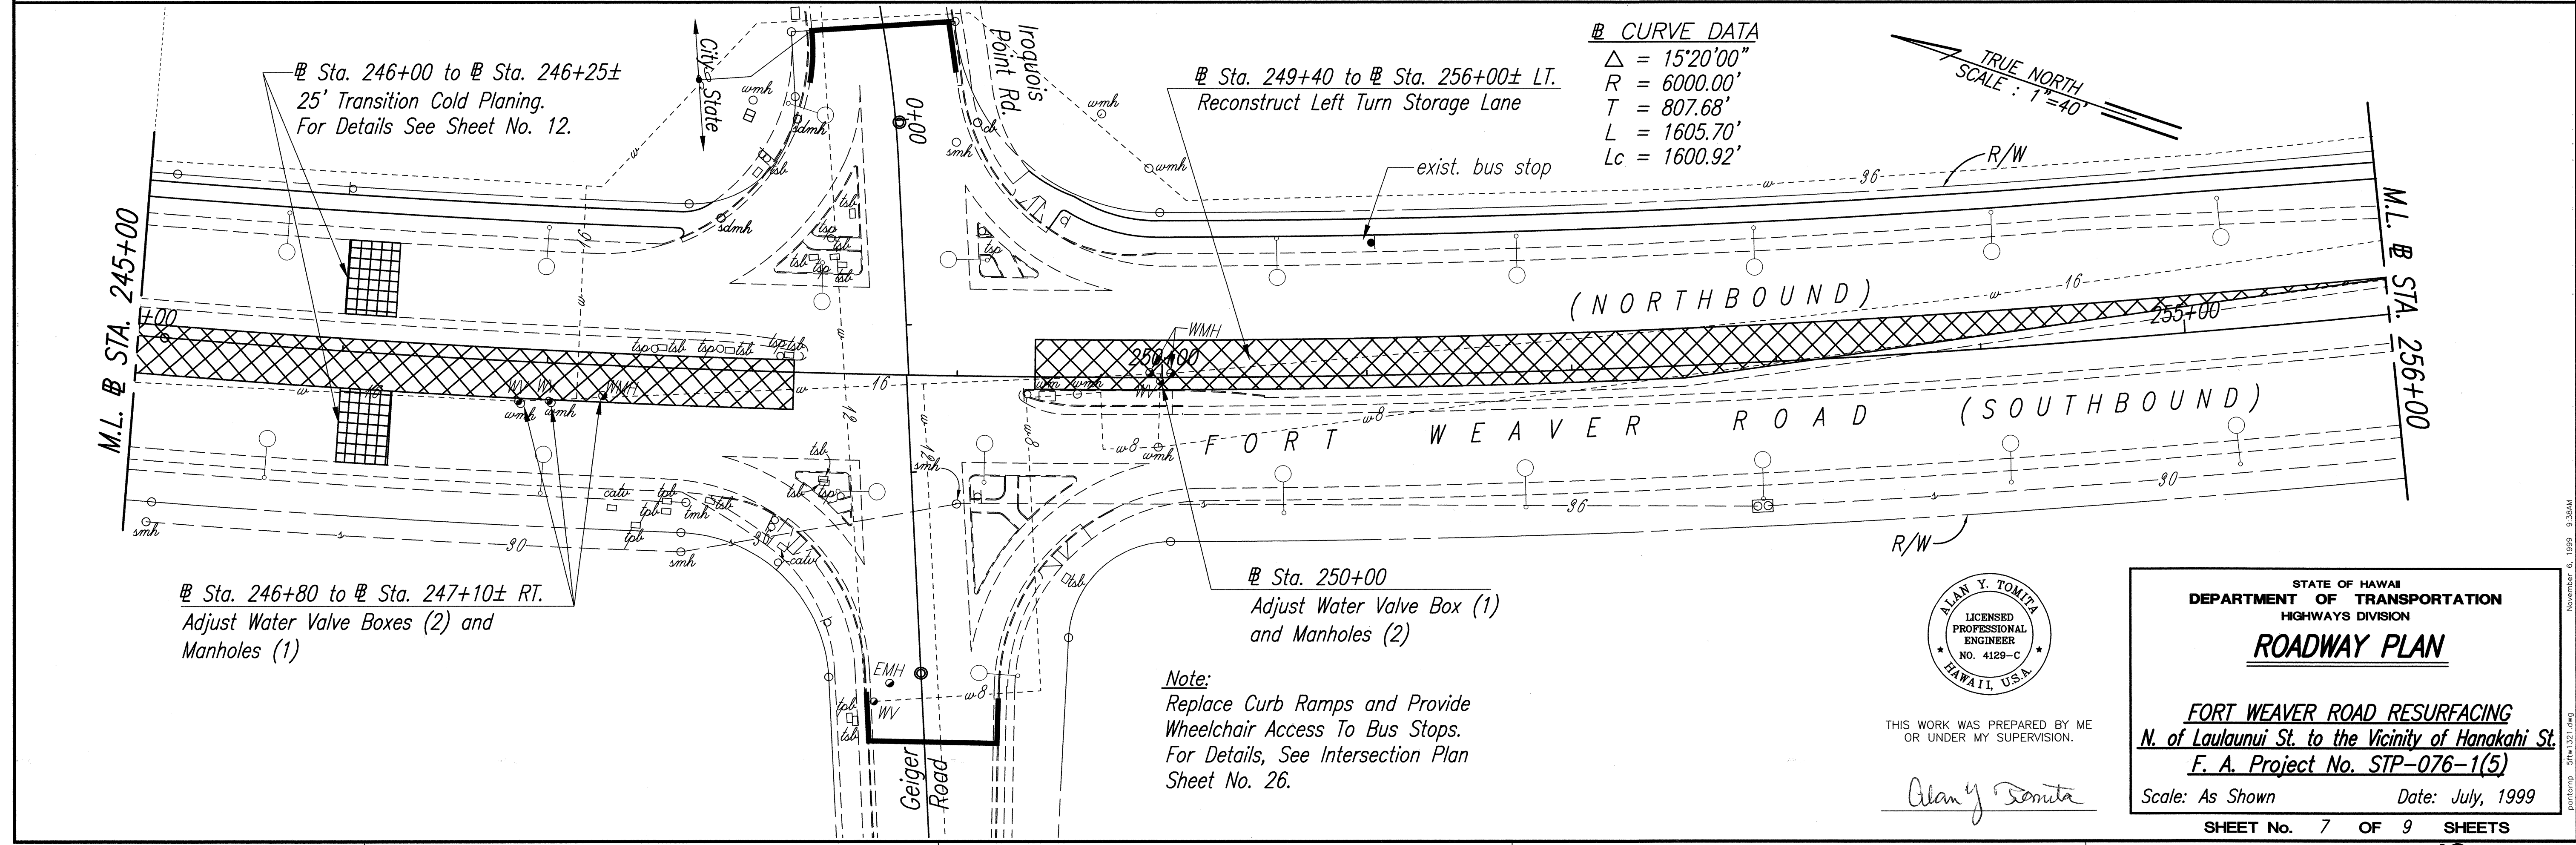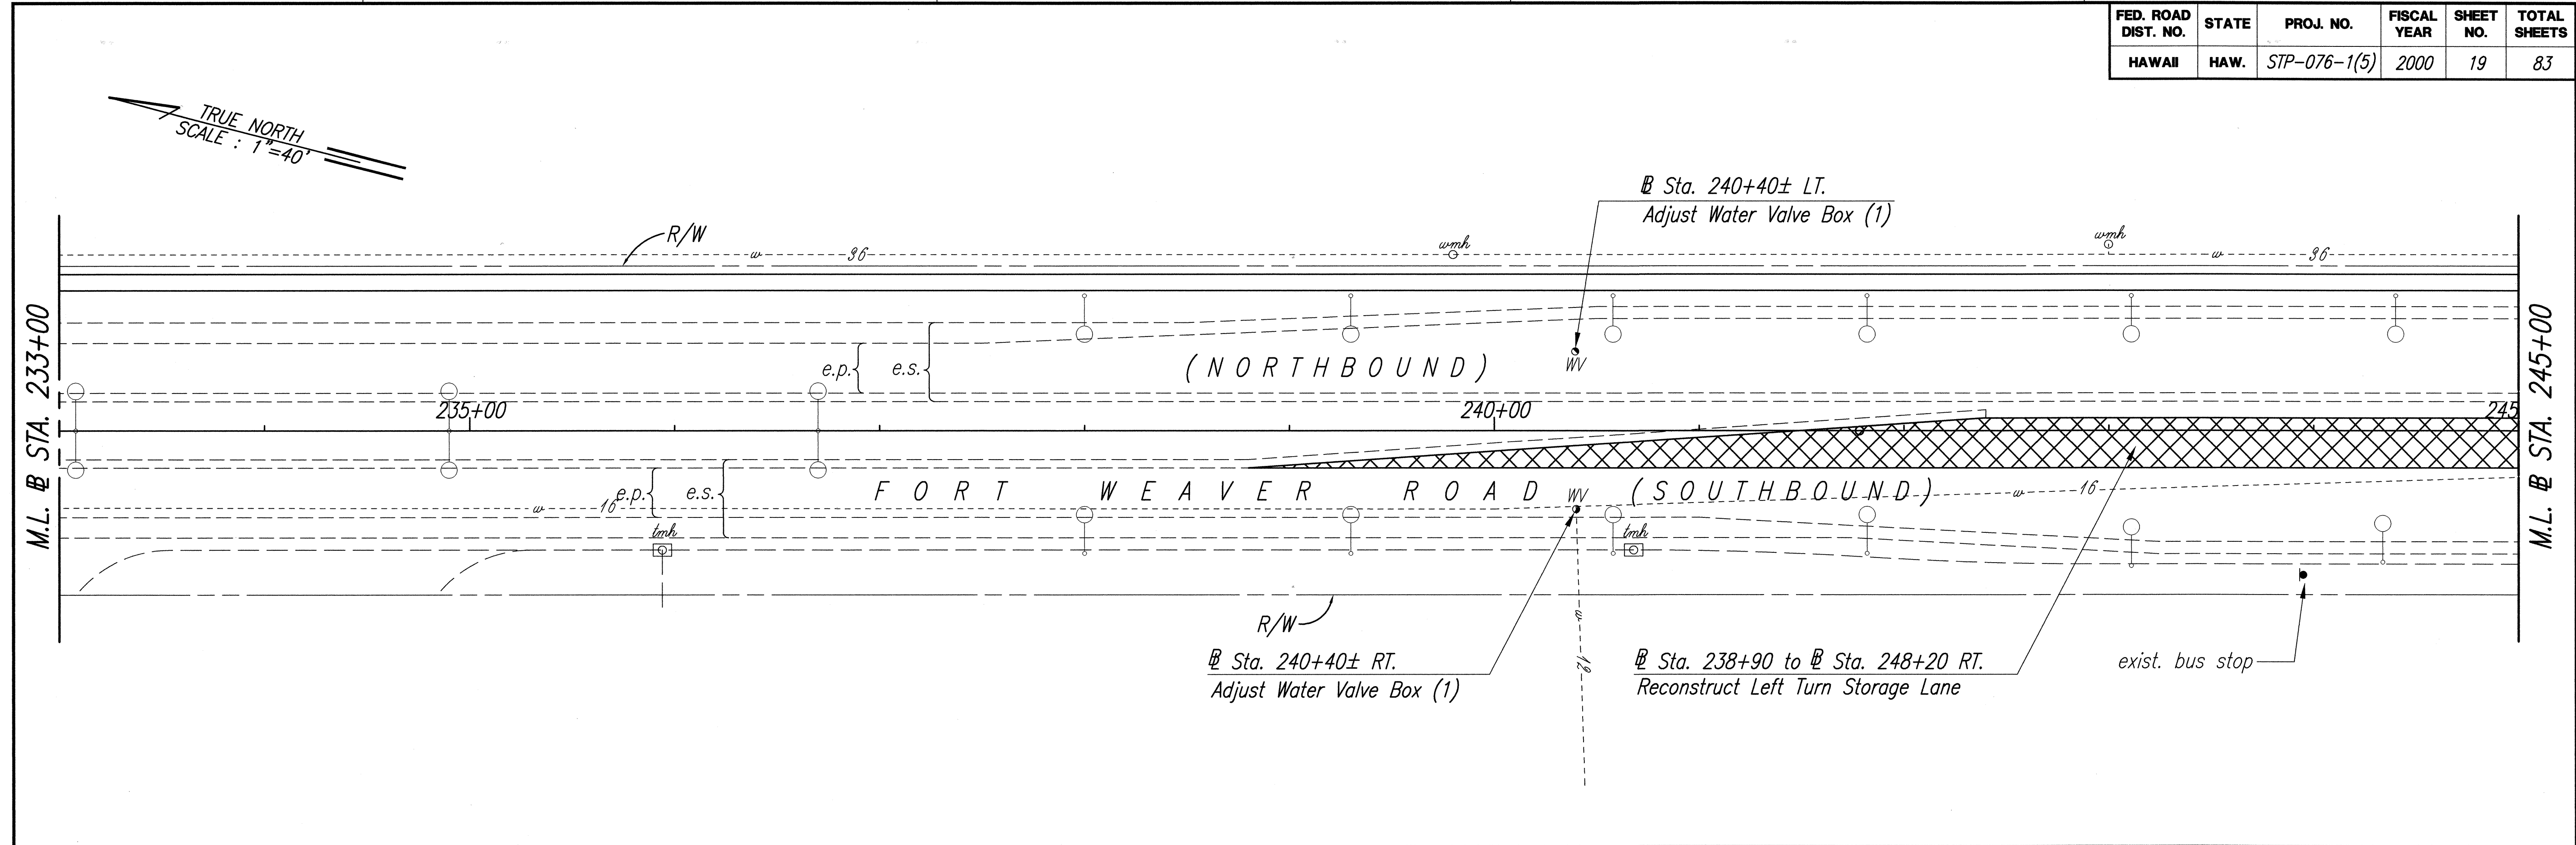

ORIGINAL PLAN	DATE
DRAWN BY	
DESIGNED BY	
QUANTITIES BY	
CHECKED BY	
No.	

ALAN Y. TOMITA
 LICENSED PROFESSIONAL ENGINEER
 NO. 4129-C
 HAWAII, U.S.A.

THIS WORK WAS PREPARED BY ME
 OR UNDER MY SUPERVISION.



Alan Y. Tomita

STATE OF HAWAII
 DEPARTMENT OF TRANSPORTATION
 HIGHWAYS DIVISION
ROADWAY PLAN


FORT WEAVER ROAD RESURFACING
N. of Lualunui St. to the Vicinity of Hanakahi St.
F. A. Project No. STP-076-1(5)
 Scale: As Shown Date: July, 1999

SHEET No. 7 OF 9 SHEETS

FED. ROAD DIST. NO.	STATE	PROJ. NO.	FISCAL YEAR	SHEET NO.	TOTAL SHEETS
HAWAII	HAW.	STP-076-1(5)	2000	20	83

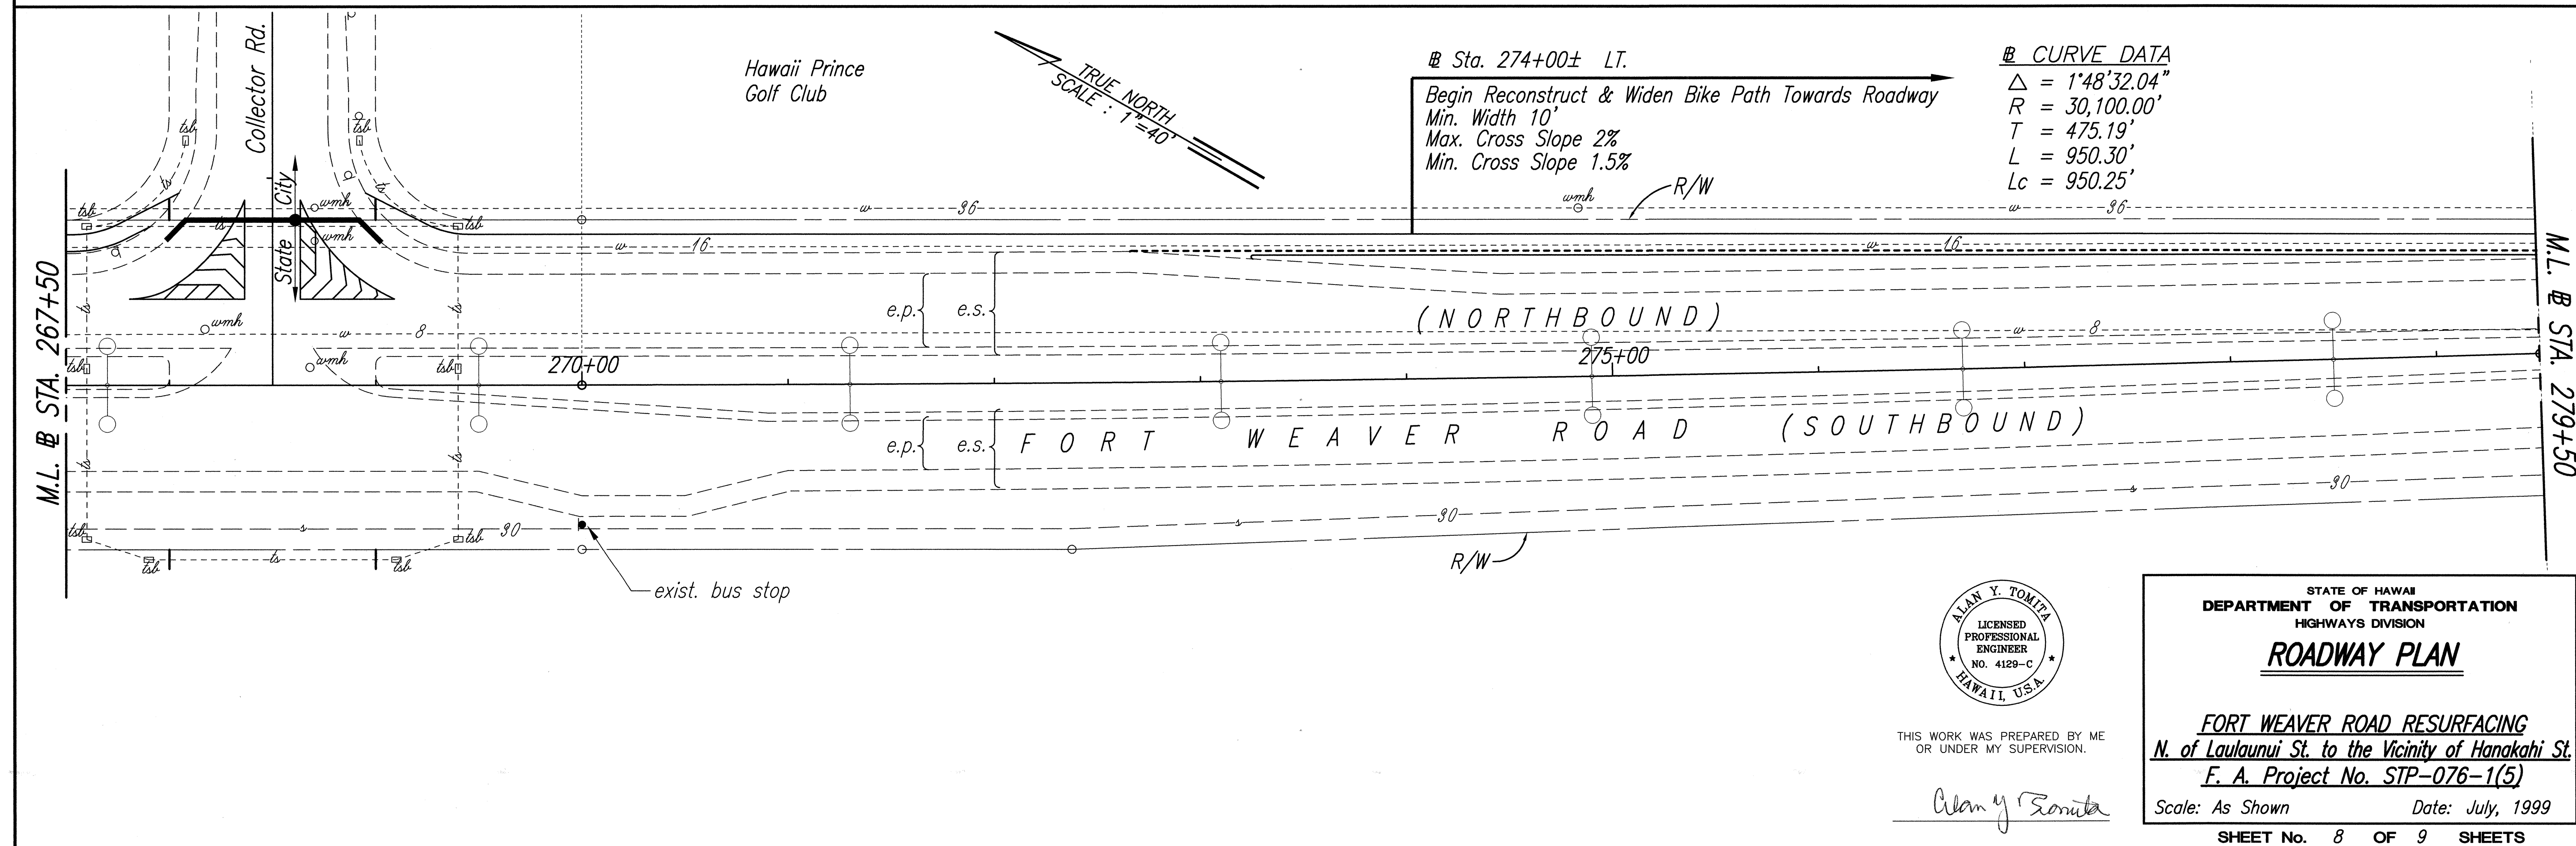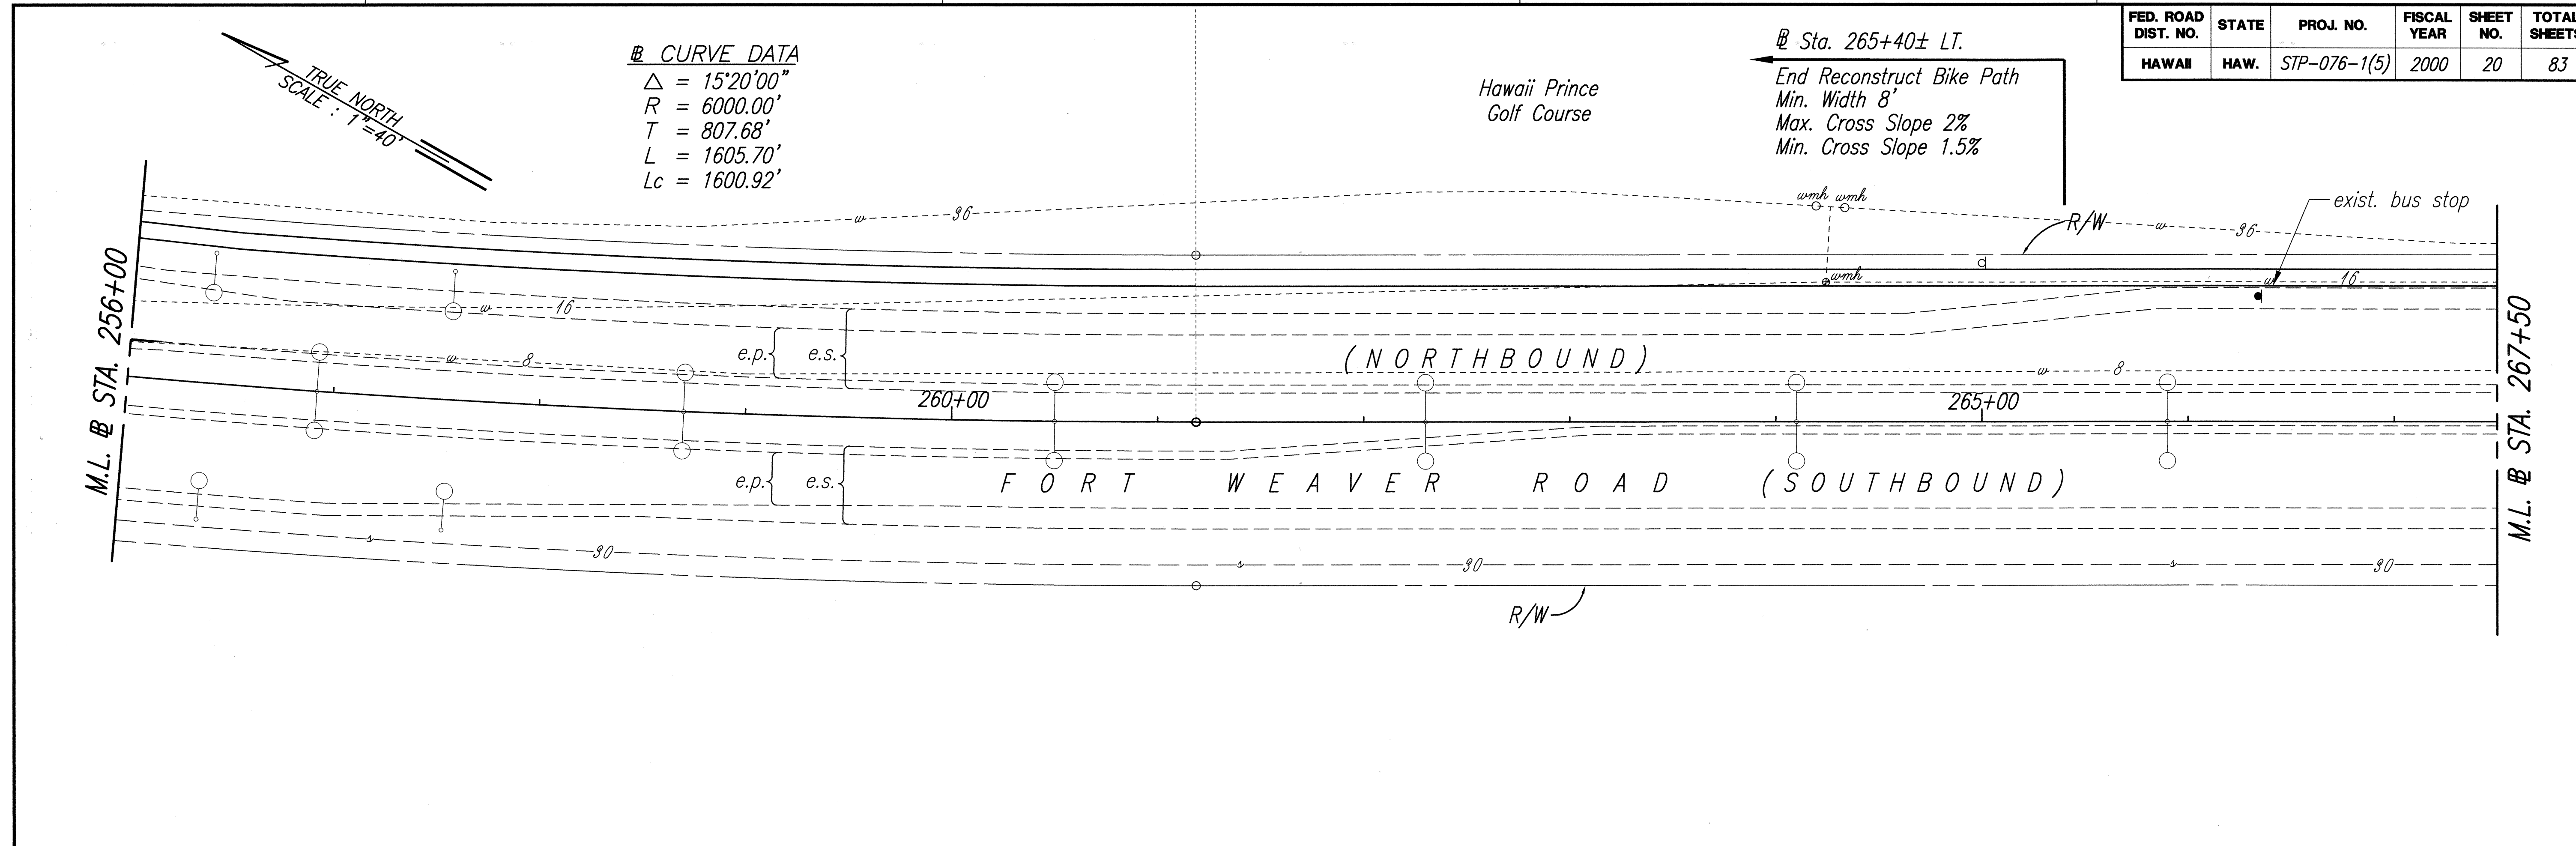

ORIGINAL PLAN	SURVEY PLOTTED BY	DATE
NOTE BOOK	DRAWN BY	
	DESIGNED BY	
	QUANTITIES BY	
	CHECKED BY	
No.		

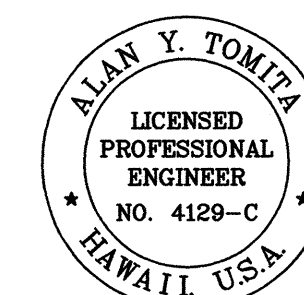

THIS WORK WAS PREPARED BY ME
OR UNDER MY SUPERVISION.

Alan Y. Tomita

STATE OF HAWAII
DEPARTMENT OF TRANSPORTATION
HIGHWAYS DIVISION


ROADWAY PLAN

FORT WEAVER ROAD RESURFACING
 N. of Lualunui St. to the Vicinity of Hanakahi St.
 F. A. Project No. STP-076-1(5)


Scale: As Shown Date: July, 1999

SHEET No. 8 OF 9 SHEETS

FED. ROAD DIST. NO.	STATE	PROJ. NO.	FISCAL YEAR	SHEET NO.	TOTAL SHEETS
HAWAII	HAW.	STP-076-1(5)	2000	C.O. 21	83

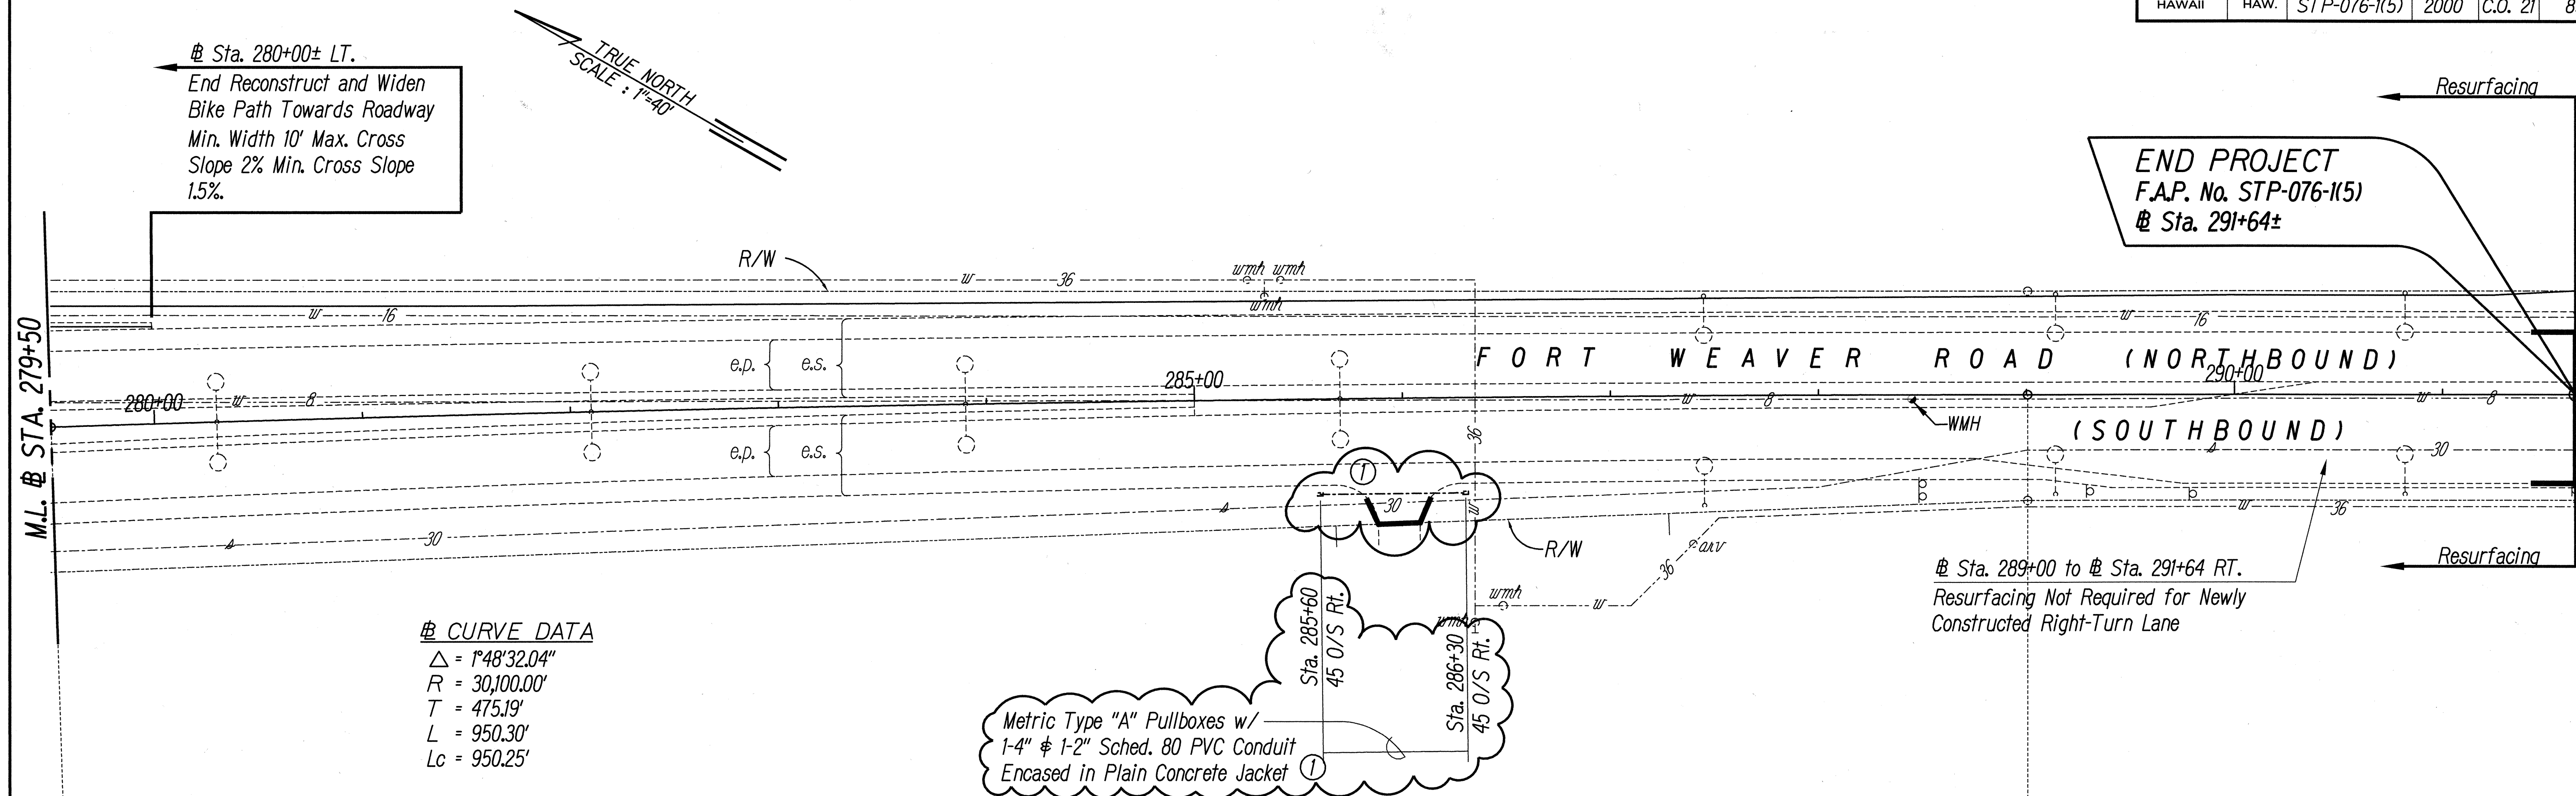

DATE	_____
SURVEY PLOTTED BY	_____
DRAWN BY	_____
DESIGNED BY	_____
CHECKED BY	_____
ORIGINAL PLAN	_____
NOTE BOOK	_____
NO.	_____

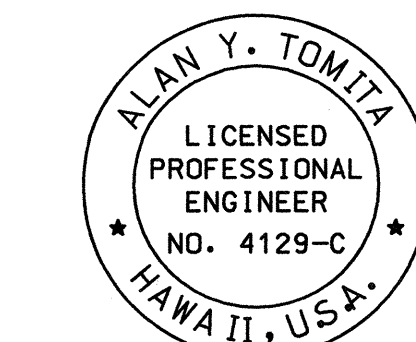

THIS WORK WAS PREPARED BY ME
OR UNDER MY SUPERVISION.

Alan Y. Tomita

7/13/01 ①	Added traffic signal pullboxes w/ conduits.
Date	Revision
STATE OF HAWAII DEPARTMENT OF TRANSPORTATION HIGHWAYS DIVISION ROADWAY PLAN FORT WEAVER ROAD RESURFACING N. of Laulaunui St. to the Vicinity of Hanakahi St. F. A. Project No. STP-076-1(5) Scale: As Shown Date: July, 1999	
SHEET No. 9 OF 9 SHEETS	