

INDEX TO DRAWINGS	
SHEET NO.	DESCRIPTION
1	TITLE SHEET
2	STANDARD PLANS SUMMARY
3 - 7	GENERAL NOTES AND LEGEND
8 - 12	TYPICAL SECTIONS & MISCELLANEOUS DETAILS
13 - 21	ROADWAY PLANS
22 - 27	INTERSECTION PLANS
28 - 32	CURB RAMP DETAILS
33 - 41	GUARDRAIL DETAILS
42 - 54	SIGNING & PAVEMENT MARKING LEGEND, NOTES, PLANS, DETAILS AND SUMMARIES
55 - 57	STRUCTURAL NOTES, PLANS & DETAILS
58	GENERAL ELECTRICAL & UTILITY NOTES
59 - 69	TRAFFIC SIGNAL SYSTEM NOTES, PLANS AND DETAILS
70	HIGHWAY LIGHTING DETAILS
71 - 83	END POST UPGRADE NOTES, PLANS AND DETAILS

STATE OF HAWAII

DEPARTMENT OF TRANSPORTATION

HIGHWAYS DIVISION

HONOLULU, HAWAII

"AS-BUILT"

PLANS FOR

FORT WEAVER ROAD

RESURFACING

NORTH OF LAULAUNUI STREET

TO THE VICINITY OF HANAKAHI STREET



FED. AID PROJECT NO. STP-076-1 (5)

DISTRICT OF EWA

ISLAND OF OAHU

T.M.K.: 9-1-10, 12 & 17

FED. ROAD DIST. NO.	STATE	FED. AID PROJ. NO.	FISCAL YEAR	SHEET NO.	TOTAL SHEETS
HAWAII	HAW.	STP-076-1(5)	2000	1	83

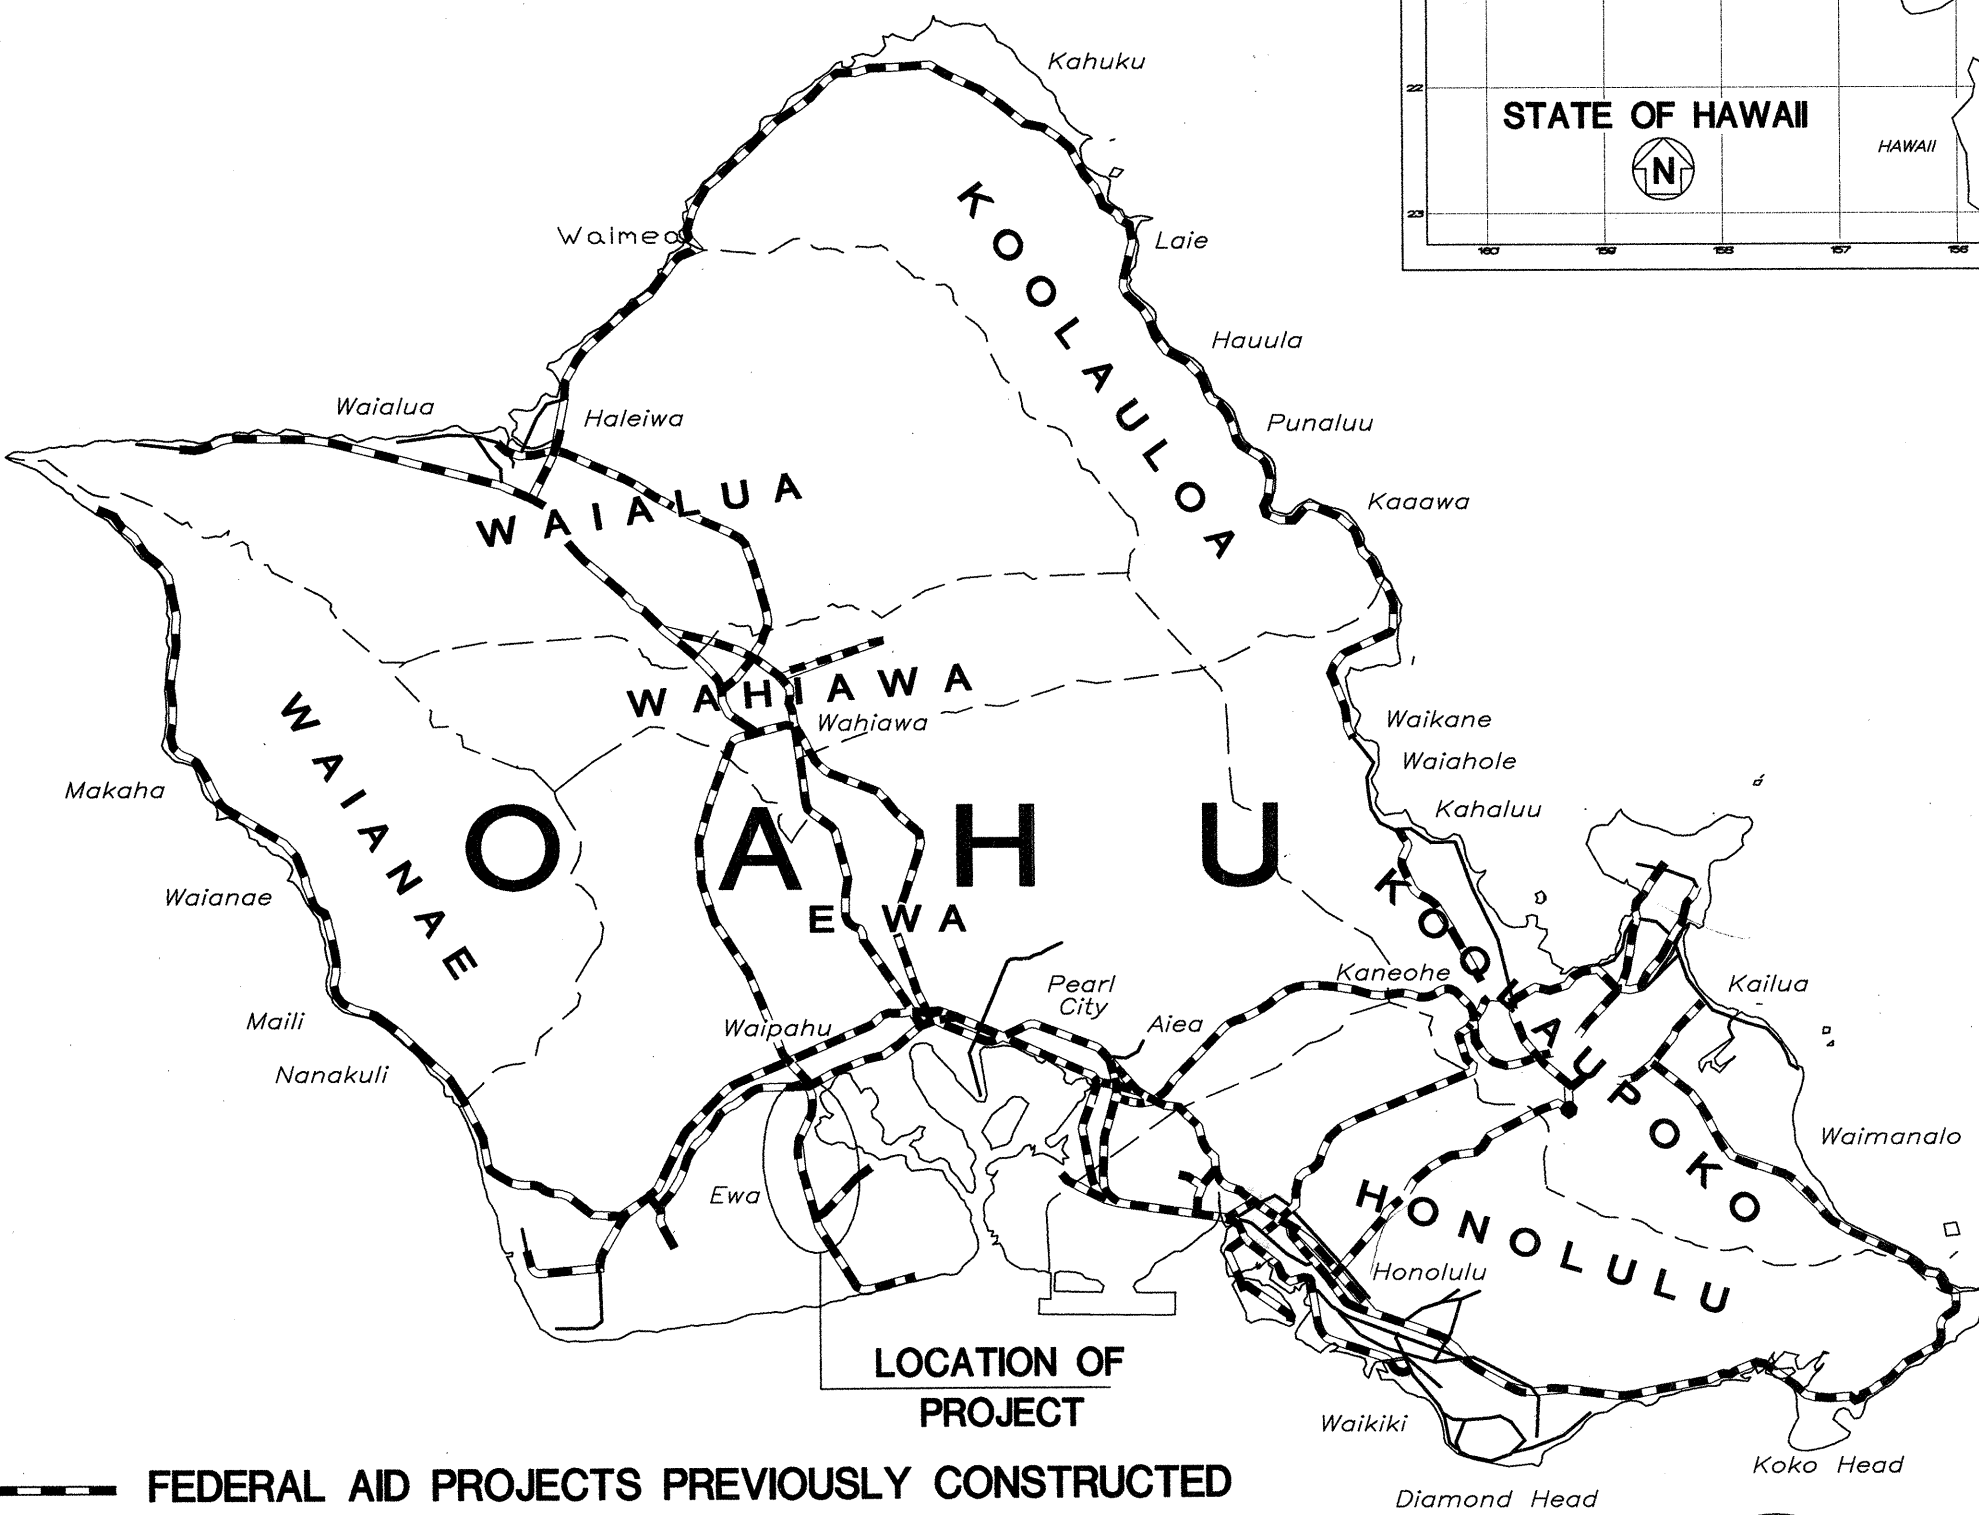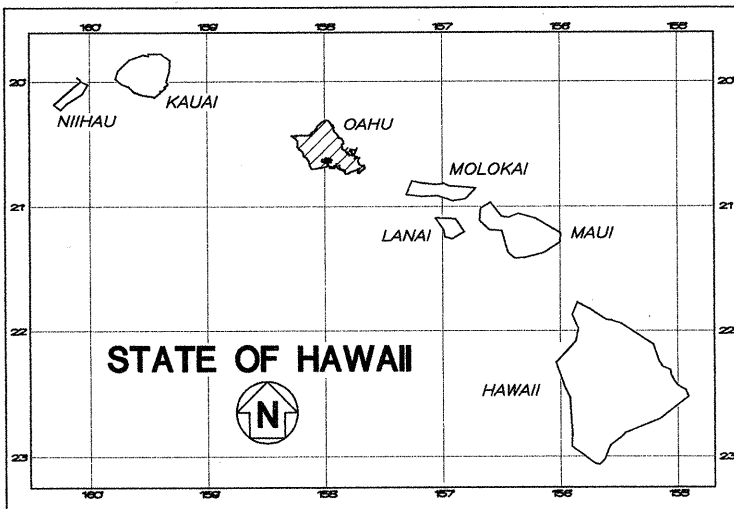

FEDERAL AID PROJECTS PREVIOUSLY CONSTRUCTED OR UNDER CONSTRUCTION

MILE POST 2.19 TO MILE POST 5.67

1 - DESIGN DESIGNATION

Farrington Hwy to Renton Rd.

ADT (1999)	61,000
ADT (2009)	88,000
ADT (2019)	114,000
DHV	9200
K	8.0
D	65/35
T	2.0
V	50

2 - DESIGN DESIGNATION

Renton Rd. to Iroquois Rd.

ADT (1999)	51,000
ADT (2009)	71,000
ADT (2019)	92,000
DHV	7400
K	8.0
D	60/40
T	1.5
V	50

3 - DESIGN DESIGNATION

Iroquois Rd. to Hanakahi St.

ADT (1999)	35,000
ADT (2009)	46,000
ADT (2019)	58,000
DHV	4600
K	8.0
D	60/40
T	2.5
V	50

DEPARTMENT OF TRANSPORTATION

STATE OF HAWAII

APPROVED:

Kevin W. ...

11/18/99

DIR. OF TRANSPORTATION

DATE

M&E Pacific, Inc.

DESIGNED BY

Steven Uechi


587-2626

8/01/99

P. S. & E. BY

PHONE

DATE

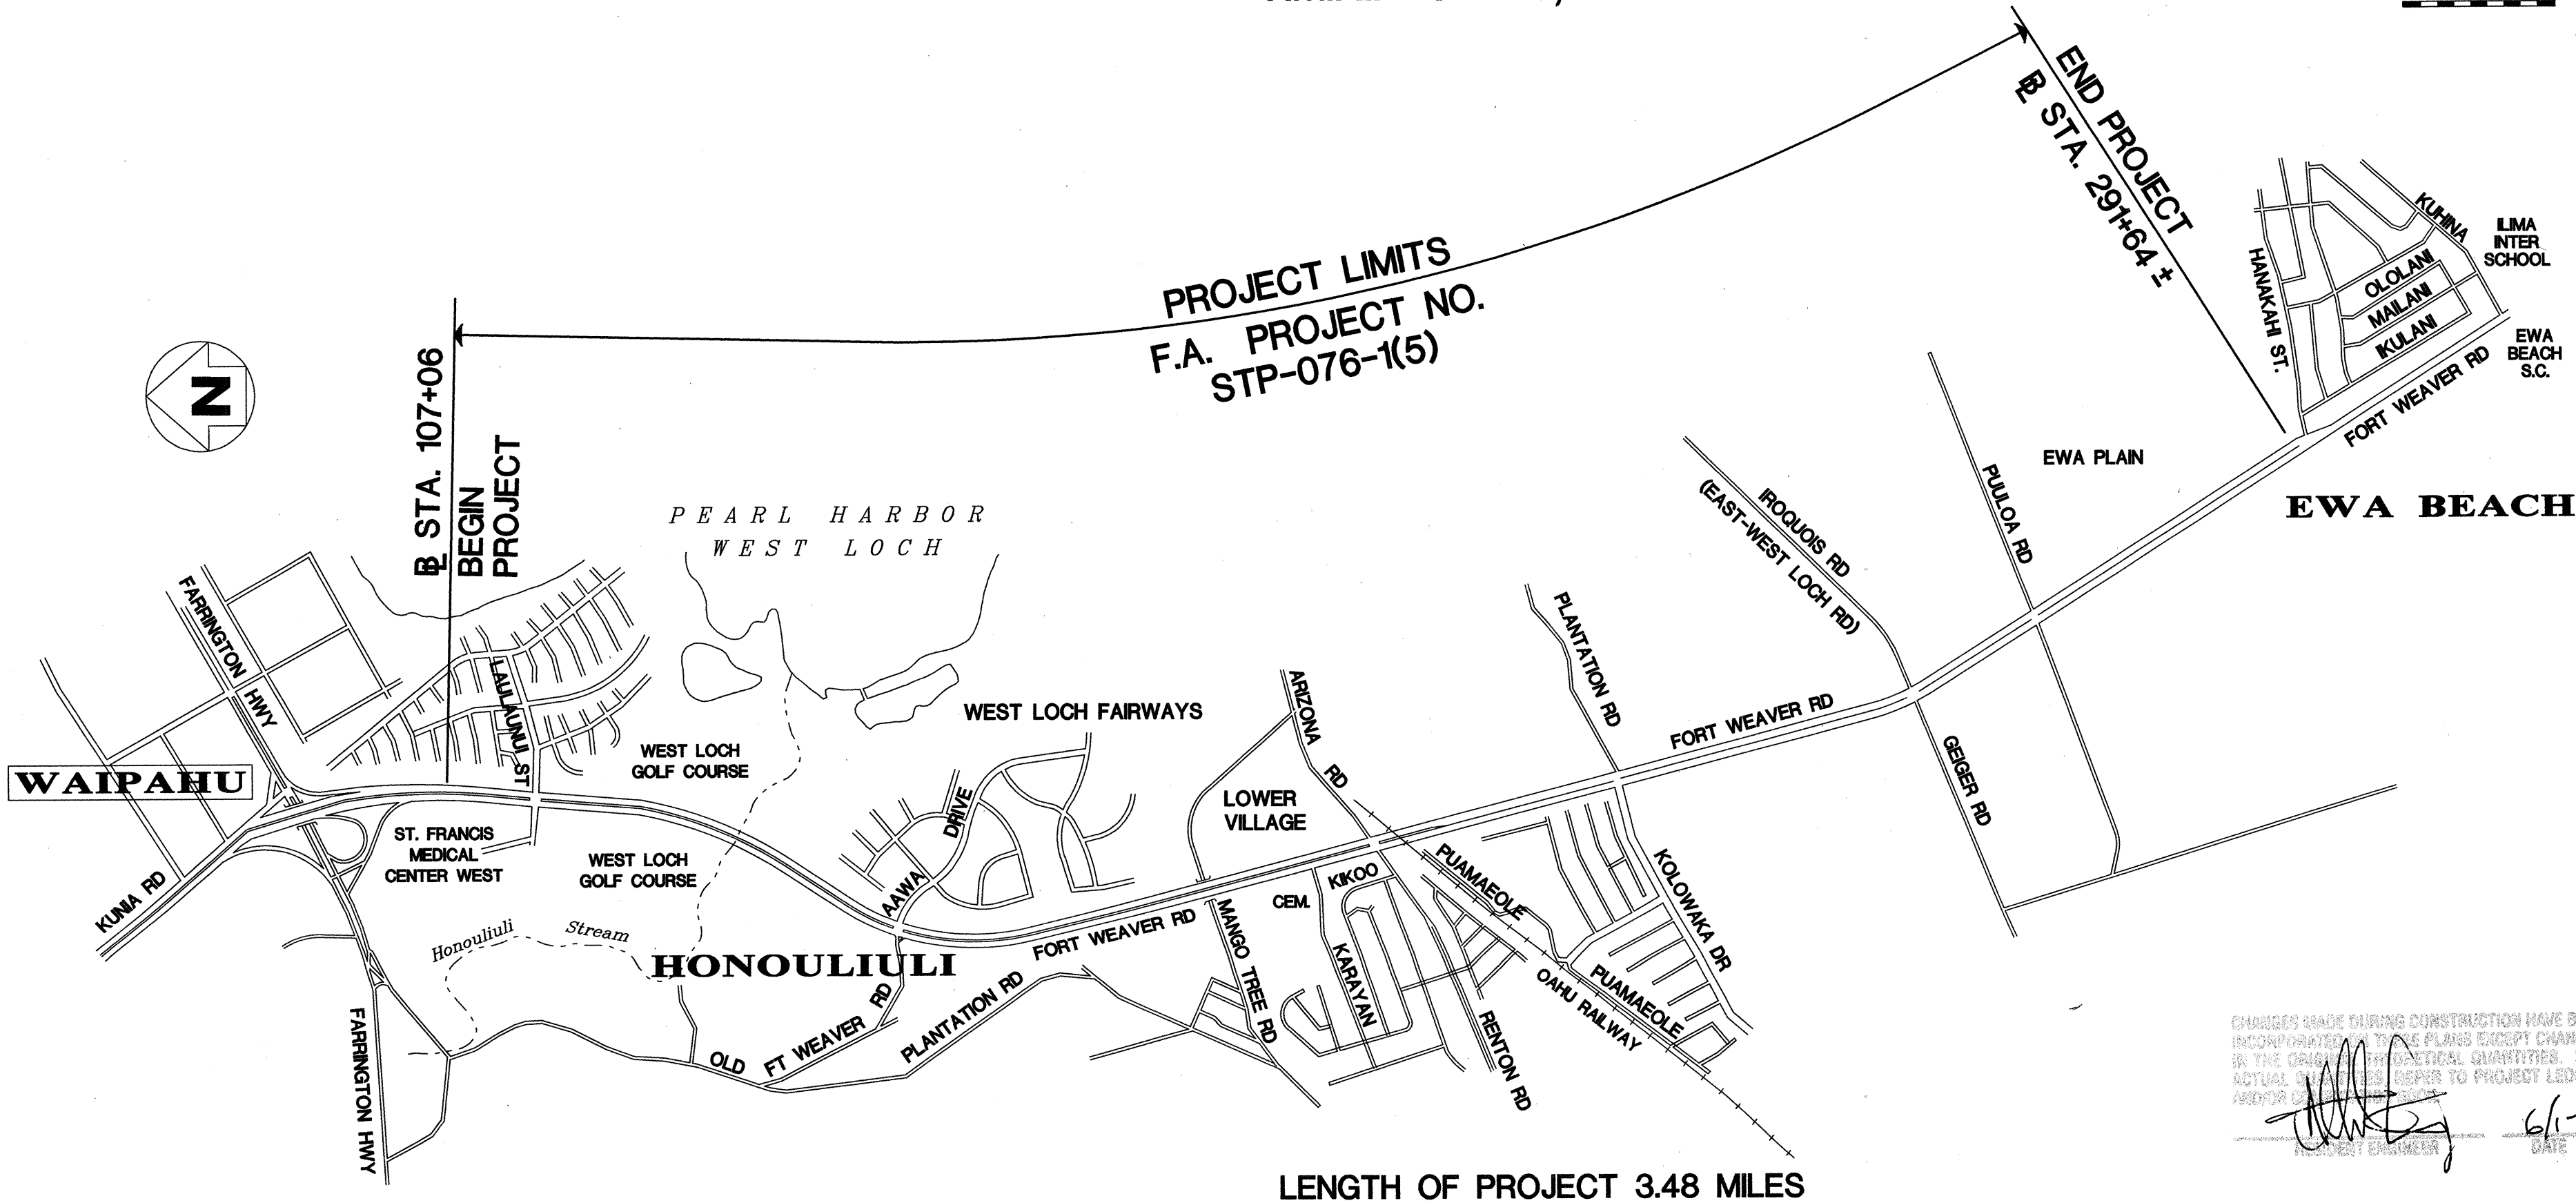

LENGTH OF PROJECT 3.48 MILES

LAYOUT PLAN

