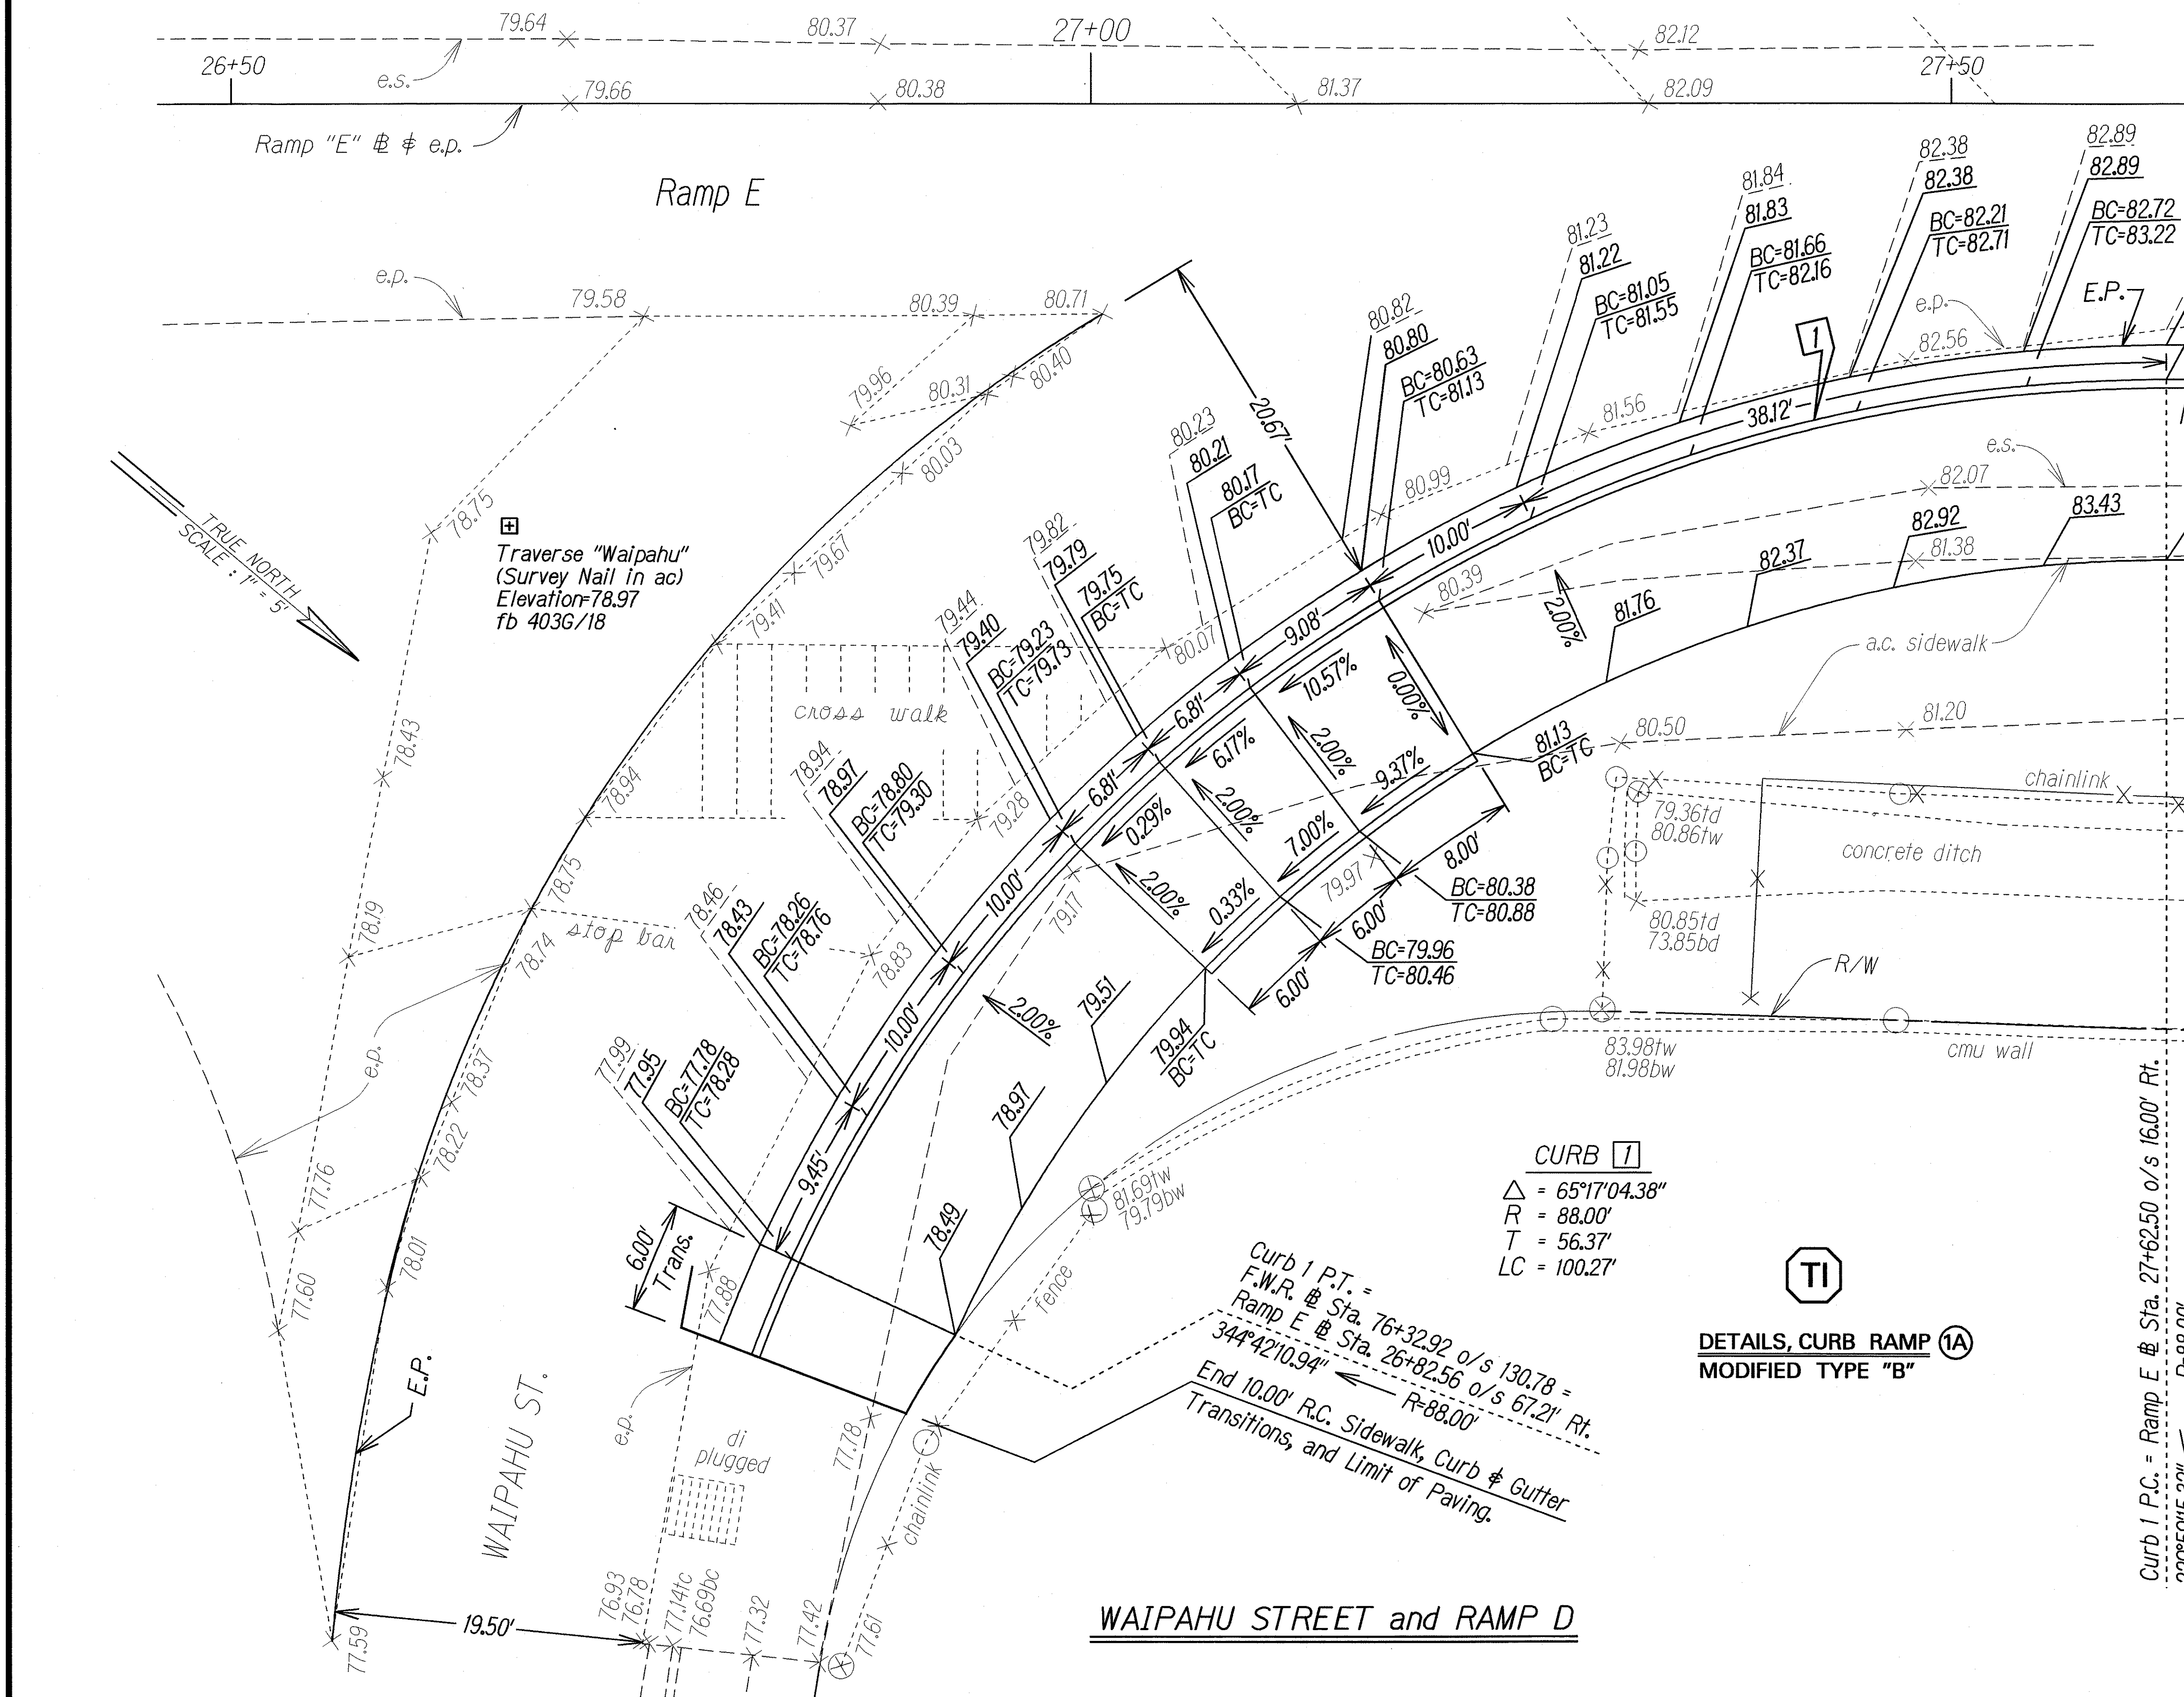


7964	90 27	27:00	28:10
------	-------	-------	-------

[illegible]

STATE OF HAWAII
DEPARTMENT OF TRANSPORTATION
HIGHWAYS DIVISION

INTERSECTION GRADING PLAN


KUNIA ROAD IMPROVEMENTS
VICINITY OF SOUTH KUPUNA LOOP
to VICINITY OF HONOWAI STREET

PROJECT NO.: HWY-0-01-04

Scale: As Noted Date: OCT, 2003

SHEET No. 1 OF 3 SHEETS


FED. ROAD DIST. NO.	STATE	PROJ. NO.	FISCAL YEAR	SHEET NO.	TOTAL SHEETS
HAWAII	HAW.	HWY-0-01-04	2004	C.O.31	61

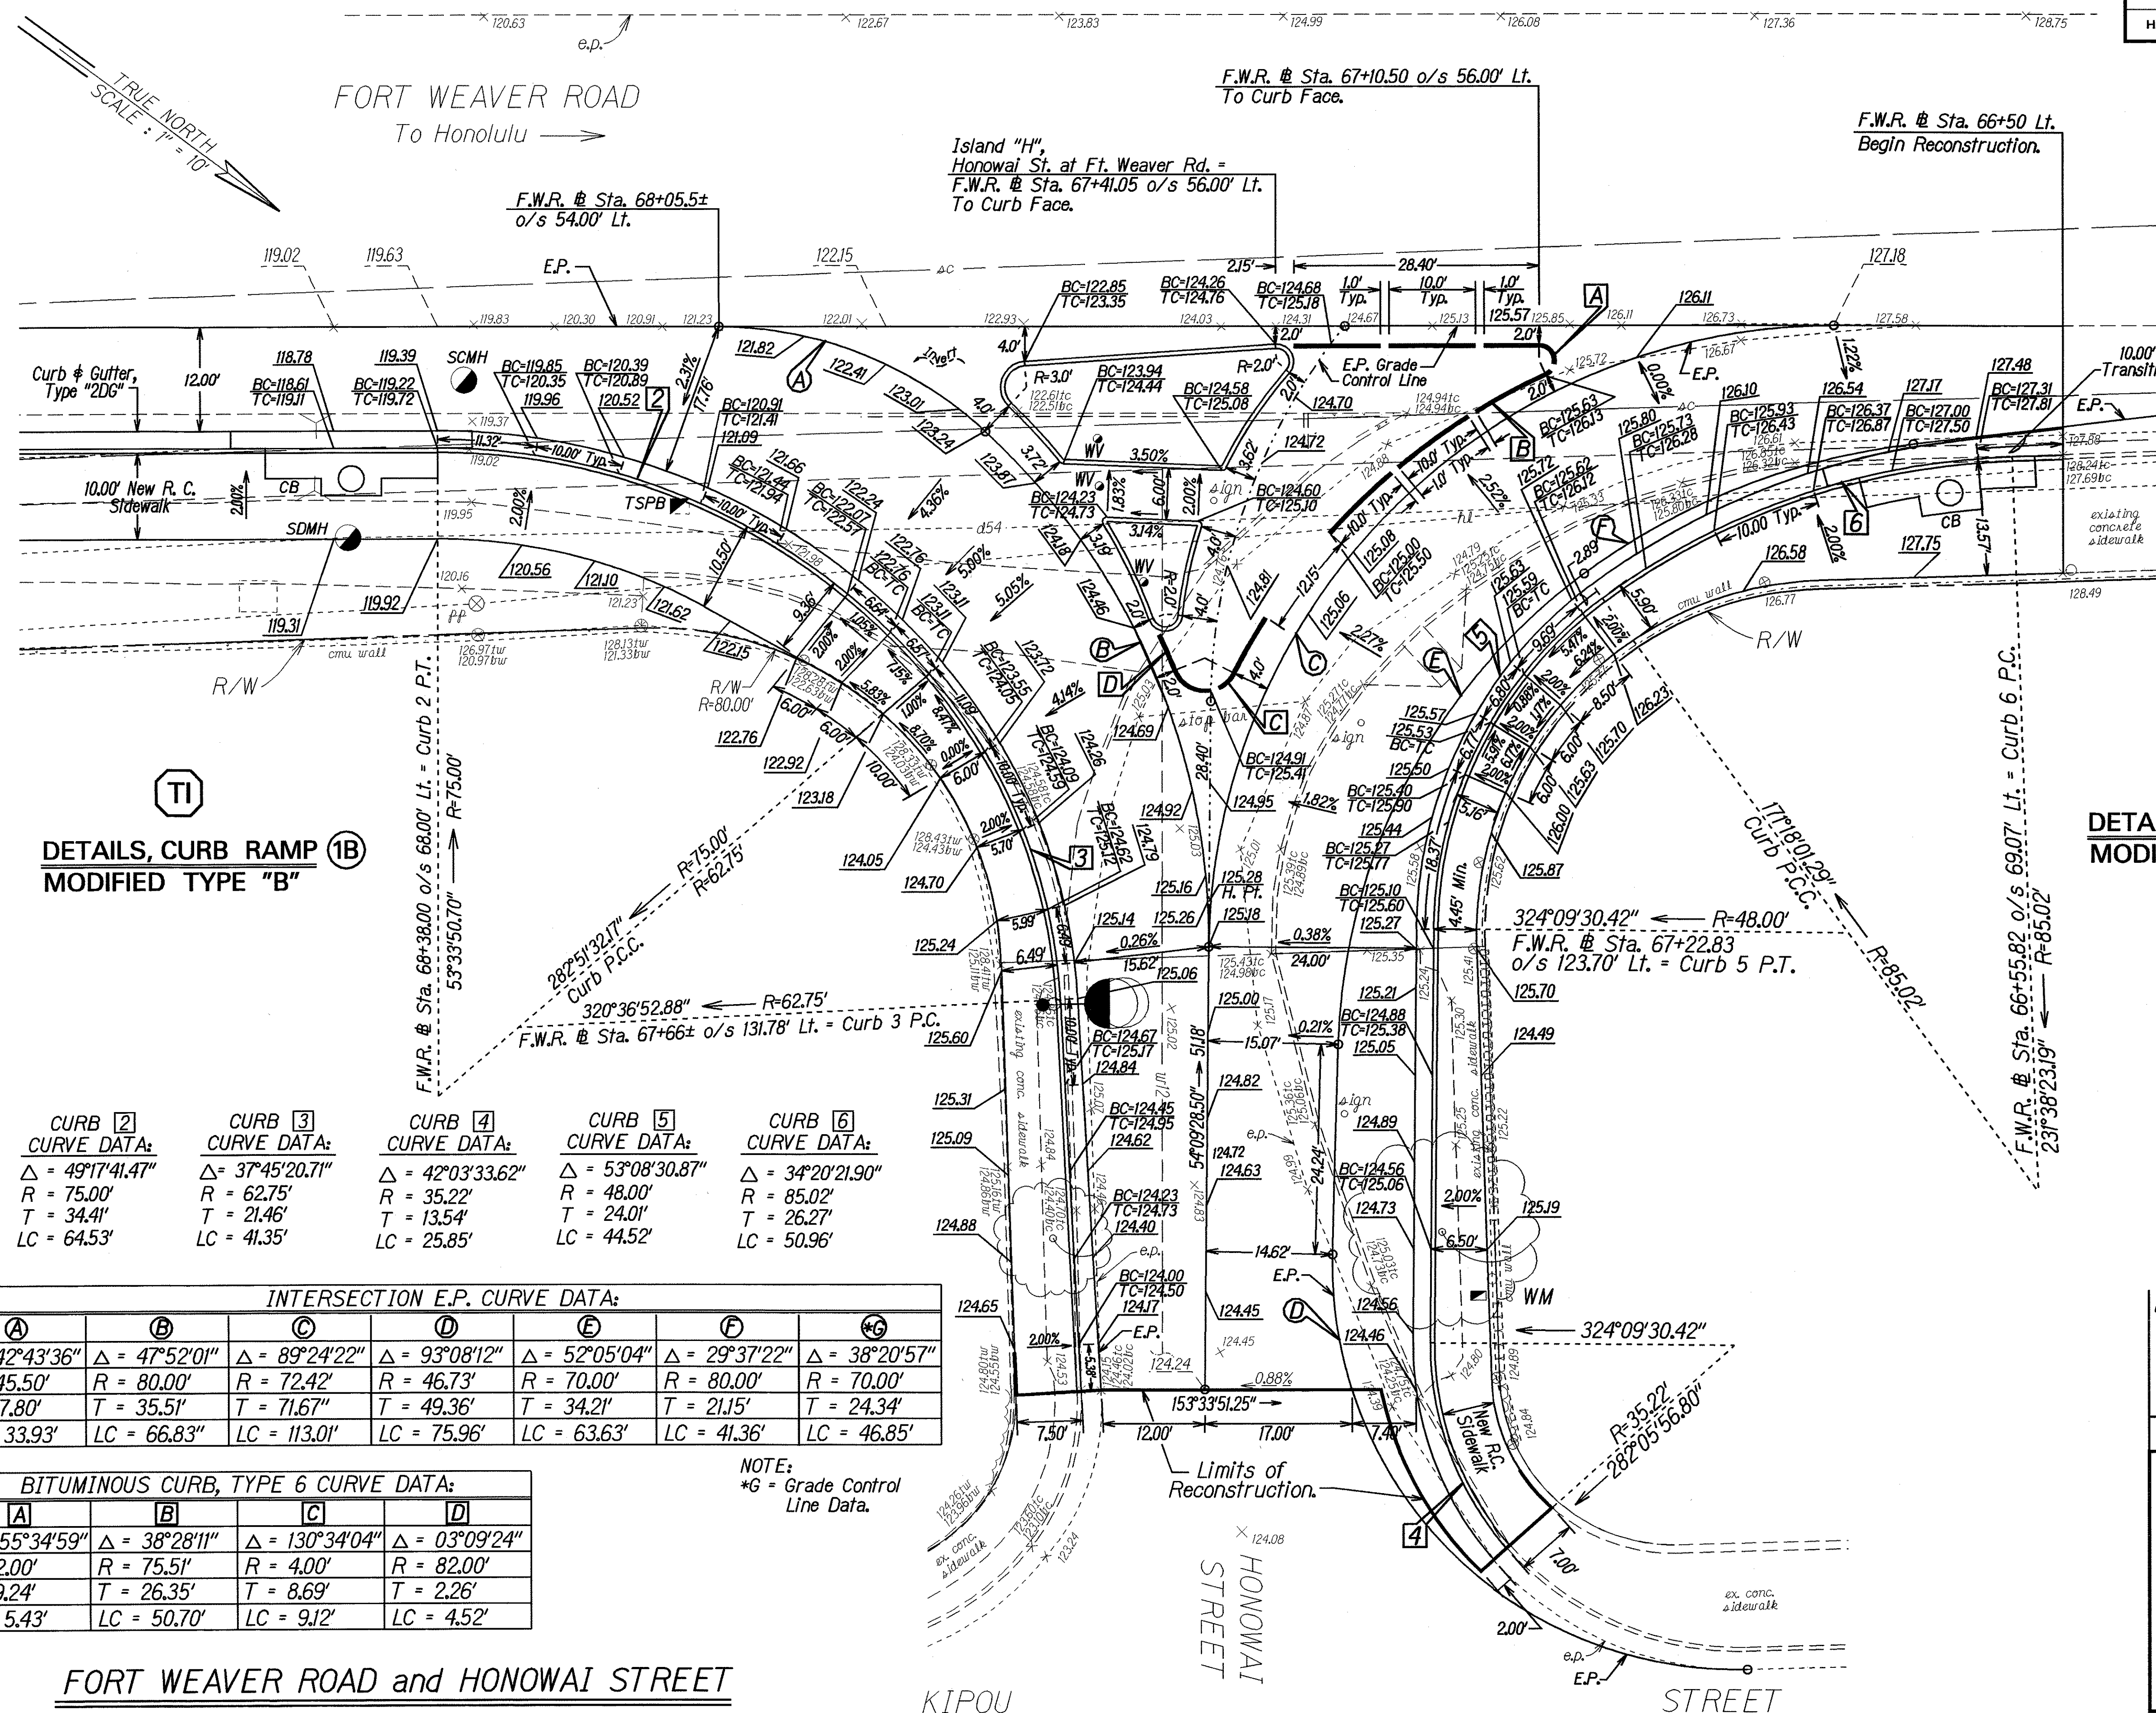

SURVEY PLOTTED BY	DATE
DRAWN BY	12/16/04
DESIGNED BY	
QUANTITIES BY	
CHECKED BY	
ORIGINAL PLAN	
NOTE BOOK	
APP. USE ONLY	
REVISIONS	

12/22/04	Added Intersection E.P. and Bituminous Curb Type 6 at Median Island With Curve Data, Labels, Grades and Dimensions and Adjusted Water Meter Box. Revised Grades and Dimensions at Median Island, Auxiliary Lanes, Curb Ramp 1B and Curve Data [6].
DATE	REVISION
STATE OF HAWAII DEPARTMENT OF TRANSPORTATION HIGHWAYS DIVISION	
INTERSECTION GRADING PLAN	
KUNIA ROAD IMPROVEMENTS	
VICINITY OF SOUTH KUPUNA LOOP	
to VICINITY OF HONOWAI STREET	
PROJECT NO.: HWY-0-01-04	
Scale: As Noted	Date: OCT, 2003
SHEET No. 2 OF 3 SHEETS	

FED. ROAD DIST. NO.	STATE	PROJ. NO.	FISCAL YEAR	SHEET NO.	TOTAL SHEETS
HAWAII	HAW.	HWY-0-01-04	2004	32	61

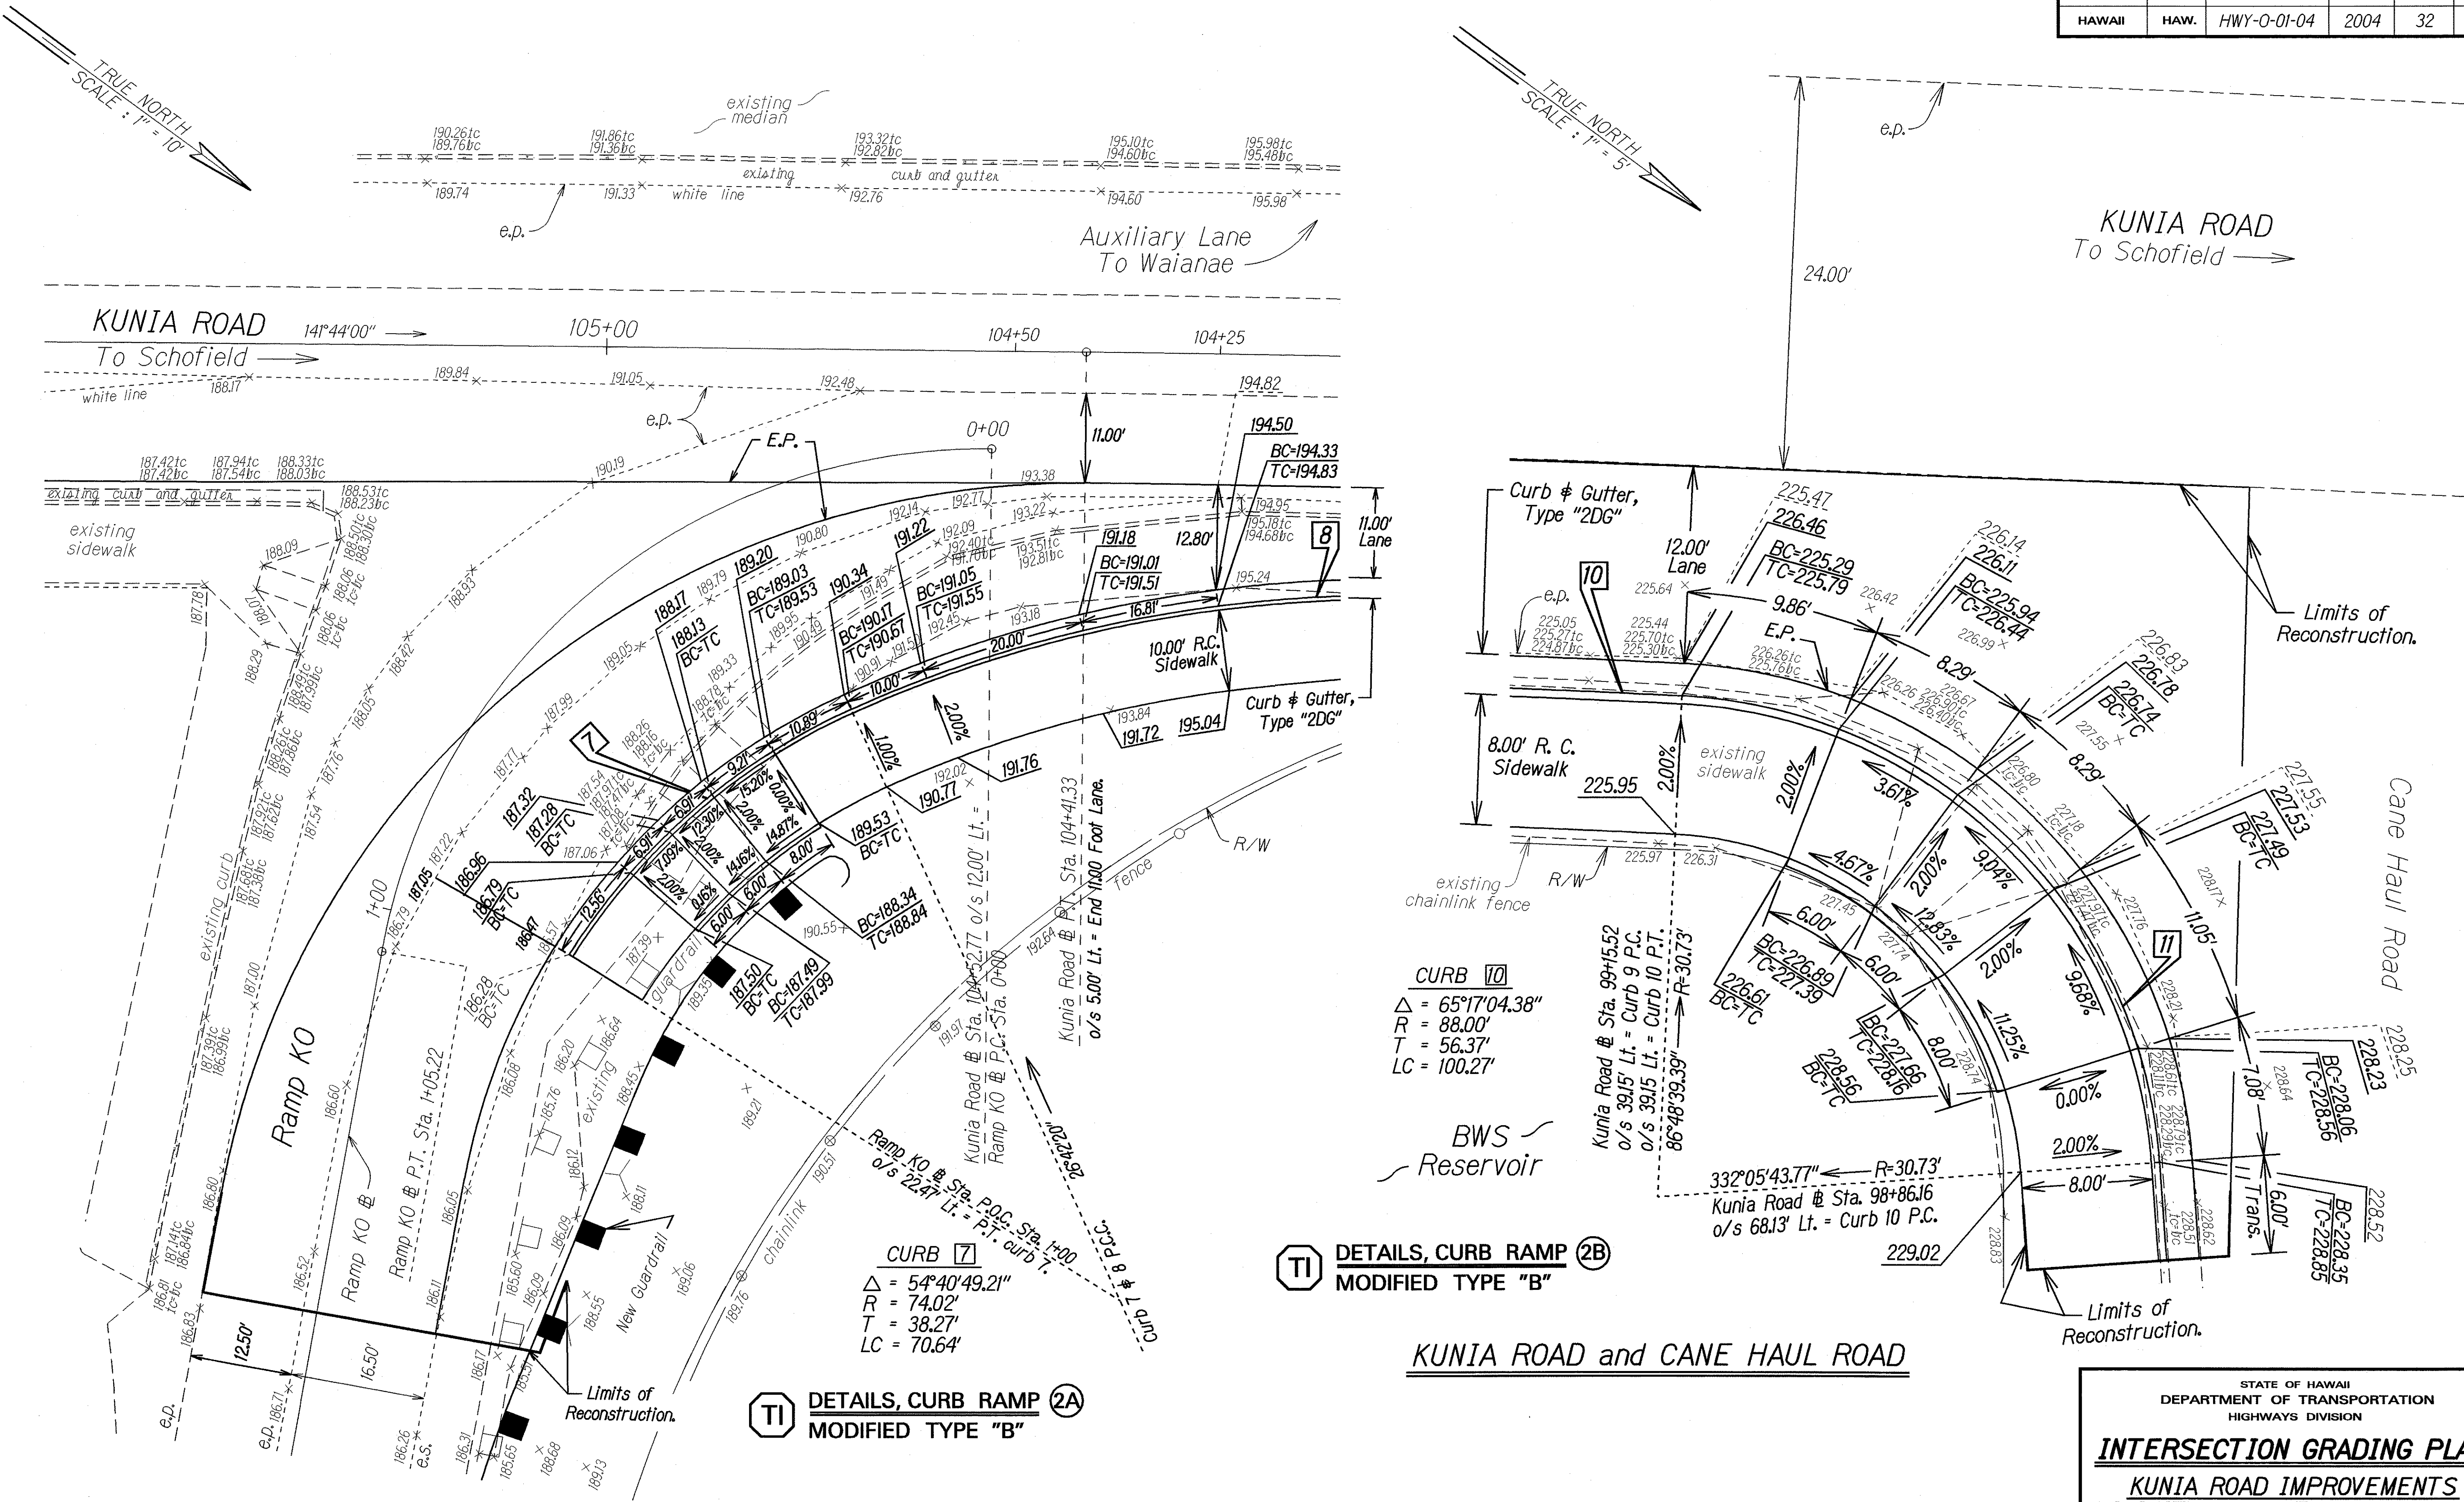

KUNIA ROAD and RAMP KO

KUNIA ROAD and CANE HAUL ROAD

ORIGINAL PLAN	DATE
SURVEY PLOTTED BY	12/19/03
DRAWN BY	12/19/03
NOTE BOOK	
CHECKED BY	
DATE	

STATE OF HAWAII
DEPARTMENT OF TRANSPORTATION
HIGHWAYS DIVISION

INTERSECTION GRADING PLAN
KUNIA ROAD IMPROVEMENTS
VICINITY OF SOUTH KUPUNA LOOP
to VICINITY OF HONOWAI STREET
PROJECT NO.: HWY-0-01-04
Scale: As Noted Date: OCT, 2003
SHEET No. 3 OF 3 SHEETS