
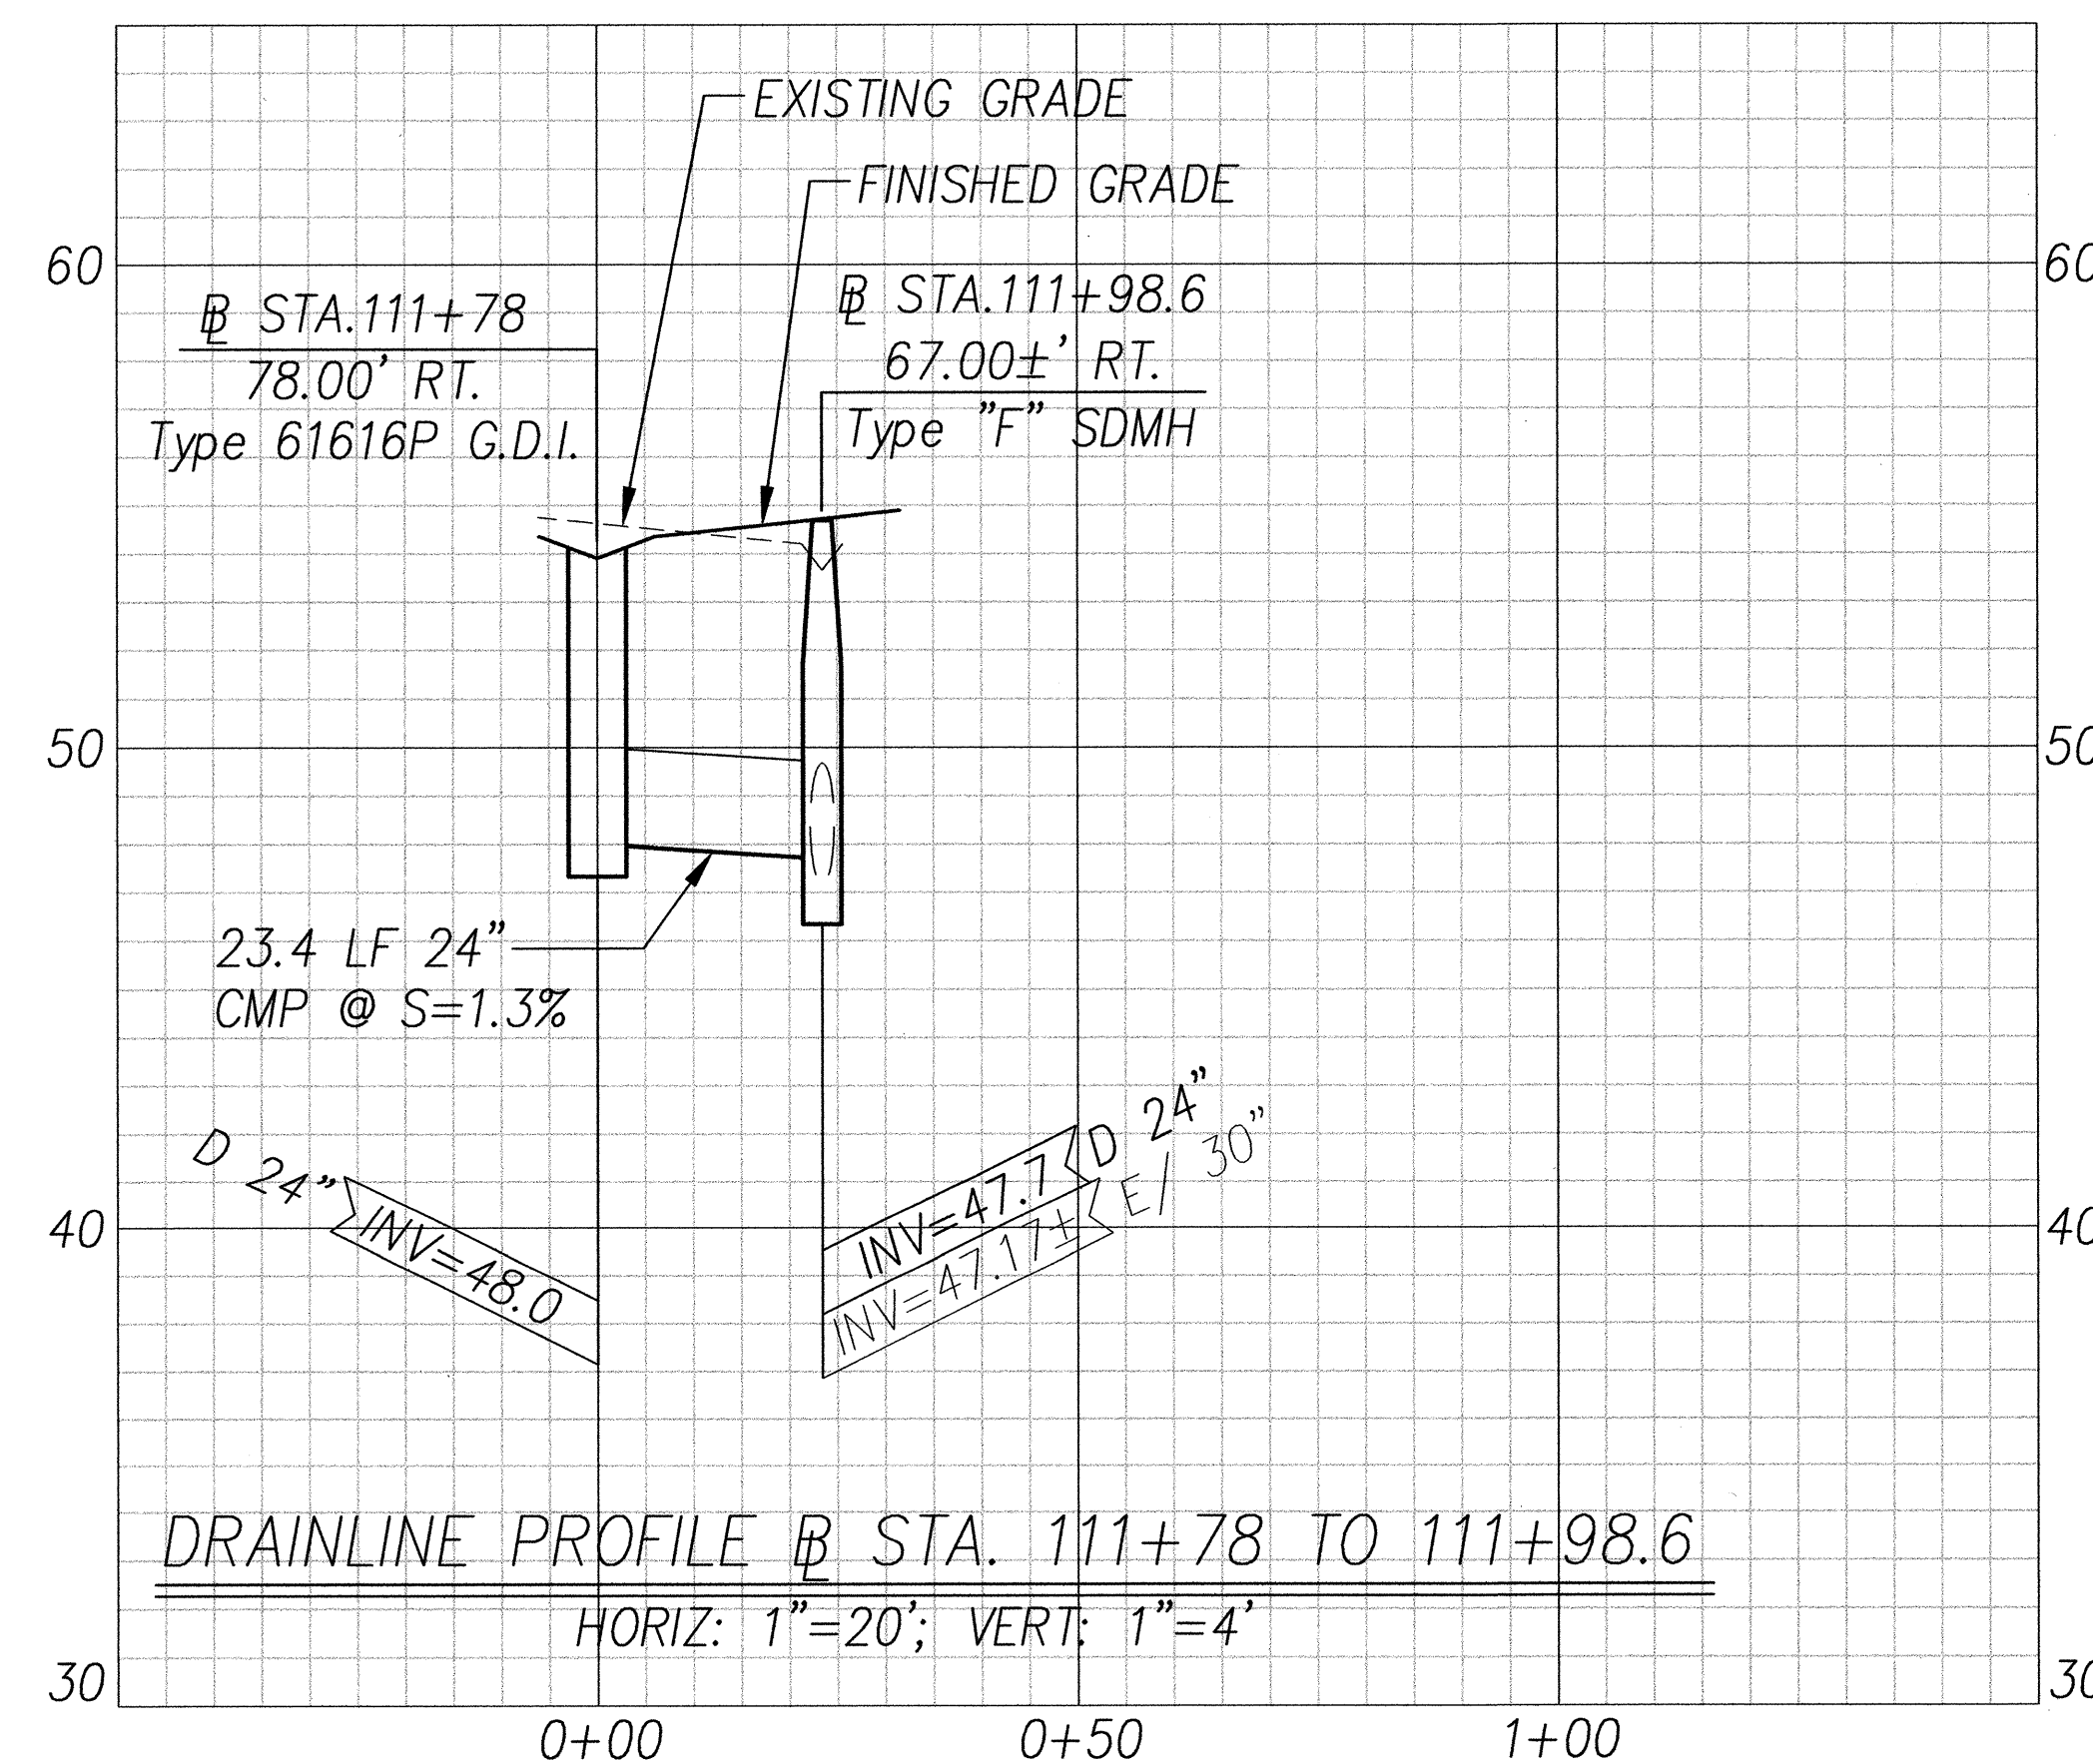
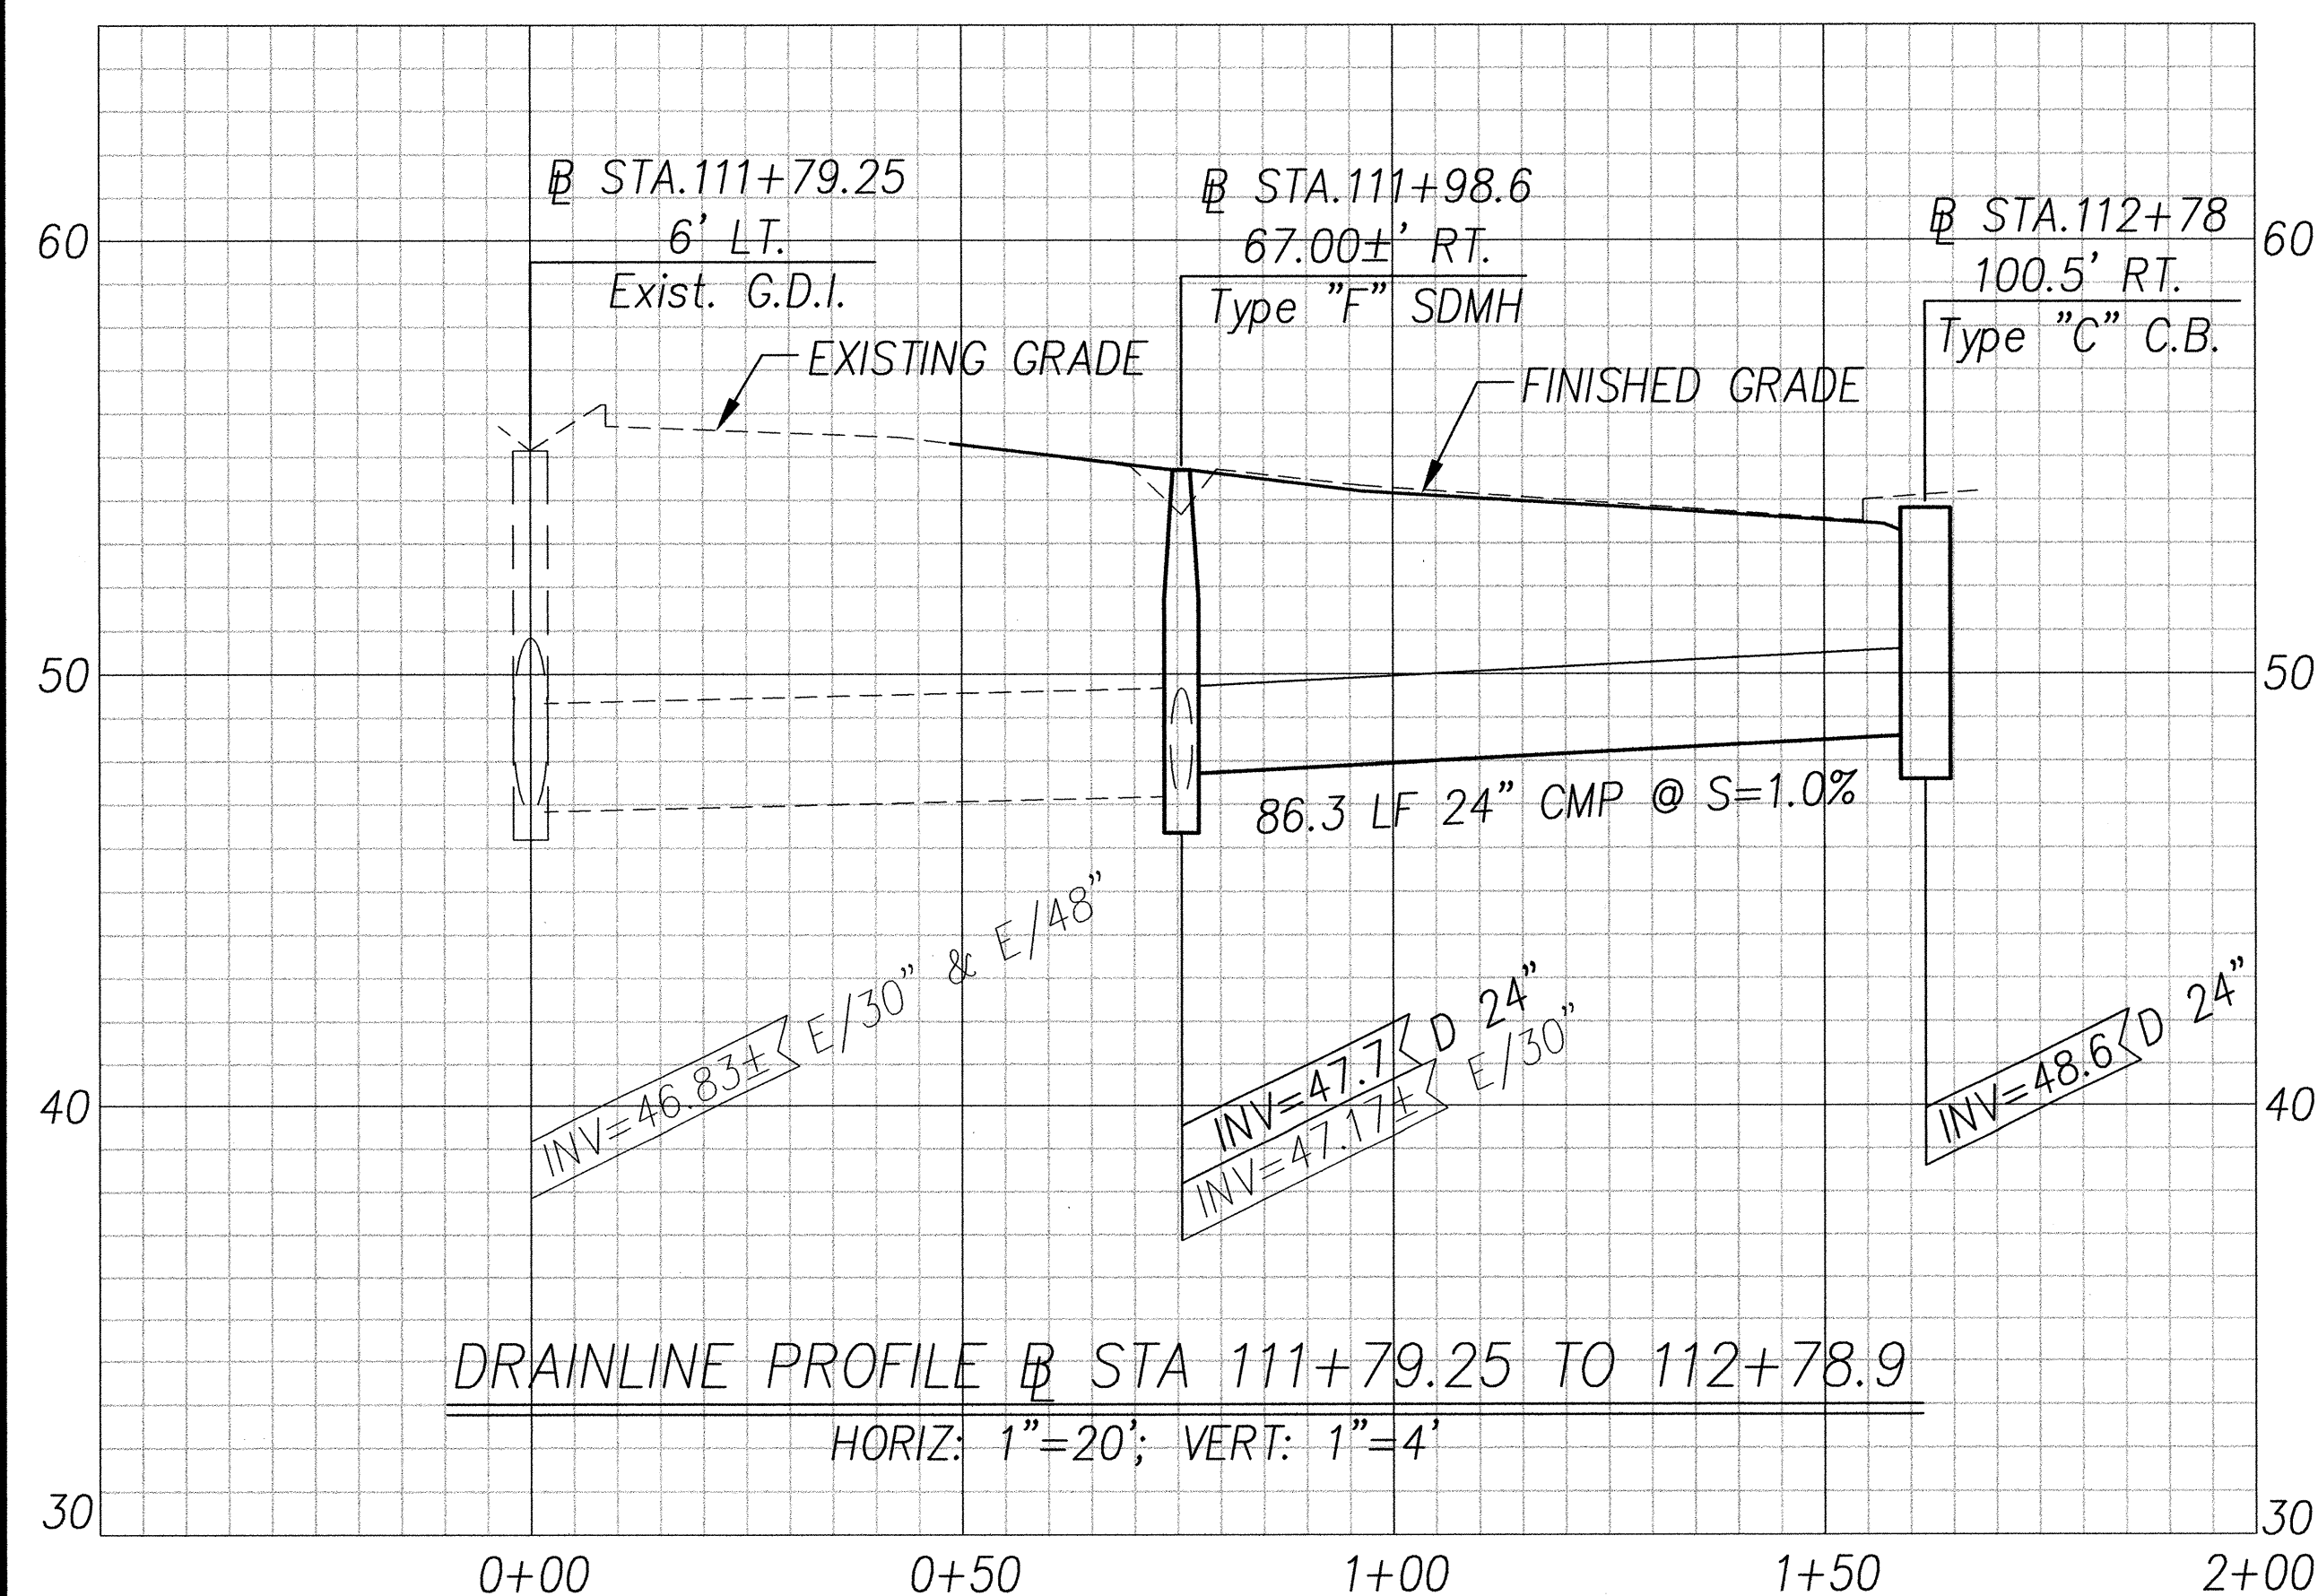


FED. ROAD DIST. NO.	STATE	FED. AID PROJ. NO.	FISCAL YEAR	SHEET NO.	TOTAL SHEETS
HAWAII	HAW.	CMAQ-076-1(8)	2004	36	127

Notes:

- ① Concrete Collar;
See Sheet 38 For Detail
- ② Set Manhole Frame & Cover
to Slope and Grade of Exist.
Ground.

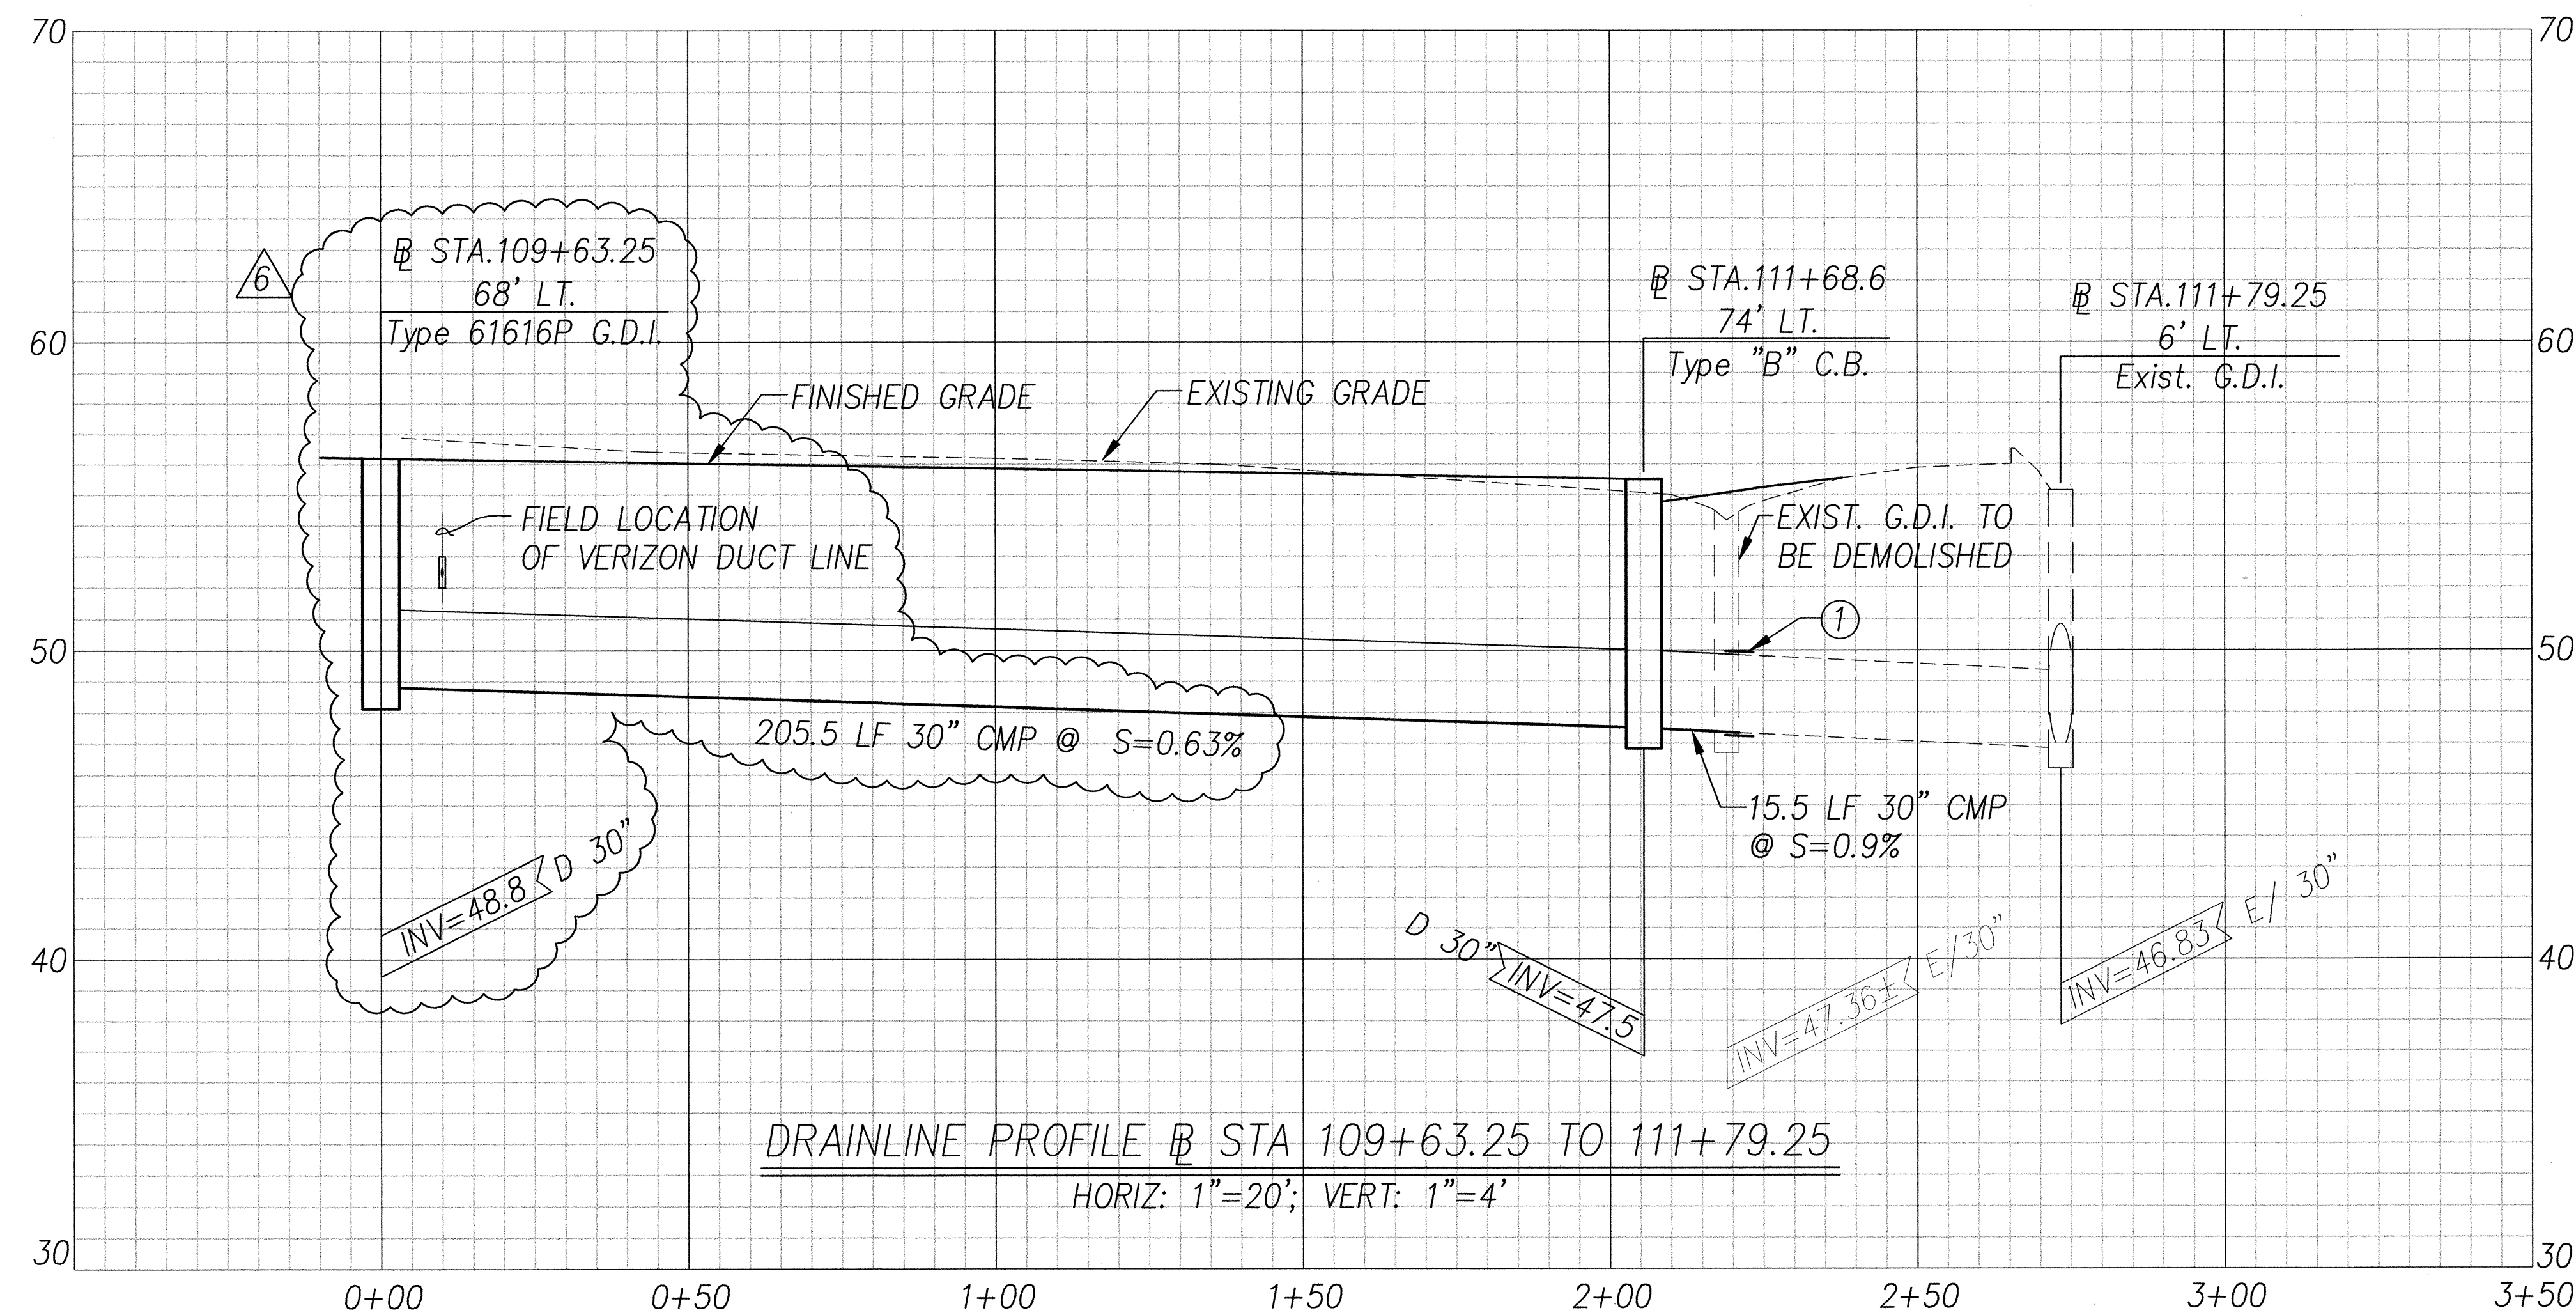

	08/26/04	Revised G.D.I. Profile
Revision	Date	Description

STATE OF HAWAII
DEPARTMENT OF TRANSPORTATION
HIGHWAYS DIVISION

DRAIN LINE PROFILES

FORT WEAVER ROAD WIDENING
NEAR LAULAUNUI STREET

FEDERAL AID PROJECT NO. CMAQ-076-1(8)

SCALE: AS NOTED DATE: October 2003

SHEET No. 5 OF 9 SHEETS



[Handwritten Signature]




 SIGNATURE

APRIL 30, 2006

 EXPIRATION DATE OF LICENSE


**THIS WORK WAS PREPARED BY
 UNDER MY SUPERVISION**

FED. ROAD DIST. NO.	STATE	FED. AID PROJ. NO.	FISCAL YEAR	SHEET NO.	TOTAL SHEETS
HAWAII	HAW.	CMAQ-076-1(8)	2004	37	127

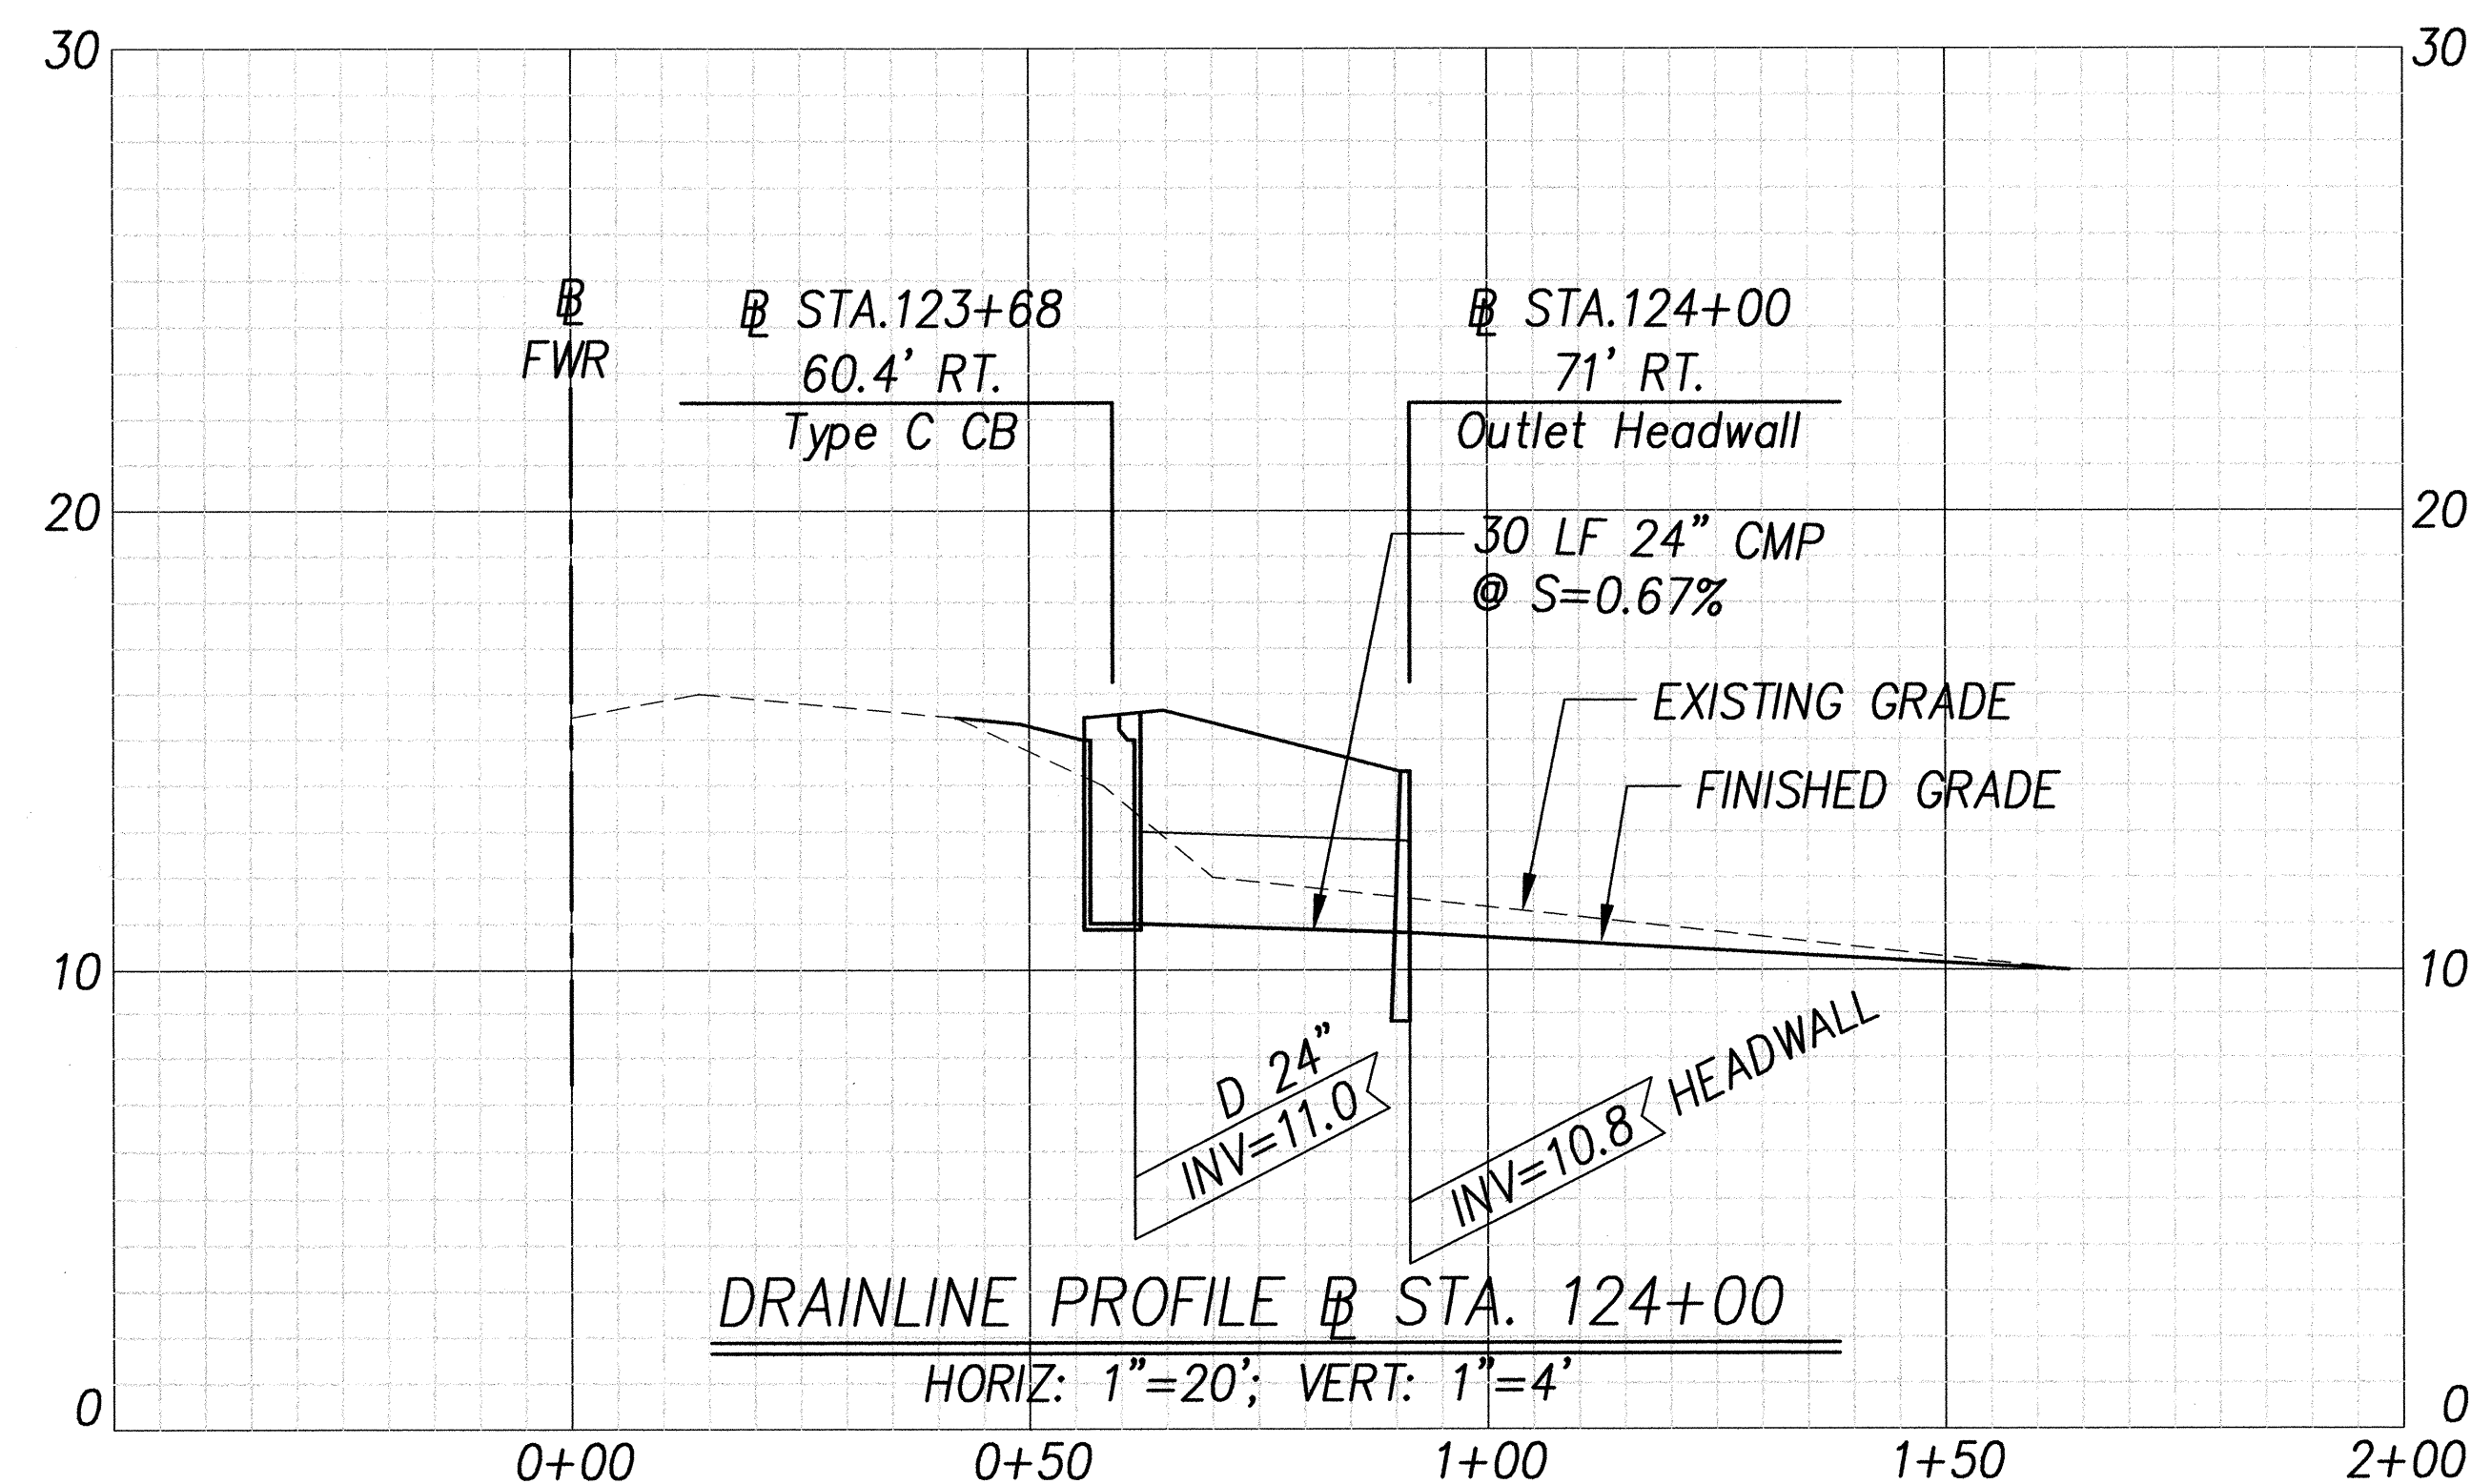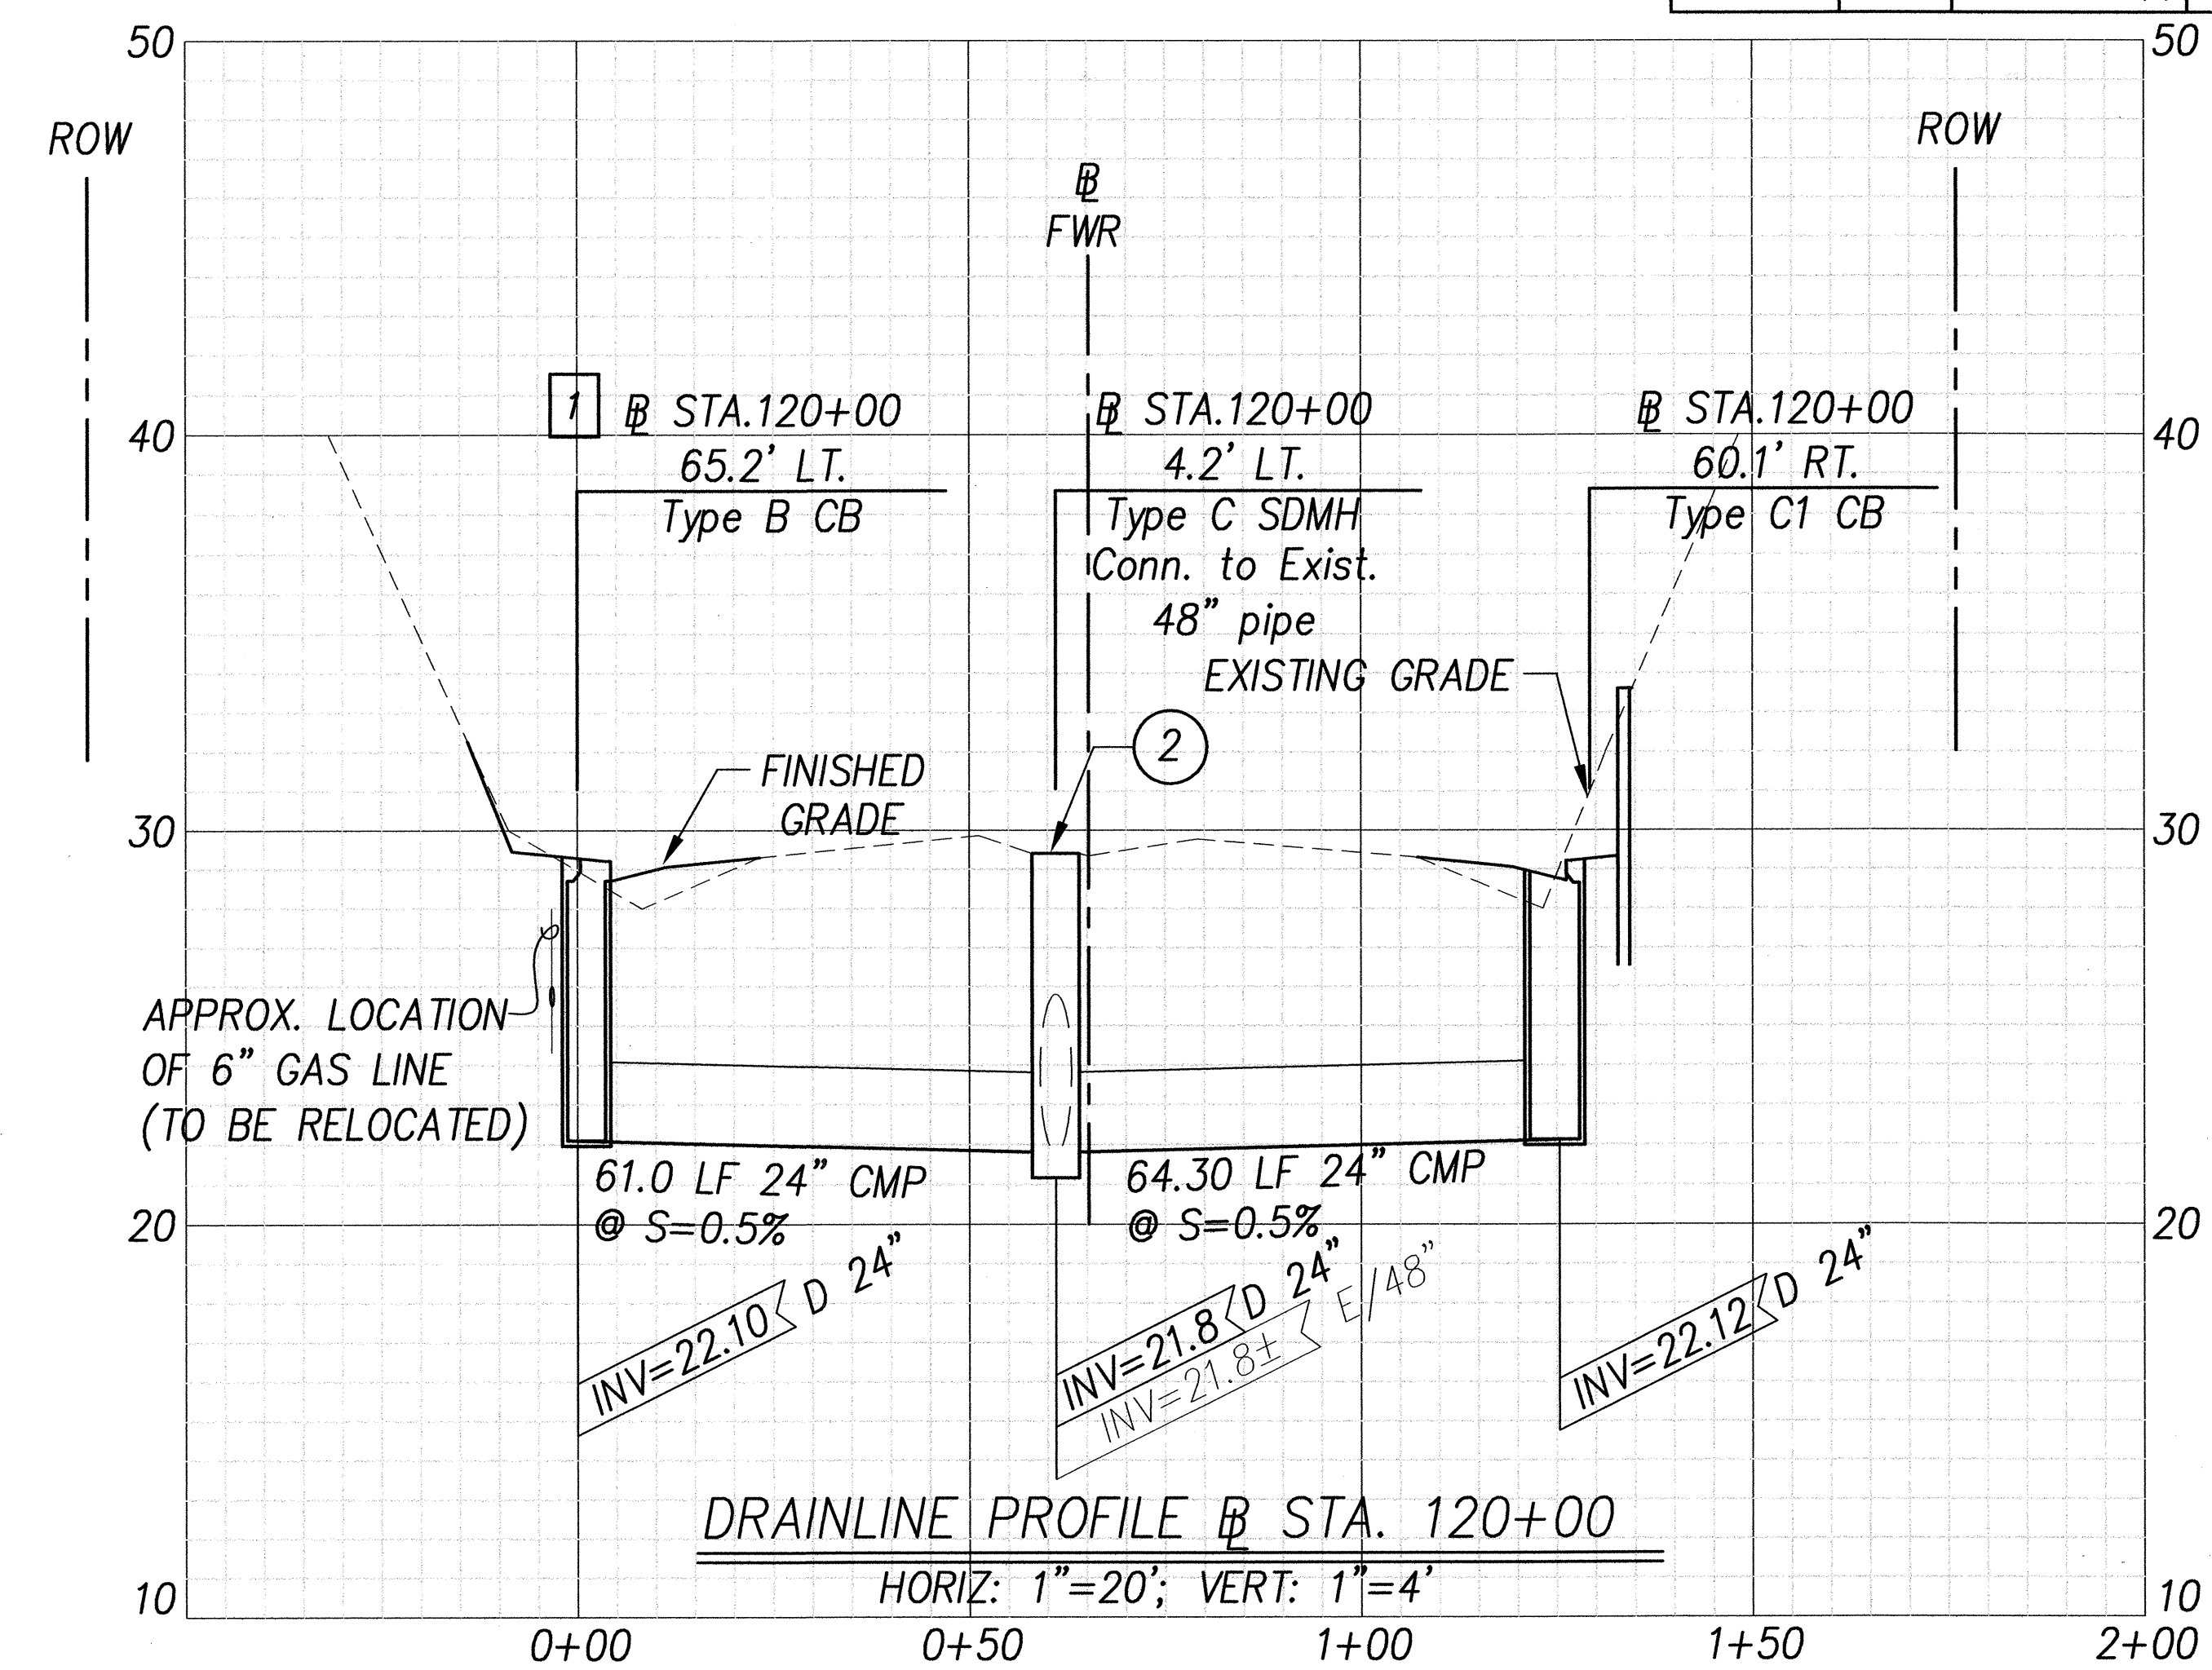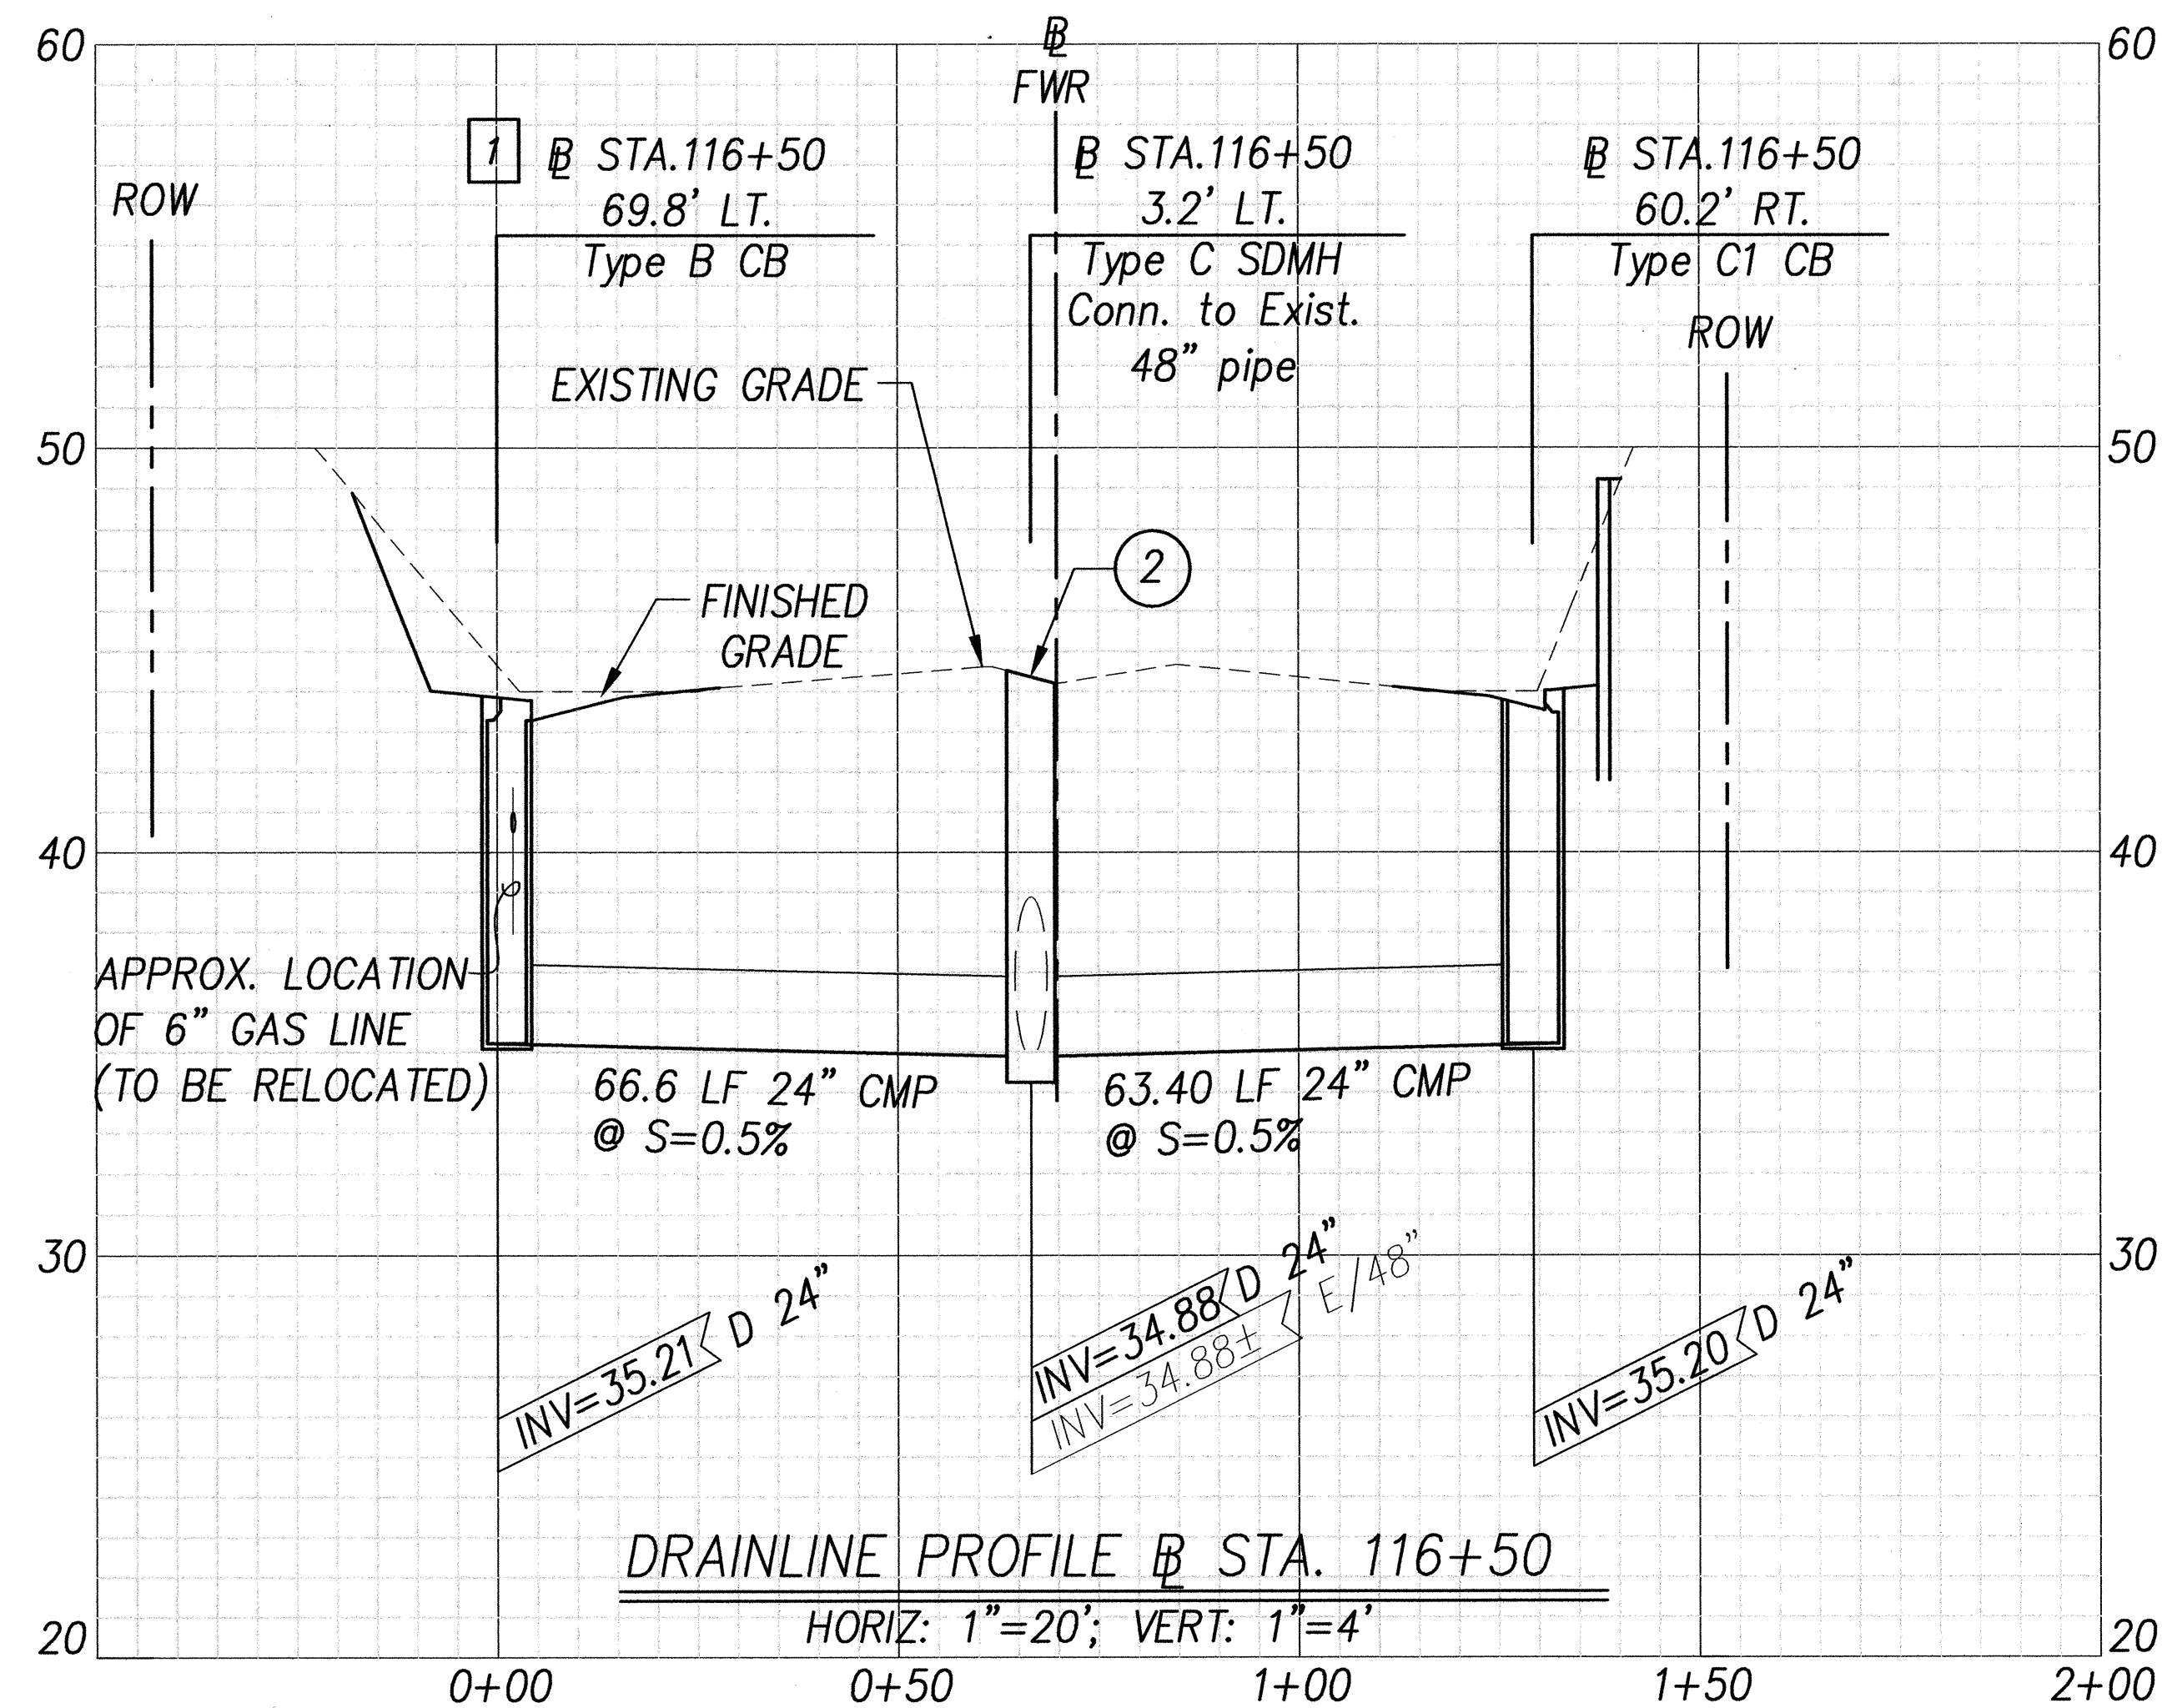

Notes:

- ① Concrete Collar;
See Sheet 38 For Detail
- ② Set Manhole Frame & Cover
to Slope and Grade of Exist.
Ground.

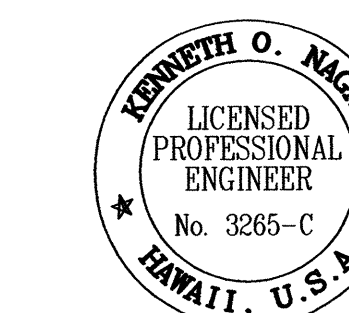

SIGNATURE
 APRIL 30, 2004
 EXPIRATION DATE OF LICENSE
 THIS WORK WAS PREPARED BY ME OR
 UNDER MY SUPERVISION

1/16/04	1	Revised CB Type
Date	Revision	

STATE OF HAWAII
 DEPARTMENT OF TRANSPORTATION
 HIGHWAYS DIVISION

DRAIN LINE PROFILES

FORT WEAVER ROAD WIDENING
 NEAR LAULAUNUI STREET

FEDERAL AID PROJECT NO. CMAQ-076-1(8)

SCALE: AS NOTED DATE: October 2003

SHEET No. 6 OF 9 SHEETS