


FED. ROAD DIST. NO.	STATE	PROJ. NO.	FISCAL YEAR	SHEET NO.	TOTAL SHEETS
HAWAII	HAW.	CMAQ-076-1(8)	2004	43	127

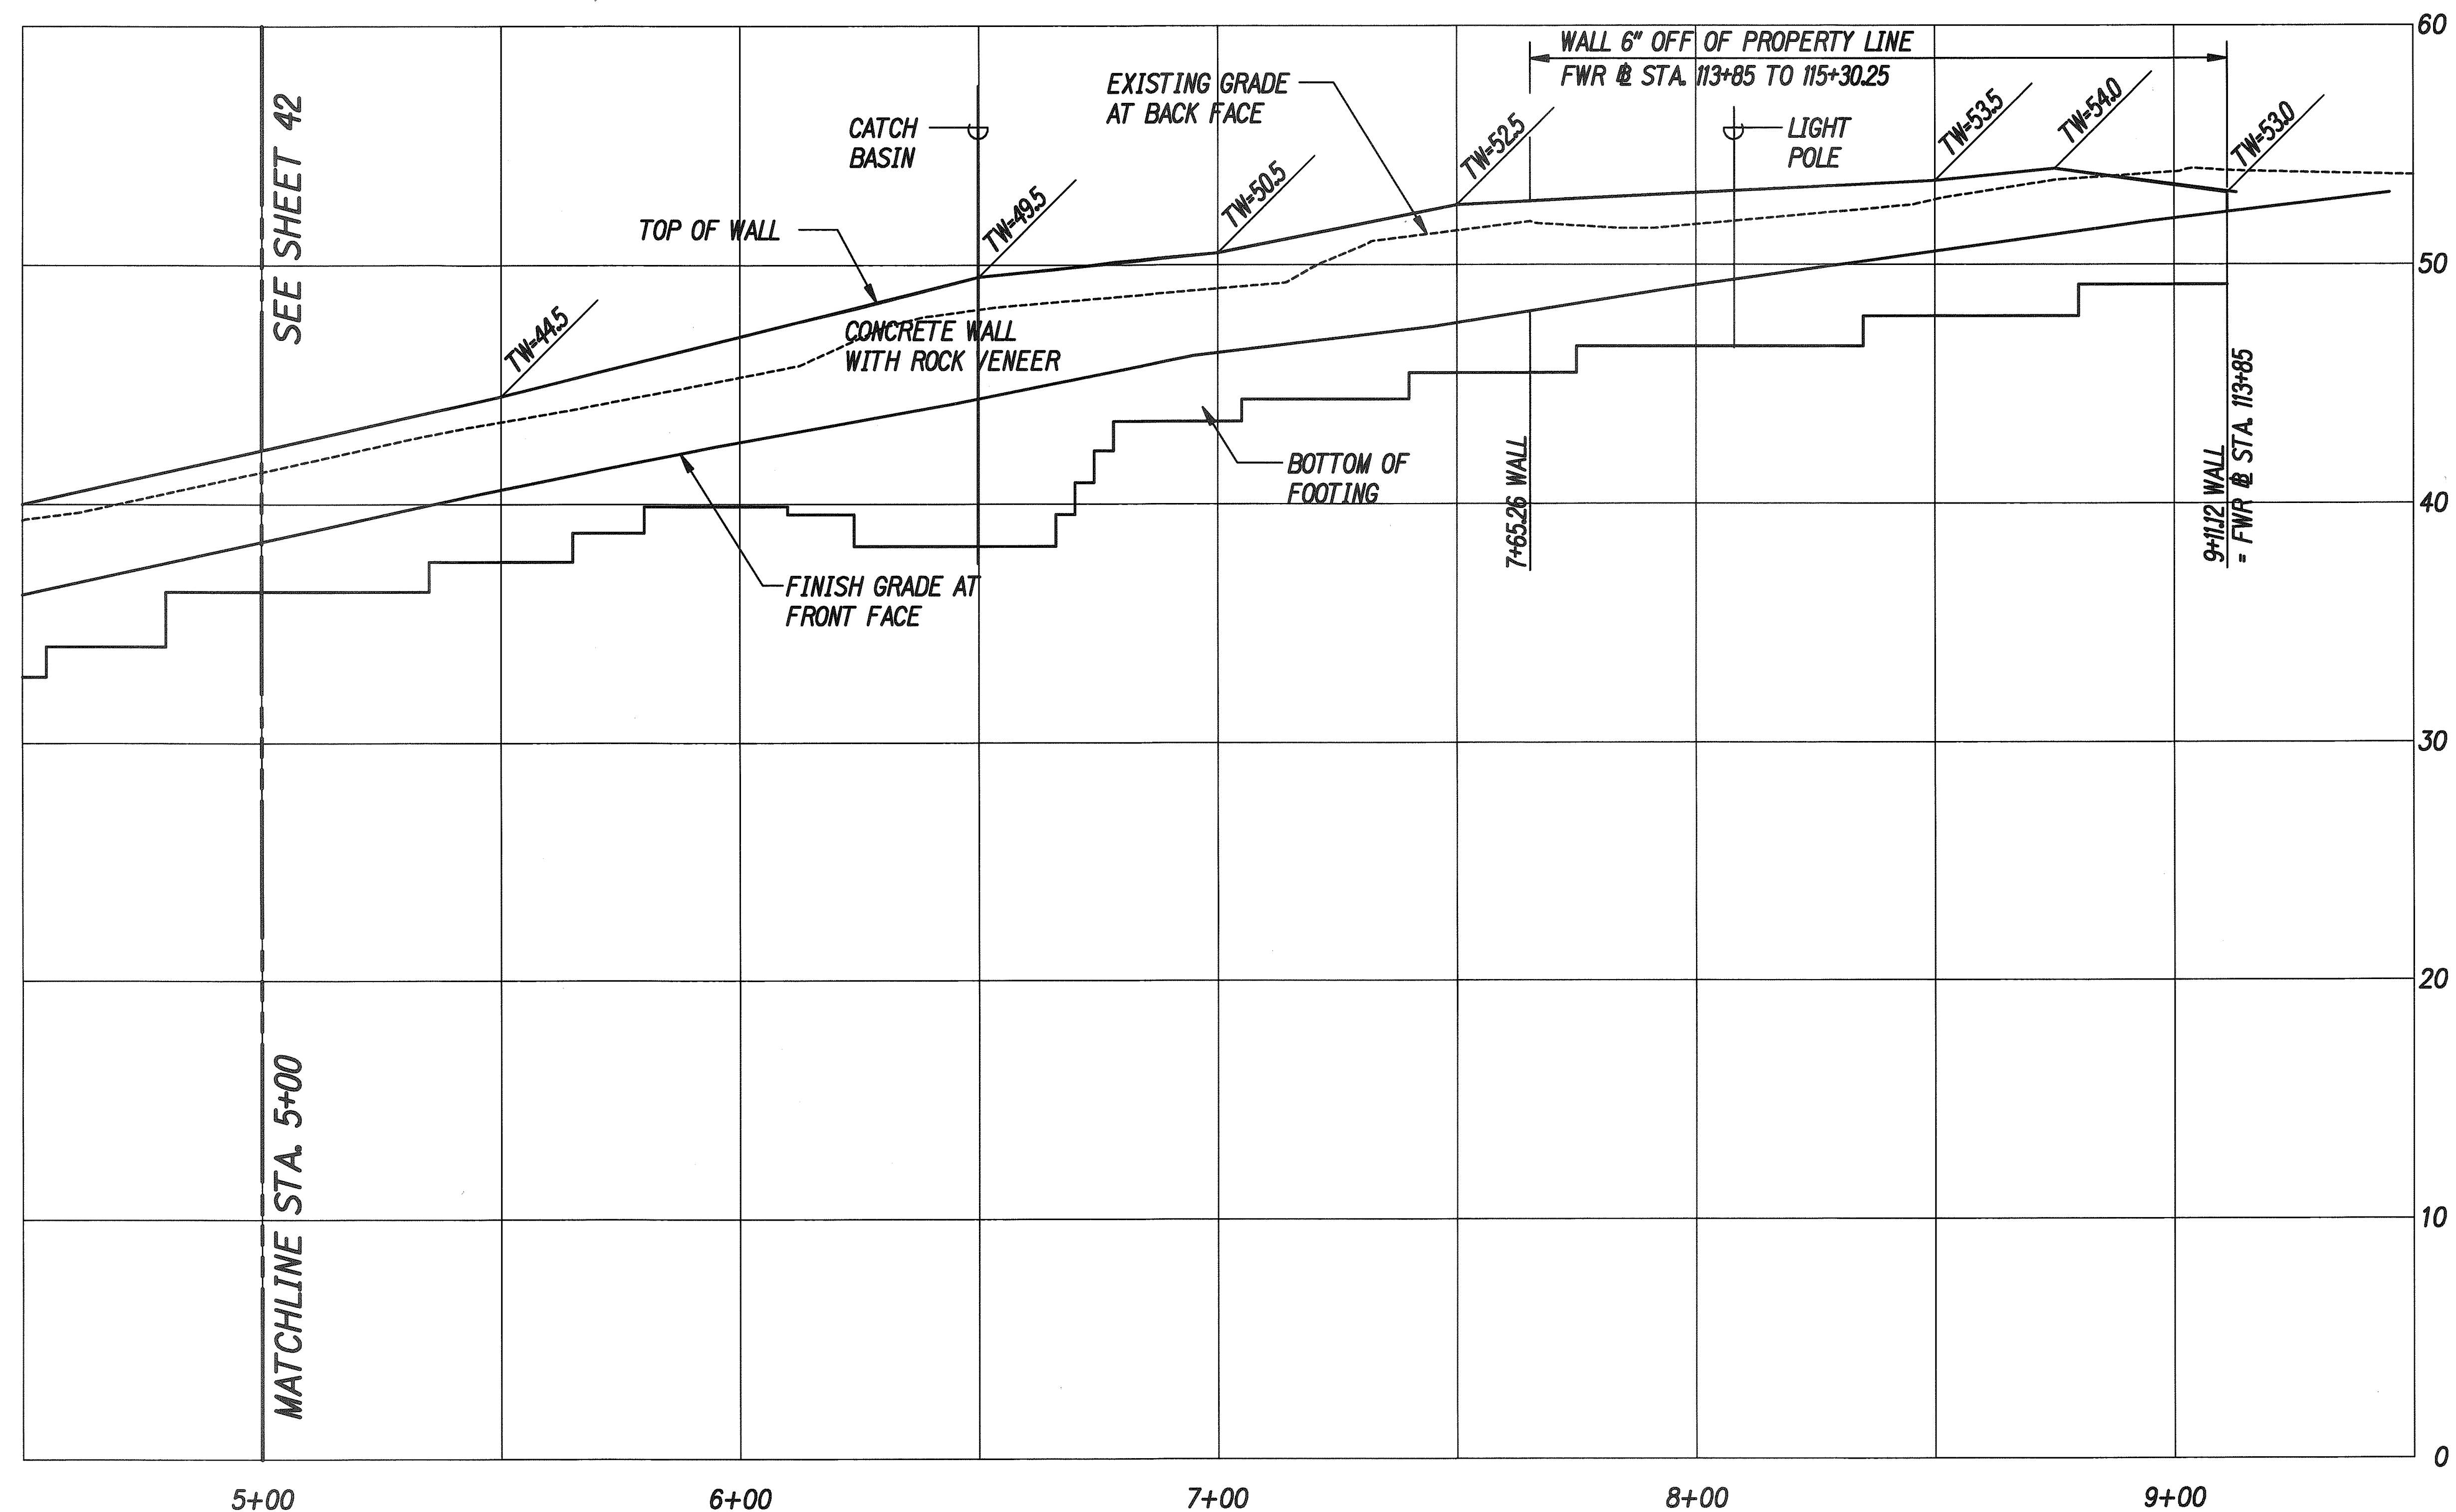

ELEVATION - WALL 1
 HORIZ: 1"=20'; VERT: 1"=4'

LEGEND FOR AS-BUILT POSTINGS	
	Squiggly line for as-built deletion
	Double line for as-built deletion
Roadway	Text for as-built posting

NOTE:
 SEE STRUCTURAL SHEETS FOR WALL SECTIONS AND DETAILS



SIGNATURE
 APRIL 30, 2008
 EXPIRATION DATE OF LICENSE
 THIS WORK WAS PREPARED BY ME OR UNDER MY SUPERVISION.

STATE OF HAWAII
 DEPARTMENT OF TRANSPORTATION
 HIGHWAYS DIVISION

RETAINING WALL ELEVATION
STA. 5+00 TO END
FORT WEAVER ROAD WIDENING
NEAR LAULAUNUI STREET
FEDERAL AND PROJECT NO. CMAQ-076-1(8)
 SCALE: AS NOTED DATE: October 2003
 SHEET No. 2 OF 2 SHEETS

"AS-BUILT"