


FED. ROAD DIST. NO.	STATE	FED. AID PROJ. NO.	FISCAL YEAR	SHEET NO.	TOTAL SHEETS
HAWAII	HAW.	CMAQ-076-1(8)	2004	104	127



ORIGINAL PLAN	SURVEY PLOTTED BY	DATE
NOTE BOOK	DRAWN BY	" "
	TRACED BY	" "
	DESIGNED BY	" "
	CHECKED BY	" "
No.		

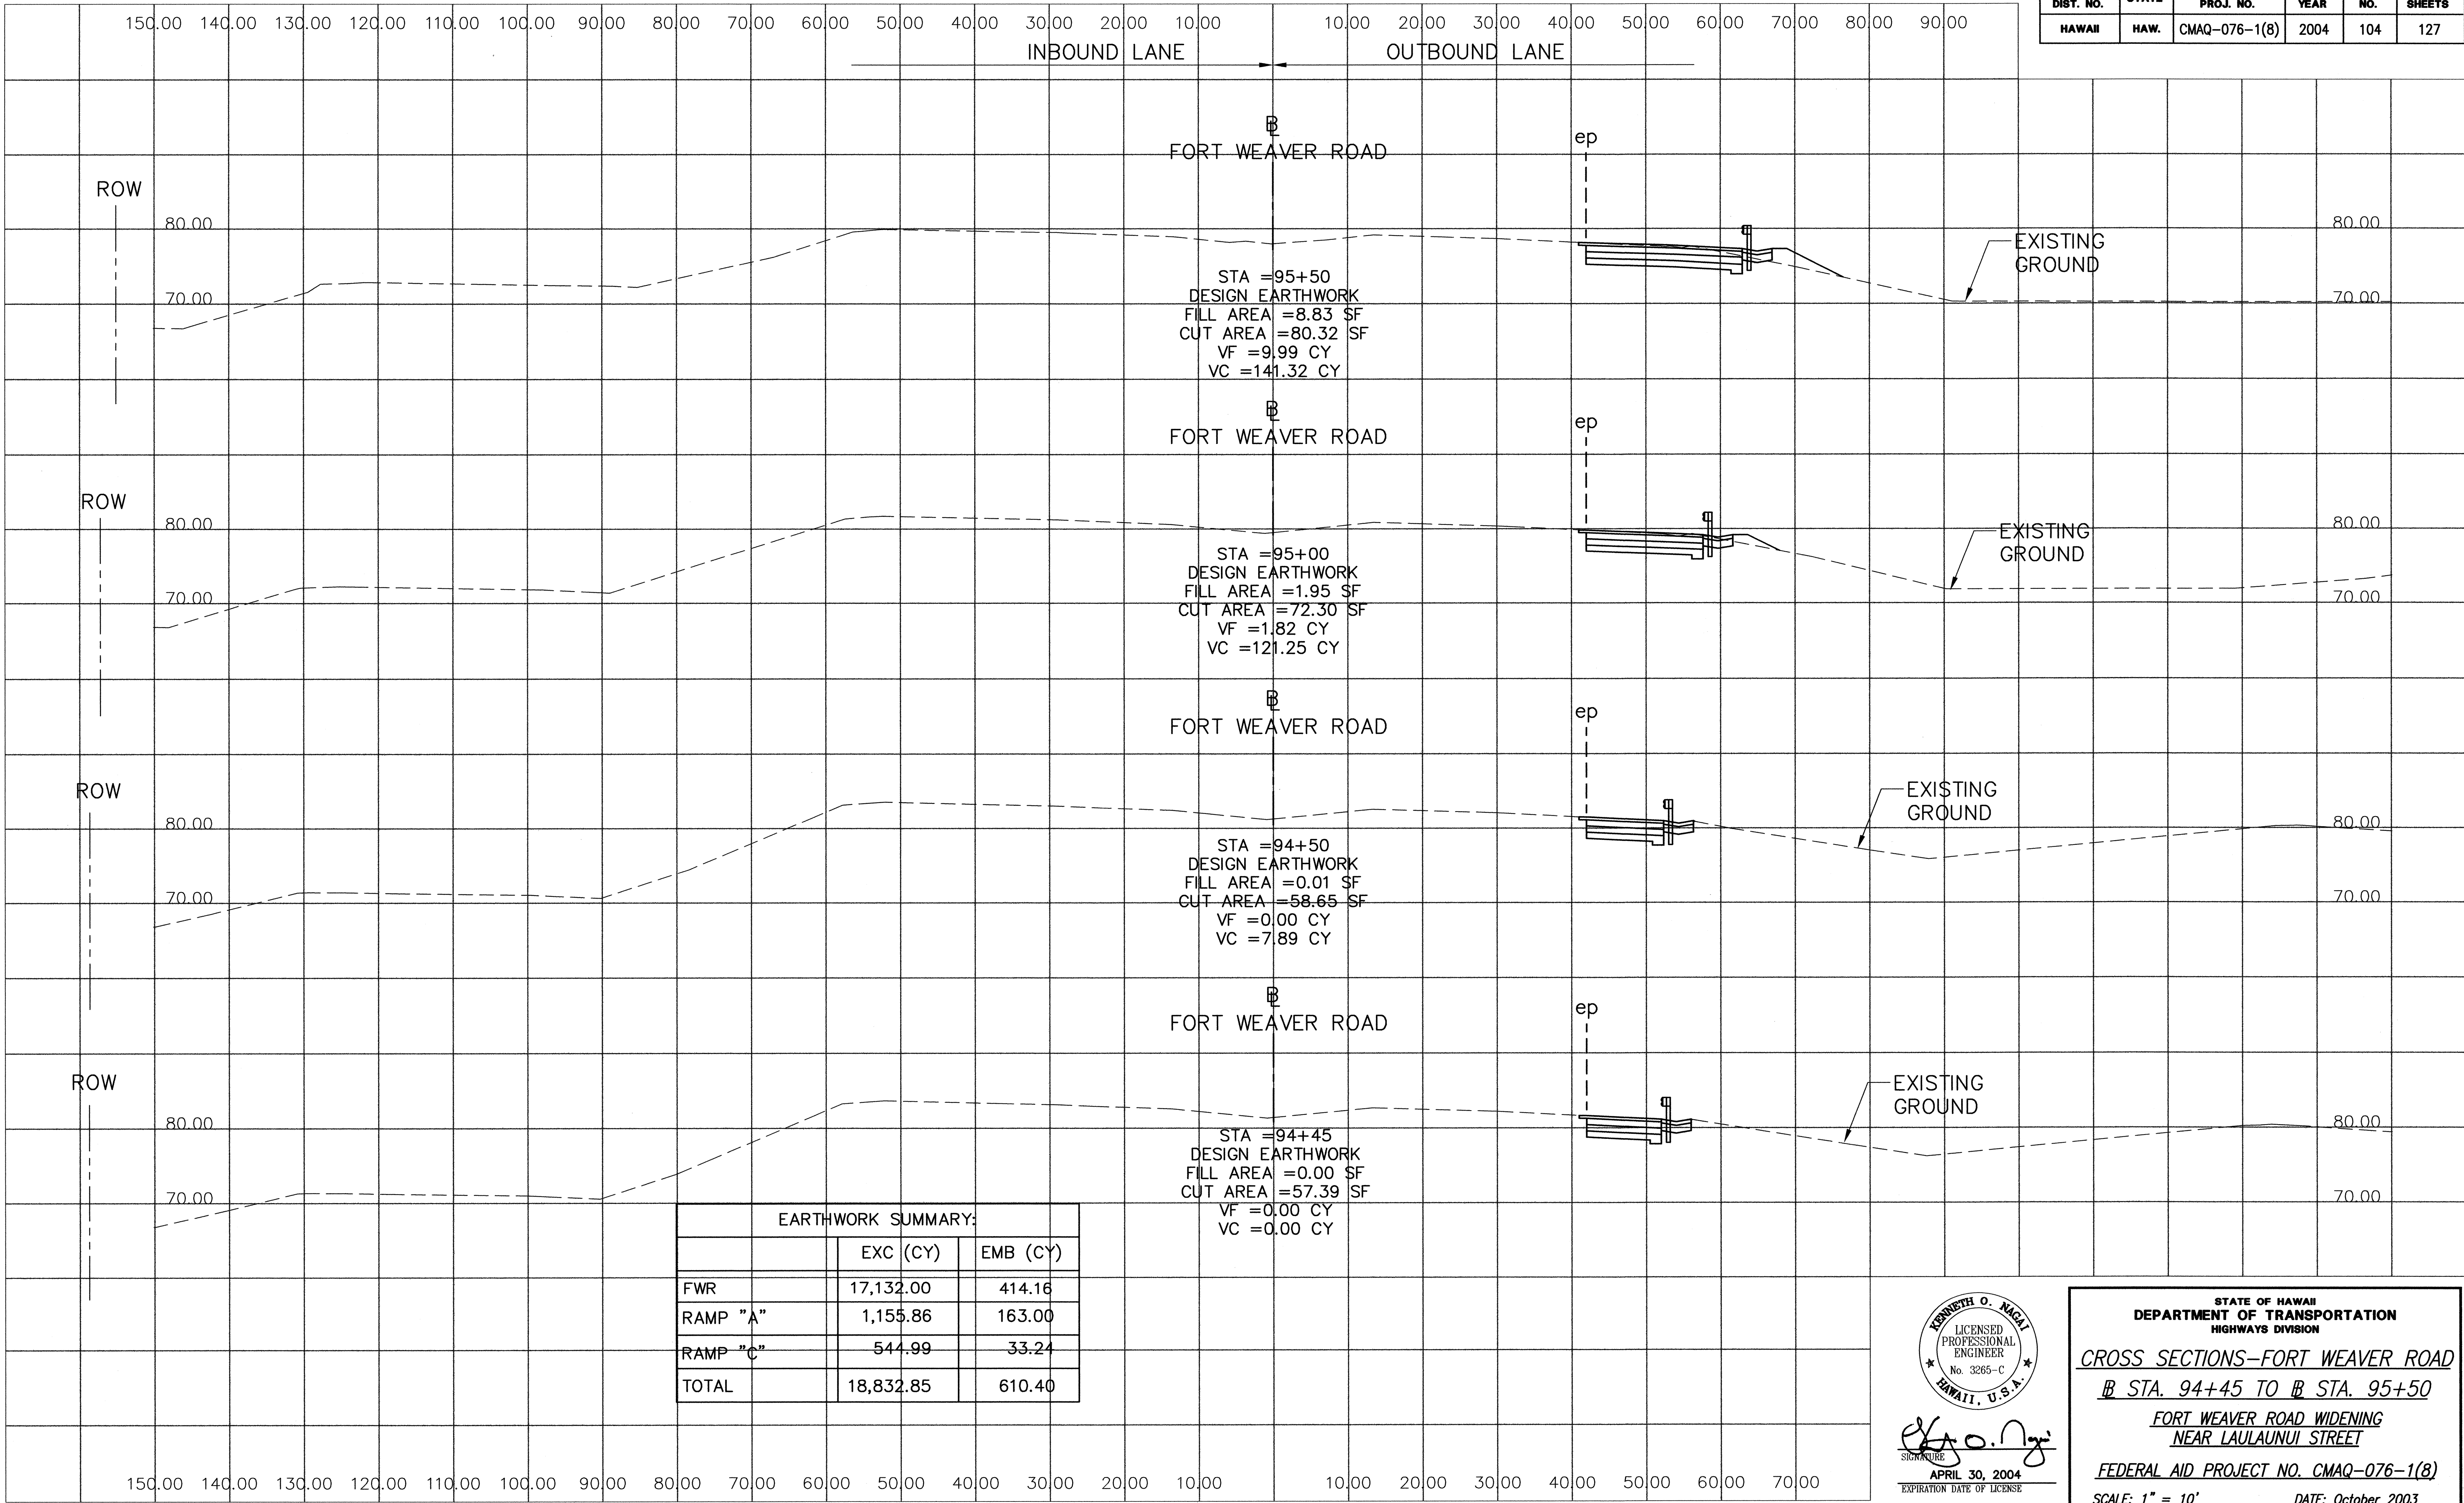


Signature: *Kenneth O. Nagai*
APRIL 30, 2004
EXPIRATION DATE OF LICENSE
THIS WORK WAS PREPARED BY ME OR UNDER MY SUPERVISION

STATE OF HAWAII
DEPARTMENT OF TRANSPORTATION
HIGHWAYS DIVISION


CROSS SECTIONS-FORT WEAVER ROAD
@ STA. 94+45 TO @ STA. 95+50
FORT WEAVER ROAD WIDENING
NEAR LAULAUNUI STREET
FEDERAL AID PROJECT NO. CMAQ-076-1(8)

SCALE: 1" = 10' DATE: October 2003
SHEET No. 1 OF 24 SHEETS

FED. ROAD DIST. NO.	STATE	FED. AID PROJ. NO.	FISCAL YEAR	SHEET NO.	TOTAL SHEETS
HAWAII	HAW.	CMAQ-076-1(8)	2004	105	127

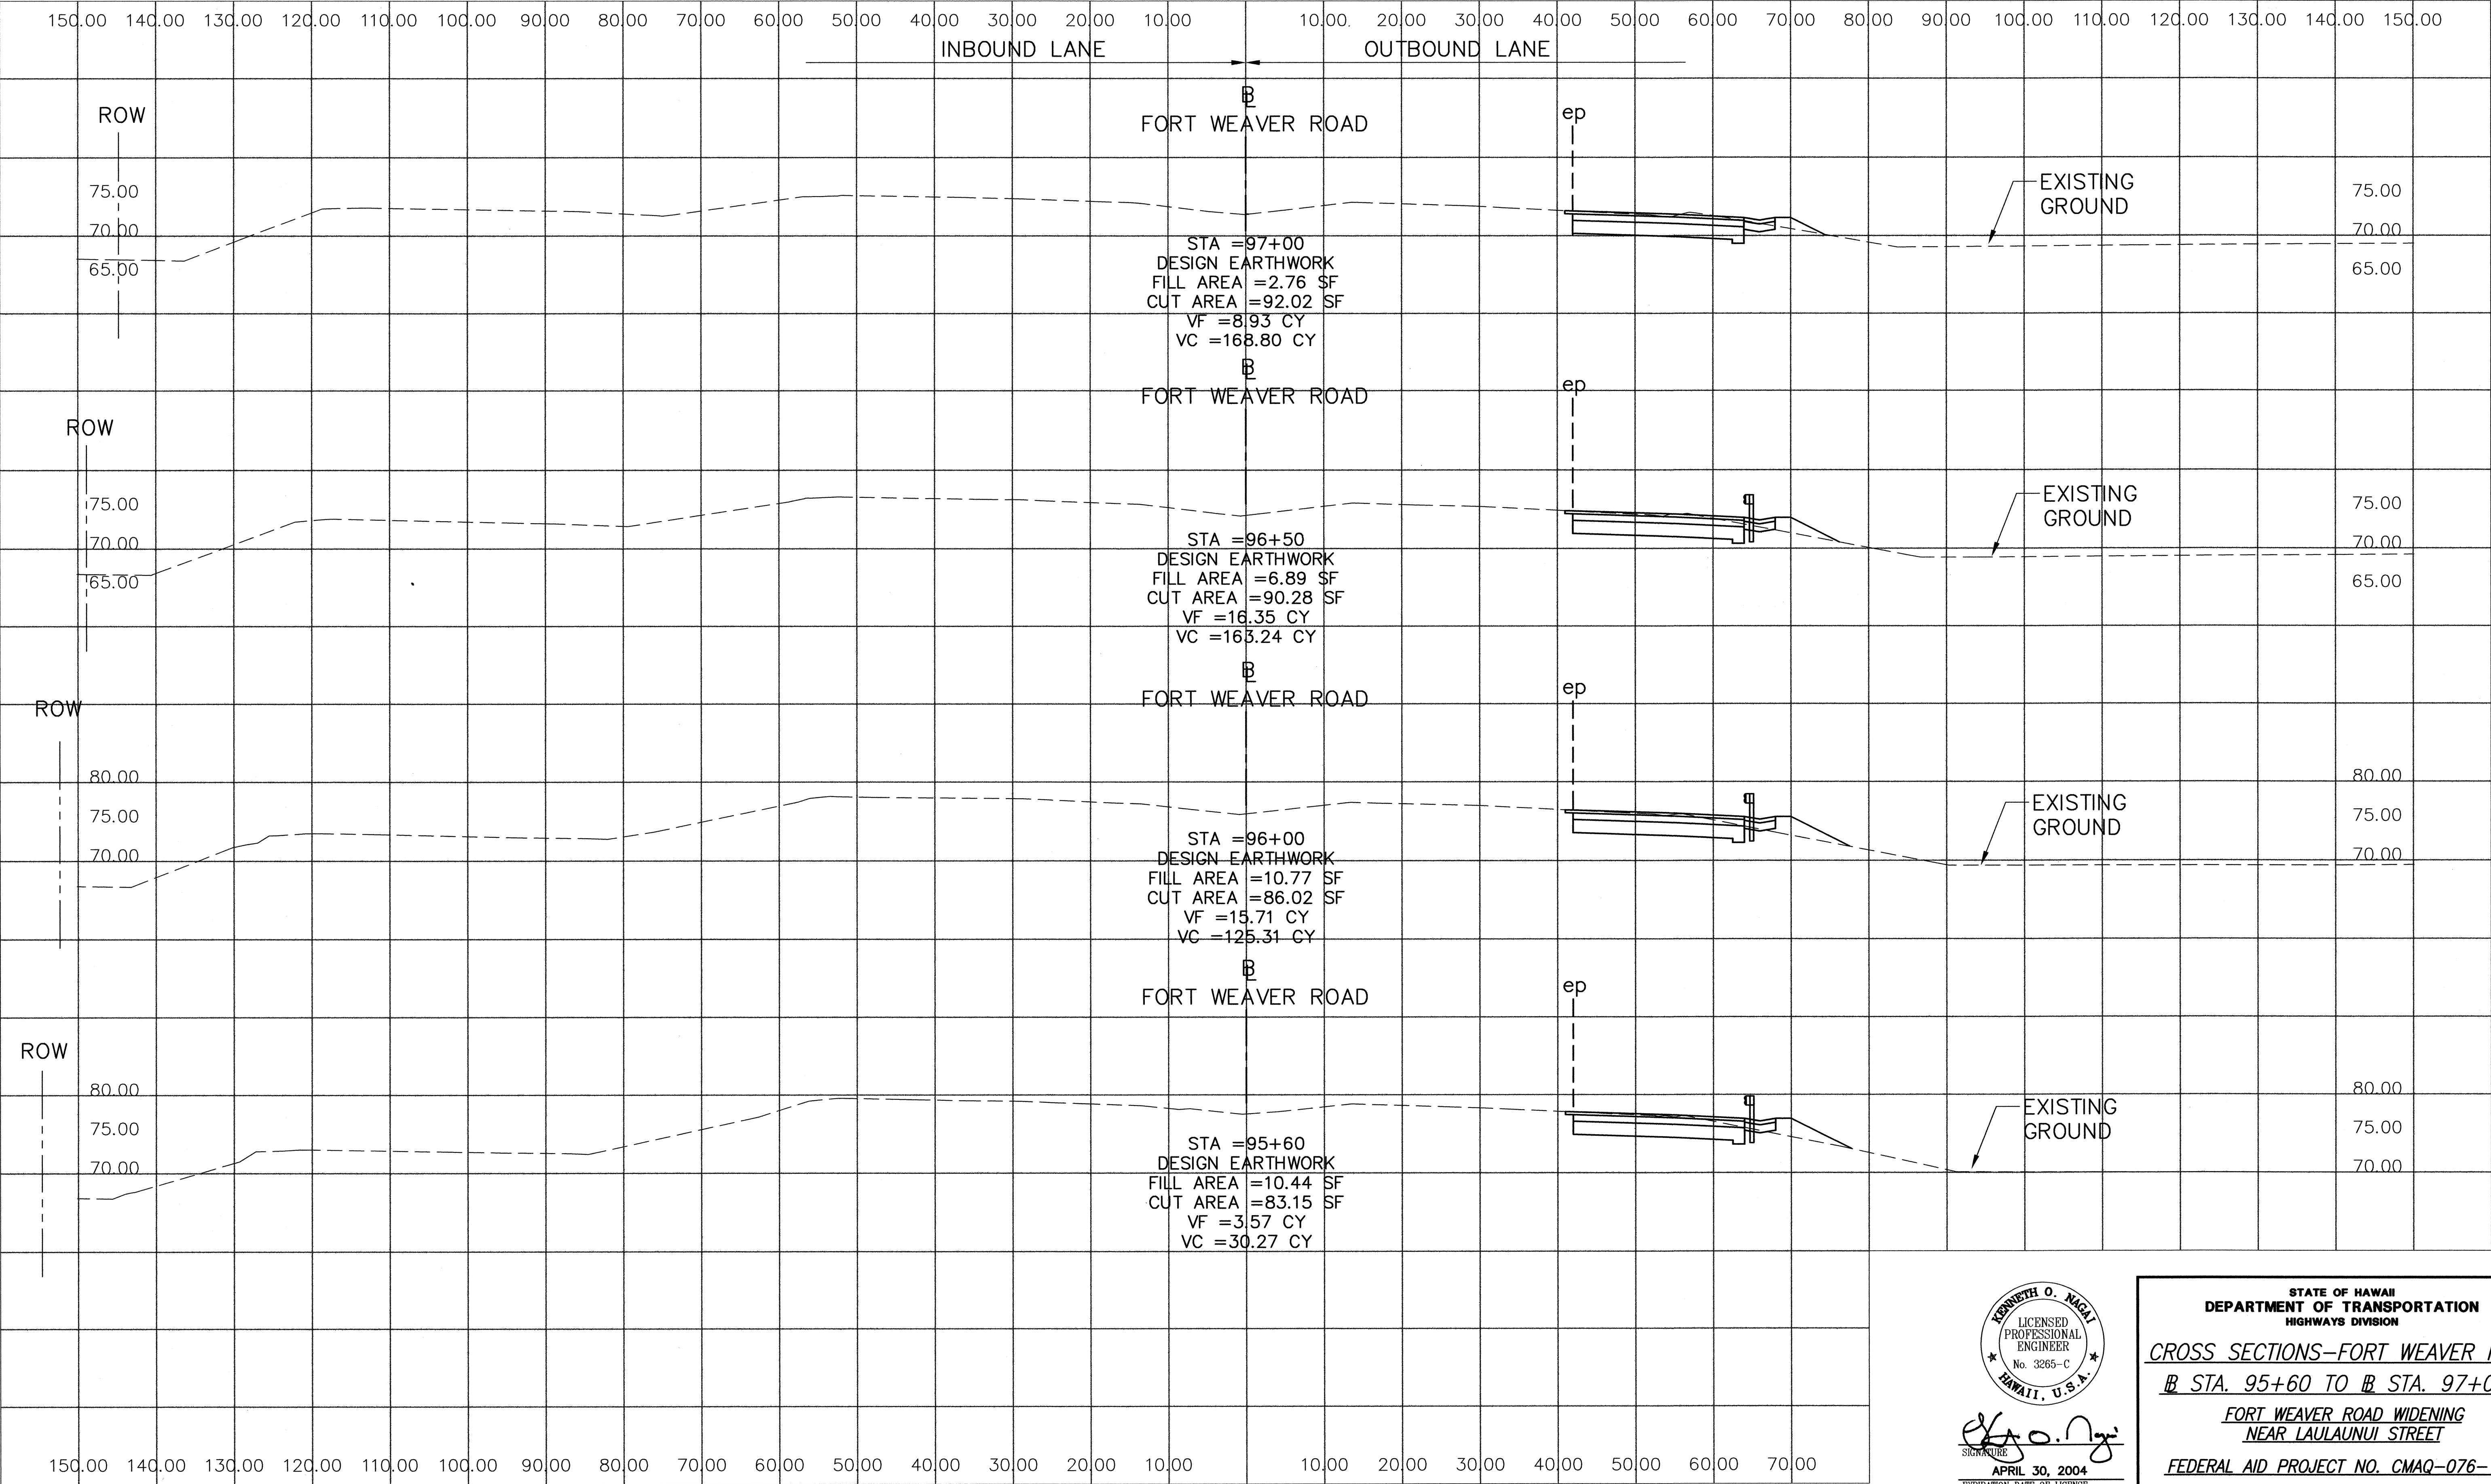

ORIGINAL PLAN	SURVEY PLOTTED BY	DATE
NOTE BOOK	DRAWN BY	" "
No.	DESIGNED BY	" "
	CHECKED BY	" "

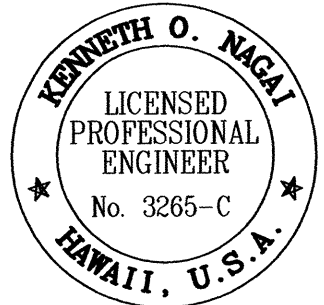

SIGNATURE
APRIL 30, 2004
EXPIRATION DATE OF LICENSE


THIS WORK WAS PREPARED BY ME OR UNDER MY SUPERVISION

STATE OF HAWAII
DEPARTMENT OF TRANSPORTATION
HIGHWAYS DIVISION


CROSS SECTIONS-FORT WEAVER ROAD
B STA. 95+60 TO B STA. 97+00
FORT WEAVER ROAD WIDENING
NEAR LAULAUNUI STREET
FEDERAL AID PROJECT NO. CMAQ-076-1(8)

SCALE: 1" = 10' DATE: October 2003
SHEET No. 2 OF 24 SHEETS

FED. ROAD DIST. NO.	STATE	FED. AID PROJ. NO.	FISCAL YEAR	SHEET NO.	TOTAL SHEETS
HAWAII	HAW.	CMAQ-076-1(8)	2004	107	127

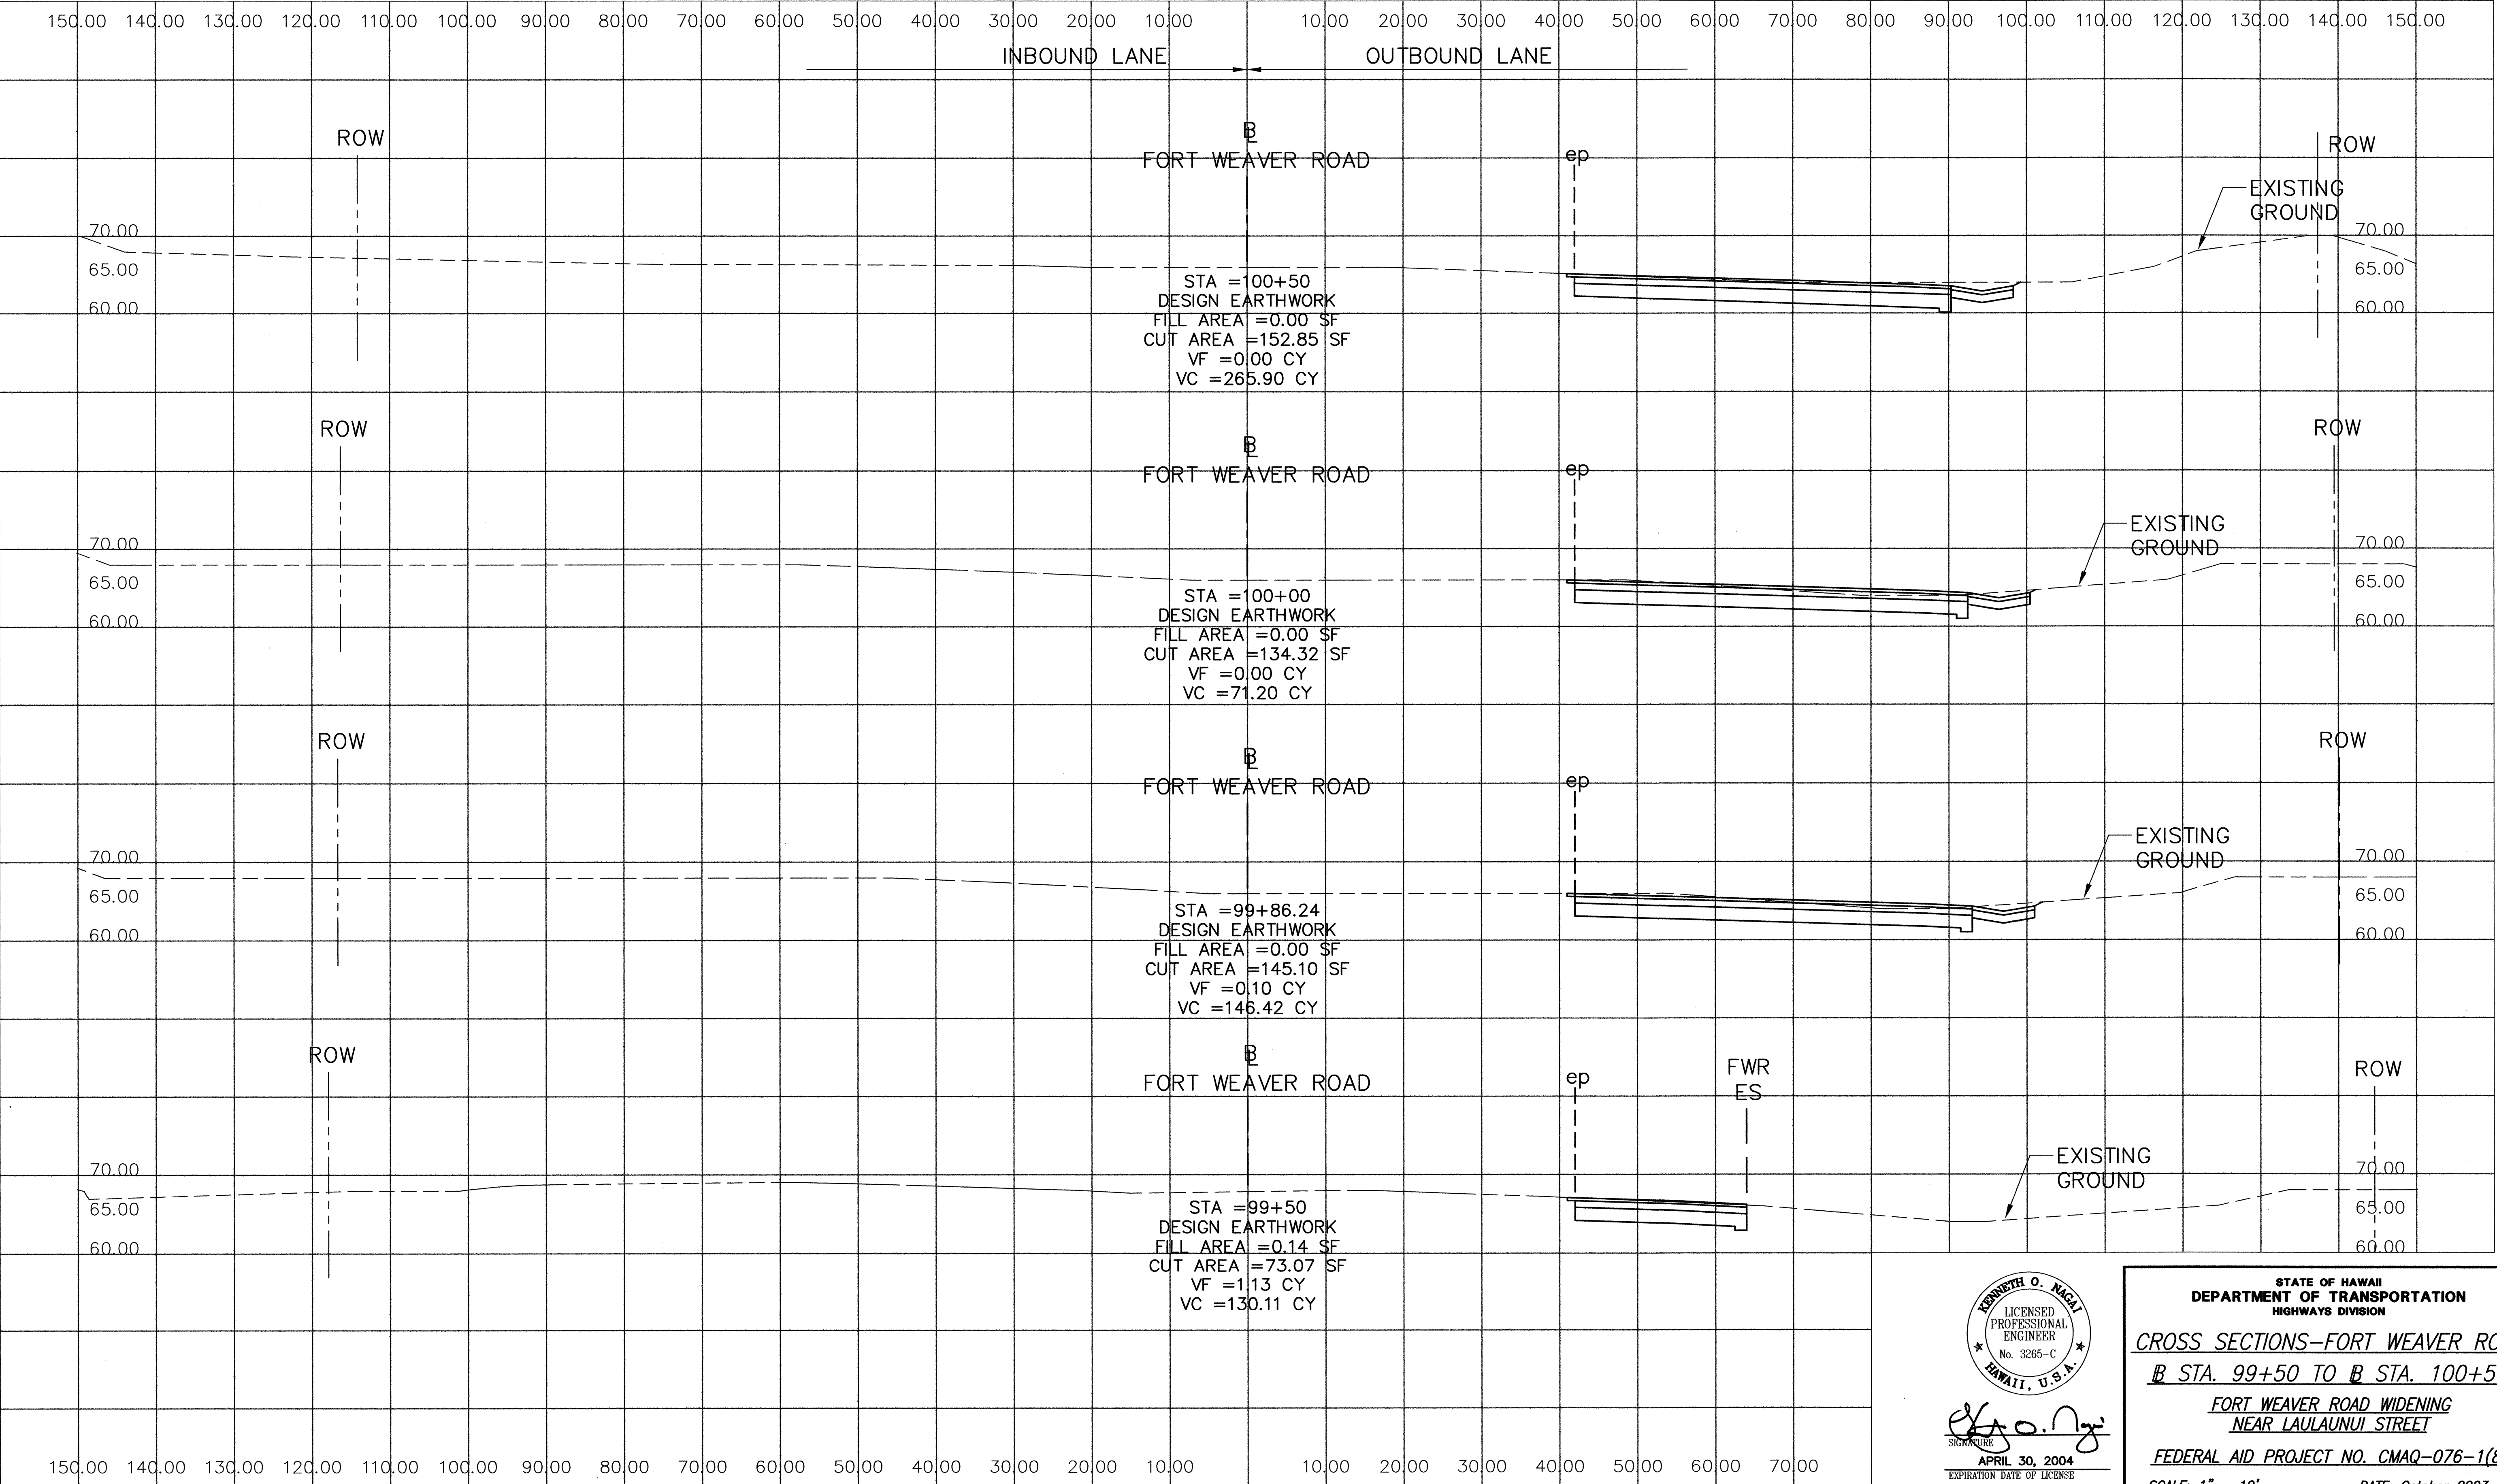

ORIGINAL PLAN	SURVEY PLOTTED BY	DATE
NOTE BOOK	DRAWN BY	" "
	DESIGNED BY	" "
	CHECKED BY	" "
No.		

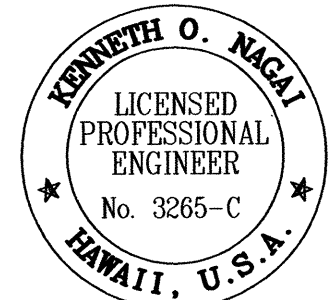


Signature: *Kenneth O. Nagai*
APRIL 30, 2004
EXPIRATION DATE OF LICENSE

THIS WORK WAS PREPARED BY ME OR UNDER MY SUPERVISION

STATE OF HAWAII
DEPARTMENT OF TRANSPORTATION
HIGHWAYS DIVISION

CROSS SECTIONS-FORT WEAVER ROAD
B STA. 99+50 TO B STA. 100+50
FORT WEAVER ROAD WIDENING
NEAR LAULAUNUI STREET
FEDERAL AID PROJECT NO. CMAQ-076-1(8)
SCALE: 1" = 10' **DATE: October 2003**
SHEET No. 4 OF 24 SHEETS

FED. ROAD DIST. NO.	STATE	FED. AID PROJ. NO.	FISCAL YEAR	SHEET NO.	TOTAL SHEETS
HAWAII	HAW.	CMAQ-076-1(8)	2004	108	127

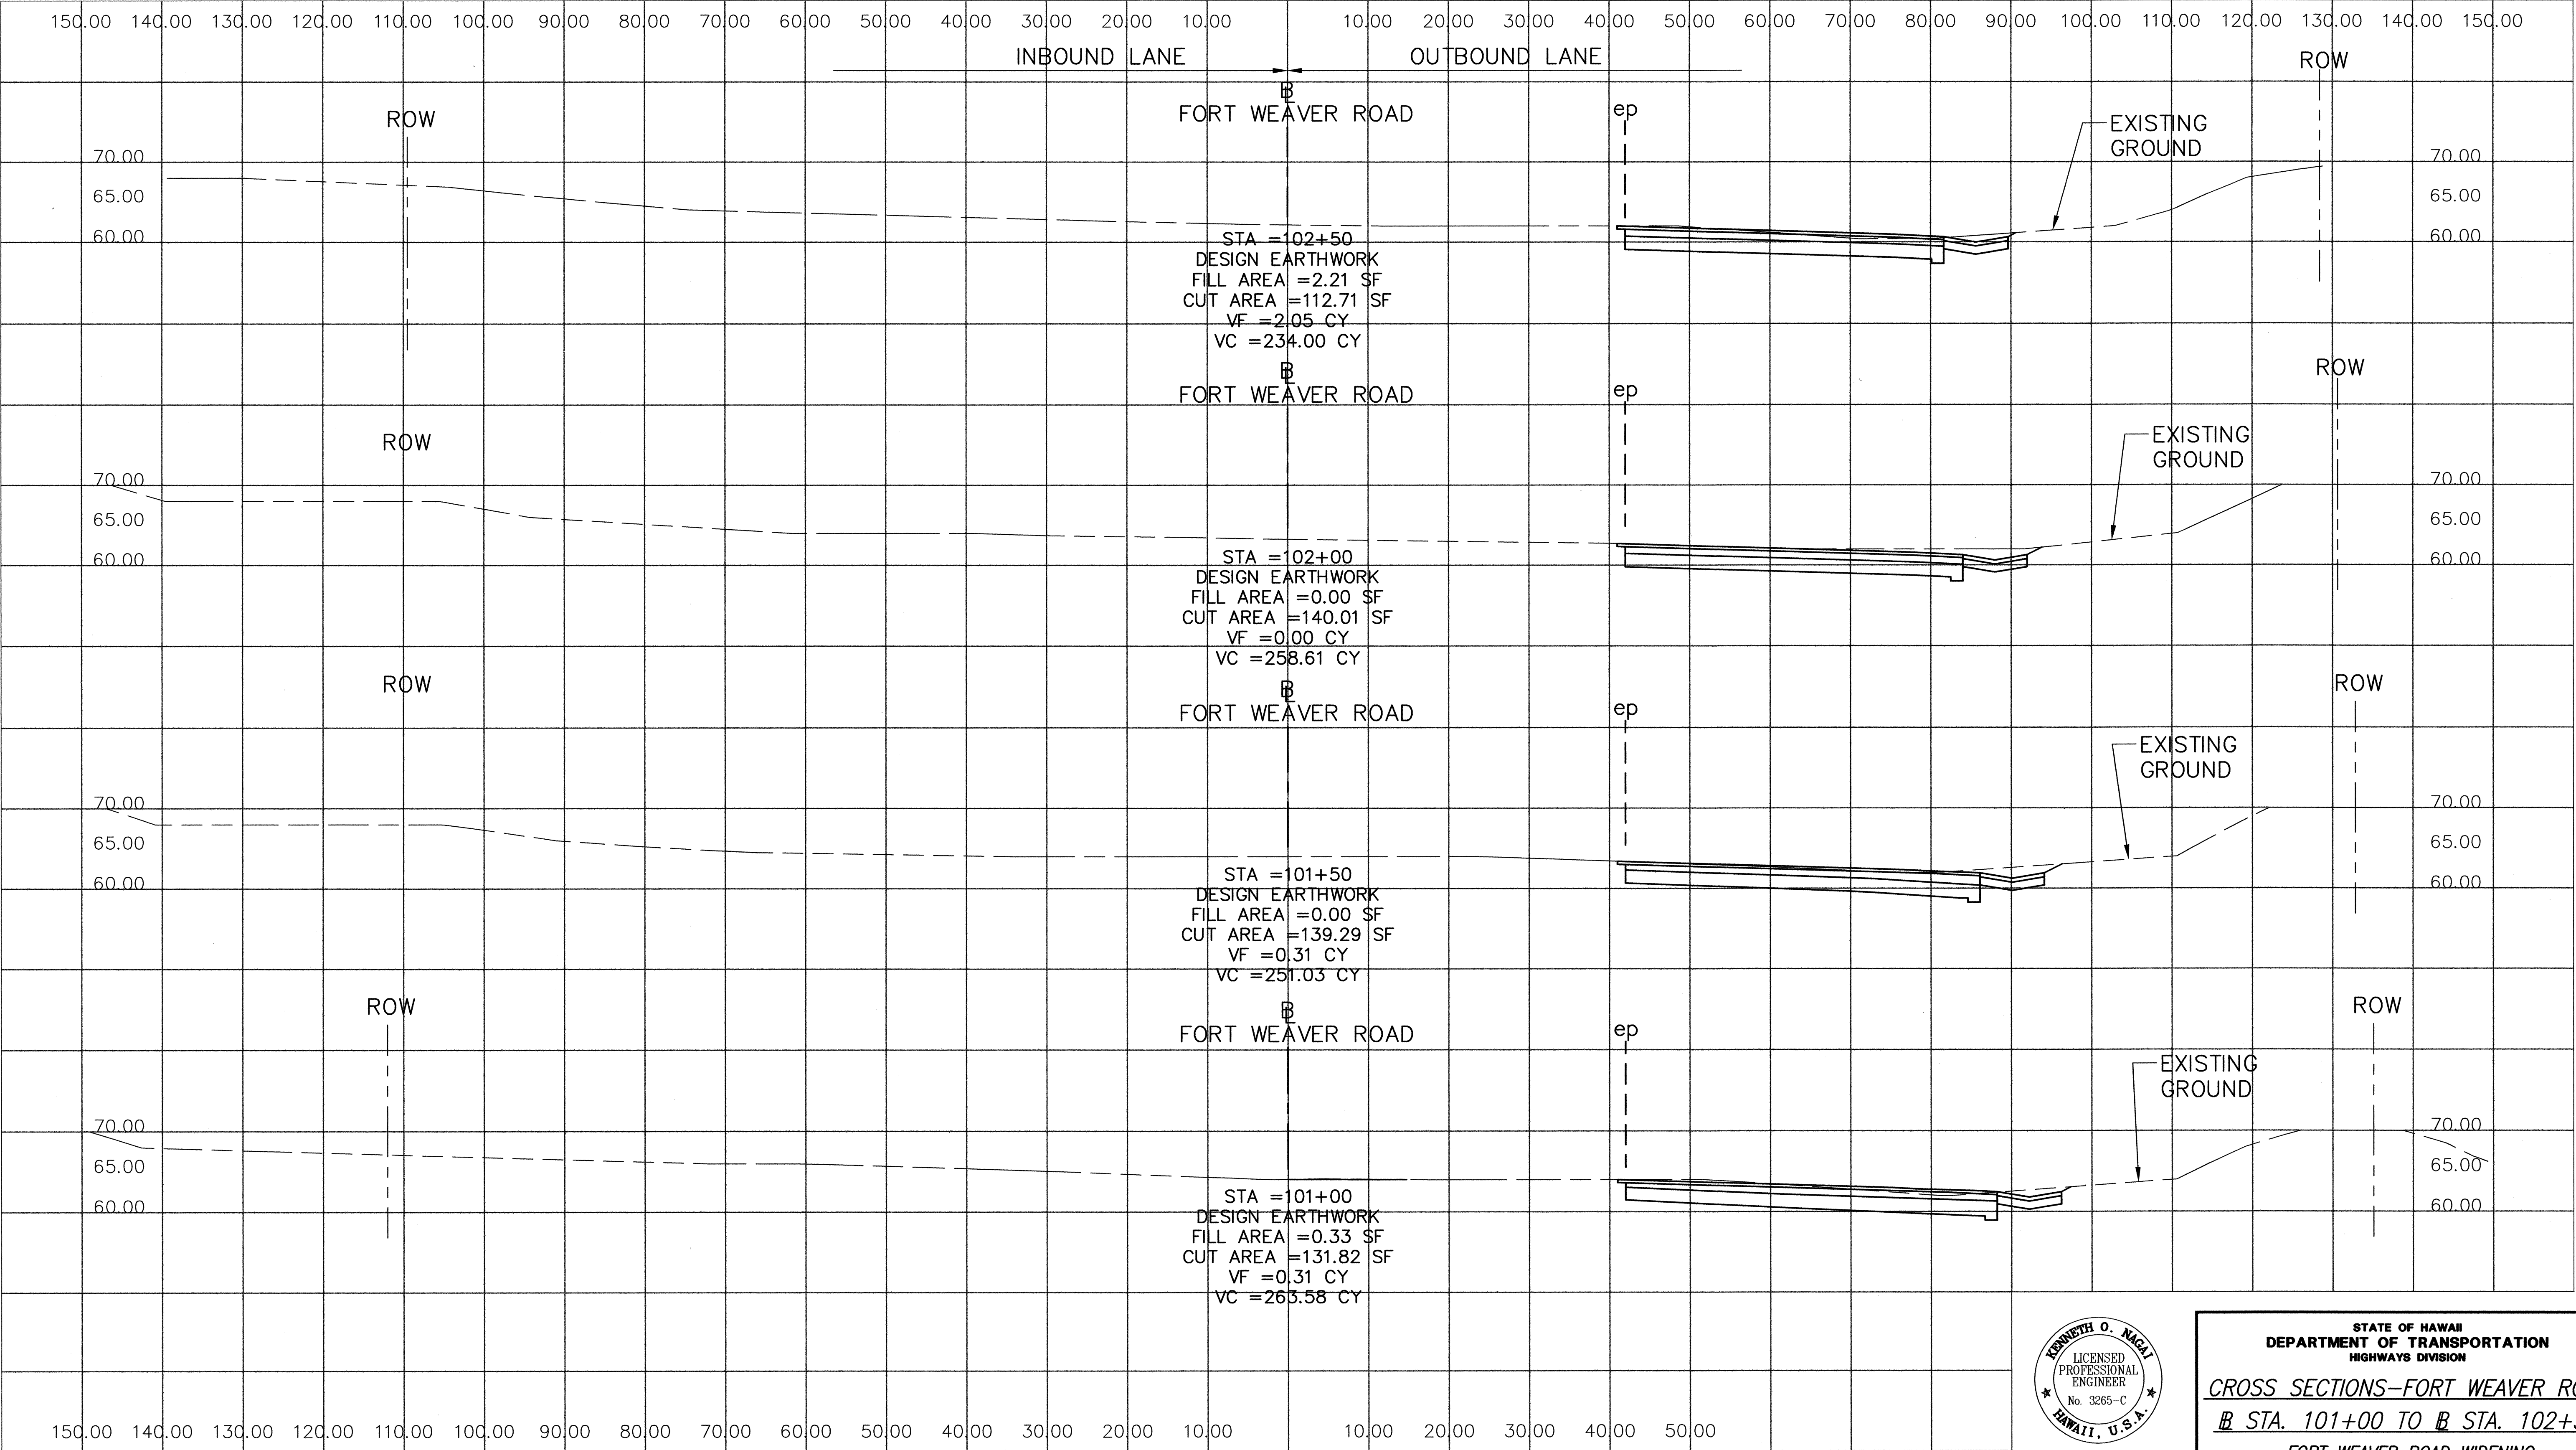

ORIGINAL PLAN	SURVEY PLOTTED BY	DATE
NOTE BOOK	DRAWN BY	" "
	TRACED BY	" "
	DESIGNED BY	" "
	CHECKED BY	" "
No.		




Signature: *Kenneth O. Naga*
APRIL 30, 2004
EXPIRATION DATE OF LICENSE
THIS WORK WAS PREPARED BY ME OR UNDER MY SUPERVISION


STATE OF HAWAII
DEPARTMENT OF TRANSPORTATION
HIGHWAYS DIVISION

CROSS SECTIONS-FORT WEAVER ROAD
STA. 101+00 TO STA. 102+50
FORT WEAVER ROAD WIDENING
NEAR LAULAUNUI STREET
FEDERAL AID PROJECT NO. CMAQ-076-1(8)
SCALE: 1" = 10' **DATE: October 2003**
SHEET No. 5 OF 24 SHEETS

FED. ROAD DIST. NO.	STATE	FED. AID PROJ. NO.	FISCAL YEAR	SHEET NO.	TOTAL SHEETS
HAWAII	HAW.	CMAQ-076-1(8)	2004	109	127

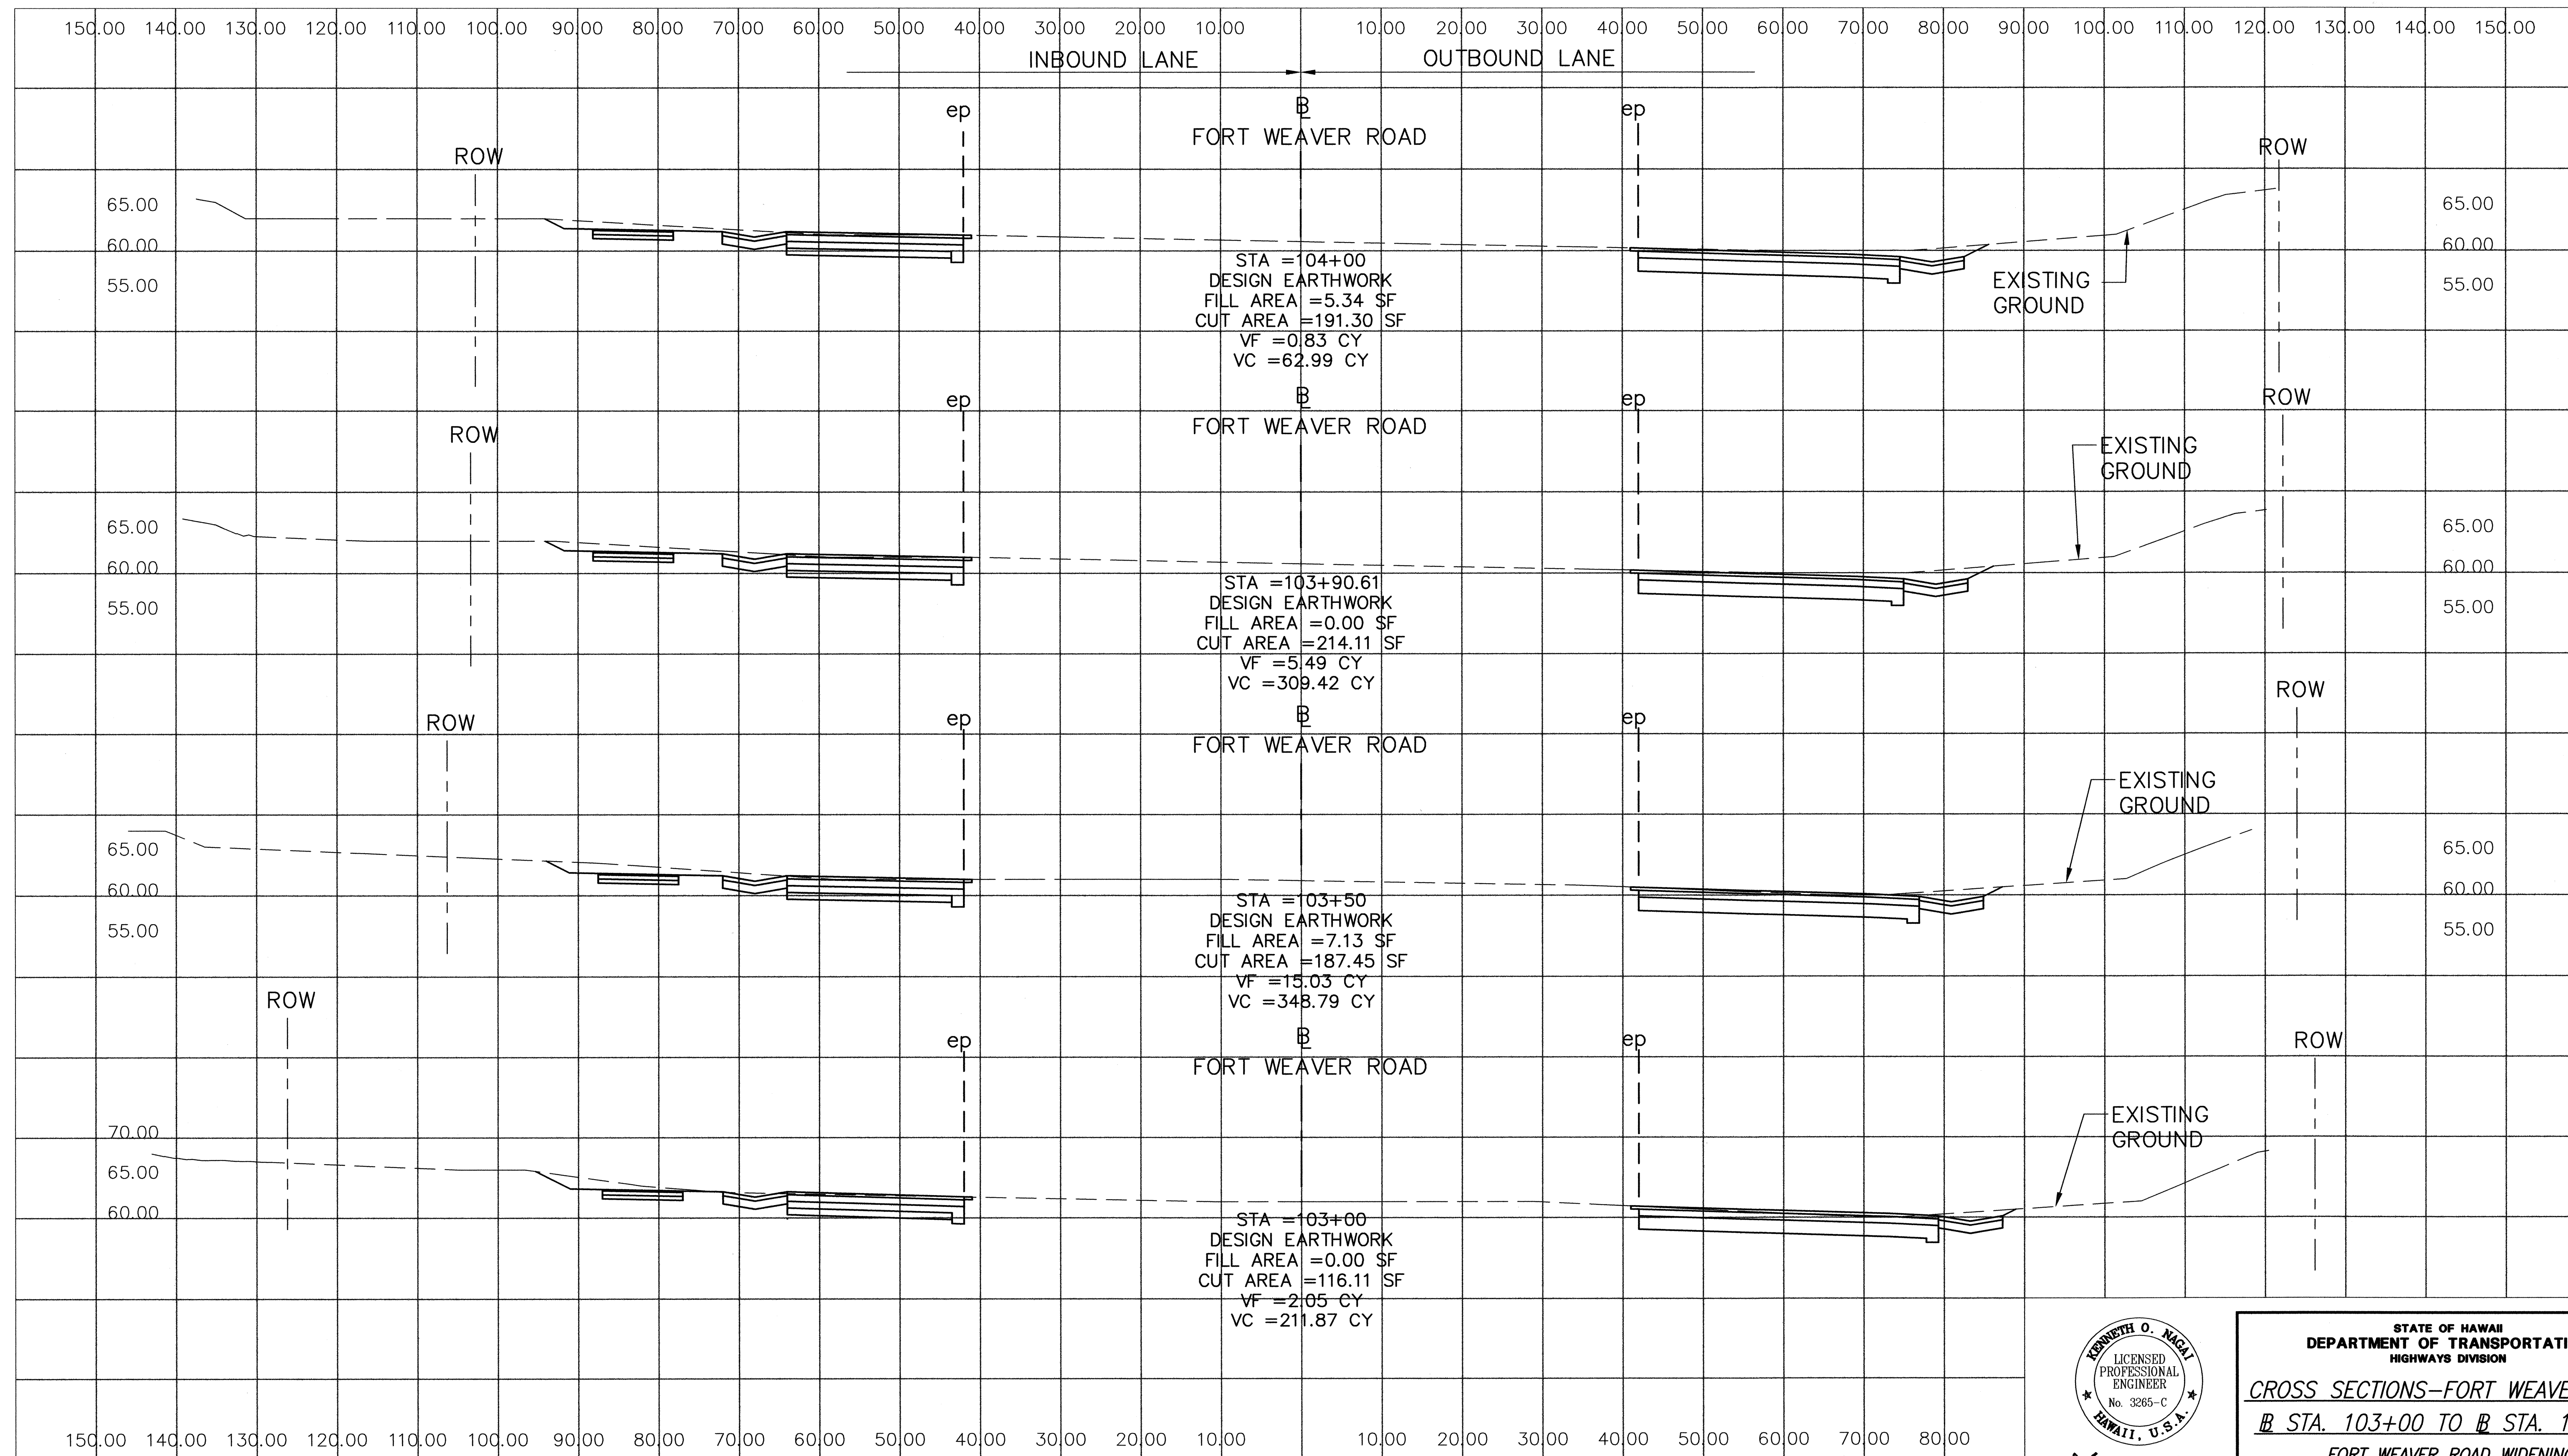


SURVEY PLOTTED BY	DATE
DRAWN BY	" "
DESIGNED BY	" "
CHECKED BY	" "
NOTE BOOK	No.

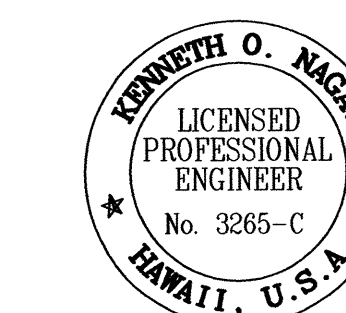

APRIL 30, 2004
EXPIRATION DATE OF LICENSE
THIS WORK WAS PREPARED BY ME OR UNDER MY SUPERVISION

STATE OF HAWAII
DEPARTMENT OF TRANSPORTATION
HIGHWAYS DIVISION
CROSS SECTIONS-FORT WEAVER ROAD
B STA. 103+00 TO B STA. 104+00
FORT WEAVER ROAD WIDENING
NEAR LAULAUNUI STREET
FEDERAL AID PROJECT NO. CMAQ-076-1(8)
SCALE: 1" = 10' **DATE: October 2003**
SHEET No. 6 OF 24 SHEETS

FED. ROAD DIST. NO.	STATE	FED. AID PROJ. NO.	FISCAL YEAR	SHEET NO.	TOTAL SHEETS
HAWAII	HAW.	CMAQ-076-1(8)	2004	110	127

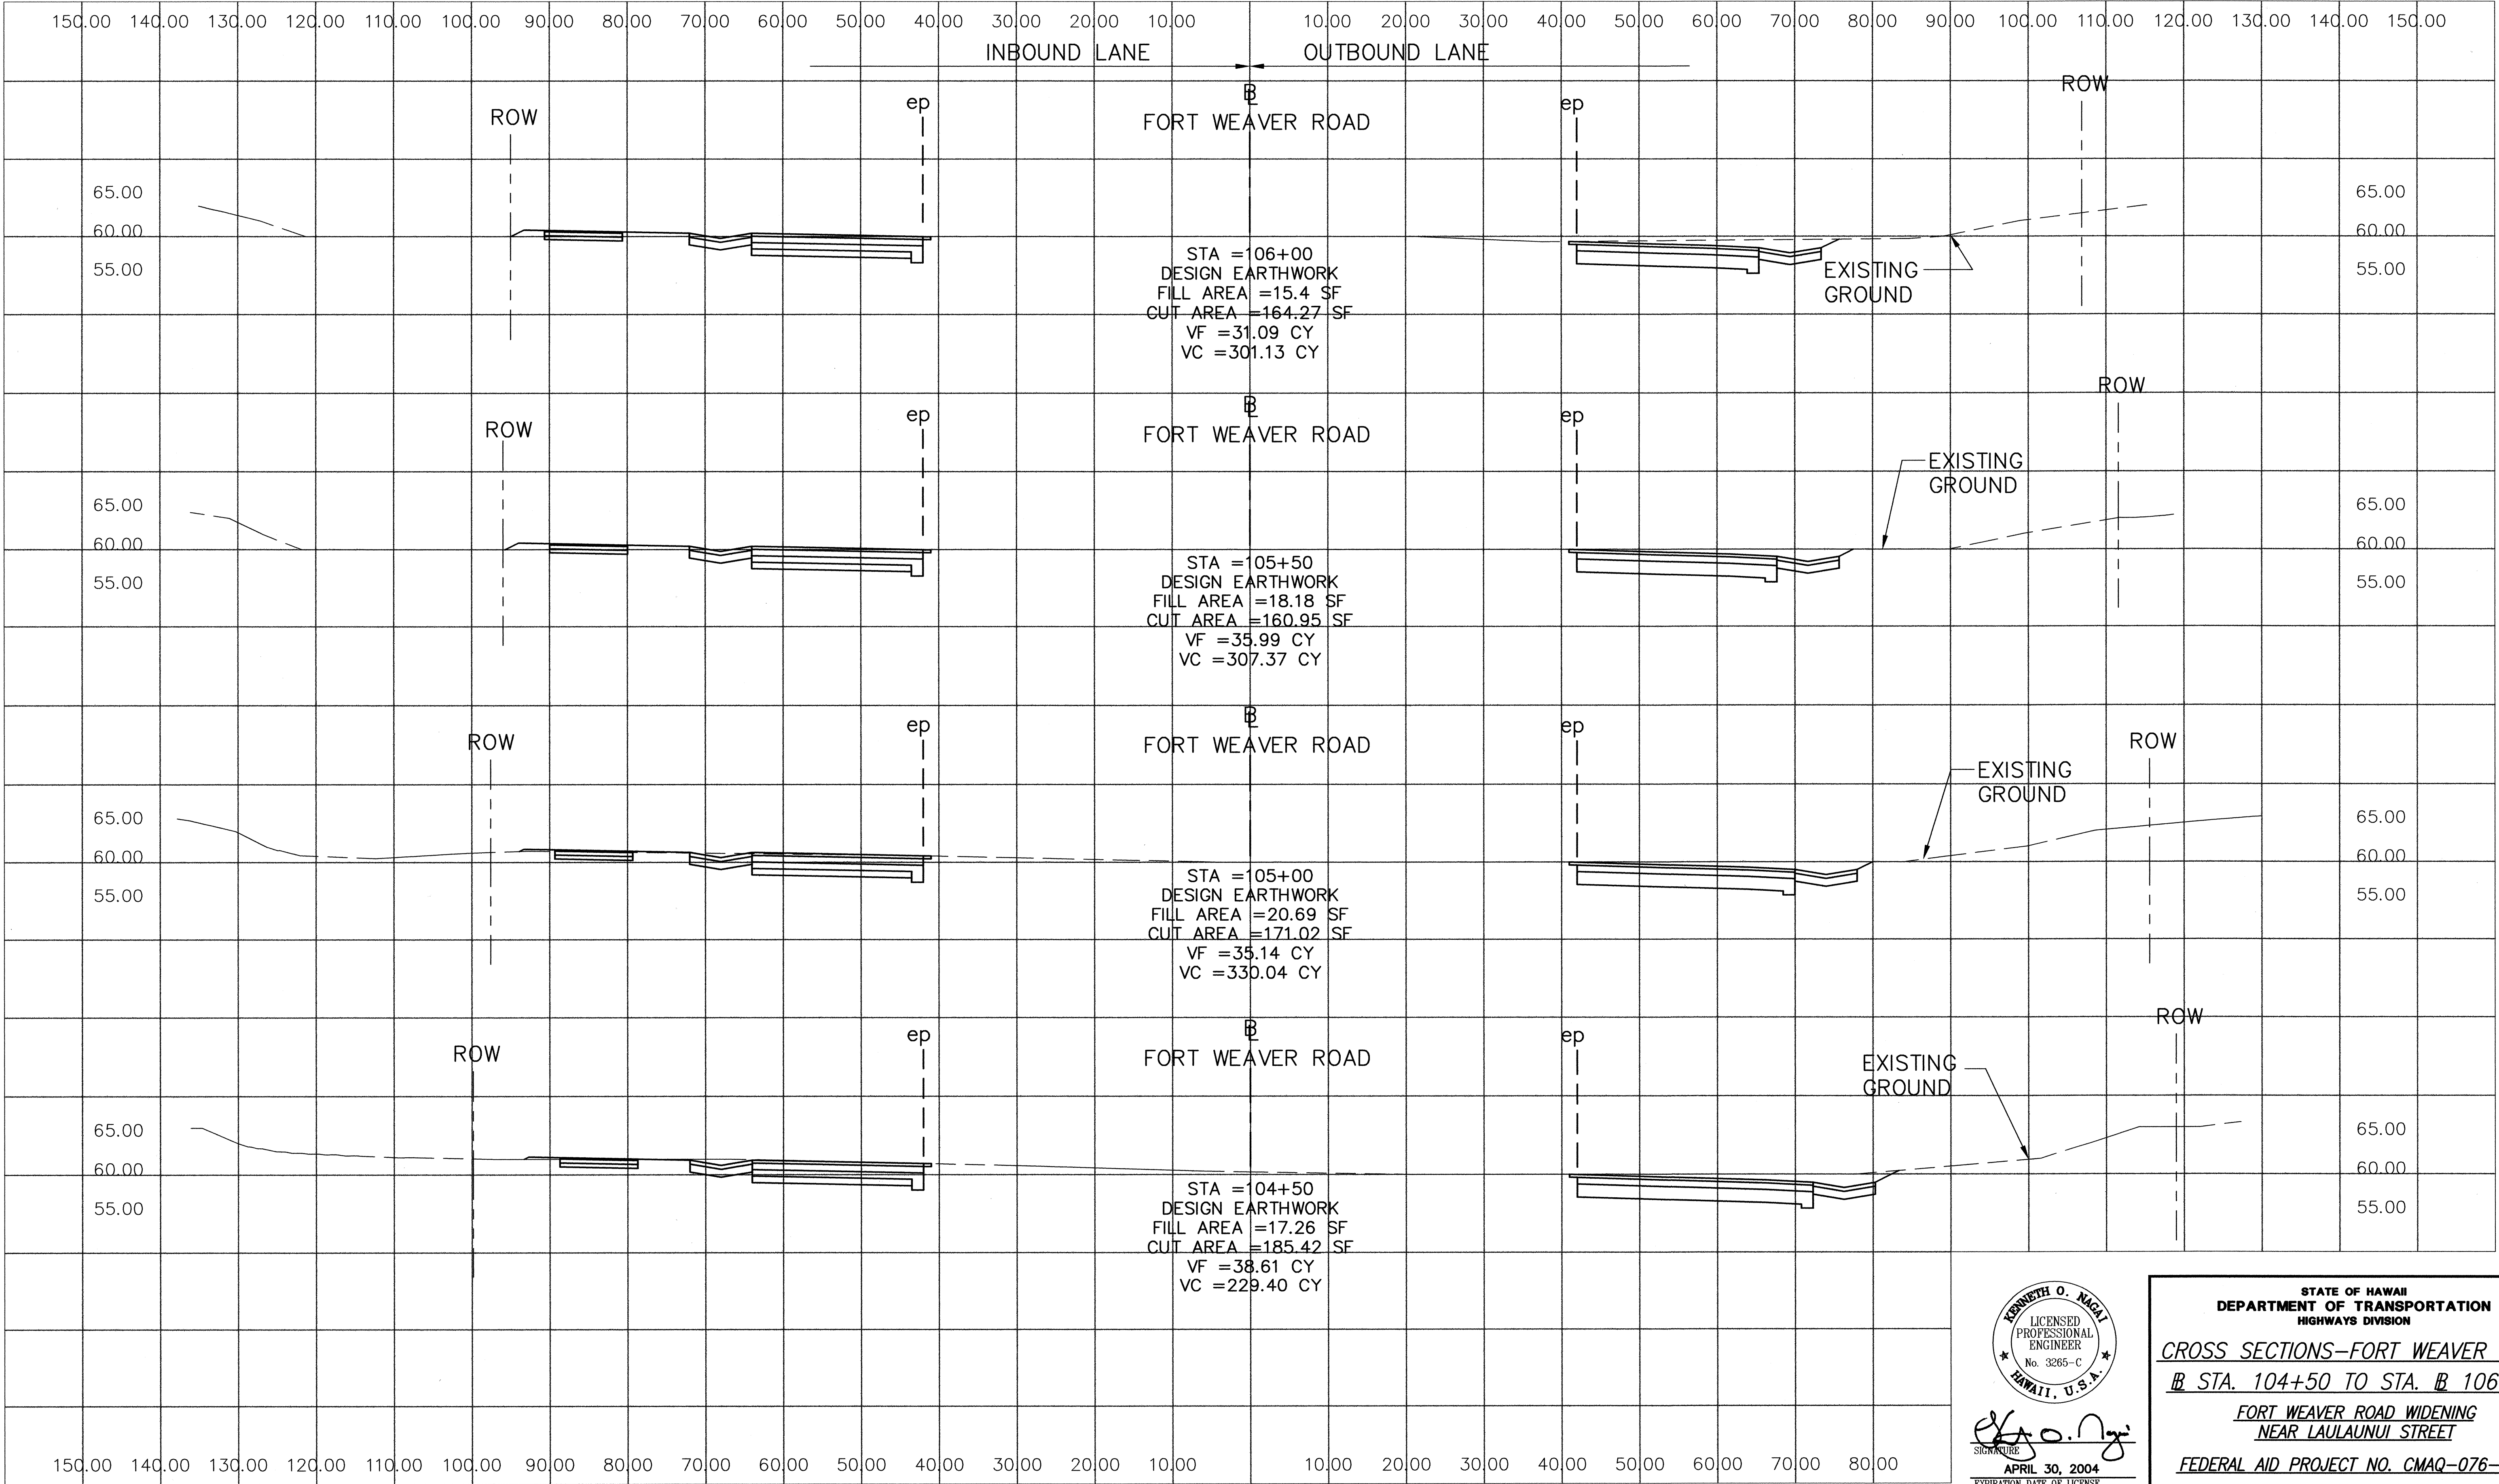


ORIGINAL PLAN	SURVEY PLOTTED BY	DATE
NOTE BOOK	DRAWN BY	
	DESIGNED BY	
	CHECKED BY	


KENNETH O. NAGAI
LICENSED PROFESSIONAL ENGINEER
No. 3265-C
HAWAII, U.S.A.
APRIL 30, 2004
EXPIRATION DATE OF LICENSE
THIS WORK WAS PREPARED BY ME OR UNDER MY SUPERVISION

STATE OF HAWAII
DEPARTMENT OF TRANSPORTATION
HIGHWAYS DIVISION
CROSS SECTIONS-FORT WEAVER ROAD
B STA. 104+50 TO STA. B 106+00
FORT WEAVER ROAD WIDENING
NEAR LAULAUNUI STREET
FEDERAL AID PROJECT NO. CMAQ-076-1(8)
SCALE: 1" = 10' DATE: October 2003
SHEET No. 7 OF 24 SHEETS

FED. ROAD DIST. NO.	STATE	FED. AID PROJ. NO.	FISCAL YEAR	SHEET NO.	TOTAL SHEETS
HAWAII	HAW.	CMAQ-076-1(8)	2004	111	127

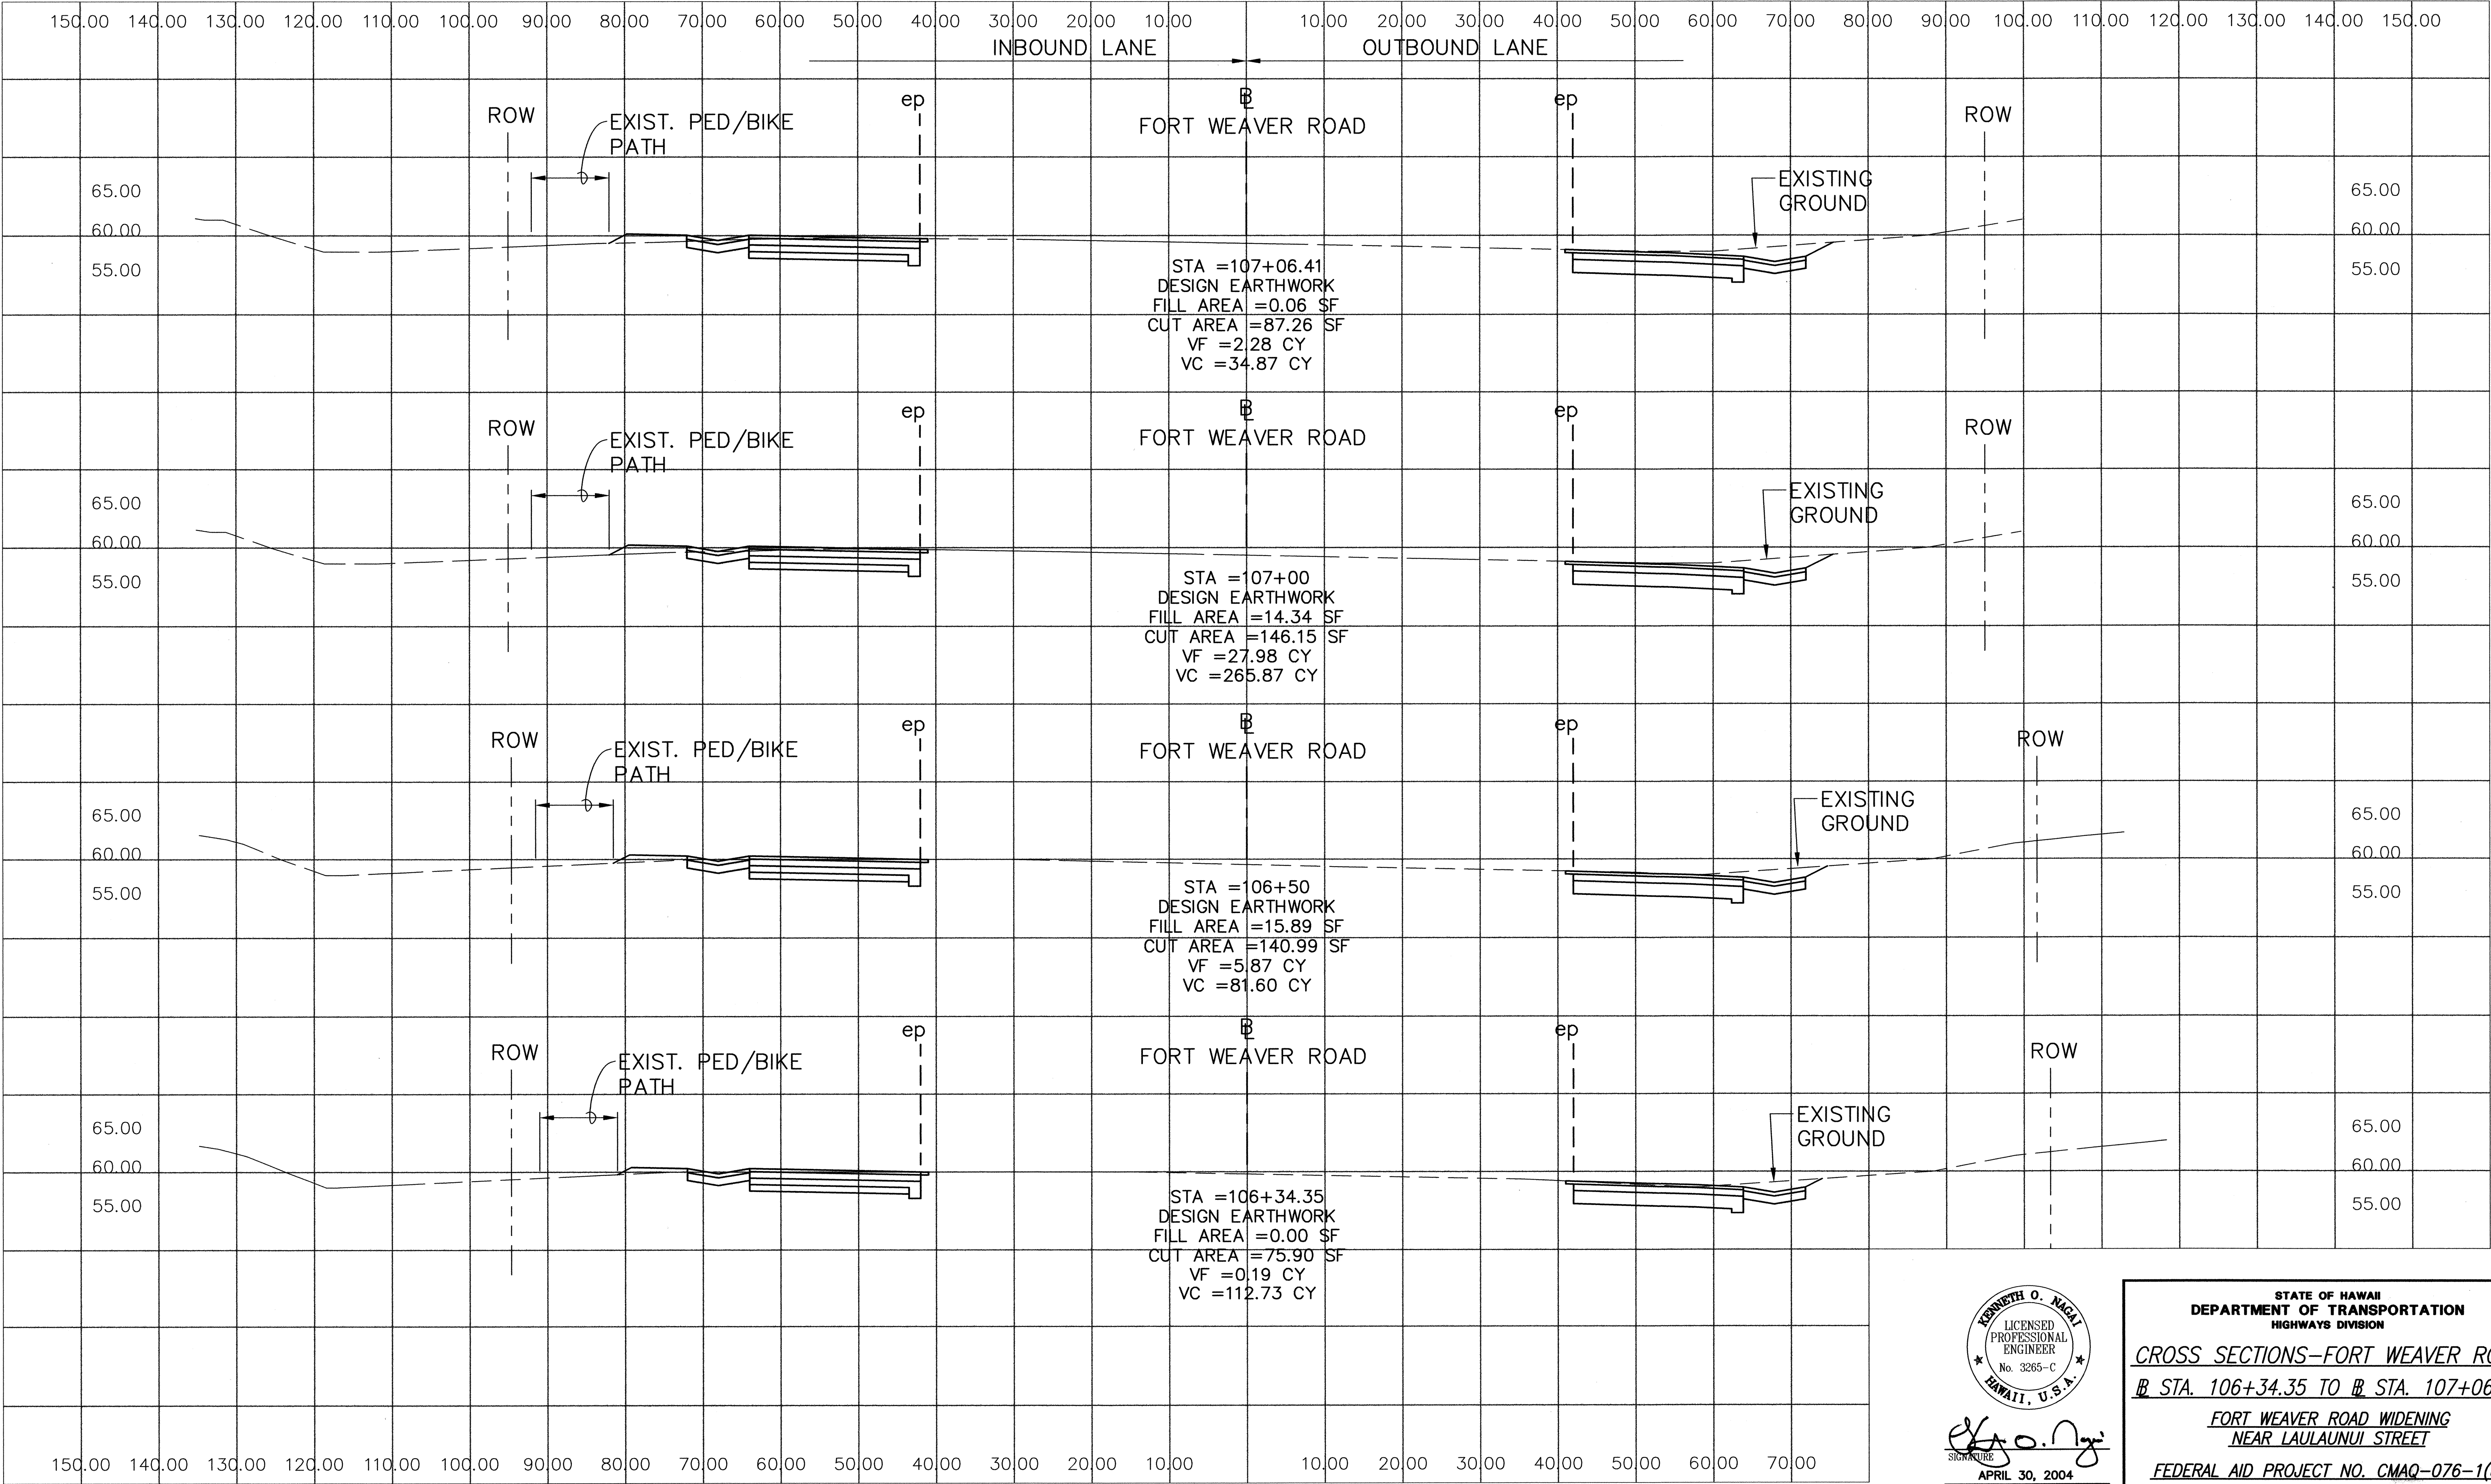

ORIGINAL PLAN	SURVEY PLOTTED BY	DATE
NO.	DRAWN BY	" "
	DESIGNED BY	" "
	CHECKED BY	" "

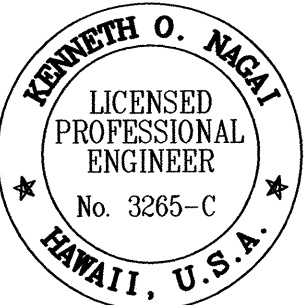

APRIL 30, 2004

THIS WORK WAS PREPARED BY ME OR UNDER MY SUPERVISION

STATE OF HAWAII
DEPARTMENT OF TRANSPORTATION
HIGHWAYS DIVISION

CROSS SECTIONS-FORT WEAVER ROAD
B STA. 106+34.35 TO B STA. 107+06.41


FORT WEAVER ROAD WIDENING
NEAR LAULAUNUI STREET

FEDERAL AID PROJECT NO. CMAQ-076-1(8)

SCALE: 1" = 10' DATE: October 2003

SHEET No. 8 OF 24 SHEETS

FED. ROAD DIST. NO.	STATE	FED. AID PROJ. NO.	FISCAL YEAR	SHEET NO.	TOTAL SHEETS
HAWAII	HAW.	CMAQ-076-1(8)	2004	112	127

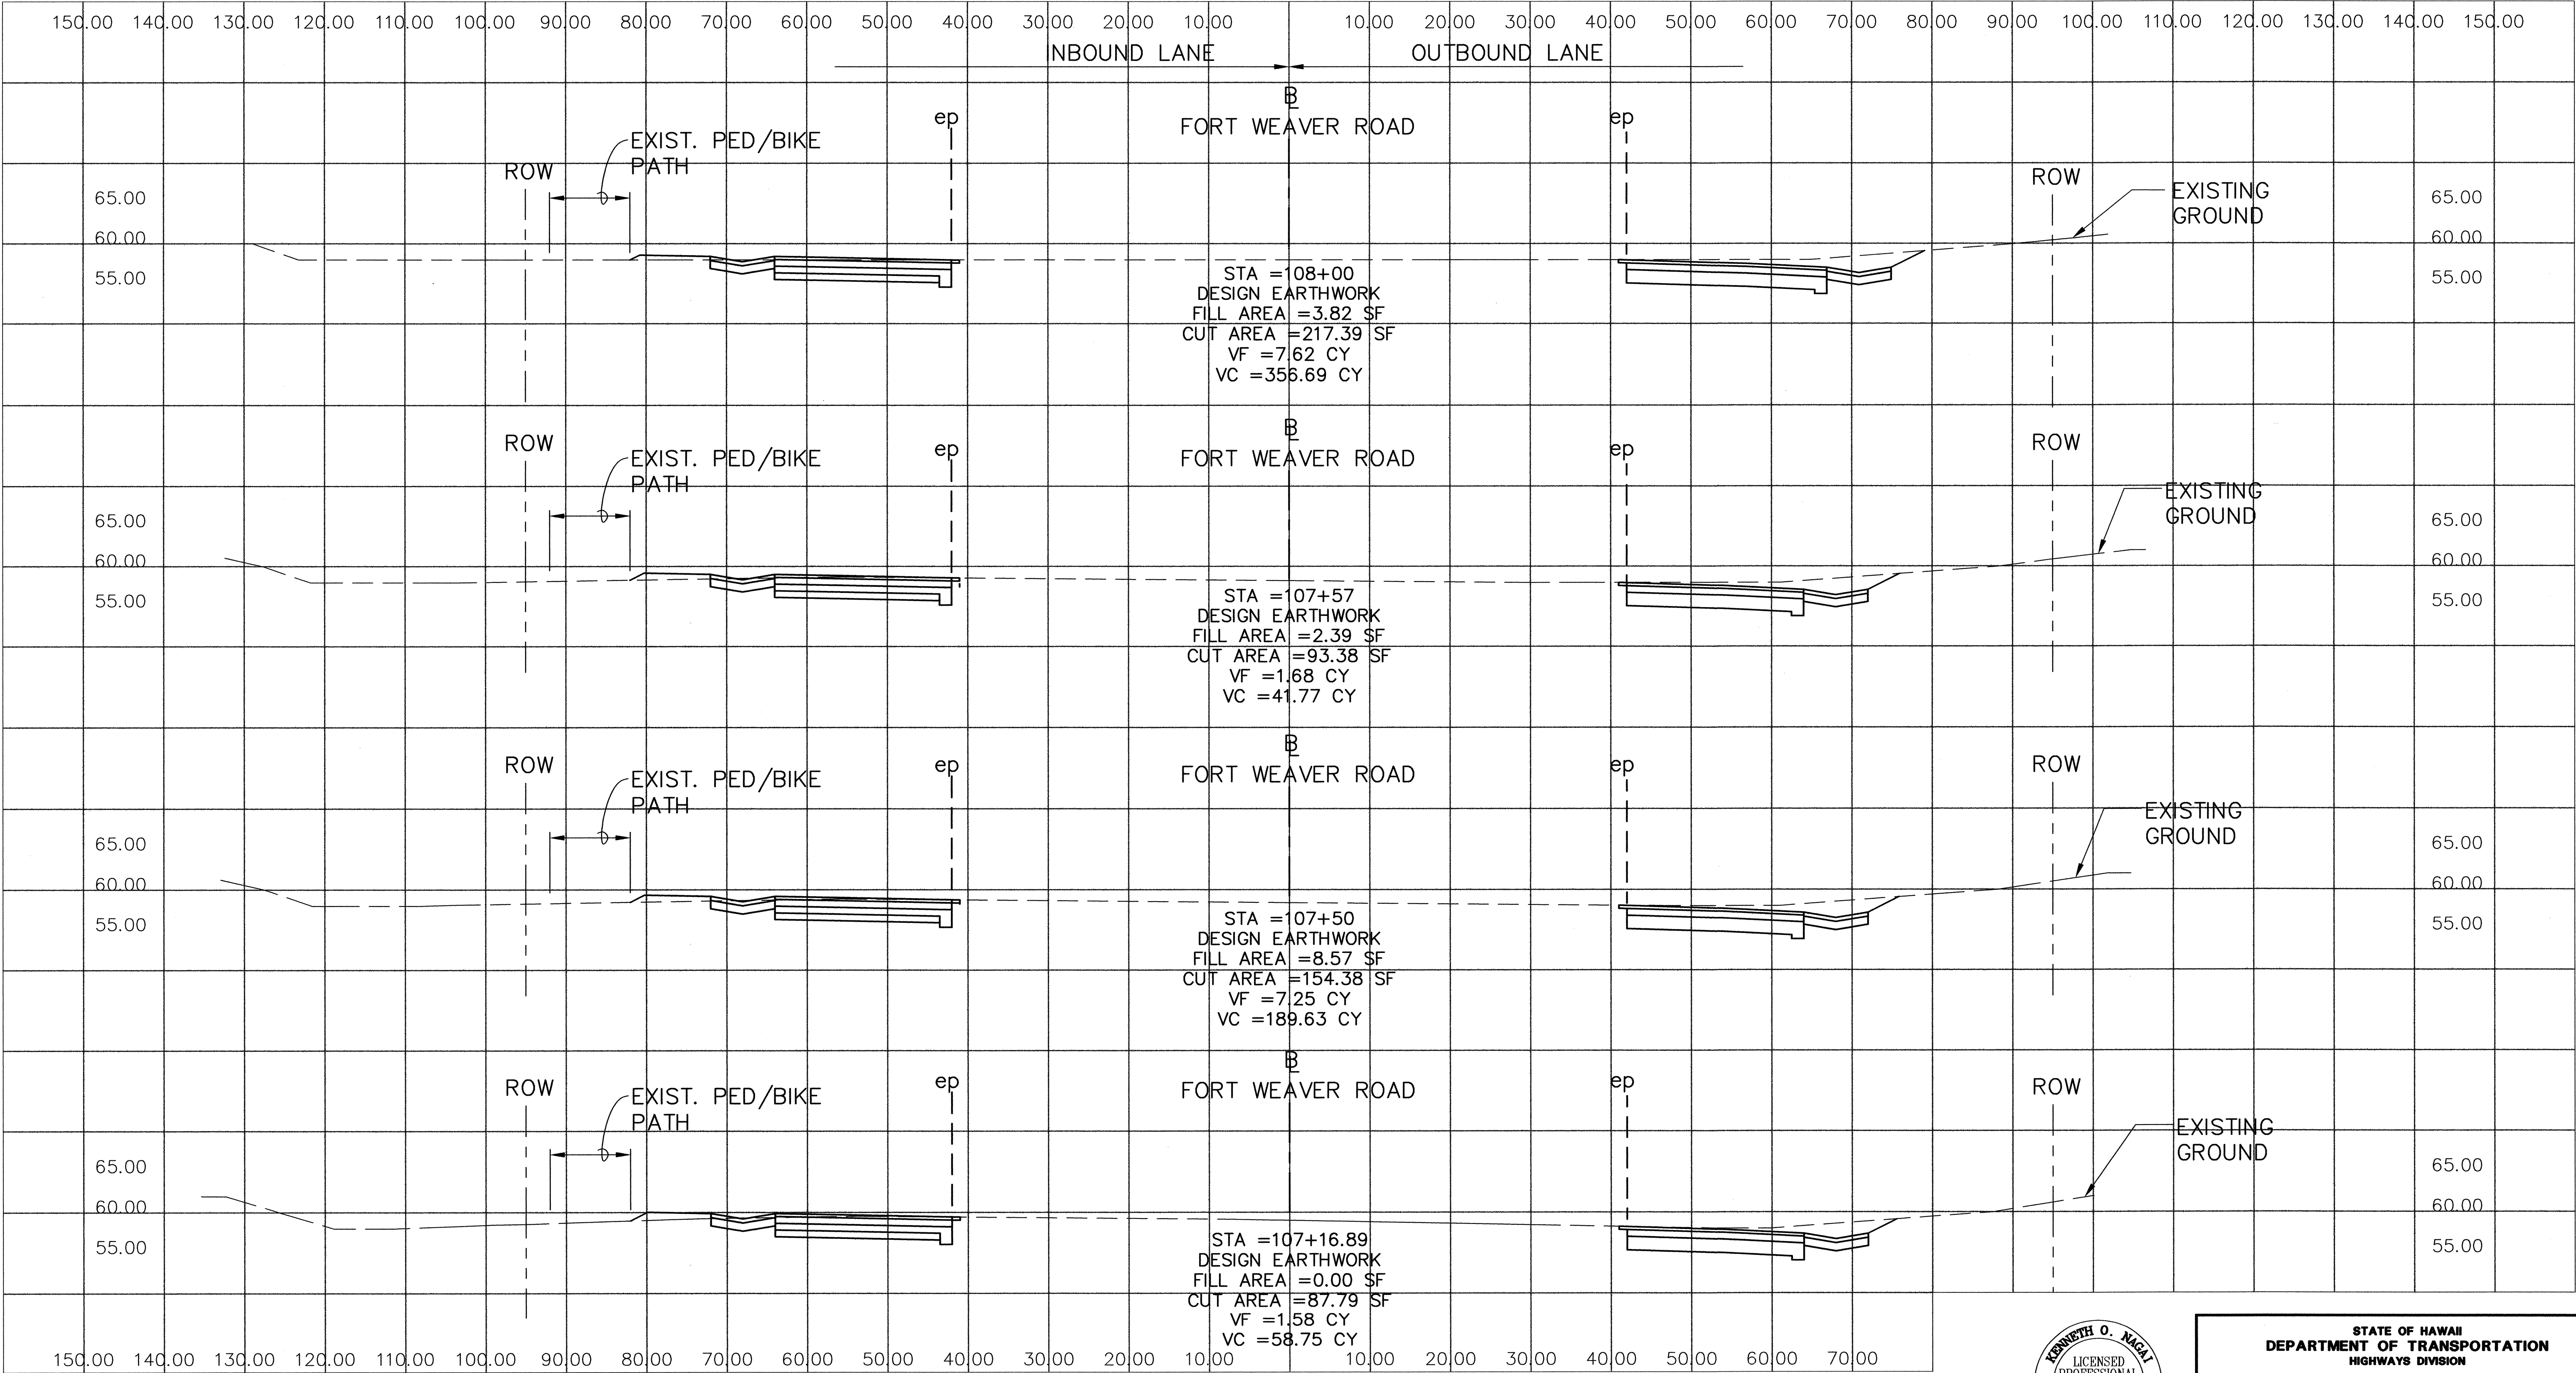

ORIGINAL PLAN	SURVEY PLOTTED BY	DATE
NOTE BOOK	DRAWN BY	
	DESIGNED BY	
	CHECKED BY	
No.		

APRIL 30, 2004

EXPIRATION DATE OF LICENSE

THIS WORK WAS PREPARED BY ME OR UNDER MY SUPERVISION

STATE OF HAWAII

DEPARTMENT OF TRANSPORTATION

HIGHWAYS DIVISION

CROSS SECTIONS-FORT WEAVER ROAD

B STA. 107+16.89 TO B STA. 108+00

FORT WEAVER ROAD WIDENING

NEAR LAULAUNUI STREET

FEDERAL AID PROJECT NO. CMAQ-076-1(8)


SCALE: 1" = 10'

DATE: October 2003

SHEET No. 9

OF 24 SHEETS

FED. ROAD DIST. NO.	STATE	PROJ. NO.	FISCAL YEAR	SHEET NO.	TOTAL SHEETS
HAWAII	HAW.	CMAQ-076-118	2004	113	127

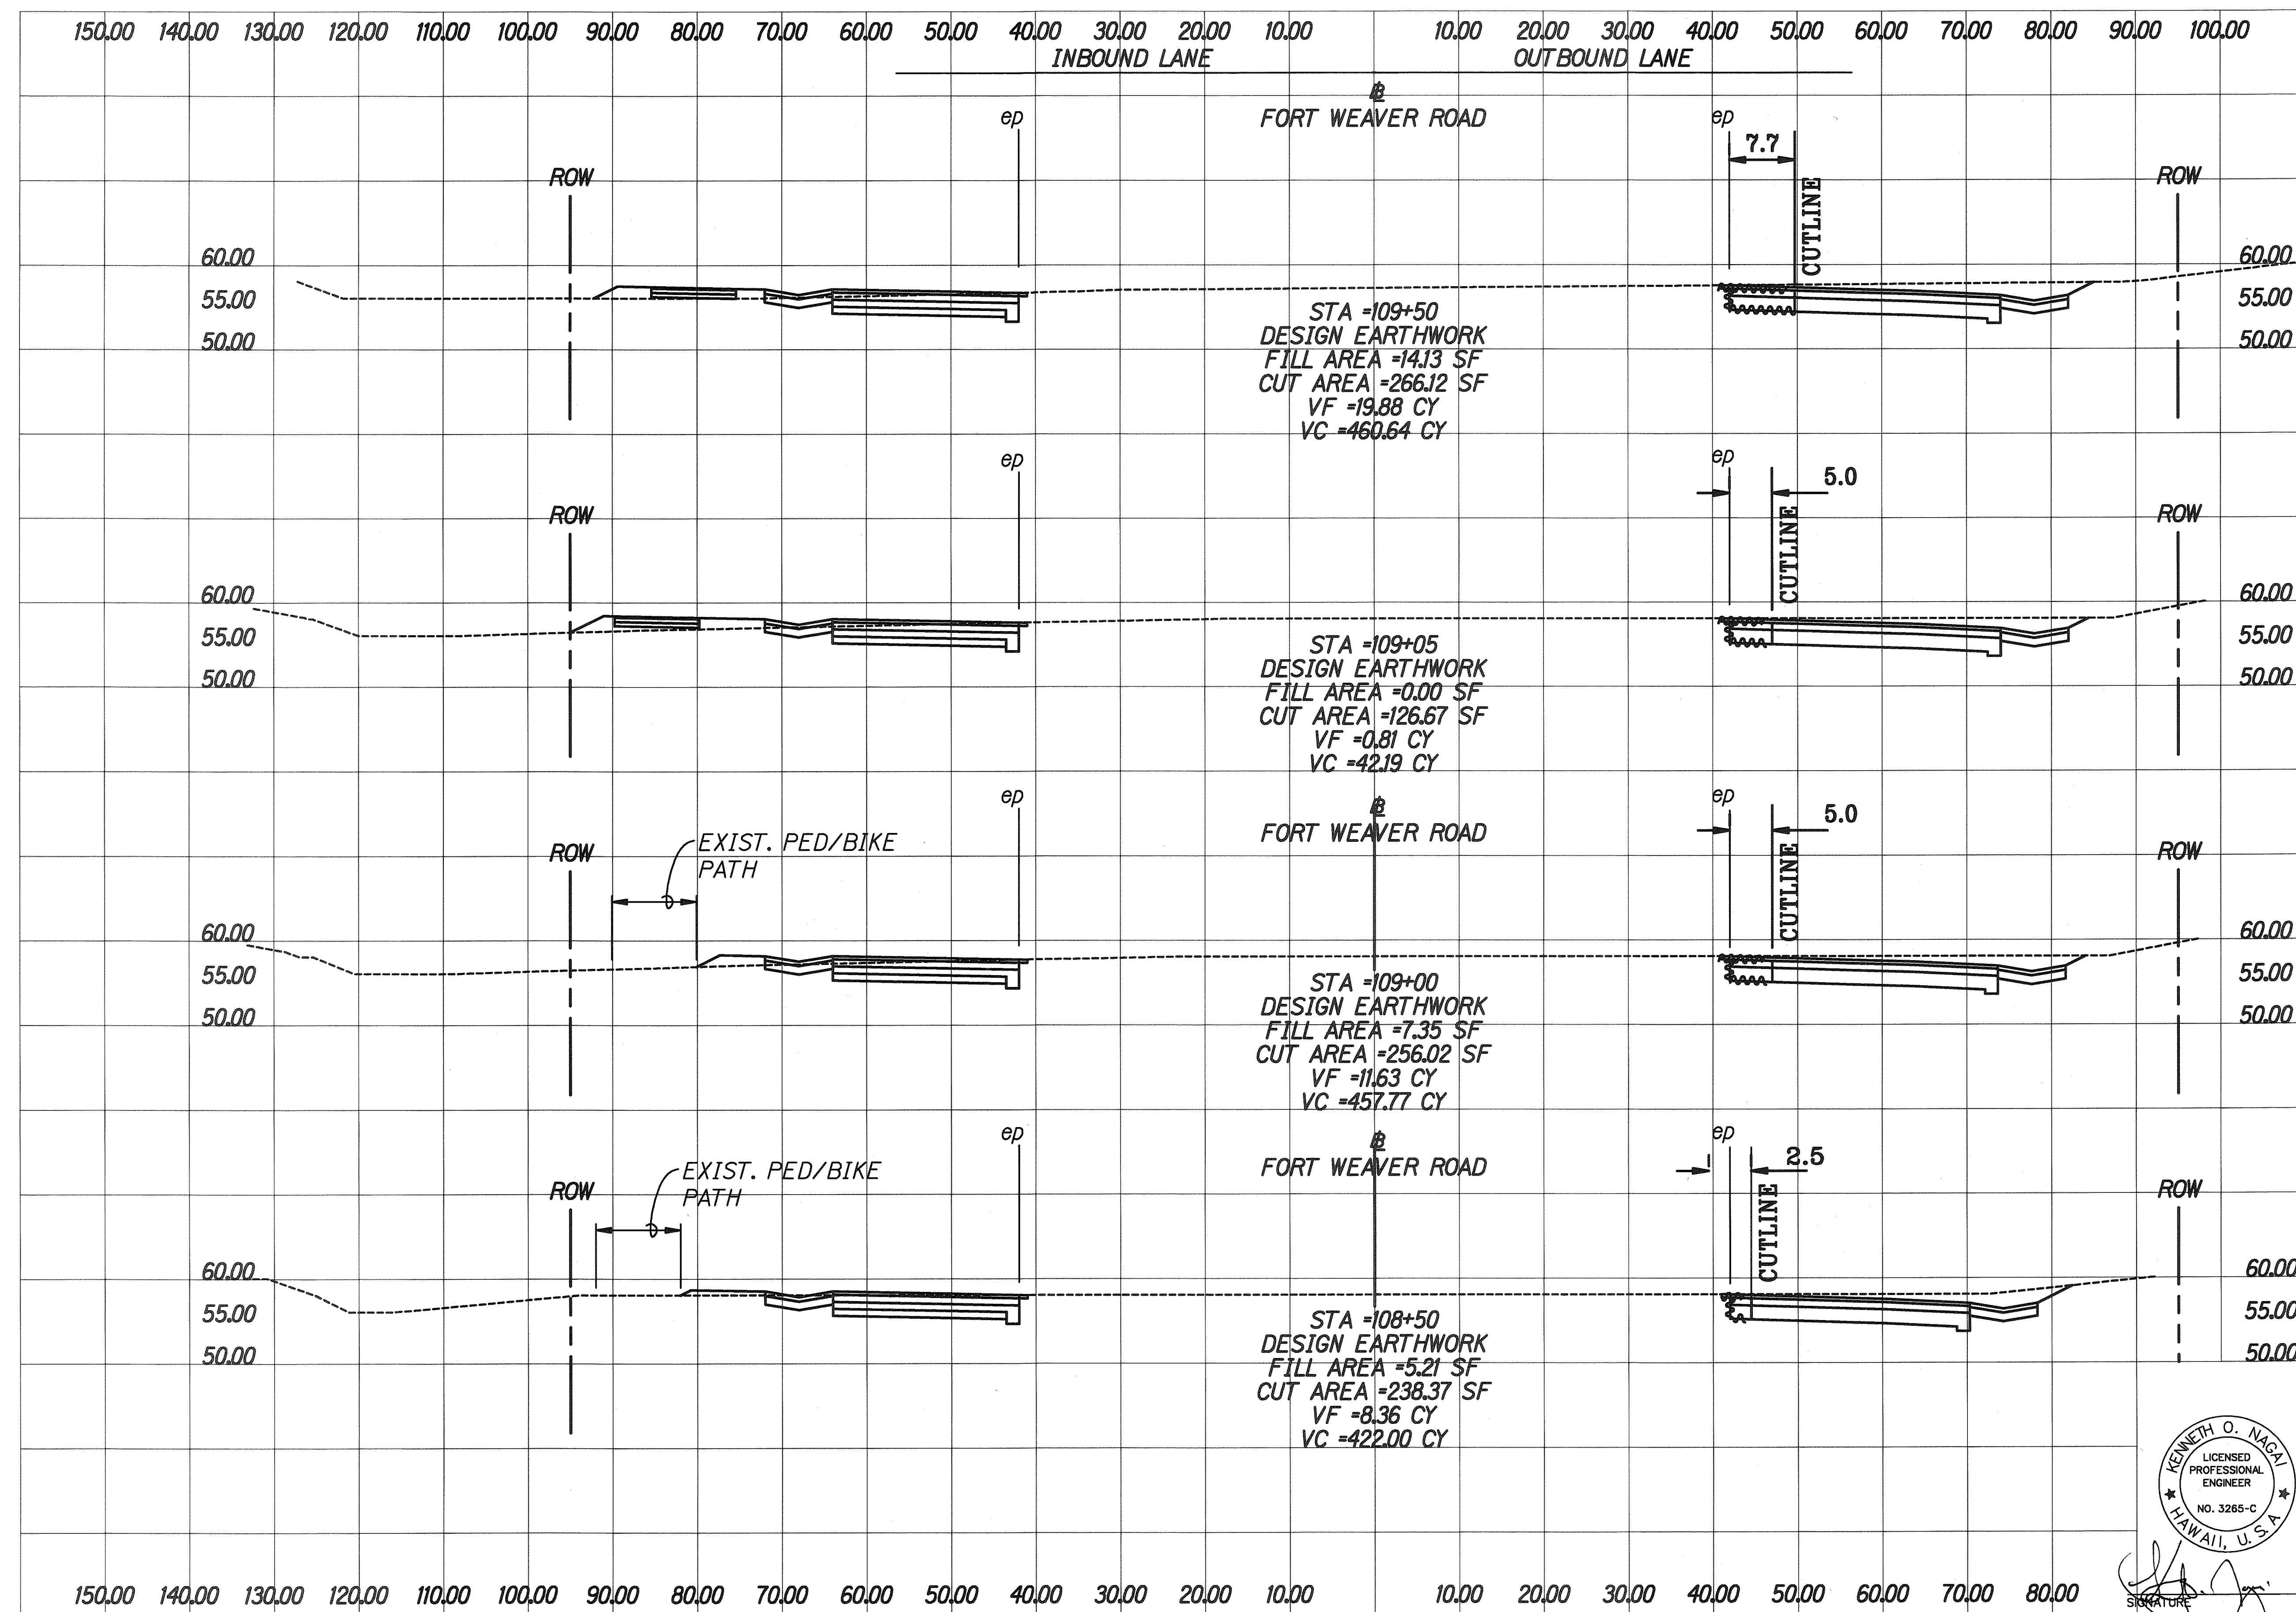

LEGEND FOR AS-BUILT POSTINGS	
	Squiggly line for as-built deletion
	Double line for as-built deletion
Roadway	Text for as-built posting


KEVIN O. NAKA
 LICENSED PROFESSIONAL ENGINEER
 NO. 3265-C
 HAWAII, U.S.A.

STATE OF HAWAII
 DEPARTMENT OF TRANSPORTATION
 HIGHWAYS DIVISION

CROSS SECTIONS - FORT WEAVER ROAD
STA 108+50 TO STA 109+50
FORT WEAVER ROAD WIDENING
NEAR LAULAUNUI STREET
FEDERAL AND PROJECT NO. CMAQ-076-118)
 SCALE: 1"=10' DATE: October 2003
 SHEET No. 10 OF 24 SHEETS

"AS-BUILT"

FED. ROAD DIST. NO.	STATE	PROJ. NO.	FISCAL YEAR	SHEET NO.	TOTAL SHEETS
HAWAII	HAW.	CMAQ-076-118	2004	114	127

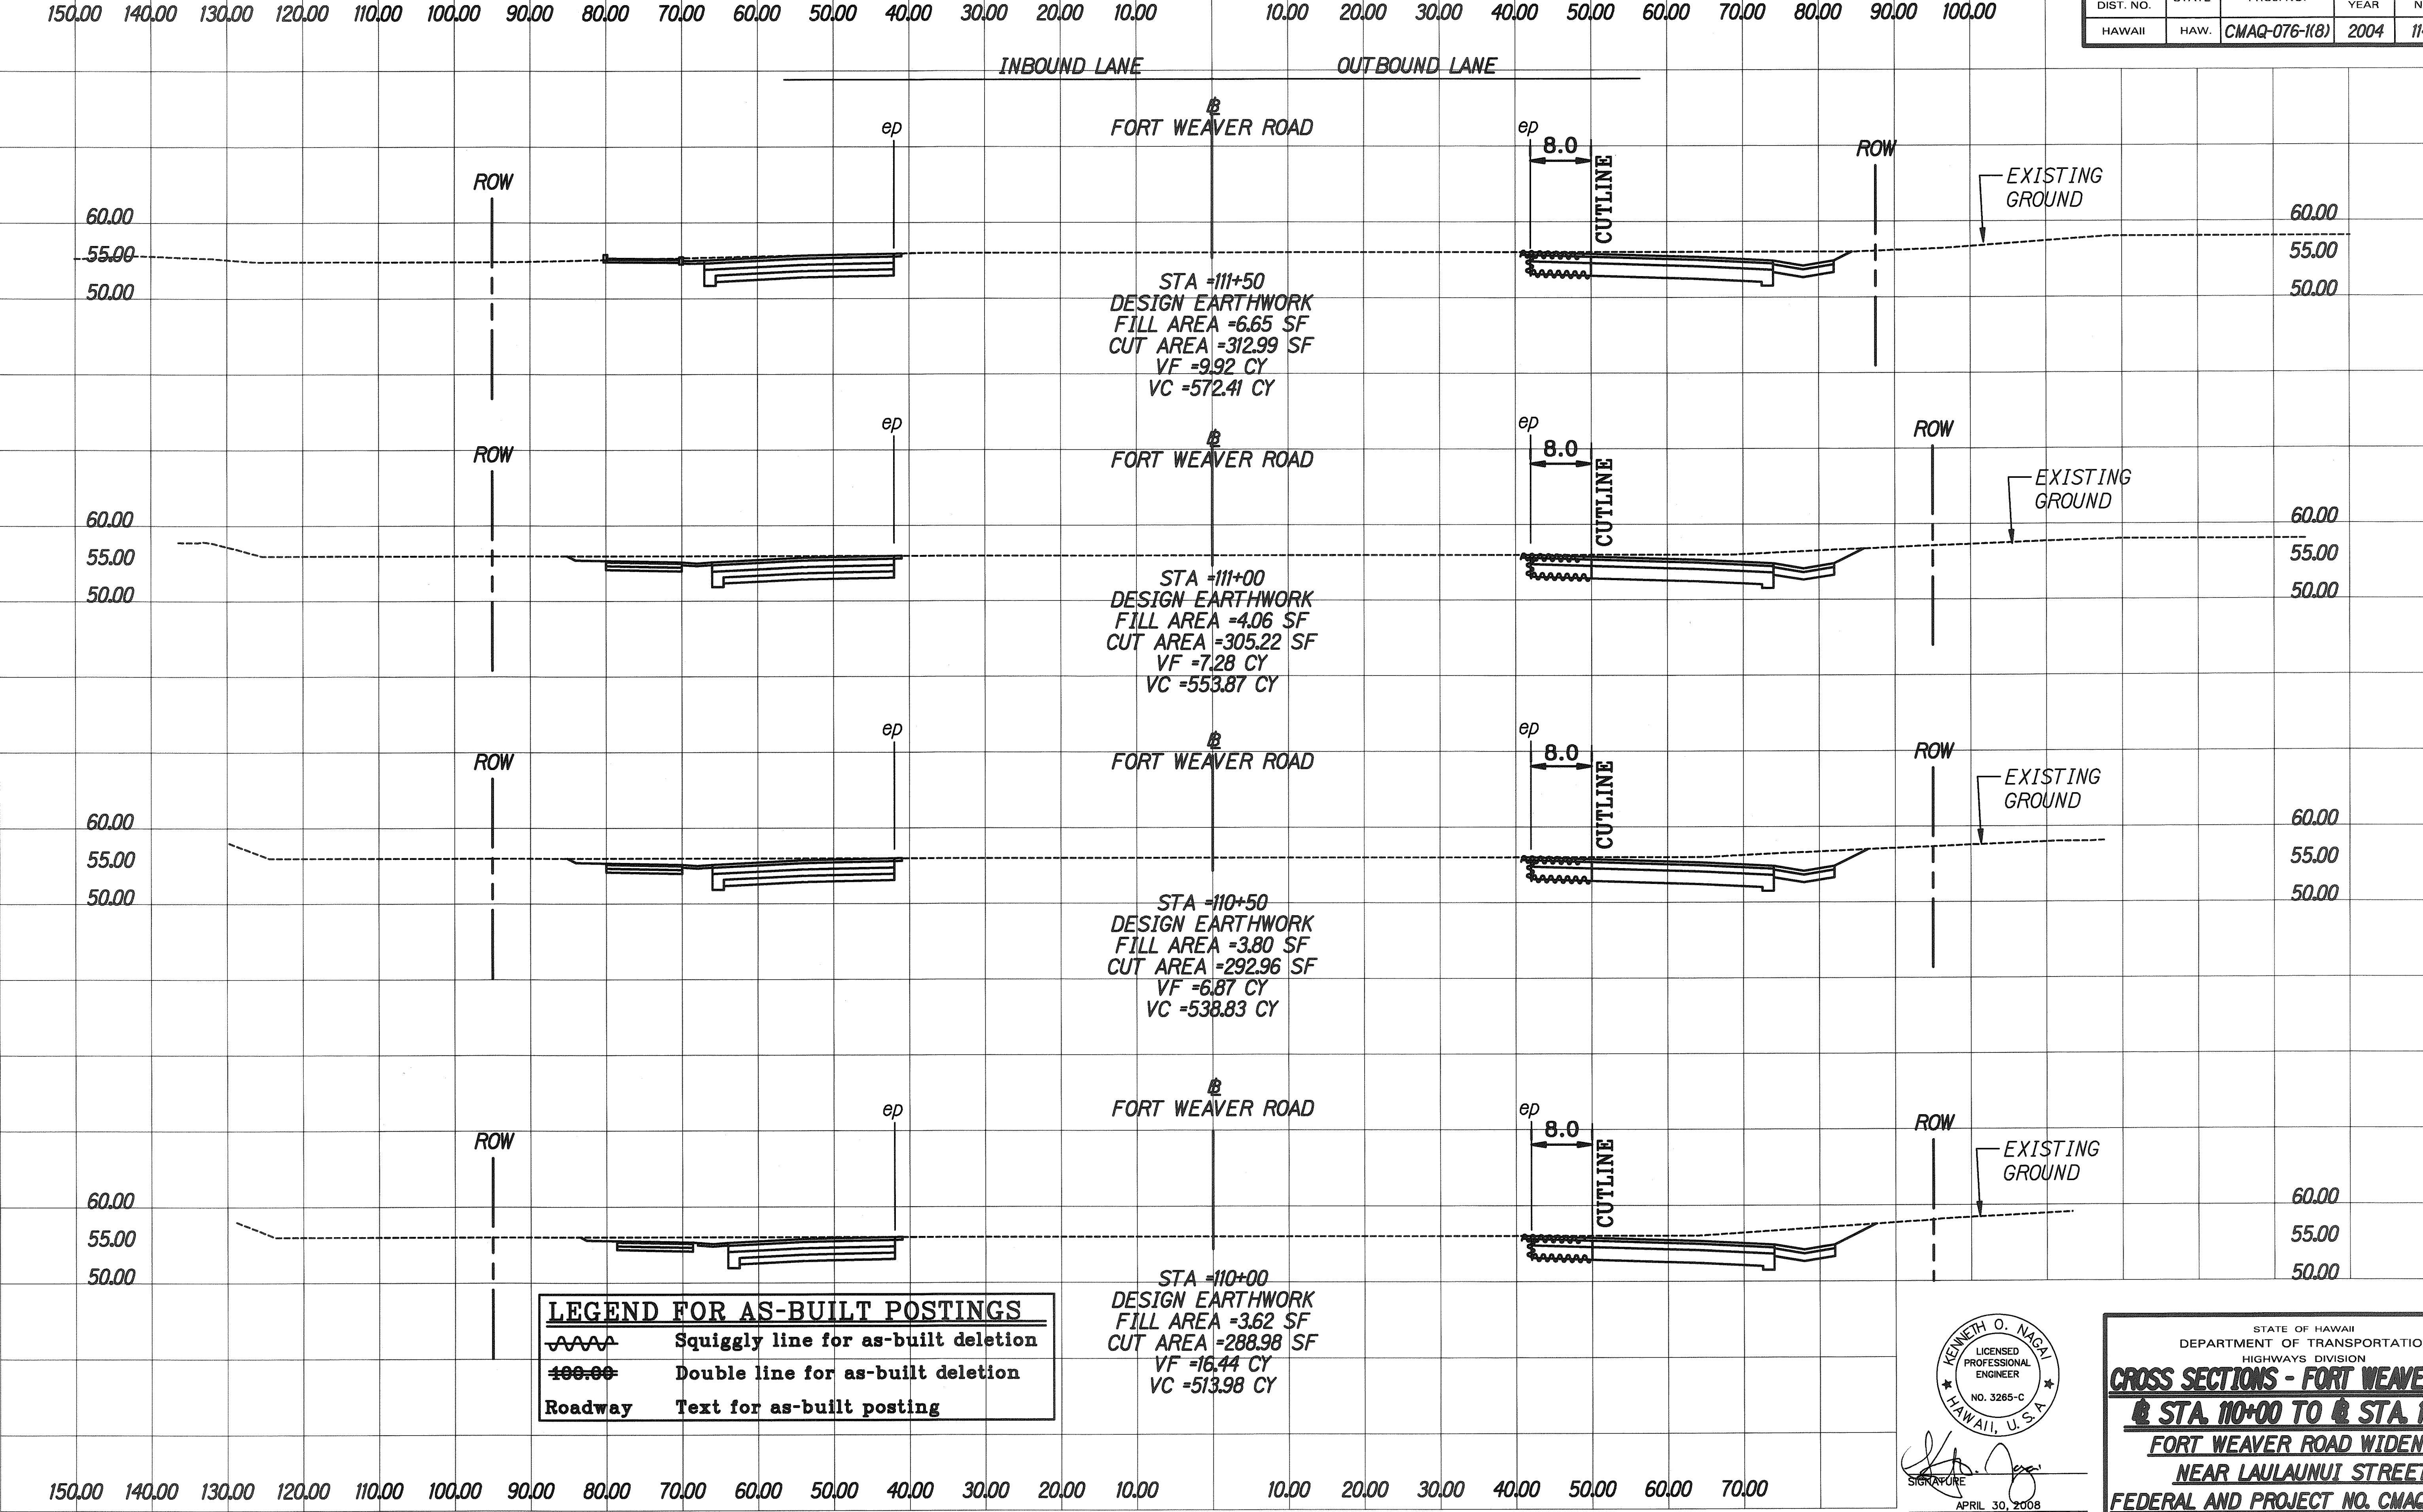

REVIEWED BY	DATE
DESIGNED BY	
TRACED BY	
NOTED BY	
QUANTITIES BY	
CHECKED BY	


KENNETH O. NAGAI
LICENSED PROFESSIONAL ENGINEER
NO. 3285-C
HAWAII, U.S.A.
APRIL 30, 2008
EXPIRATION DATE OF LICENSE
THIS WORK WAS PREPARED BY ME OR UNDER MY SUPERVISION.

STATE OF HAWAII
DEPARTMENT OF TRANSPORTATION
HIGHWAYS DIVISION

CROSS SECTIONS - FORT WEAVER ROAD
STA 110+00 TO STA 111+50
FORT WEAVER ROAD WIDENING
NEAR LAULAUNUI STREET
FEDERAL AND PROJECT NO. CMAQ-076-118
SCALE: 1"=10' **DATE: October 2003**

SHEET No. 11 OF 24 SHEETS

FED. ROAD DIST. NO.	STATE	PROJ. NO.	FISCAL YEAR	SHEET NO.	TOTAL SHEETS
HAWAII	HAW.	CMAQ-076-1(8)	2004	115	127

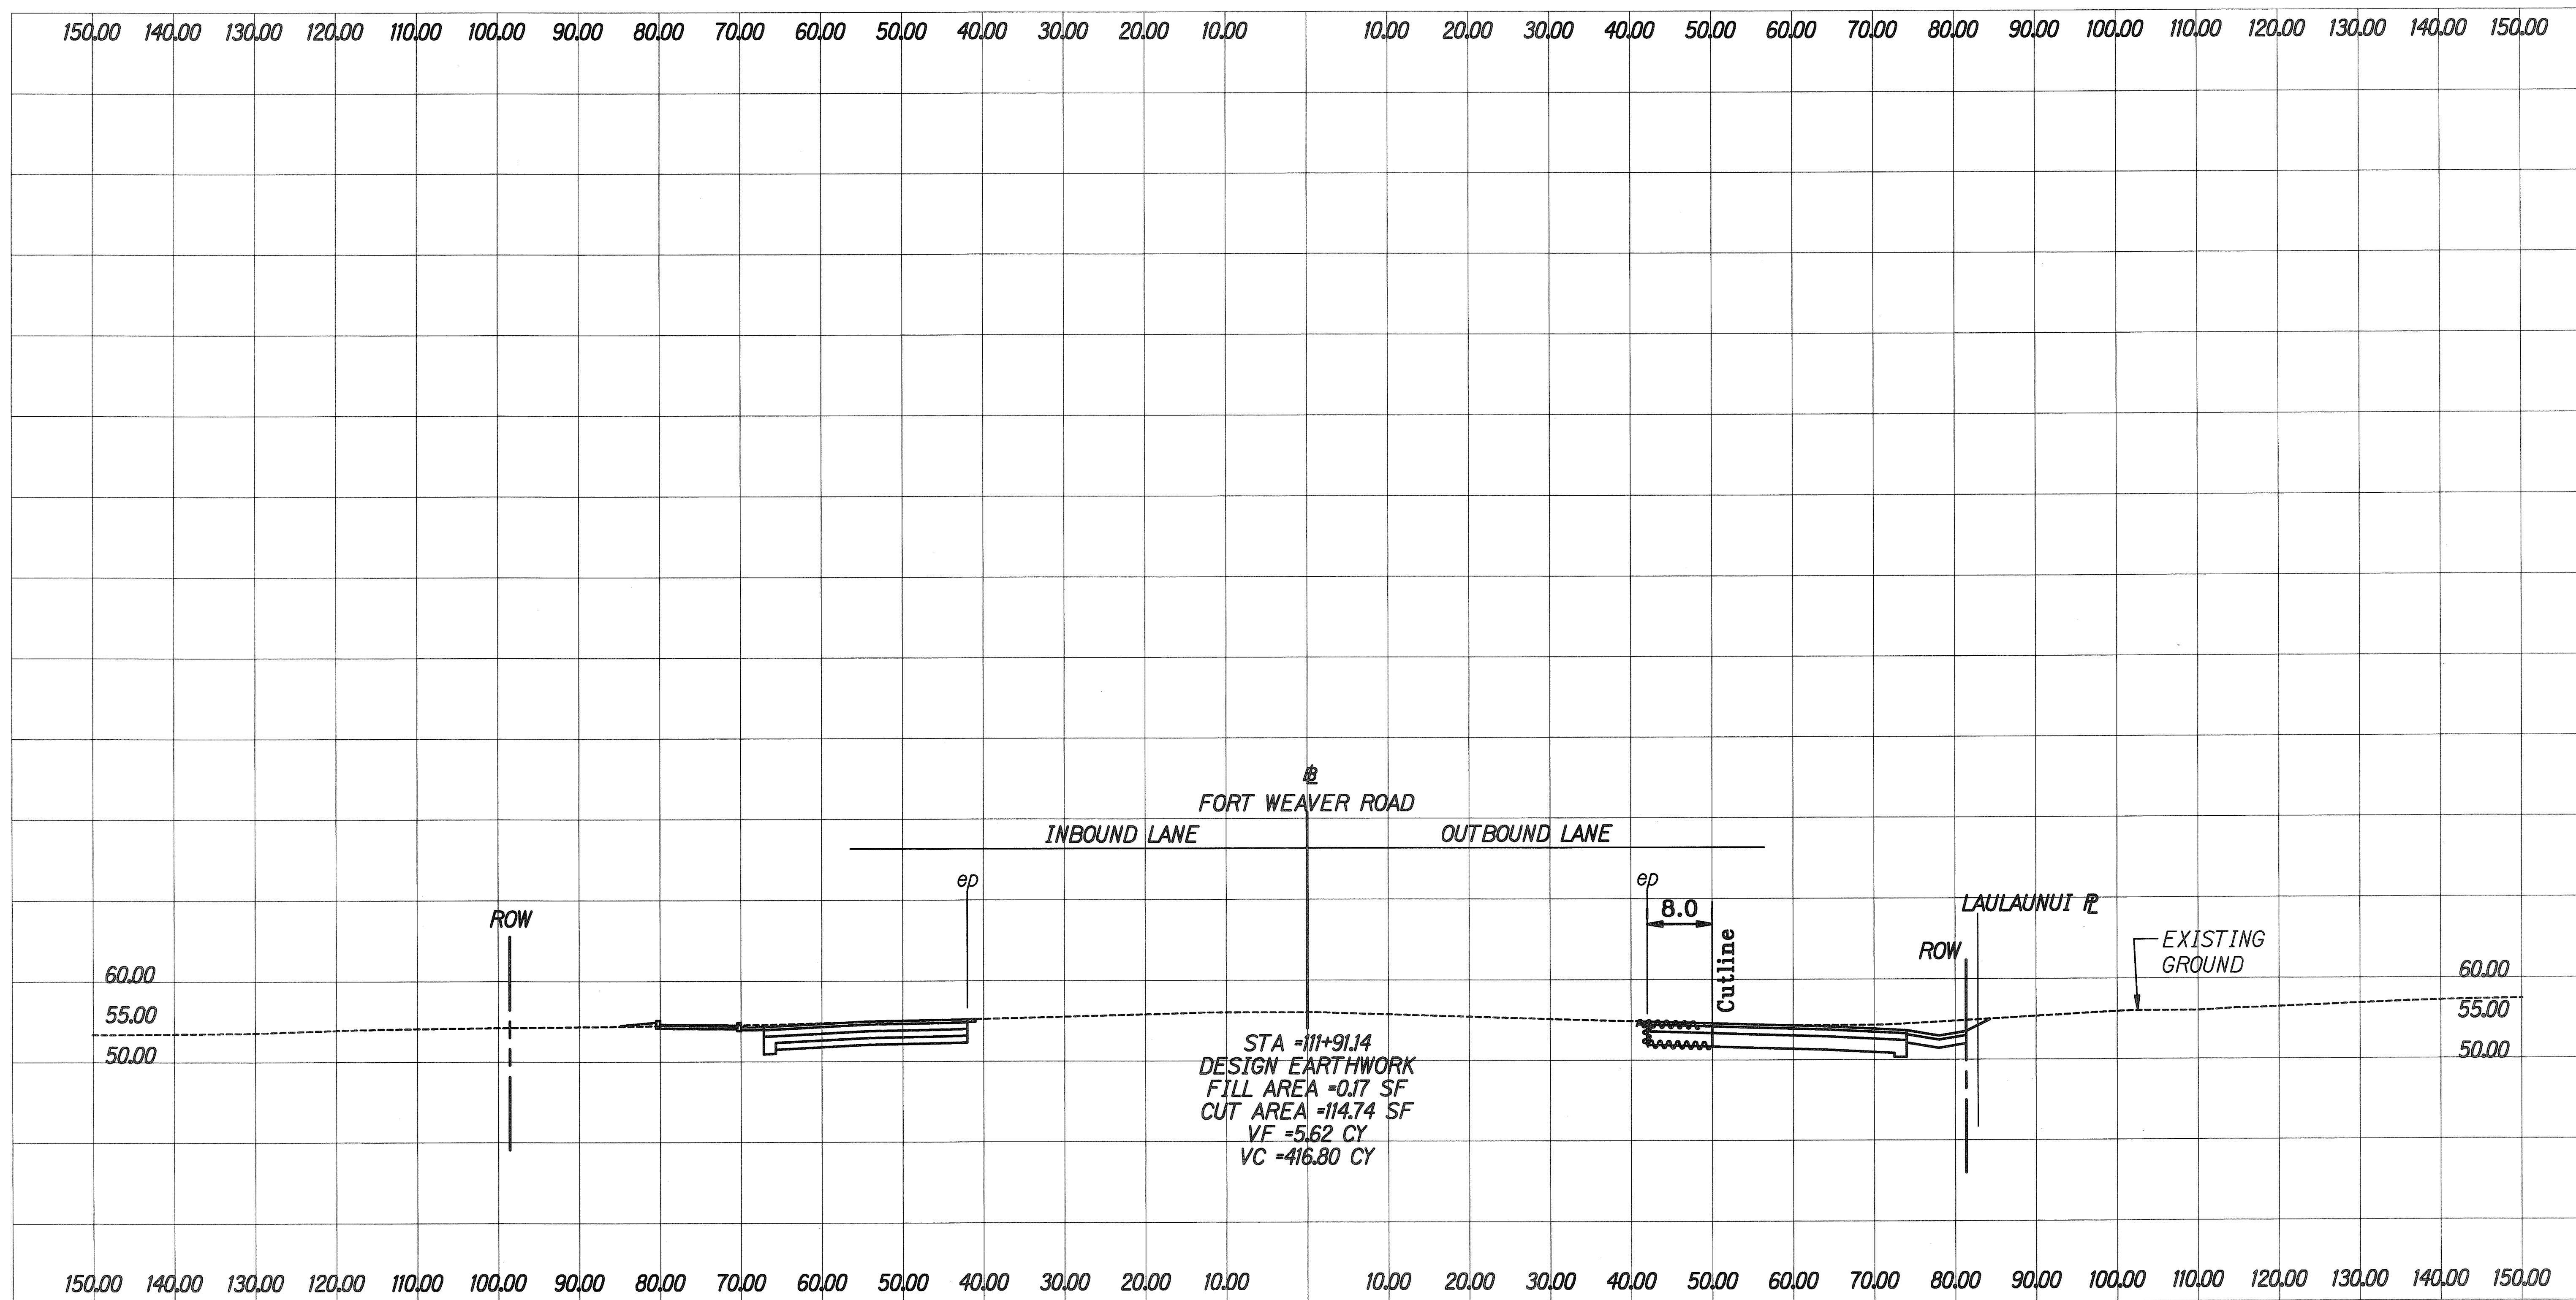

SURVEY PLATTED BY	DATE
DRAWN BY	
TRACED BY	
NOTES BOOK	
CMAQ-076-1(8)	
QUANTITIES BY	
CHECKED BY	
NO. 175297	

LEGEND FOR AS-BUILT POSTINGS	
~~~~~	Squiggly line for as-built deletion
==	Double line for as-built deletion
Roadway	Text for as-built posting

KENNETH O. NAGAI  
LICENSED PROFESSIONAL ENGINEER  
NO. 3265-C  
HAWAII, U.S.A.

APRIL 30, 2008  
EXPIRATION DATE OF LICENSE


THIS WORK WAS PREPARED BY ME OR UNDER MY SUPERVISION.

STATE OF HAWAII DEPARTMENT OF TRANSPORTATION HIGHWAYS DIVISION	
<b>CROSS SECTIONS - FORT WEAVER ROAD</b>	
<b>STA 111+91.4</b>	
<b>FORT WEAVER ROAD WIDENING</b>	
<b>NEAR LAULAUNUI STREET</b>	
<b>FEDERAL AND PROJECT NO. CMAQ-076-1(8)</b>	
SCALE: 1"=10'	DATE: October 2003
SHEET No. 12 OF 24 SHEETS	

"AS-BUILT"

115

FED. ROAD DIST. NO.	STATE	PROJ. NO.	FISCAL YEAR	SHEET NO.	TOTAL SHEETS
HAWAII	HAW.	CMAQ-076-118	2004	116	127

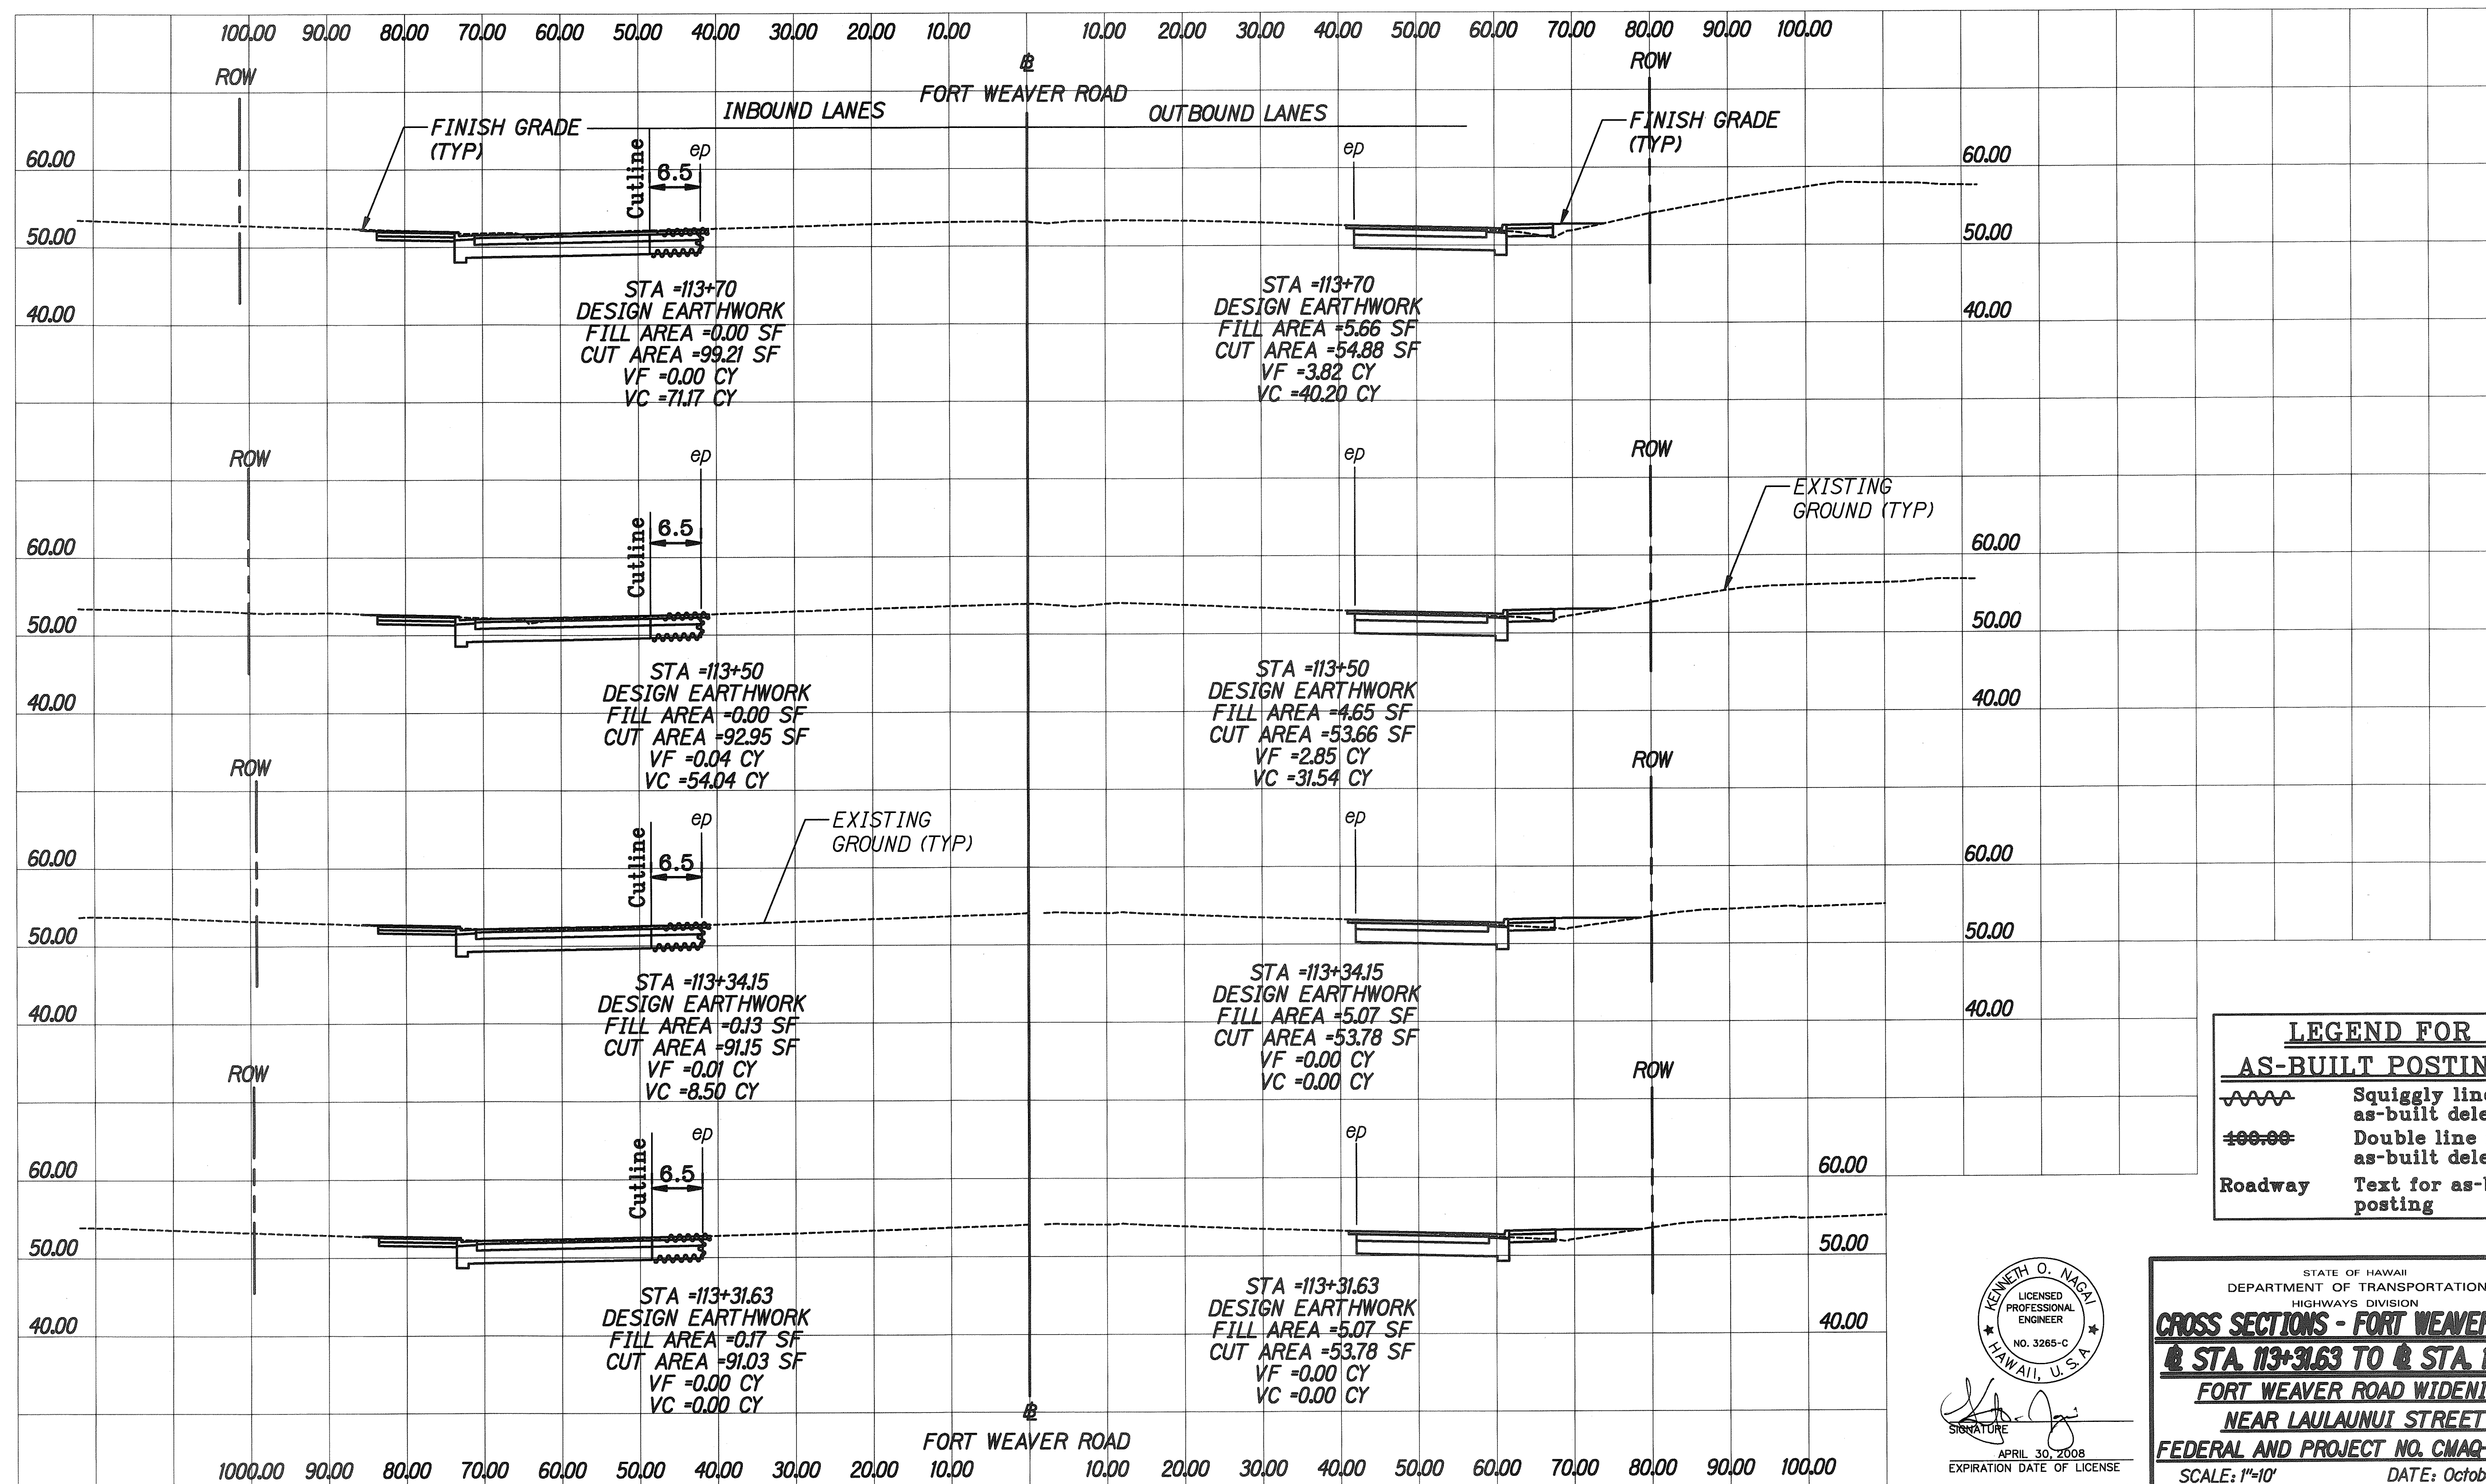

**LEGEND FOR AS-BUILT POSTINGS**

~~~~~ Squiggly line for as-built deletion

~~100.00~~ Double line for as-built deletion

Roadway Text for as-built posting

KENNETH O. NACKI
LICENSED PROFESSIONAL ENGINEER
NO. 3265-C
HAWAII, U.S.A.

APRIL 30, 2008
EXPIRATION DATE OF LICENSE

THIS WORK WAS PREPARED BY ME OR UNDER MY SUPERVISION.

STATE OF HAWAII
DEPARTMENT OF TRANSPORTATION
HIGHWAYS DIVISION

CROSS SECTIONS - FORT WEAVER ROAD
@ STA 113+31.63 TO @ STA 113+70


FORT WEAVER ROAD WIDENING
NEAR LAULAUNUI STREET
FEDERAL AND PROJECT NO. CMAQ-076-118)

SCALE: 1"=10' DATE: October 2003

SHEET No. 13 OF 24 SHEETS

"AS-BUILT"

| FED. ROAD DIST. NO. | STATE | PROJ. NO. | FISCAL YEAR | SHEET NO. | TOTAL SHEETS |
|---------------------|-------|---------------|-------------|-----------|--------------|
| HAWAII | HAW. | CMAQ-076-1(8) | 2004 | 117 | 127 |

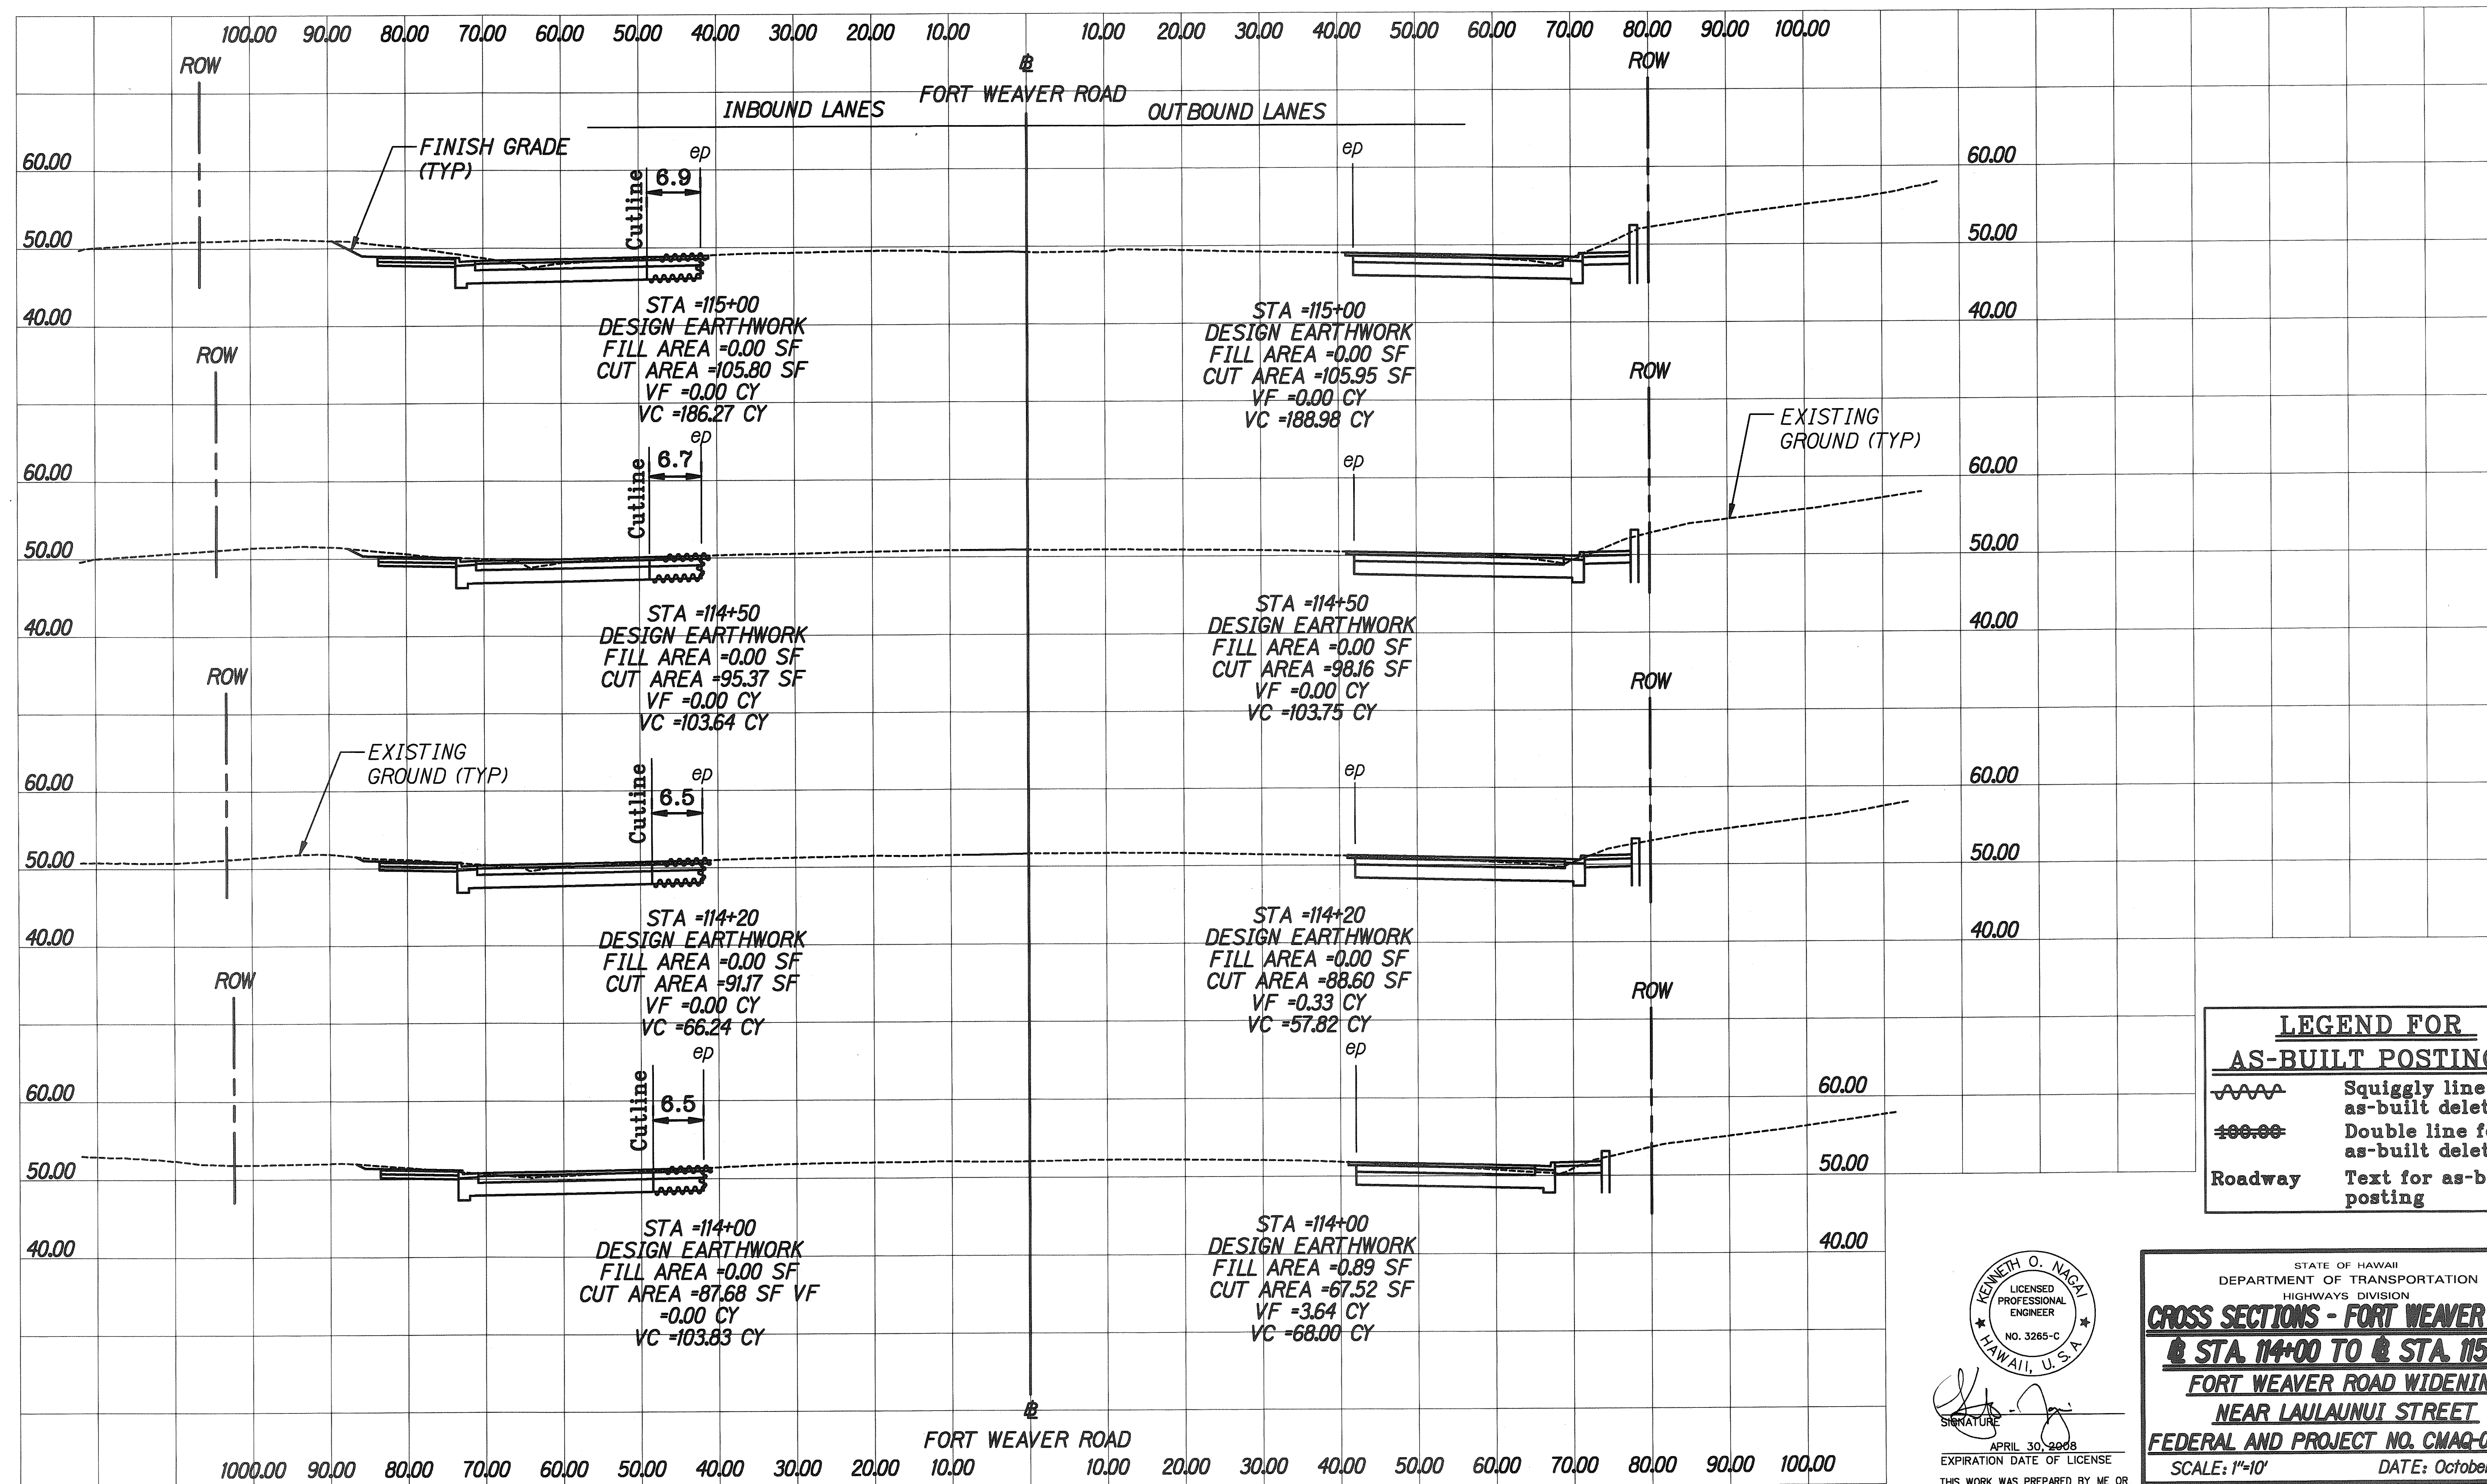

LEGEND FOR AS-BUILT POSTINGS

~~~~~ Squiggly line for as-built deletion

==== Double line for as-built deletion

Roadway Text for as-built posting

KENNETH O. NAGAL  
LICENSED PROFESSIONAL ENGINEER  
NO. 3265-C  
HAWAII, U.S.A.

APRIL 30, 2008  
EXPIRATION DATE OF LICENSE  
THIS WORK WAS PREPARED BY ME OR UNDER MY SUPERVISION.

STATE OF HAWAII  
DEPARTMENT OF TRANSPORTATION  
HIGHWAYS DIVISION


**CROSS SECTIONS - FORT WEAVER ROAD**  
**STA 114+00 TO STA 115+00**  
**FORT WEAVER ROAD WIDENING**  
**NEAR LAULAUNUI STREET**  
**FEDERAL AND PROJECT NO. CMAQ-076-1(8)**

SCALE: 1"=10' DATE: October 2003

SHEET No. 14 OF 24 SHEETS

"AS-BUILT"

| FED. ROAD DIST. NO. | STATE | PROJ. NO.     | FISCAL YEAR | SHEET NO. | TOTAL SHEETS |
|---------------------|-------|---------------|-------------|-----------|--------------|
| HAWAII              | HAW.  | CMAQ-076-1(8) | 2004        | 118       | 127          |

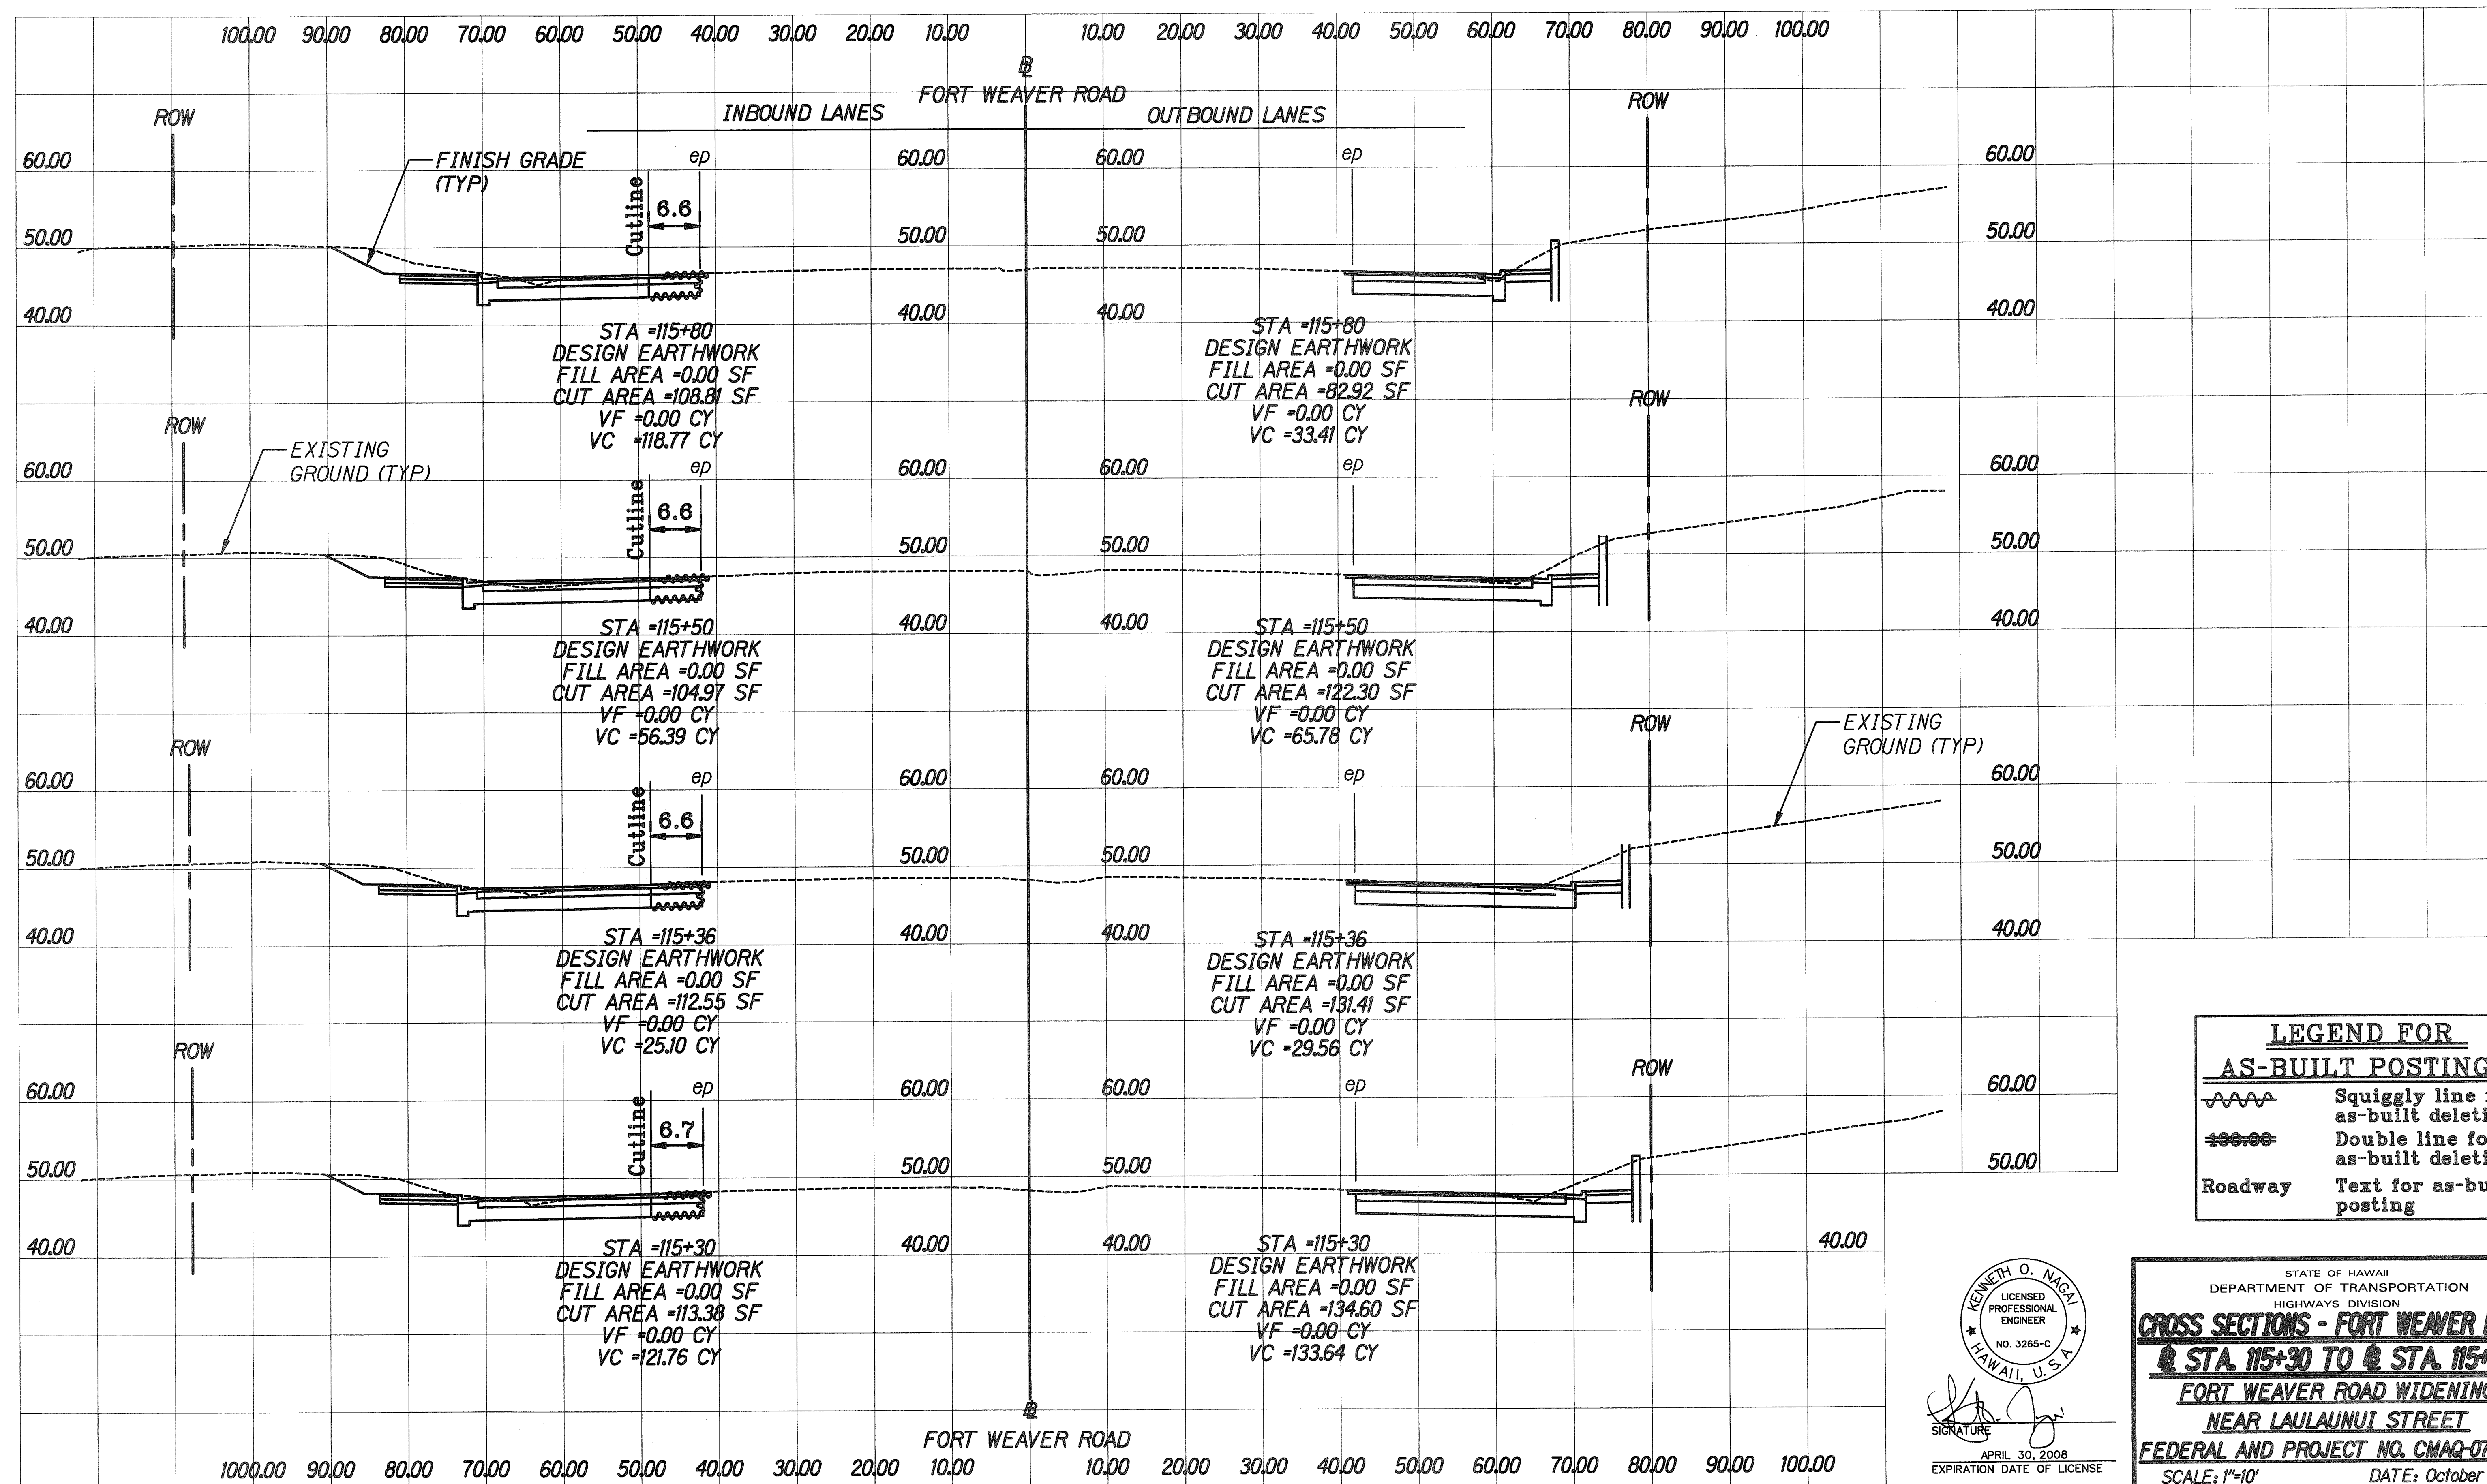


**LEGEND FOR AS-BUILT POSTINGS**

~~~~~ Squiggly line for as-built deletion

== Double line for as-built deletion

Roadway Text for as-built posting

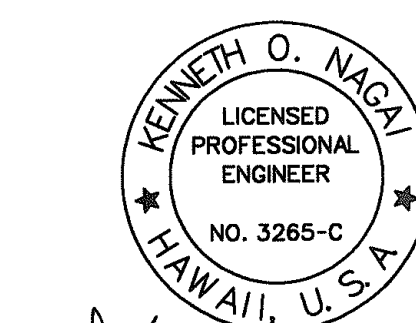

SIGNATURE: [Signature]

APRIL 30, 2008
EXPIRATION DATE OF LICENSE

THIS WORK WAS PREPARED BY ME OR UNDER MY SUPERVISION.

STATE OF HAWAII
DEPARTMENT OF TRANSPORTATION
HIGHWAYS DIVISION


CROSS SECTIONS - FORT WEAVER ROAD
STA 115+30 TO STA 115+80
FORT WEAVER ROAD WIDENING
NEAR LAULAUNUI STREET
FEDERAL AND PROJECT NO. CMAQ-076-1(8)

SCALE: 1"=10' DATE: October 2003

SHEET No. 15 OF 24 SHEETS

"AS-BUILT"

| FED. ROAD DIST. NO. | STATE | PROJ. NO. | FISCAL YEAR | SHEET NO. | TOTAL SHEETS |
|---------------------|-------|---------------|-------------|-----------|--------------|
| HAWAII | HAW. | CMAQ-076-1(8) | 2004 | 119 | 127 |

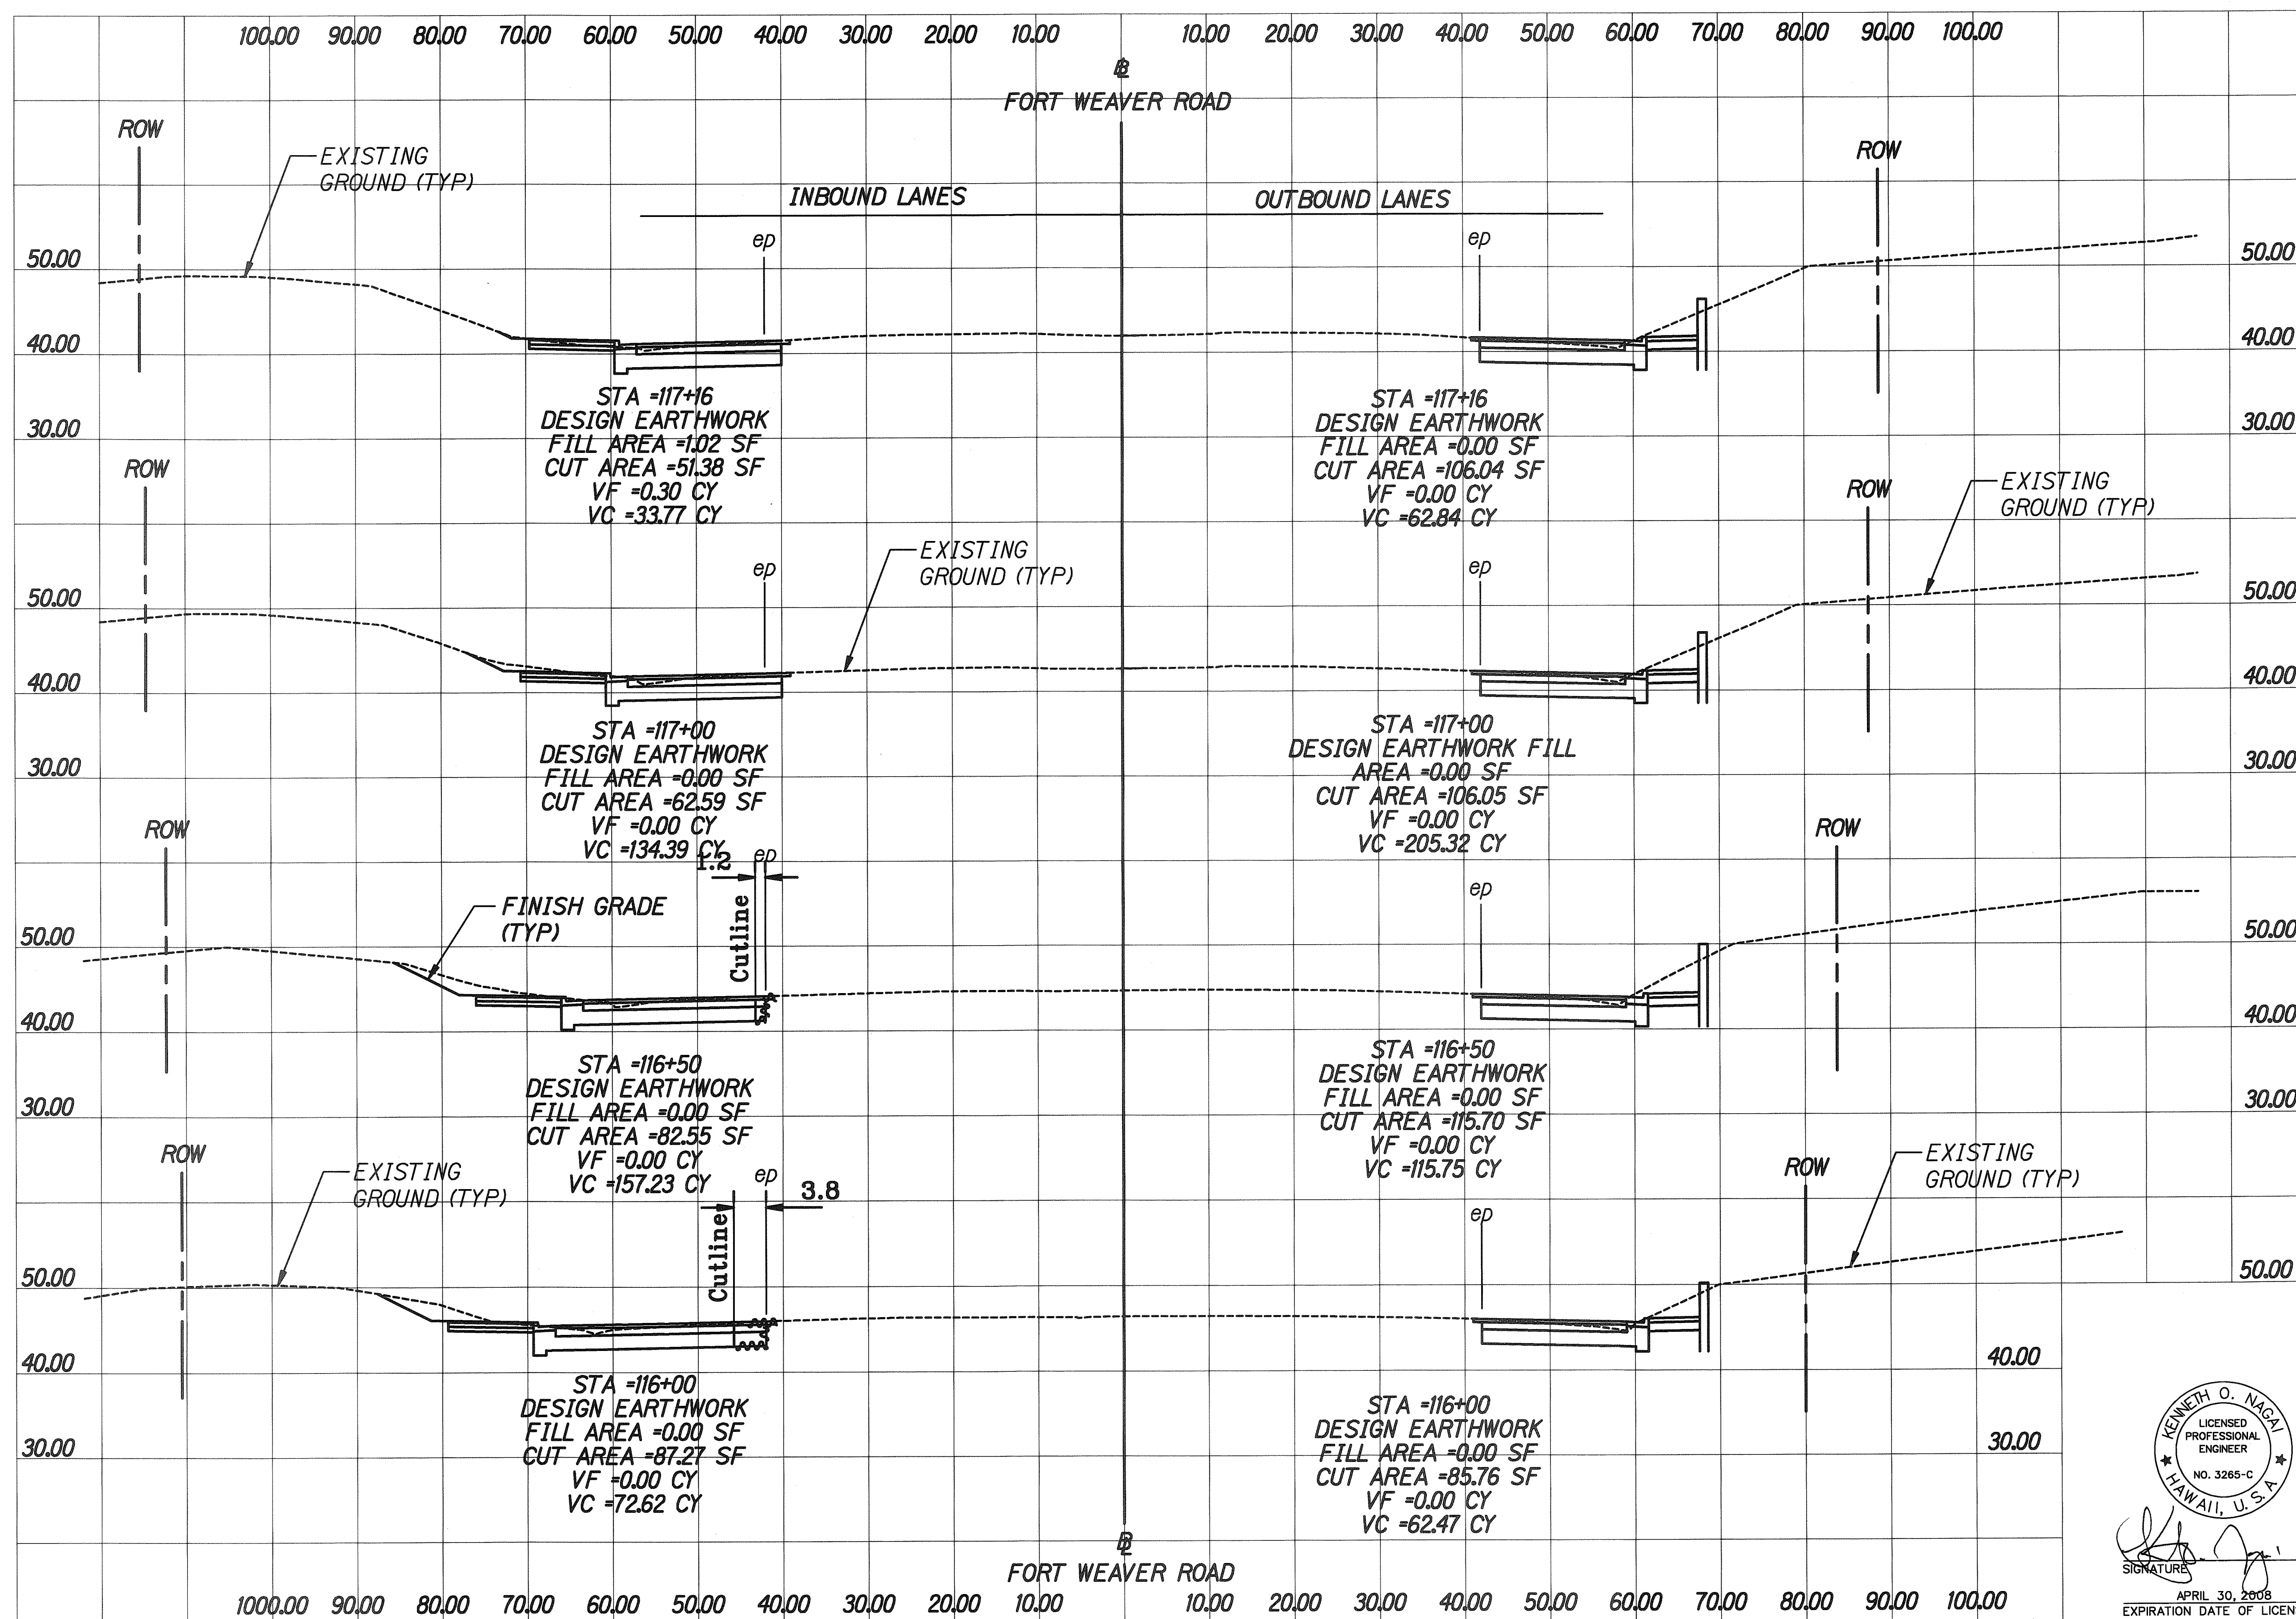

| LEGEND FOR AS-BUILT POSTINGS | |
|------------------------------|-------------------------------------|
| | Squiggly line for as-built deletion |
| | Double line for as-built deletion |
| Roadway | Text for as-built posting |

KENNETH O. NAGA
 LICENSED PROFESSIONAL ENGINEER
 NO. 3265-C
 HAWAII, U.S.A.
 SIGNATURE

STATE OF HAWAII
 DEPARTMENT OF TRANSPORTATION
 HIGHWAYS DIVISION
CROSS SECTIONS - FORT WEAVER ROAD
STA. 116+00 TO STA. 117+16
FORT WEAVER ROAD WIDENING
NEAR LAULAUNUI STREET
FEDERAL AND PROJECT NO. CMAQ-076-1(8)
 SCALE: 1"=10' DATE: October 2003


APRIL 30, 2008
 EXPIRATION DATE OF LICENSE
 THIS WORK WAS PREPARED BY ME OR UNDER MY SUPERVISION.

SHEET No. 16 OF 24 SHEETS

"AS-BUILT"

SURVEY PLATTED BY: DATE: X
 DESIGNED BY: X
 CHECKED BY: X
 NOTE: MOE
 QUANTITIES BY: X
 DESIGNED BY: X
 CHECKED BY: X

| FED. ROAD DIST. NO. | STATE | FED. AID PROJ. NO. | FISCAL YEAR | SHEET NO. | TOTAL SHEETS |
|---------------------|-------|--------------------|-------------|-----------|--------------|
| HAWAII | HAW. | CMAQ-076-1(8) | 2004 | 120 | 127 |

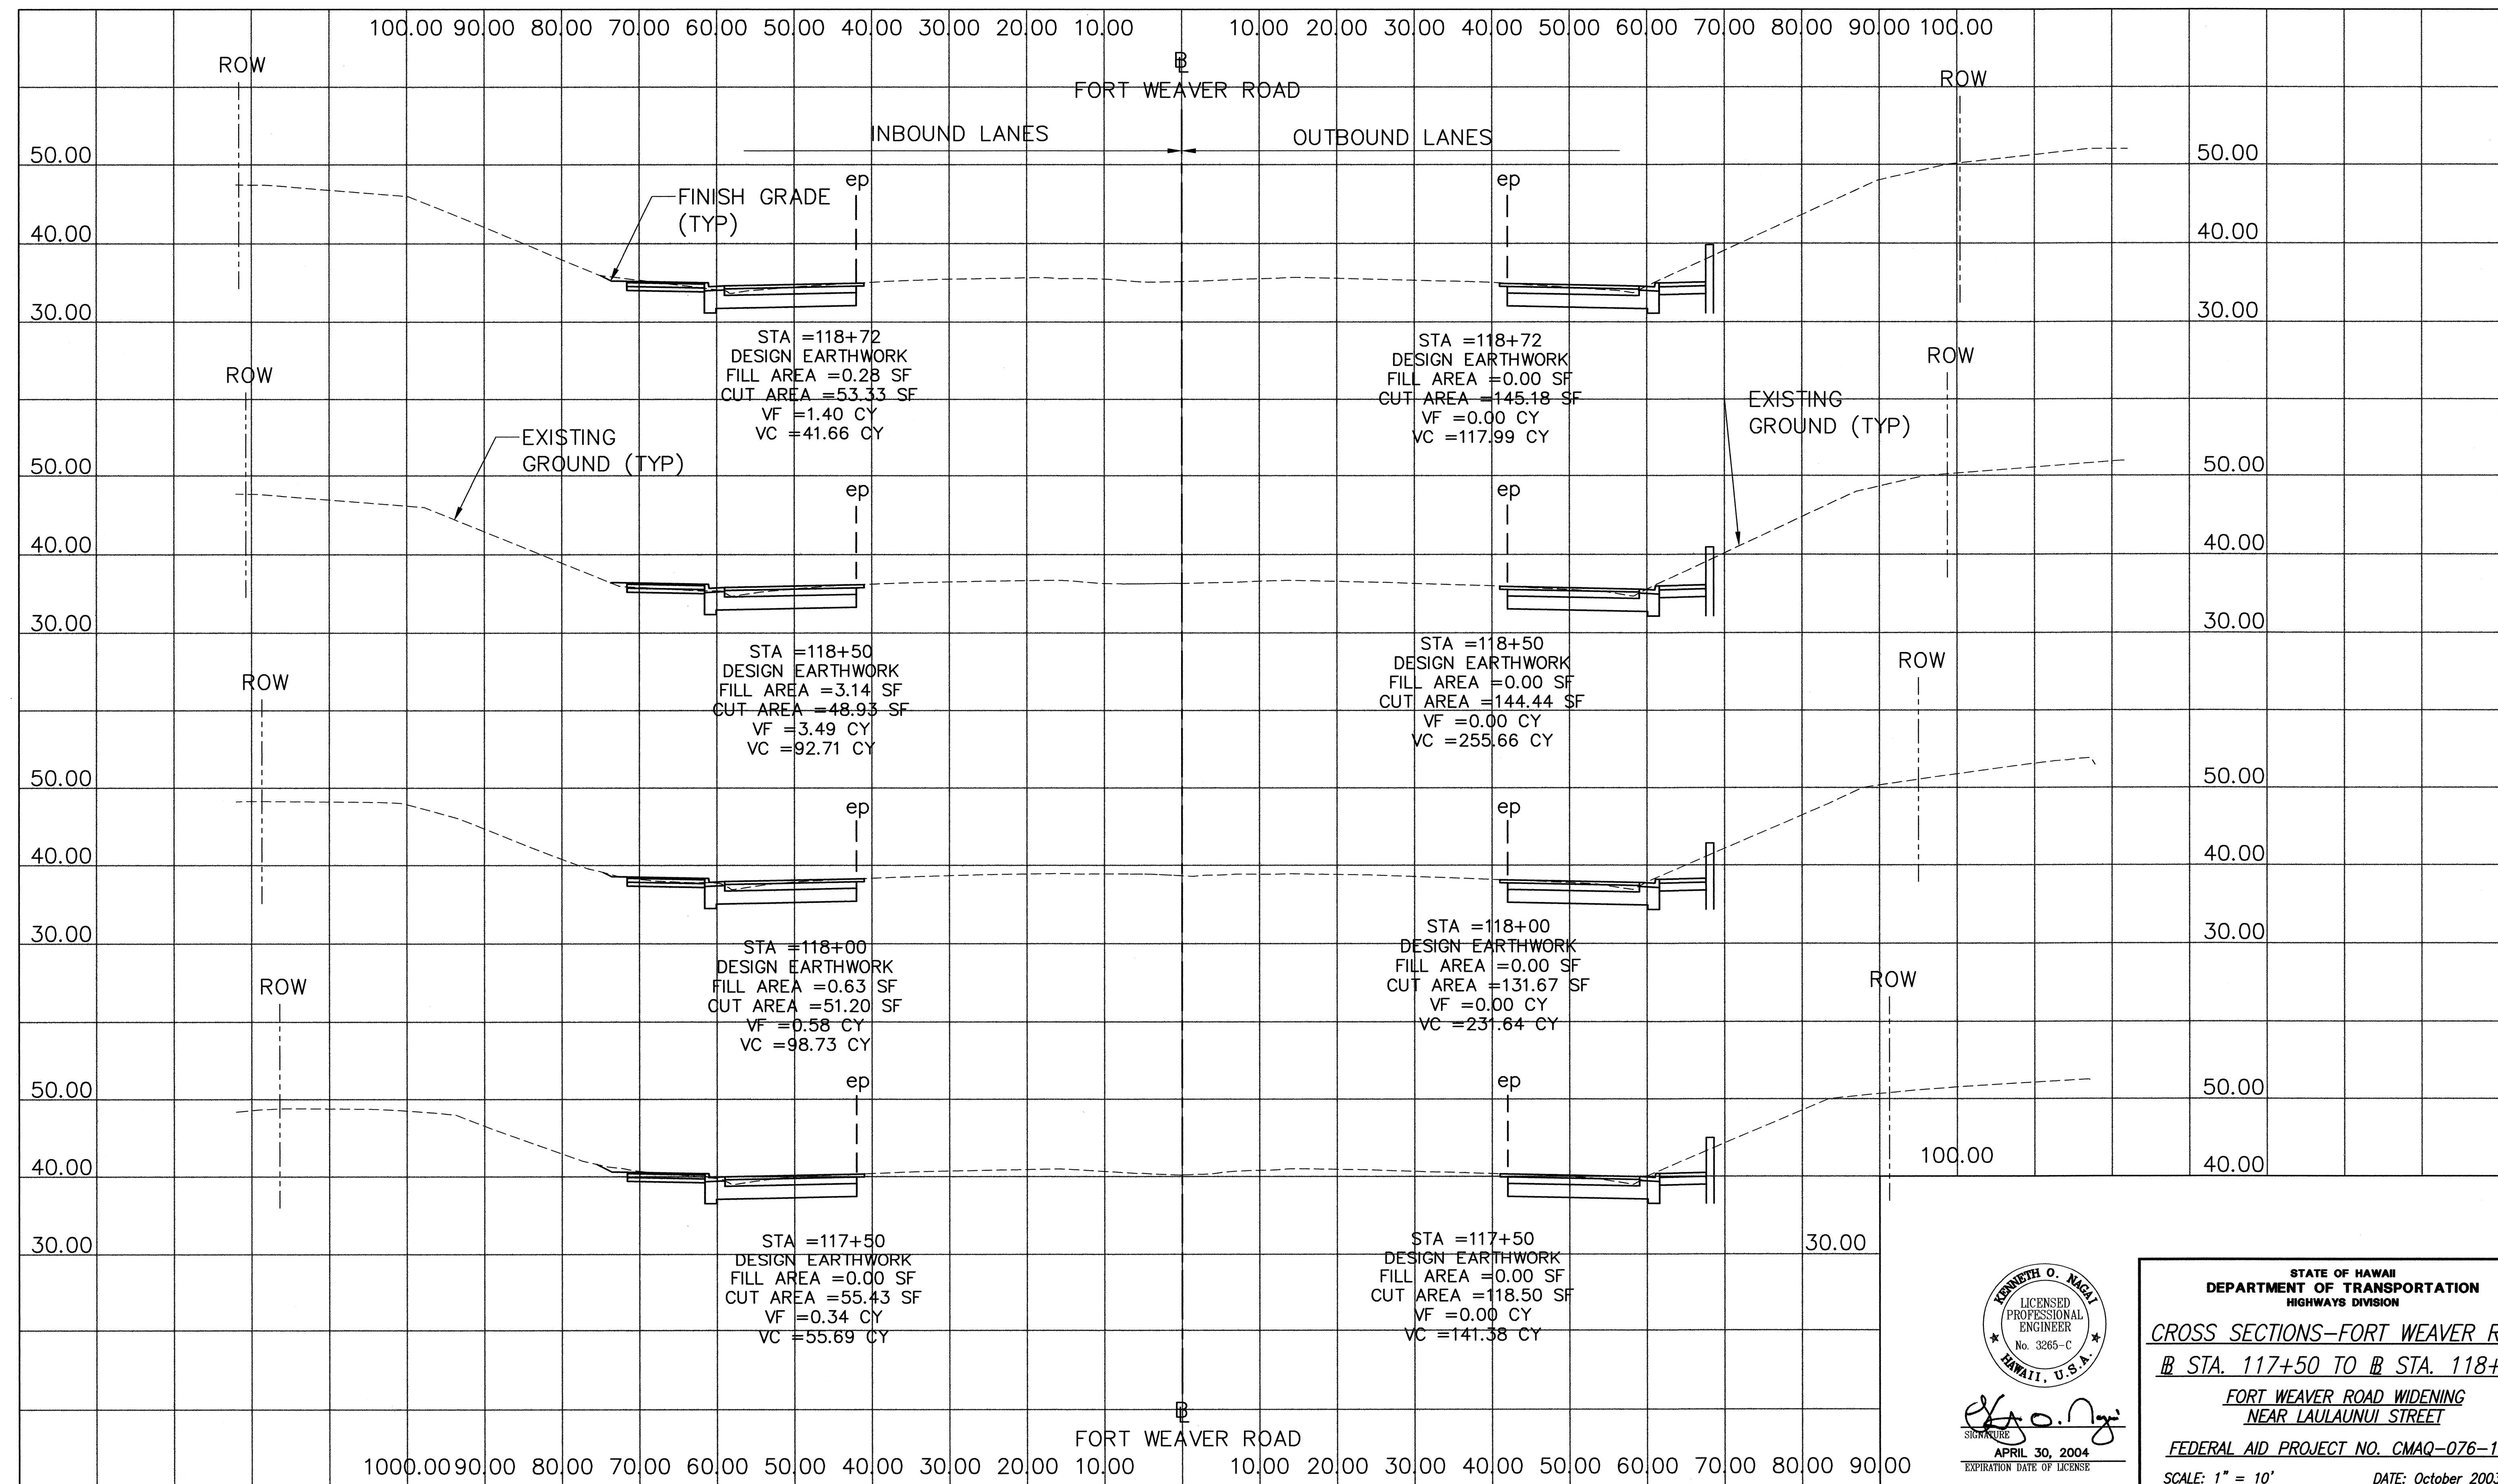


| | | |
|---------------|-------------------|------|
| ORIGINAL PLAN | SURVEY PLOTTED BY | DATE |
| NOTE BOOK | DRAWN BY | " " |
| | DESIGNED BY | " " |
| | CHECKED BY | " " |
| | | " " |
| | | " " |
KENNETH O. NAGAI
LICENSED PROFESSIONAL ENGINEER
No. 3265-C
HAWAII, U.S.A.
APRIL 30, 2004
EXPIRATION DATE OF LICENSE
THIS WORK WAS PREPARED BY ME OR UNDER MY SUPERVISION

STATE OF HAWAII
DEPARTMENT OF TRANSPORTATION
HIGHWAYS DIVISION
CROSS SECTIONS-FORT WEAVER ROAD
STA. 117+50 TO STA. 118+72
FORT WEAVER ROAD WIDENING
NEAR LAULAUNUI STREET
FEDERAL AID PROJECT NO. CMAQ-076-1(8)
SCALE: 1" = 10' **DATE: October 2003**
SHEET No. 17 OF 24 SHEETS

| FED. ROAD DIST. NO. | STATE | FED. AID PROJ. NO. | FISCAL YEAR | SHEET NO. | TOTAL SHEETS |
|---------------------|-------|--------------------|-------------|-----------|--------------|
| HAWAII | HAW. | CMAQ-076-1(8) | 2004 | 121 | 127 |

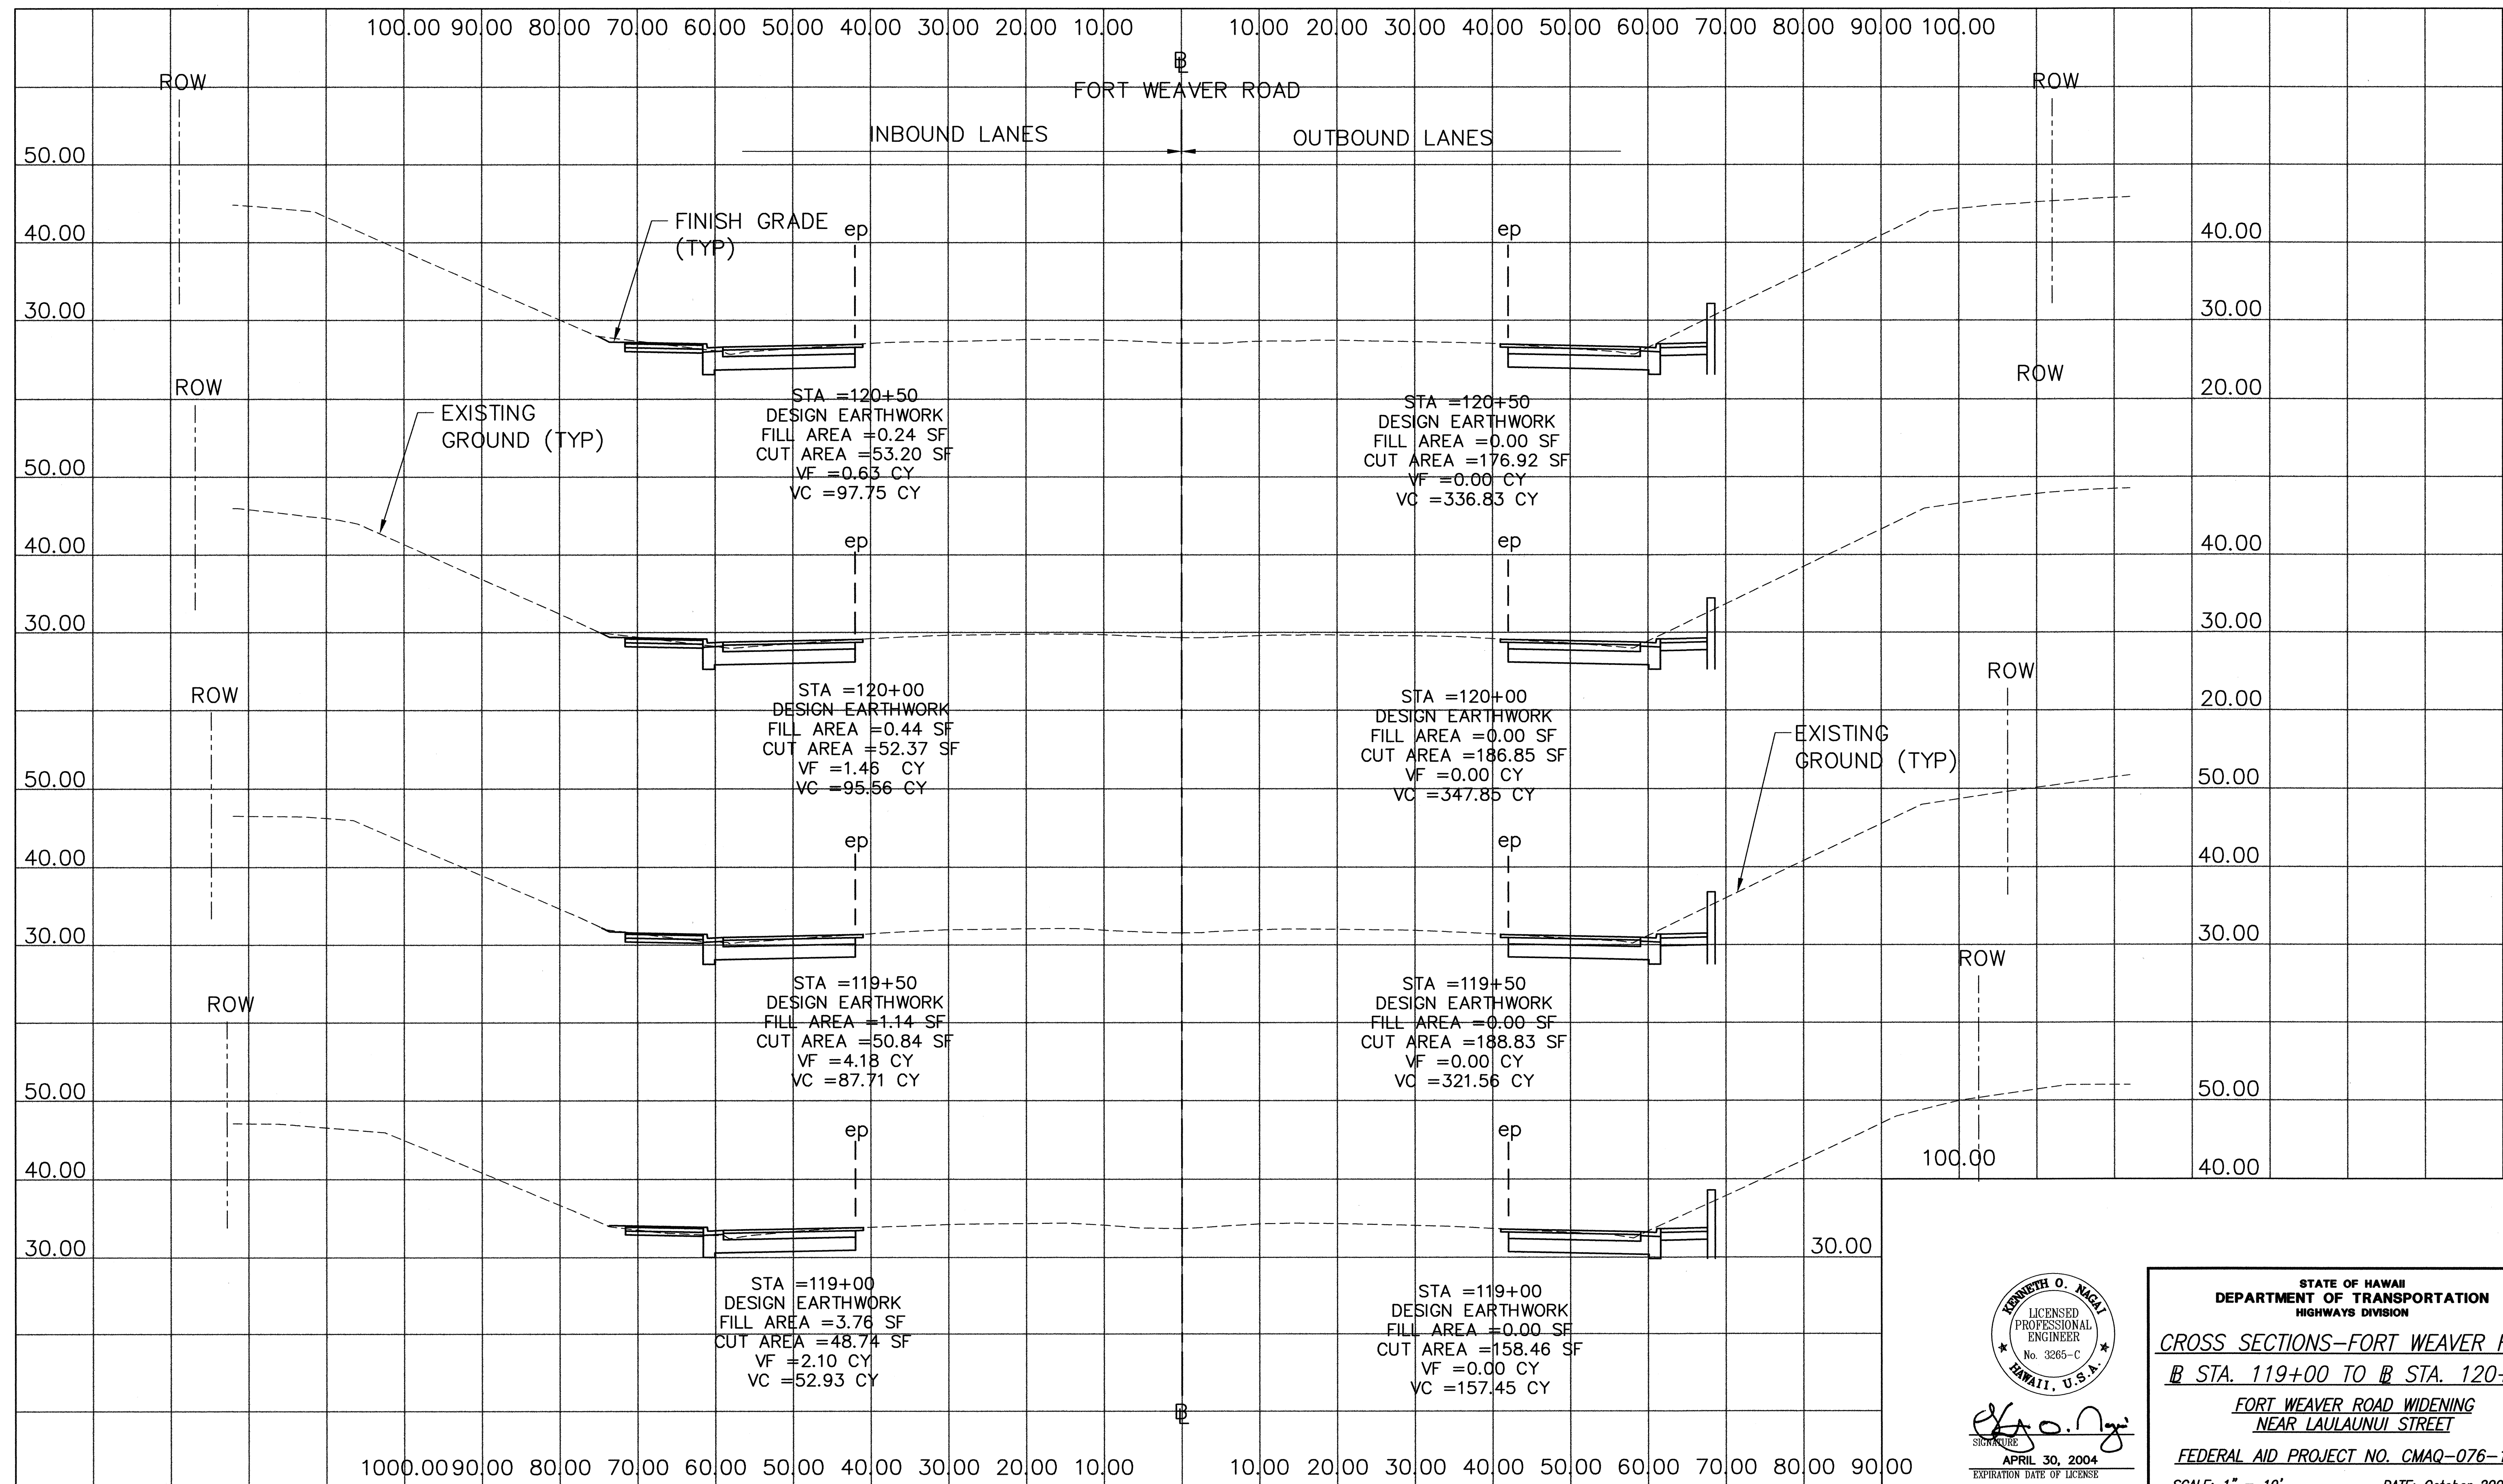


| | |
|-------------------|------|
| SURVEY PLOTTED BY | DATE |
| DRAWN BY | |
| TRACED BY | |
| DESIGNED BY | |
| CHECKED BY | |
| No. | |

KENNETH O. NAGAI
 LICENSED PROFESSIONAL ENGINEER
 No. 3265-C
 HAWAII, U.S.A.
 APRIL 30, 2004
 EXPIRATION DATE OF LICENSE
 THIS WORK WAS PREPARED BY ME OR UNDER MY SUPERVISION

STATE OF HAWAII
 DEPARTMENT OF TRANSPORTATION
 HIGHWAYS DIVISION
 CROSS SECTIONS-FORT WEAVER ROAD
 STA. 119+00 TO STA. 120+50
 FORT WEAVER ROAD WIDENING
 NEAR LAULAUNUI STREET
 FEDERAL AID PROJECT NO. CMAQ-076-1(8)
 SCALE: 1" = 10'
 DATE: October 2003
 SHEET No. 18 OF 24 SHEETS

| FED. ROAD DIST. NO. | STATE | FED. AID PROJ. NO. | FISCAL YEAR | SHEET NO. | TOTAL SHEETS |
|---------------------|-------|--------------------|-------------|-----------|--------------|
| HAWAII | HAW. | CMAQ-076-1(8) | 2004 | 122 | 127 |

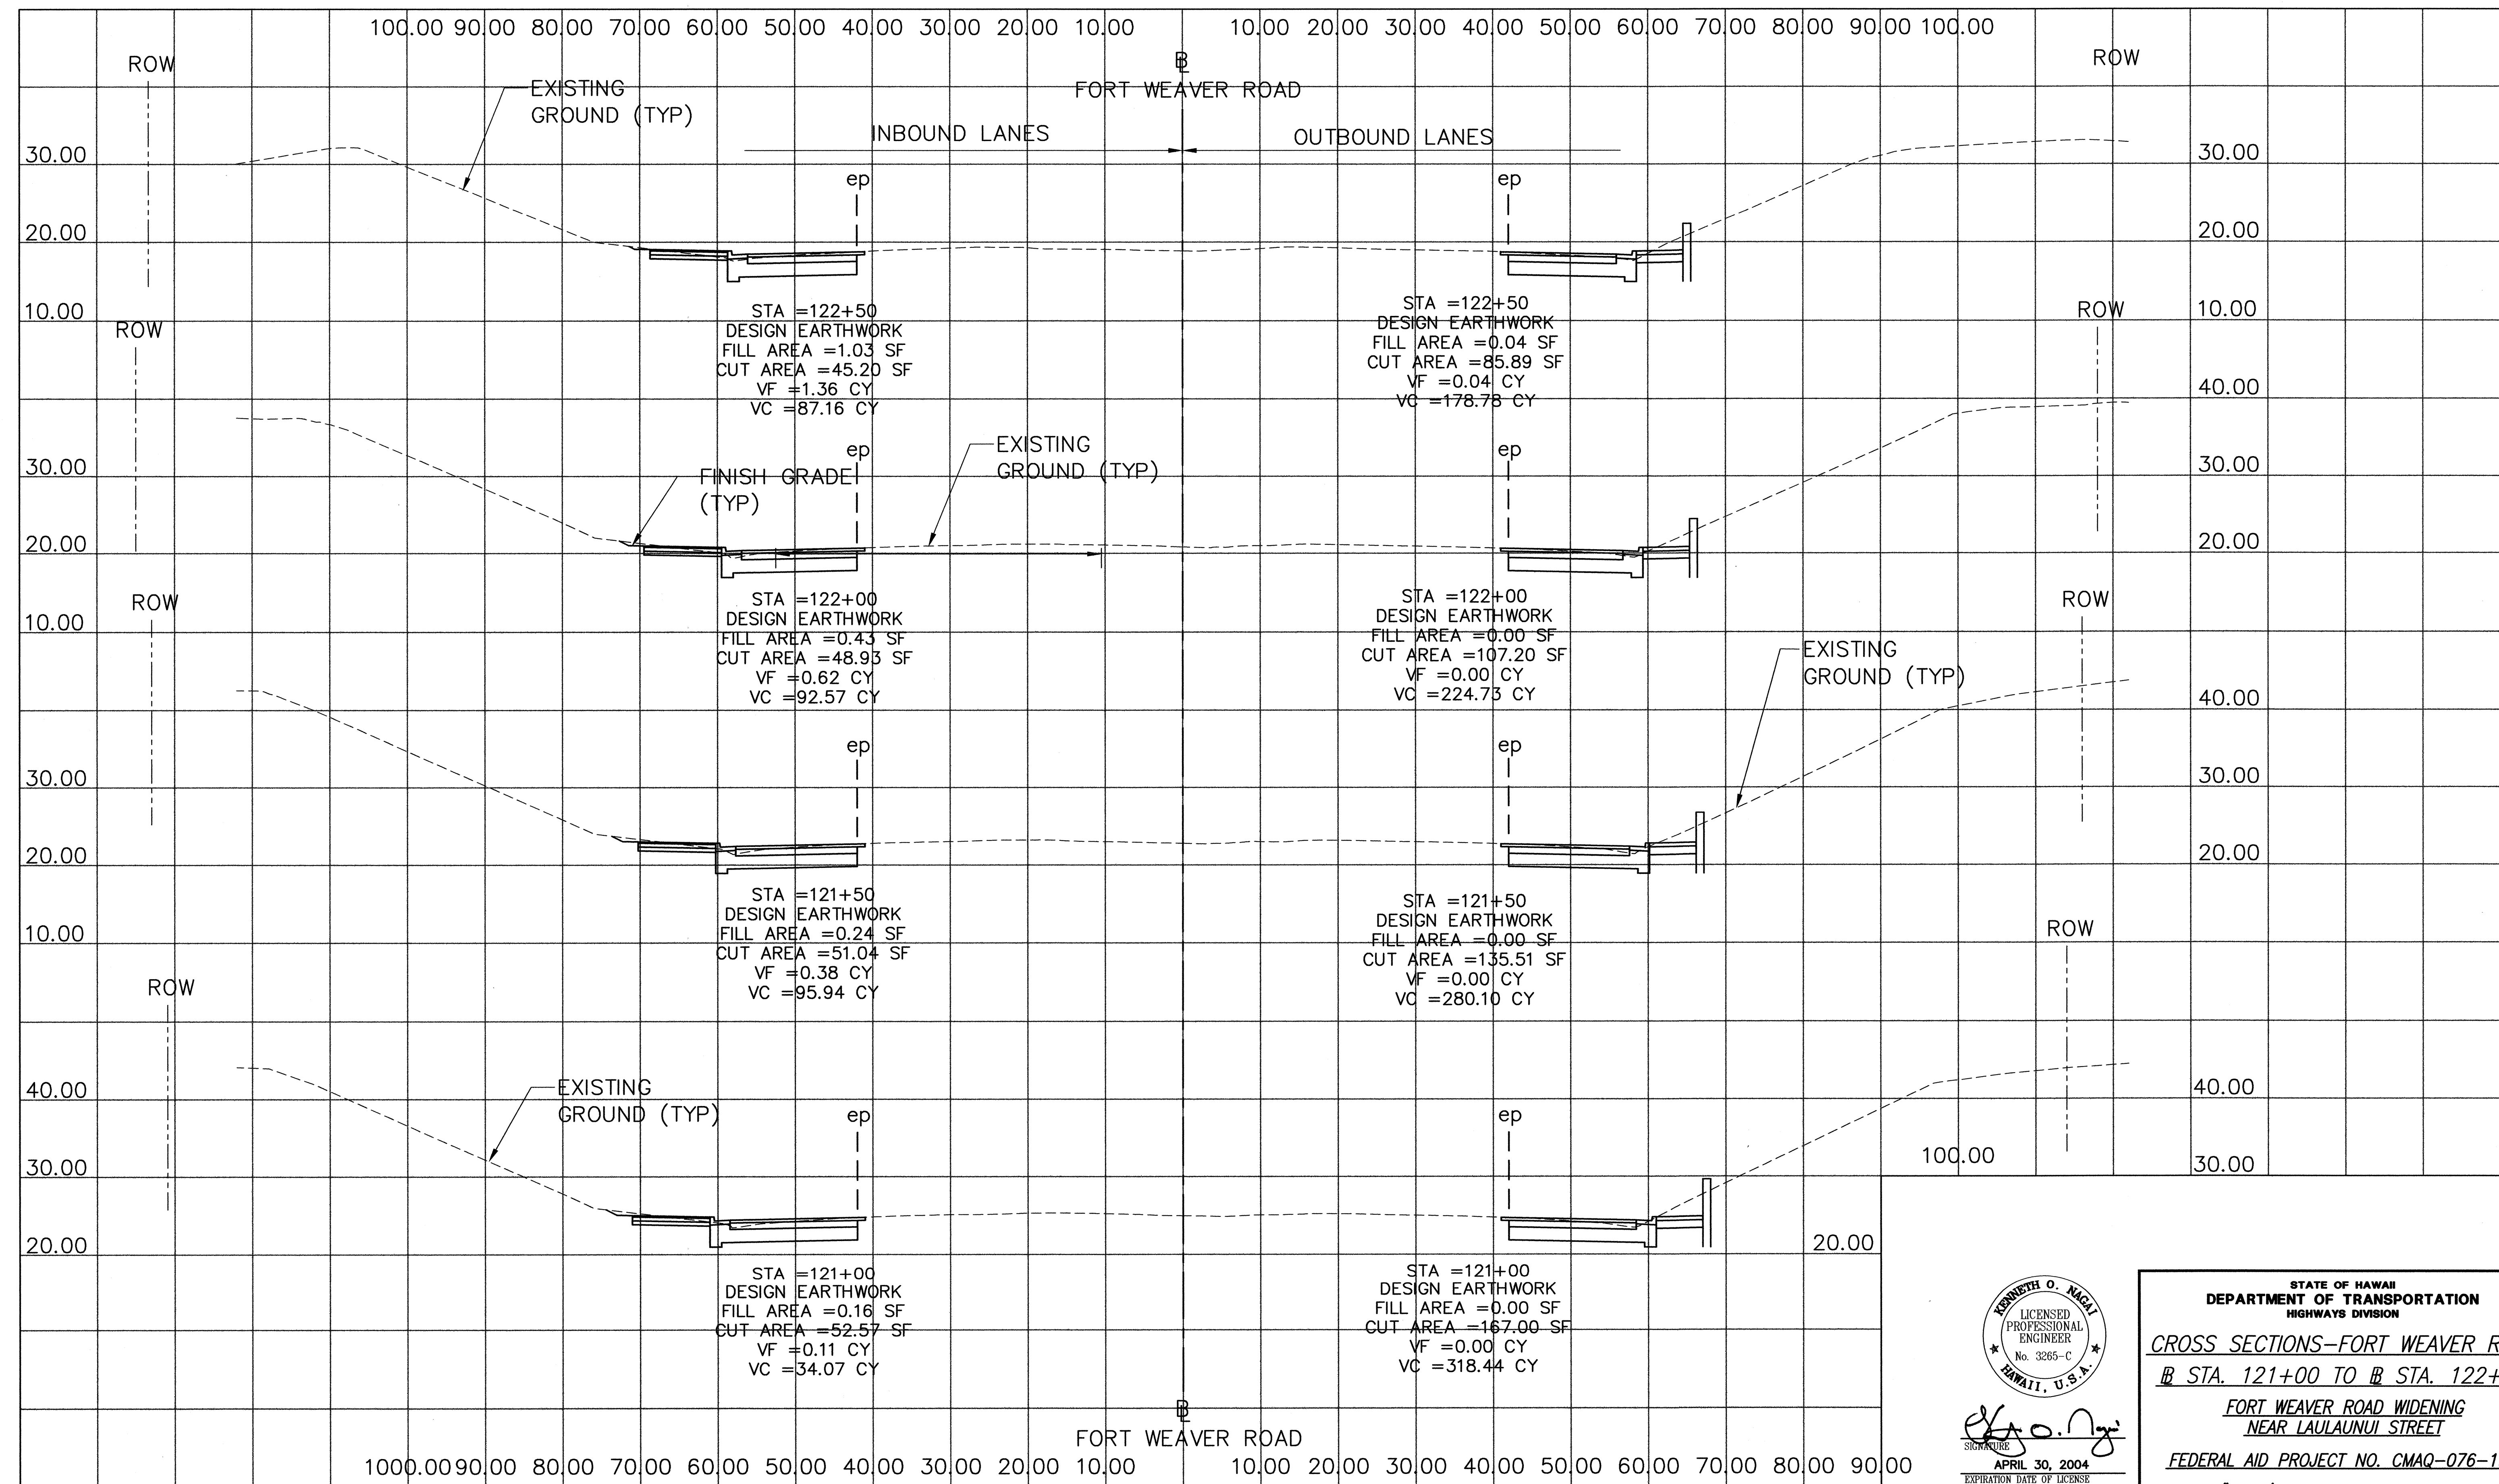


| | |
|-------------------|------|
| SURVEY PLOTTED BY | DATE |
| DRAWN BY | |
| DESIGNED BY | |
| CHECKED BY | |
| ORIGINAL PLAN | |
| NOTE BOOK | |
| No. | |

KENNETH O. NAGLE
 LICENSED PROFESSIONAL ENGINEER
 No. 3285-C
 HAWAII, U.S.A.
 APRIL 30, 2004
 EXPIRATION DATE OF LICENSE
 THIS WORK WAS PREPARED BY ME OR UNDER MY SUPERVISION

STATE OF HAWAII
 DEPARTMENT OF TRANSPORTATION
 HIGHWAYS DIVISION
 CROSS SECTIONS-FORT WEAVER ROAD
 STA. 121+00 TO STA. 122+50
 FORT WEAVER ROAD WIDENING
 NEAR LAULAUNUI STREET
 FEDERAL AID PROJECT NO. CMAQ-076-1(8)
 SCALE: 1" = 10' DATE: October 2003
 SHEET No. 19 OF 24 SHEETS

| FED. ROAD DIST. NO. | STATE | FED. AID PROJ. NO. | FISCAL YEAR | SHEET NO. | TOTAL SHEETS |
|---------------------|-------|--------------------|-------------|-----------|--------------|
| HAWAII | HAW. | CMAQ-076-1(8) | 2004 | 123 | 127 |

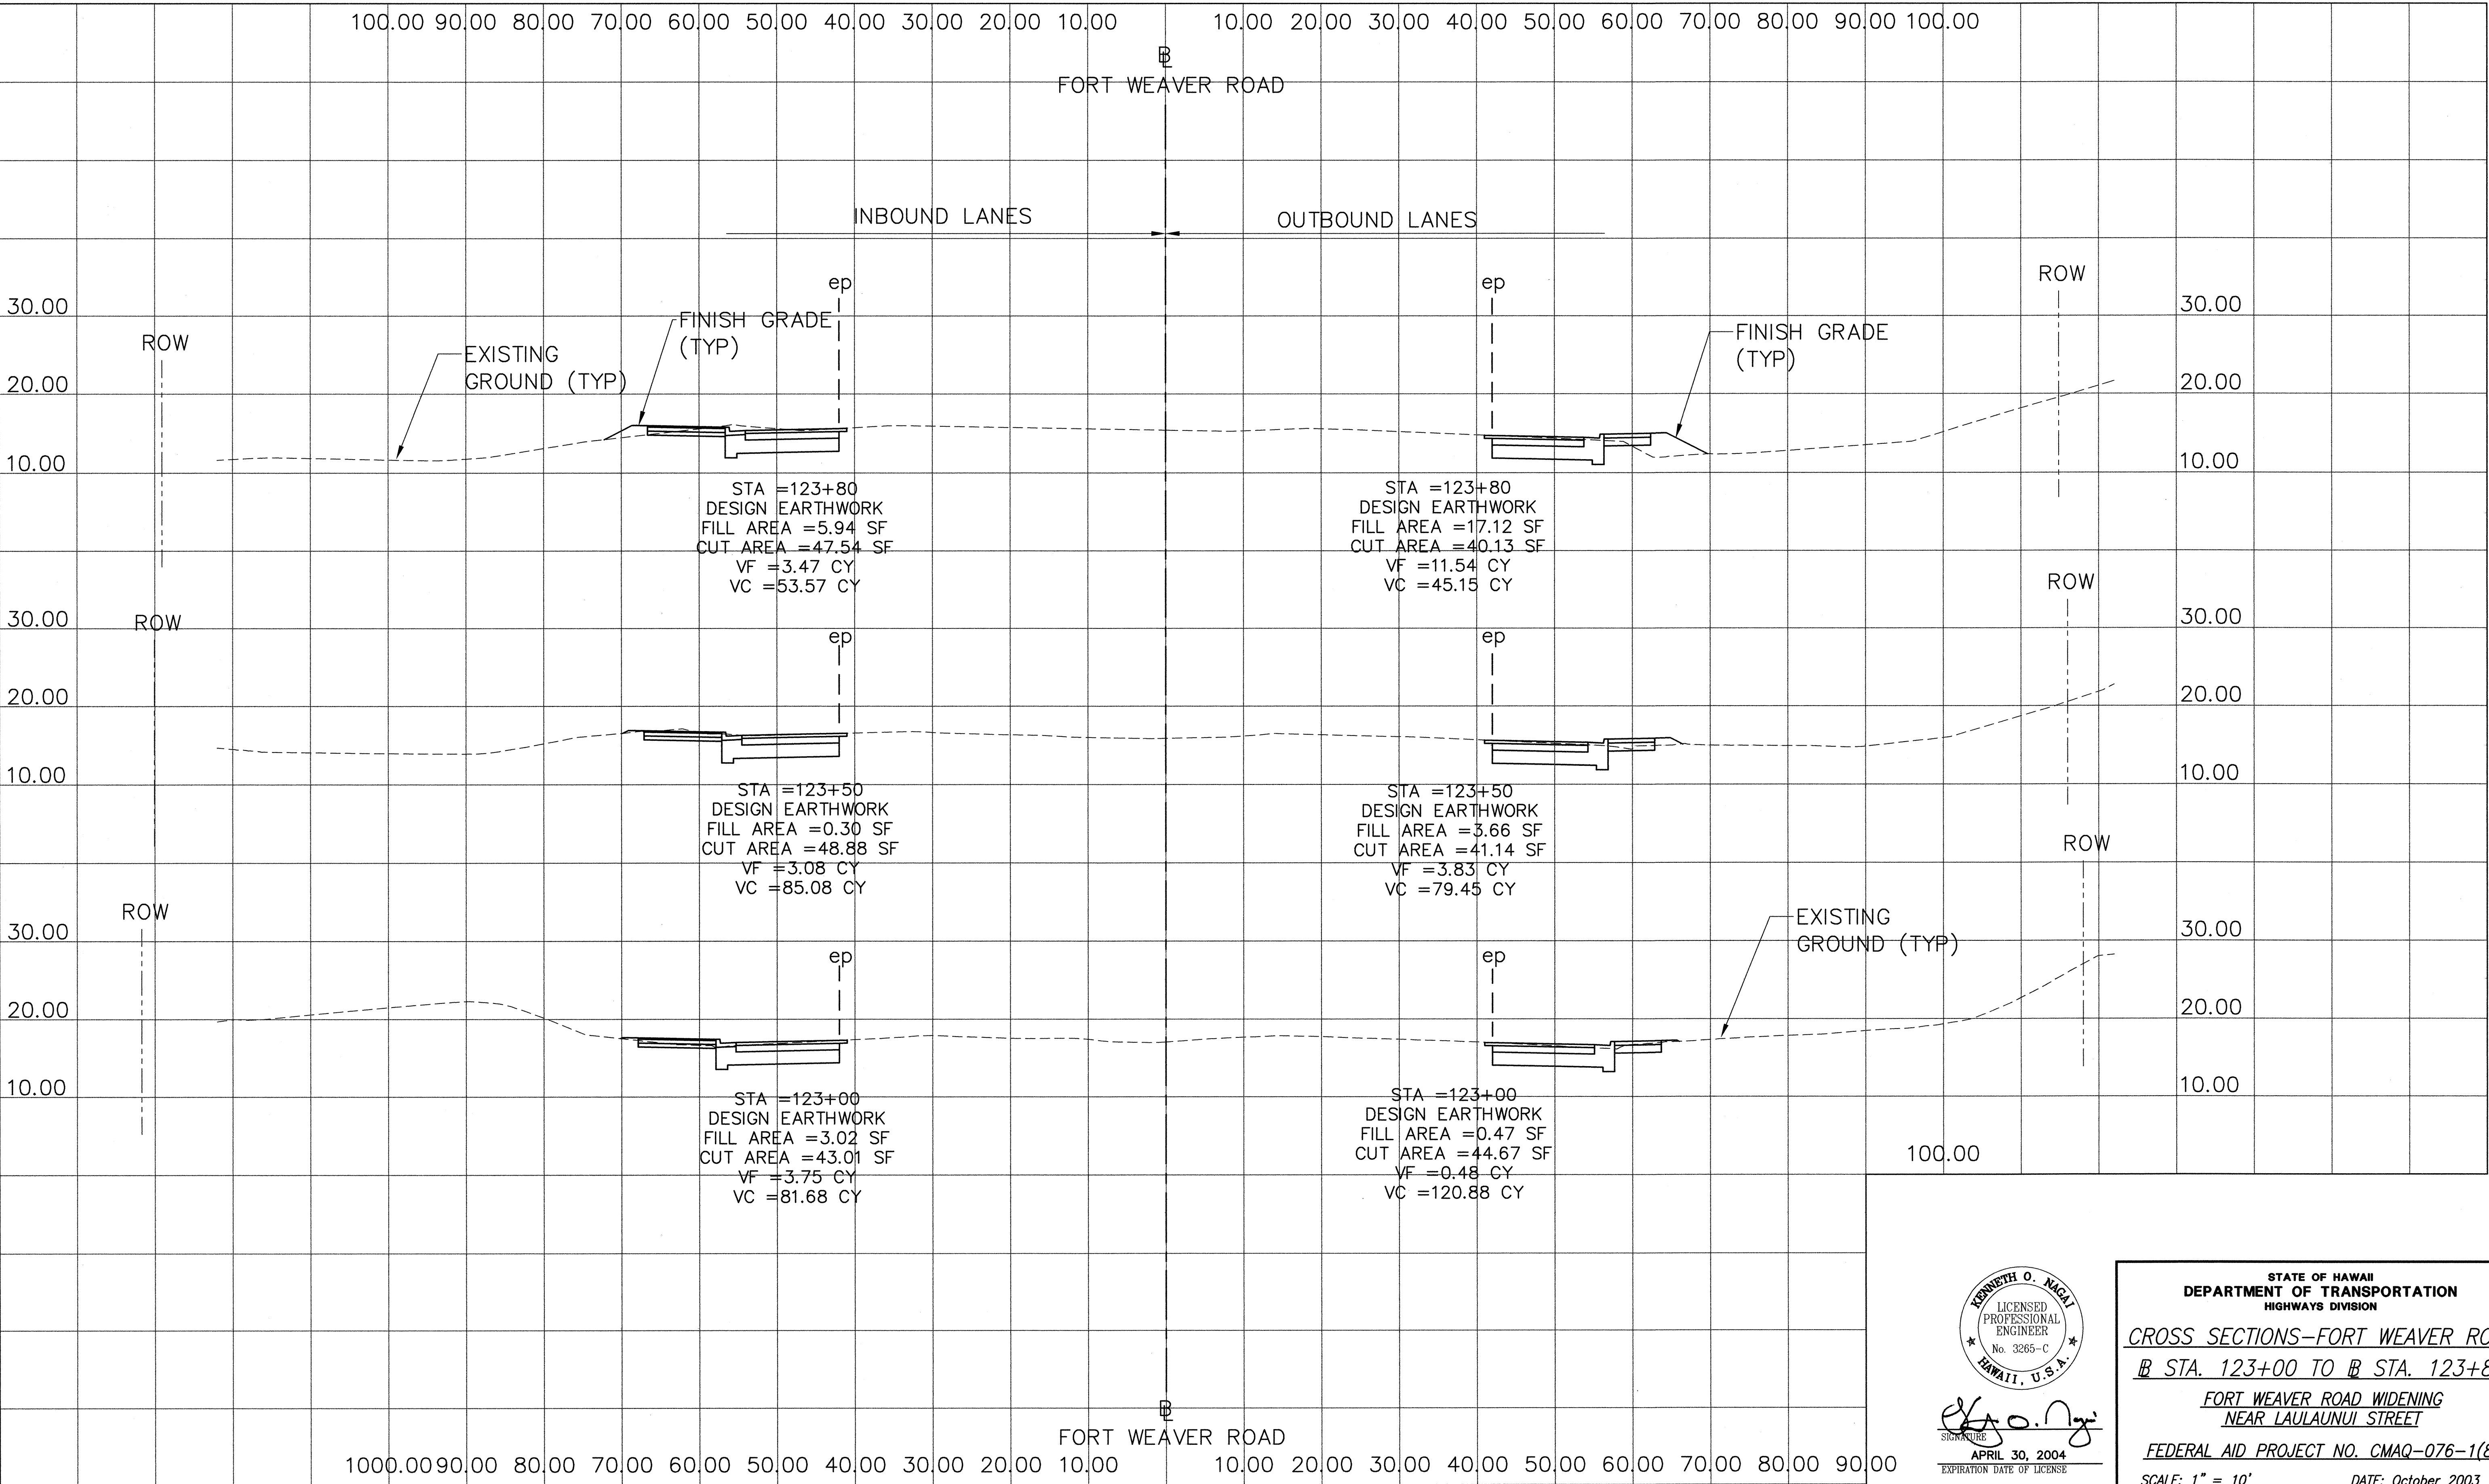

| | |
|-------------------|------|
| SURVEY PLOTTED BY | DATE |
| DRAWN BY | |
| TRACED BY | |
| DESIGNED BY | |
| CHECKED BY | |
| NOTE BOOK | |
| No. | |

KENNETH O. NAGAI
LICENSED PROFESSIONAL ENGINEER
No. 3265-C
HAWAII, U.S.A.

[Signature]
APRIL 30, 2004
EXPIRATION DATE OF LICENSE


THIS WORK WAS PREPARED BY ME OR UNDER MY SUPERVISION

STATE OF HAWAII
DEPARTMENT OF TRANSPORTATION
HIGHWAYS DIVISION


CROSS SECTIONS-FORT WEAVER ROAD
STA. 123+00 TO STA. 123+80
FORT WEAVER ROAD WIDENING
NEAR LAULAUNUI STREET
FEDERAL AID PROJECT NO. CMAQ-076-1(8)
SCALE: 1" = 10'
DATE: October 2003

SHEET No. 20 OF 24 SHEETS

| FED. ROAD DIST. NO. | STATE | FED. AID PROJ. NO. | FISCAL YEAR | SHEET NO. | TOTAL SHEETS |
|---------------------|-------|--------------------|-------------|-----------|--------------|
| HAWAII | HAW. | CMAQ-076-1(8) | 2004 | 126 | 127 |

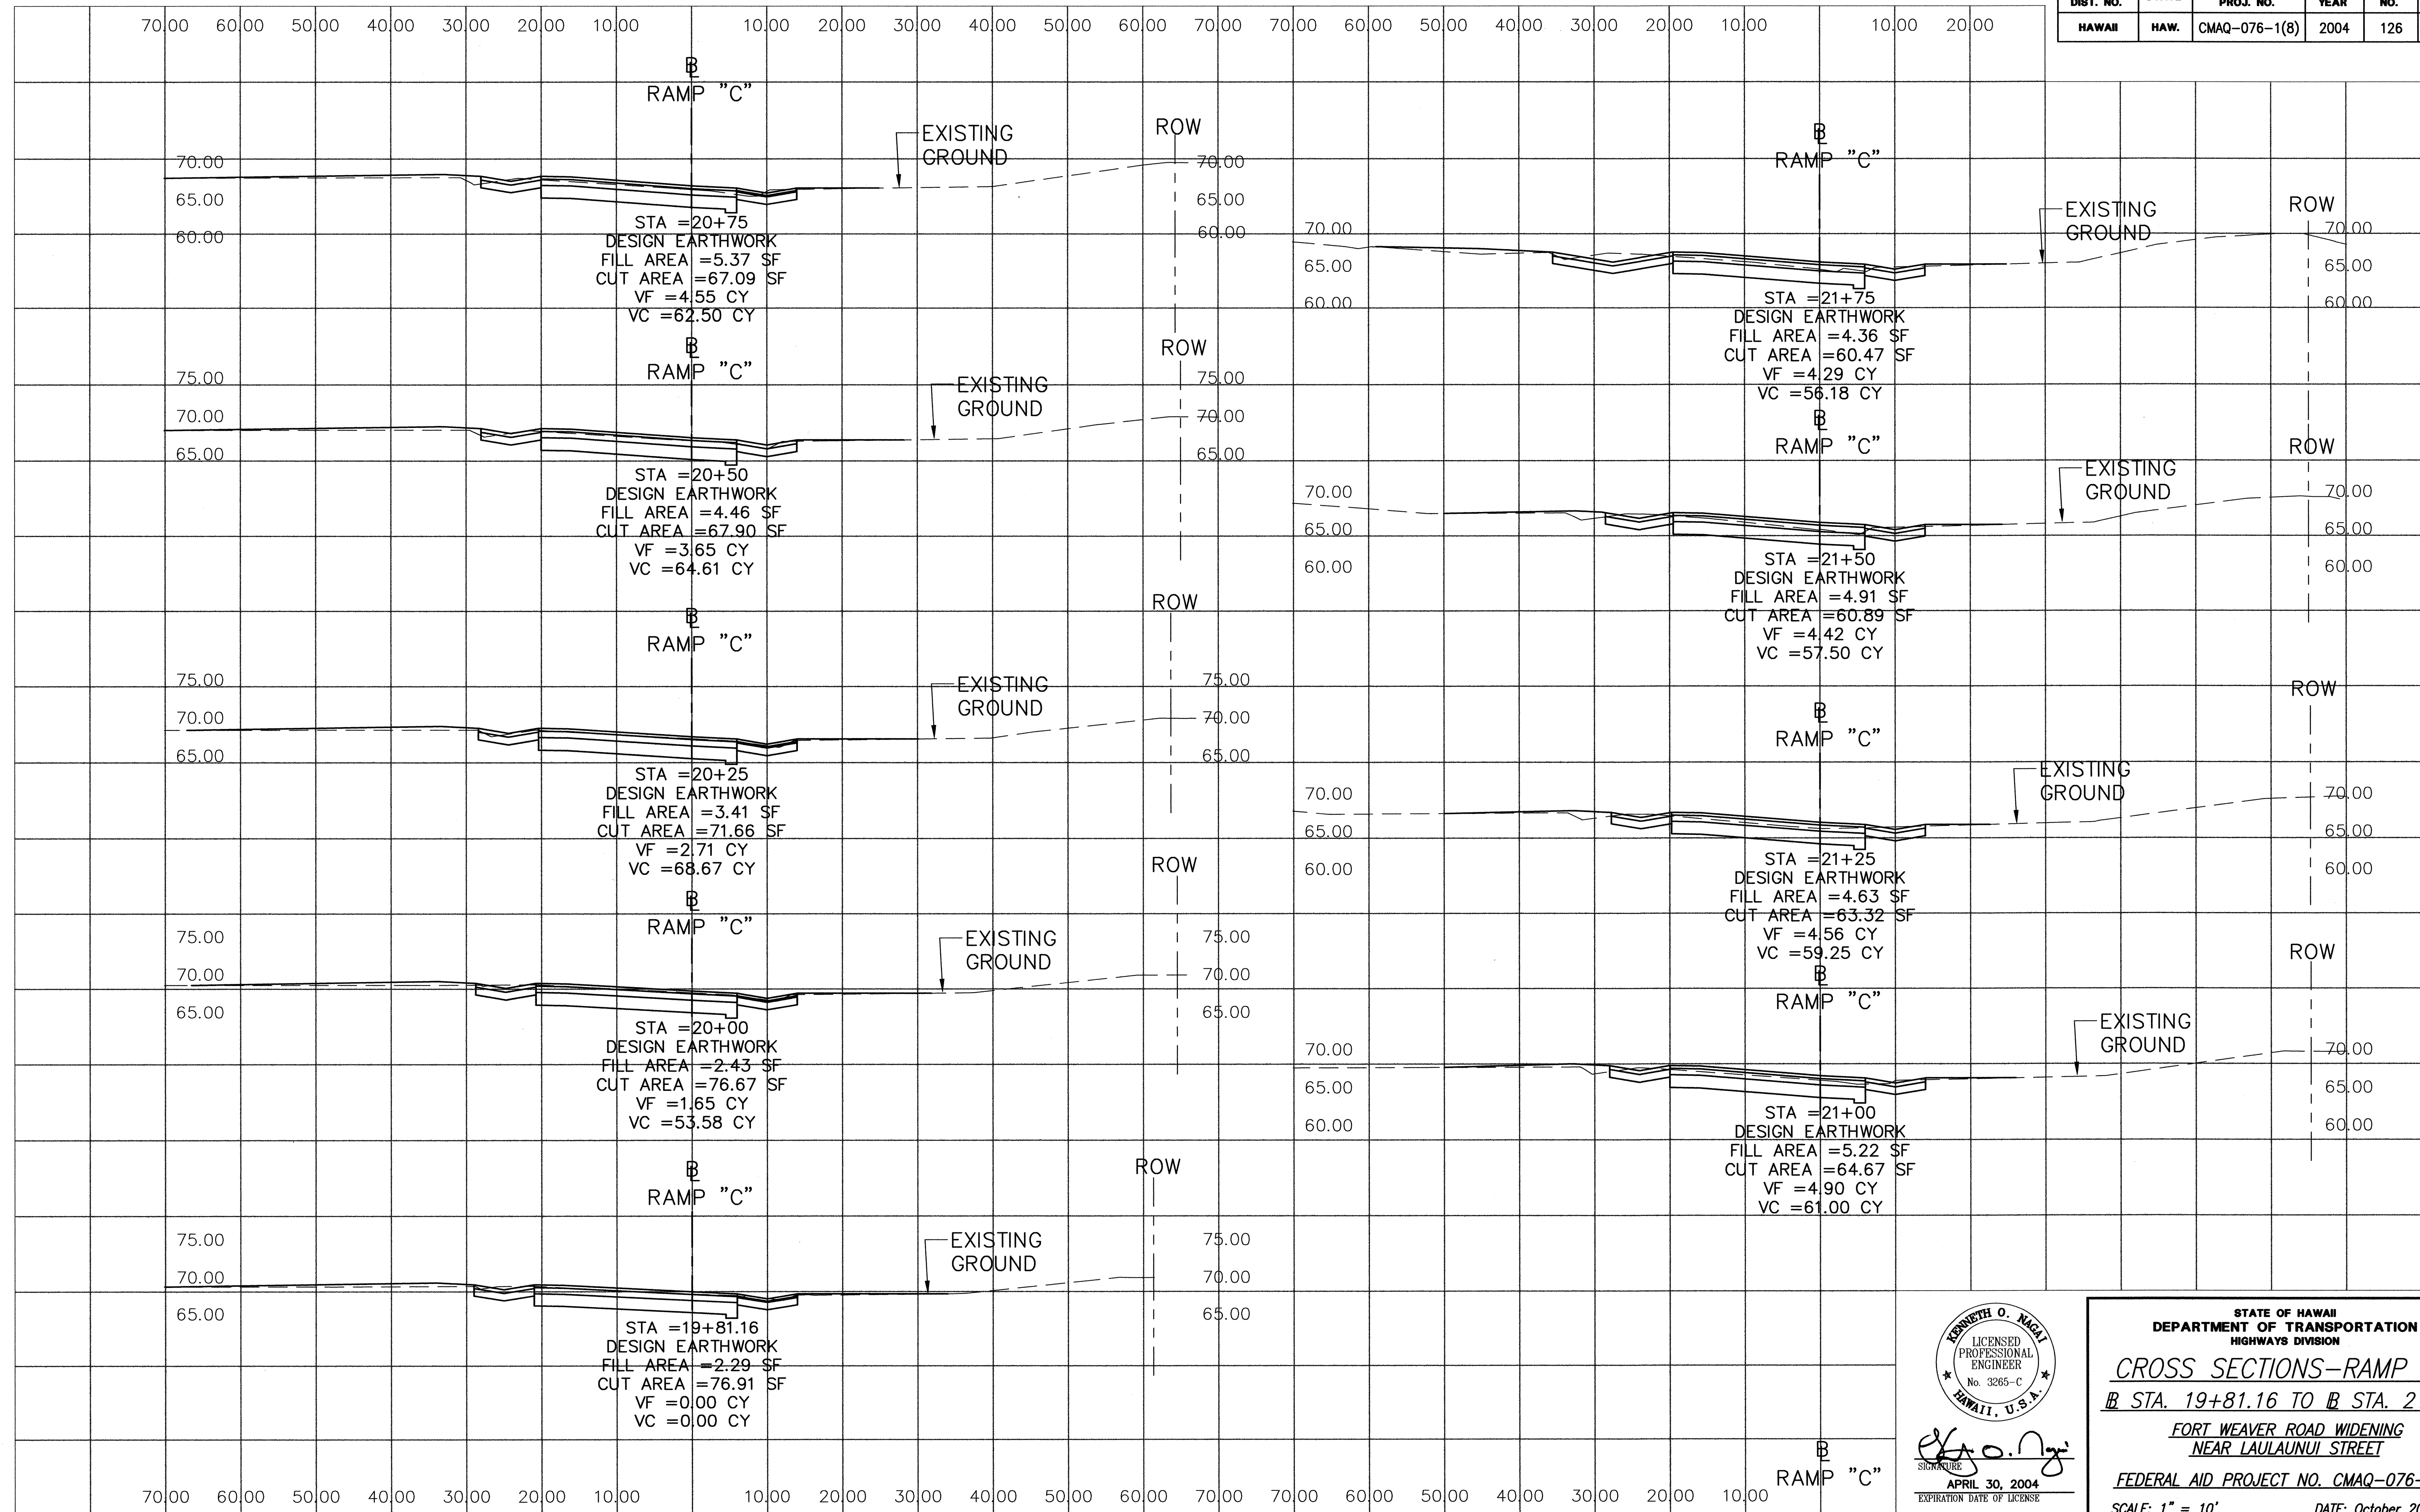


| | |
|-------------------|------|
| SURVEY PLOTTED BY | DATE |
| DRAWN BY | |
| DESIGNED BY | |
| CHECKED BY | |
| NO. | |

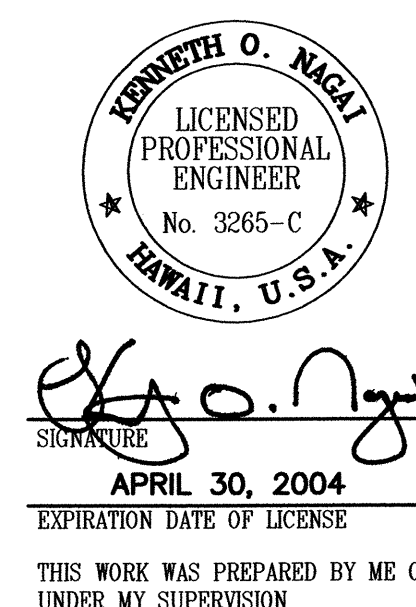

STATE OF HAWAII
DEPARTMENT OF TRANSPORTATION
HIGHWAYS DIVISION

CROSS SECTIONS-RAMP "C"
B STA. 19+81.16 TO B STA. 21+75
FORT WEAVER ROAD WIDENING
NEAR LAULAUNUI STREET
FEDERAL AID PROJECT NO. CMAQ-076-1(8)
SCALE: 1" = 10' DATE: October 2003
SHEET No. 23 OF 24 SHEETS

| FED. ROAD DIST. NO. | STATE | FED. AID PROJ. NO. | FISCAL YEAR | SHEET NO. | TOTAL SHEETS |
|---------------------|-------|--------------------|-------------|-----------|--------------|
| HAWAII | HAW. | CMAQ-076-1(8) | 2004 | 127 | 127 |

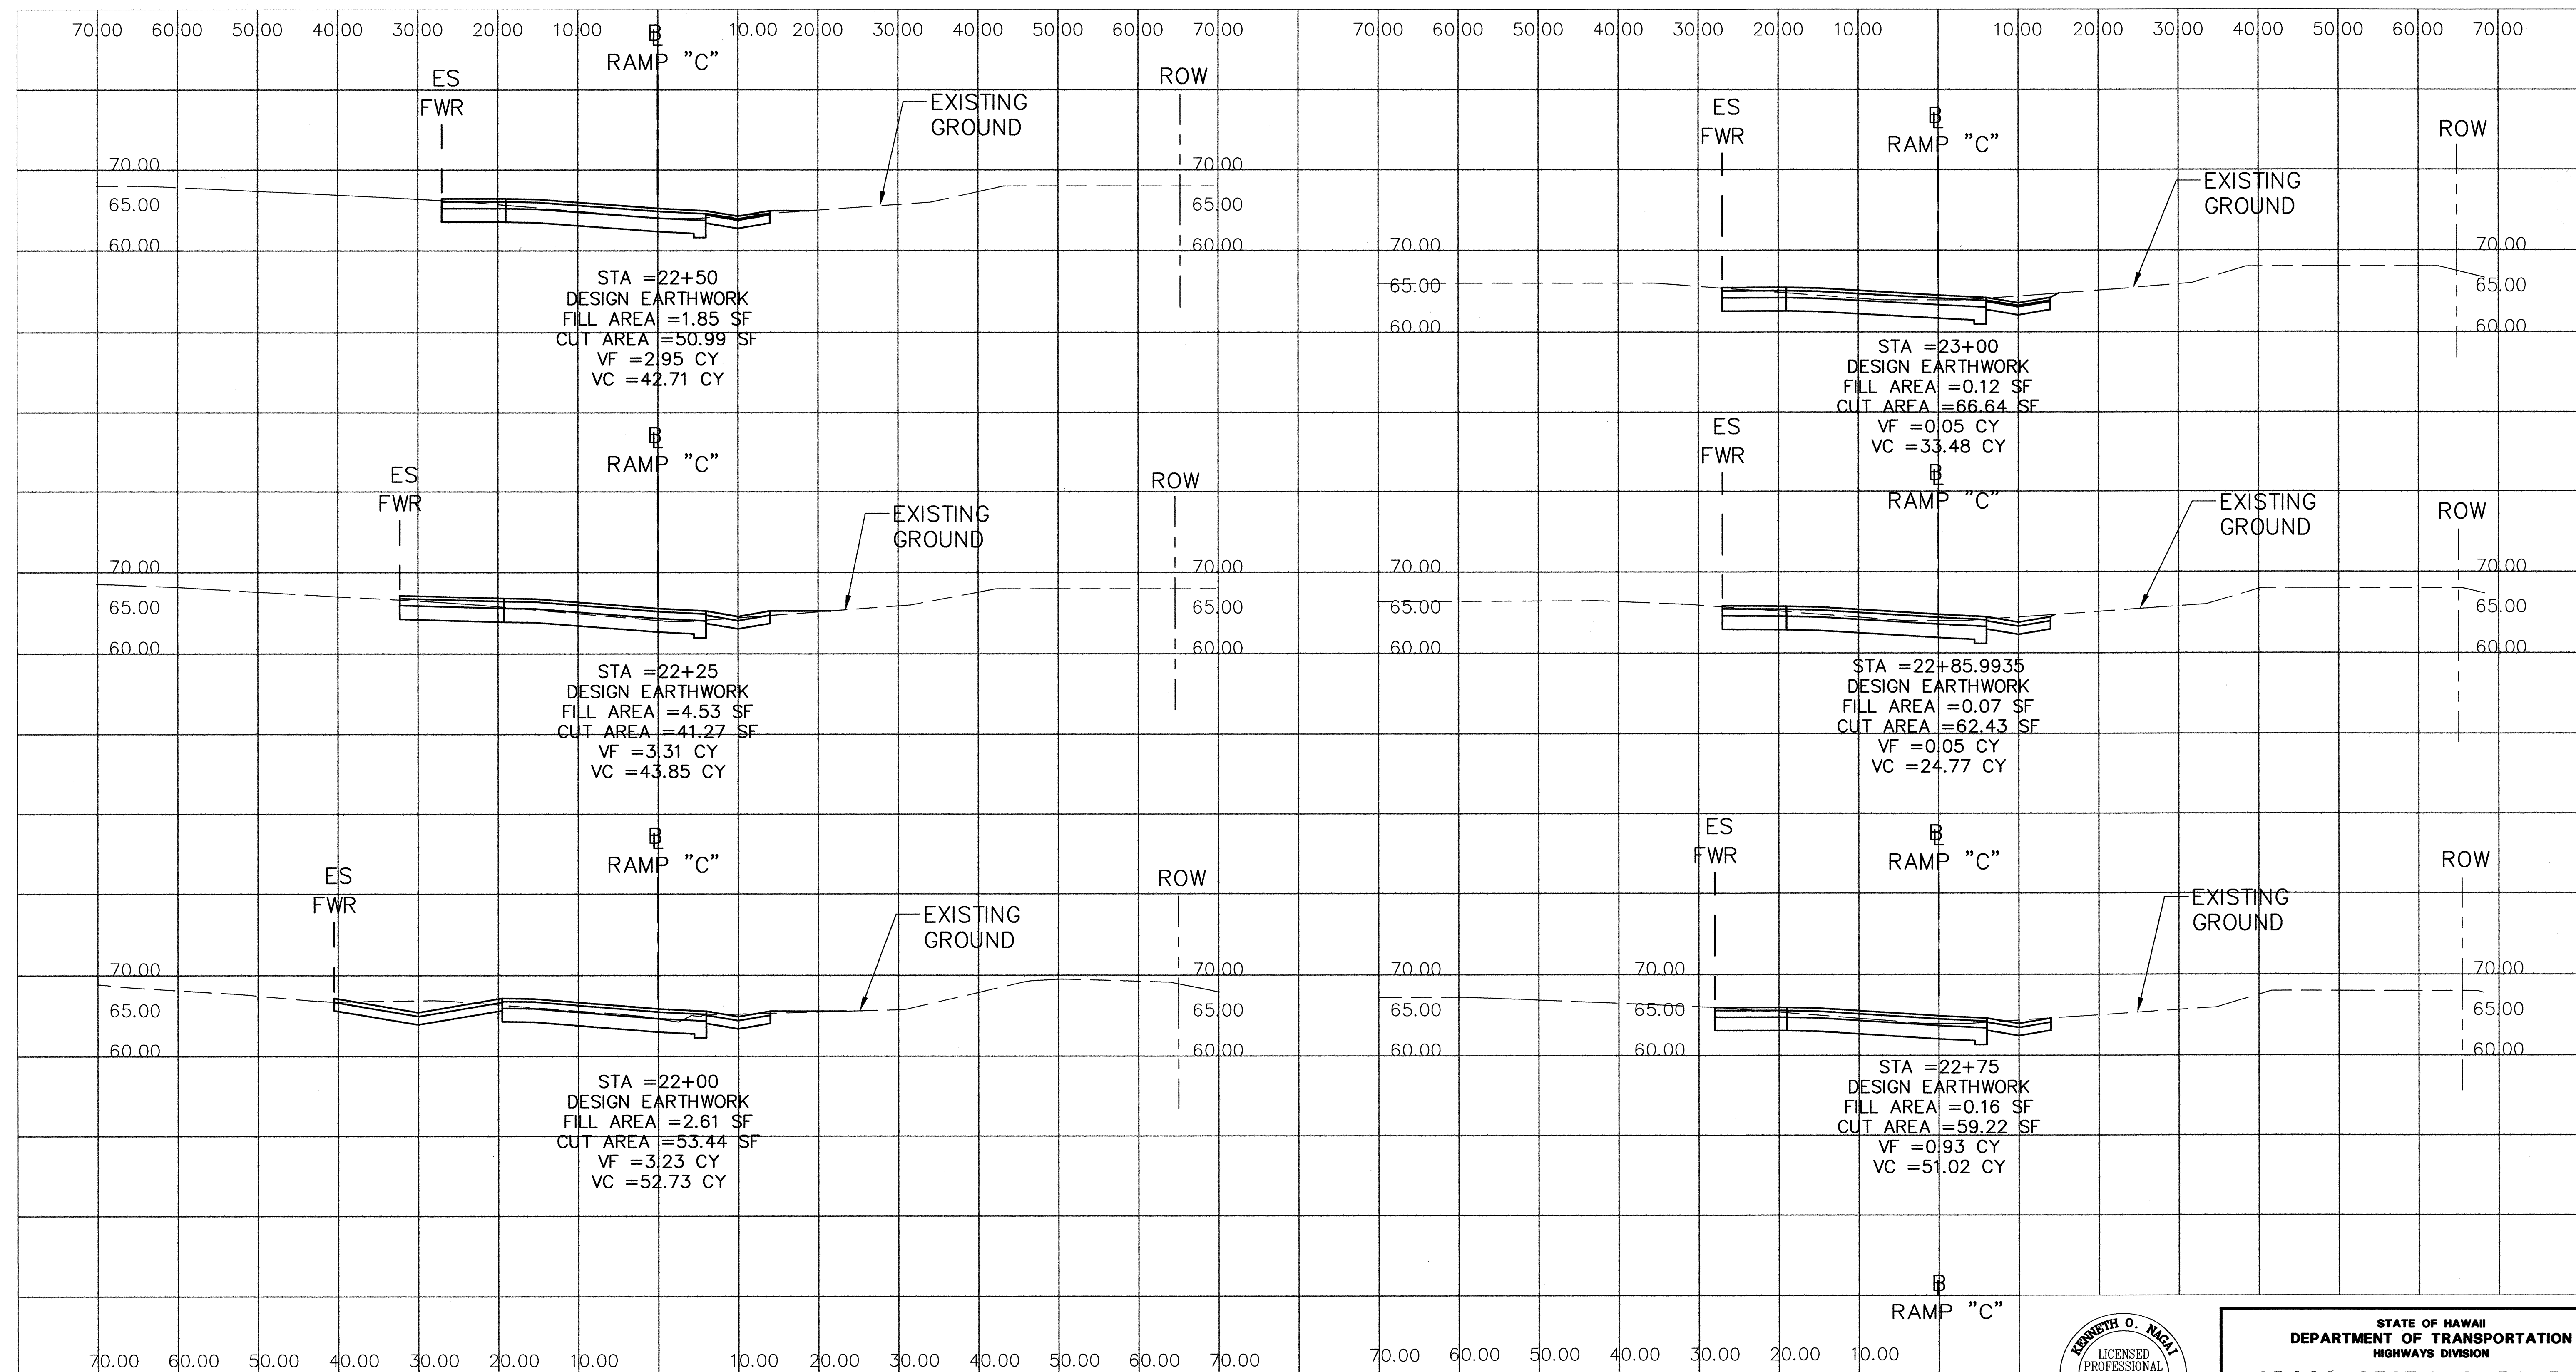

| | |
|-------------------|------|
| SURVEY PLOTTED BY | DATE |
| DRAWN BY | " " |
| DESIGNED BY | " " |
| CHECKED BY | " " |
| ORIGINAL PLAN | No. |

KENNETH O. NAGAI
 LICENSED PROFESSIONAL ENGINEER
 No. 3285-C
 HAWAII, U.S.A.
 SIGNATURE
 APRIL 30, 2004
 EXPIRATION DATE OF LICENSE
 THIS WORK WAS PREPARED BY ME OR UNDER MY SUPERVISION

STATE OF HAWAII
 DEPARTMENT OF TRANSPORTATION
 HIGHWAYS DIVISION
CROSS SECTIONS-RAMP "C"
 B STA. 22+00 To B STA. 23+00
 FORT WEAVER ROAD WIDENING
 NEAR LAULAUNUI STREET
 FEDERAL AID PROJECT NO. CMAQ-076-1(8)
 SCALE: 1" = 10' DATE: October 2003
 SHEET No. 24 OF 24 SHEETS