


INDEX TO DRAWINGS	
SHEET NO.	DESCRIPTION
1	TITLE SHEET
2	STANDARD PLANS SUMMARY
3 - 7	GENERAL NOTES AND LEGEND
8 - 15	TYPICAL ROAD SECTIONS
16	SECTIONS AND MISCELLANEOUS DETAILS
17	BUS PAD PAVEMENT SECTION
18 - 23	ROADWAY PLANS
24, 25	INTERSECTION DETAIL PLANS
26, 27	CURB RETURN GRADES AND CURB RAMP DETAILS
28, 29	SUPERELEVATION DIAGRAMS & PROFILE
30, 31	RAMP AND ROAD ELEVATIONS
32	DRAINAGE SUMMARY
33 - 35	DRAINAGE PLANS
36, 37	DRAIN LINE PROFILES
38 - 40	DRAINAGE DETAILS
41	GAS LINE RELOCATION & DETAIL
42, 43	RETAINING WALL ELEVATIONS
44 - 46	STRUCTURAL PLANS
47 - 53	GUARDRAIL DETAILS
54 - 60	SIGNING & PAVEMENT MARKING LEGEND, NOTES, PLANS, & DETAILS
61	TRAFFIC SUMMARIES
62 - 84	ELECTRICAL PLANS
85	WORK ZONE SIGNING PLAN, NOTES & DETAILS
86 - 92	CONCRETE BARRIER INSTALLATION AND TEMPORARY RESTRIPIING PLAN
93, 94	PORTABLE CONCRETE BARRIER DETAILS
95	TEMPORARY BUS STOP RELOCATION
96	RAMP CLOSURE DETOUR PLAN
97, 98	BUS SHELTER DETAILS
99 - 103	BORING LOGS
104 - 127	ROAD CROSS SECTIONS

128 5-1 PLANTING PLAN

DATE OCT. 2003
PHONE 692-7570
HWY-DD
MANAGED BY
DESIGNED BY
KN CONSULTING SERVICES, INC.




17 5-1 ROADWAY PLAN
RAMP "A", "C" & "C-1"

STATE OF HAWAII
DEPARTMENT OF TRANSPORTATION
HIGHWAYS DIVISION
HONOLULU, HAWAII
"AS-BUILT"
PLANS FOR
FORT WEAVER ROAD WIDENING
NEAR LAULAUNUI STREET
FEDERAL-AID PROJECT NO. CMAQ-076-1(8)

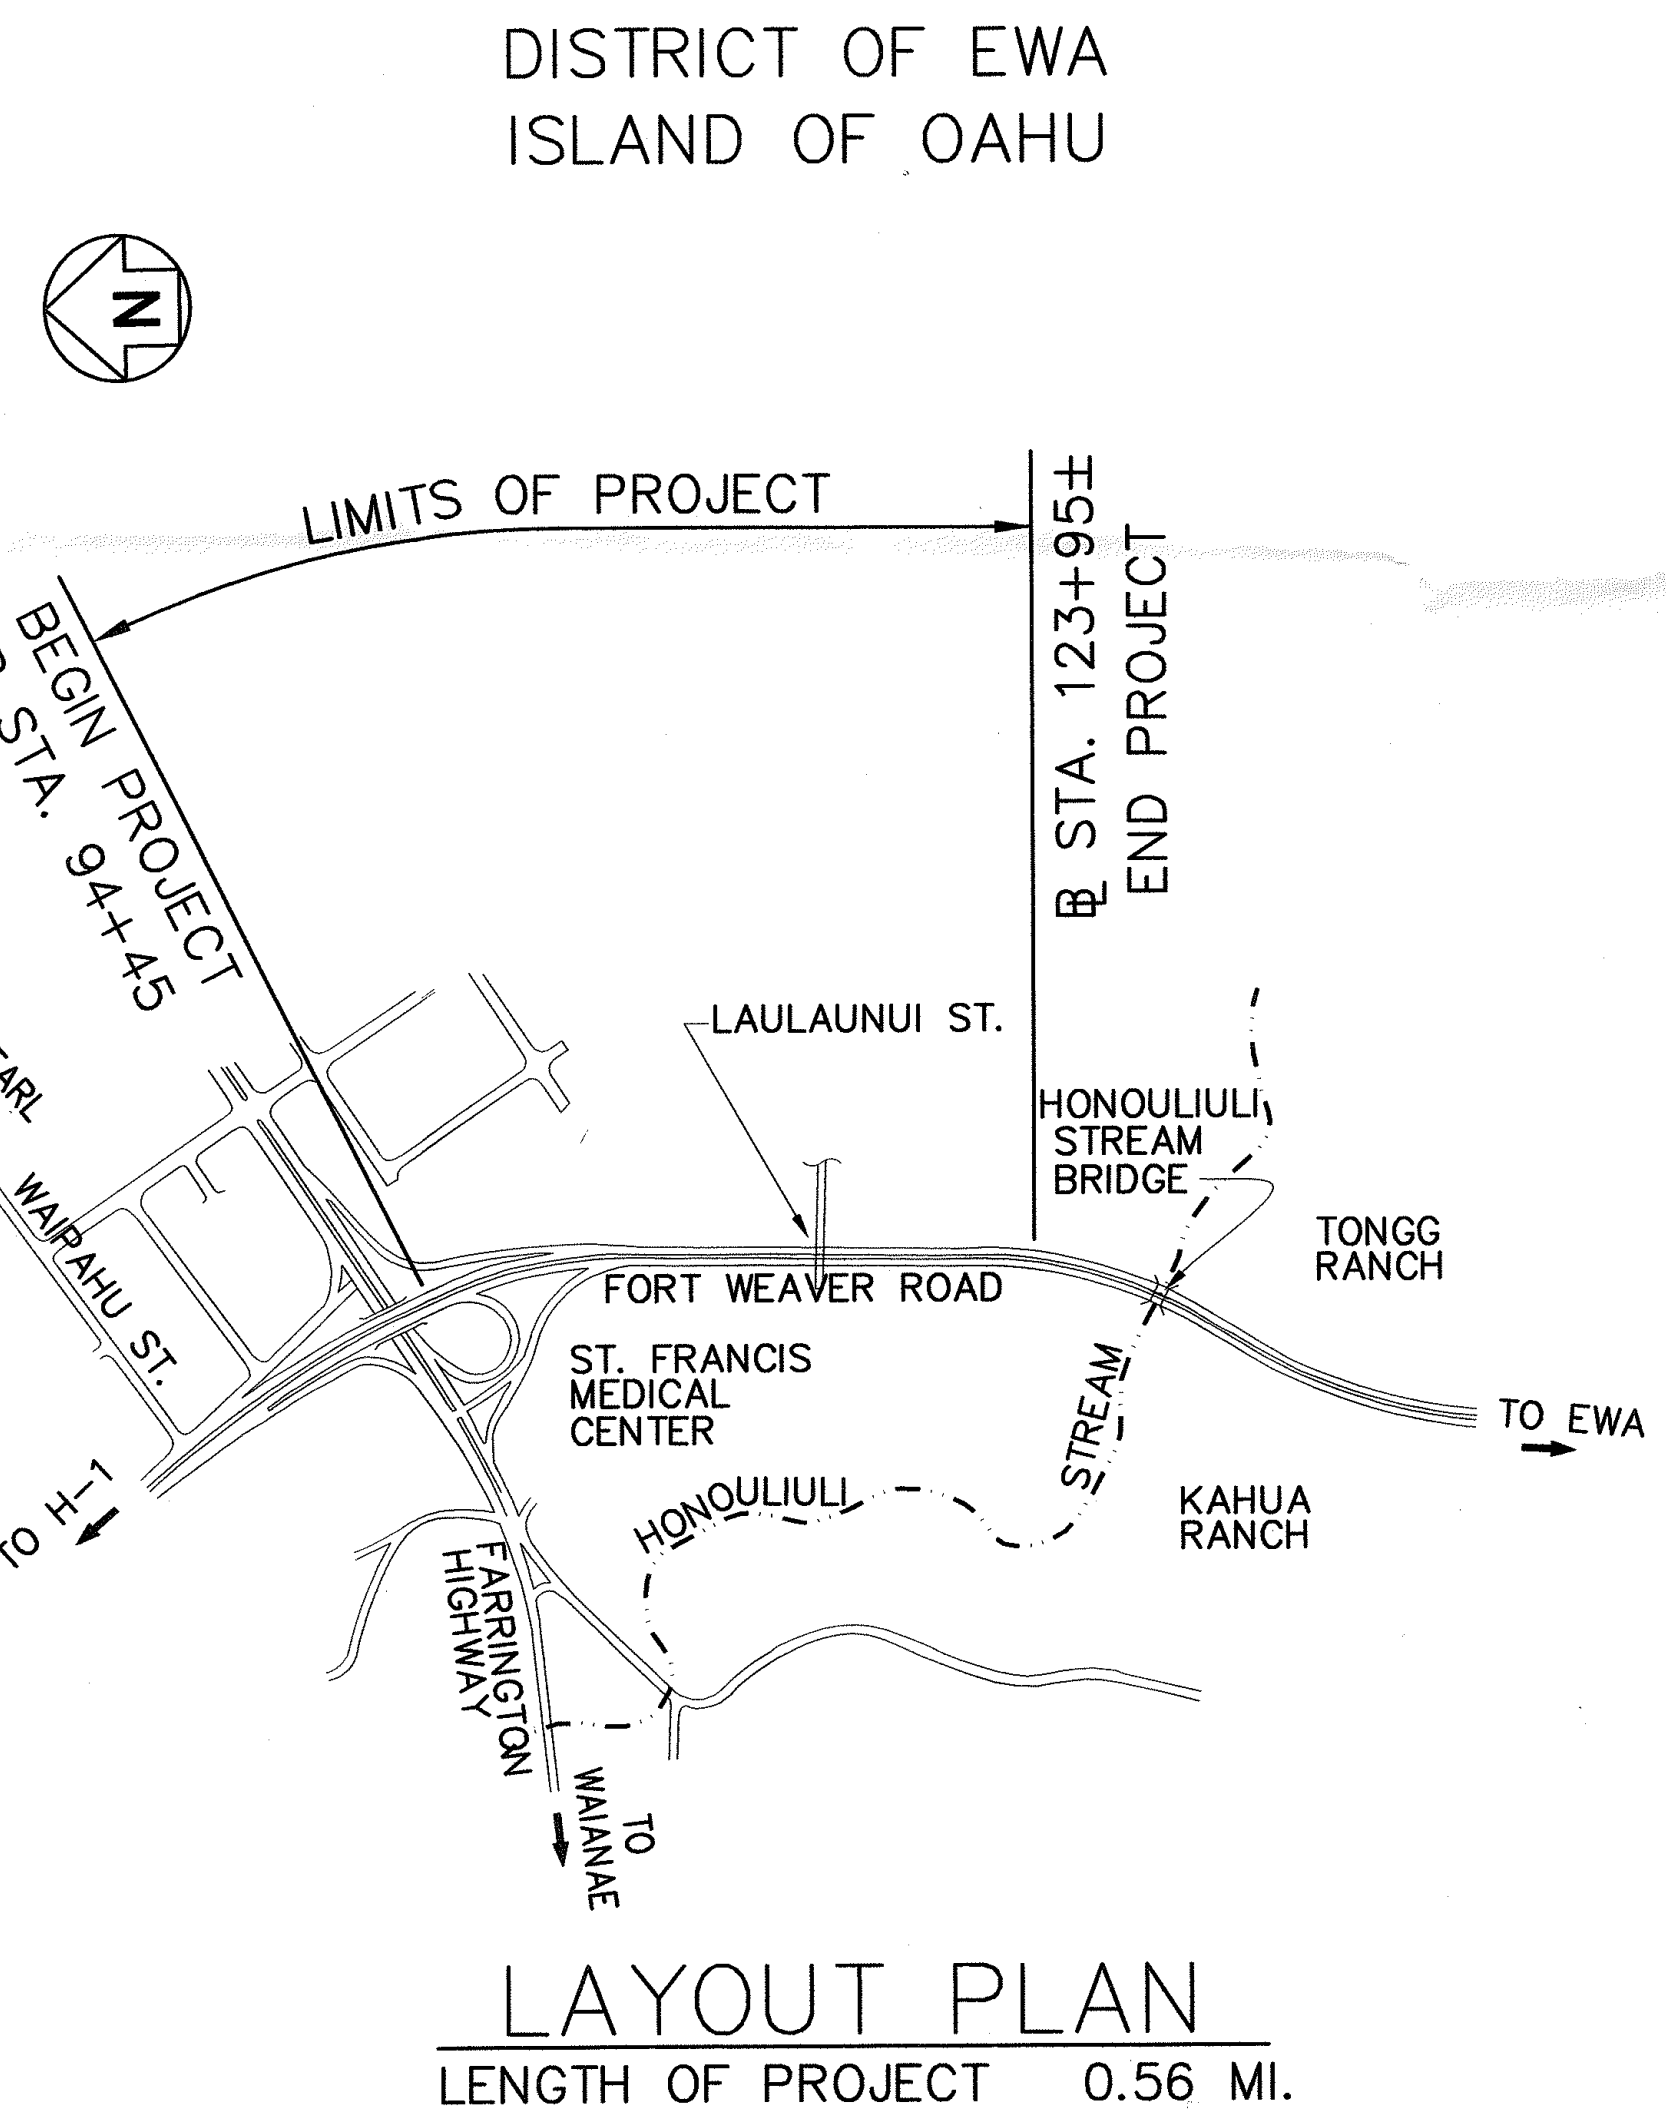

LAYOUT PLAN
LENGTH OF PROJECT 0.56 MI.
GRAPHIC SCALE IN THOUSAND FEET

FED. ROAD DIST. NO.	STATE	FED. AID PROJ. NO.	FISCAL YEAR	SHEET NO.	TOTAL SHEETS
HAWAII	HAW.	CMAQ-076-1(8)	2004	1	127

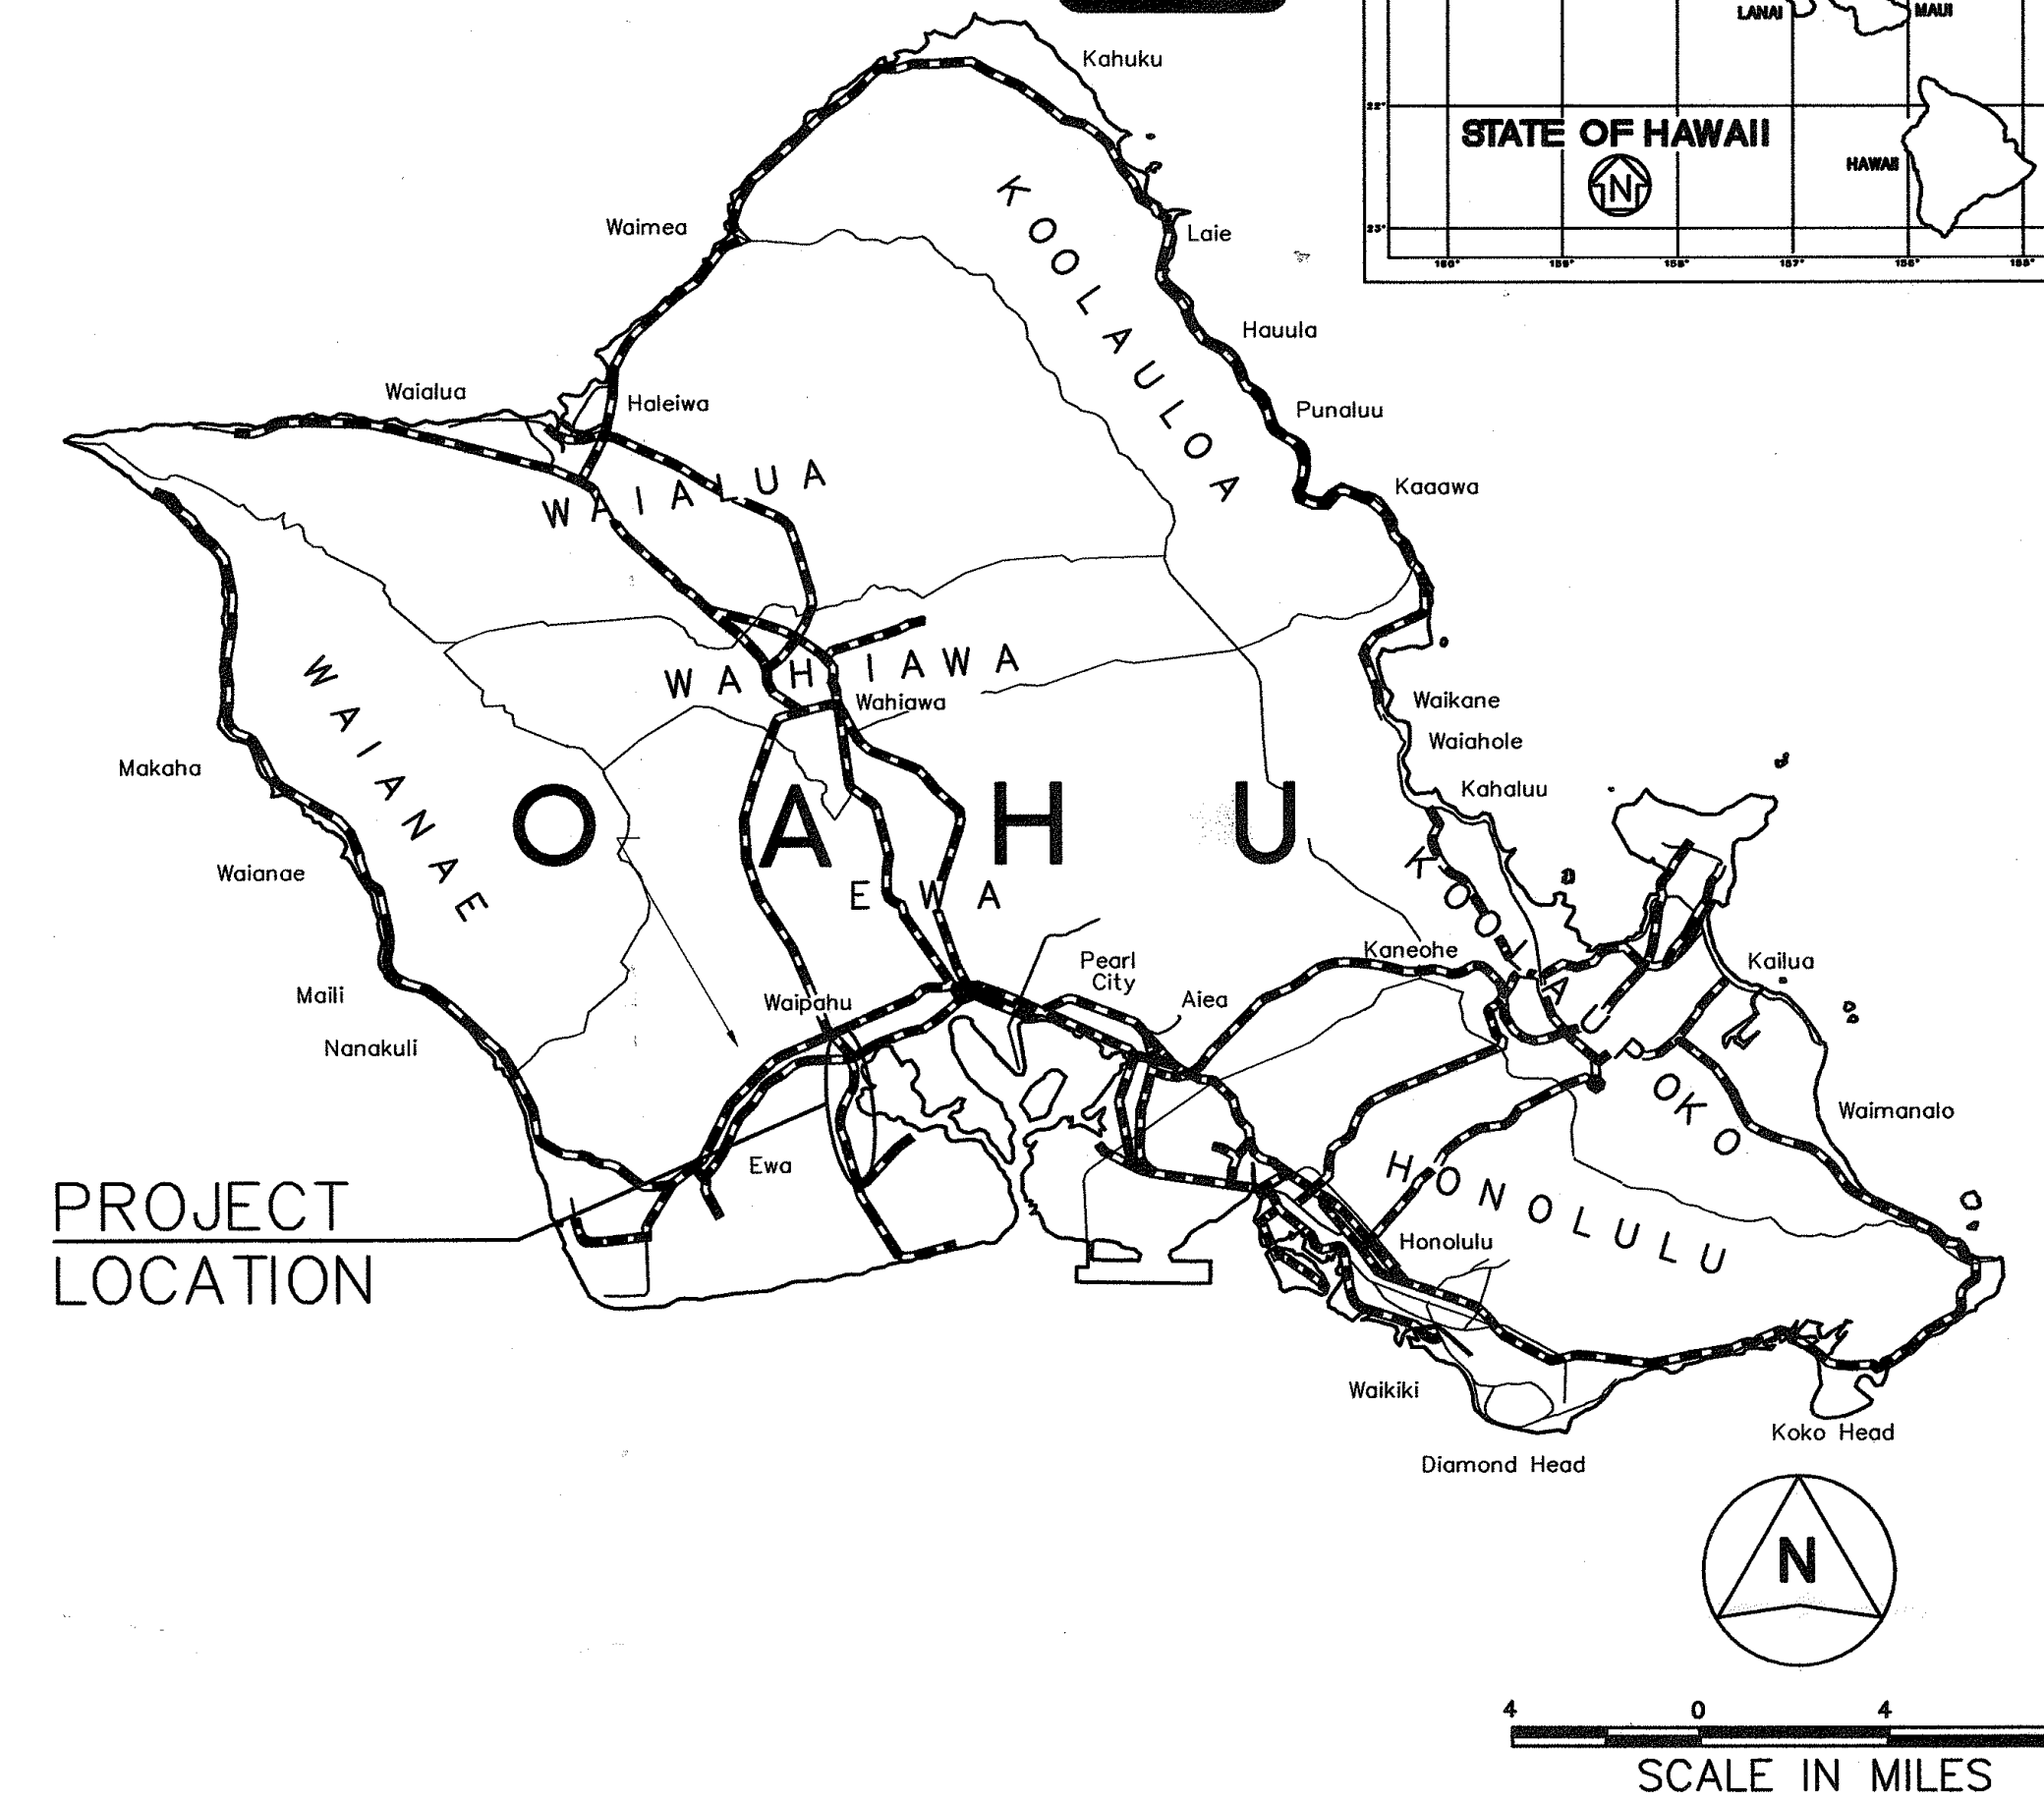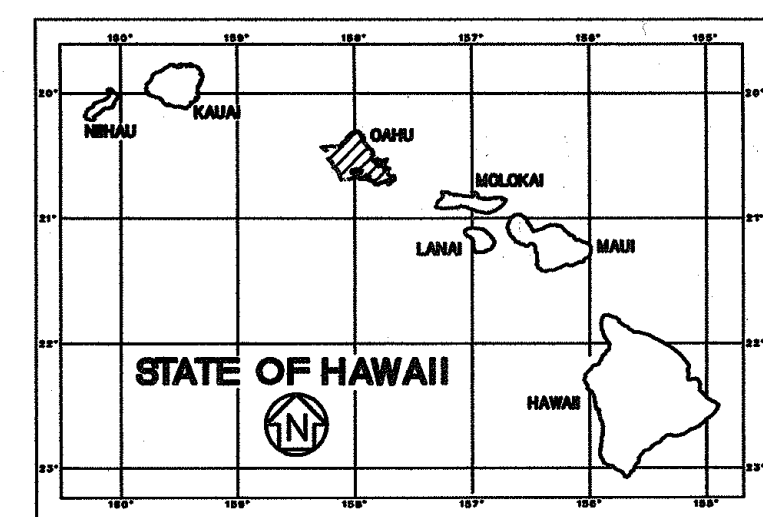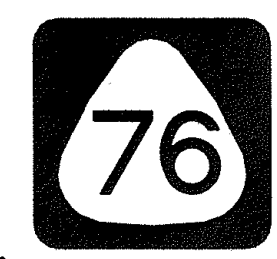

FEDERAL AID PROJECTS PREVIOUSLY CONSTRUCTED OR UNDER CONSTRUCTION
MILE POST 5.94 TO MILE POST 5.38

DESIGN DESIGNATION	
ADT (2002)	59,600
ADT (2022)	95,300
DHV	7,100
D	65/35
T	2.5%
V	50 MPH (NORTH OF LAULAUNUI ST.)
V	40 MPH (SOUTH OF LAULAUNUI ST.)

CHANGES MADE DURING CONSTRUCTION HAVE BEEN INCORPORATED ON THESE PLANS EXCEPT CHANGES IN THE ORIGINAL THEORETICAL QUANTITIES. FOR ACTUAL QUANTITIES, REFER TO PROJECT LEDGER AND/OR COMPUTATION BOOK.

RESIDENT ENGINEER
DATE

DEPARTMENT OF TRANSPORTATION
STATE OF HAWAII
APPROVED:
DIR. OF TRANSPORTATION
DATE 11.28.03