


FED. ROAD DIST. NO.	STATE	FEDERAL AID PROJ. NO.	FISCAL YEAR	SHEET NO.	TOTAL SHEETS
HAWAII	HAW.	CMAQ-076-1(9)	2006	26	160

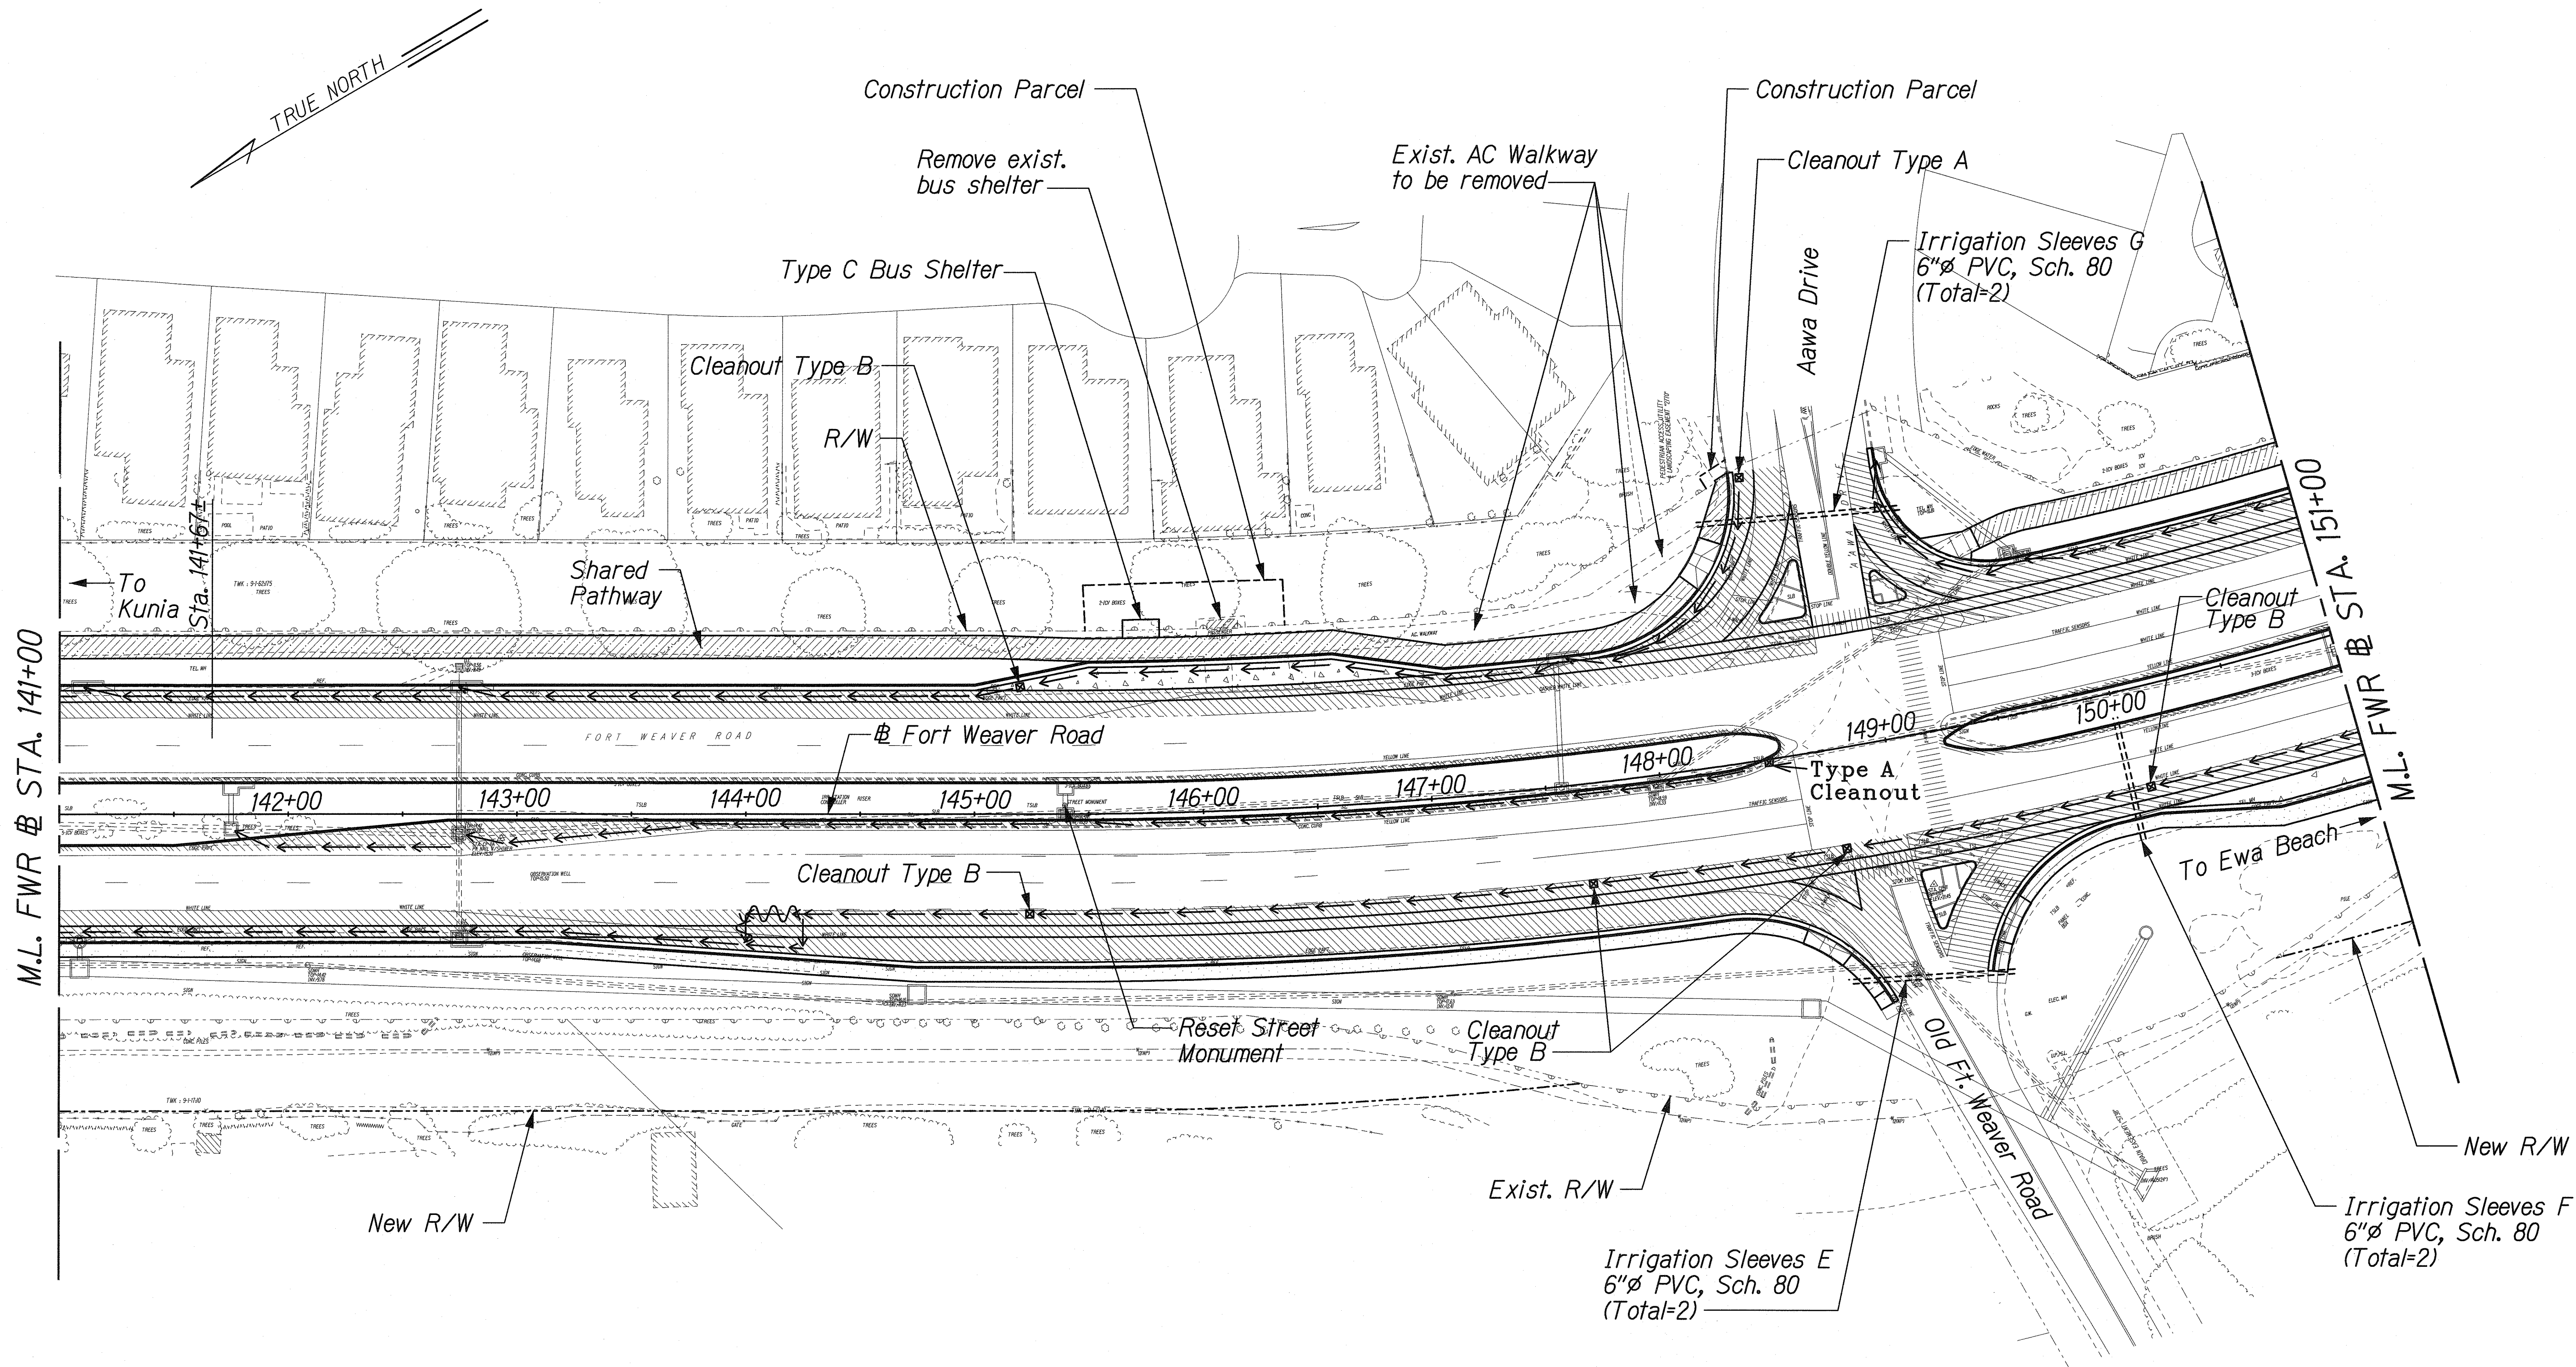

DESIGNED BY	DATE
TRACED BY	
NOTED BY	
CHECKED BY	
IN CHARGE	

\\FORT-WEAVER-ROAD\PACKAGE 1\ROAD\ROAD3.dgn

LEGEND FOR AS-BUILT POSTINGS

Squiggly line for as-built deletion

Double line for as-built deletion

Roadway Text for as-built posting

THIS WORK WAS PREPARED BY ME OR UNDER MY SUPERVISION.

STATE OF HAWAII
DEPARTMENT OF TRANSPORTATION
HIGHWAYS DIVISION


ROADWAY PLAN
STA. 141+00 TO 151+00

FORT WEAVER ROAD WIDENING
VICINITY OF AAWA DRIVE TO GEIGER ROAD

Scale: 1" = 40' Date: Sept. 20, 2007

SHEET No. RI-3 OF 39 SHEETS

FED. ROAD DIST. NO.	STATE	FEDERAL AID PROJ. NO.	FISCAL YEAR	SHEET NO.	TOTAL SHEETS
HAWAII	HAW.	CMAQ-076-1(19)	2006	27	160

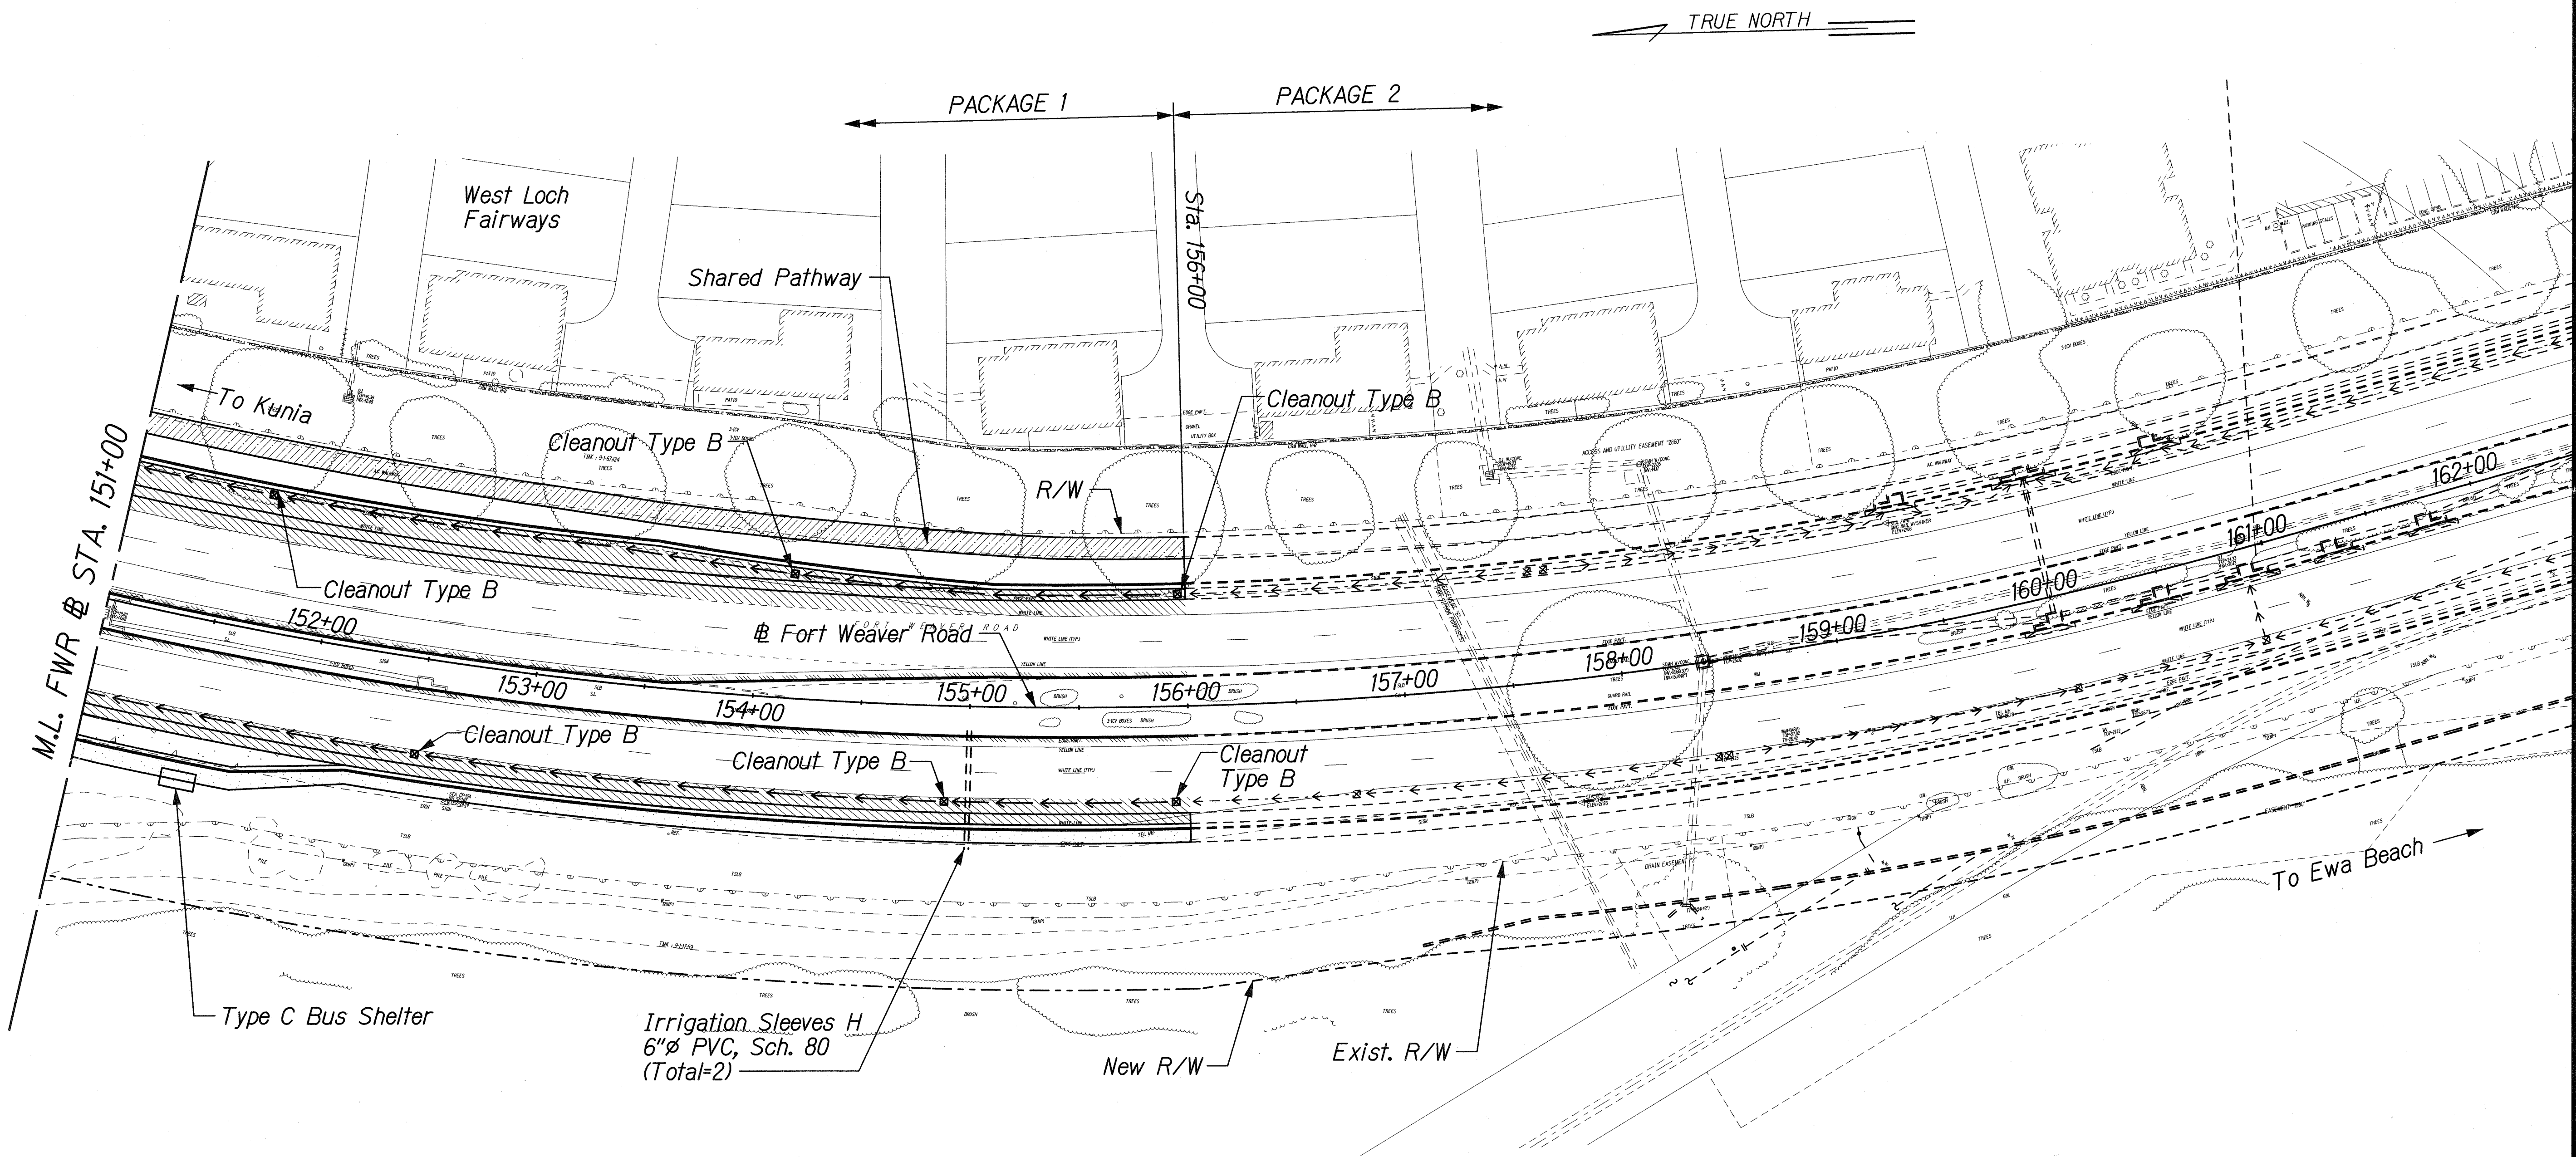

ORIGINAL PLAN	SURVEY PLOTTED BY	DATE
NOTE BOOK	DRAWN BY	
	CHECKED BY	
	DESIGNED BY	
	IN CHARGE	

J:\FORT WEAVER ROAD\PACKAGE 1\ROAD\ROAD4.dgn

THIS WORK WAS PREPARED BY ME OR UNDER MY SUPERVISION


Randall M. Urashki

STATE OF HAWAII
DEPARTMENT OF TRANSPORTATION
HIGHWAYS DIVISION


ROADWAY PLAN
STA. 151+00 TO 160+00
FORT WEAVER ROAD WIDENING
VICINITY OF AWA DRIVE TO GEIGER ROAD

Scale: 1" = 40' Date: Sept. 20, 2007


FED. ROAD DIST. NO.	STATE	FEDERAL AID PROJ. NO.	FISCAL YEAR	SHEET NO.	TOTAL SHEETS
HAWAII	HAW.	CMAQ-076-1(9)	2006	28	160

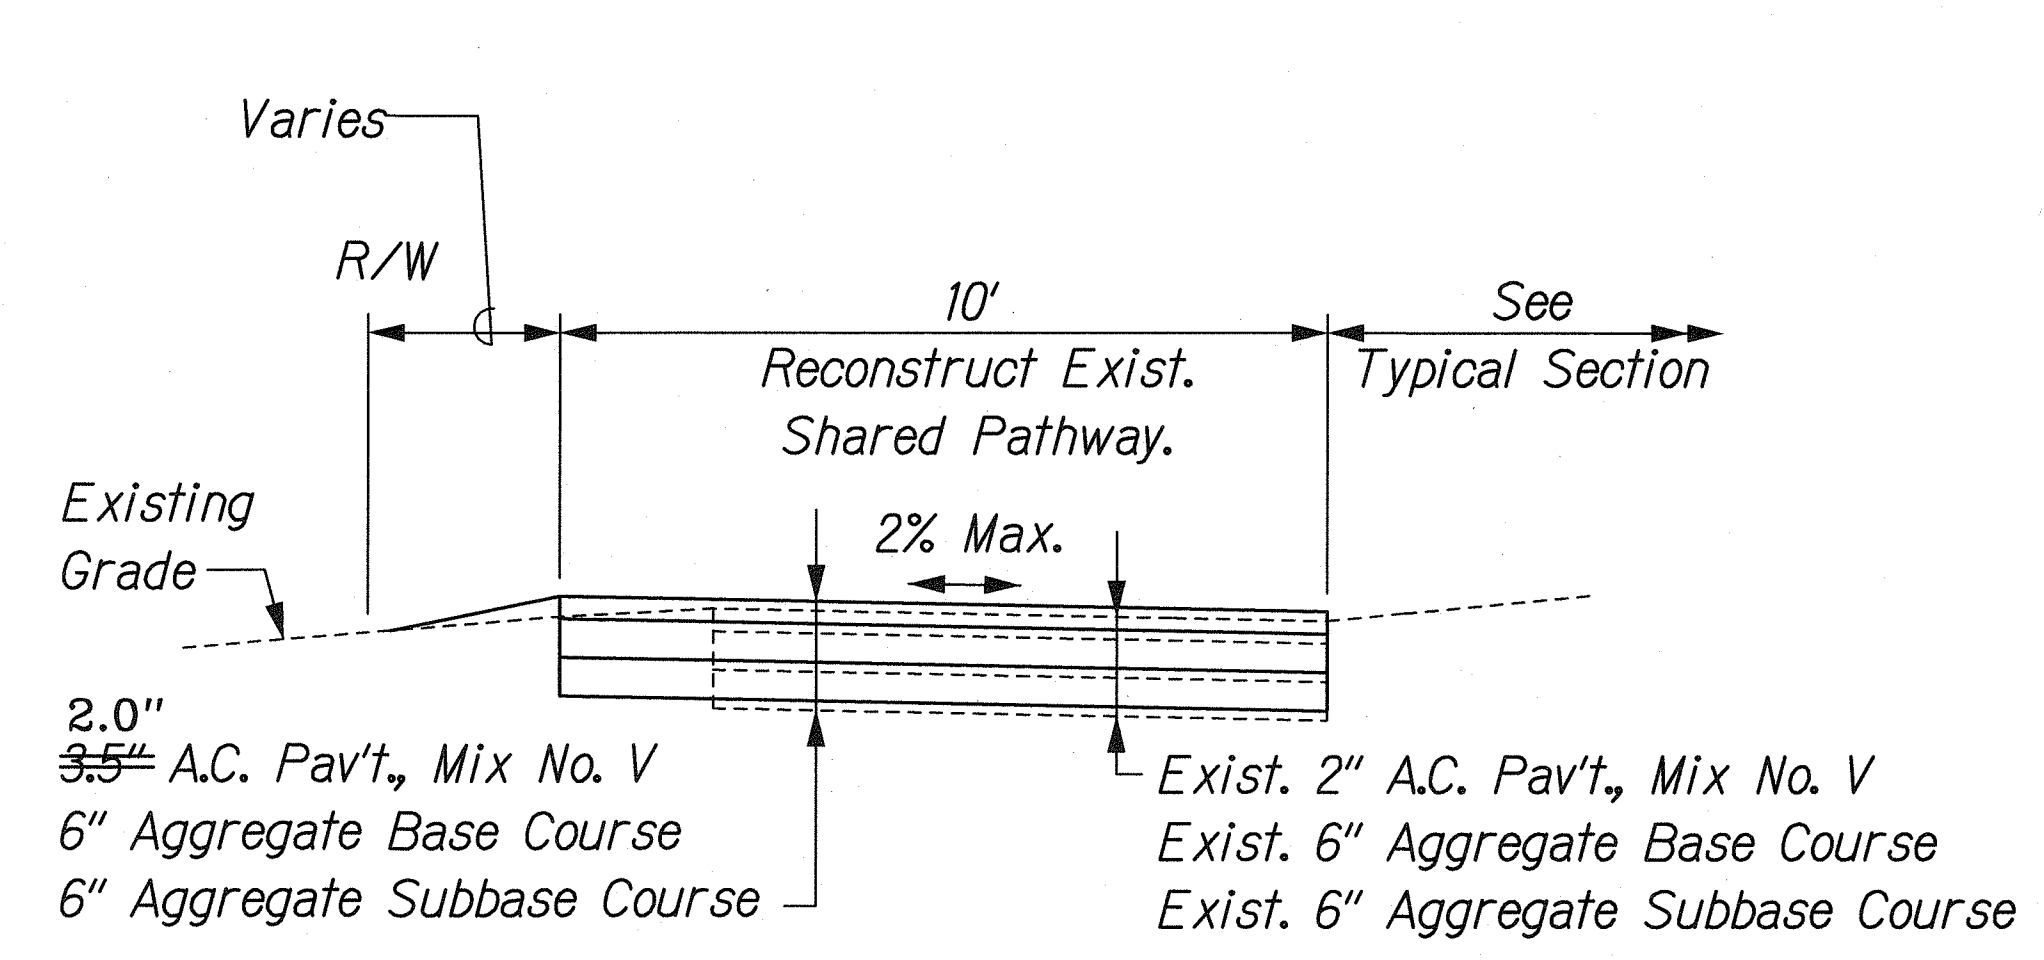

STA. 123+80.0 - STA. 129+70.3±
 STA. 132+88.2 - STA. 140+75.0
 STA. 145+06.6 - STA. 148+49.6

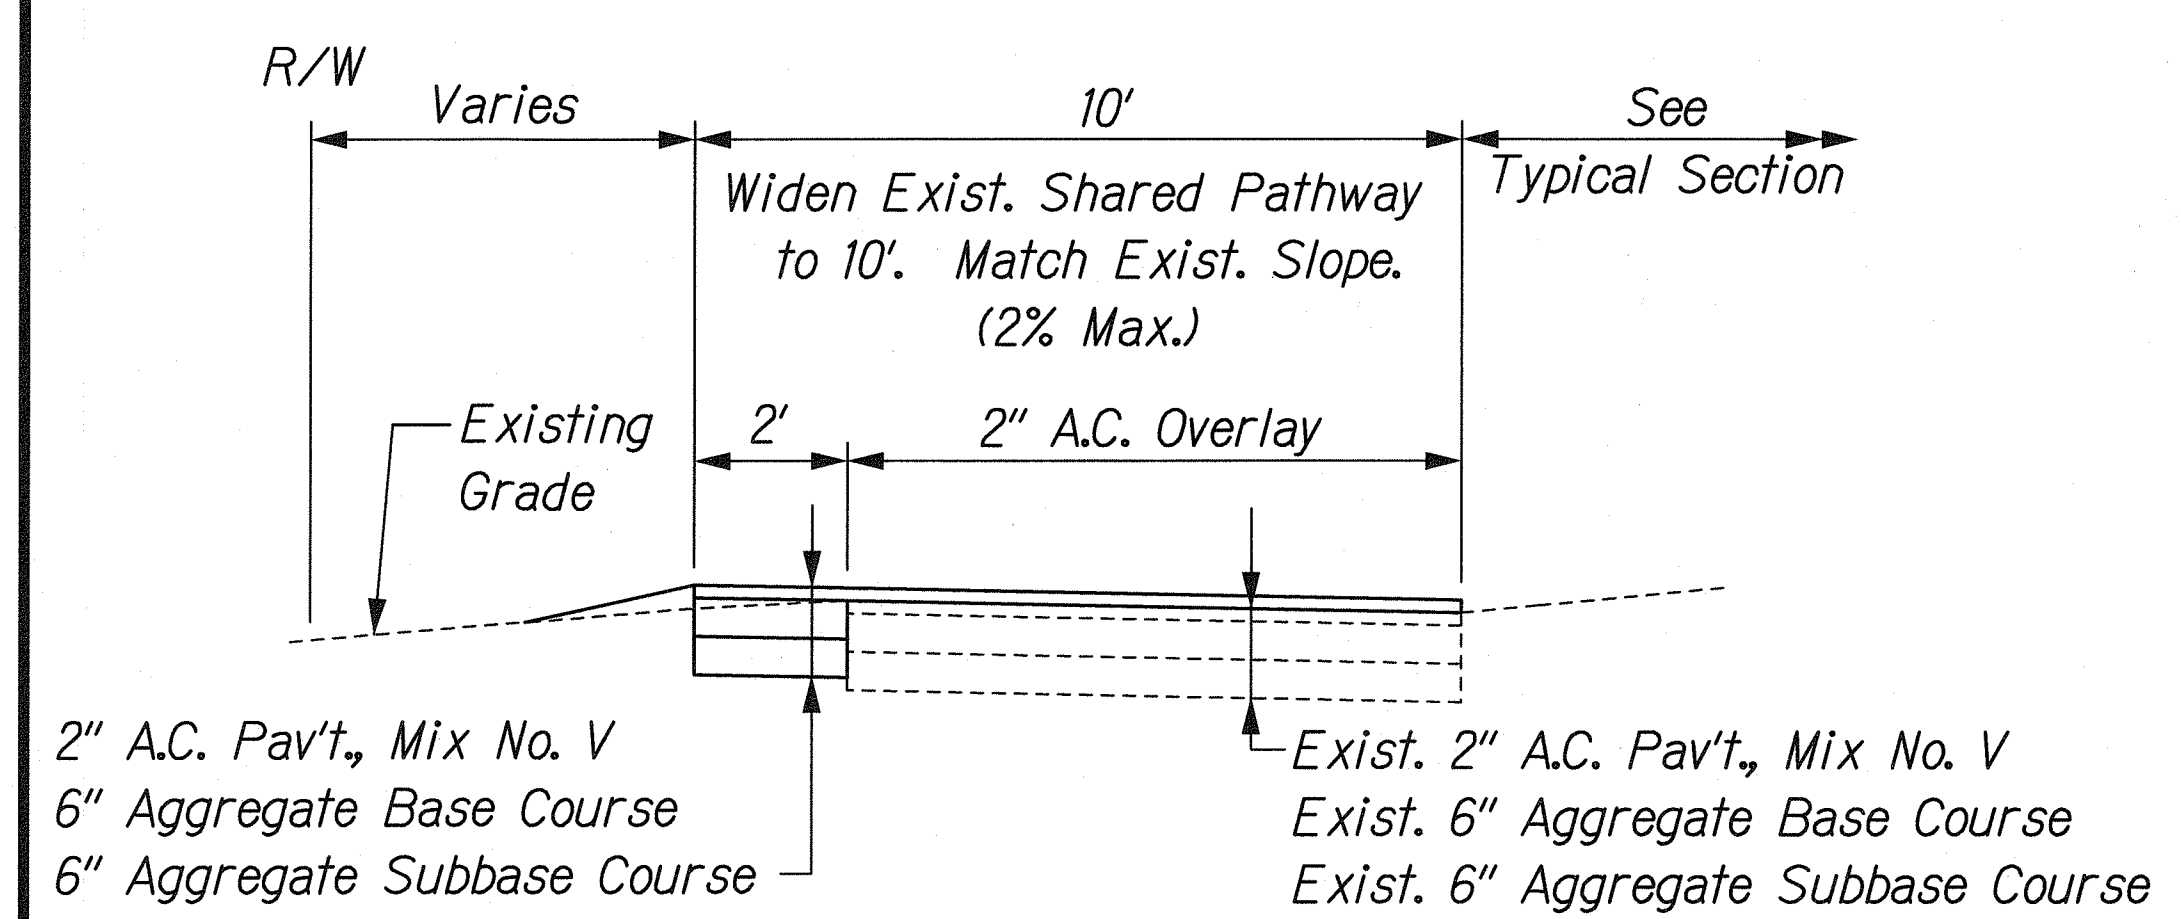


STA. 149+54± - STA. 153+00

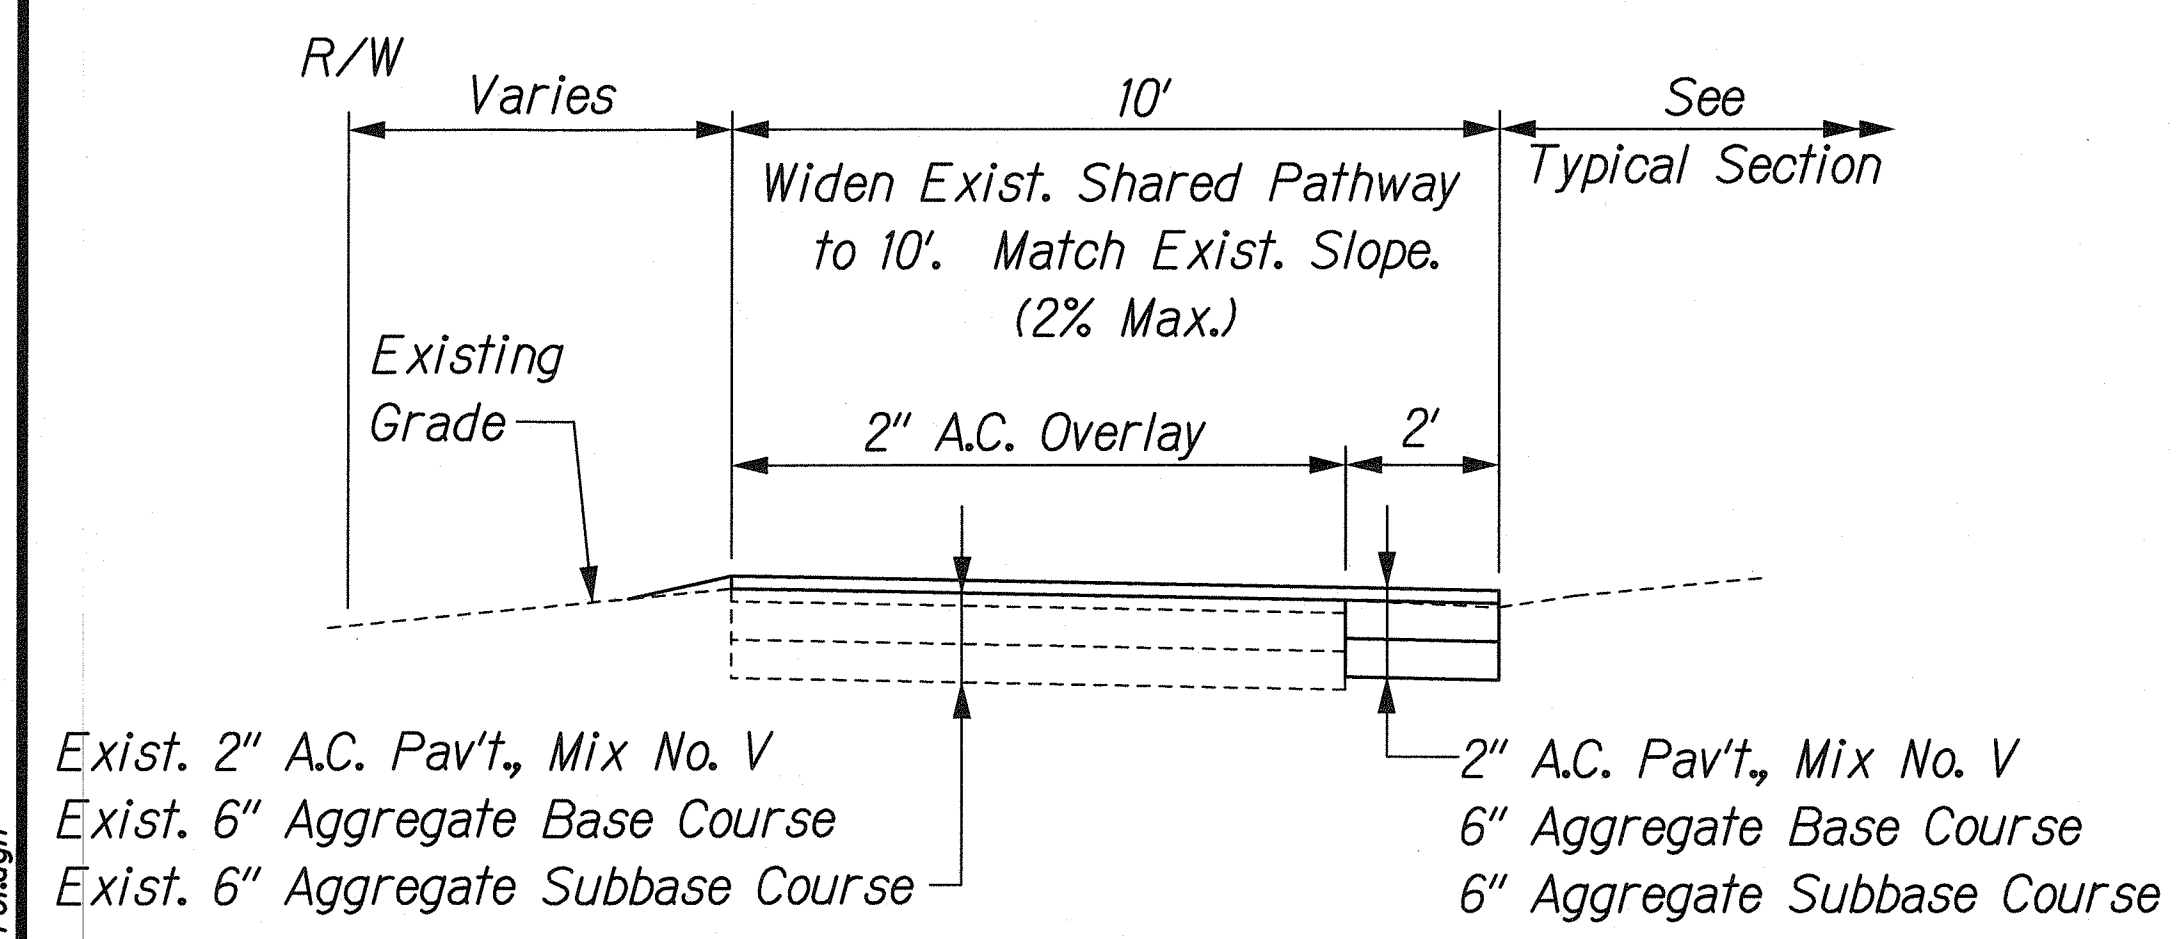


STA. 140+75.0 - STA. 145+06.6
 STA. 153+50.0 - STA. 156+00.0

RECONSTRUCT/WIDEN EXISTING SHARED PATHWAY
 Scale: 1/2" = 5'

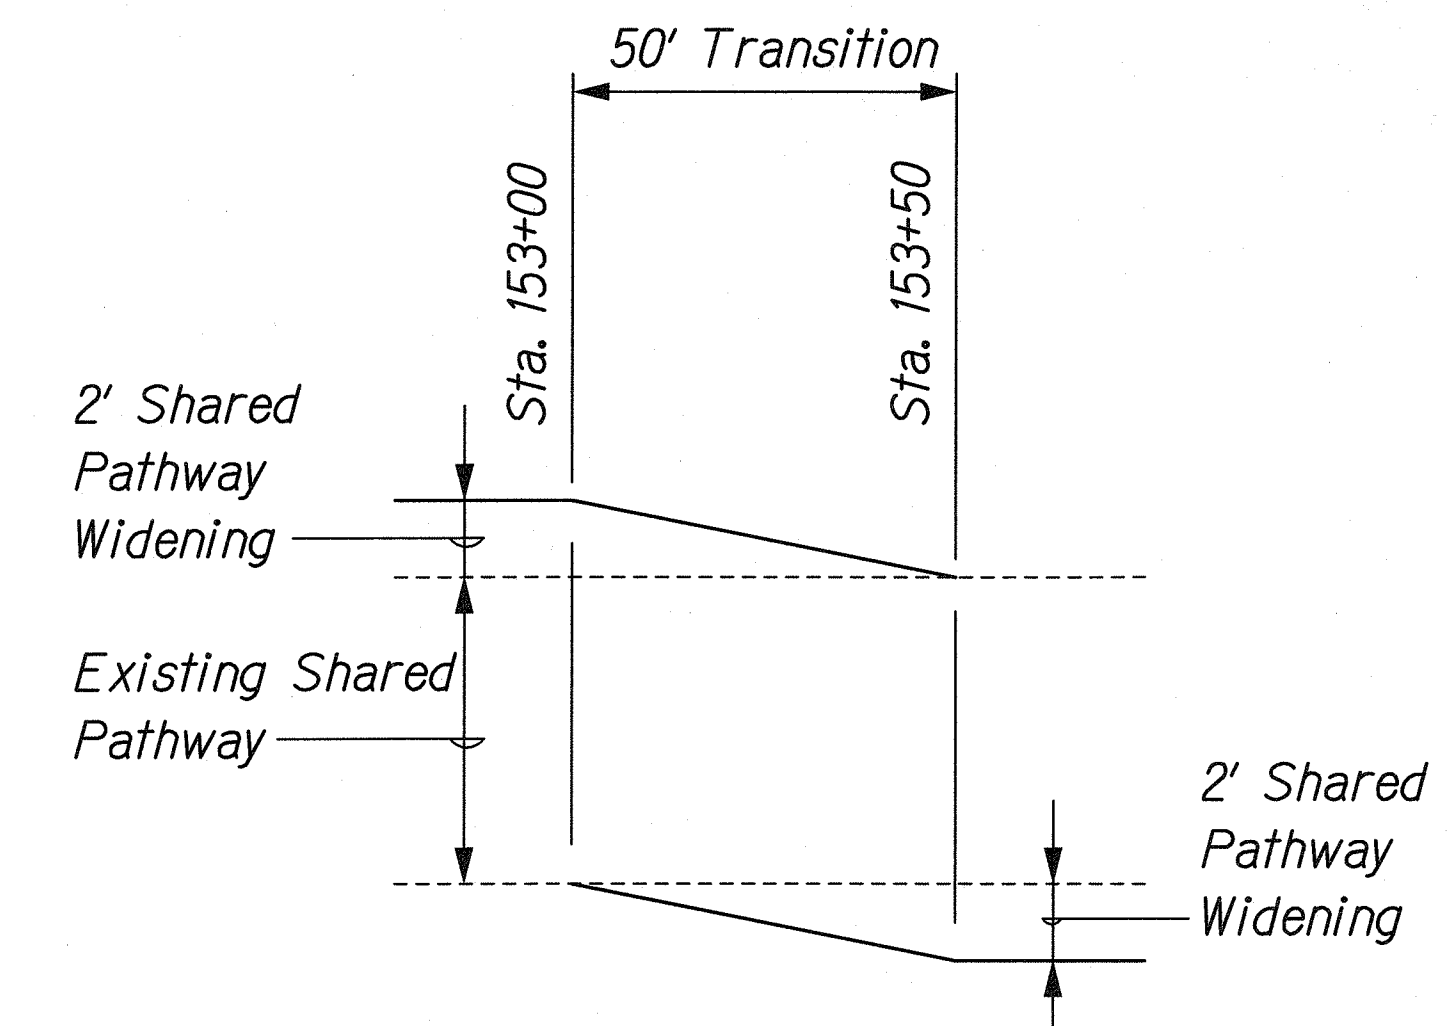


SHARED PATHWAY TRANSITION
 Not To Scale

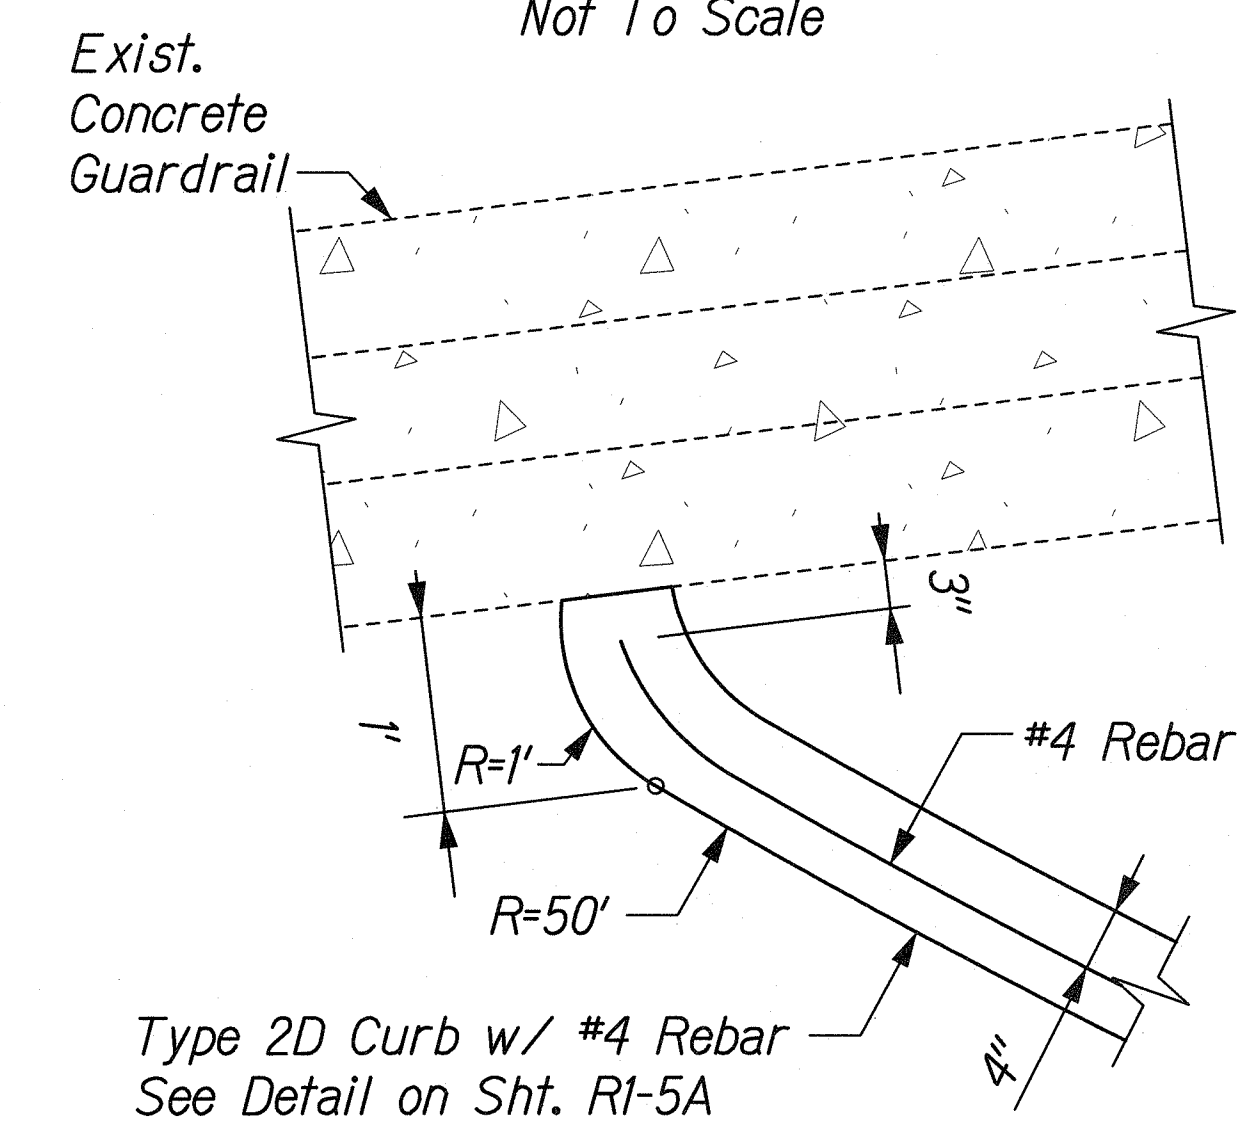

Type 2D Curb w/ #4 Rebar
 See Detail on Sht. RI-5A


PLAN

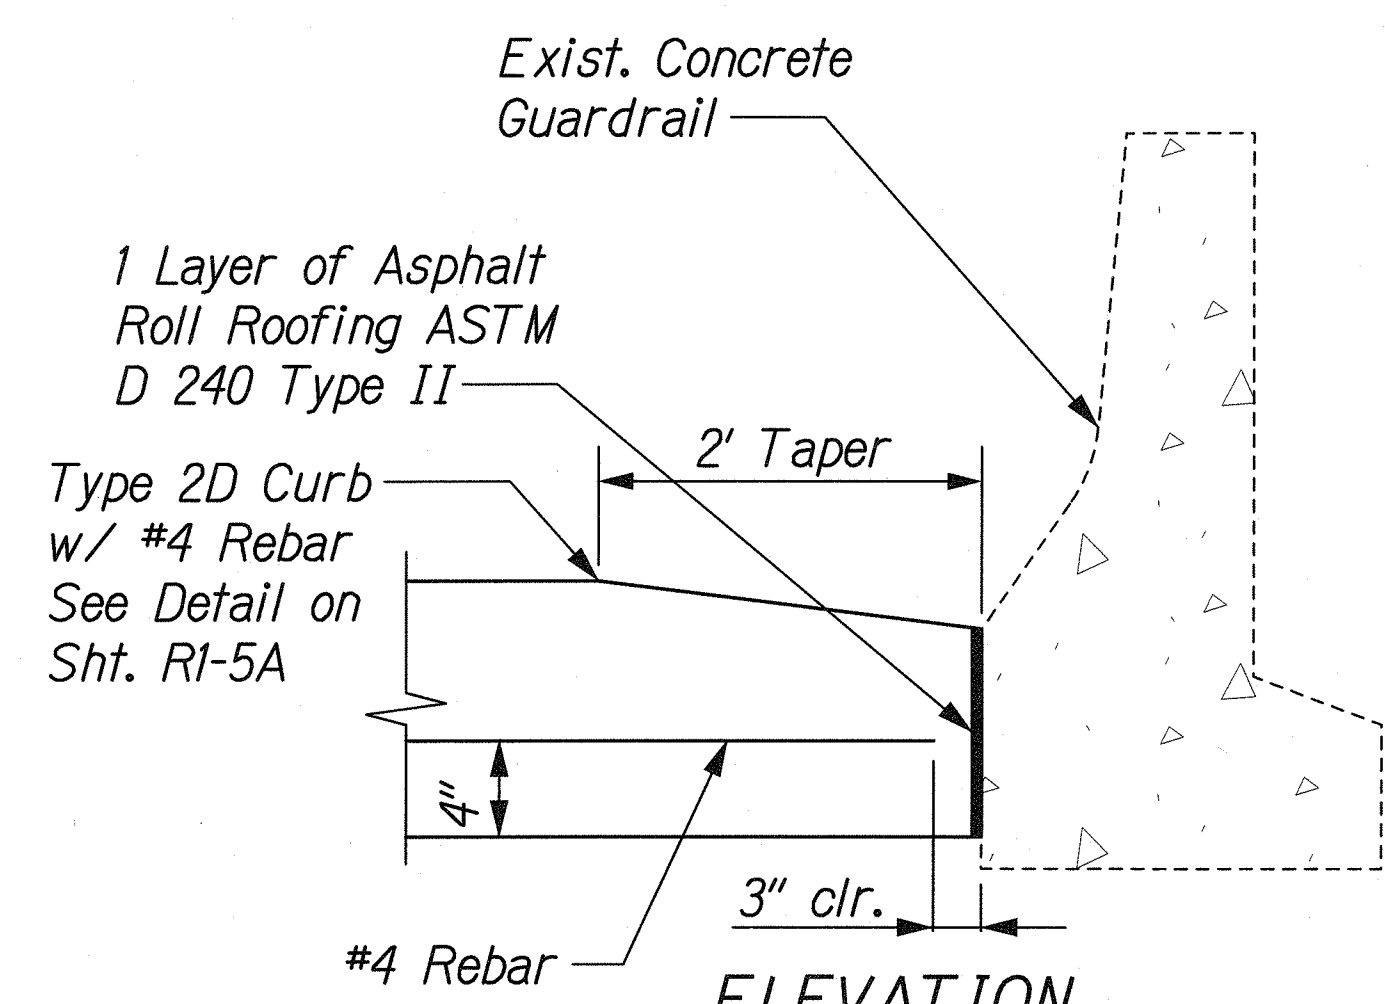


ELEVATION

TYPICAL TIE-IN FOR TYPE 2D CURB
 AND CONCRETE GUARDRAIL

Scale: 1"=1'-0"

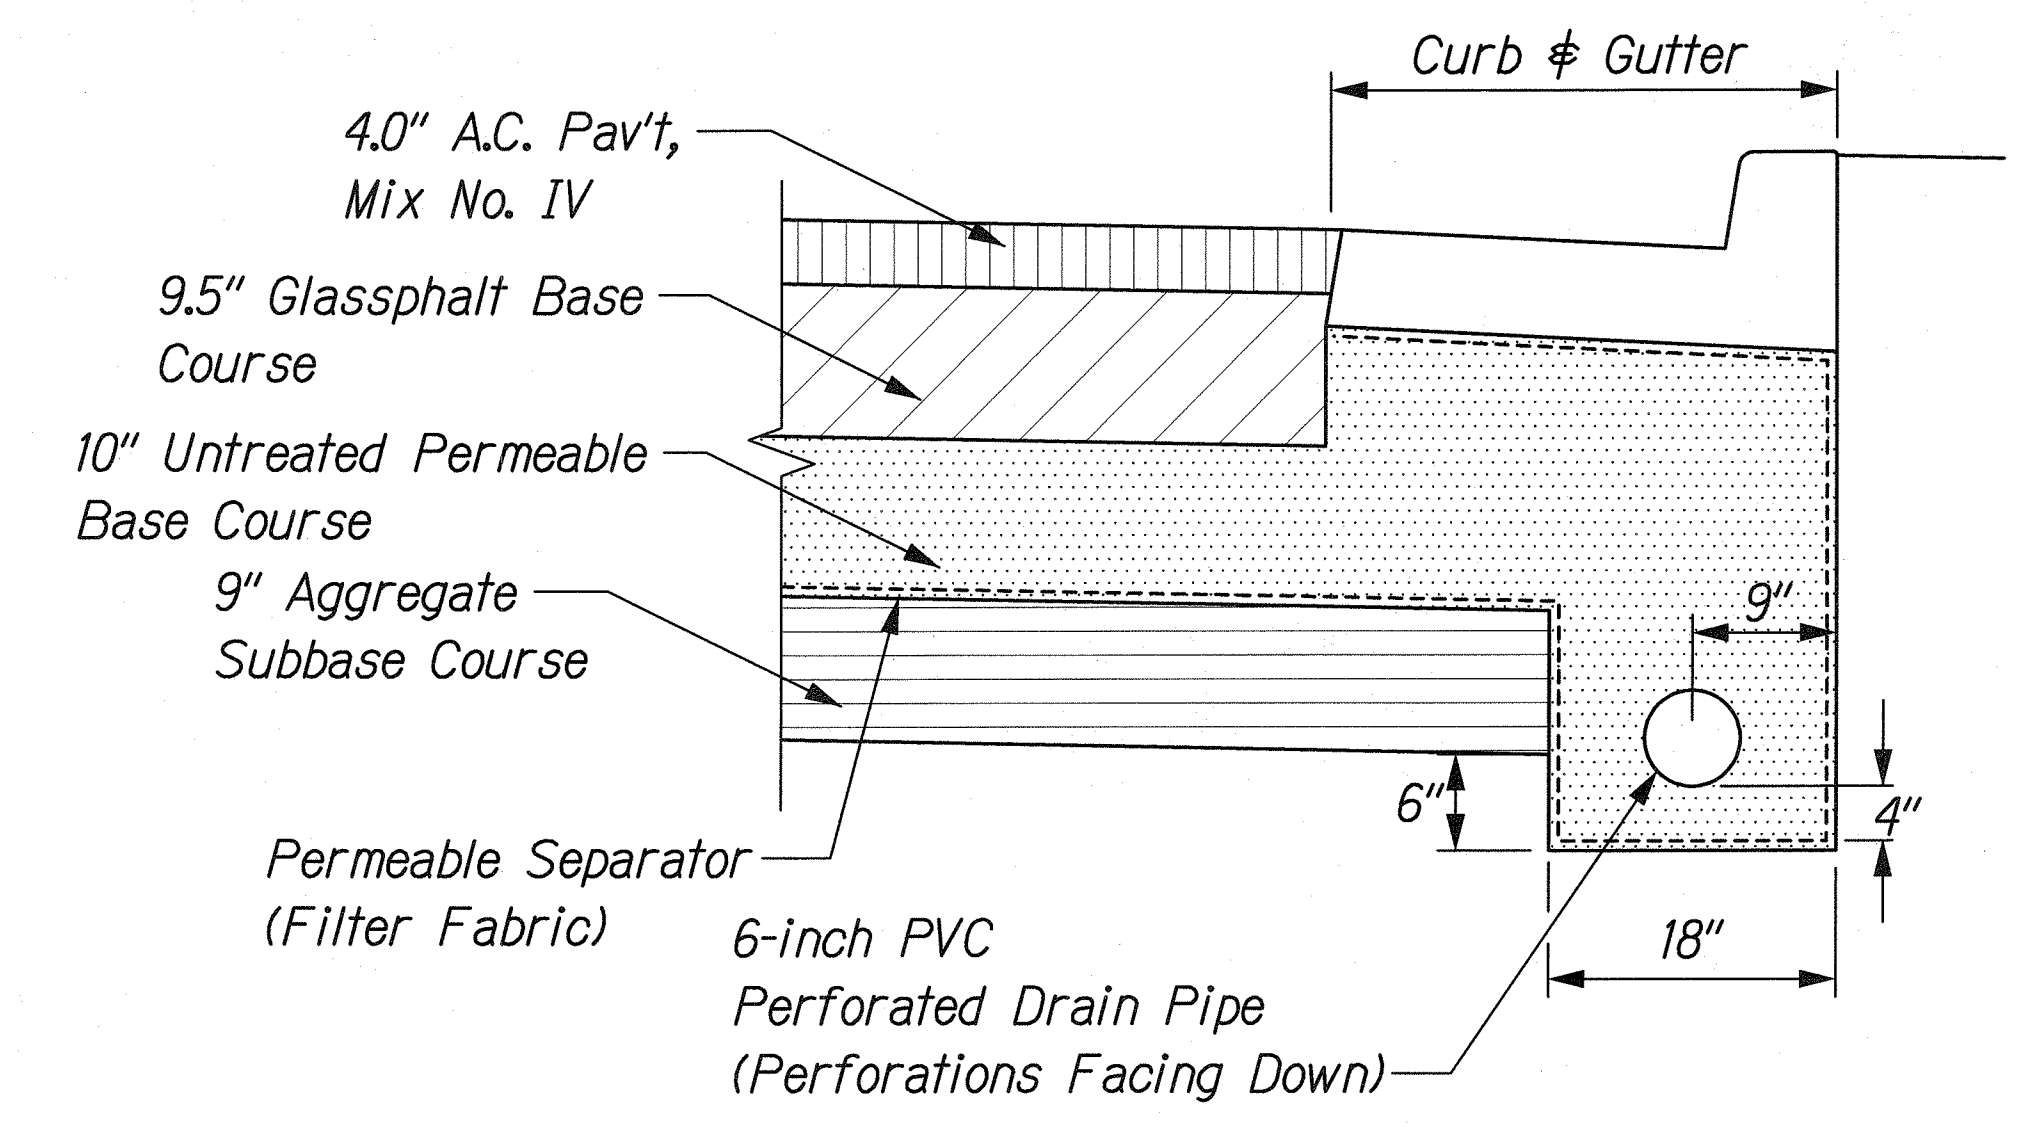

DETAIL A
 Scale: 1" = 1'

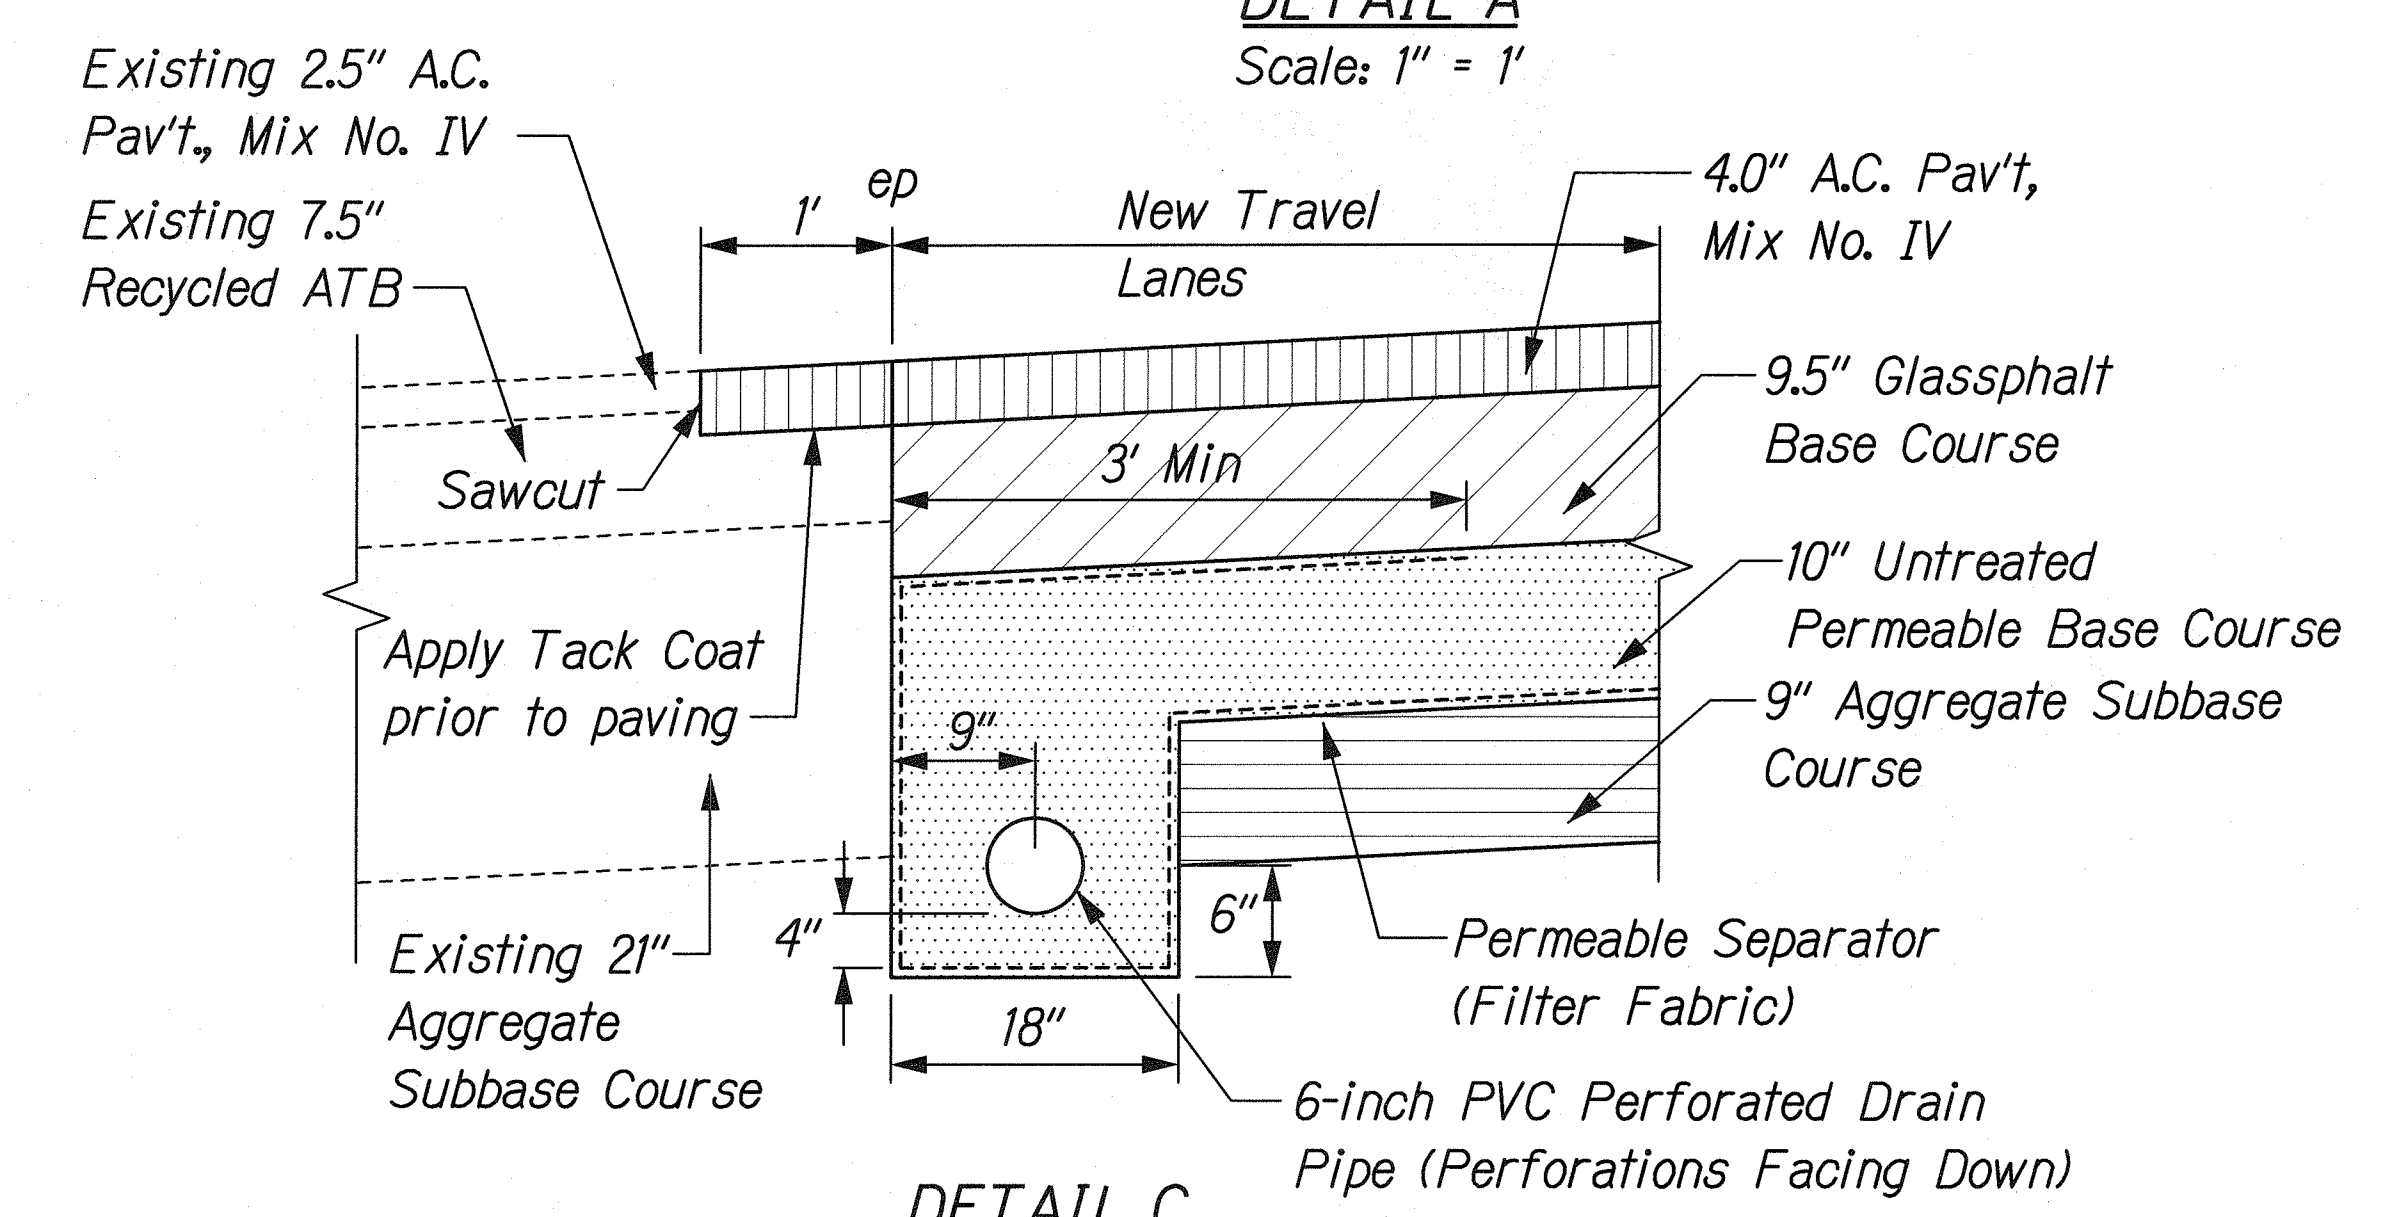

DETAIL C
 Scale: 1" = 1'

LEGEND FOR AS-BUILT POSTINGS	
	Squiggly line for as-built deletion
	Double line for as-built deletion
	Text for as-built posting

THIS WORK WAS PREPARED BY ME OR UNDER MY SUPERVISION

R. Urasaki

STATE OF HAWAII
 DEPARTMENT OF TRANSPORTATION
 HIGHWAYS DIVISION

ROADWAY CONSTRUCTION DETAILS

FORT WEAVER ROAD WIDENING
 VICINITY OF AAWA DRIVE TO GEIGER ROAD

Scale: As Shown Date: Sept. 20, 2007

SHEET No. RI-5 OF 39 SHEETS

DATE	_____
DESIGNED BY	_____
CHECKED BY	_____
NOTED BY	_____
QUANTITIES BY	_____
TRACED BY	_____
ORIGINAL PLAN	_____

16/FORT WEAVER ROAD/ROAD/RDE/0104gn

