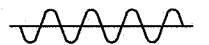
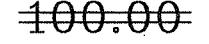



FED. ROAD DIST. NO.	STATE	FEDERAL AID PROJ. NO.	FISCAL YEAR	SHEET NO.	TOTAL SHEETS
HAWAII	HAW.	CMAQ-076-1(9)	2006	47	160



LEGEND FOR

AS-BUILT POSTINGS

 Squiggly line for as-built deletion


 Double line for as-built deletion

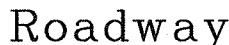 Roadway Text for as-built posting

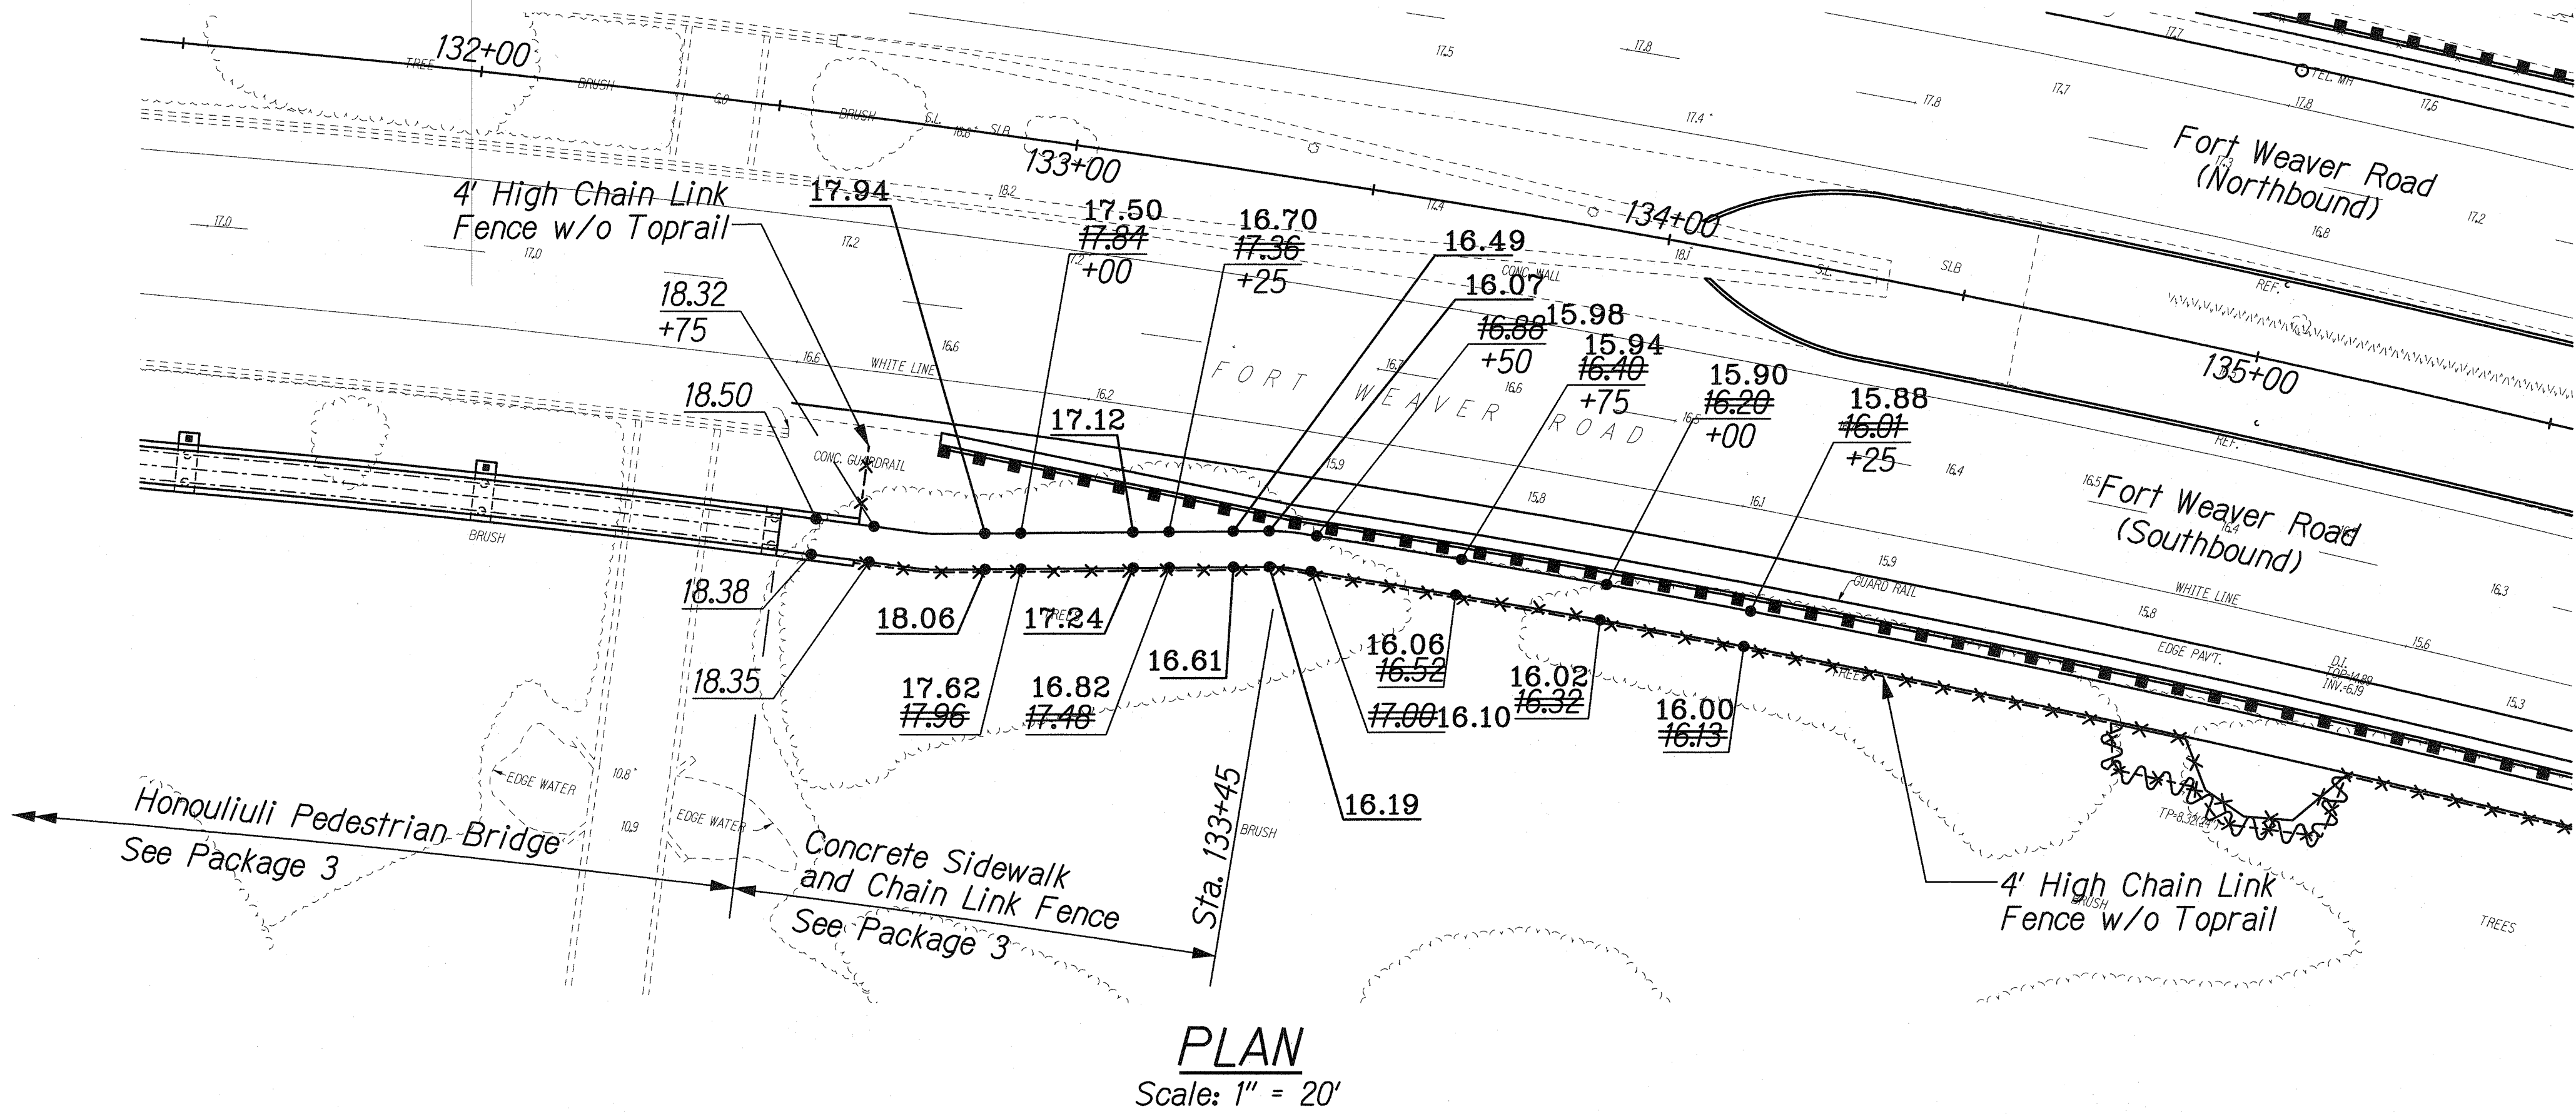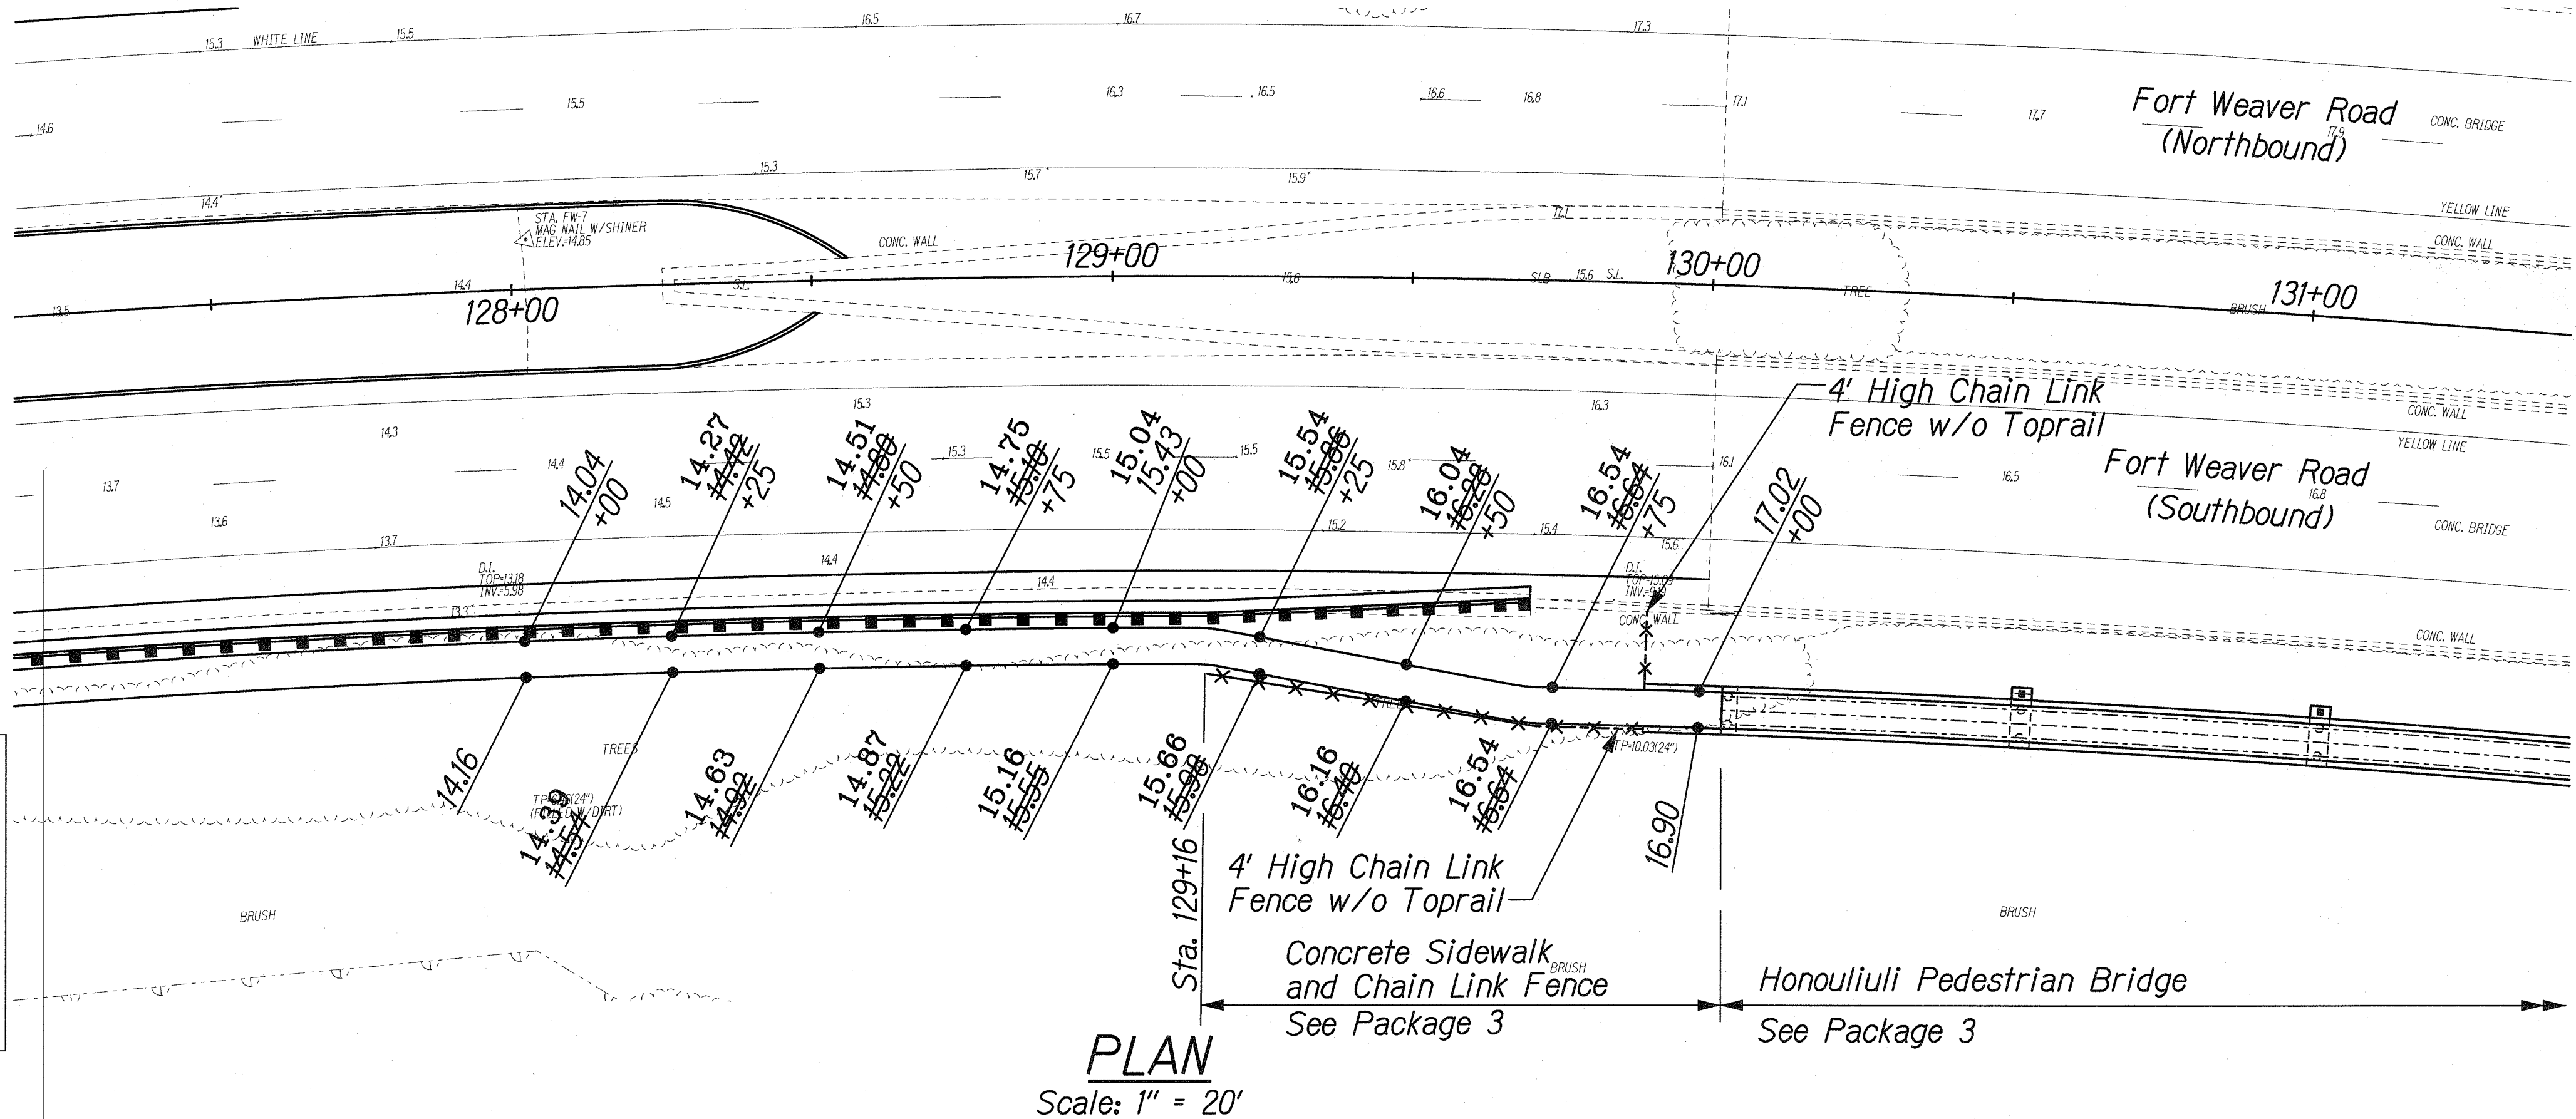

DESIGNED BY	DATE
DRAWN BY	
CHECKED BY	
NOTED BY	
APPROVED BY	

1/4 FORT WEAVER ROAD/ROAD/spot elev.dwg

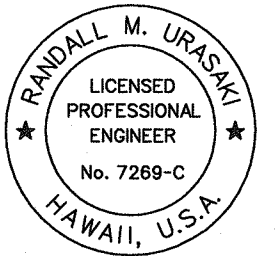

THIS WORK WAS PREPARED BY ME OR UNDER MY SUPERVISION.

Randall M. Urasaki

STATE OF HAWAII
DEPARTMENT OF TRANSPORTATION
HIGHWAYS DIVISION

SPOT ELEVATIONS
AT HONOLULU PED. BRIDGE

FORT WEAVER ROAD WIDENING
VICINITY OF AAWA DRIVE TO GEIGER ROAD

Scale: 1"=20' Date: Sept. 20, 2007

SHEET No RI-24 OF 39 SHEETS