

CANE HAUL ROAD PEDESTRIAN BRIDGE GENERAL NOTES:

FED. ROAD DIST. NO.	STATE	FEDERAL AID PROJ. NO.	FISCAL YEAR	SHEET NO.	TOTAL SHEETS
HAWAII	HAW.	CMAQ-076-1(9)	2006	290	371

1. General Specifications:

Hawaii Department of Transportation, Standard Specifications for Road and Bridge Construction, 1994, together with Special Provisions prepared for this contract.

2. Design Specifications:

(A) AASHTO 2004 LRFD Bridge Design Specification (Third Edition) and its subsequent interim specification with interim supplements and modifications by the Highway Division, Department of Transportation, State of Hawaii.

(B) AASHTO/AWS D1.5M/D1.5 Bridge Welding Code, Latest Edition.

3. Loads:

(A) Live Load: 100 psf

(B) Seismic Loads: Aceleration coefficient - 0.18
 Seismic Performance Zone - 2
 Importance Category - Other Bridges

4. Materials:

(A) All concrete except Precast Prestressed Concrete Beam shall have a 28-day cylinder compressive strength of 4,000 psi.

(B) For concrete strength of Precast Prestressed Concrete Beam, see Sht. S2-6.

(C) Tetraguard AS20 shrinkage reducing admixture (SRA) shall be included in the concrete mix for the deck. The required dosage shall be 128 ounces per cubic yard of concrete and follow all manufacturer's recommendations

(D) All reinforcing steel shall be ASTM A615 Grade 60 unless otherwise noted.

(E) All structural steel shall be ASTM A36 hot dip galvanized after fabrication, unless otherwise noted.

(F) All Type I Metal Bikeway Railings shall be steel structural Tubing conforming to ASTM A500 Grade B and shall be hot-dipped galvanized after fabrications.

(G) All Type I Metal Bikeway Railing Anchor Bolts shall be steel bolts conforming to ASTM A307. Anchor bolts shall be hot-dipped galvanized.

(H) All Type I Metal Bikeway Railing Anchor Bolt Nuts shall be steel nuts conforming to ASTM A563. Nuts shall be hot-dipped galvanized.

(I) All Type I Metal Bikeway Railing Anchor Bolt washers shall be steel washers conforming to ASTM F436. Washers shall be hot-dipped galvanized.

(J) All welds shall be made using E70XX electrodes. Welds shall be performed by a qualified welder.

5. Reinforcement:

(A) The minimum covering measured from the surfaces of the concrete to the face of any reinforcing bars shall be as follows, except as otherwise shown:

(1) Deck

A. Top bars = 2" with a tolerances of - 0 inch and +3/8 inch.

B. Bottom bars = 1 1/2" except as otherwise noted.

(2) Abutment Walls and Wing Walls = 2" to ties or outermost reinforcing except as otherwise noted.

(3) Concrete cast against and permanently esposed to earth = 3"

(4) All other unless otherwise noted = 2"

(B) Reinforcing bars shall be detailed in accordance with the latest edition of ACI Detailing Manual for reinforced concrete structures.

(C) Minimum clear spacing between parallel bars shall be 1 1/2 times the diameter of bars (for non bundled bars). In no case shall the clear distance between the bars be less than 1 1/2 times the maximum size of the coarse aggregate or 1 1/2".

(E) All dimensions relating to reinforcing bars are to centers of bars unless otherwise noted.

(D) Reinforcing bars shall be securely tied at all intersections and lap splices except where the spacing of intersections is less than one foot in each direction, in which case alternate intersections shall be tied.

(F) Vertical wall bars be arranged in such manner as to avoid interference with girder and deck bars above as directed by the Engineer.

6. Girder Bearings:

(A) Girder concrete bearing seat shall be poured monolithically with supporting structure. Top of concrete bearing seat shall be finished with steel trowel to a smooth level surface to the elevation shown on plans. Grind down high spots as needed to provide an even bearing surface to 1/16"± tolerance.

(B) The concrete seat and elastomeric pad shall be placed as shown.

7. Construction Notes:

(A) See Standard Specifications and Special Provisions.

(B) In general, top of concrete deck slab shall be constructed to follow the bridge vertical and horizontal curves and superelevations.

(C) Except as otherwise noted, all vertical dimensions are measured plumb.

(D) For concrete finish see Standard Specifications and Special Provisions.

(E) Contruction joints may be relocated or additional ones added subject to the approval of the Engineer.

(F) Unless otherwise noted, all exposed concrete edges shall be chamfered 3/4"x3/4".

(G) Contractor shall verify footing elevations before fabricating footing and wall reinforcing.

(H) Elastomeric bearing pads shall be secured to the concrete bearing surface with adhesives or other means necessary as approved by the Engineer.

8. General:

(A) Standard detail drawings refer to all structures in general, except for modifications as may be required for special conditions. For such modifications refer to the corresponding detailed drawings.

9. Foundation:

Footings are embeded min. 5 feet below finish grade.

Footings should also be embeded such that a horizontal distance of 5 feet is maintained between the bottom edge of footing and slope face.

(A) Allowable bearing value (net)= 4,000 psf for service limit state
 = 7,200 psf for strength limit state
 = 12,000 psf for extreme event limit state

(B) Coefficient of friction = 0.49 for strength limit state
 = 0.58 extreme event limit state

(C) Passive earth pressure = 235 pcf for strength limit state
 = 470 pcf for extreme event limit state

(D) Active earth pressure = 40 pcf

(E) Internal friction angle = 30 degrees

10. Load Capacity Ratings:

(A) Inventory Rating
 Design Load Rating = 2.19 X (Pedestrian LL = 100 PSF)

(B) Operating Rating
 Design Load Rating = 3.85 X (Pedestrian LL = 100 PSF)

DESIGNED BY	DATE
DRAWN BY	
CHECKED BY	
IN CHARGE	
NOTED BY	
QUANTITIES BY	
NO.	

16/FORT WEAVER ROAD/STRUCT/struct-notes.01dgn

THIS WORK WAS PREPARED BY ME OR UNDER MY SUPERVISION.
SIGNATURE: *Hui Pang Chen* EXPIRATION DATE: 04/30/10 OF THE LICENSE

STATE OF HAWAII
DEPARTMENT OF TRANSPORTATION
HIGHWAYS DIVISION


CANE HAUL RD. PEDESTRIAN BRIDGE

GENERAL NOTES


FORT WEAVER ROAD WIDENING
VICINITY OF AAWA DRIVE TO GEIGER ROAD

Scale: None Date: Feb. 22, 2008

FED. ROAD DIST. NO.	STATE	FEDERAL AID PROJ. NO.	FISCAL YEAR	SHEET NO.	TOTAL SHEETS
HAWAII	HAW.	CMAQ-076-1(9)	2006	291	371

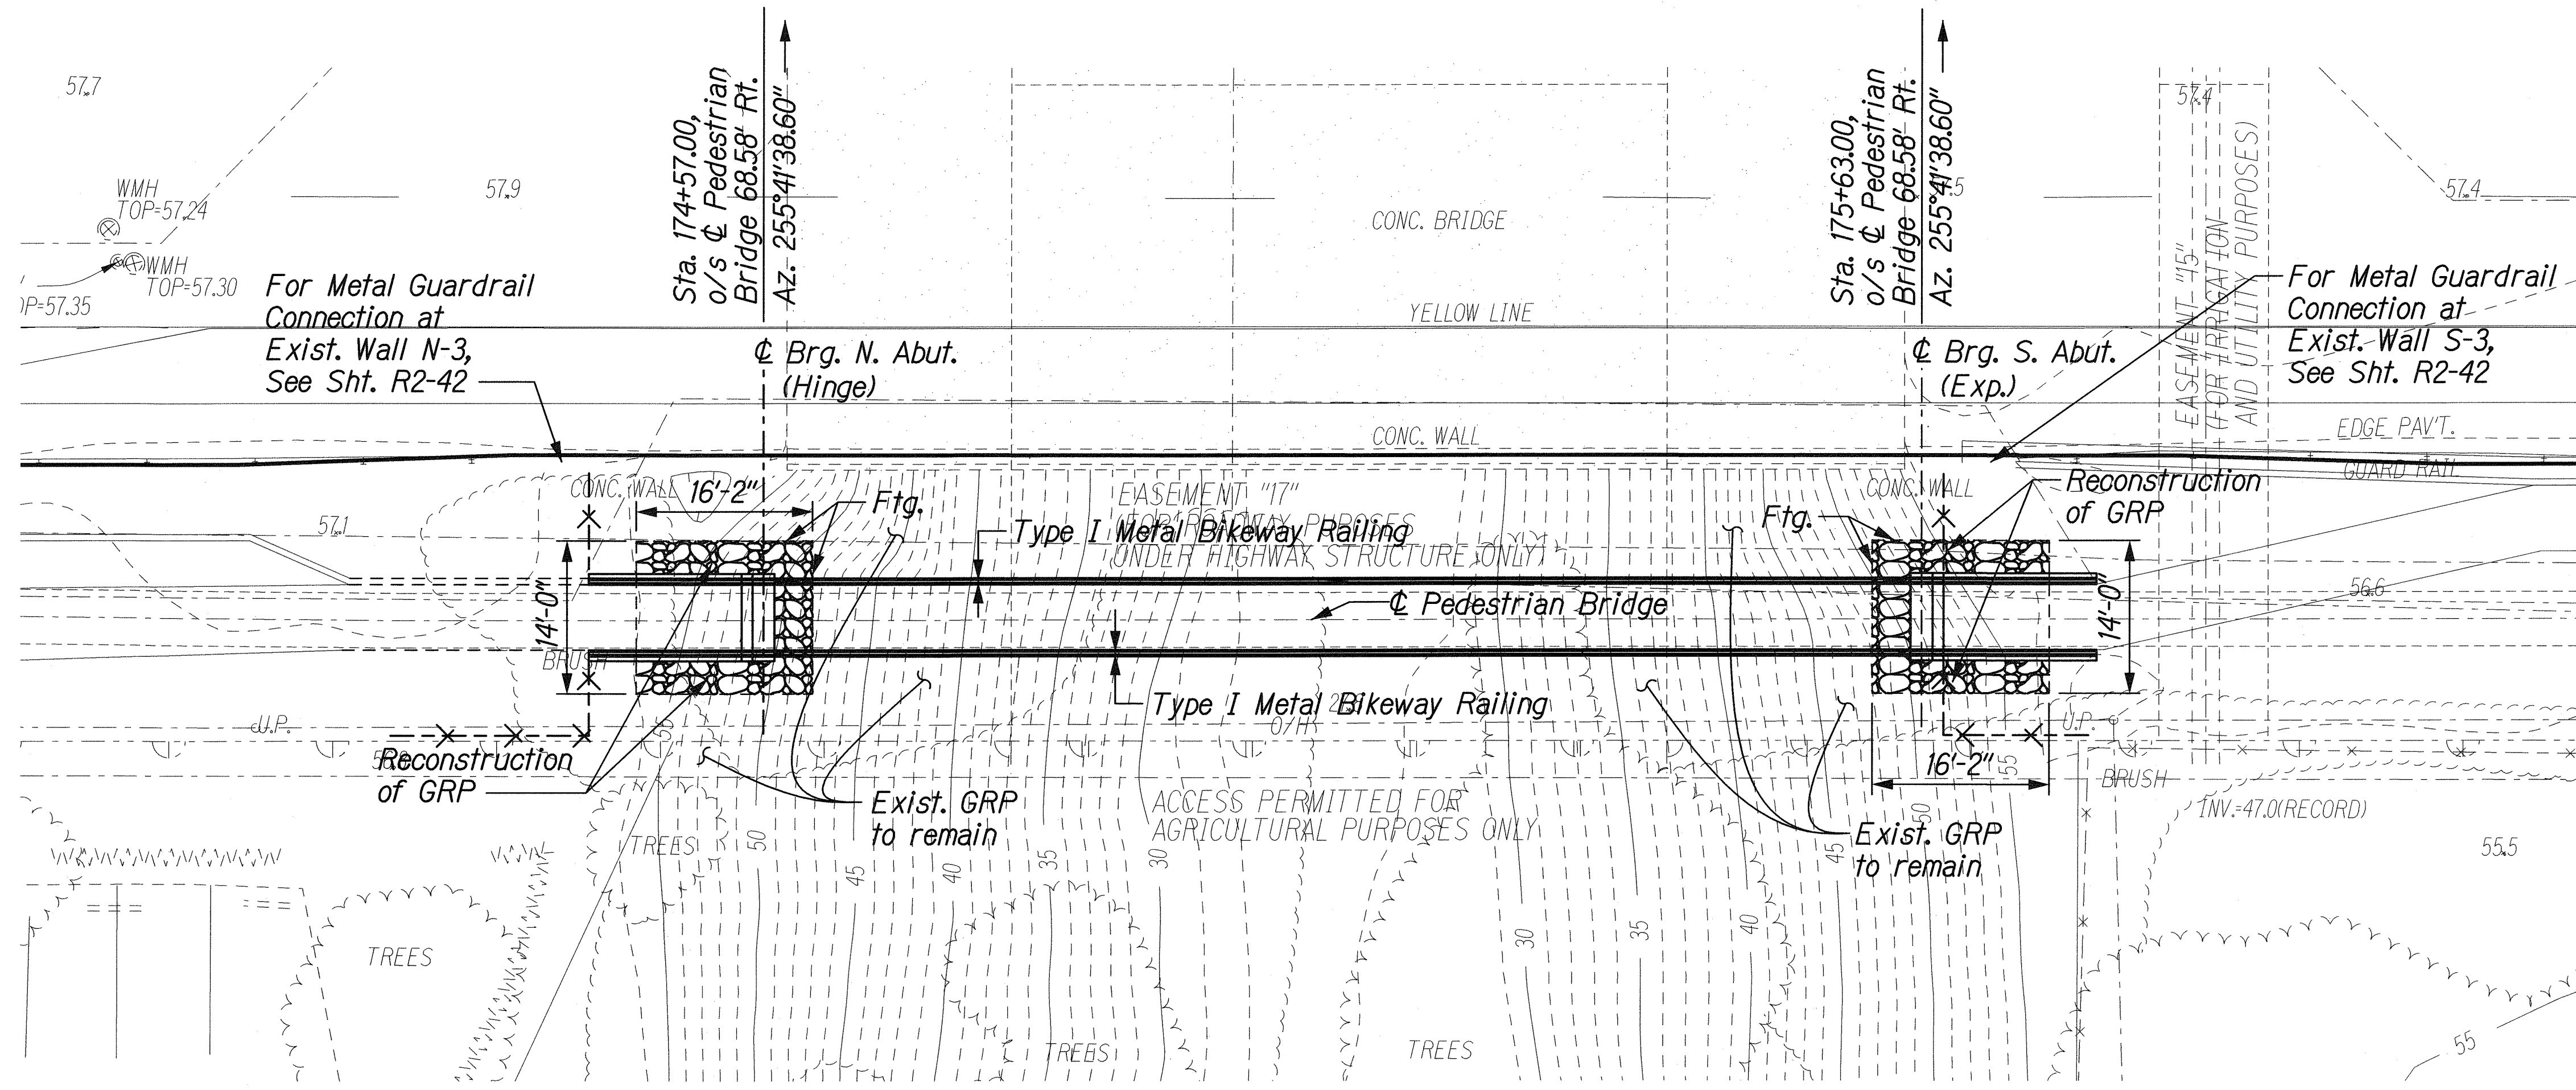

PLAN
Scale: 1" = 10'

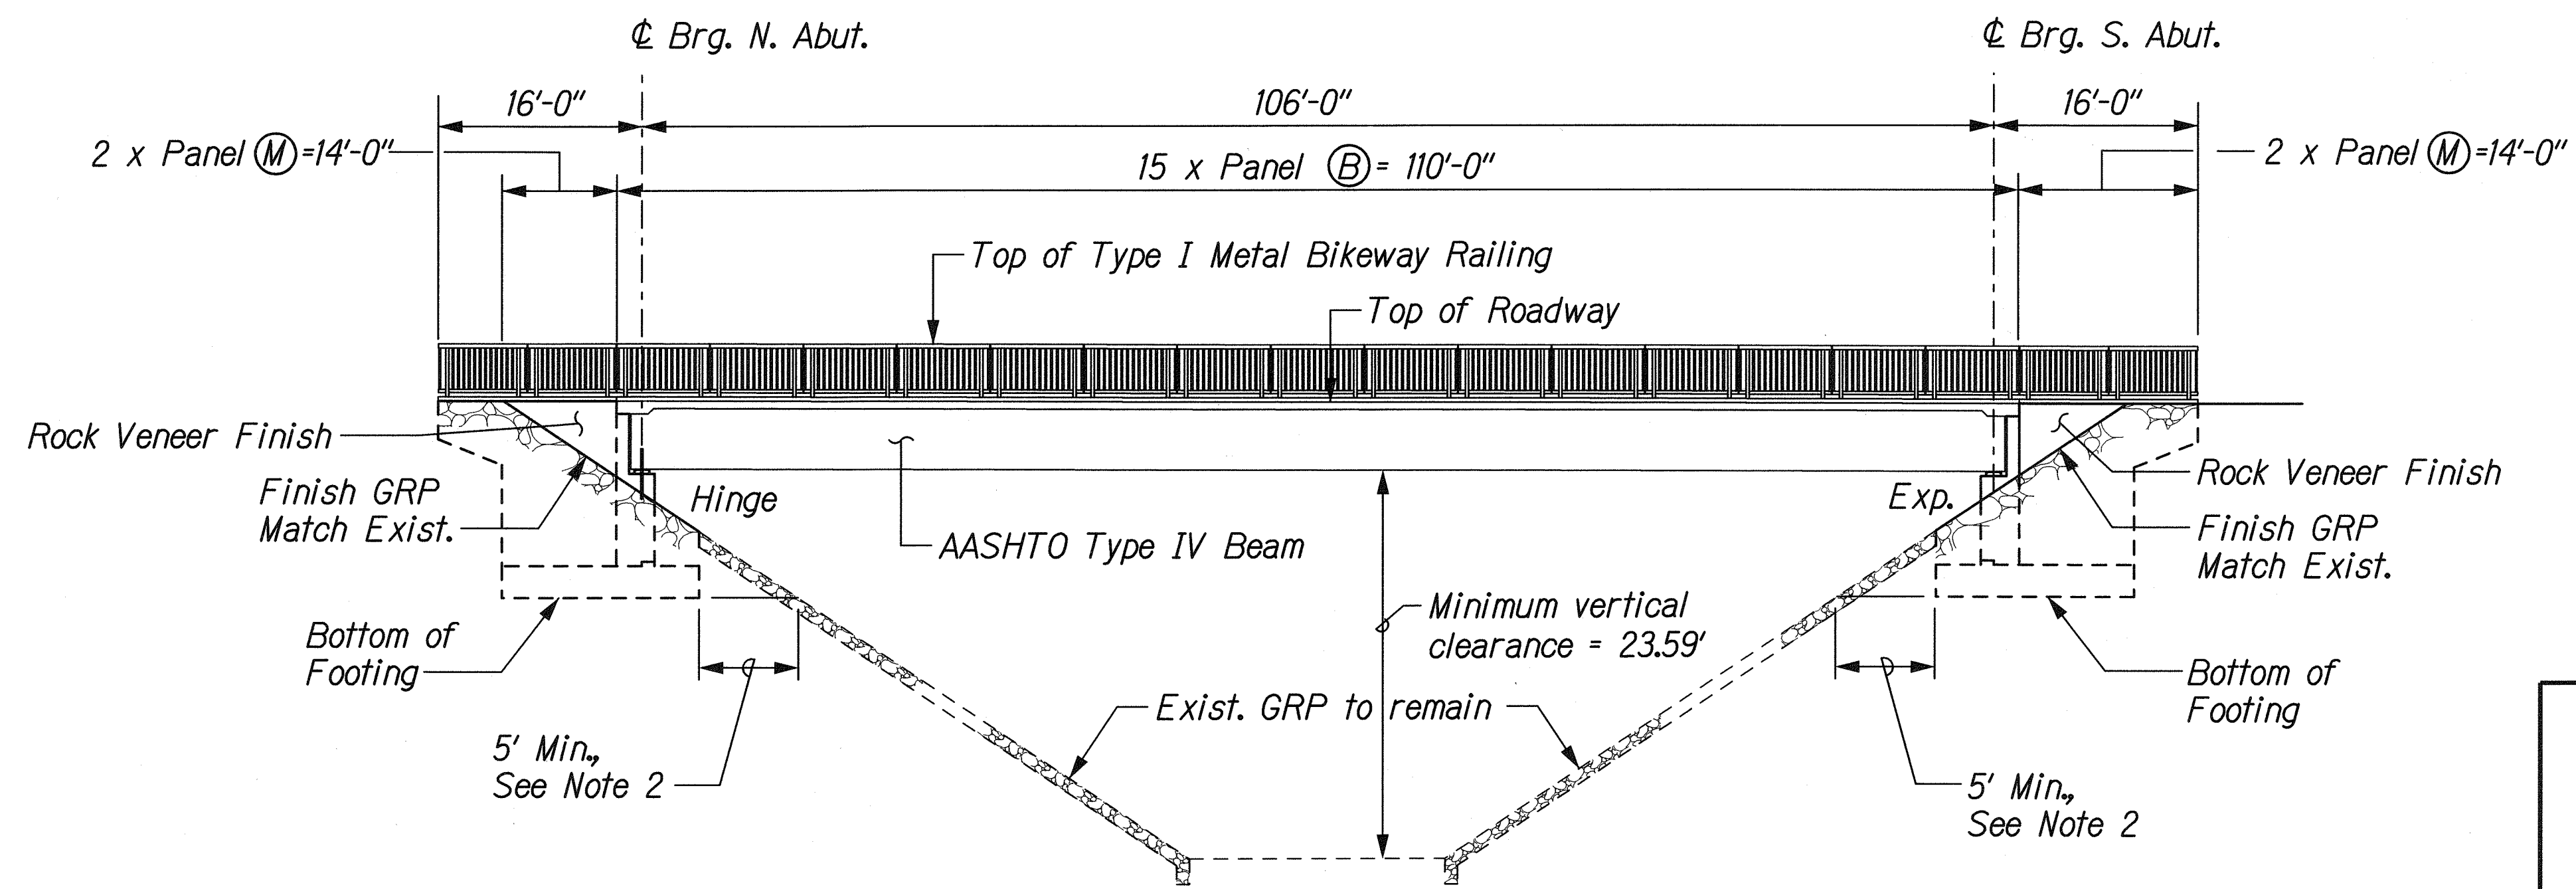

ELEVATION
Scale: 1" = 10'

Notes:

- For Panels (B), and (M), see Table A on Sht. S2-9.
- A horizontal distance of 5 feet min. shall be maintained. If the horizontal distance is less than 5 feet, the footing shall be lowered to meet the requirement and height of wall stem shall be adjusted accordingly without changing the top of wall stem elevations

THIS WORK WAS PREPARED BY ME OR UNDER MY SUPERVISION.

Rui Pang Chen
SIGNATURE

04/30/10
EXPIRATION DATE OF THE LICENSE




STATE OF HAWAII
DEPARTMENT OF TRANSPORTATION
HIGHWAYS DIVISION

CANE HAUL RD. PEDESTRIAN BRIDGE
PLAN AND ELEVATION

FORT WEAVER ROAD WIDENING
VICINITY OF AAWA DRIVE TO GEIGER ROAD

Scale: As Noted Date: Feb. 22, 2008

FED. ROAD DIST. NO.	STATE	FEDERAL AID PROJ. NO.	FISCAL YEAR	SHEET NO.	TOTAL SHEETS
HAWAII	HAW.	CMAQ-076-1(9)	2006	292	371

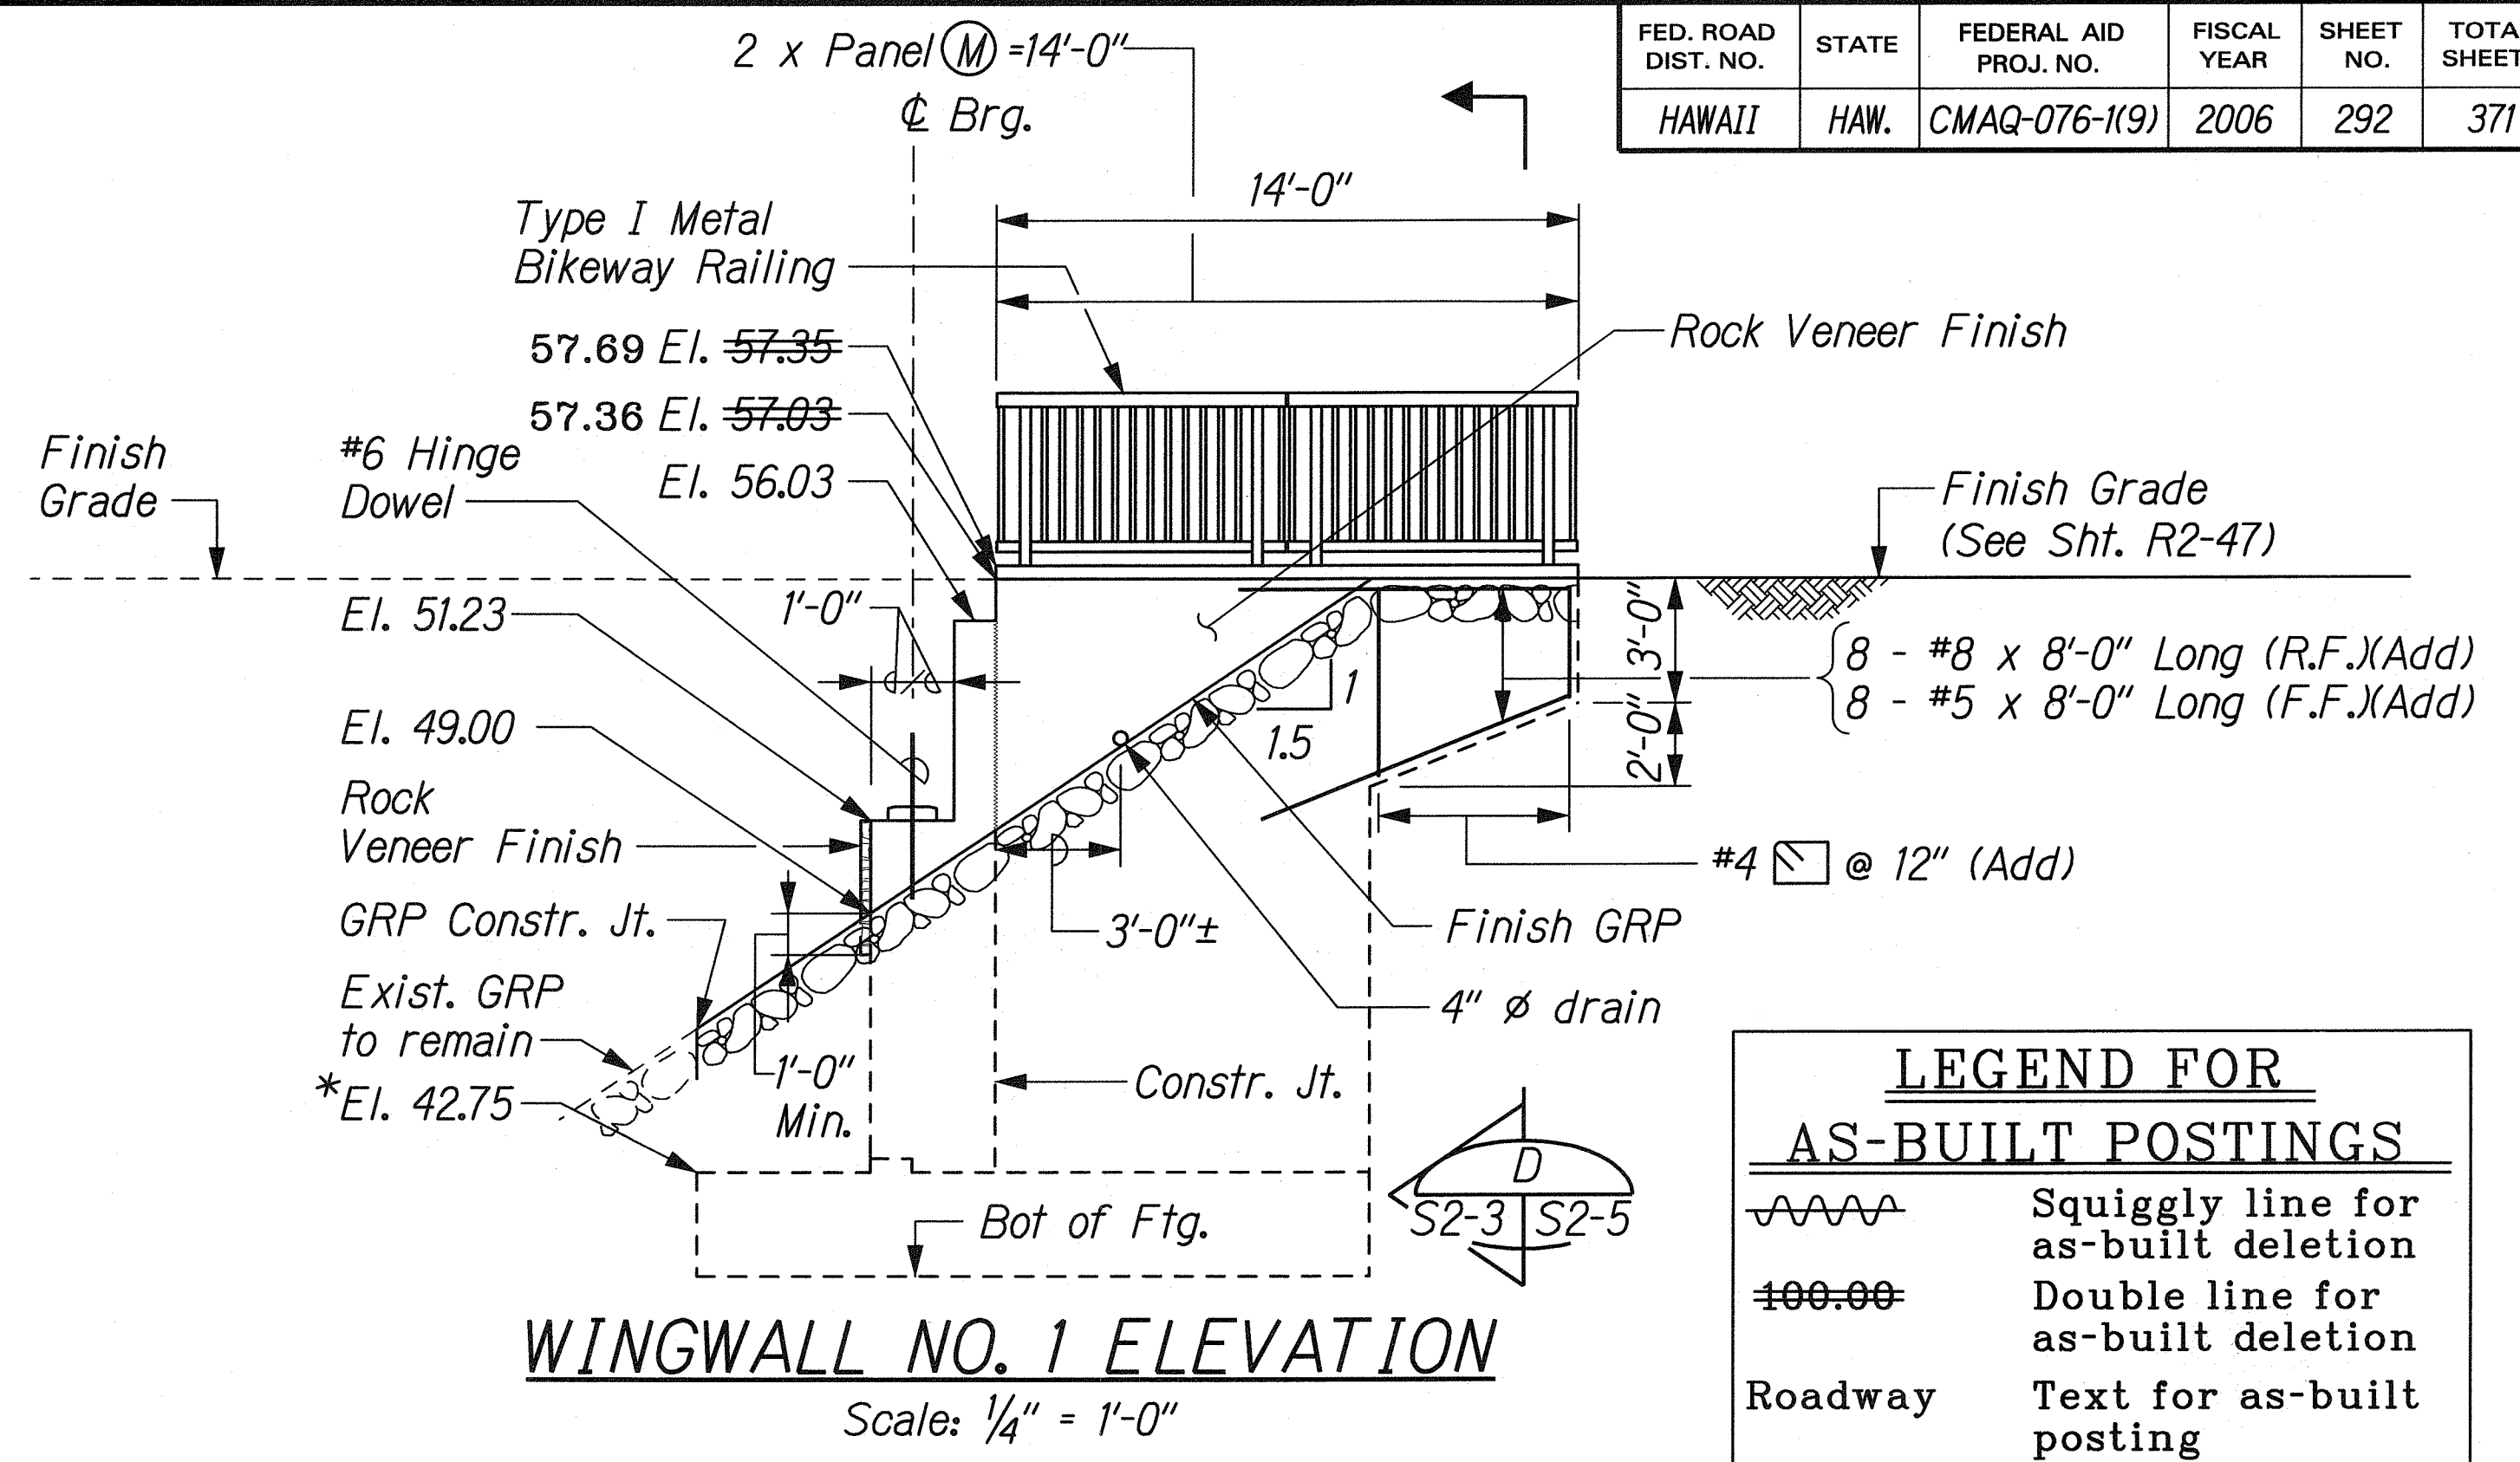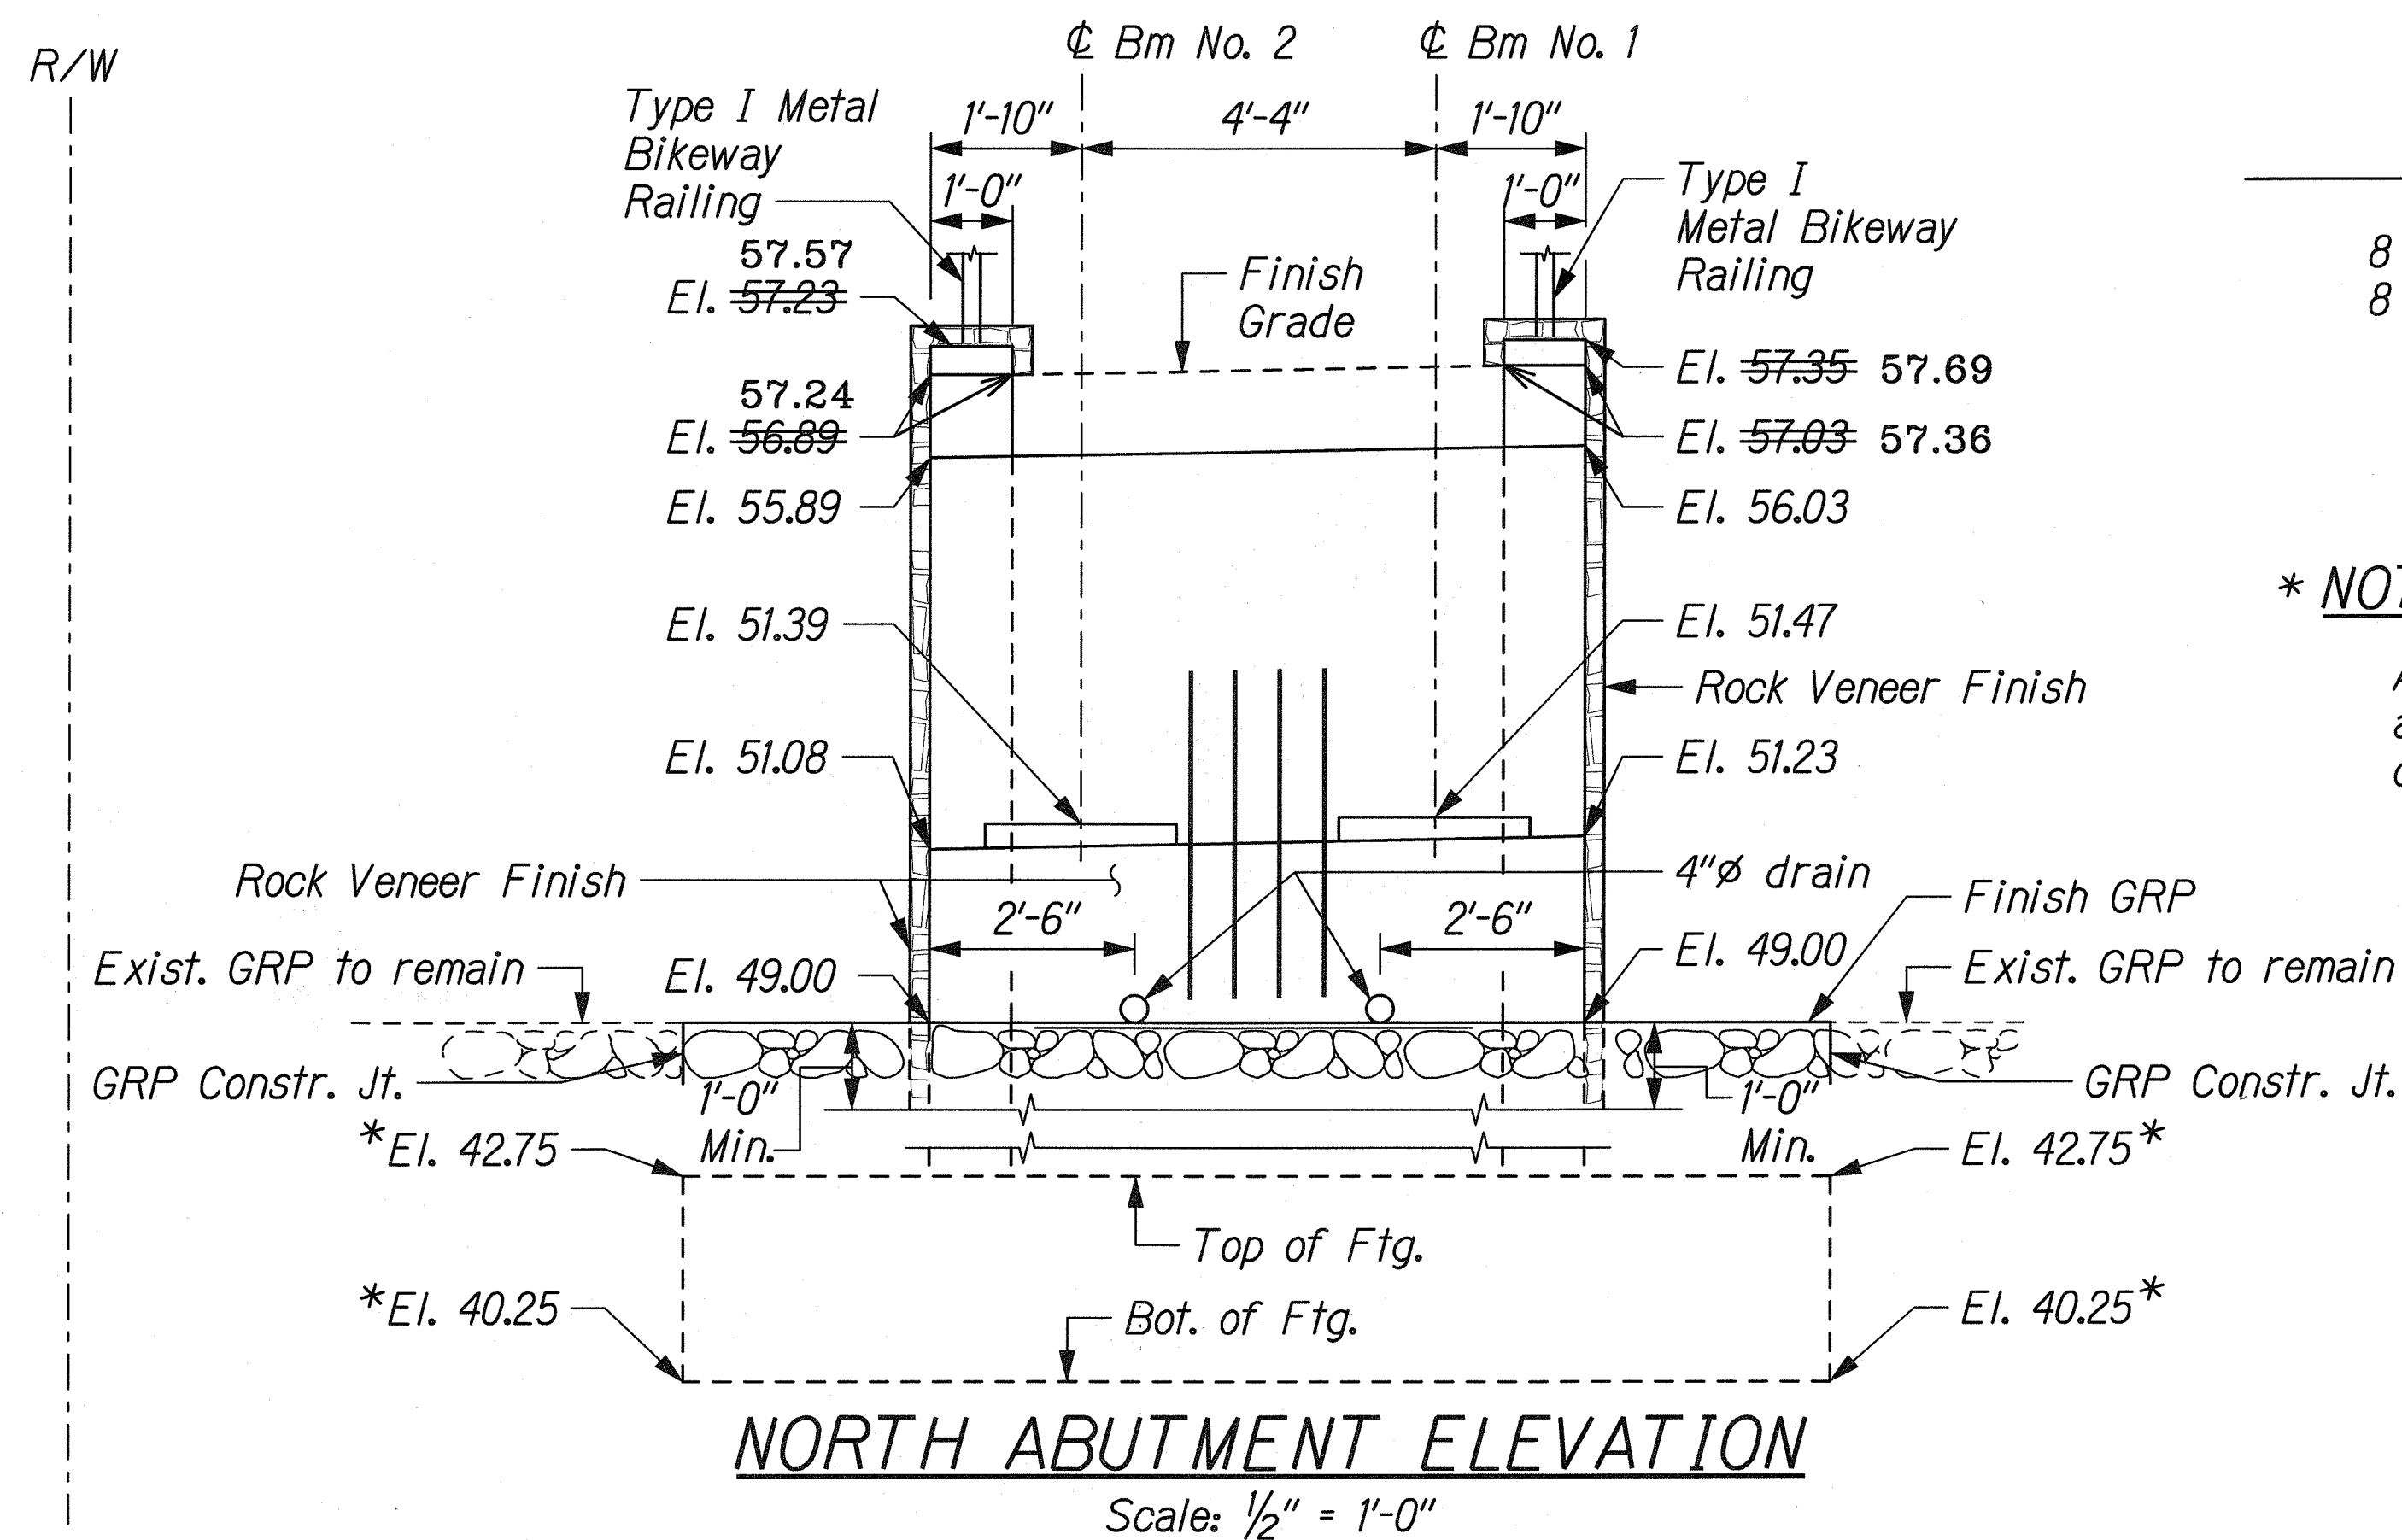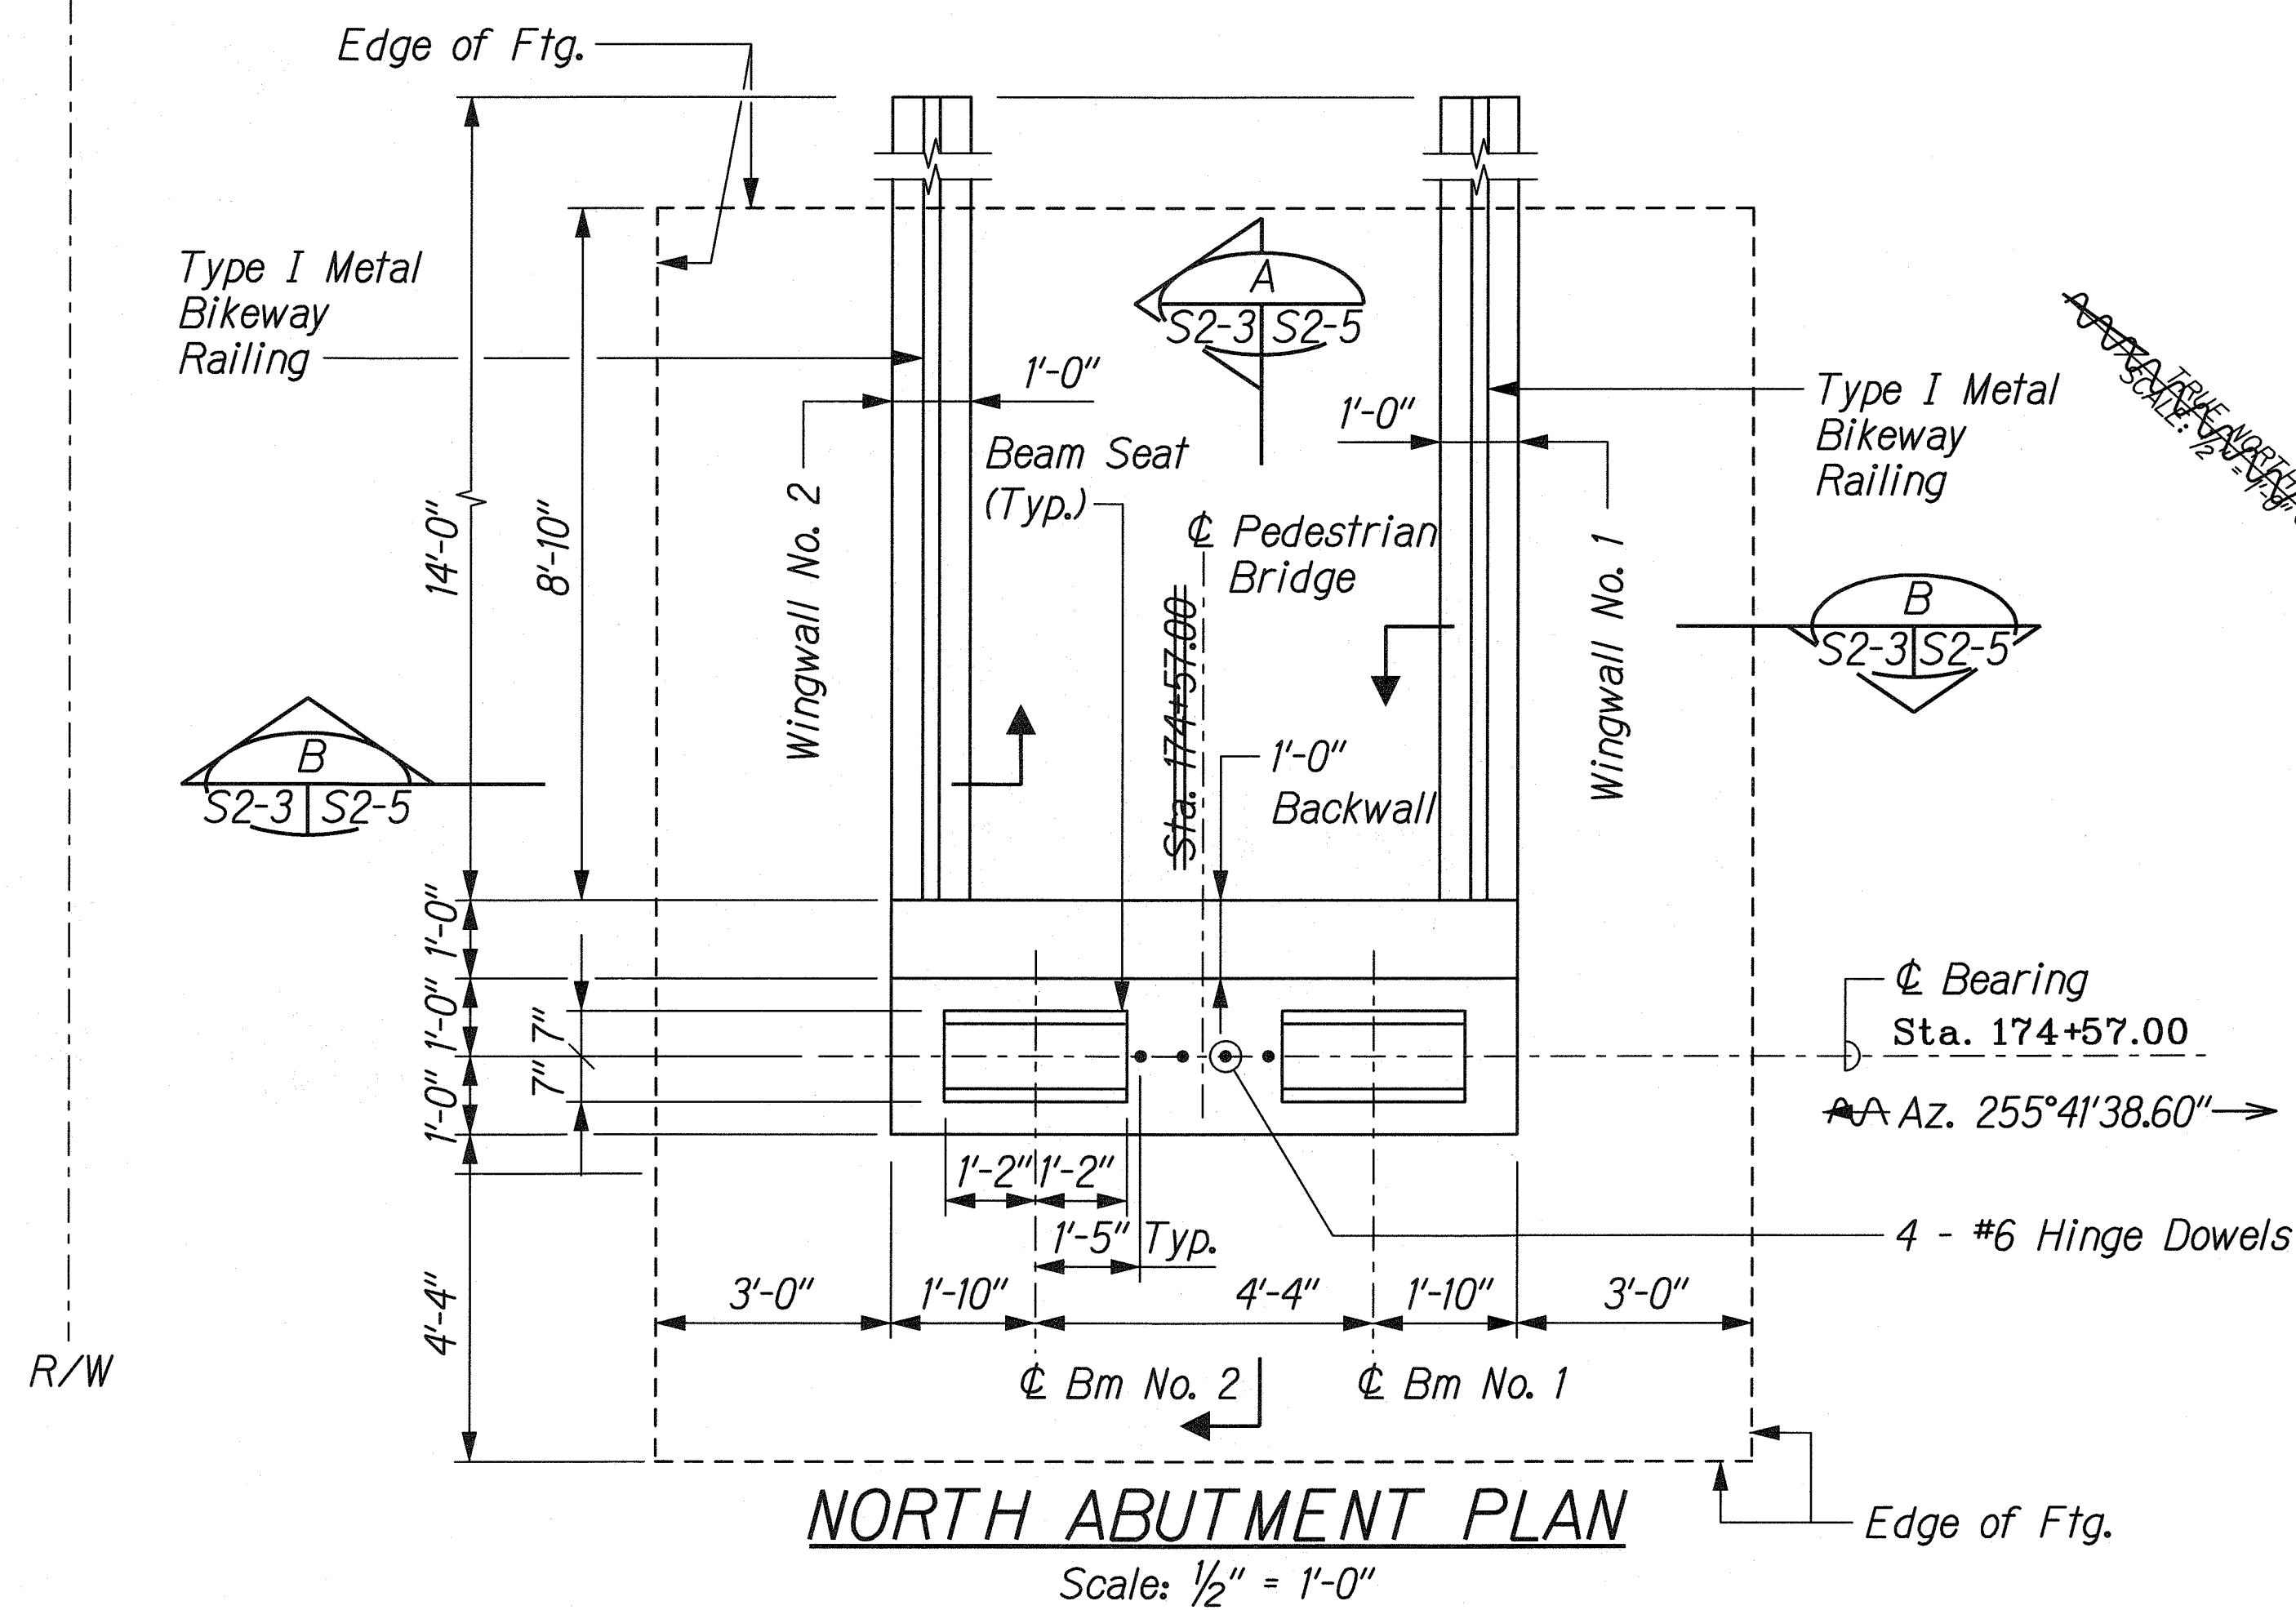

*** NOTE 'A':**
Adjust Footing elevations according to the requirements of Note 2 on Sht. S2-2.

NOTES:

- For location plan, see Sheet No. S2-2.
- For Beam Seat details, see Sheet. No. S2-5.
- For Type I Metal Bikeway Railing, see Sheet. No. S2-8 & S2-9.
- All concrete shall have 28-day compressive strength (fc') of 4,000 psi.
- All rebar shall be ASTM A615 Gr. 60.

STATE OF HAWAII
DEPARTMENT OF TRANSPORTATION
HIGHWAYS DIVISION

**CANE HAUL RD. PEDESTRIAN BRIDGE
ABUTMENT DETAILS - 1**

FORT WEAVER ROAD WIDENING
VICINITY OF AWA DRIVE TO GEIGER ROAD

Scale: As Noted Date: Feb. 22, 2008

THIS WORK WAS PREPARED BY ME
OR UNDER MY SUPERVISION

Hui Pang Chen
SIGNATURE

EXPIRATION DATE
04/30/10
OF THE LICENSE





SHEET No. S2-3 OF 9 SHEETS

AS BUILT **292**

SURVEY PLOTTED BY	DATE
DESIGNED BY	
CHECKED BY	
ORIGINAL PLAN	
NOTE BOOK	

FORT WEAVER ROAD/STRUCT/ST-DET-05-08

FED. ROAD DIST. NO.	STATE	FEDERAL AID PROJ. NO.	FISCAL YEAR	SHEET NO.	TOTAL SHEETS
HAWAII	HAW.	CMAQ-076-1(9)	2006	293	371

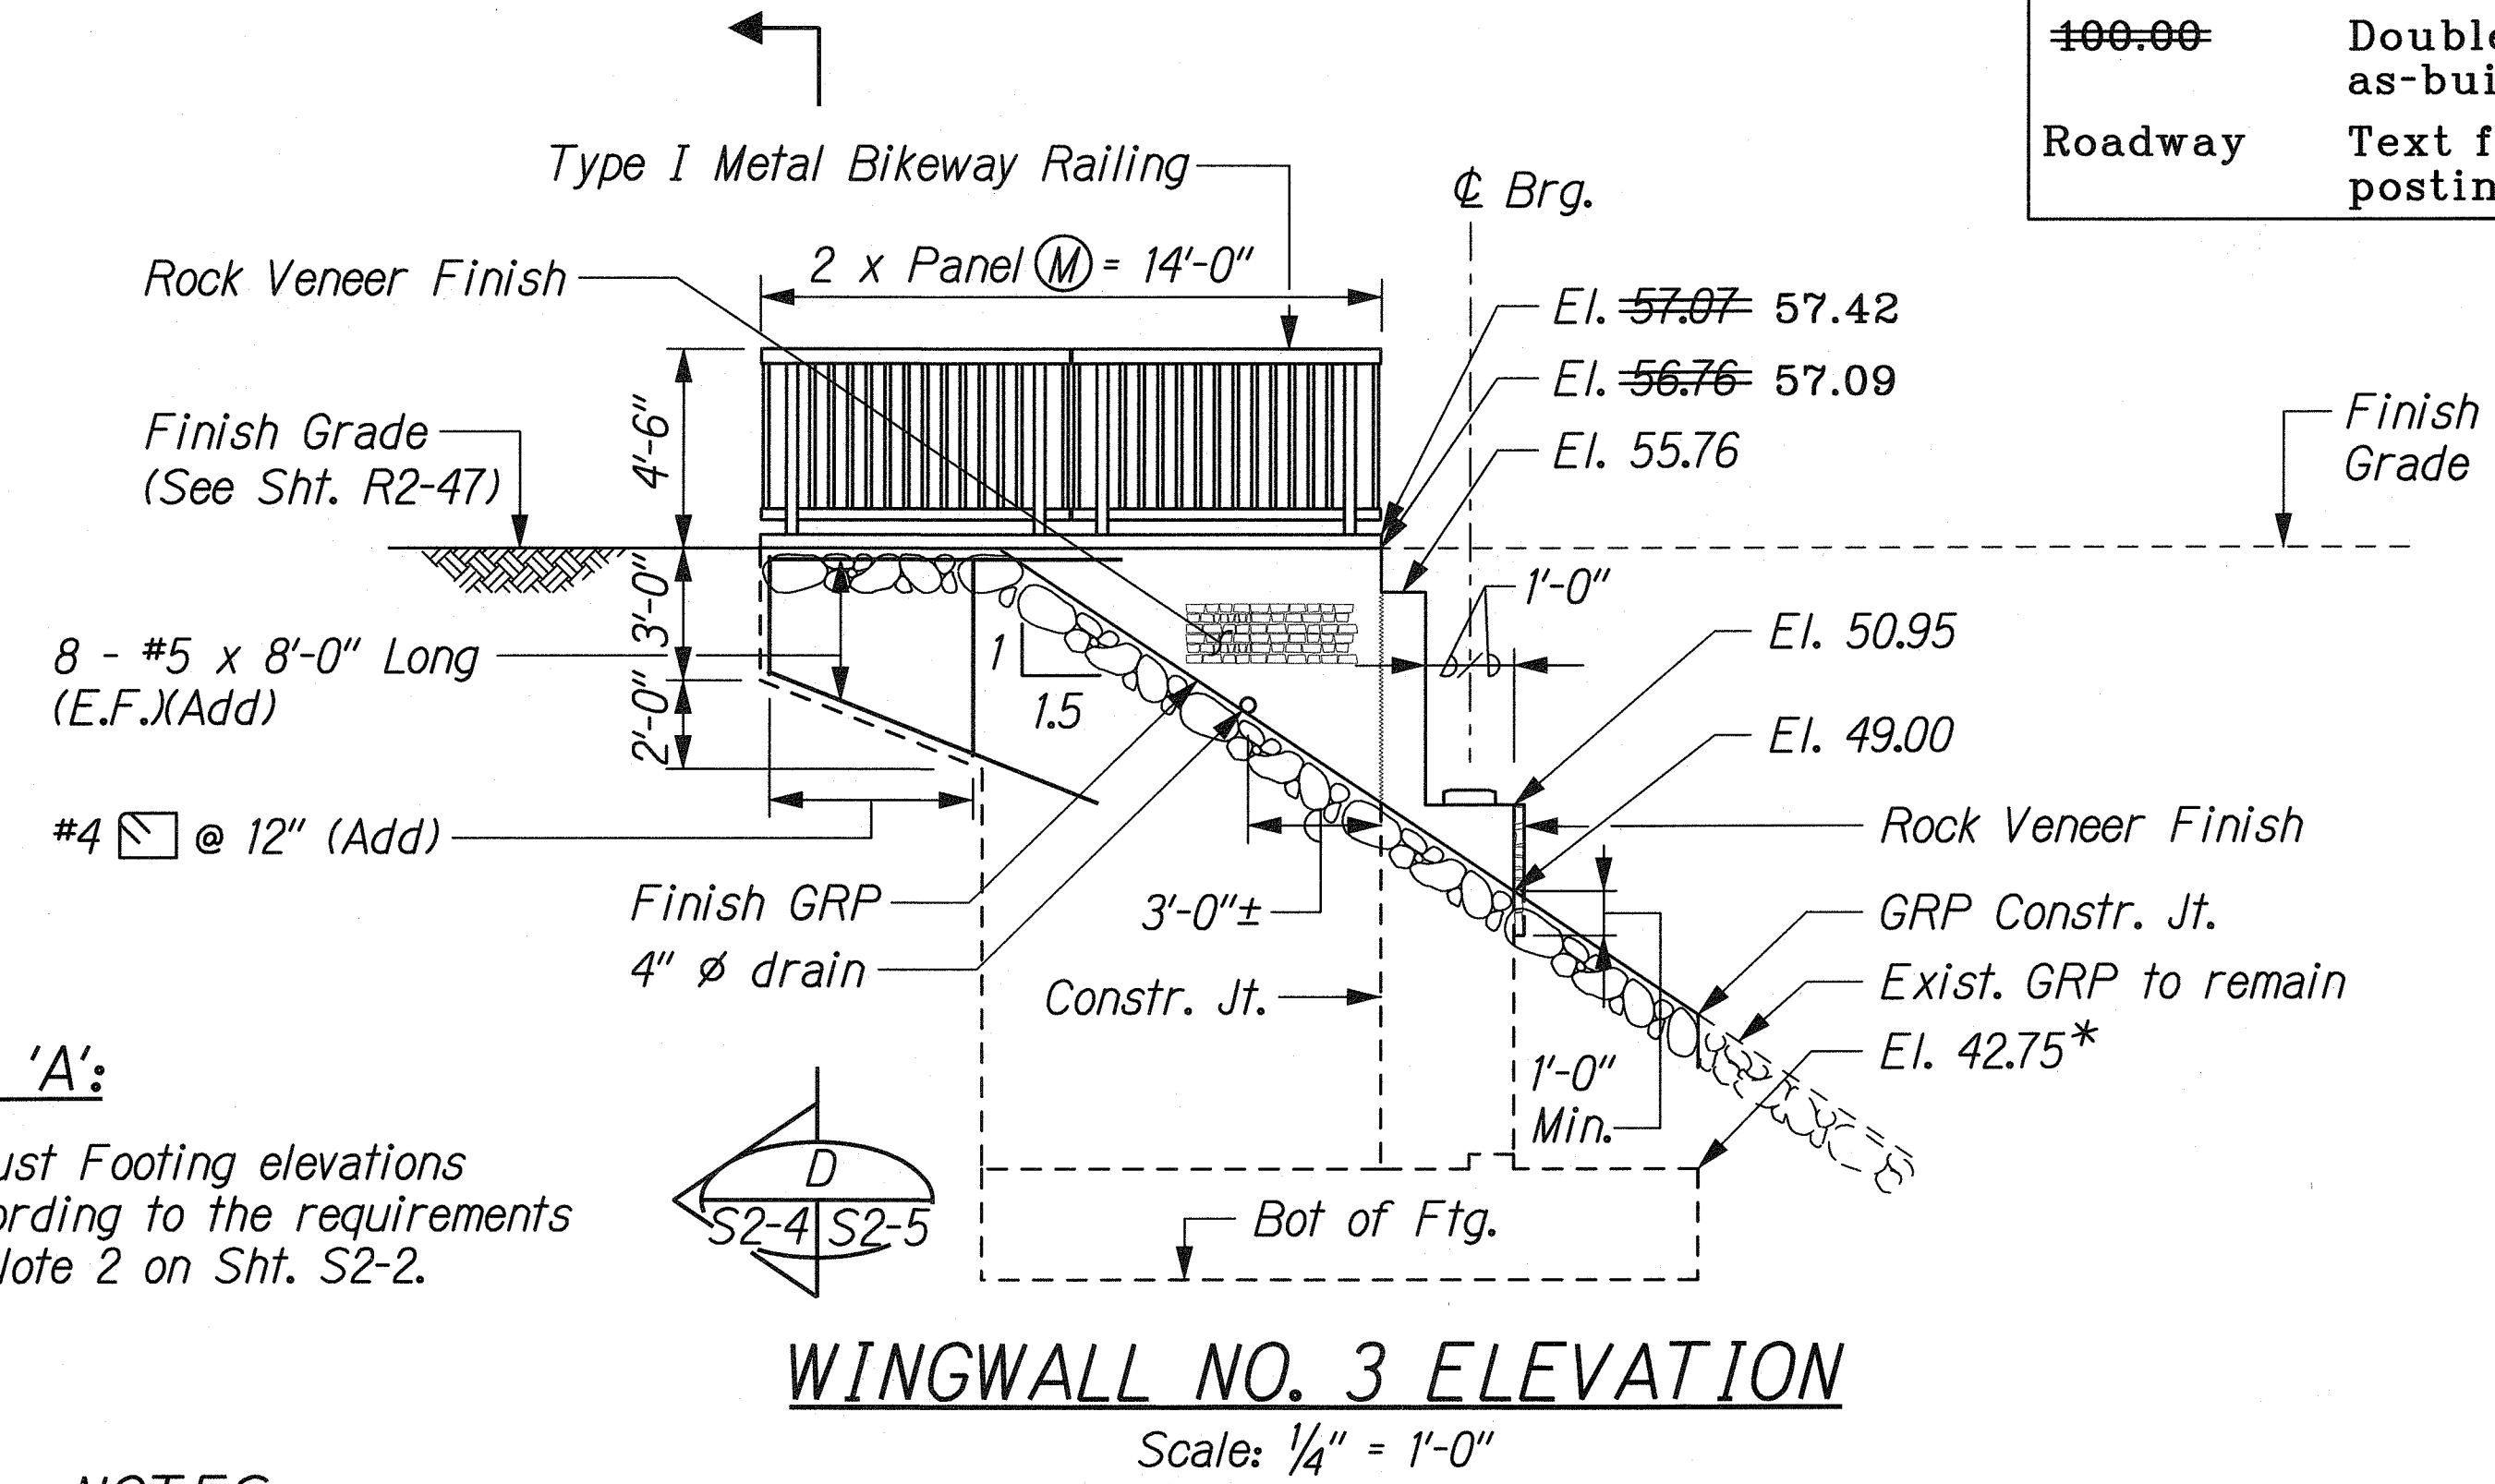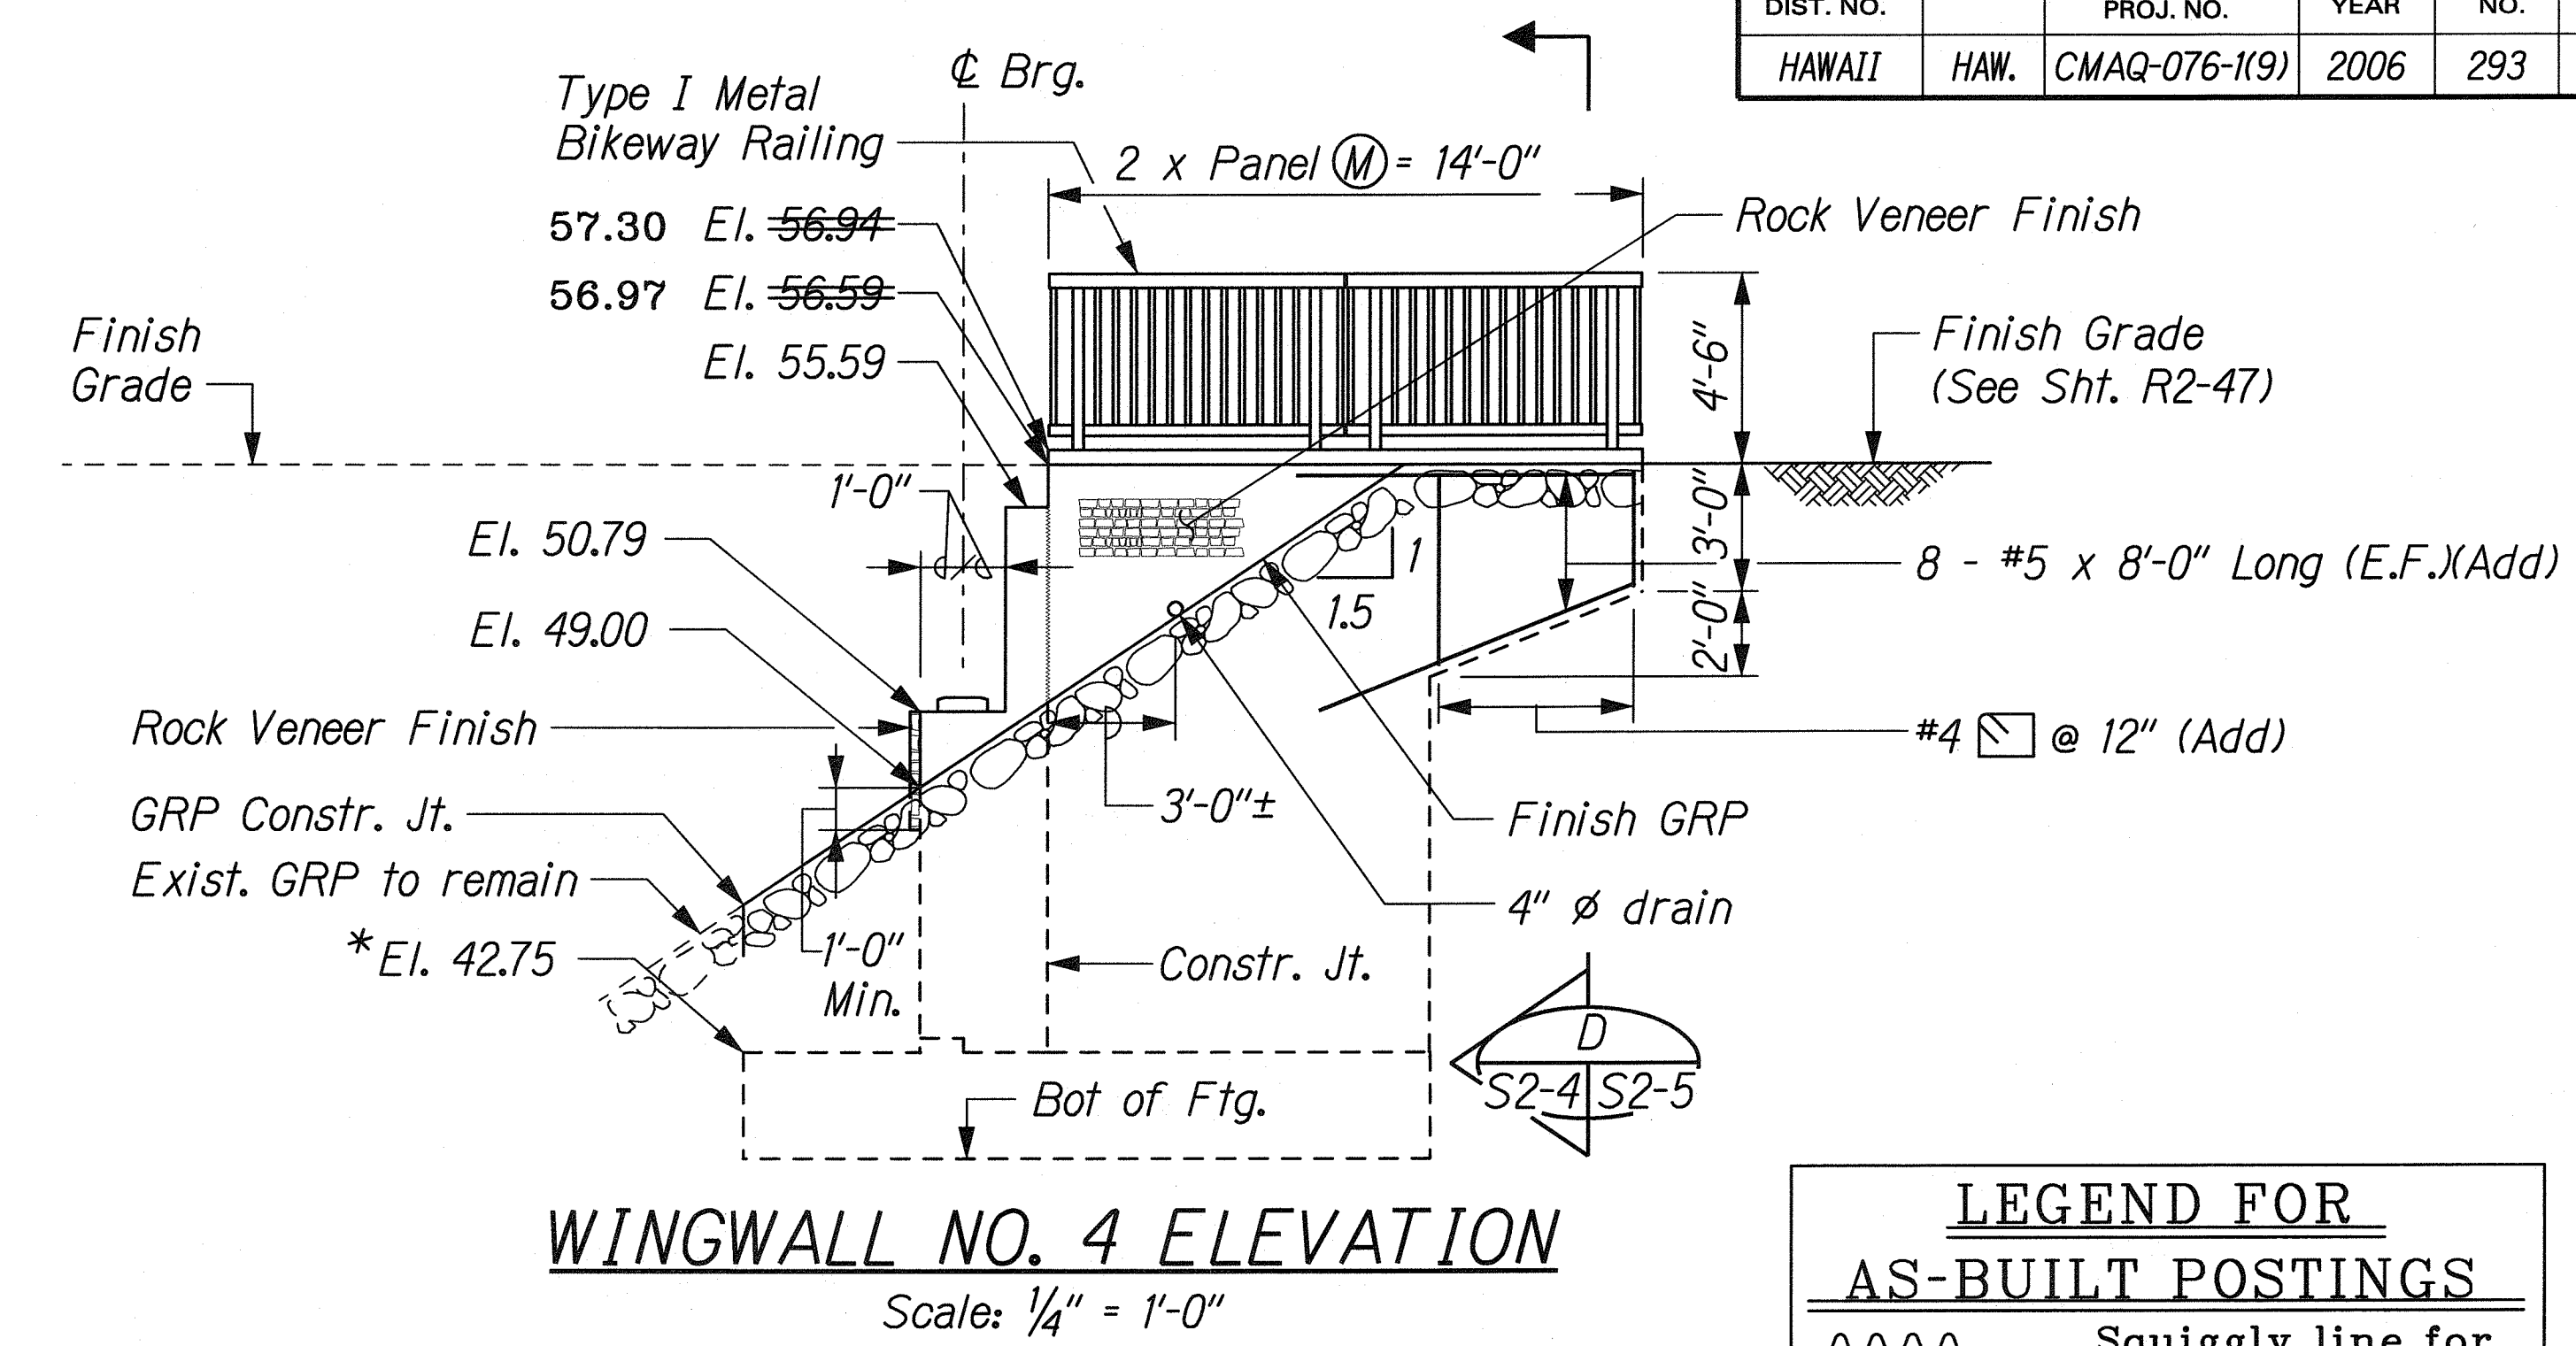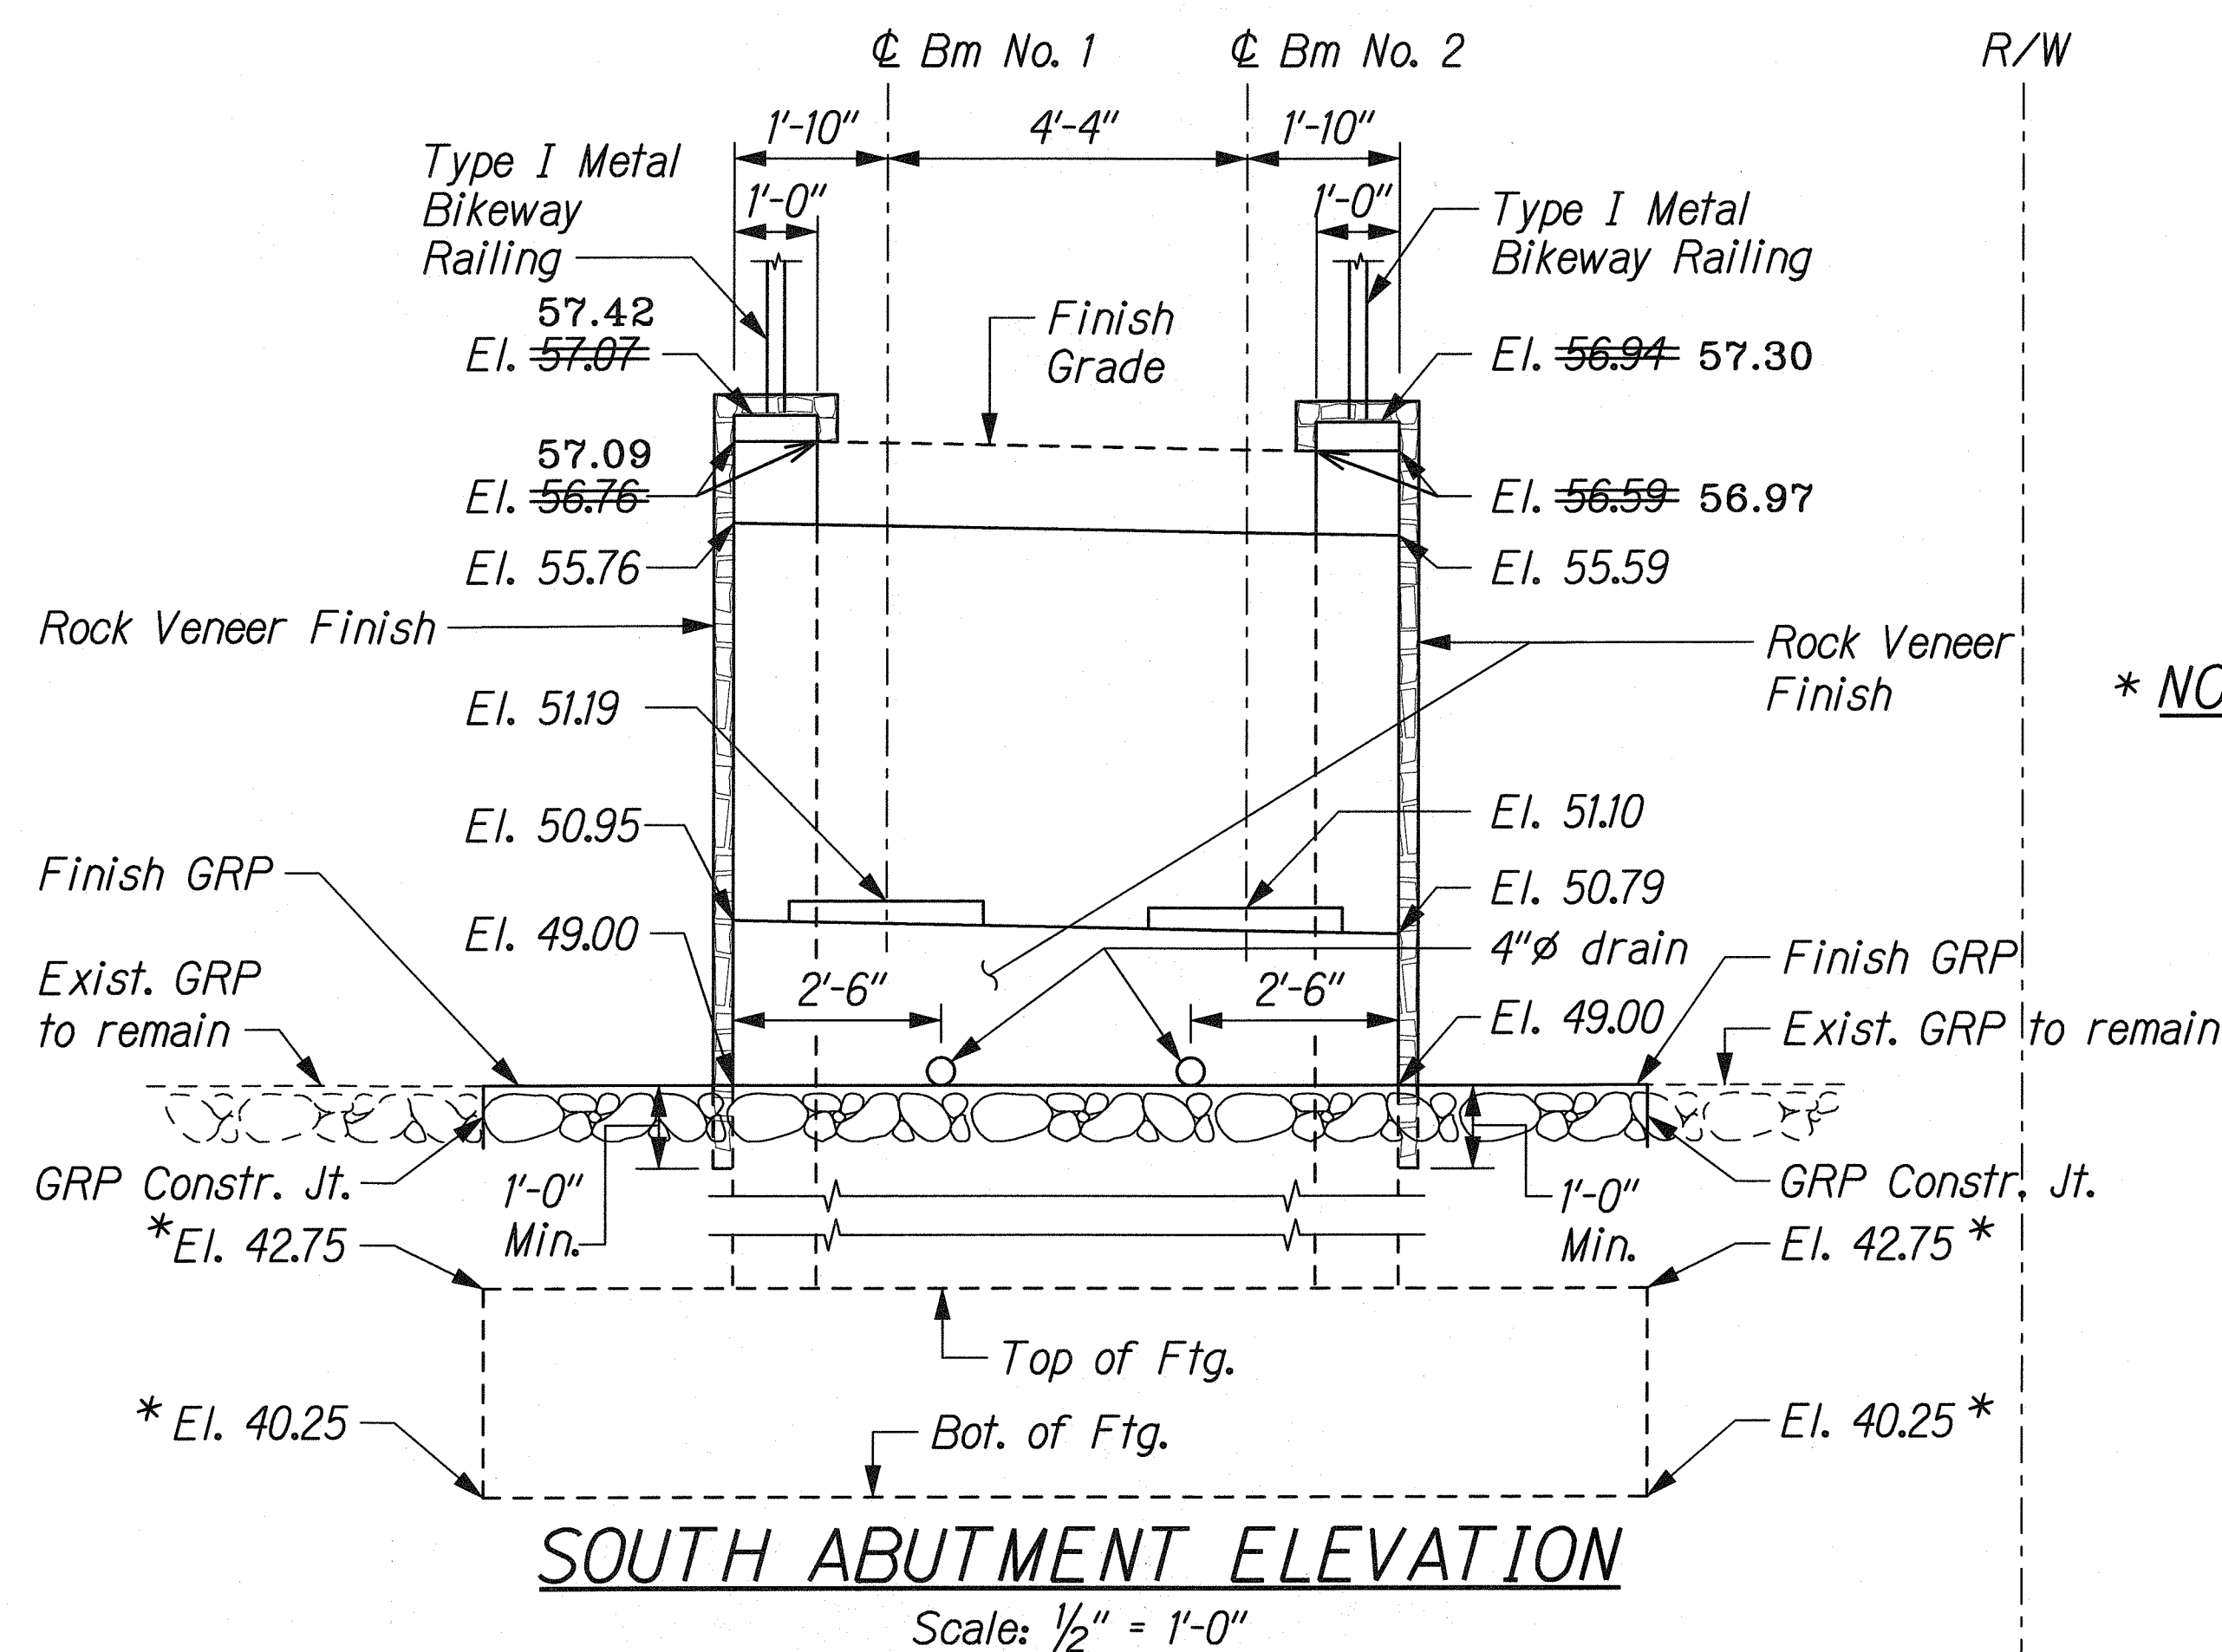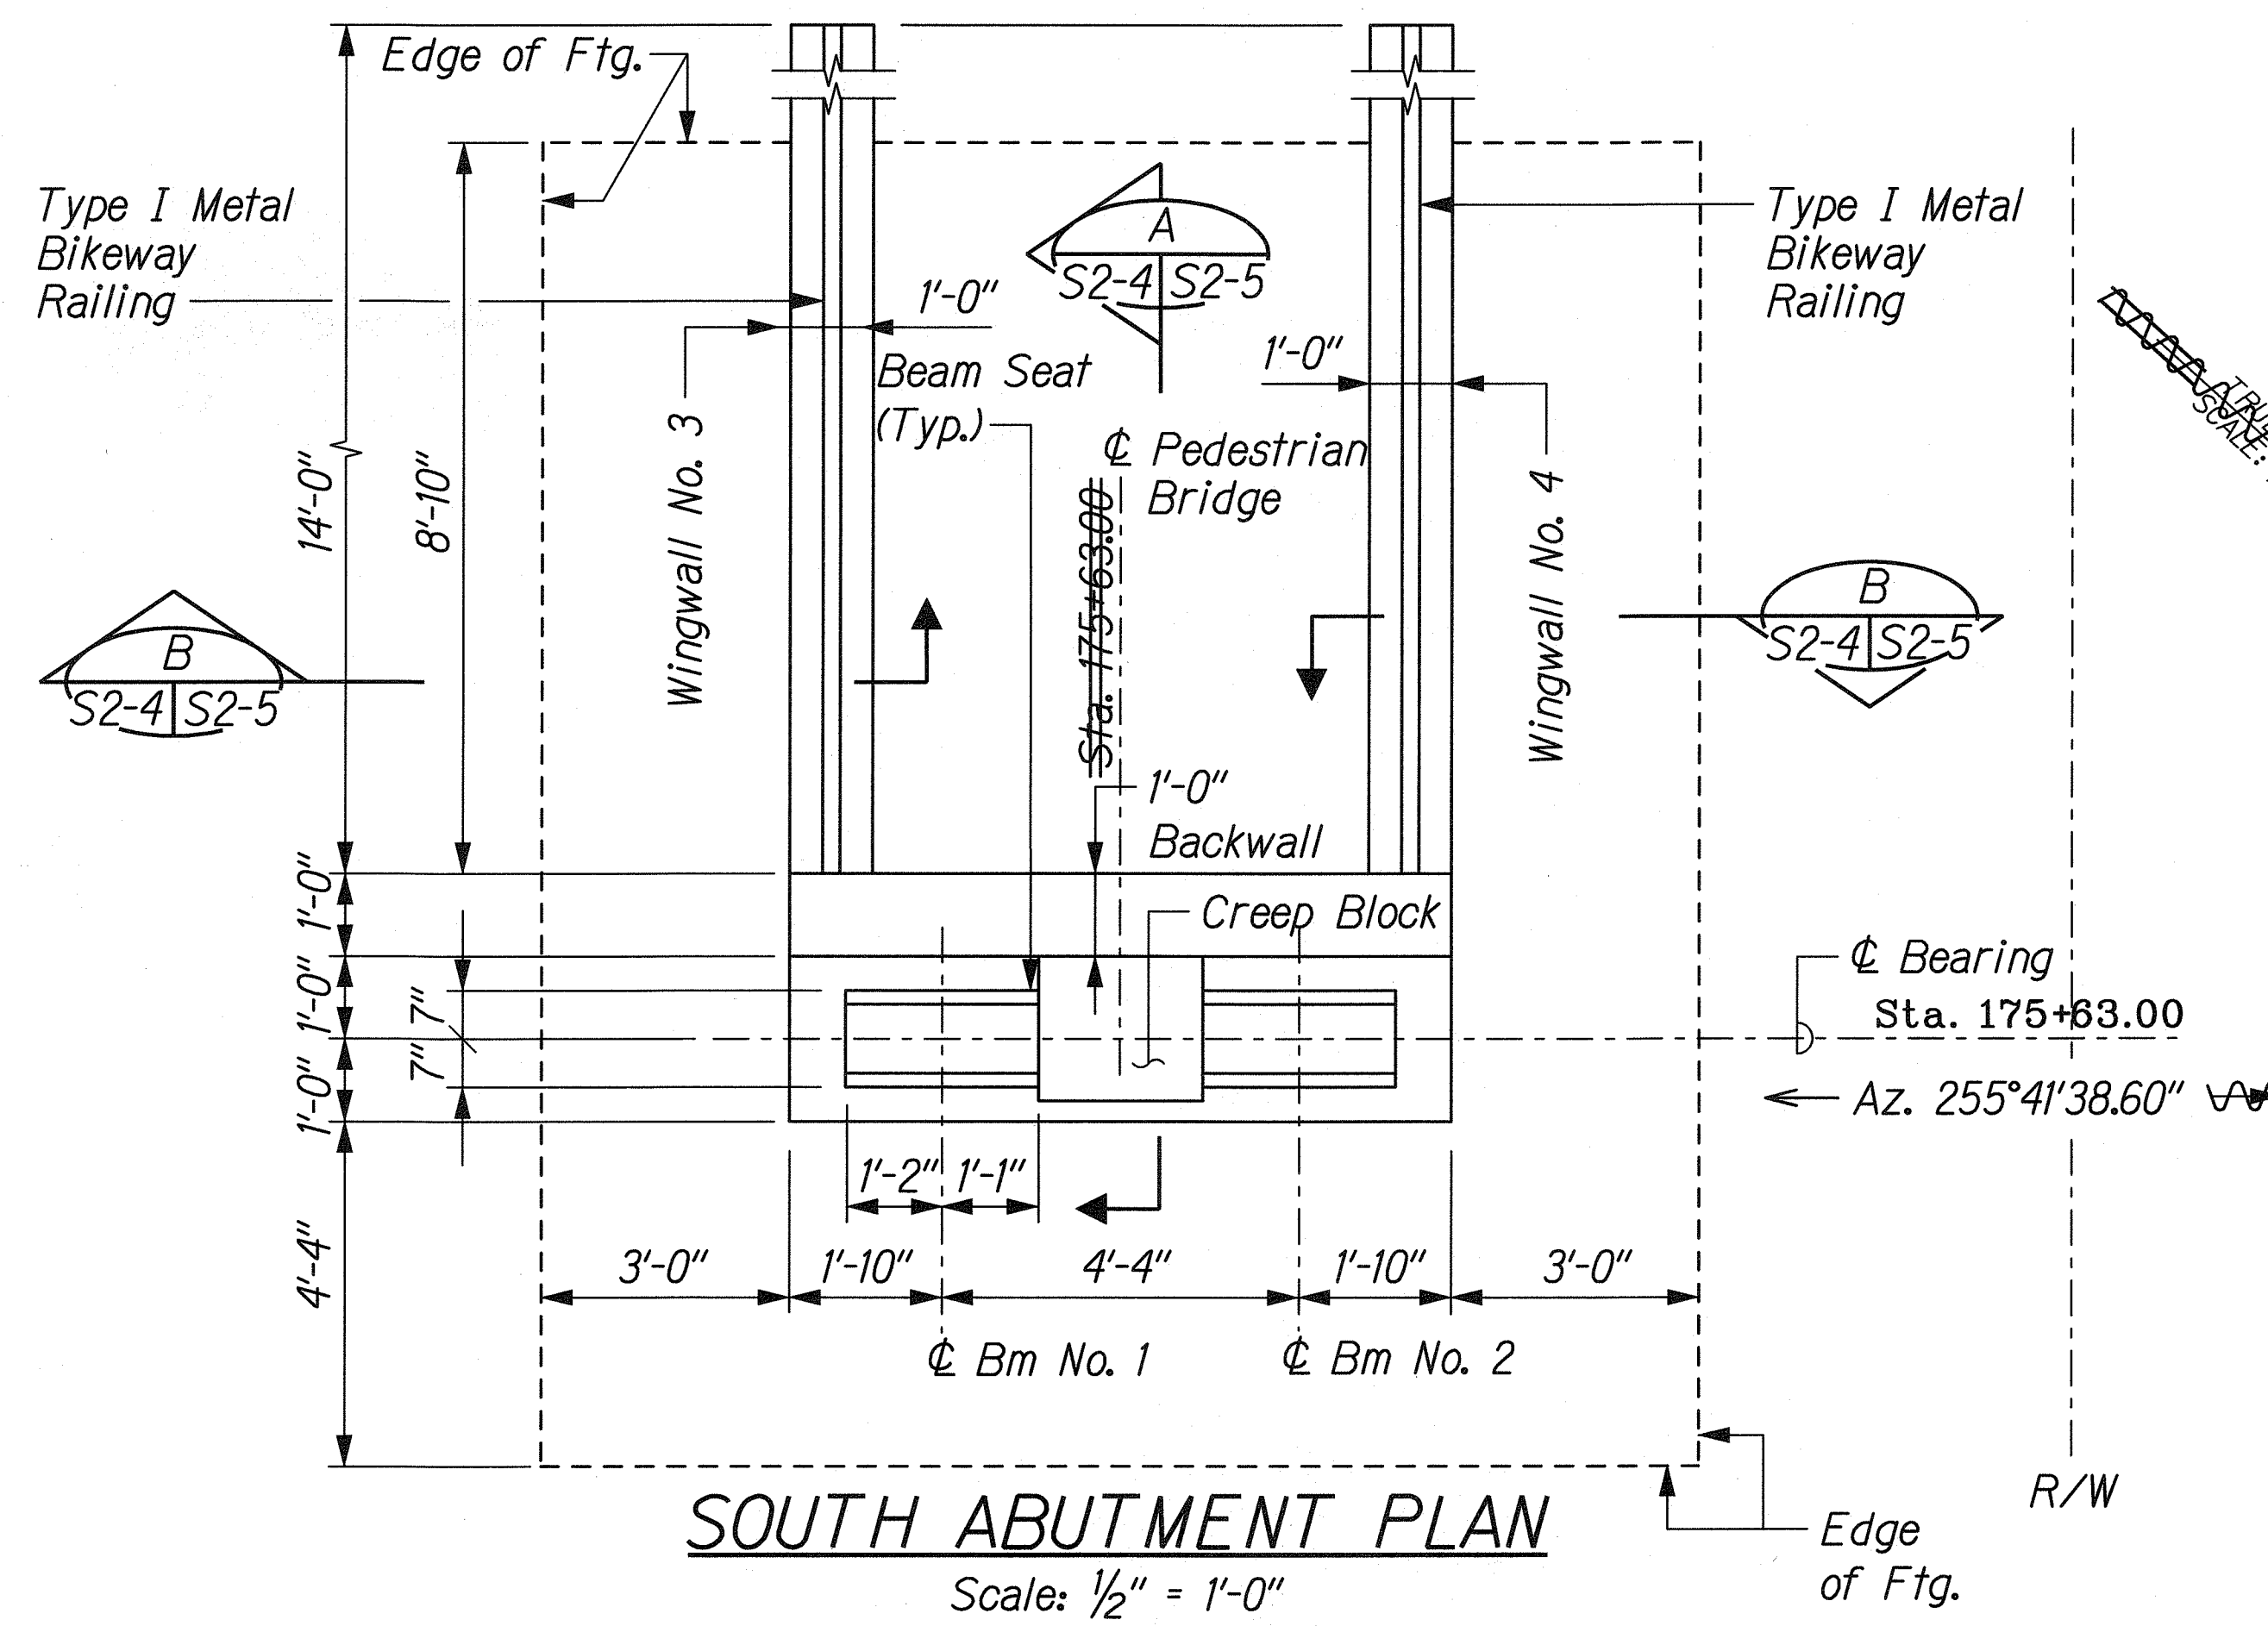

LEGEND FOR AS-BUILT POSTINGS	
	Squiggly line for as-built deletion
	Double line for as-built deletion
Roadway	Text for as-built posting

*** NOTE 'A':**
Adjust Footing elevations according to the requirements of Note 2 on Sht. S2-2.

- NOTES:**
- For location plan, see Sheet No. S2-2.
 - For Beam Seat and Creep Block details, see Sheet. No. S2-5.
 - For Type I Metal Bikeway Railing, see Sheet. No. S2-8 & S2-9.
 - All concrete shall have 28-day compressive strength (fc') of 4,000 psi.
 - All rebar shall be ASTM A615 Gr. 60.

STATE OF HAWAII
DEPARTMENT OF TRANSPORTATION
HIGHWAYS DIVISION

CANE HAUL RD. PEDESTRIAN BRIDGE
ABUTMENT DETAILS - 2

FORT WEAVER ROAD WIDENING
VICINITY OF AAWA DRIVE TO GEIGER ROAD

Scale: As Noted Date: Feb. 22, 2008

SHEET No. S2-4 OF 9 SHEETS

HUI PANG CHEN
LICENSED PROFESSIONAL ENGINEER
No. 3865-S
HAWAII, U.S.A.

THIS WORK WAS PREPARED BY ME OR UNDER MY SUPERVISION.

Hui Pang Chen
SIGNATURE



04/30/10
EXPIRATION DATE OF THE LICENSE

AS BUILT

293



SURVEY PLOTTED BY	DATE
DESIGNED BY	
TRACED BY	
NOTE BOOK	
QUANTITIES BY	
CHECKED BY	

L/FORT WEAVER ROAD/STRUCT/ST-DET06.dgn

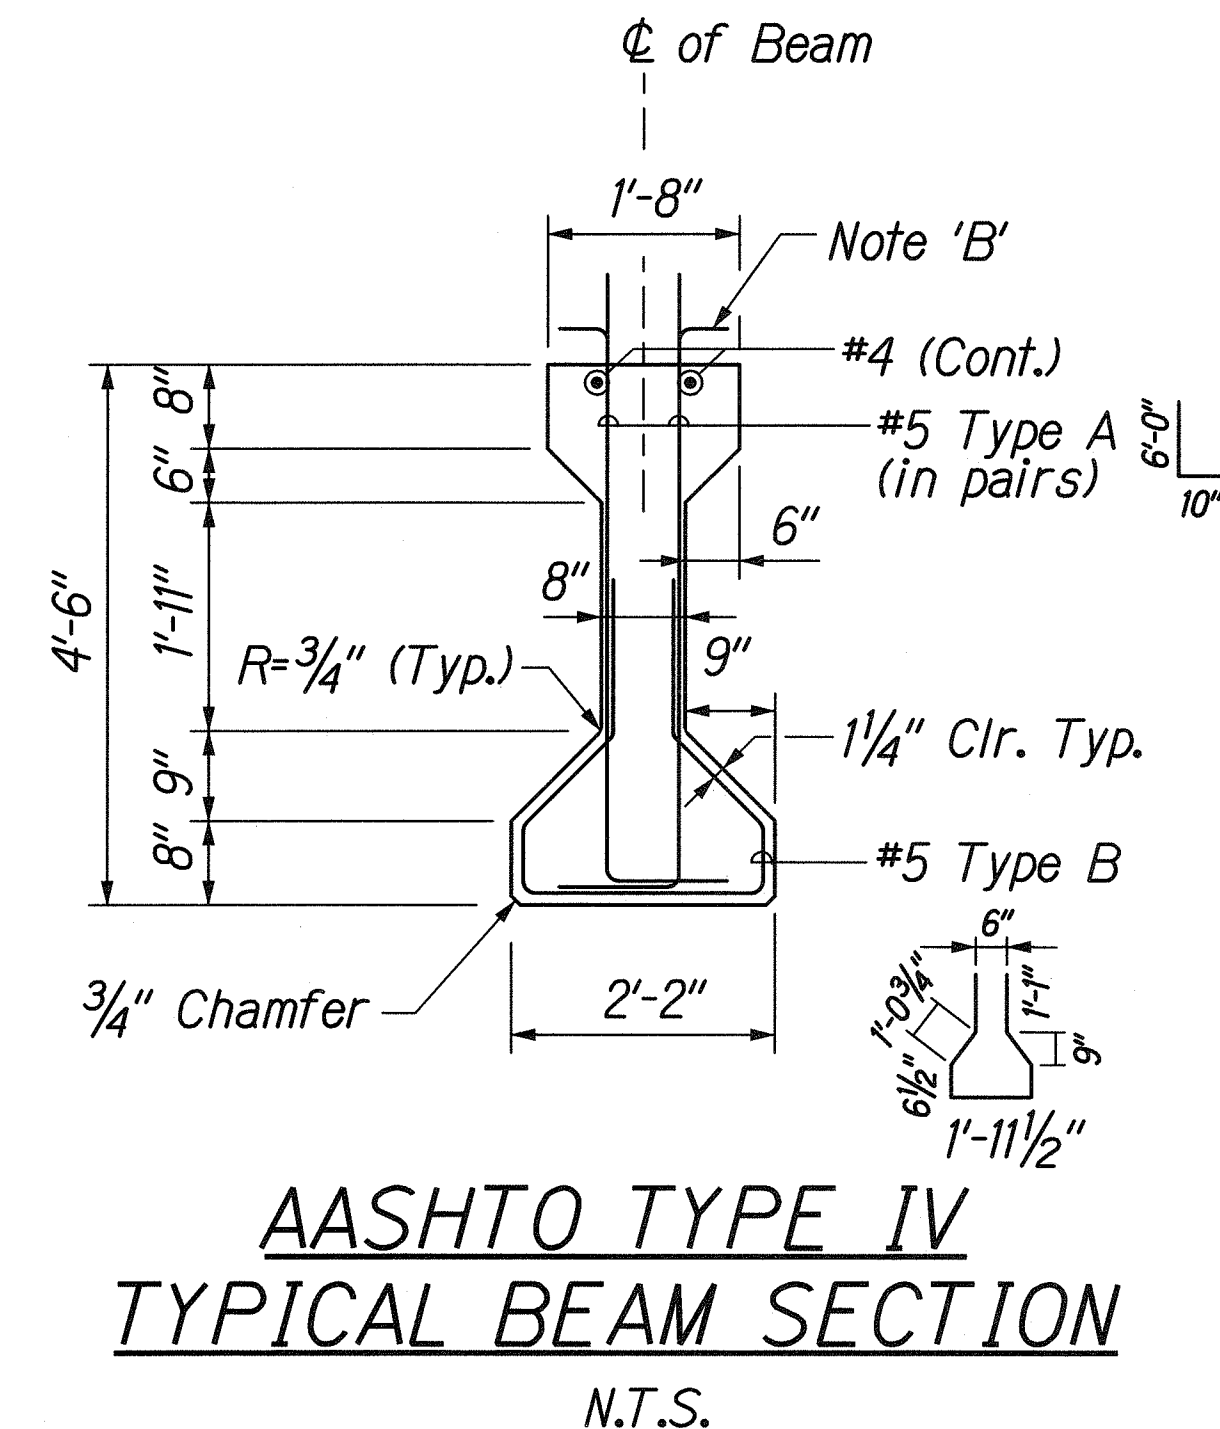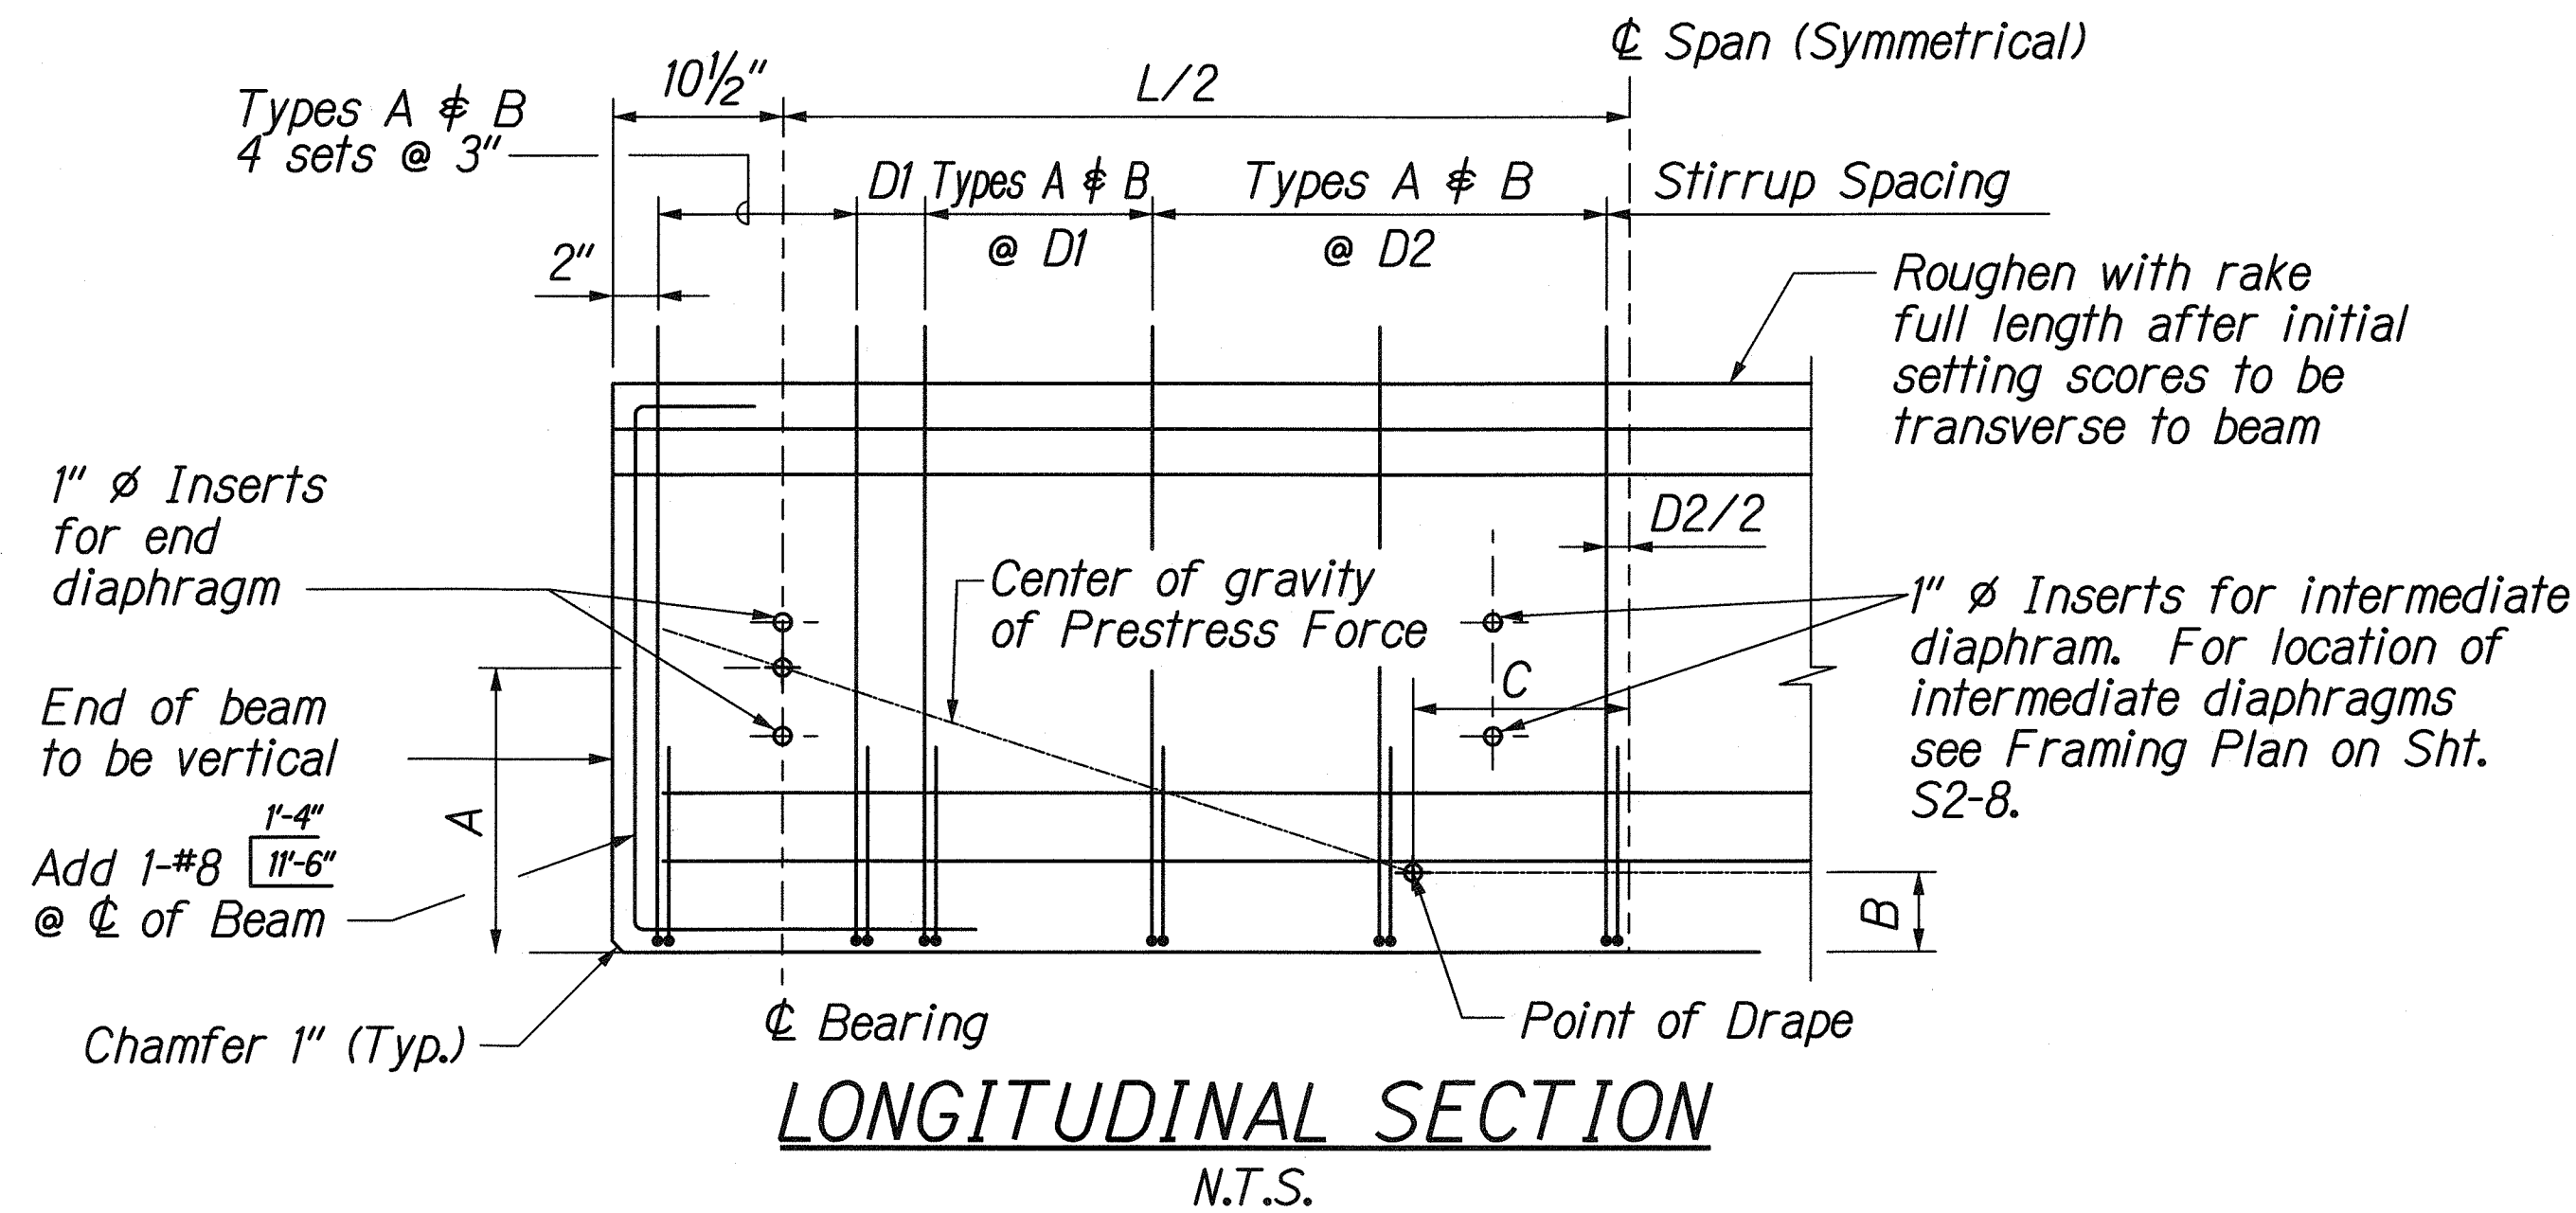

PRESTRESSED BEAM NOTES:

1. Minimum Concrete strength for precast/prestressed concrete beam shall be 6000 psi at 28 days.
2. Minimum compressive strength of concrete at transfer, see Table this Sheet.
3. Prestressing strands shall be 1/2" diameter, 270 ksi, low-relax strands conforming to ASTM A 416. The estimated total losses due to creep, shrinkage, elastic shortening, and relaxation of steel are 43,900 psi.
4. Non-prestressed reinforcing steel in prestressed beam shall be Grade 60 unless otherwise noted. For properties, see State Standard Specifications.
5. The calculated camber includes the effect of the initial prestress force and the weight of the beam after removal from the bed. Negative values shown for calculated camber indicate a net upward deflection. The calculated camber values shown do not account for any camber growth of the beam. The actual camber shall not exceed the calculated camber shown on the plans by more than 100% at time of installation.
6. The dead load deflection includes the combined effects of the weight of beam, slab, haunch, diaphragm, and concrete railing.
7. Strand release sequence shall not induce any lateral deflection of the beam. For Strand release procedures, see Special Provisions.
8. The Contractor shall submit his proposed strand releasing sequence to the Engineer for acceptance.
9. During curing, care shall be taken to avoid any lateral deflection of the beam due to improper orientation.
10. Lifting devices shall be placed as close as possible to the centerline of bearings of the beam. Details and locations of lifting devices shall be submitted to the Engineer for acceptance. Such approval does not relieve the Contractor of his responsibilities if beam is damaged due to the failure of the lifting device.
11. For details of end and intermediate diagrams see Sheet No. S2-7.

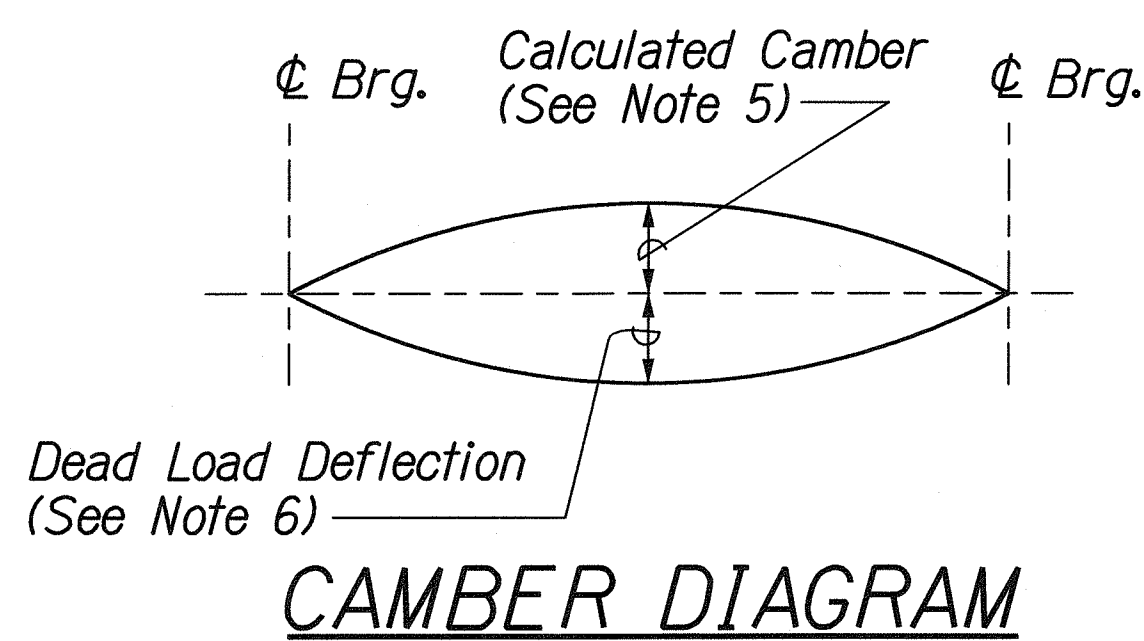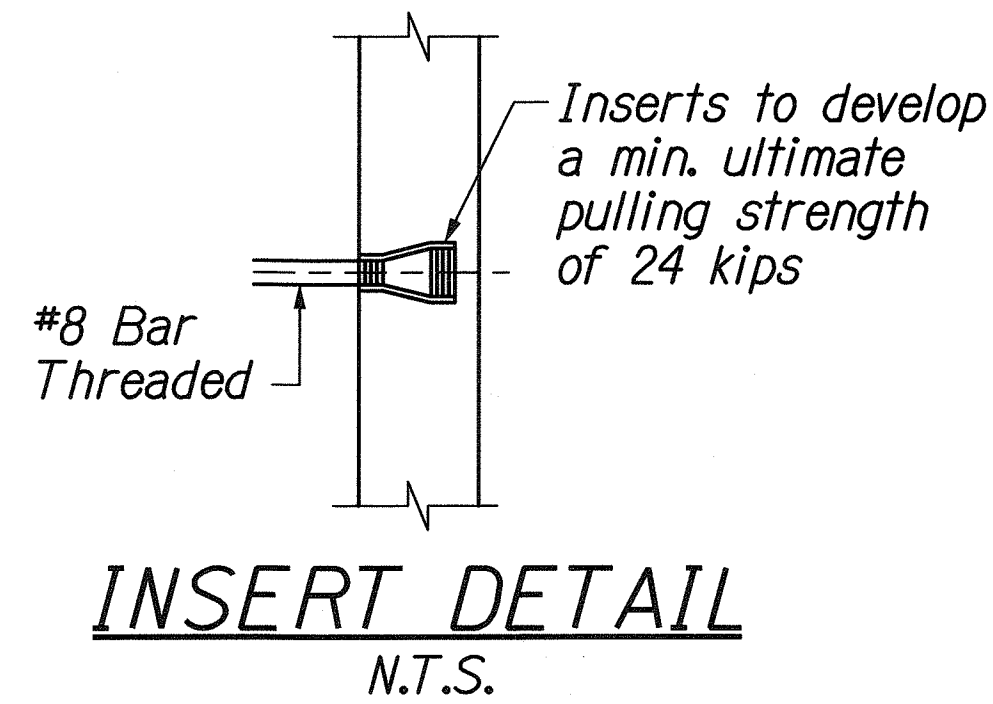


NOTE 'A':

For low relaxation strands, the stress immediately prior to transfer shall not exceed 0.75 fs', where fs' is the ultimate tensile strength of prestressing steel.

NOTE 'B':

Bend bars in field 2" below top of deck. All reinforcing dimensions are out to out.

BEAM SCHEDULE										
BEAM TYPE	INITIAL PRESTRESS FORCE (KIPS) (BEFORE ANY LOSS)	FINAL PRESTRESS FORCE (KIPS) (AFTER ALL LOSSES)	CALCULATED CAMBER SEE NOTE 5	DEAD LOAD DEFLECTION SEE NOTE 6	LOCATION OF CENTER OF GRAVITY OF PRESTRESSED FORCE			STIRRUPS		REMARKS
					DIST A	DIST B	DIST. TO PT. OF DRAPE C	NO. OF STIRRUPS @ SPACING D1	NO. OF STIRRUPS @ SPACING D2	
IV	1239.3	970.63	-1.283"	1.195"	14.19"	5.73"	10'-6"	25 @ 12"	Balance @ 18"	4500

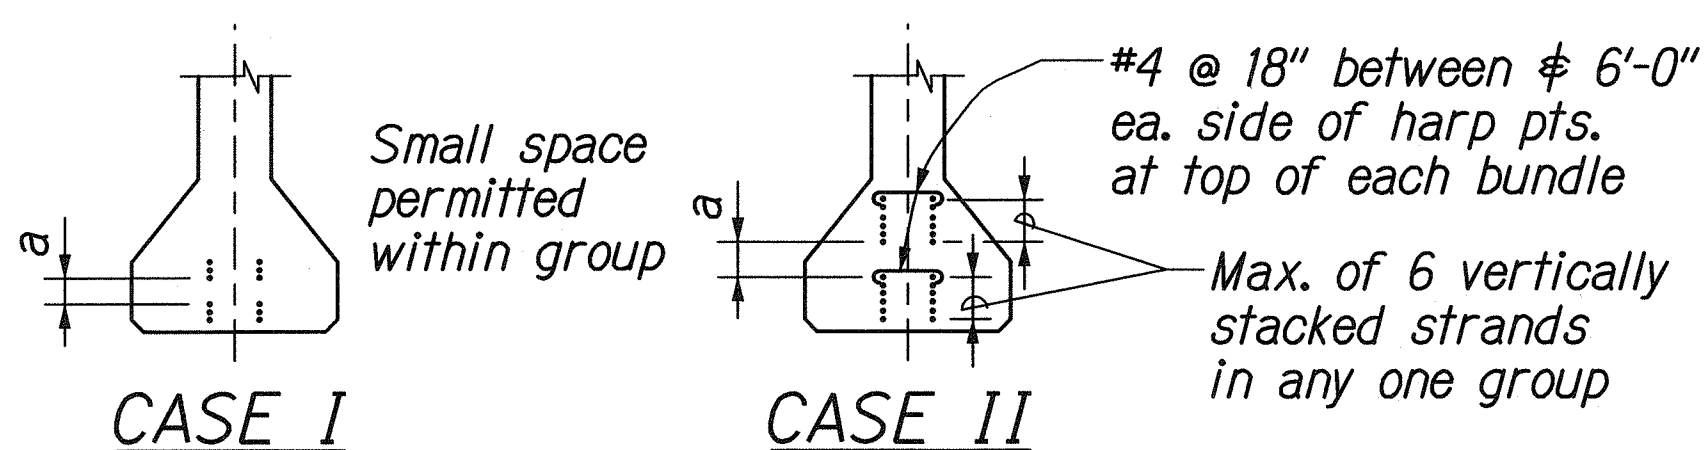

ARRANGEMENT AND CLEARANCE FOR PRETENSIONED STRANDS

1. Strands may be bundled in groups as shown.
2. The min. distance "a" between groups or individual strands is 2" for 1/2" ø Strands.
3. "a" is measured between centers of adjacent strands.

BUNDLING OF PRESTRESSED REINFORCEMENT

DESIGNED BY	DATE
TRACED BY	
NOTED BY	
CHECKED BY	
ORIGINAL PLAN	
NOTE BOOK	
NO.	

1/4 FORT WEAVER ROAD, STRUCT/ST-DET/04/09

THIS WORK WAS PREPARED BY ME OR UNDER MY SUPERVISION.

Signature: Hui Pang Chen

EXPIRATION DATE OF THE LICENSE: 04/30/10

STATE OF HAWAII
DEPARTMENT OF TRANSPORTATION
HIGHWAYS DIVISION


CANE HAUL RD. PEDESTRIAN BRIDGE

BEAM DETAILS - 1


FORT WEAVER ROAD WIDENING
VICINITY OF AAWA DRIVE TO GEIGER ROAD

Scale: Not to Scale Date: Feb. 22, 2008

FED. ROAD DIST. NO.	STATE	FEDERAL AID PROJ. NO.	FISCAL YEAR	SHEET NO.	TOTAL SHEETS
HAWAII	HAW.	CMAQ-076-1(9)	2006	296	371

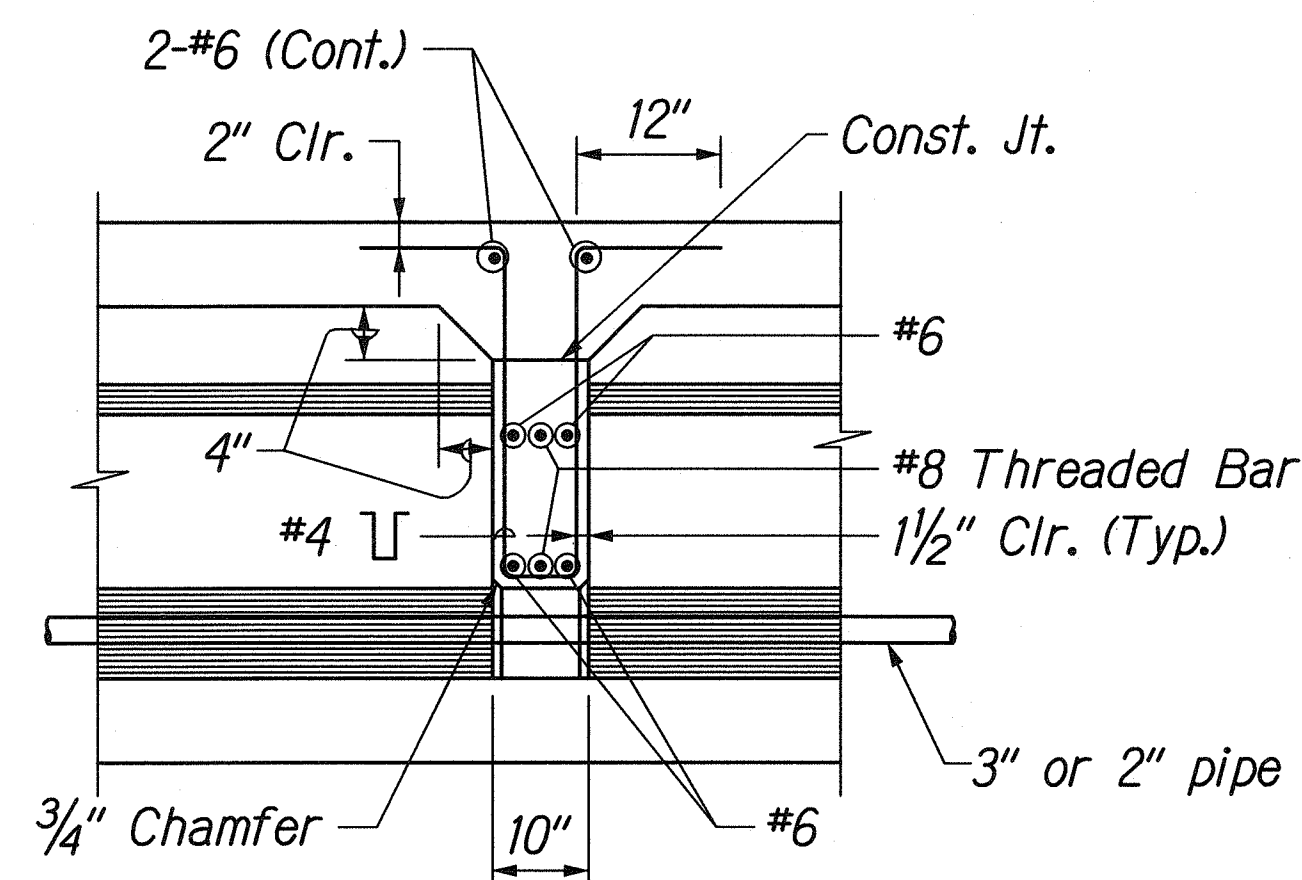


SECTION A
S2-7 S2-7

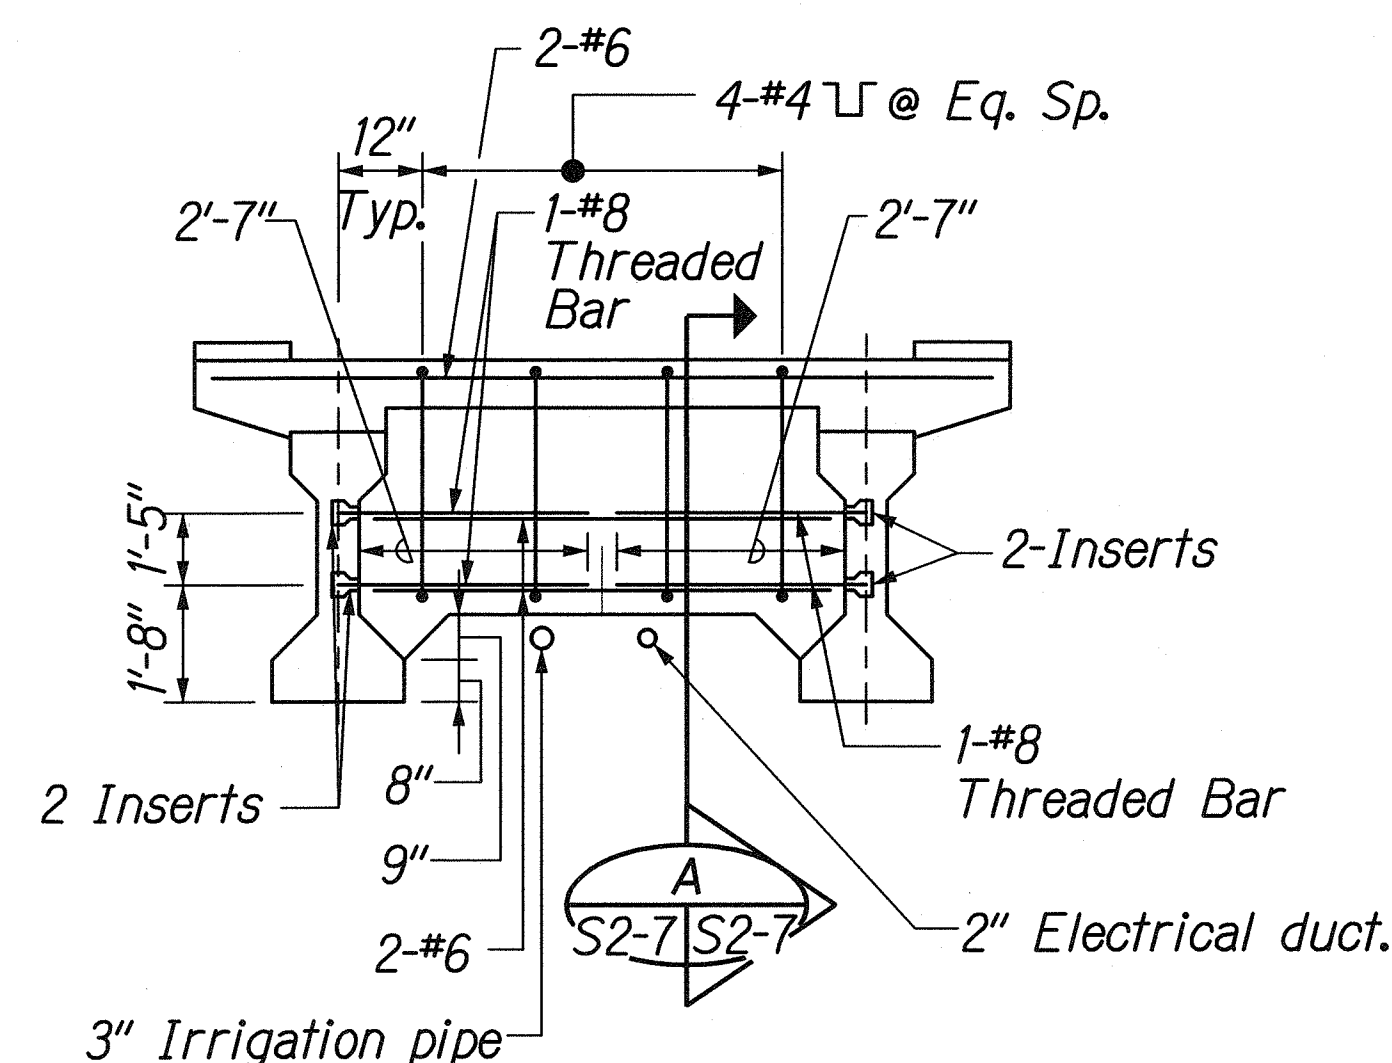


INTERMEDIATE DIAPHRAGM

TYPICAL INTERMEDIATE DIAPHRAGM DETAILS

N.T.S.

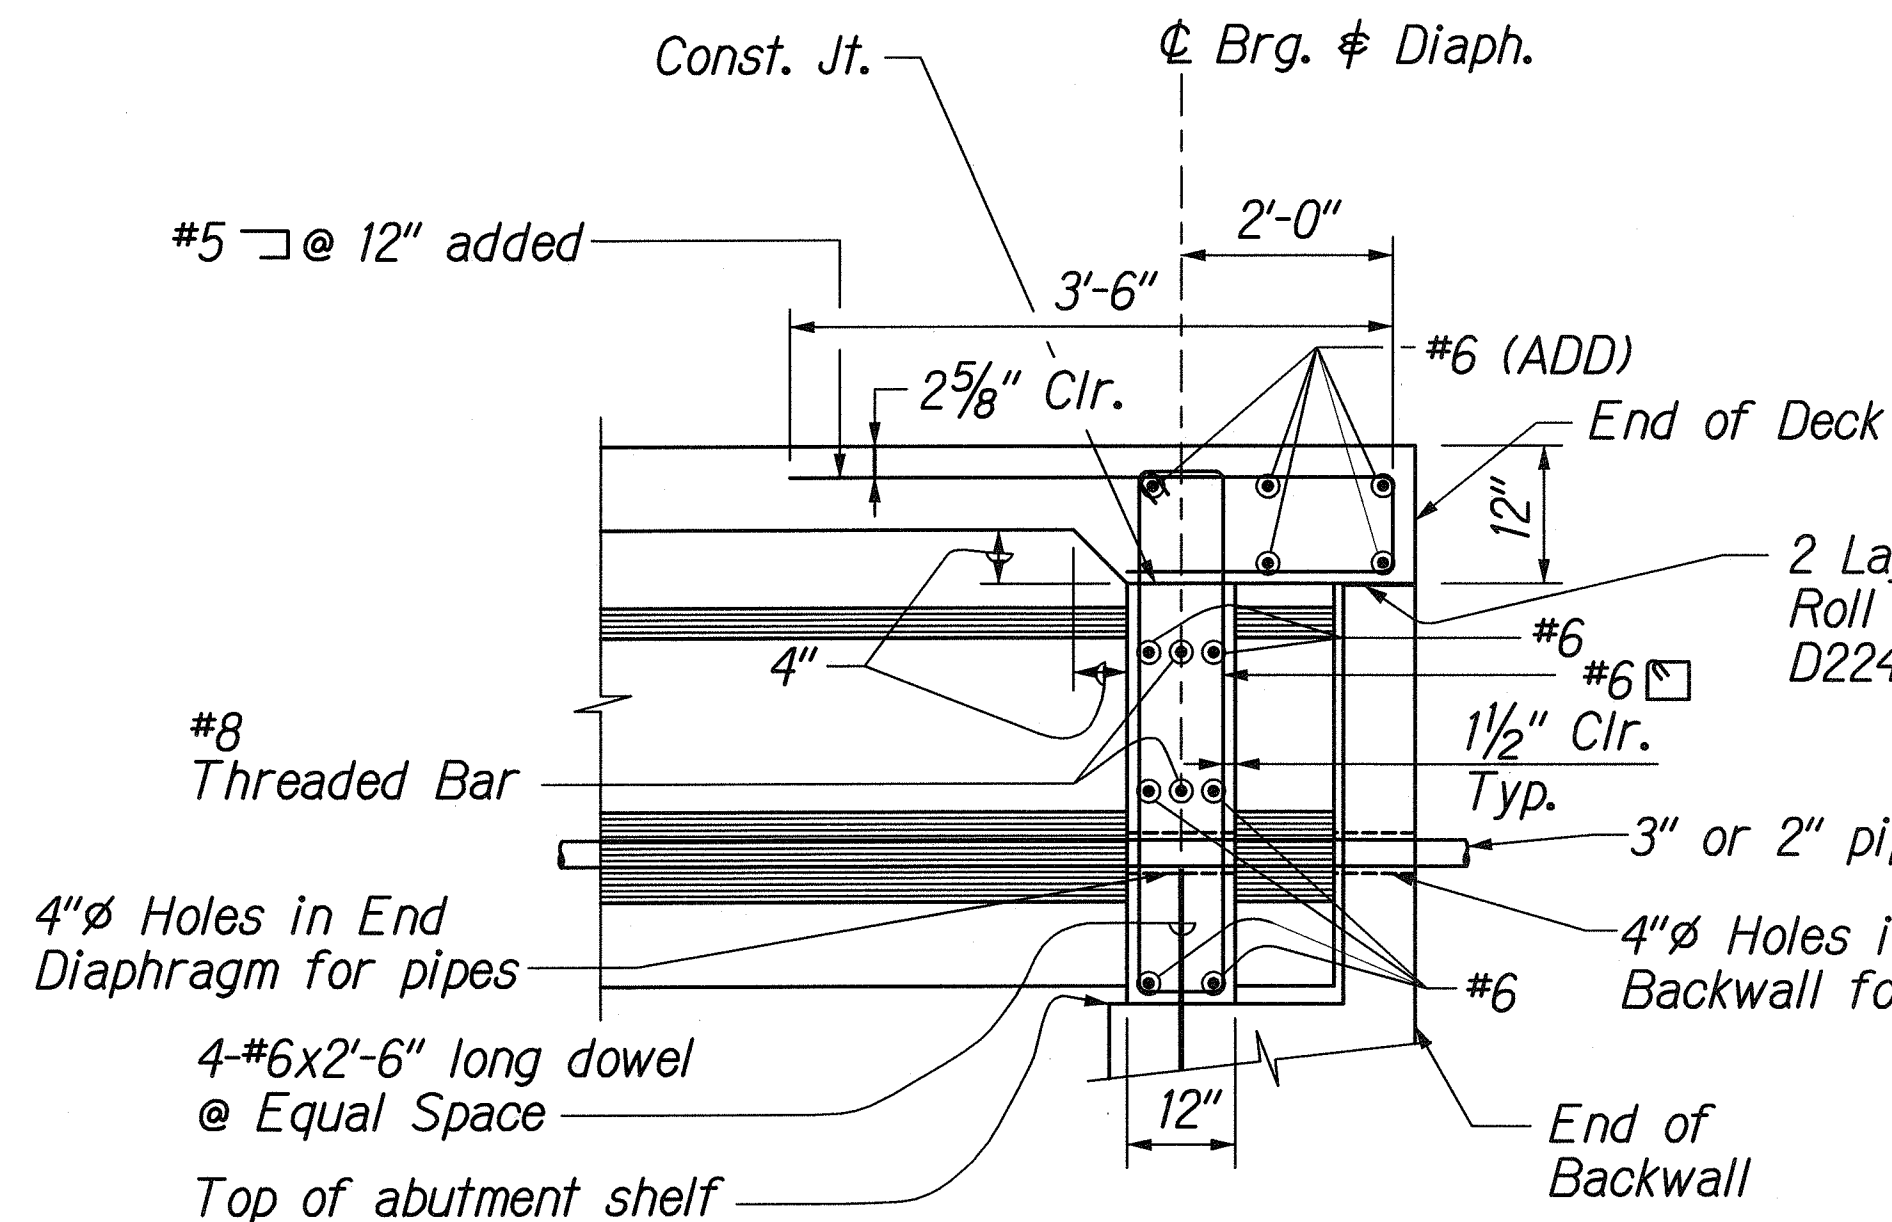

SECTION B
S2-7 S2-7

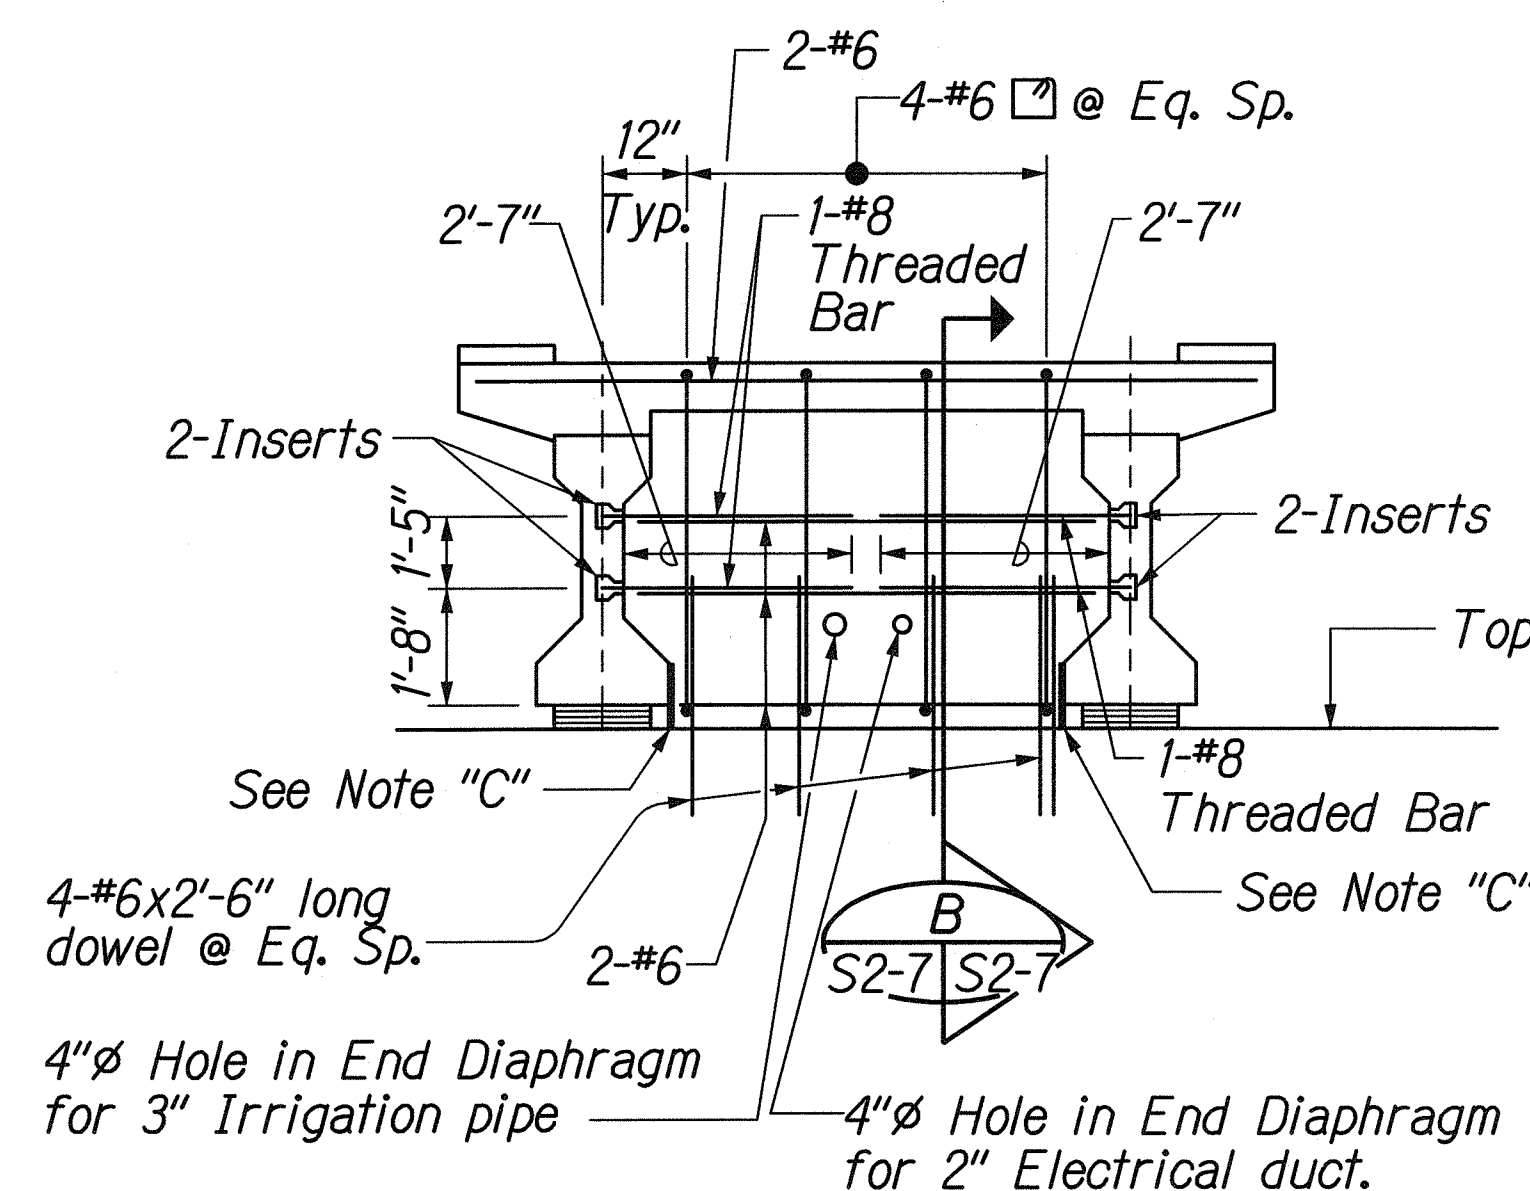


AT HINGE BEARING

TYPICAL END DIAPHRAGM DETAILS


N.T.S.

NOTE 'C':

Provide styrofoam to protect the elastomeric pads from concrete encroachment prior to placing end diaphragm concrete at the hinge bearing. Provide two layers Asphalt Roll Roofing ASTM D224, Type II.

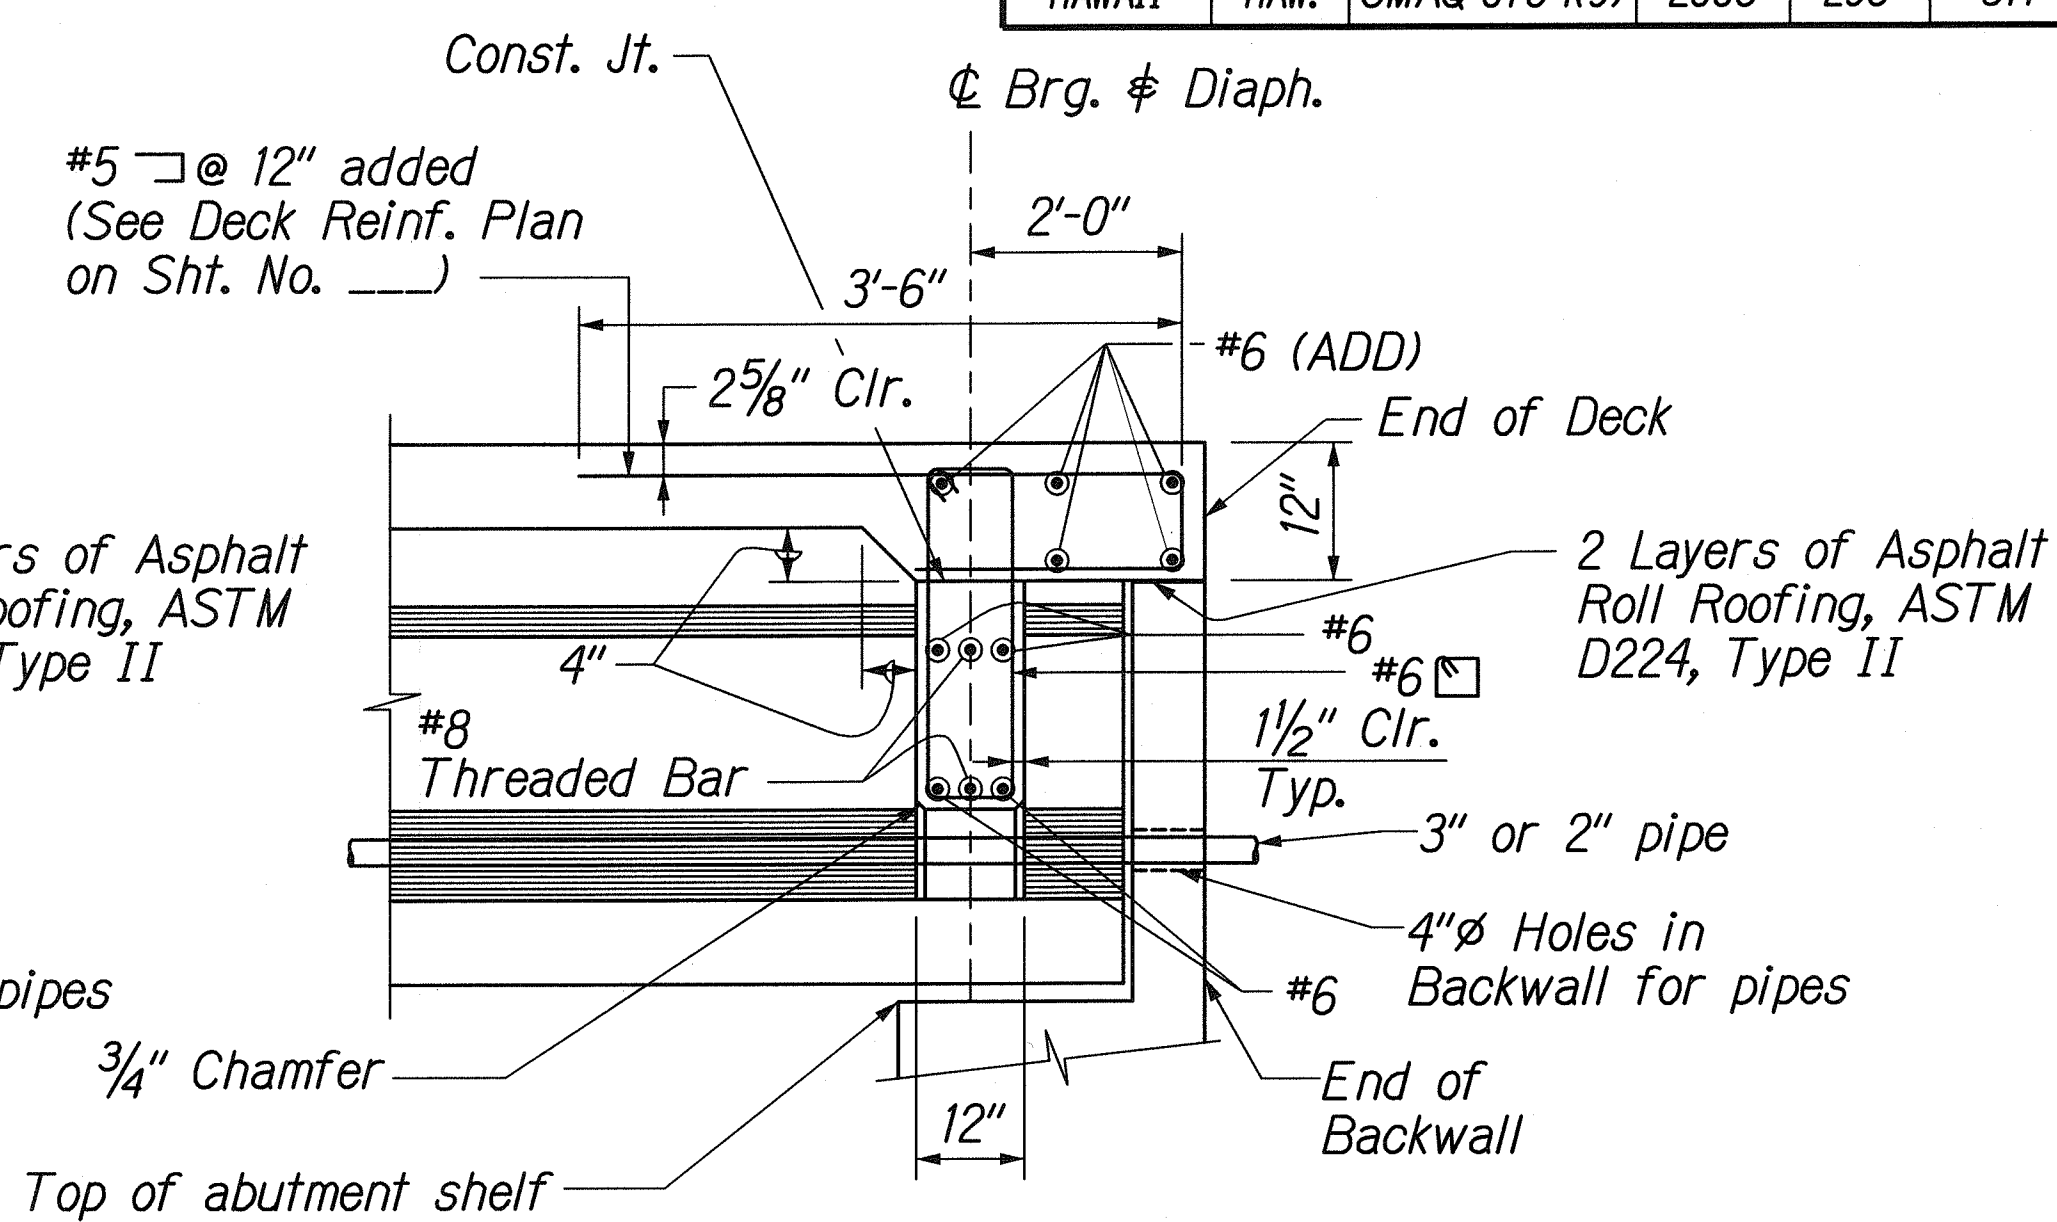


SECTION C
S2-7 S2-7

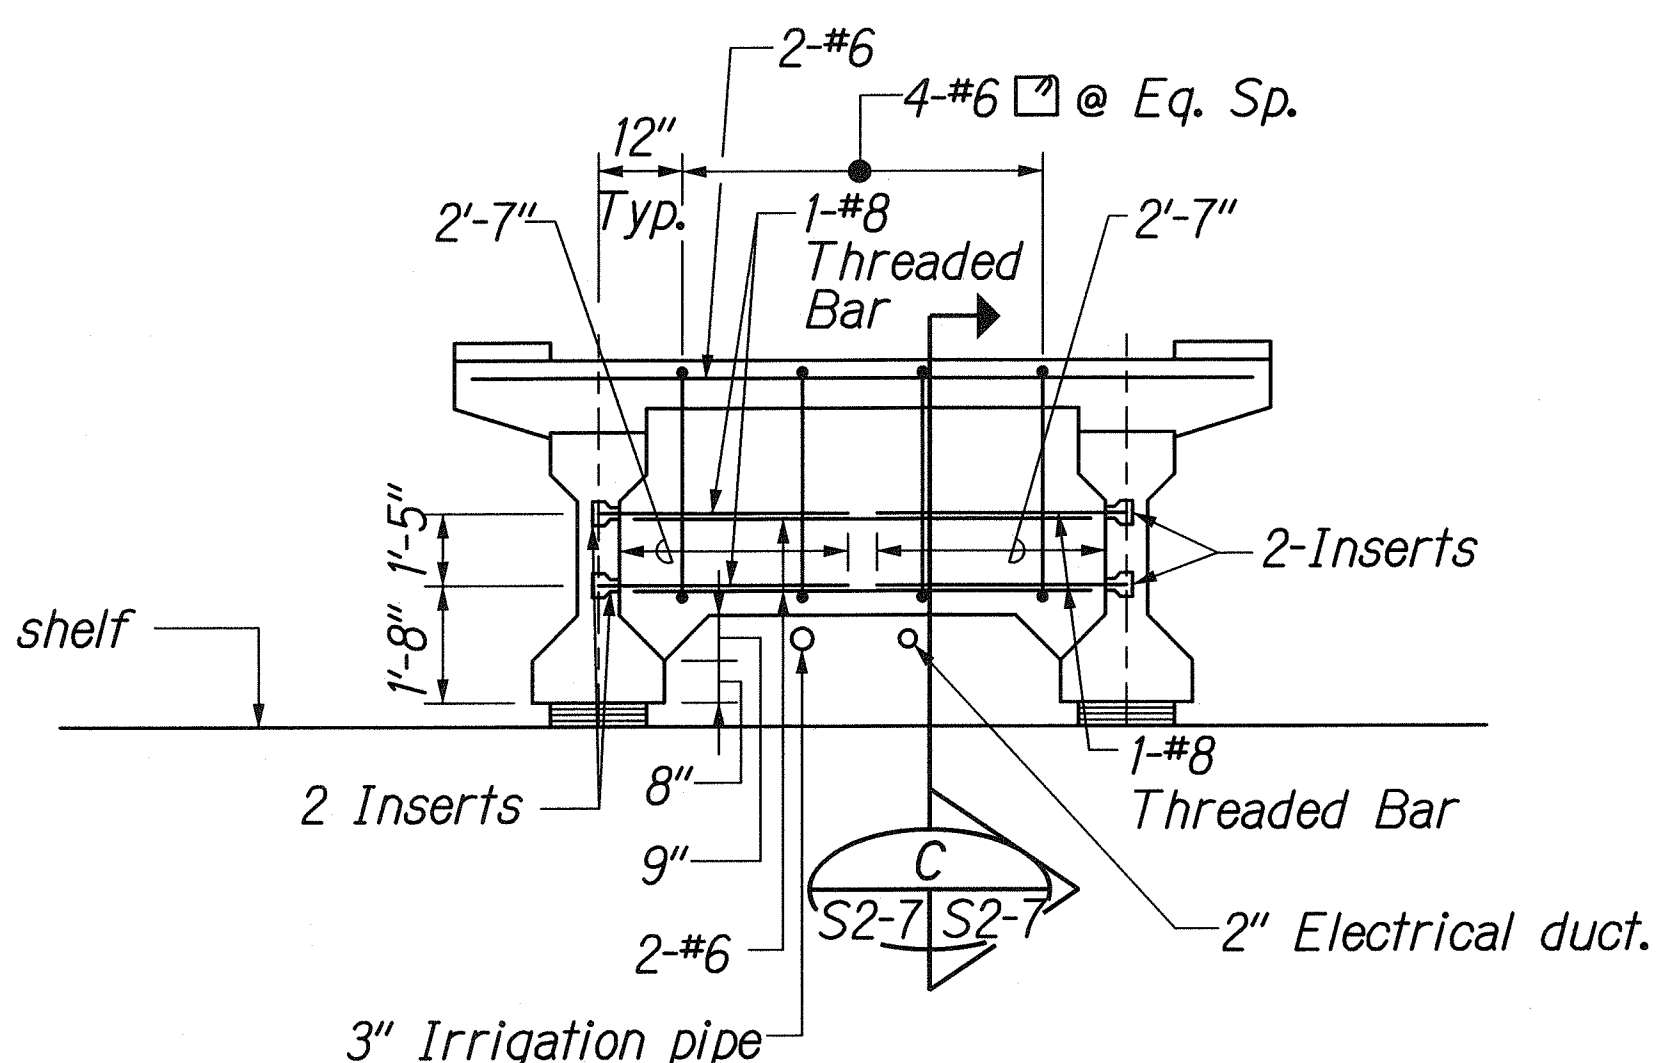


AT EXPANSION BEARING

	STATE OF HAWAII DEPARTMENT OF TRANSPORTATION HIGHWAYS DIVISION CANE HAUL RD. PEDESTRIAN BRIDGE BEAM DETAILS - 2 FORT WEAVER ROAD WIDENING VICINITY OF AAWA DRIVE TO GEIGER ROAD Scale: As Shown Date: Feb. 22, 2008
	SHEET No. S2-7 OF 9 SHEETS


FED. ROAD DIST. NO.	STATE	FEDERAL AID PROJ. NO.	FISCAL YEAR	SHEET NO.	TOTAL SHEETS
HAWAII	HAW.	CMAQ-076-1(9)	2006	297	371

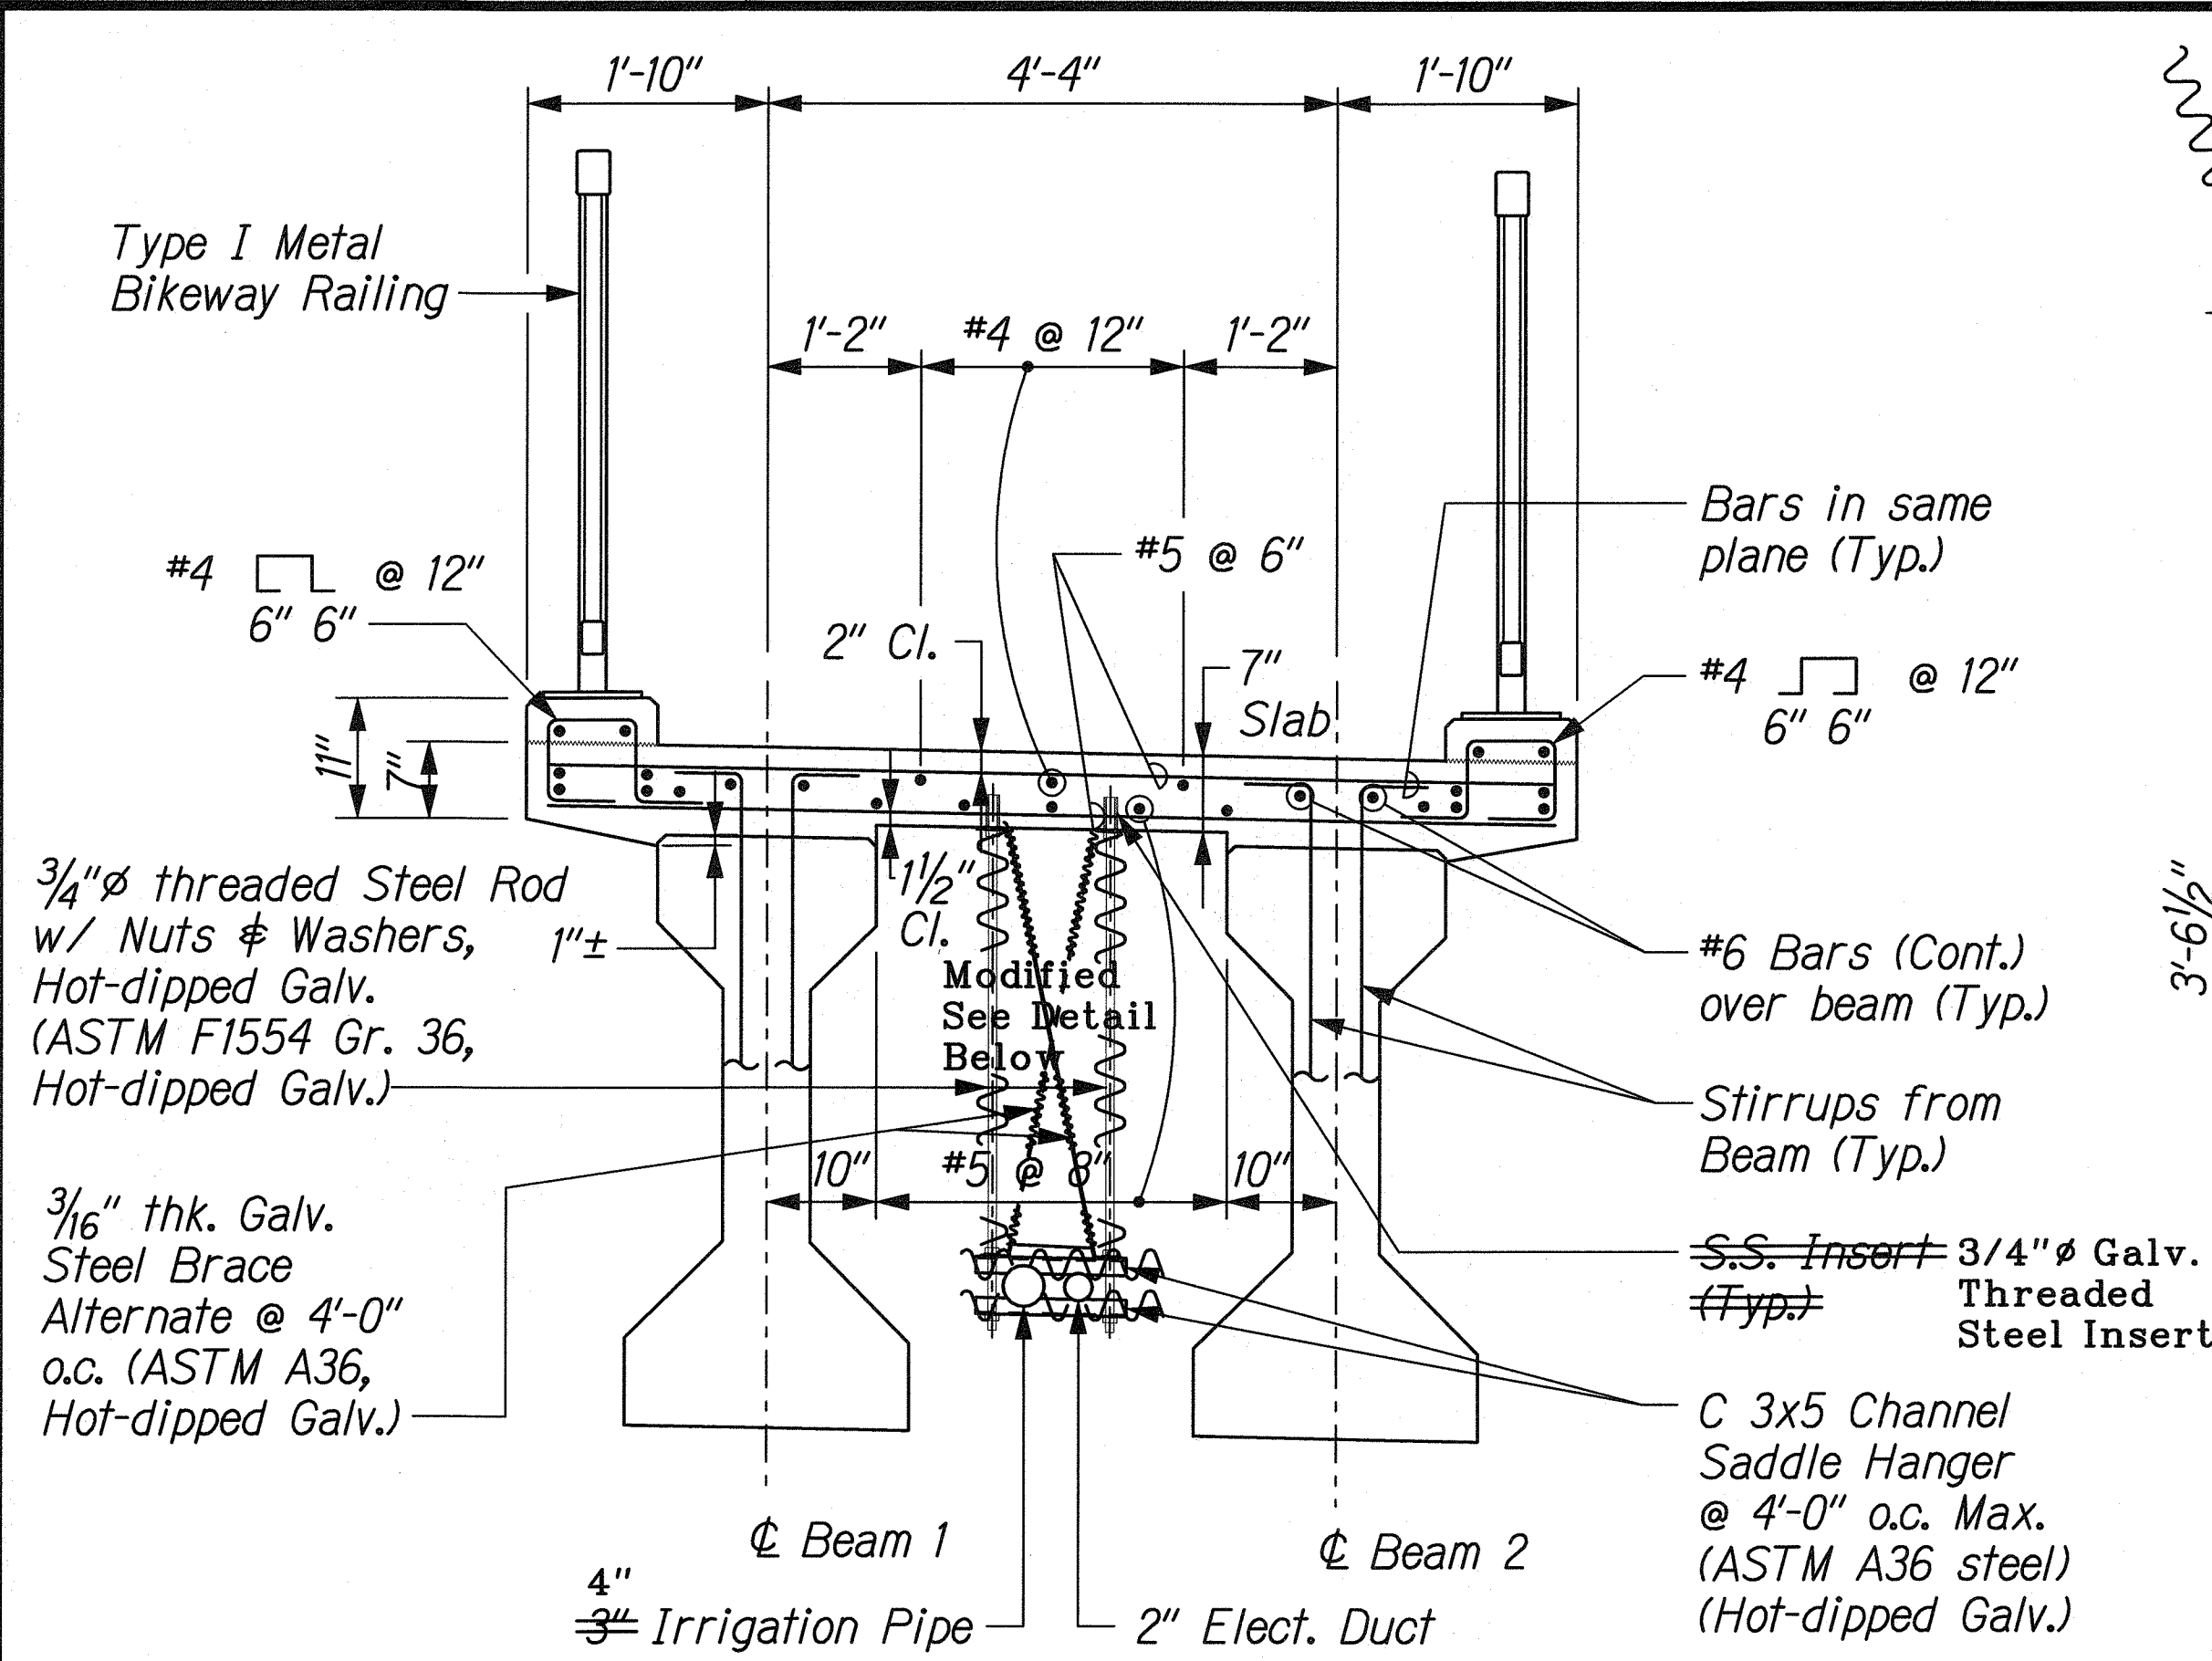



TYPICAL SECTION (LOOK UPSTATION)
Scale: 3/4" = 1'-0"

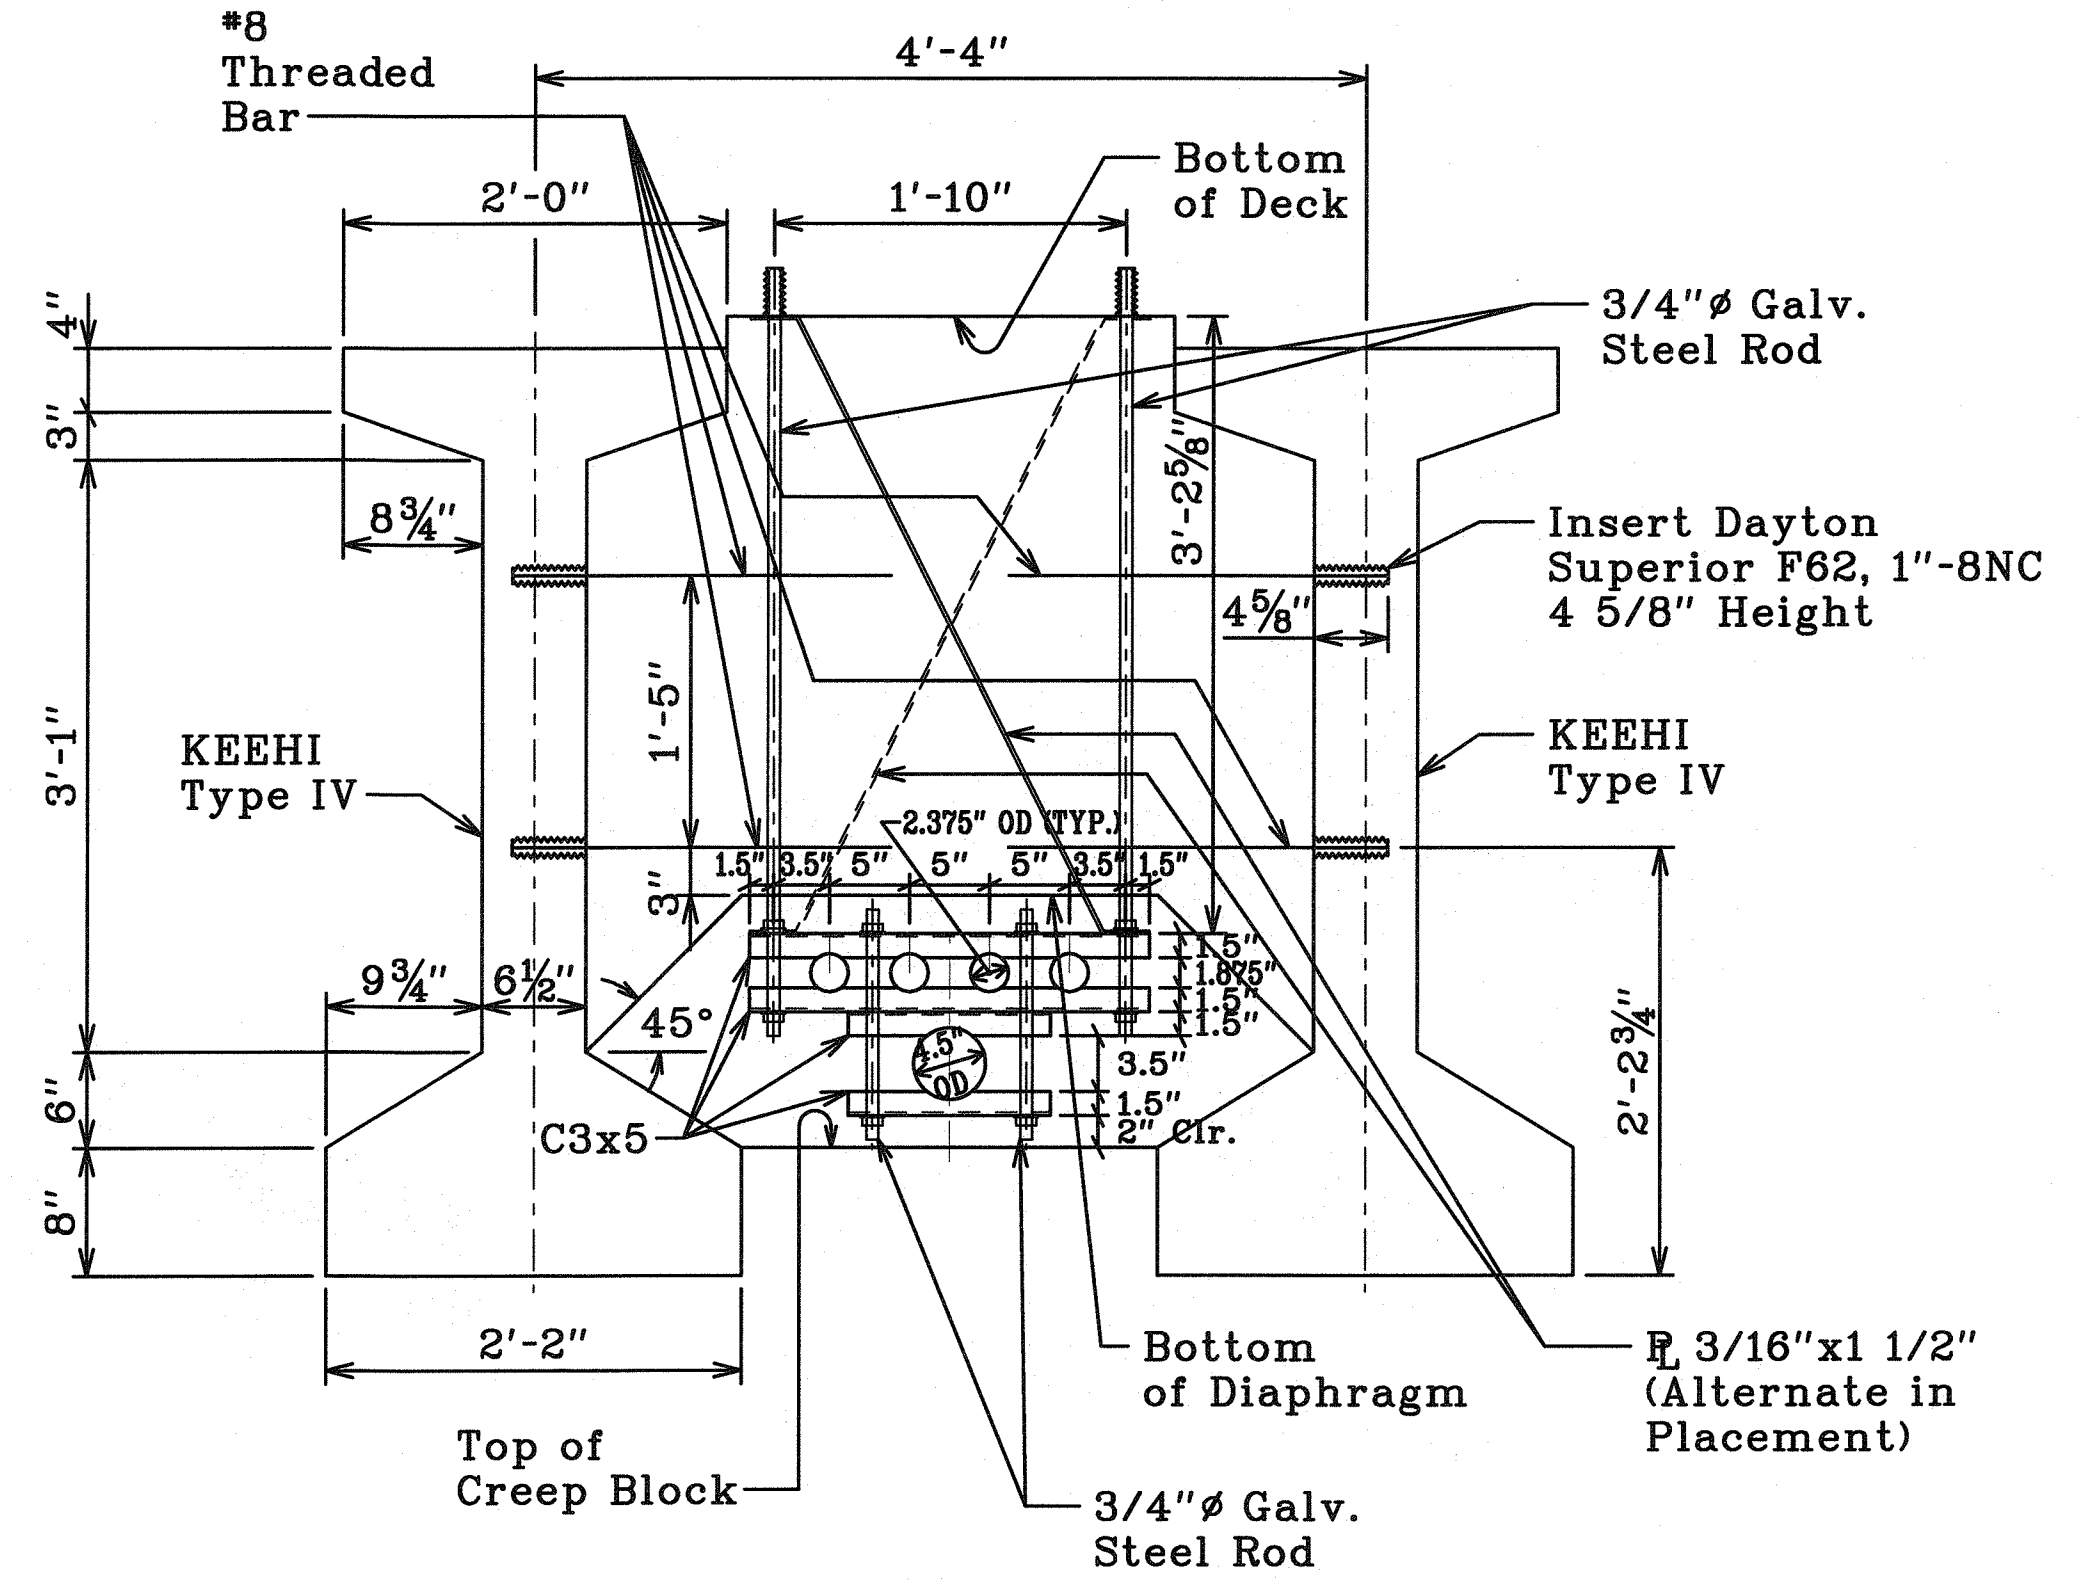


**CANE HAUL ROAD PEDESTRIAN BRIDGE
UTILITY HANGER**
Scale: 1"=1'-0"
(See Material Specified in this Sheet)

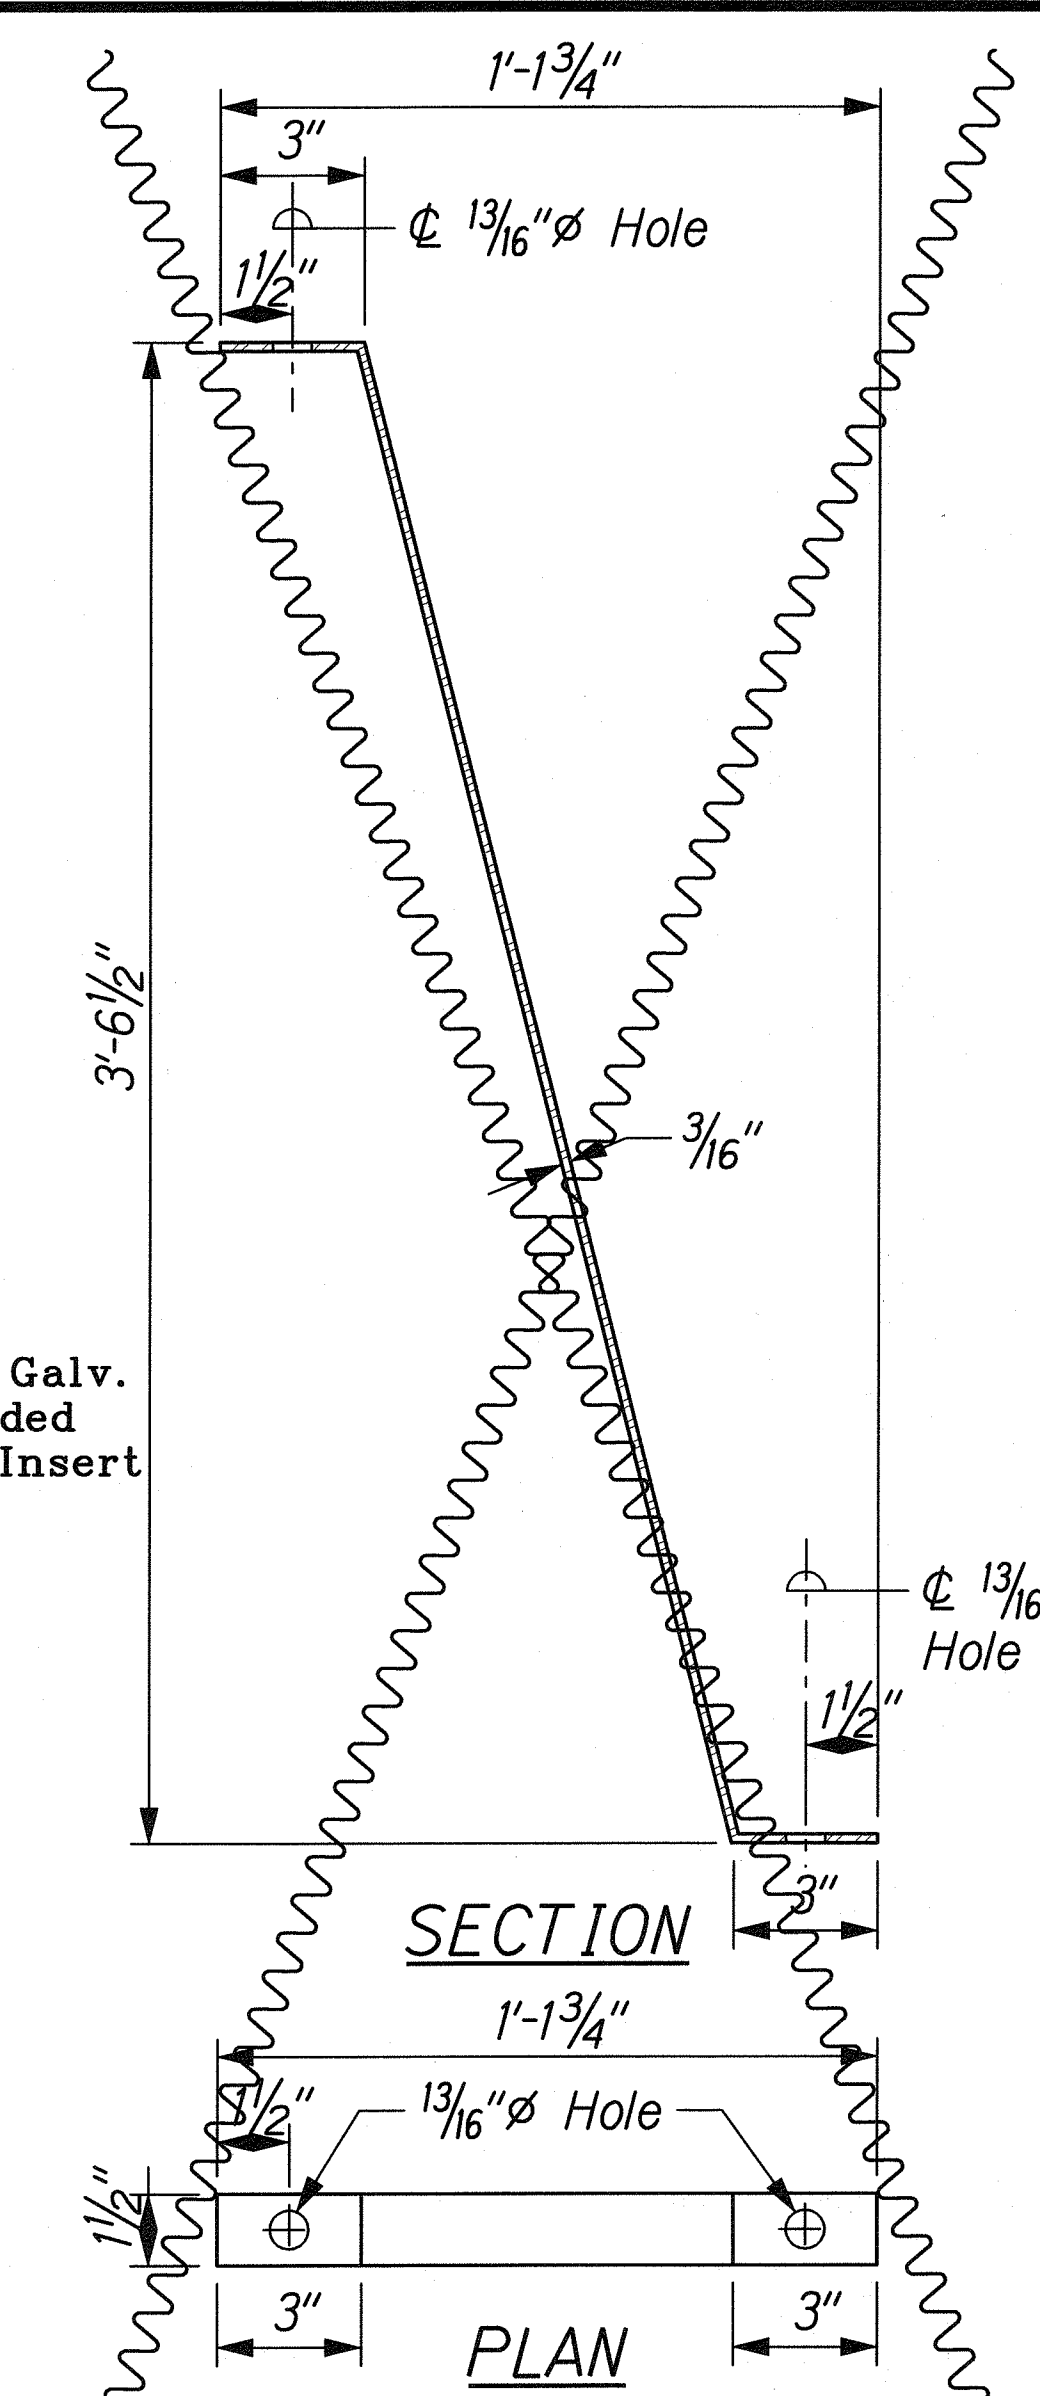

3/16\"/>

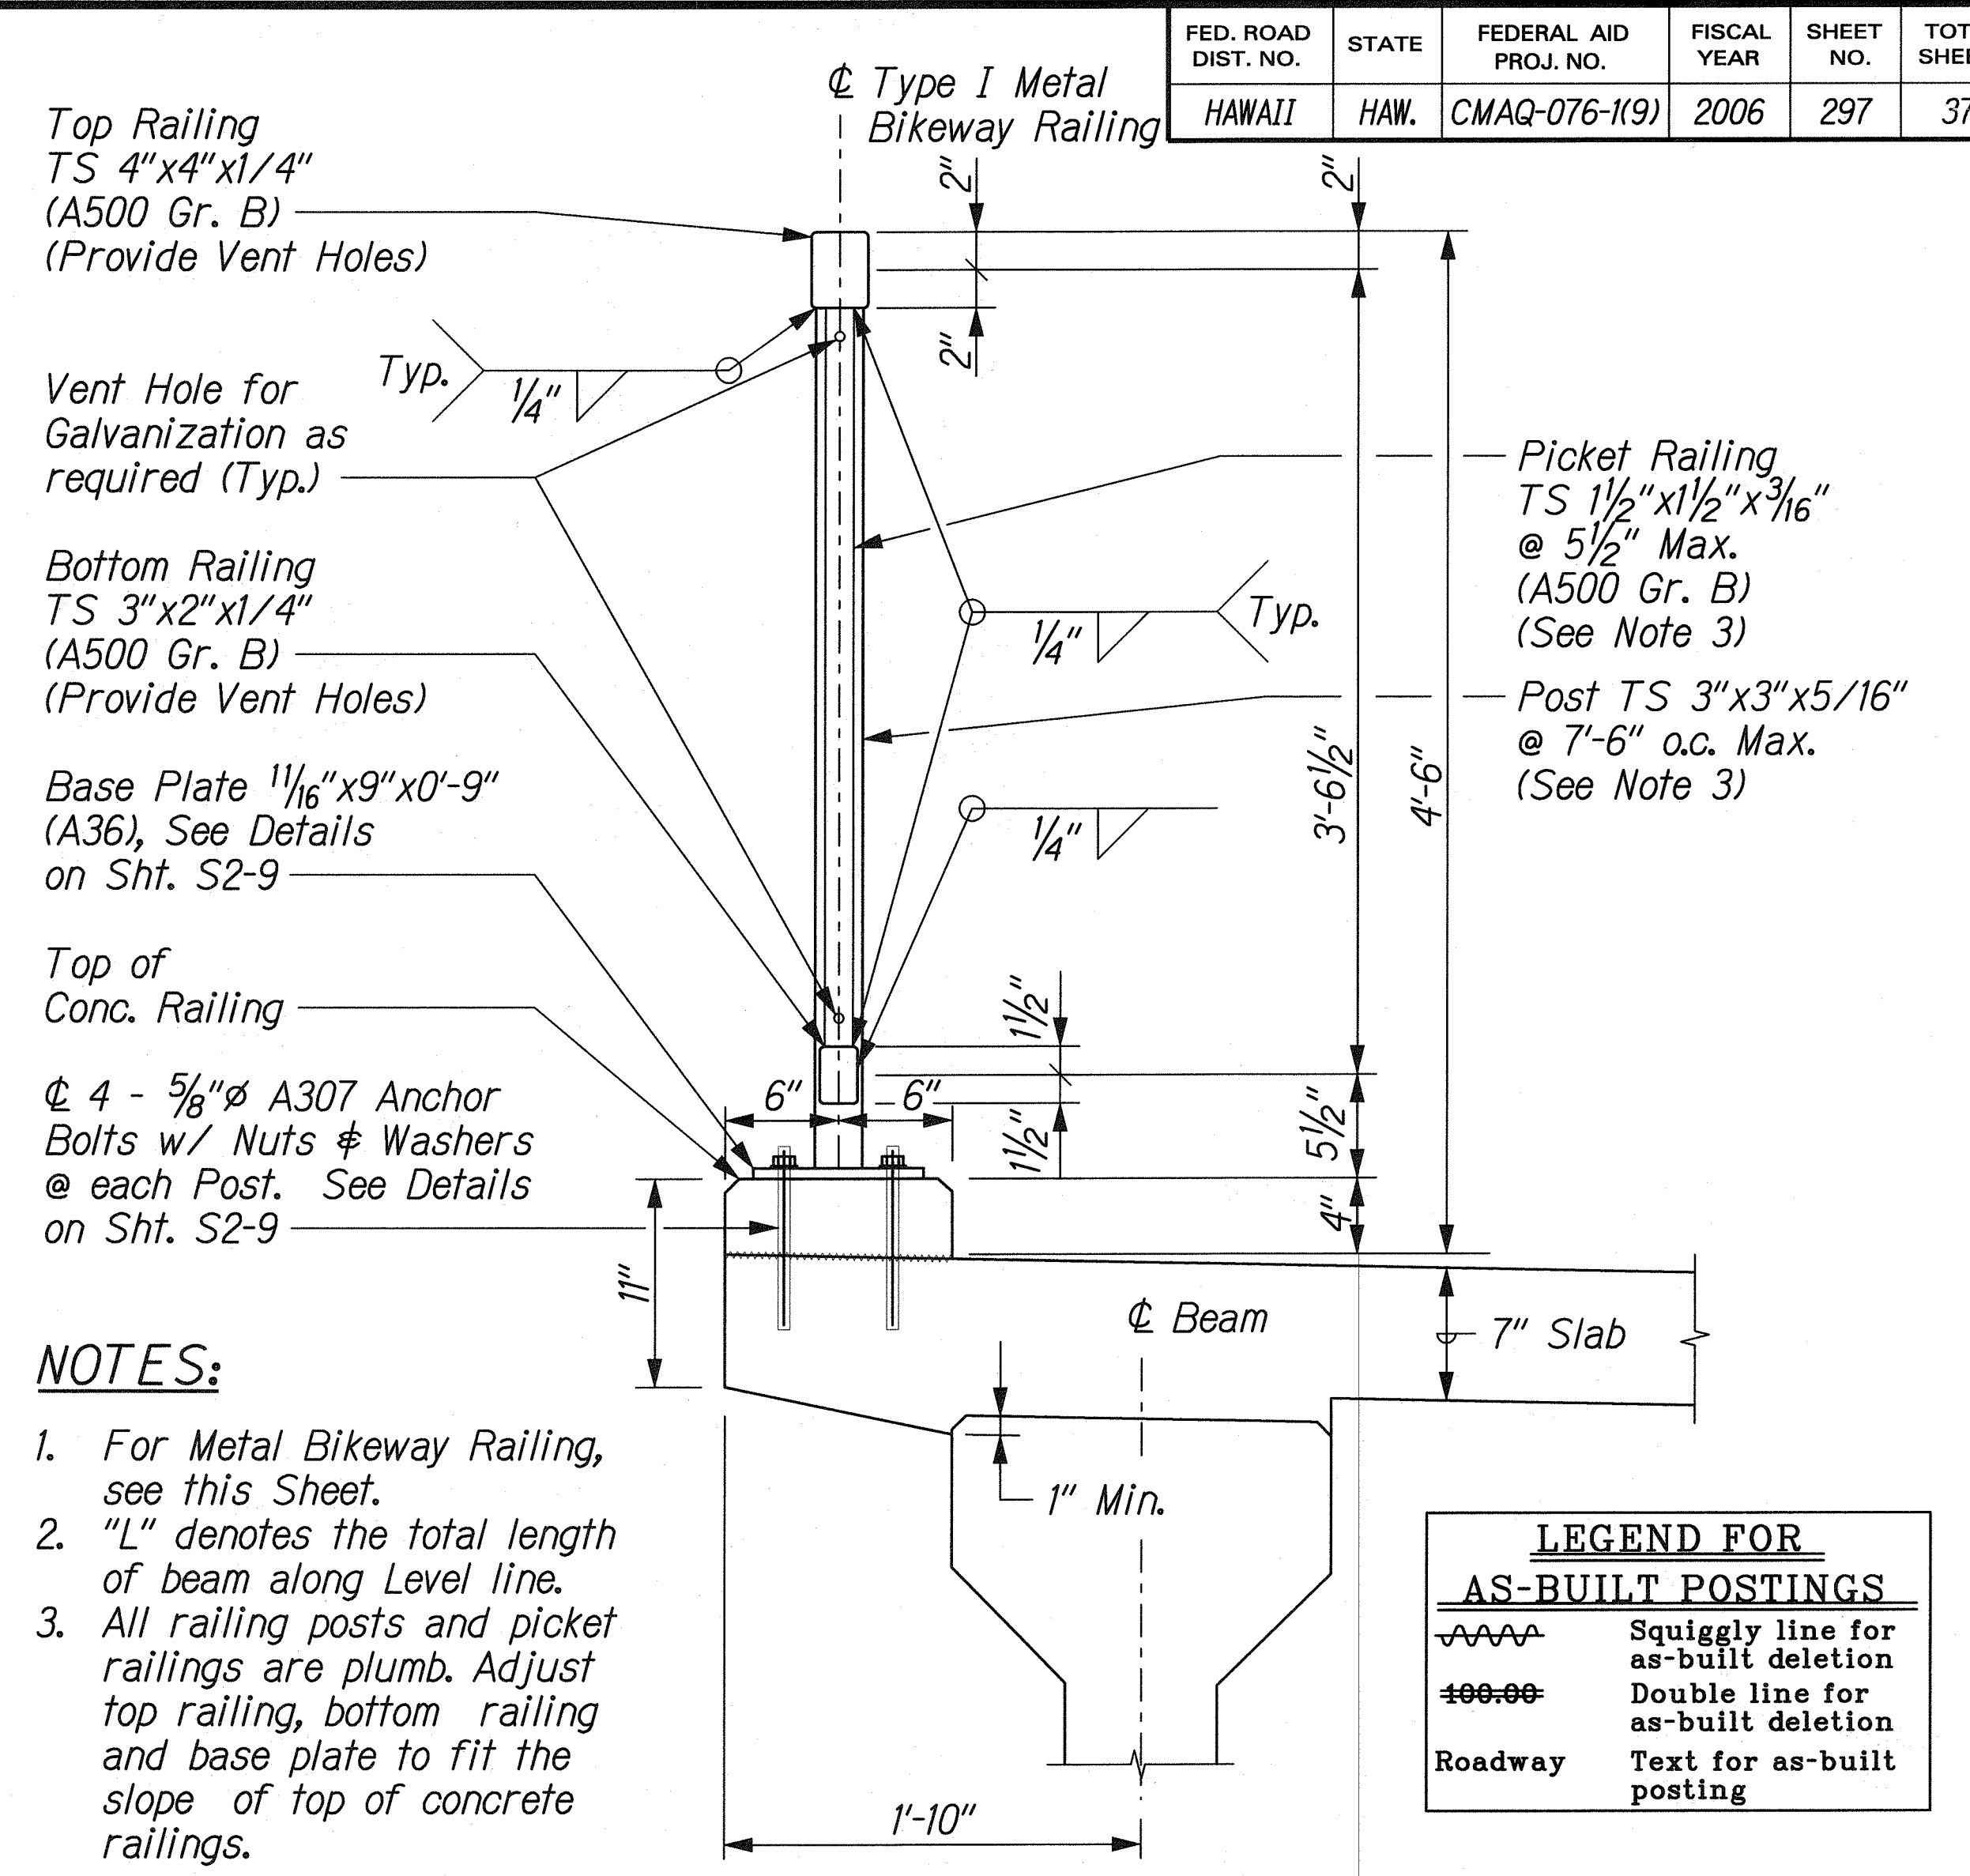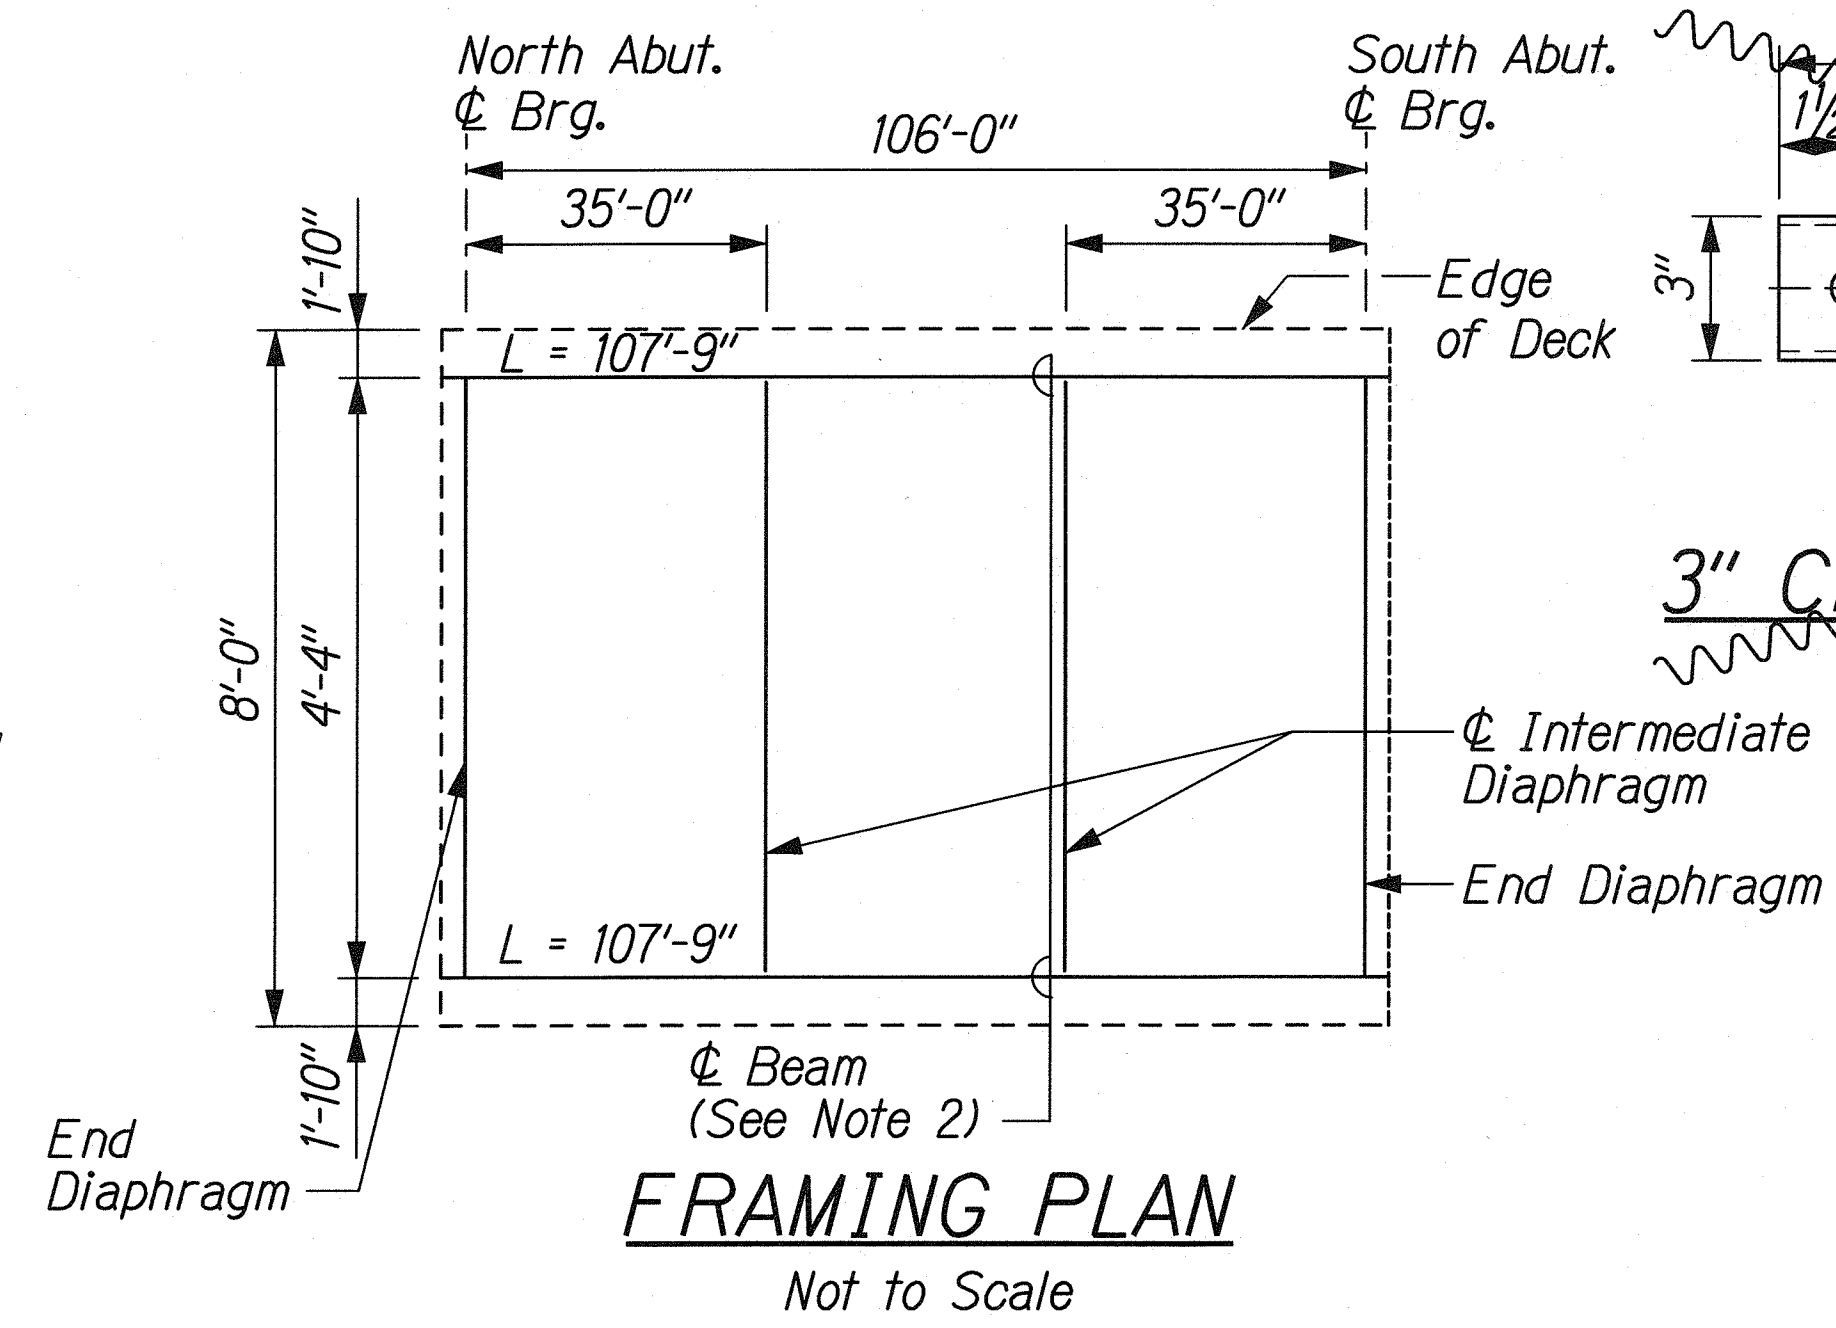

TYPE I METAL BIKEWAY RAILING TYPICAL SECTION
Scale: 1 1/2" = 1'-0"

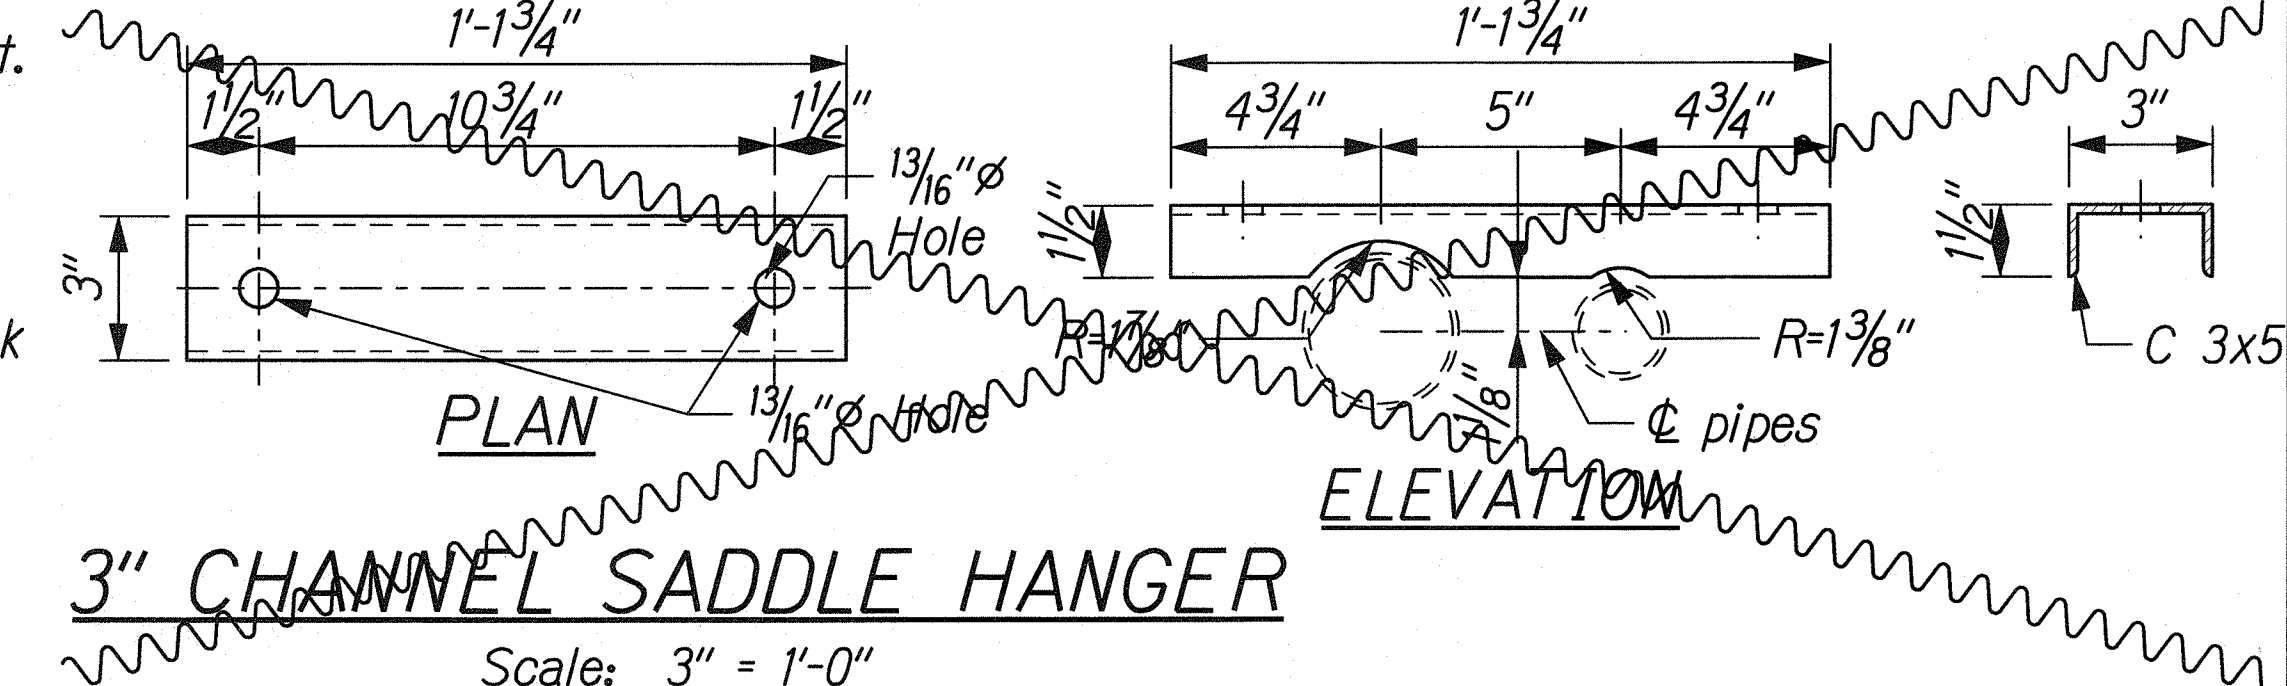

3\"/>

THIS WORK WAS PREPARED BY ME OR UNDER MY SUPERVISION.
Signature: *Hui Pang Chen*
Date: 04/30/10
Expiration Date of License

STATE OF HAWAII
DEPARTMENT OF TRANSPORTATION
HIGHWAYS DIVISION

**CANE HAUL RD. PEDESTRIAN BRIDGE
DECK REINFORCING AND RAILING**


FORT WEAVER ROAD WIDENING
VICINITY OF AAWA DRIVE TO GEIGER ROAD

Scale: As Shown Date: Feb. 22, 2008

SHEET No. S2-8 OF 9 SHEETS

SURVEY PLOTTED BY	DATE
DESIGNED BY	
NOTED BY	
CHECKED BY	
ORIGINAL PLAN	
NOTE BOOK	
N.	

L:\FORT WEAVER ROAD\STRUCT\ST-DET08.dgn

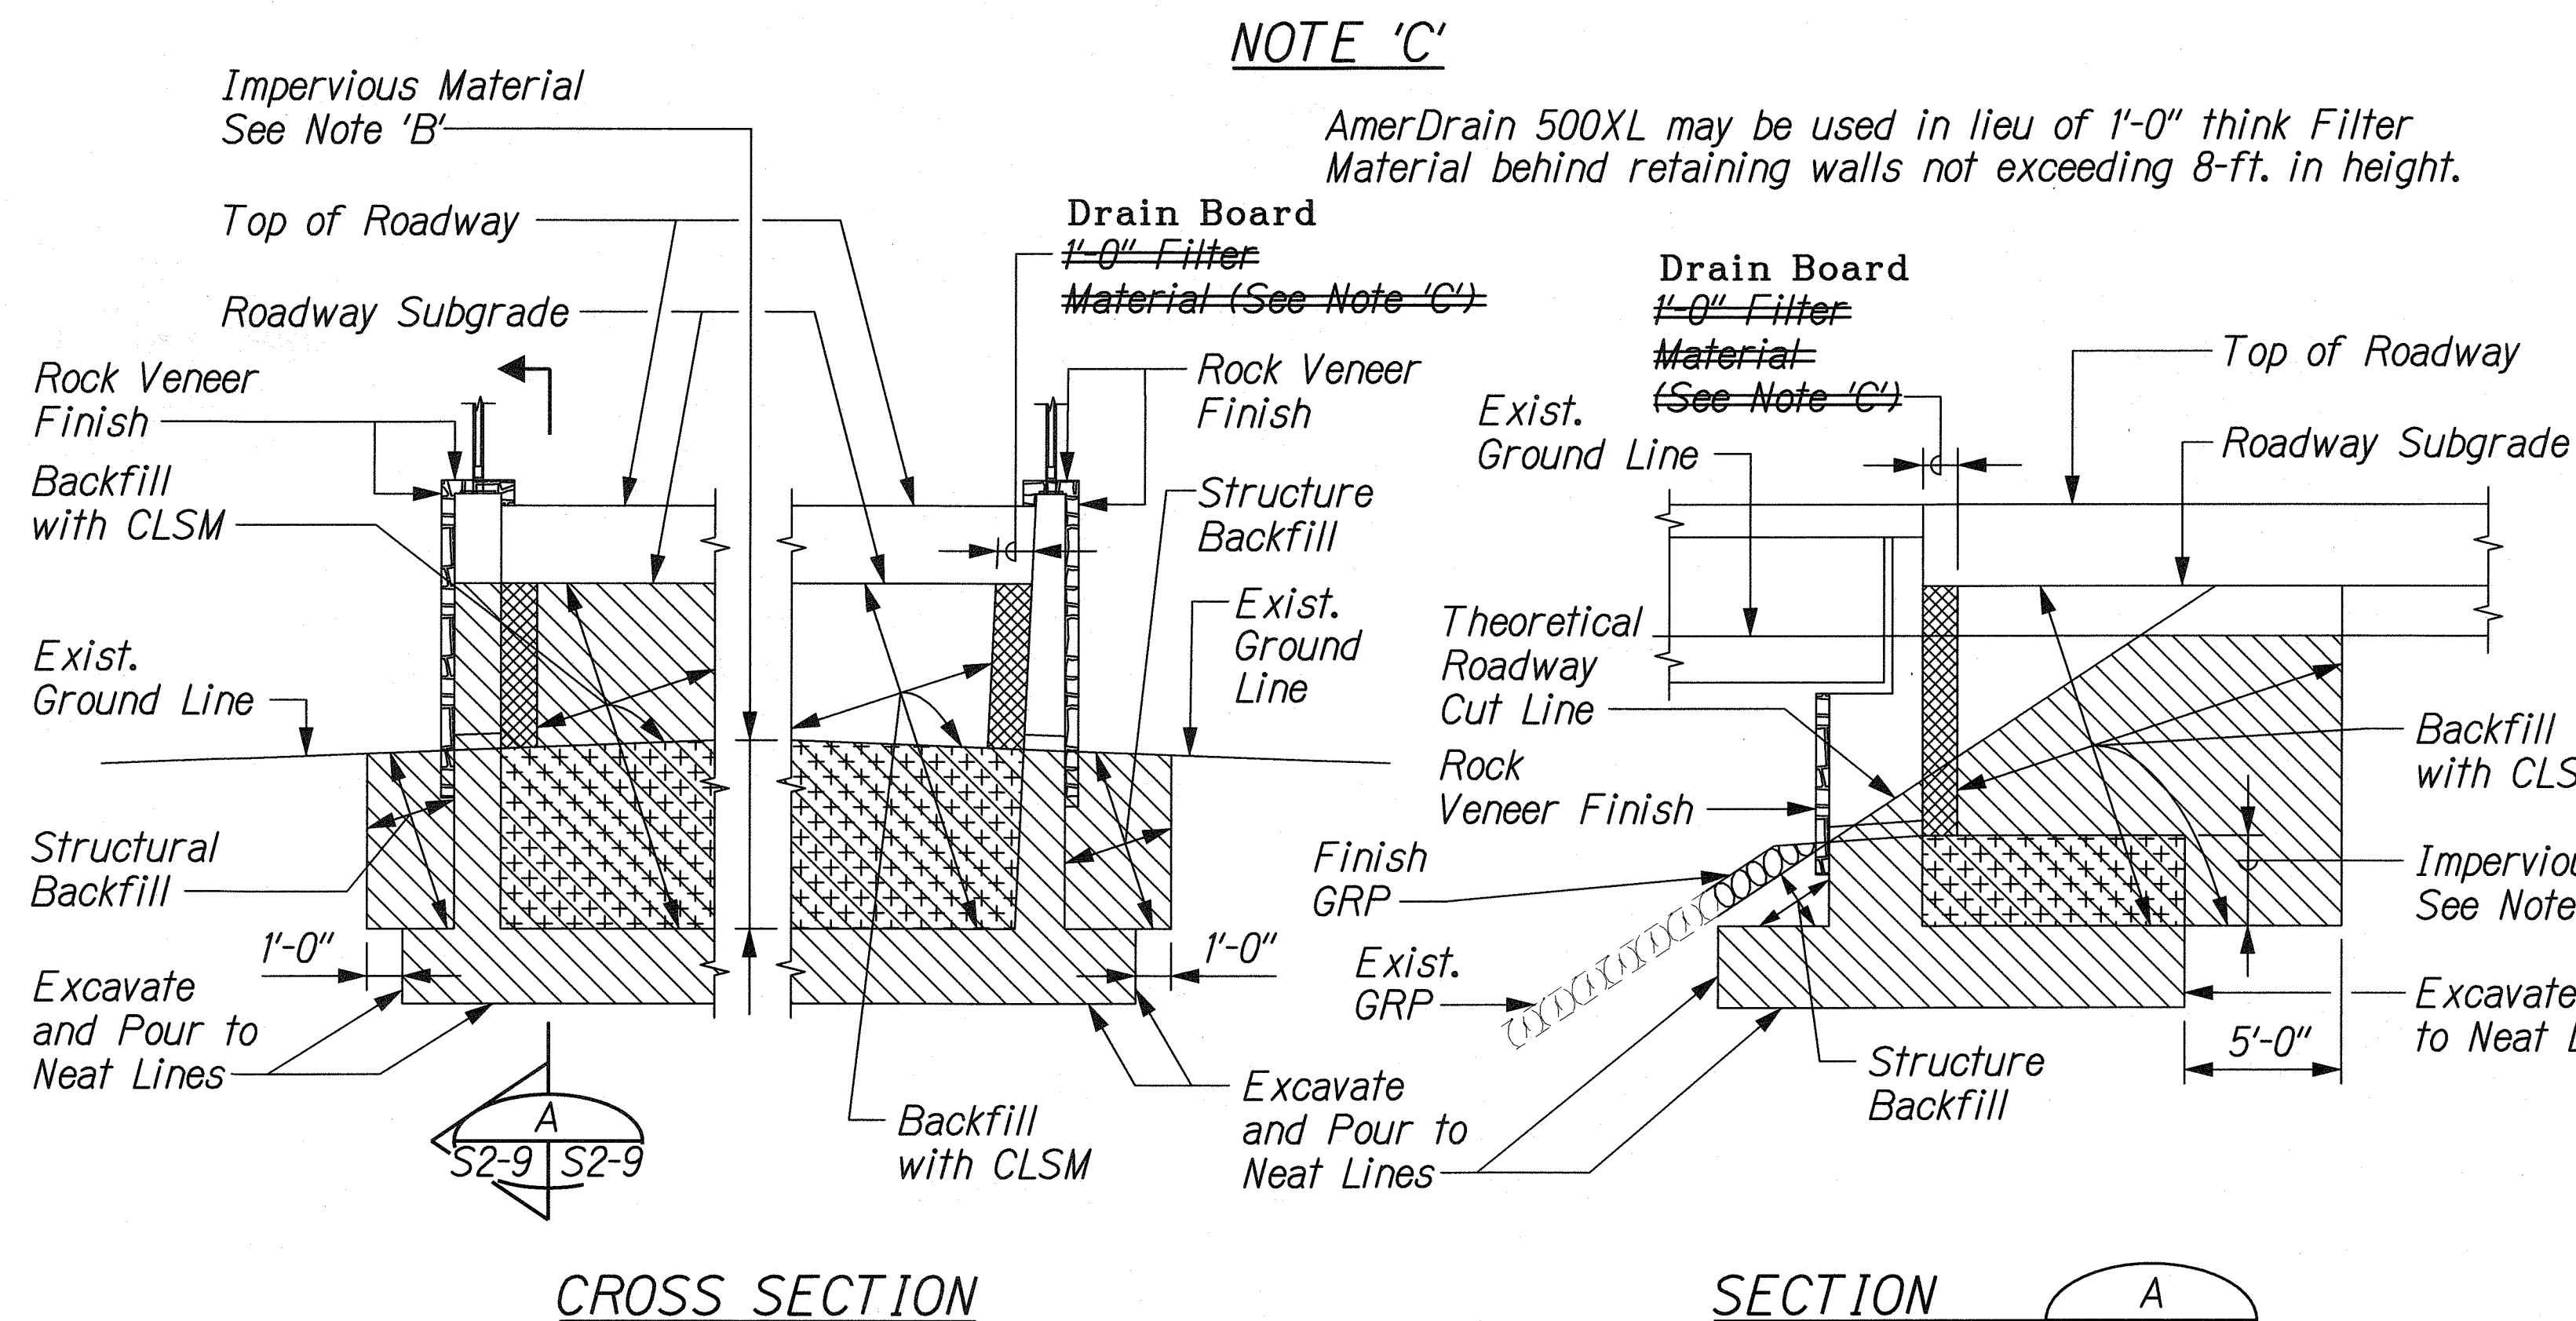

NOTE 'A'
Hatched areas denote the payment limits of structure excavation. All other excavation shall be Roadway Excavation.

NOTE 'B'
Impervious material as selected by the Engineer shall be incidental to structure backfill. The subgrade upon which filter material is to be placed shall be made impervious as possible by pneumatic tamping or other approved methods.

PAYMENT LIMITS
Not to Scale

SECTION
A
S2-9 | S2-9

LEGEND

- Denotes Structural Excavation (See Note 'A')
- Denotes Impervious Material (See Note 'B')
- Drain Board Denotes Filter Material (See Note 'C')

NOTE 'D'

Provide Vent holes for galvanization as required for TS members at Top & Bottom railings, Picket railings and posts.


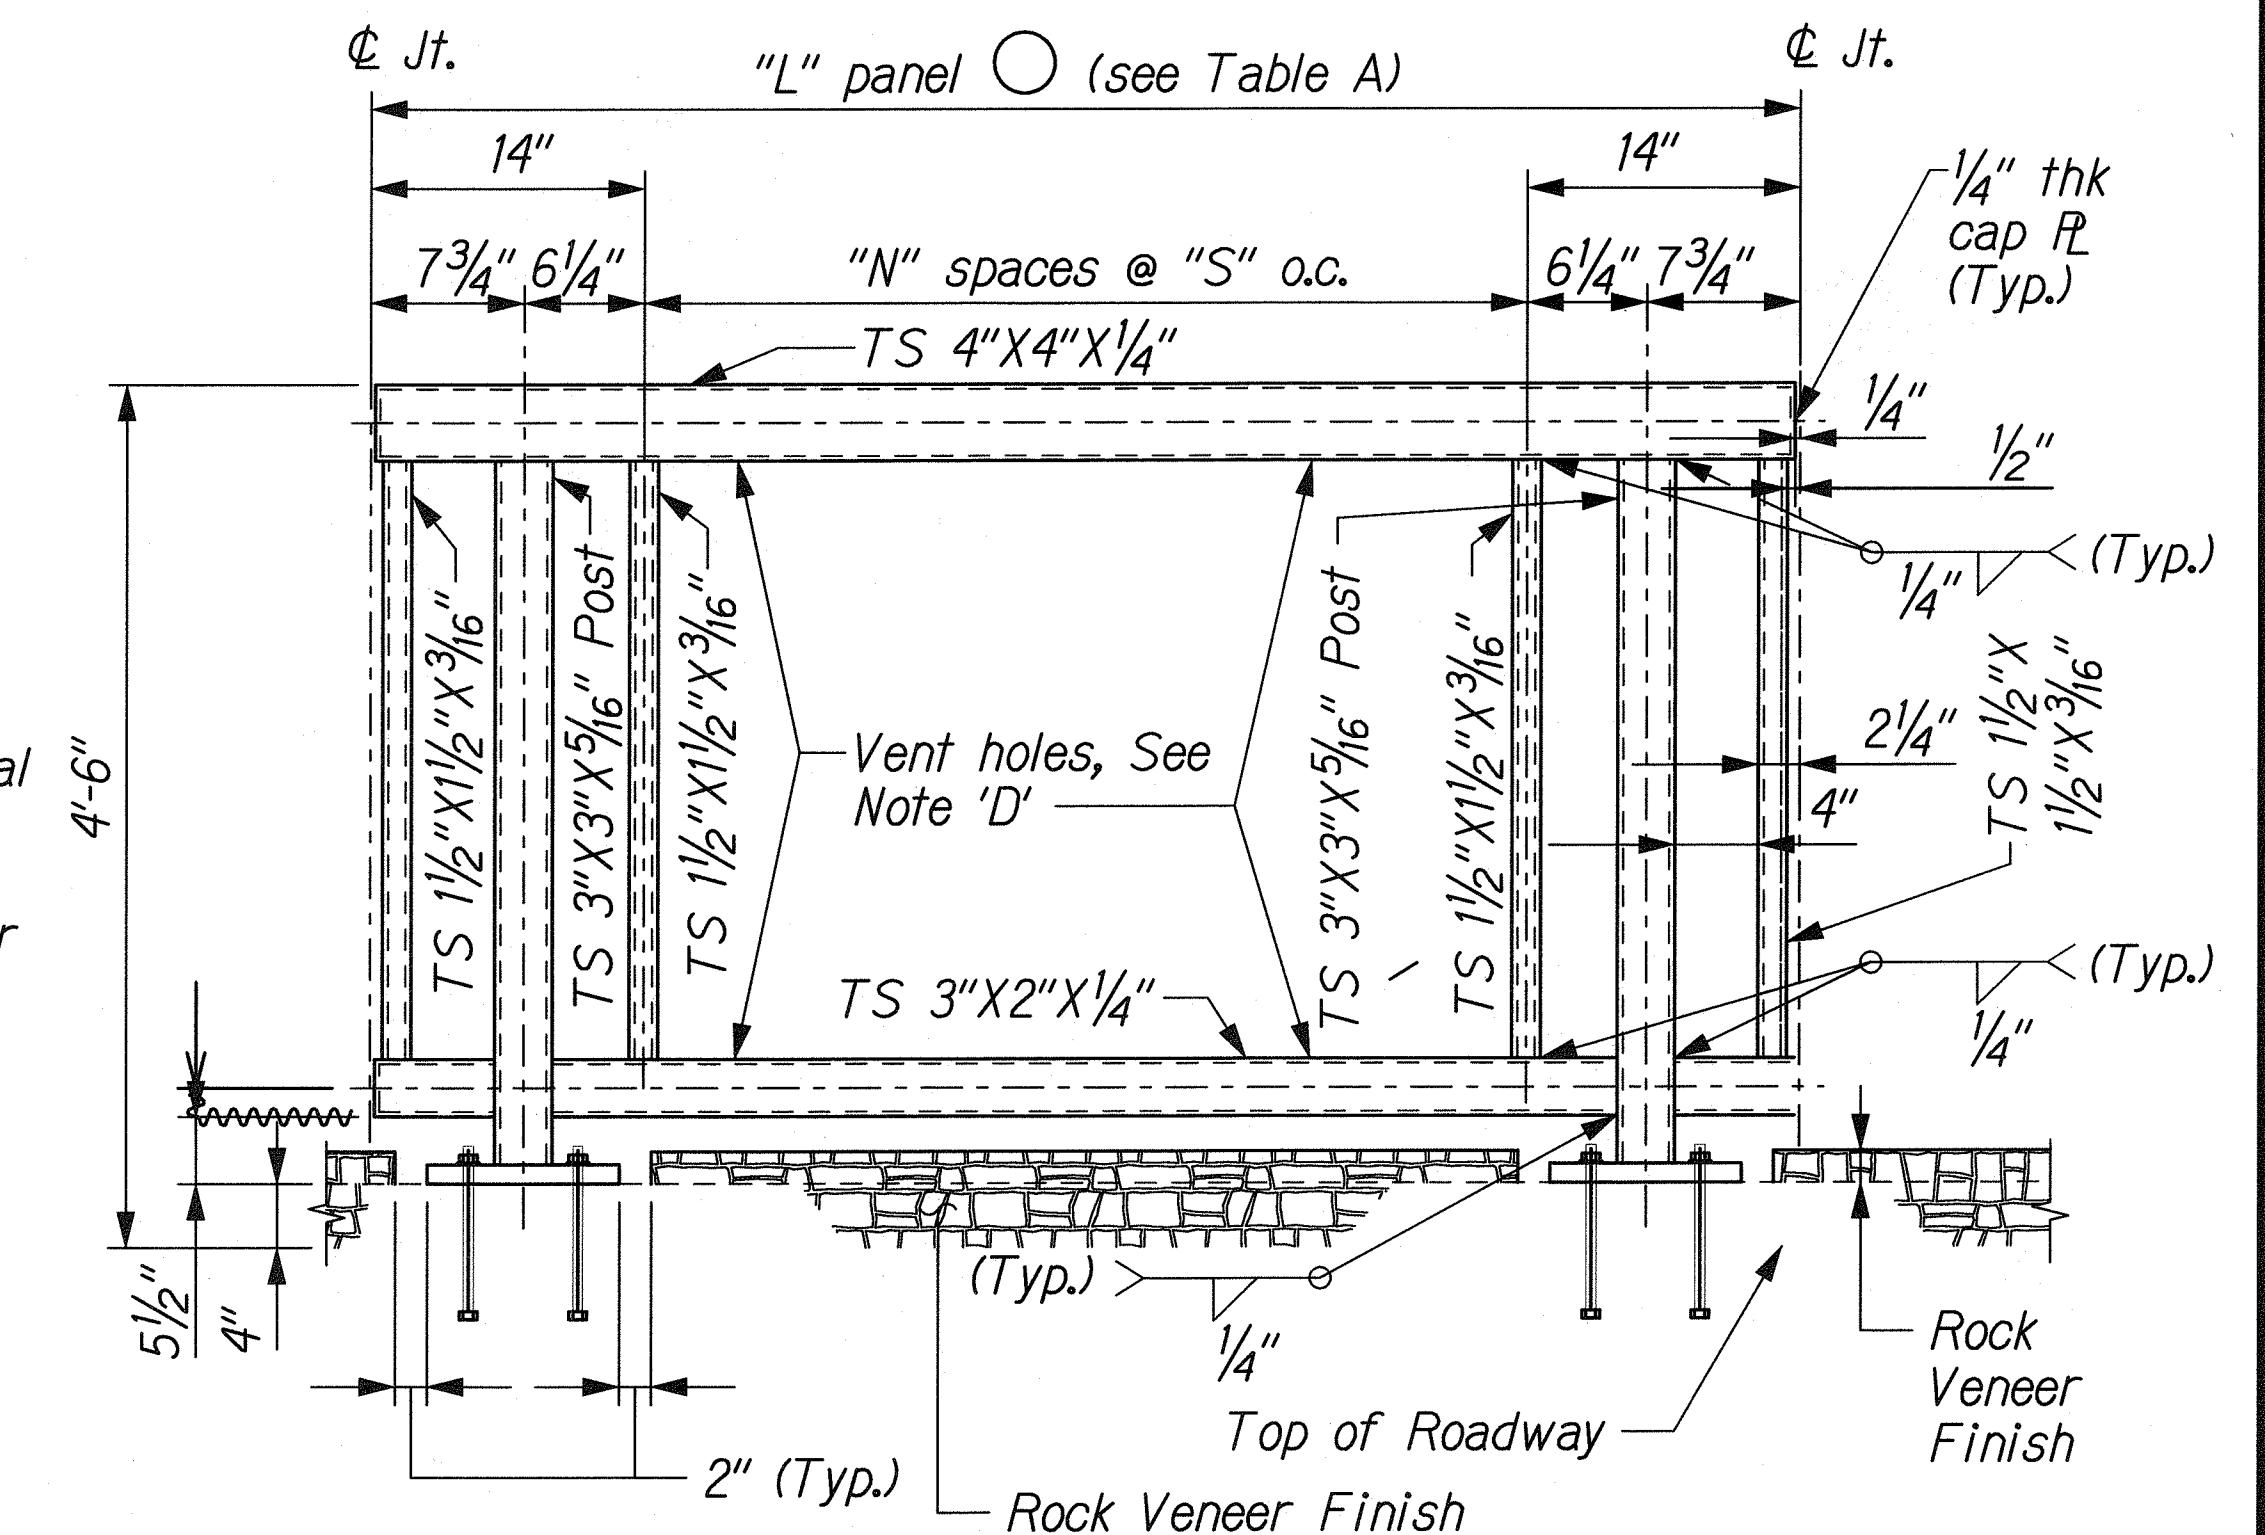


Table A-Type I Metal Bikeway Railing Panel Length			
Panel	Panel Length "L"	"N" Spaces	Spacing "S"
(B)	7'-4"	11	5 15/32" ±
(M)	7'-0"	11	5 3/32" ±

TYPE I METAL BIKEWAY RAILING PANEL ARRANGEMENT


Scale: 1"=1'-0"

LEGEND FOR AS-BUILT POSTINGS	
	Squiggly line for as-built deletion
	Double line for as-built deletion
Roadway	Text for as-built posting

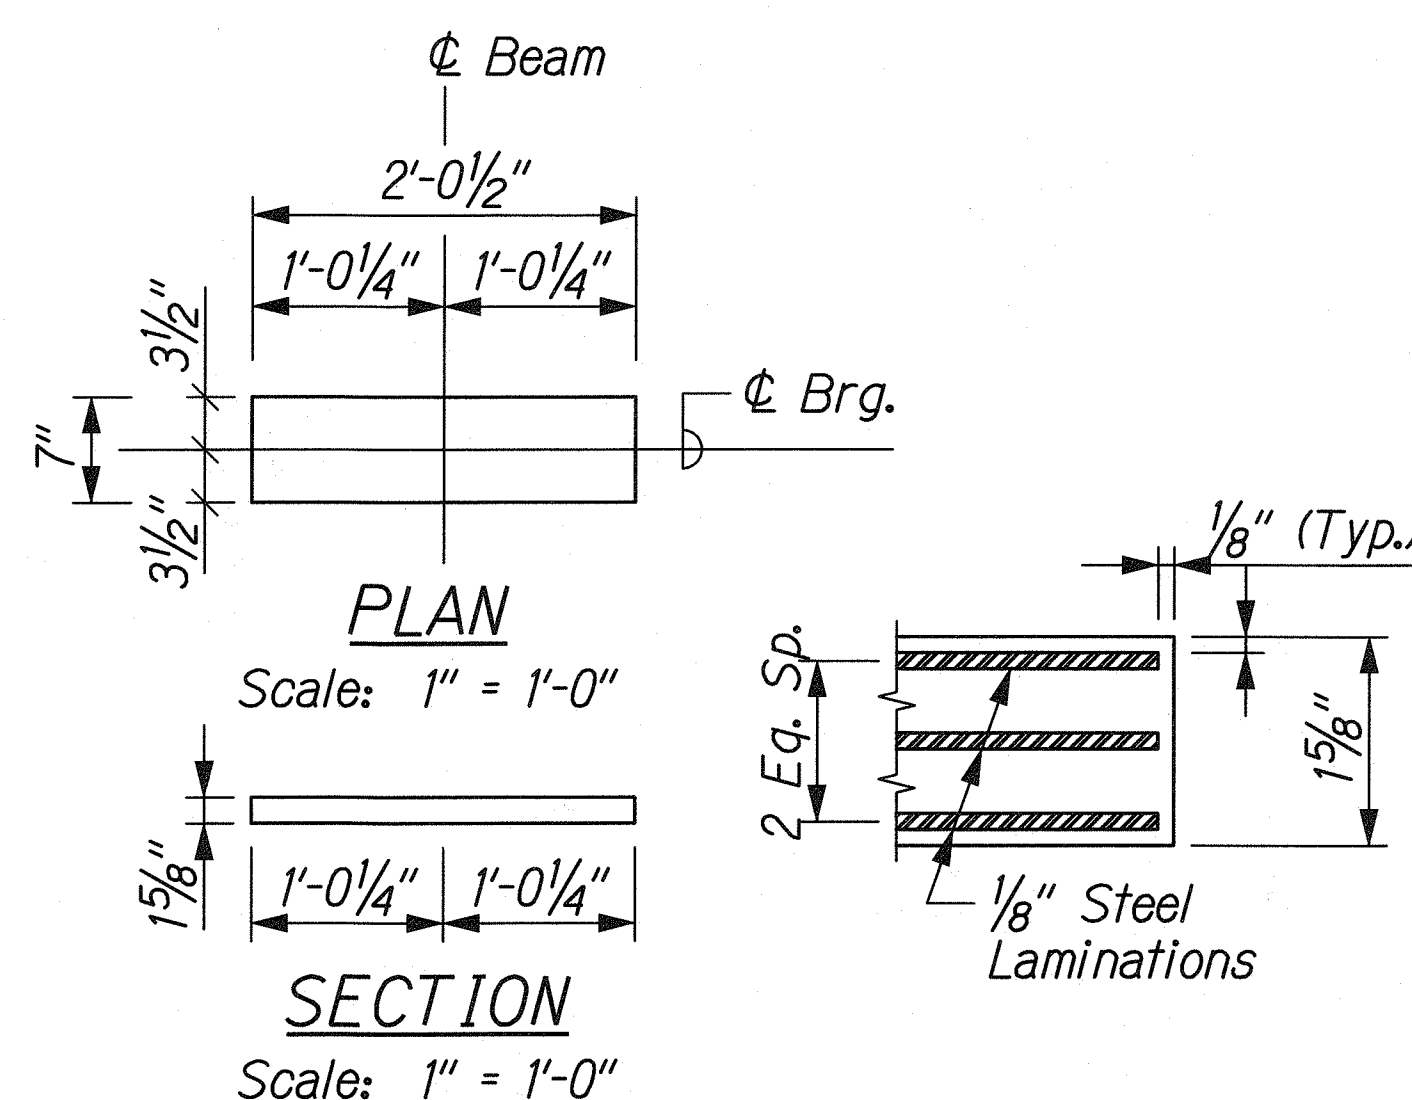



ELASTOMERIC BEARING PAD DETAILS

Not to Scale

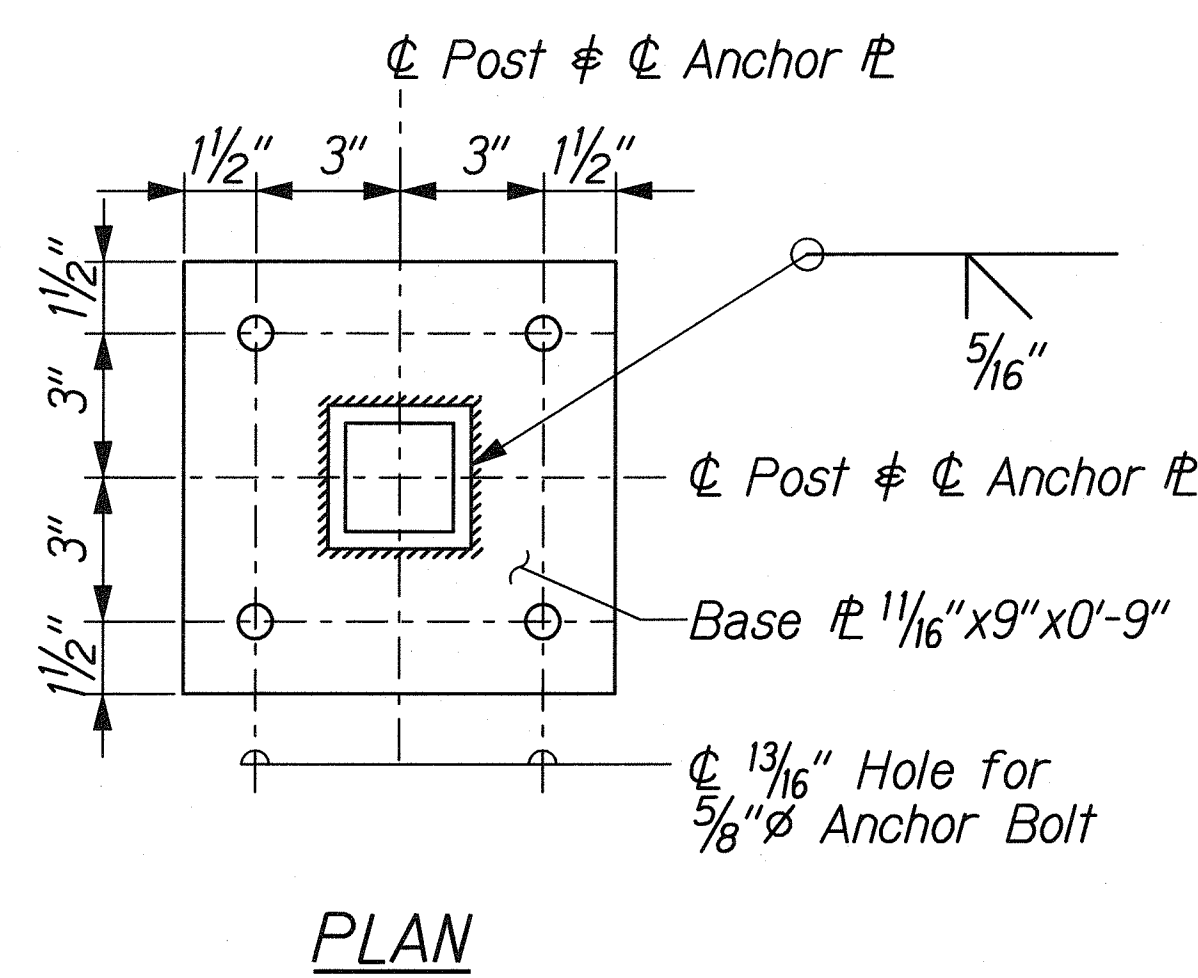

BASE PLATE DETAIL

Scale: 3" = 1'-0"

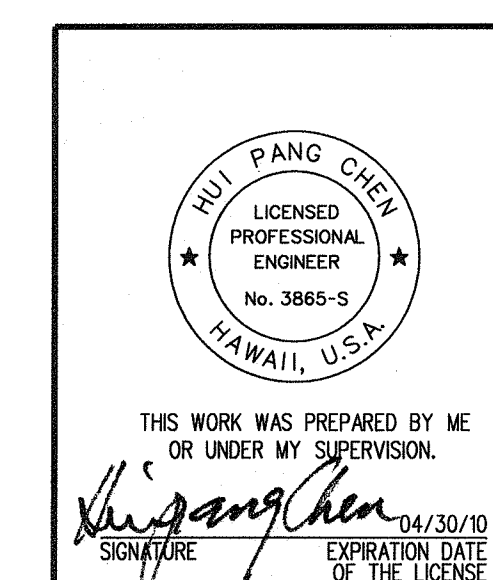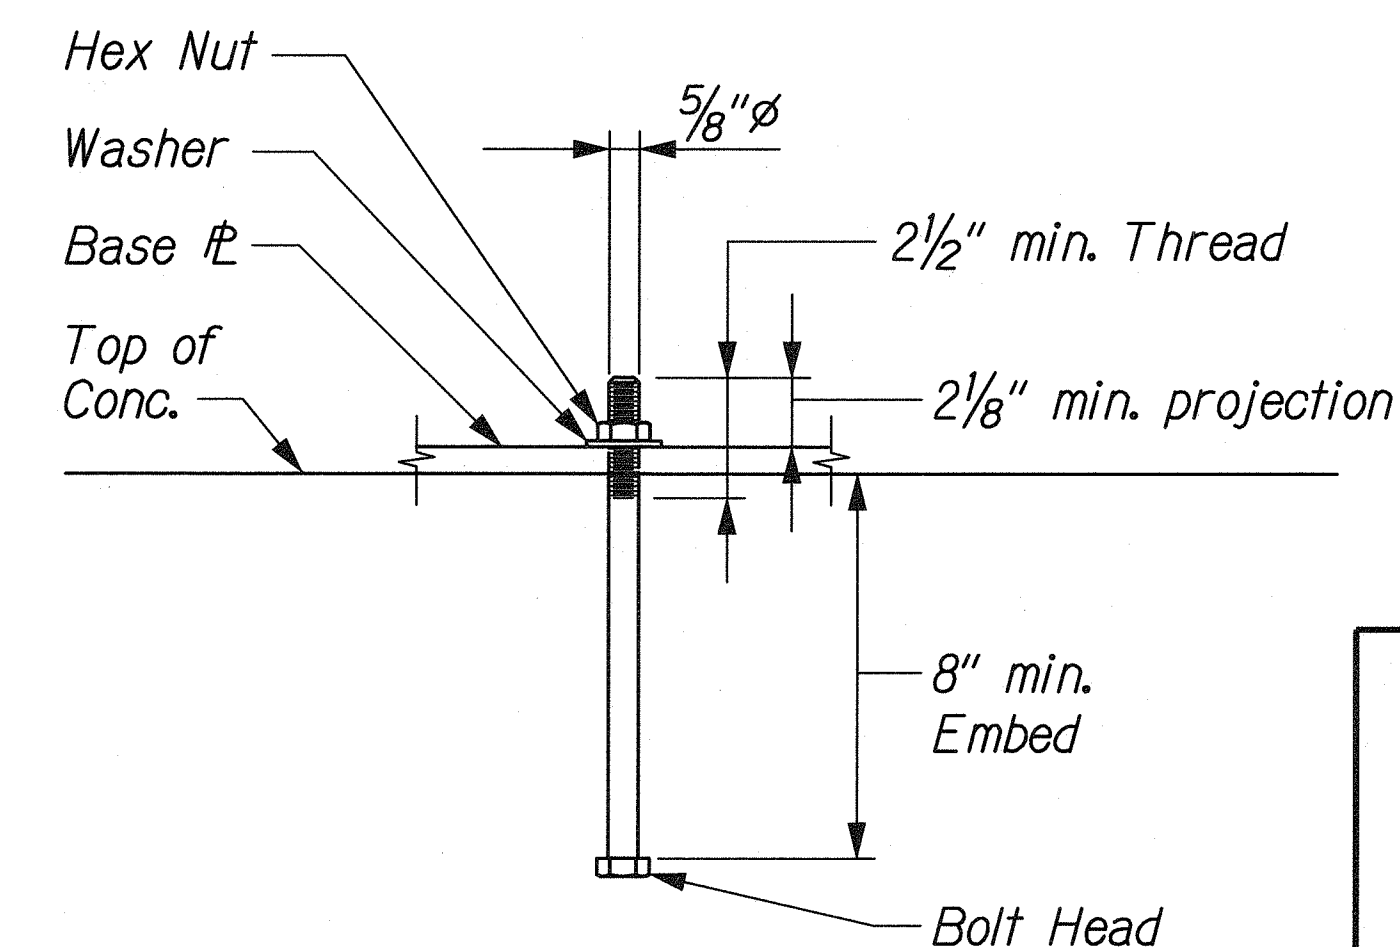

STATE OF HAWAII
DEPARTMENT OF TRANSPORTATION
HIGHWAYS DIVISION

CANE HAUL RD. PEDESTRIAN BRIDGE
MISCELLANEOUS DETAILS

FORT WEAVER ROAD WIDENING
VICINITY OF AWA DRIVE TO GEIGER ROAD

Scale: As Noted Date: Feb. 22, 2008