

BEST MANAGEMENT PRACTICE NOTES:

The following special conditions apply to all land disturbance work conducted under this general permit:

a) Construction Management Techniques

- (1) Clearing and grubbing shall be held to the minimum necessary for grading and equipment operation.
- (2) Construction shall be sequenced to minimize the exposure time of the cleared surface area.
- (3) Construction shall be staged or phased for large projects. Areas of one phase shall be stabilized before another phase is initiated. Stabilization shall be accomplished by temporarily or permanently protecting the disturbed soil surface from rainfall impacts and runoff.
- (4) Erosion and sediment control measures shall be in place and functional before earth moving operations begin. These measures shall be properly constructed and maintained throughout the construction period.
- (5) All control measures shall be checked and repaired as necessary, for example, weekly in dry periods and within twenty-four hours after any rainfall of 0.5 inches or greater within a 24-hour period. During prolonged rainfall, daily checking is necessary. The permittee shall maintain records of checks and repairs.
- (6) The permittee shall maintain records of the duration and estimated volume of storm water discharge(s).
- (7) The Contractor shall designate a specific individual to be responsible for erosion and sediment controls on each project site.

b) Vegetation Controls

- (1) Pre-construction vegetative ground cover shall not be destroyed, removed, or disturbed more than twenty calendar days prior to land disturbance.
- (2) Temporary soil stabilization with appropriate vegetation shall be applied on areas that will remain unfinished for more than thirty calendar days.
- (3) Permanent soil stabilization with perennial vegetation or pavement shall be applied as soon as practical after final grading. Irrigation and maintenance of the perennial vegetation shall be provided for thirty calendar days or until the vegetation takes root, whichever is shorter.

c) Structural Controls

- (1) Storm water flowing toward the construction area shall be diverted by using appropriate control measures, as practical.
- (2) Erosion control measures shall be designed according to the size of disturbed or drainage areas to detain runoff and trap sediment.
- (3) Water must be discharged in a manner that the discharge shall not cause or contribute to a violation of the basic water quality criteria as specified in section 11-54-04.

d) Grading Controls

- (1) All grading work will be done in conformance with Soil Erosion Standards and Guidelines, Department of Public Works, City & County of Honolulu, dated November 1975; and applicable provisions of Chapter 54, Water Quality Standards, and Chapter 55, Water Pollution Control, Title 11, Administrative Rules of the State Department of Health.

e) Erosion and Sediment Controls

- (1) Erosion and sediment controls will consist of silt fences, storm drain inlet protective measures, stabilized construction entrances and any additional control measures (temporary dikes, sandbags, etc.) as needed. Erosion and sediment controls will be in place until construction is complete. Locations of erosion and sediment controls will be determined on an "as needed basis" as determined by a "walk through" of the project area with the State's project engineer and the Contractor's representative. Approximate locations of erosion and sediment controls are shown on the plans.

- (2) Silt fences will be installed along the edges of open channels, ditches, and bottom of new and existing slopes to filter sediment from runoff before runoff enters the stream, channels, and/or ditches.

- (3) Storm drain inlet protective measures will be installed around existing and new drain inlets to prevent sediment from entering the storm drain system.

- (4) Stabilized control entrances shall be installed and maintained wherever vehicles are leaving the construction site and entering public roads to prevent transporting sediment onto paved roads.

- (5) Dust mitigation measures include:
 - 1. Daily watering of disturbed areas until construction is complete.
 - 2. Placing gravel where vehicles travel to minimize dust should daily watering not be sufficient.

f) Timing Controls

- (1) Clearing and grubbing for the road will start at the beginning of the project.
- (2) Construction will be sequenced to minimize exposure time of cleared surfaces.
- (3) Temporary erosion and sediment control measures will be in place and functional before earth moving operations begin, and will be maintained throughout the construction period until construction is complete.
- (4) Temporary erosion and sediment control measures may be removed at the beginning of the workday to facilitate construction, but shall be replaced at the end of the workday.
- (5) All temporary erosion and sediment control measures shall be removed after construction is completed and permanent controls are in place.
- (6) Disturbed areas caused by the project construction activities will be restored to their original pre-construction condition or will be hydro-mulched once the permanent work is completed.

HYDRO TESTING WATER:

- (1) Untreated hydro testing water will not be discharged into the storm drainage system or any streams on this project.
- (2) Any hydro testing water will be treated and neutralized and either contained on-site and allowed to infiltrate into the ground or pumped into the Contractor's water truck and used for dust control.

ADDITIONAL MANAGEMENT PRACTICES:

- (1) All construction equipment will be maintained in operable condition and inspected for signs of leaks.
- (2) Hazardous material (including fuels, oils, solvents, etc.) will not be stored in the construction area or in the access area.
- (3) General daily practices:
 - a. The work area will be kept clean of debris.
 - b. All spills will be cleaned immediately.
 - c. Silt and debris will not be allowed to enter the storm drain system.
- (4) All pickup trucks will be fueled off-site.
- (5) Slurry from saw cutting operations will be contained by placing absorbent materials and sandbags on the low side of the area being cut. Material that is not contained will be vacuumed immediately following the saw cutting operations.
- (6) Slurry from coring operations will be contained and disposed of in the concrete wash pit or lined container.

FED. ROAD DIST. NO.	STATE	FEDERAL AID PROJ. NO.	FISCAL YEAR	SHEET NO.	TOTAL SHEETS
HAWAII	HAW.	CMAQ-076-1(9)	2006	145	371

EMERGENCY POINT OF CONTACT:

- Howard Luyt, Project Manager, 478-4830
- Colin Ching, Project Superintendent, 479-5739
- Darek Kawamoto, Project Engineer, 479-0686

DESIGNED BY	DATE
TRACED BY	
NOTED BY	
CHECKED BY	

1/6 FORT WEAVER ROAD/PACKAGE2/EROSION/BMP1.dgn

THIS WORK WAS PREPARED BY ME OR UNDER MY SUPERVISION.

SIGNATURE: *[Signature]* EXPIRATION DATE OF THE LICENSE: 04/30/10


STATE OF HAWAII
DEPARTMENT OF TRANSPORTATION
HIGHWAYS DIVISION

**WATER POLLUTION AND
EROSION CONTROL NOTES**


FORT WEAVER ROAD WIDENING
VICINITY OF AAWA DRIVE TO GEIGER ROAD

Scale: None Date: Feb. 22, 2008


FED. ROAD DIST. NO.	STATE	FEDERAL AID PROJ. NO.	FISCAL YEAR	SHEET NO.	TOTAL SHEETS
HAWAII	HAW.	CMAQ-076-1(9)	2006	146	371

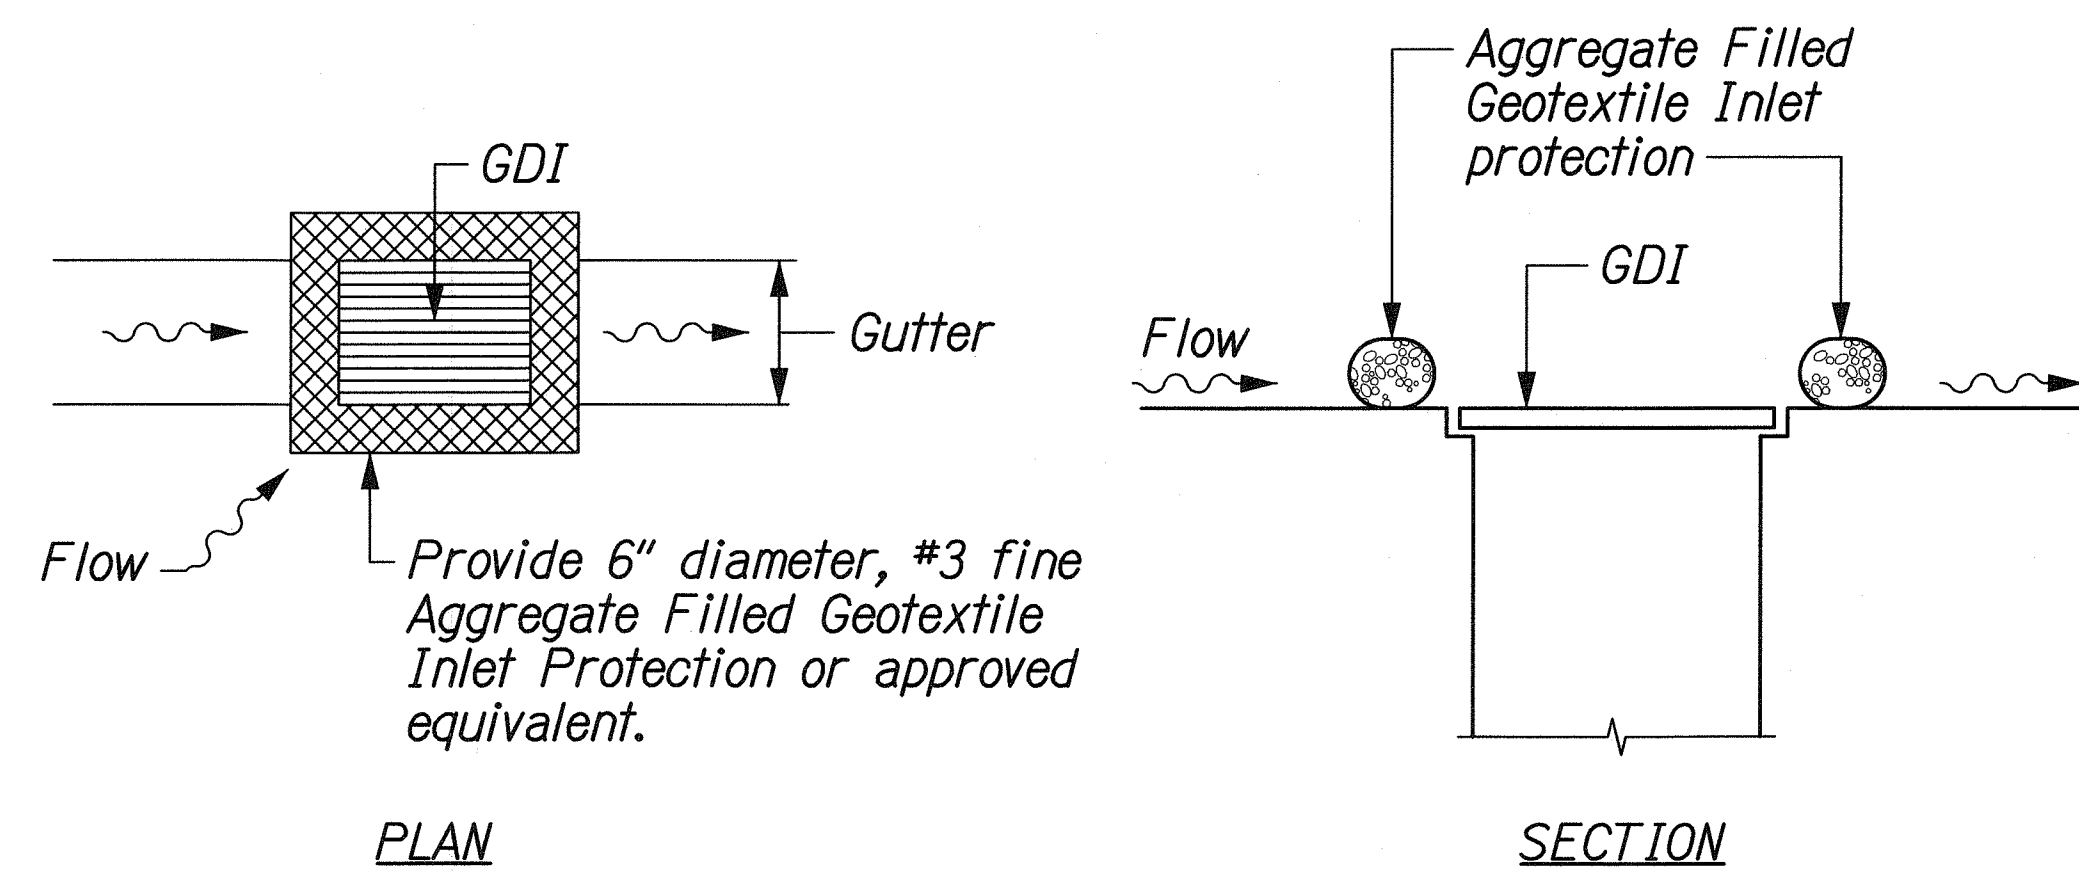



INLET PROTECTION
Not to Scale

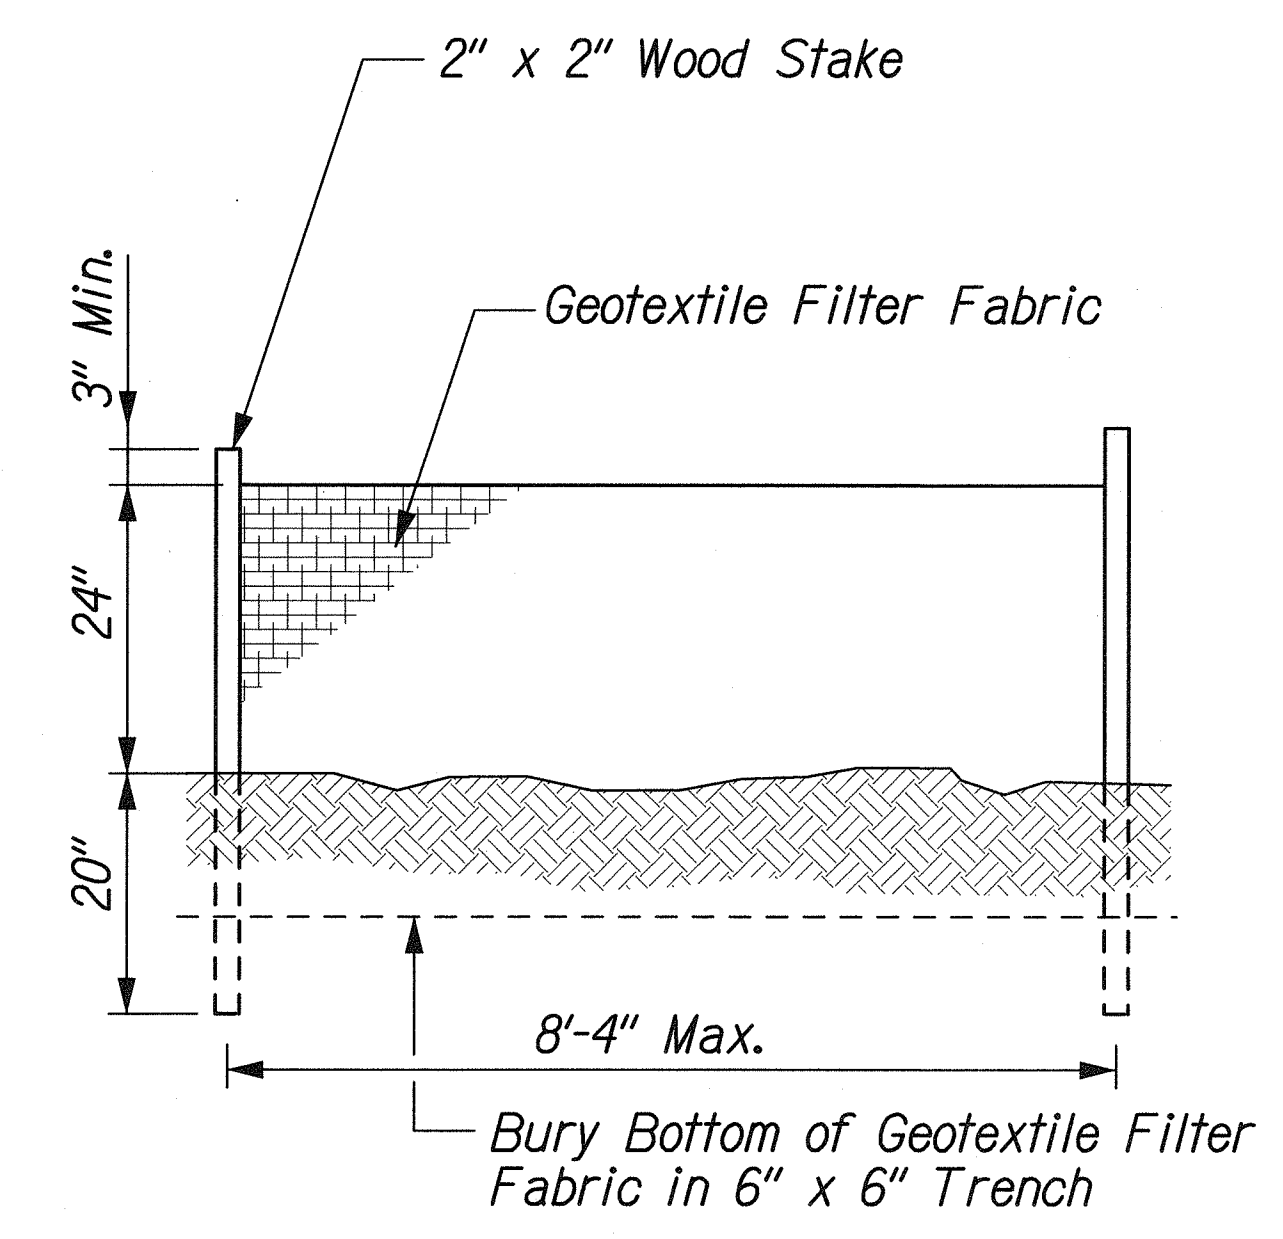

SILT FENCE DETAIL
Not to Scale

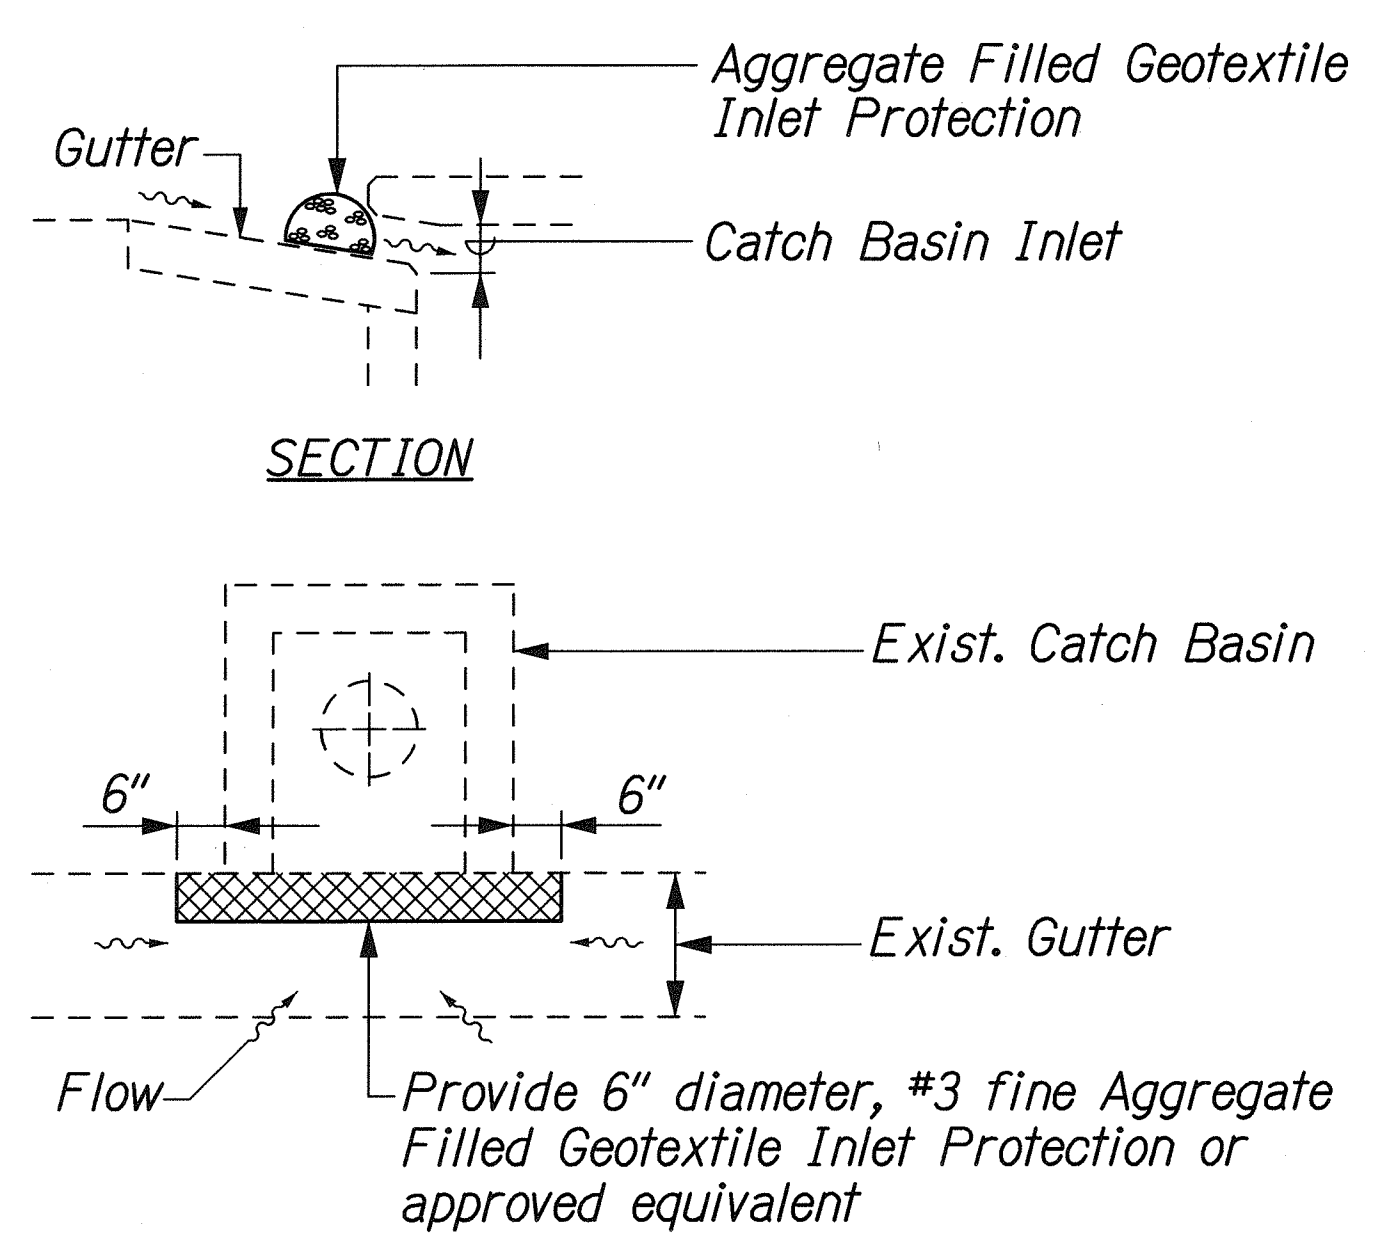

INLET PROTECTION AT EXISTING CATCH BASIN
Not to Scale

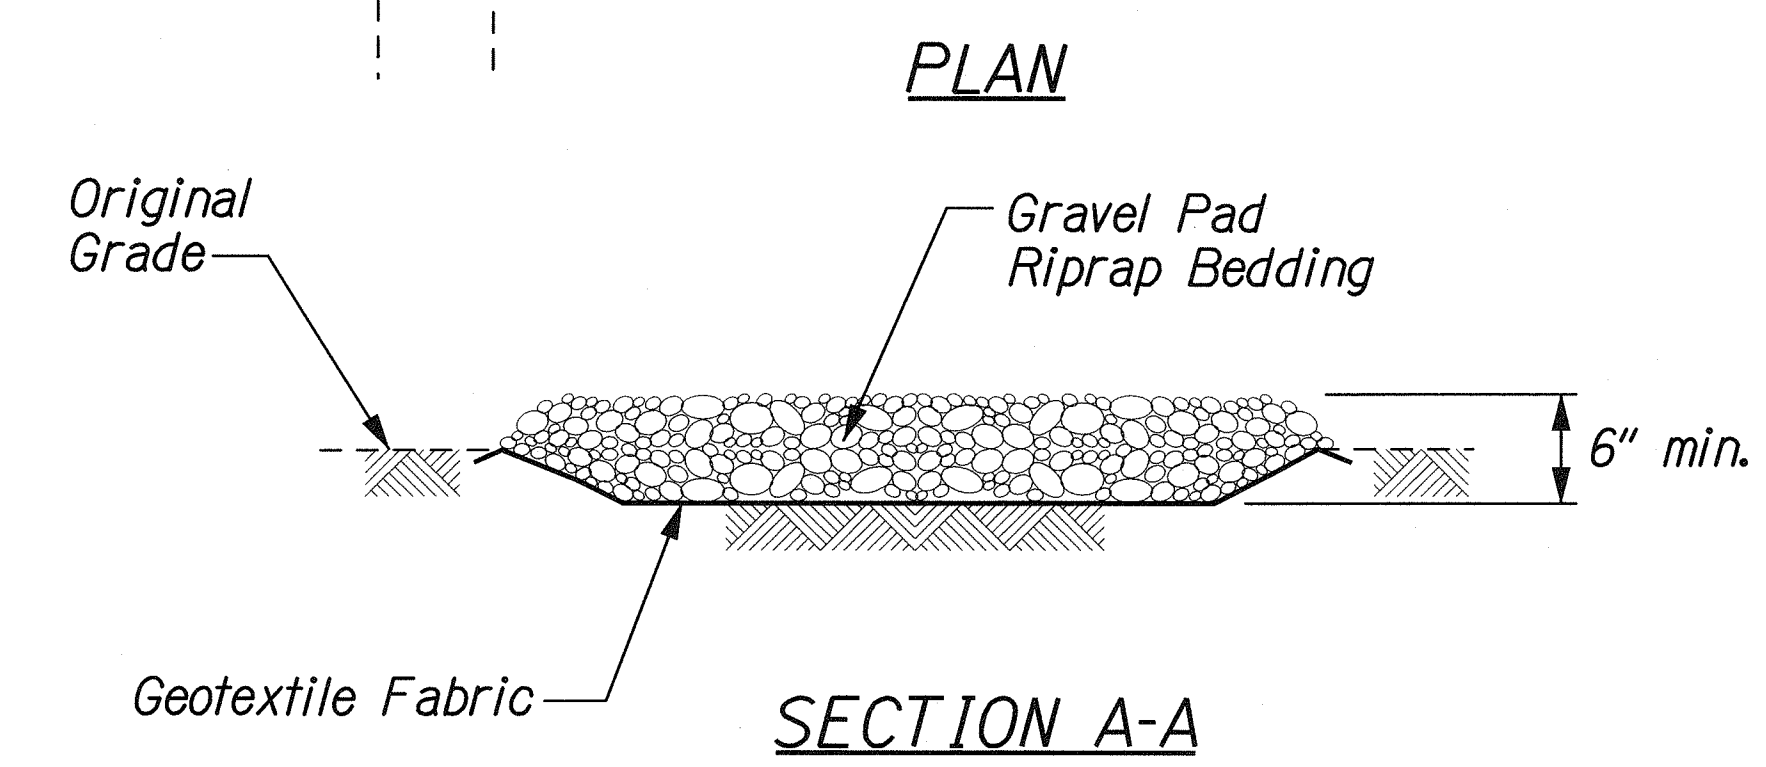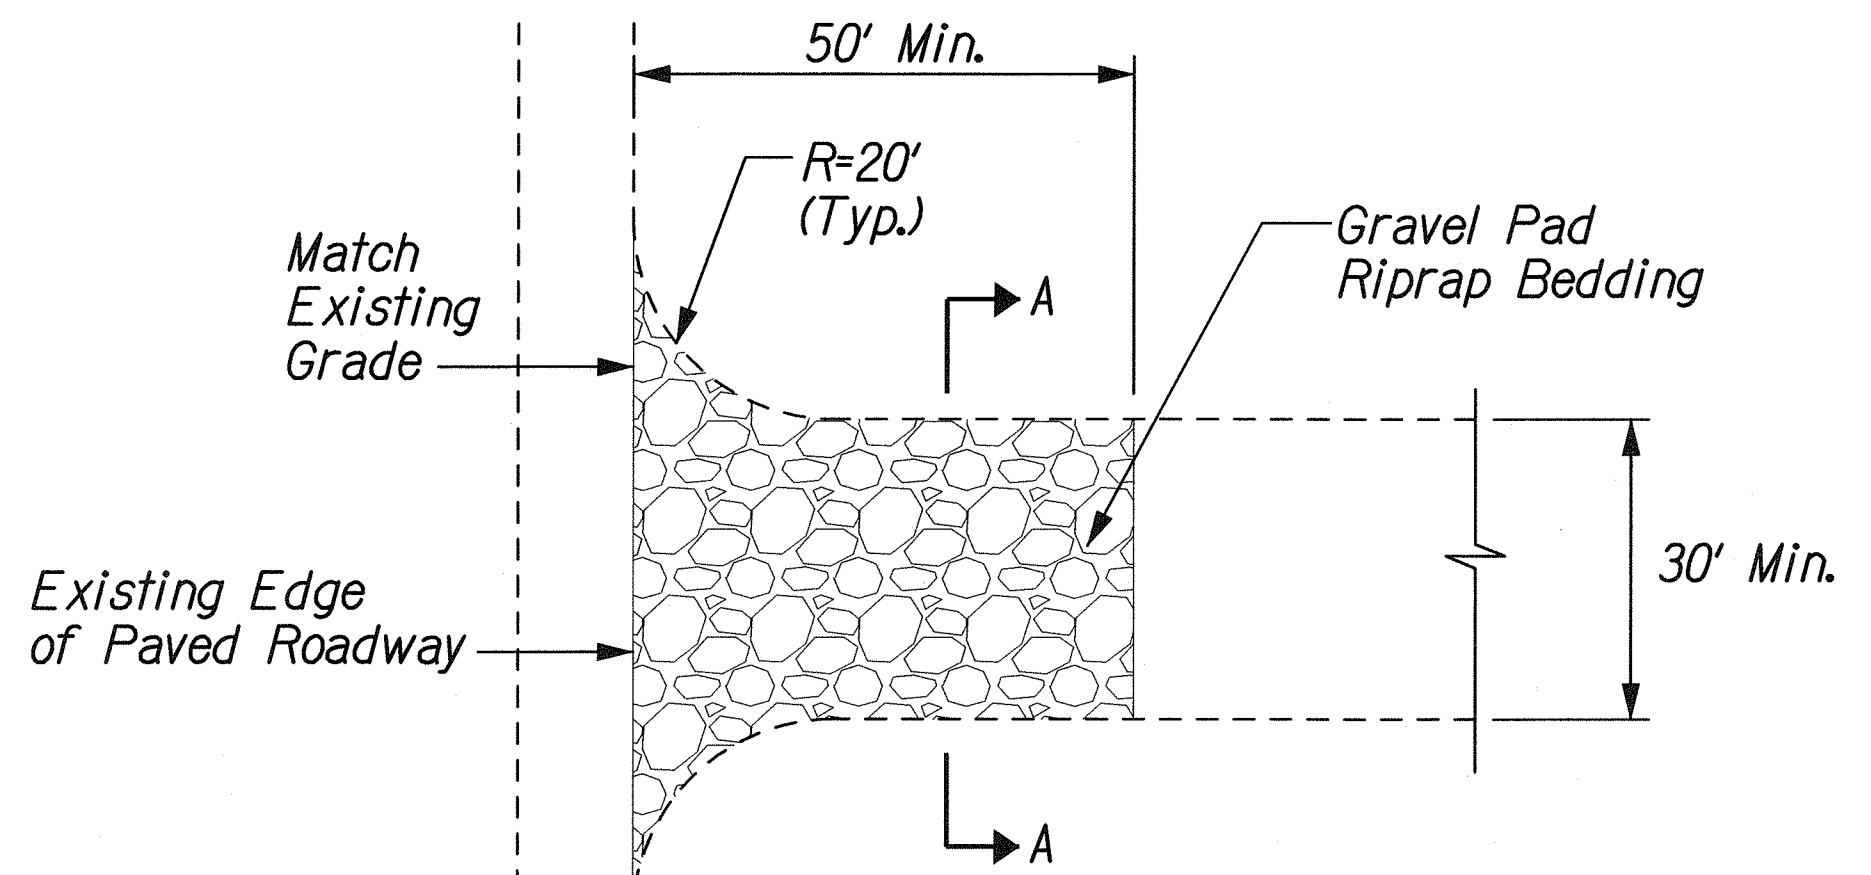

TEMPORARY CONSTRUCTION ENTRANCE STABILIZATION
Not to Scale

- SILT FENCE NOTES:**
1. The filter fabric shall be a minimum of 36 inches wide.
 2. If silt fence is obtained from manufacturer as a package (i.e. fabric attached to post) the manufacturer's installation instructions shall be adhered to.

THIS WORK WAS PREPARED BY ME
OR UNDER MY SUPERVISION.
SIGNATURE: *R. Urasaki* EXPIRATION DATE: 04/30/10 OF THE LICENSE

STATE OF HAWAII
DEPARTMENT OF TRANSPORTATION
HIGHWAYS DIVISION

**WATER POLLUTION AND
EROSION CONTROL DETAILS**


FORT WEAVER ROAD WIDENING
VICINITY OF AAWA DRIVE TO GEIGER ROAD

Scale: None Date: Feb. 22, 2008

ORIGINAL PLAN	SURVEY PLOTTED BY	DATE
NOTE BOOK	DRAWN BY	
	DESIGNED BY	
	QUANTITIES BY	
	CHECKED BY	

J:\FORT WEAVER ROAD\MISC\BMP-DET.dgn

FED. ROAD DIST. NO.	STATE	FEDERAL AID PROJ. NO.	FISCAL YEAR	SHEET NO.	TOTAL SHEETS
HAWAII	HAW.	CMAQ-076-1(9)	2006	147	371

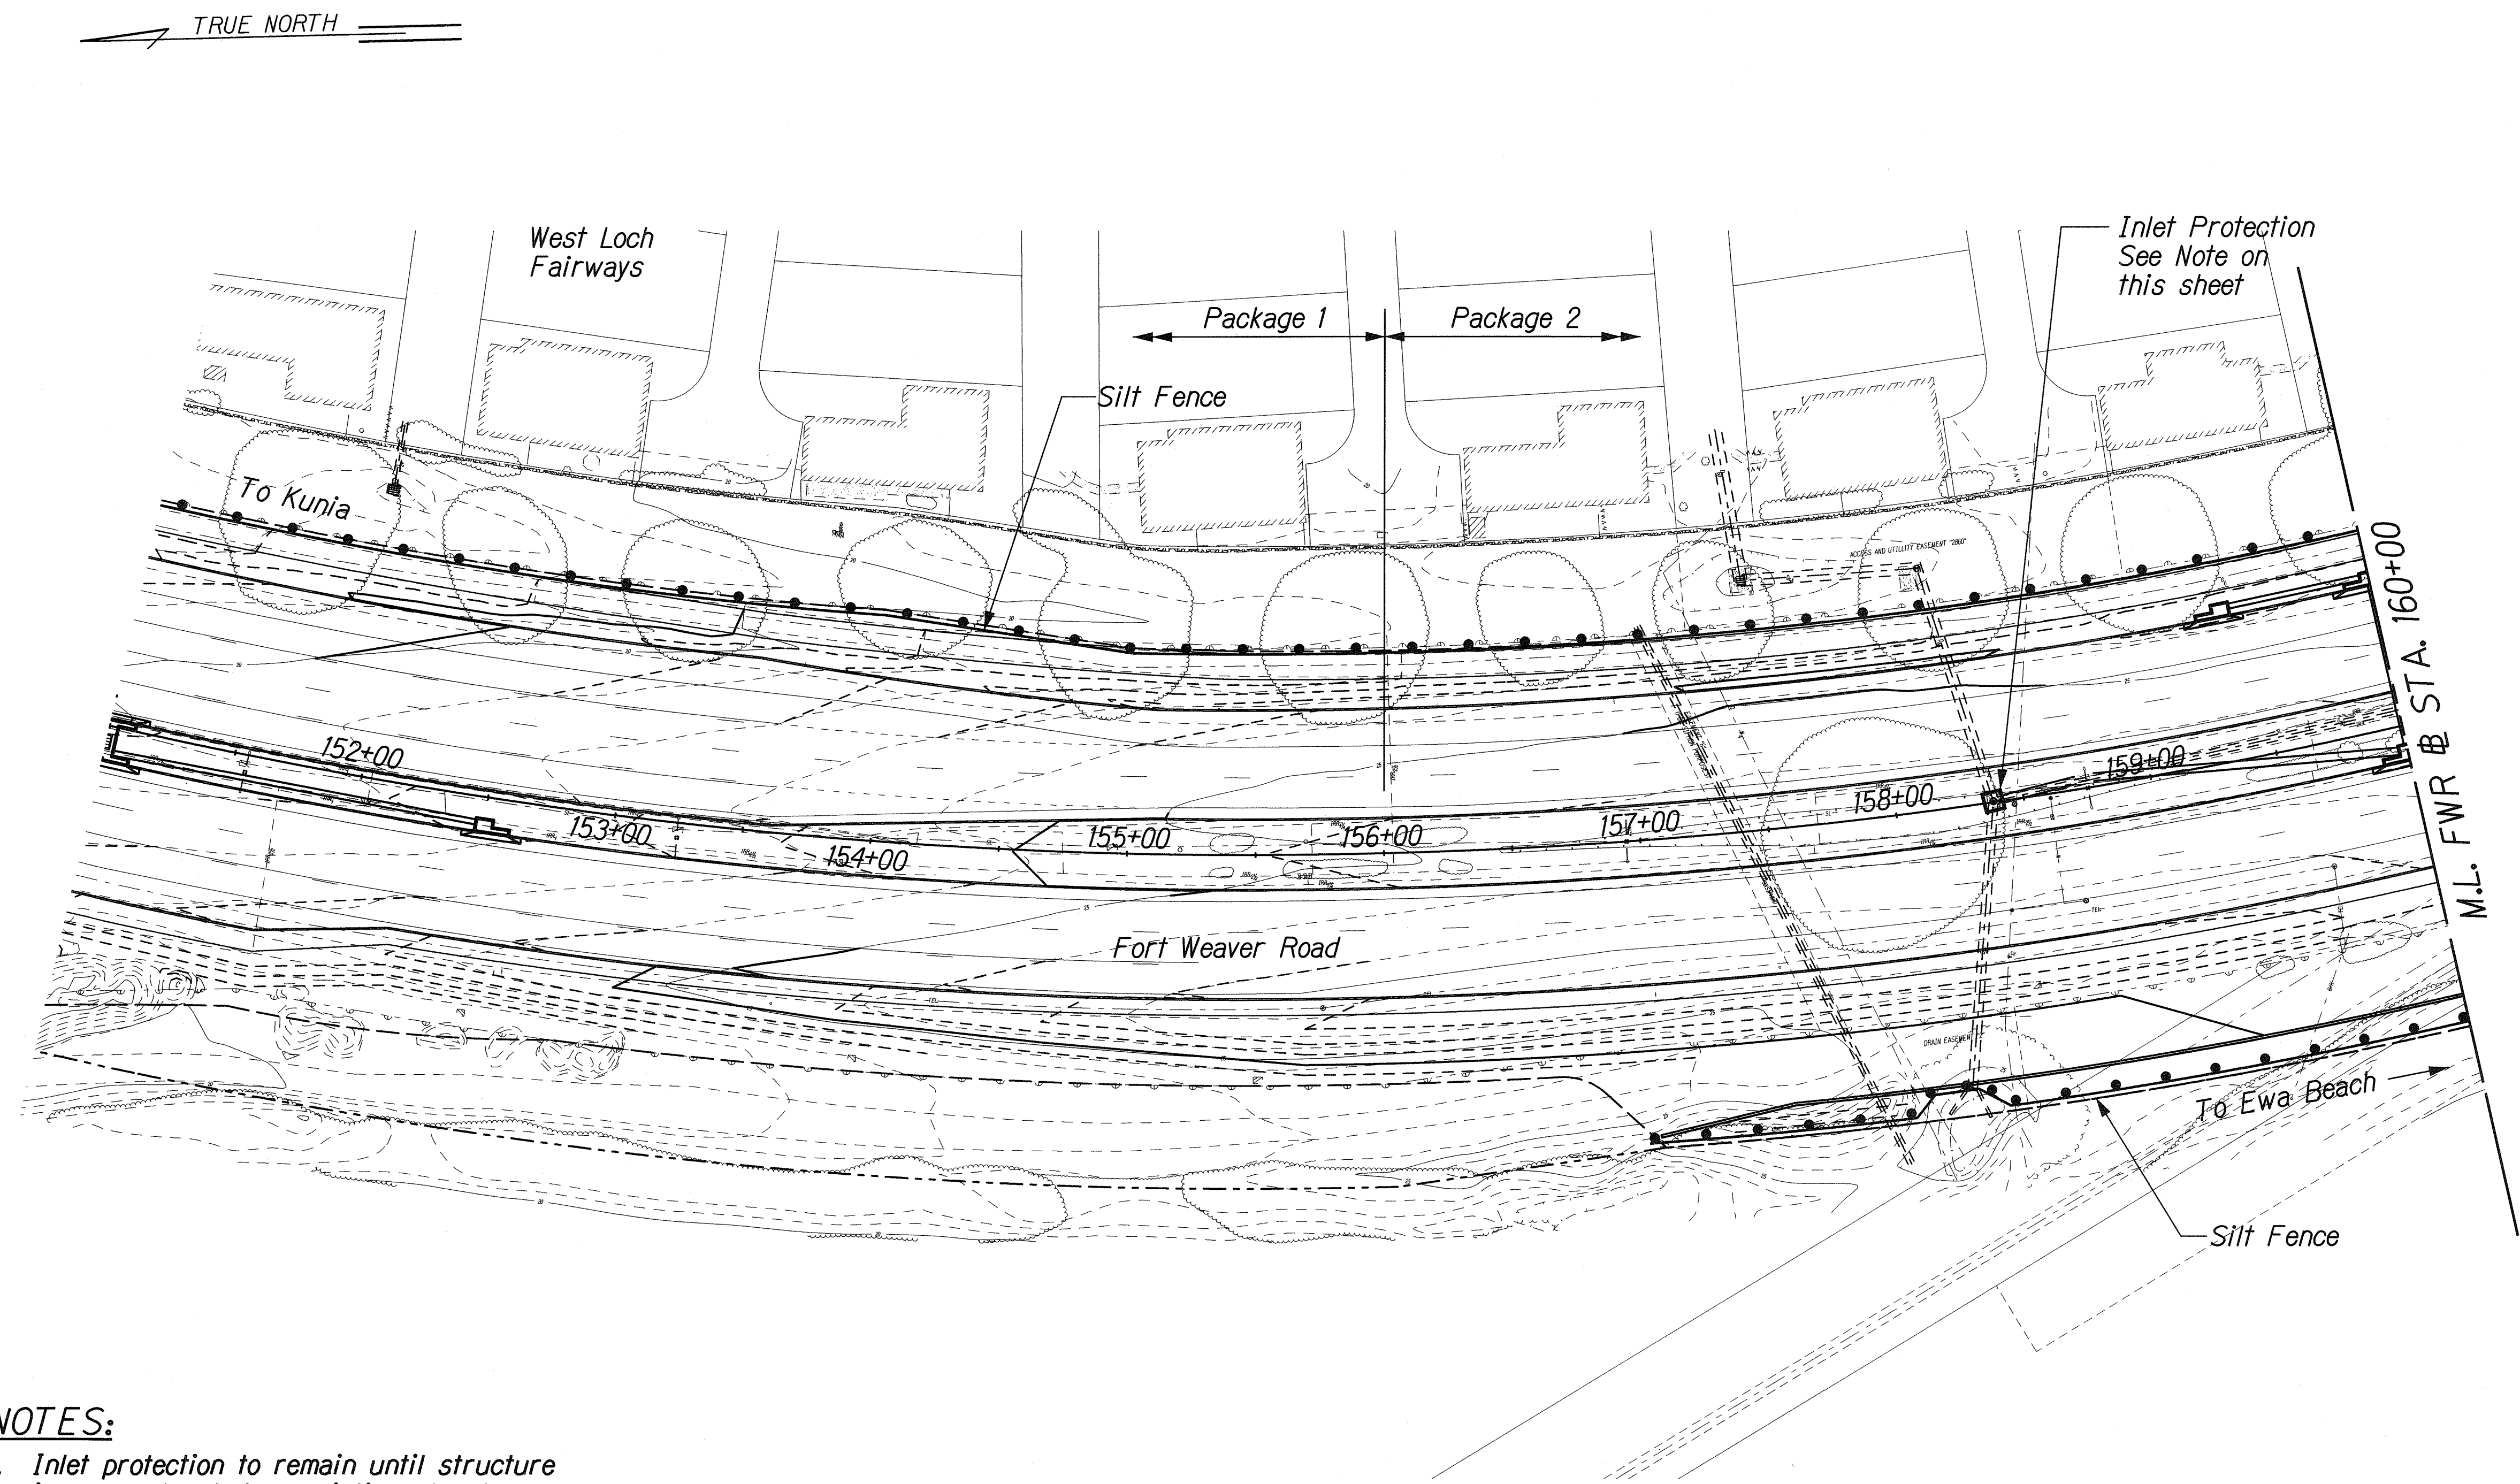

- NOTES:**
1. Inlet protection to remain until structure is re-constructed or existing structure removed.
 2. Provide inlet protection at all new catch basins and drop inlets.

- LEGEND:**
- Silt Fence
 - Inlet Protection

ORIGINAL PLAN	DATE
DESIGNED BY	
NOTED BY	
CHECKED BY	

16/FORT WEAVER ROAD/PACKAGE2/EROSION/EROSION1.dgn

THIS WORK WAS PREPARED BY ME
OR UNDER MY SUPERVISION.
SIGNATURE: *R. M. Urasaki*
04/30/10
EXPIRATION DATE OF THE LICENSE

STATE OF HAWAII
DEPARTMENT OF TRANSPORTATION
HIGHWAYS DIVISION



EROSION CONTROL PLAN
STA. 151+00 TO 160+00

FORT WEAVER ROAD WIDENING
VICINITY OF AAWA DRIVE TO GEIGER ROAD

Scale: 1" = 40' Date: Feb. 22, 2008

SHEET No. EC2-3 OF 14 SHEETS

FED. ROAD DIST. NO.	STATE	FEDERAL AID PROJ. NO.	FISCAL YEAR	SHEET NO.	TOTAL SHEETS
HAWAII	HAW.	CMAQ-076-1(9)	2006	148	371

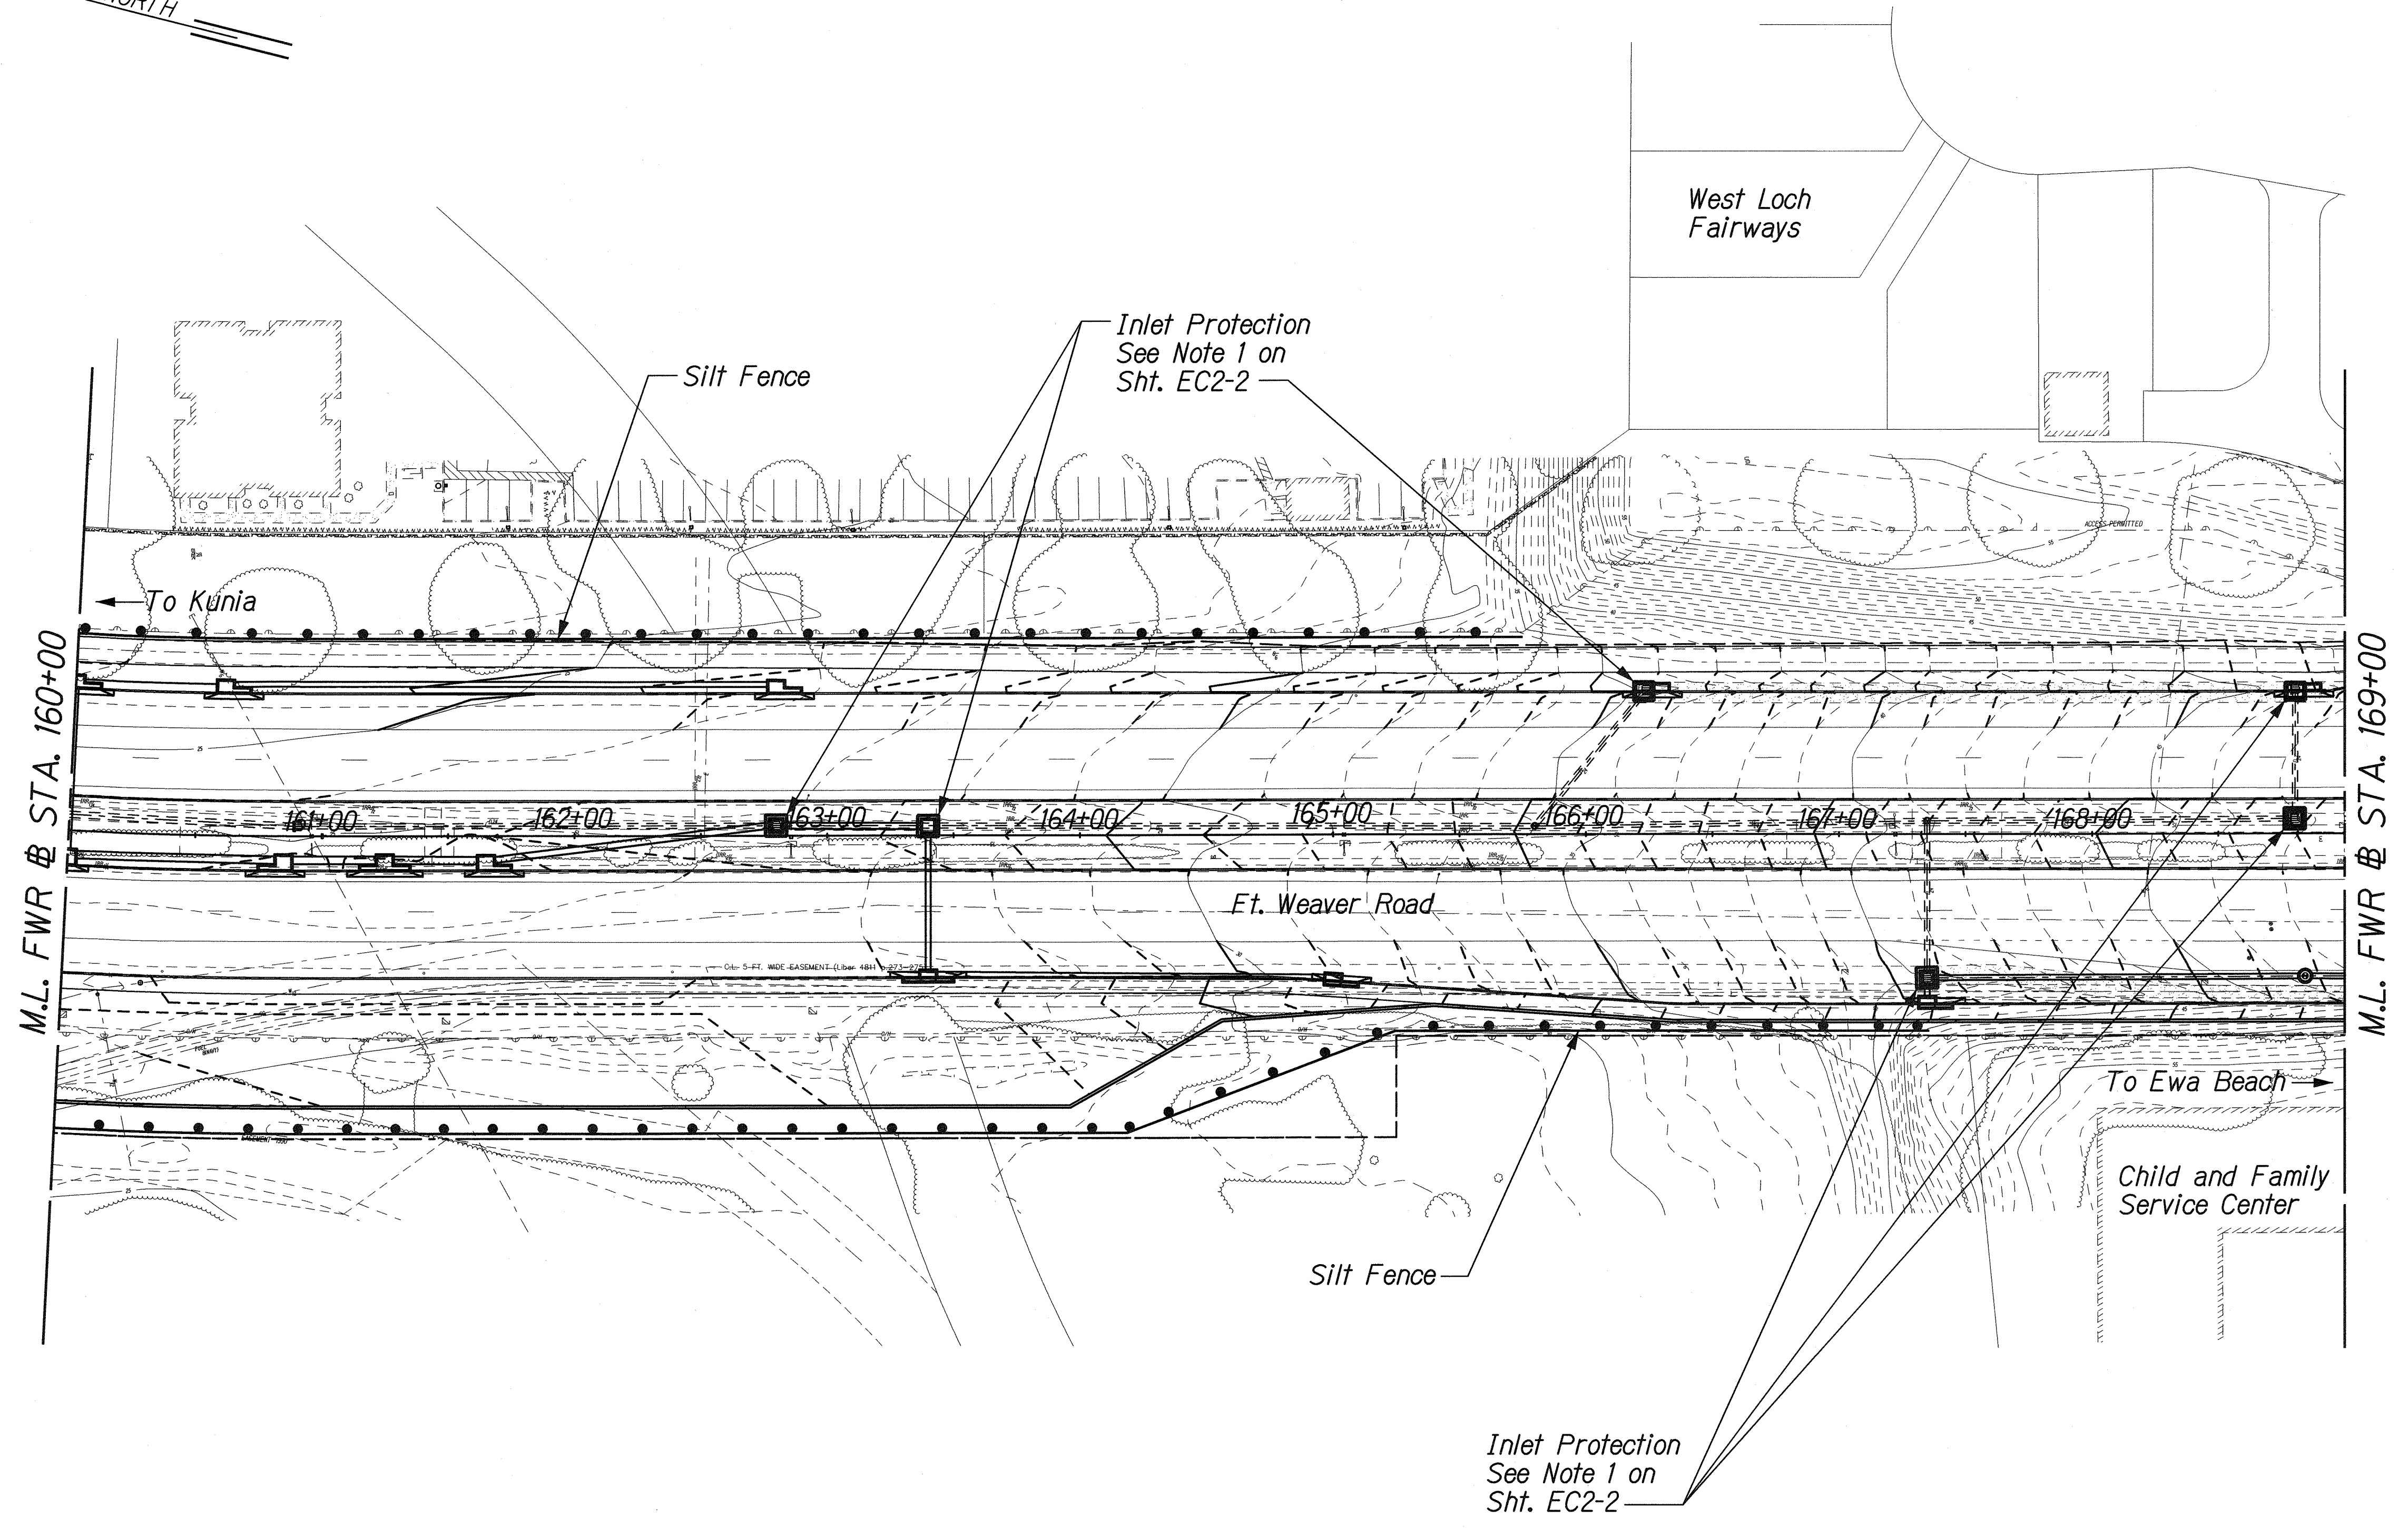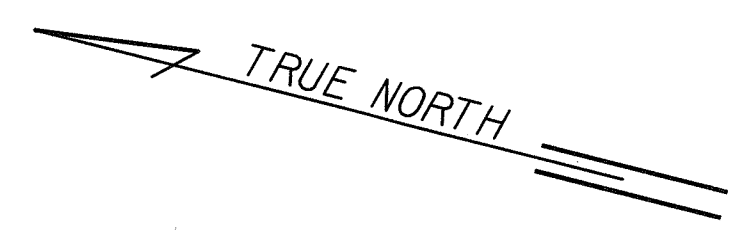

DESIGNED BY	DATE
CHECKED BY	
NOTED BY	
QUANTITIES BY	
PLANNED BY	
ENGINEER BY	
IN CHARGE BY	
PROJECT NO.	
PROJECT NAME	

\\FORT-WEAVER-ROAD\PACKAGE2\EROSION\EROSION2.dgn

THIS WORK WAS PREPARED BY ME OR UNDER MY SUPERVISION.

R. Urasak

SIGNATURE 04/30/10
EXPIRATION DATE OF THE LICENSE

STATE OF HAWAII
DEPARTMENT OF TRANSPORTATION
HIGHWAYS DIVISION


EROSION CONTROL PLAN
STA. 160+00 TO 169+00

FORT WEAVER ROAD WIDENING
VICINITY OF AAWA DRIVE TO GEIGER ROAD

Scale: 1" = 40' Date: Feb. 22, 2008

SHEET No. EC2-4 OF 14 SHEETS

FED. ROAD DIST. NO.	STATE	FEDERAL AID PROJ. NO.	FISCAL YEAR	SHEET NO.	TOTAL SHEETS
HAWAII	HAW.	CMAQ-076-1(9)	2006	149	371

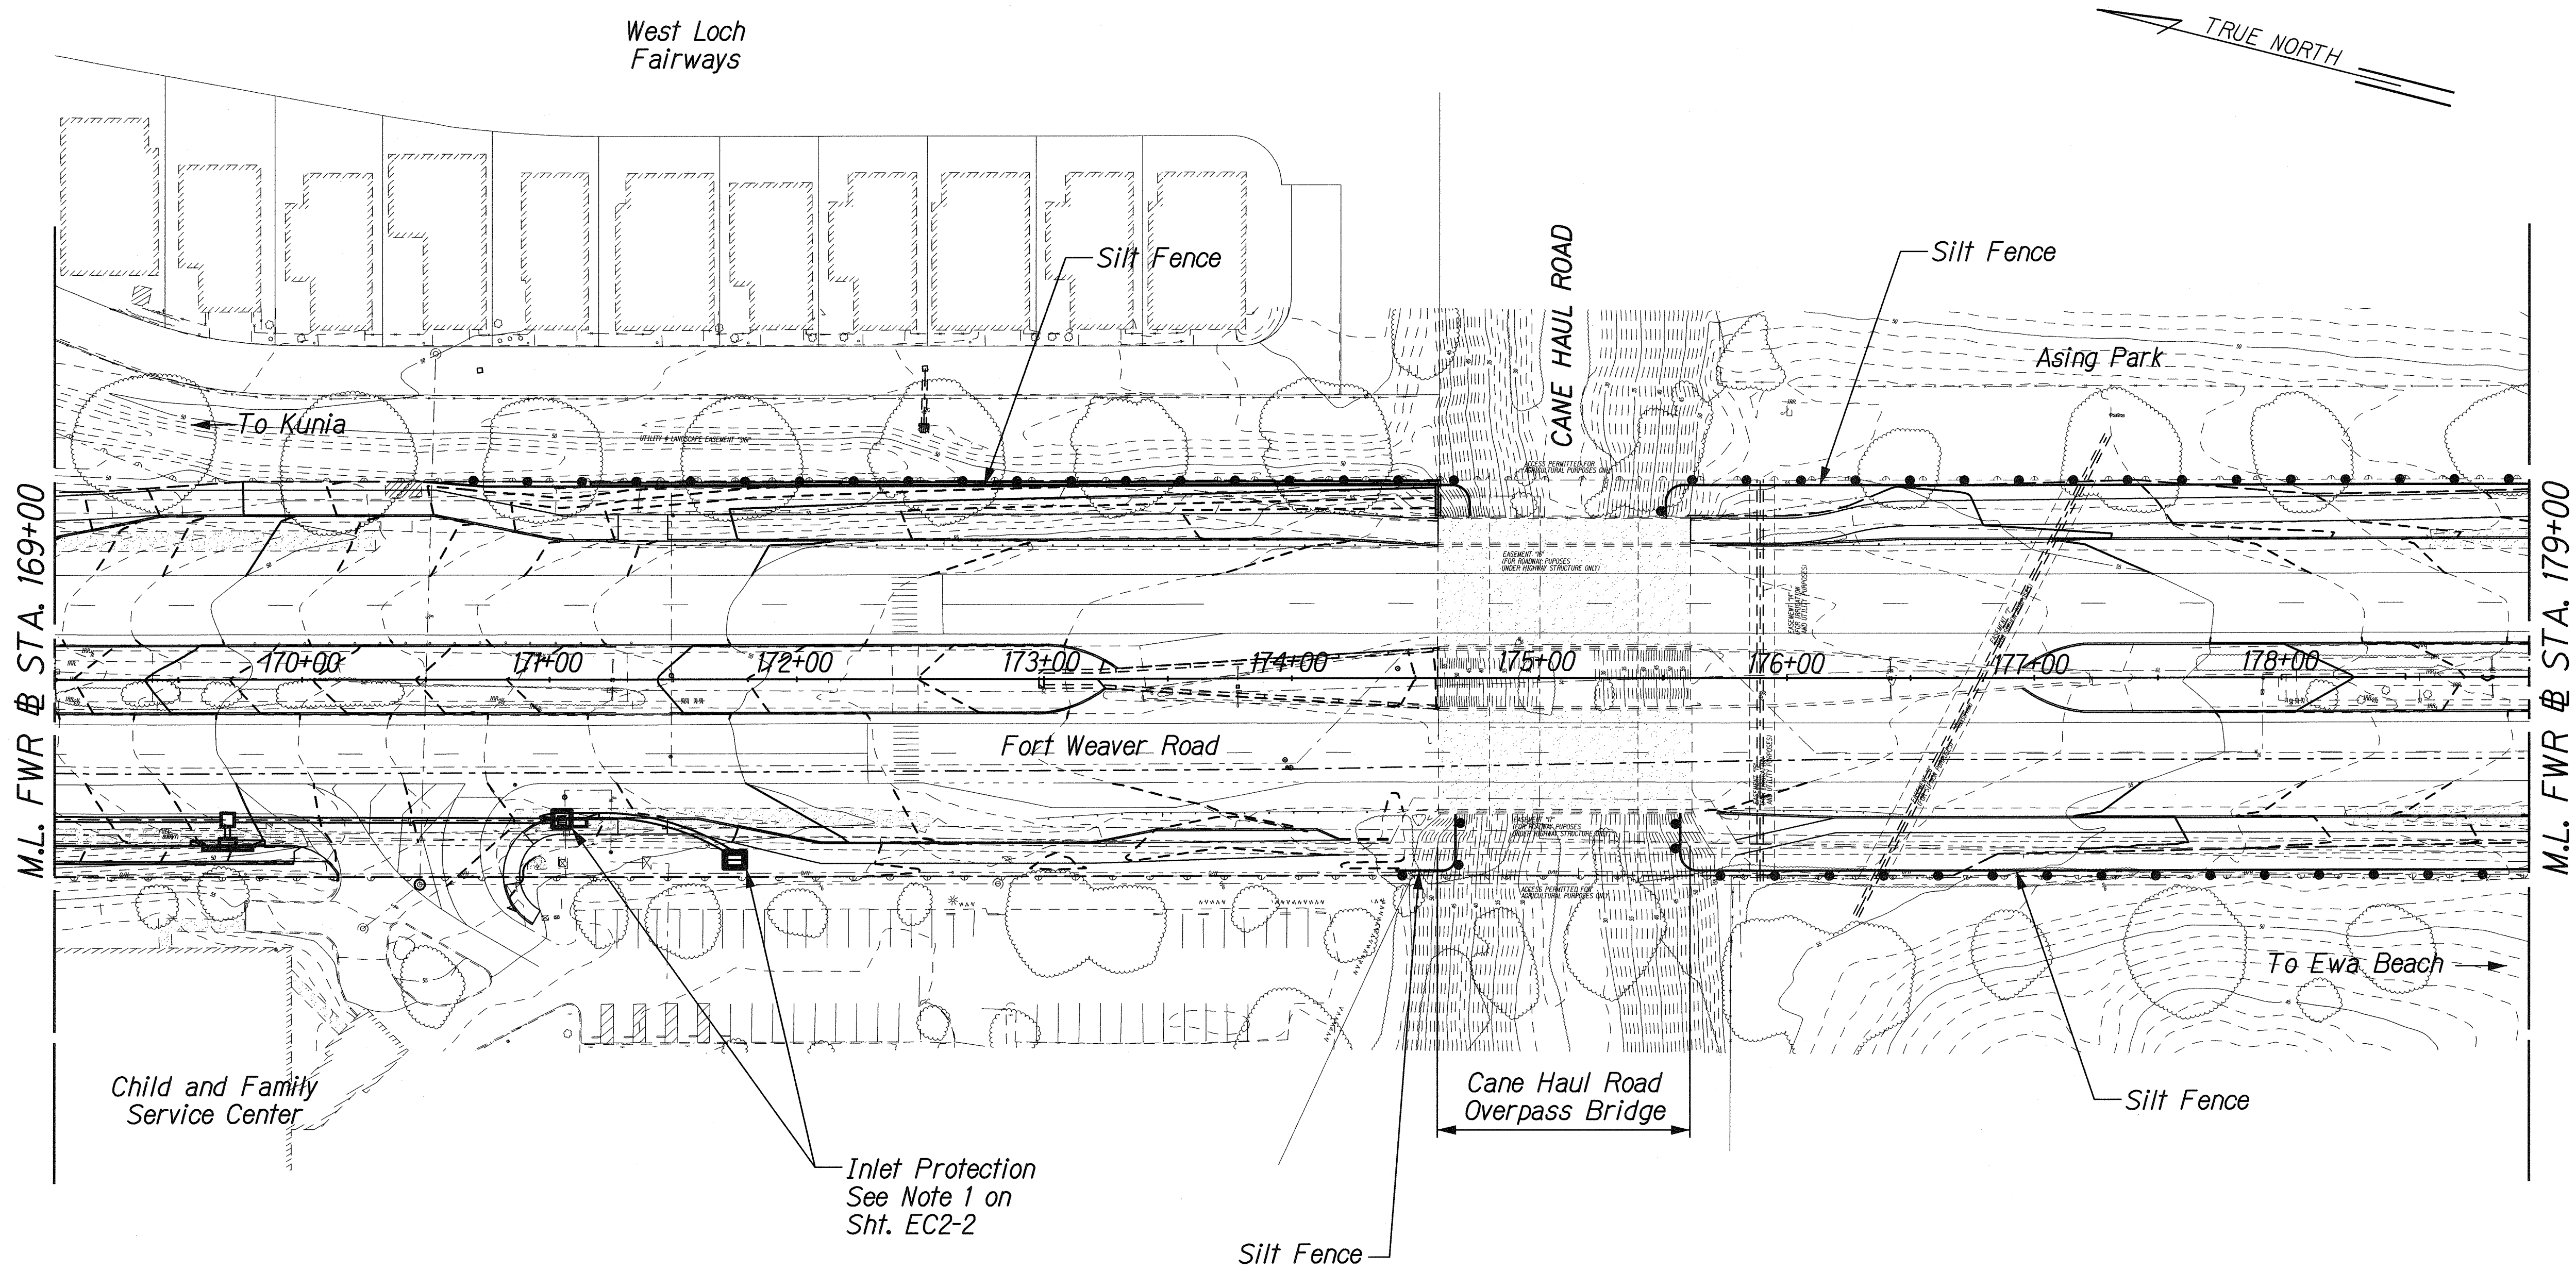

DESIGNED BY	DATE
TRACED BY	
NOTED BY	
CHECKED BY	
IN CHARGE	

\\FORT-WEAVER-ROAD\PACKAGE2\EROSION\EROSION3.dgn

RANDALL M. URASAK
 LICENSED PROFESSIONAL ENGINEER
 No. 7269-C
 HAWAII, U.S.A.

THIS WORK WAS PREPARED BY ME OR UNDER MY SUPERVISION.

[Signature]
 SIGNATURE

04/30/10
 EXPIRATION DATE OF THE LICENSE


STATE OF HAWAII
DEPARTMENT OF TRANSPORTATION
HIGHWAYS DIVISION

EROSION CONTROL PLAN
STA. 169+00 TO 179+00

FORT WEAVER ROAD WIDENING
VICINITY OF AAWA DRIVE TO GEIGER ROAD


Scale: 1" = 40' Date: Feb. 22, 2008

FED. ROAD DIST. NO.	STATE	FEDERAL AID PROJ. NO.	FISCAL YEAR	SHEET NO.	TOTAL SHEETS
HAWAII	HAW.	CMAQ-076-1(9)	2006	150	371

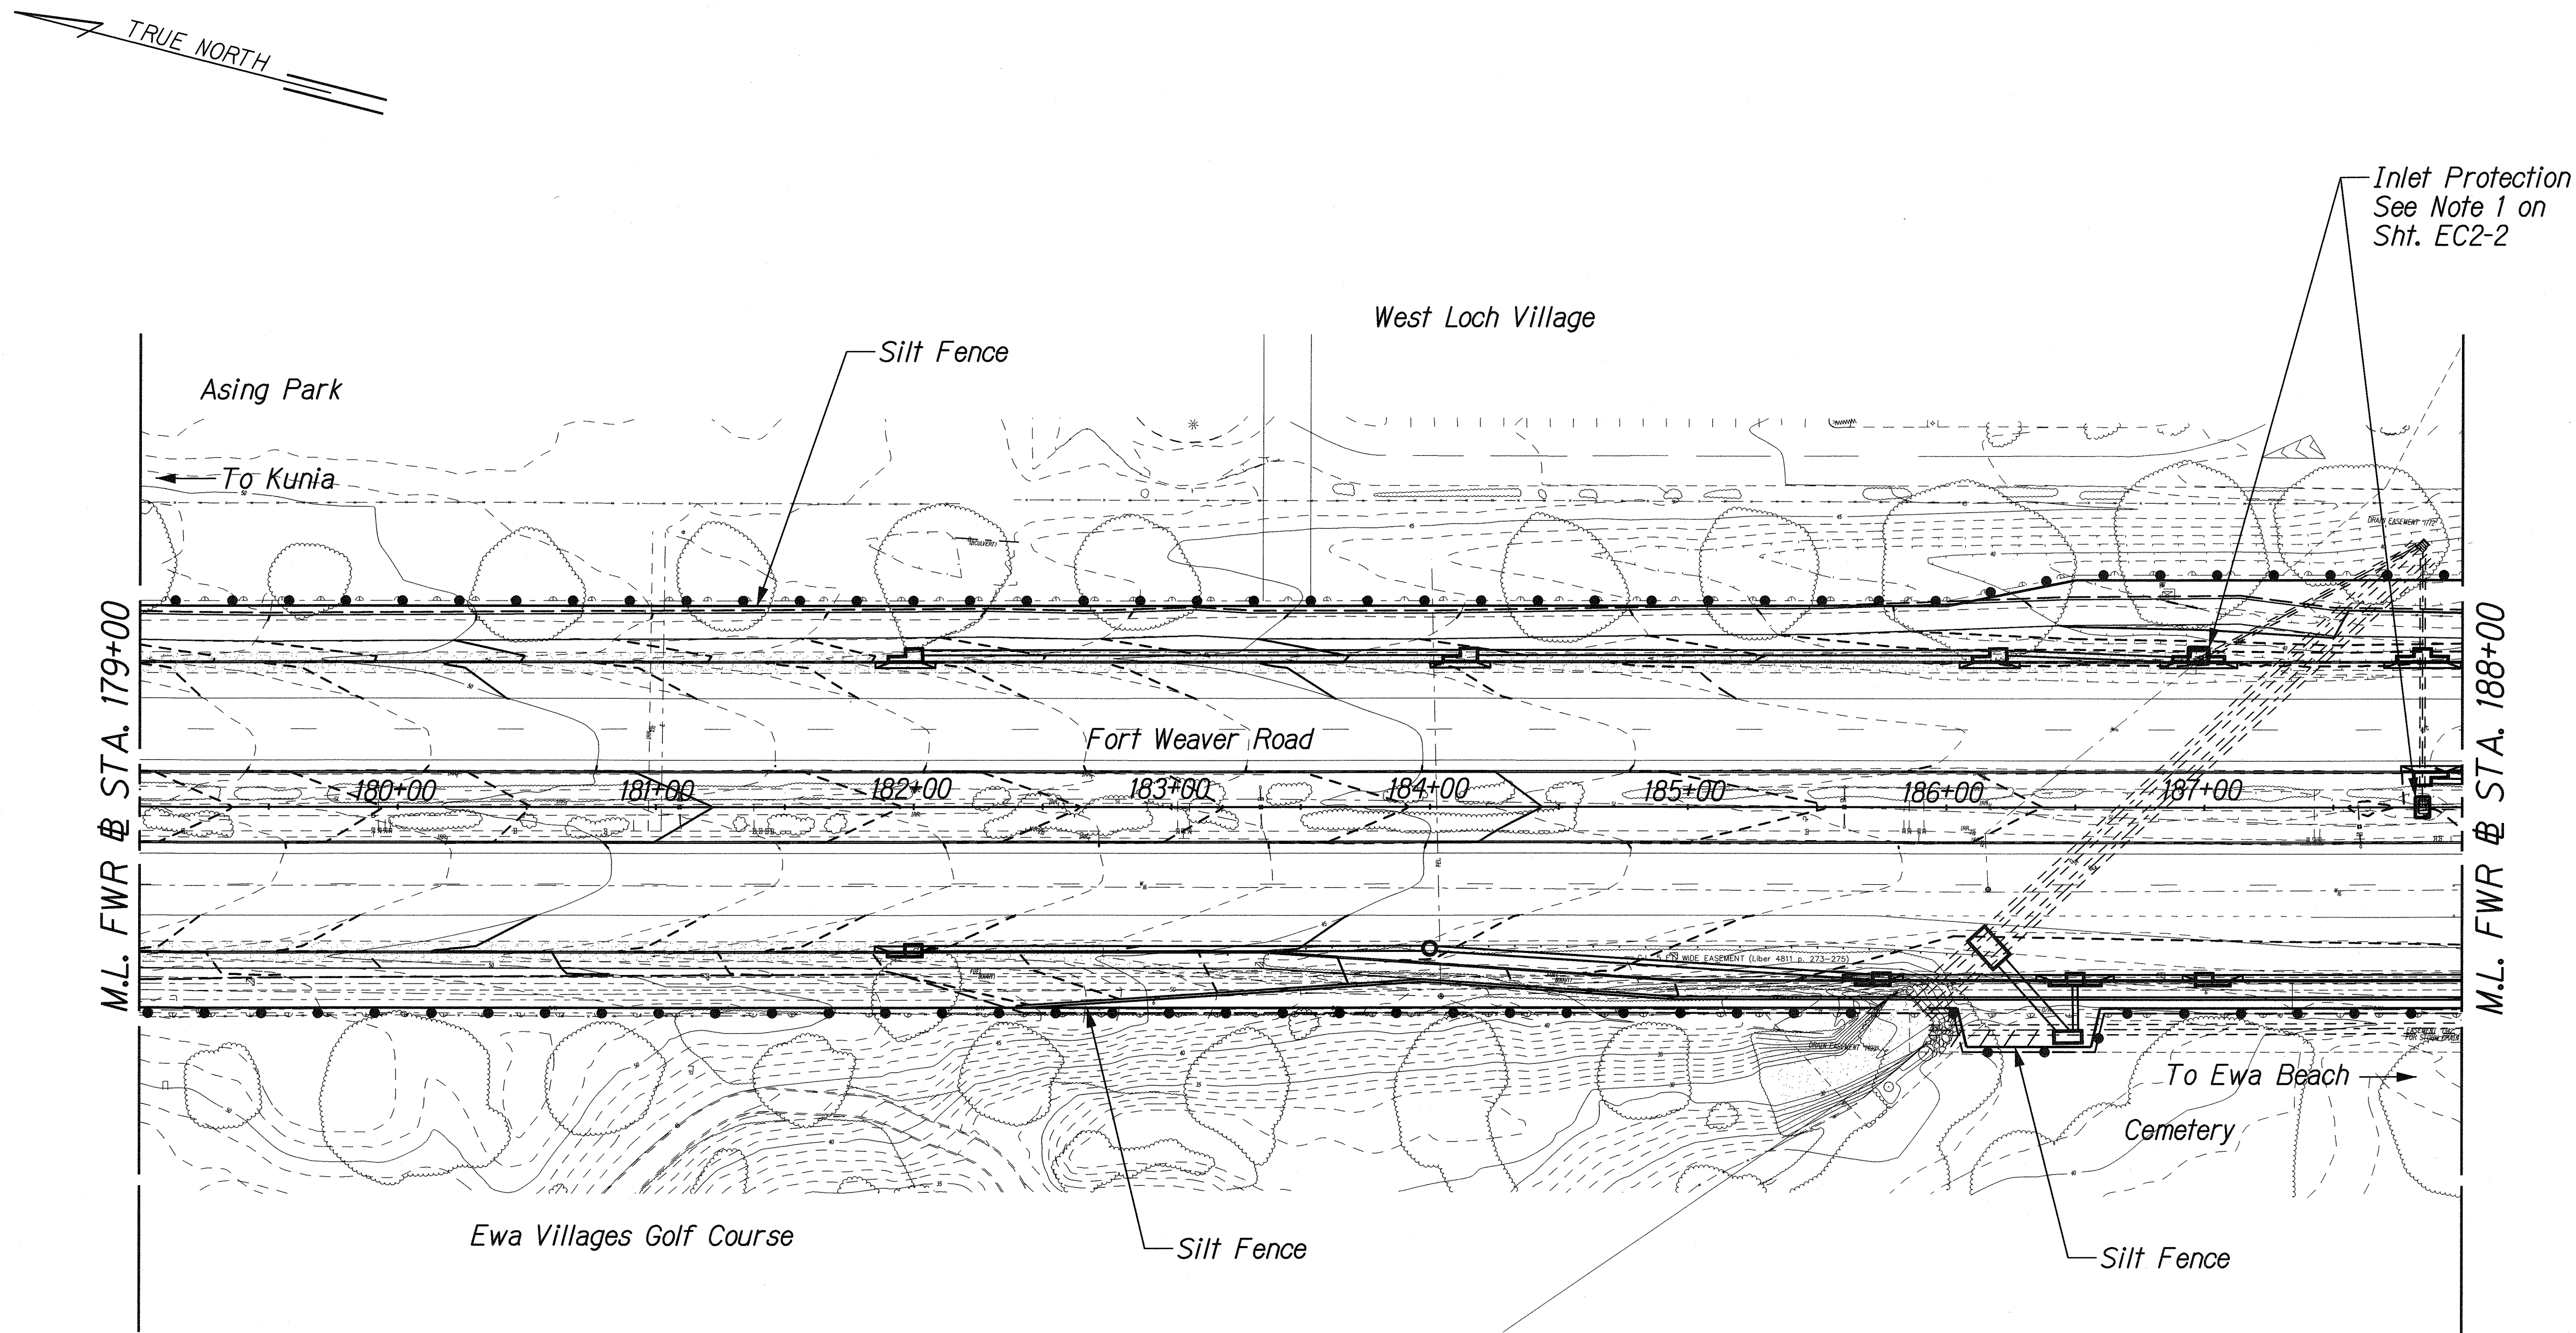

DESIGNED BY	DATE
DRAWN BY	
CHECKED BY	
NOTED BY	
QUANTITIES BY	
DATE	

J:\FORT WEAVER ROAD\PACKAGE2\EROSION\EROSTON4.dgn

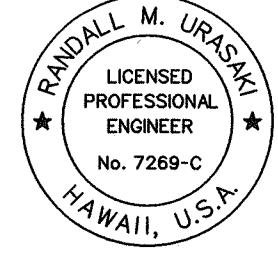

THIS WORK WAS PREPARED BY ME
OR UNDER MY SUPERVISION.
04/30/10
EXPIRATION DATE OF THE LICENSE


STATE OF HAWAII
DEPARTMENT OF TRANSPORTATION
HIGHWAYS DIVISION

EROSION CONTROL PLAN
STA. 179+00 TO 188+00

FORT WEAVER ROAD WIDENING
VICINITY OF AAWA DRIVE TO GEIGER ROAD

Scale: 1" = 40' Date: Feb. 22, 2008

FED. ROAD DIST. NO.	STATE	FEDERAL AID PROJ. NO.	FISCAL YEAR	SHEET NO.	TOTAL SHEETS
HAWAII	HAW.	CMAQ-076-1(9)	2006	151	371

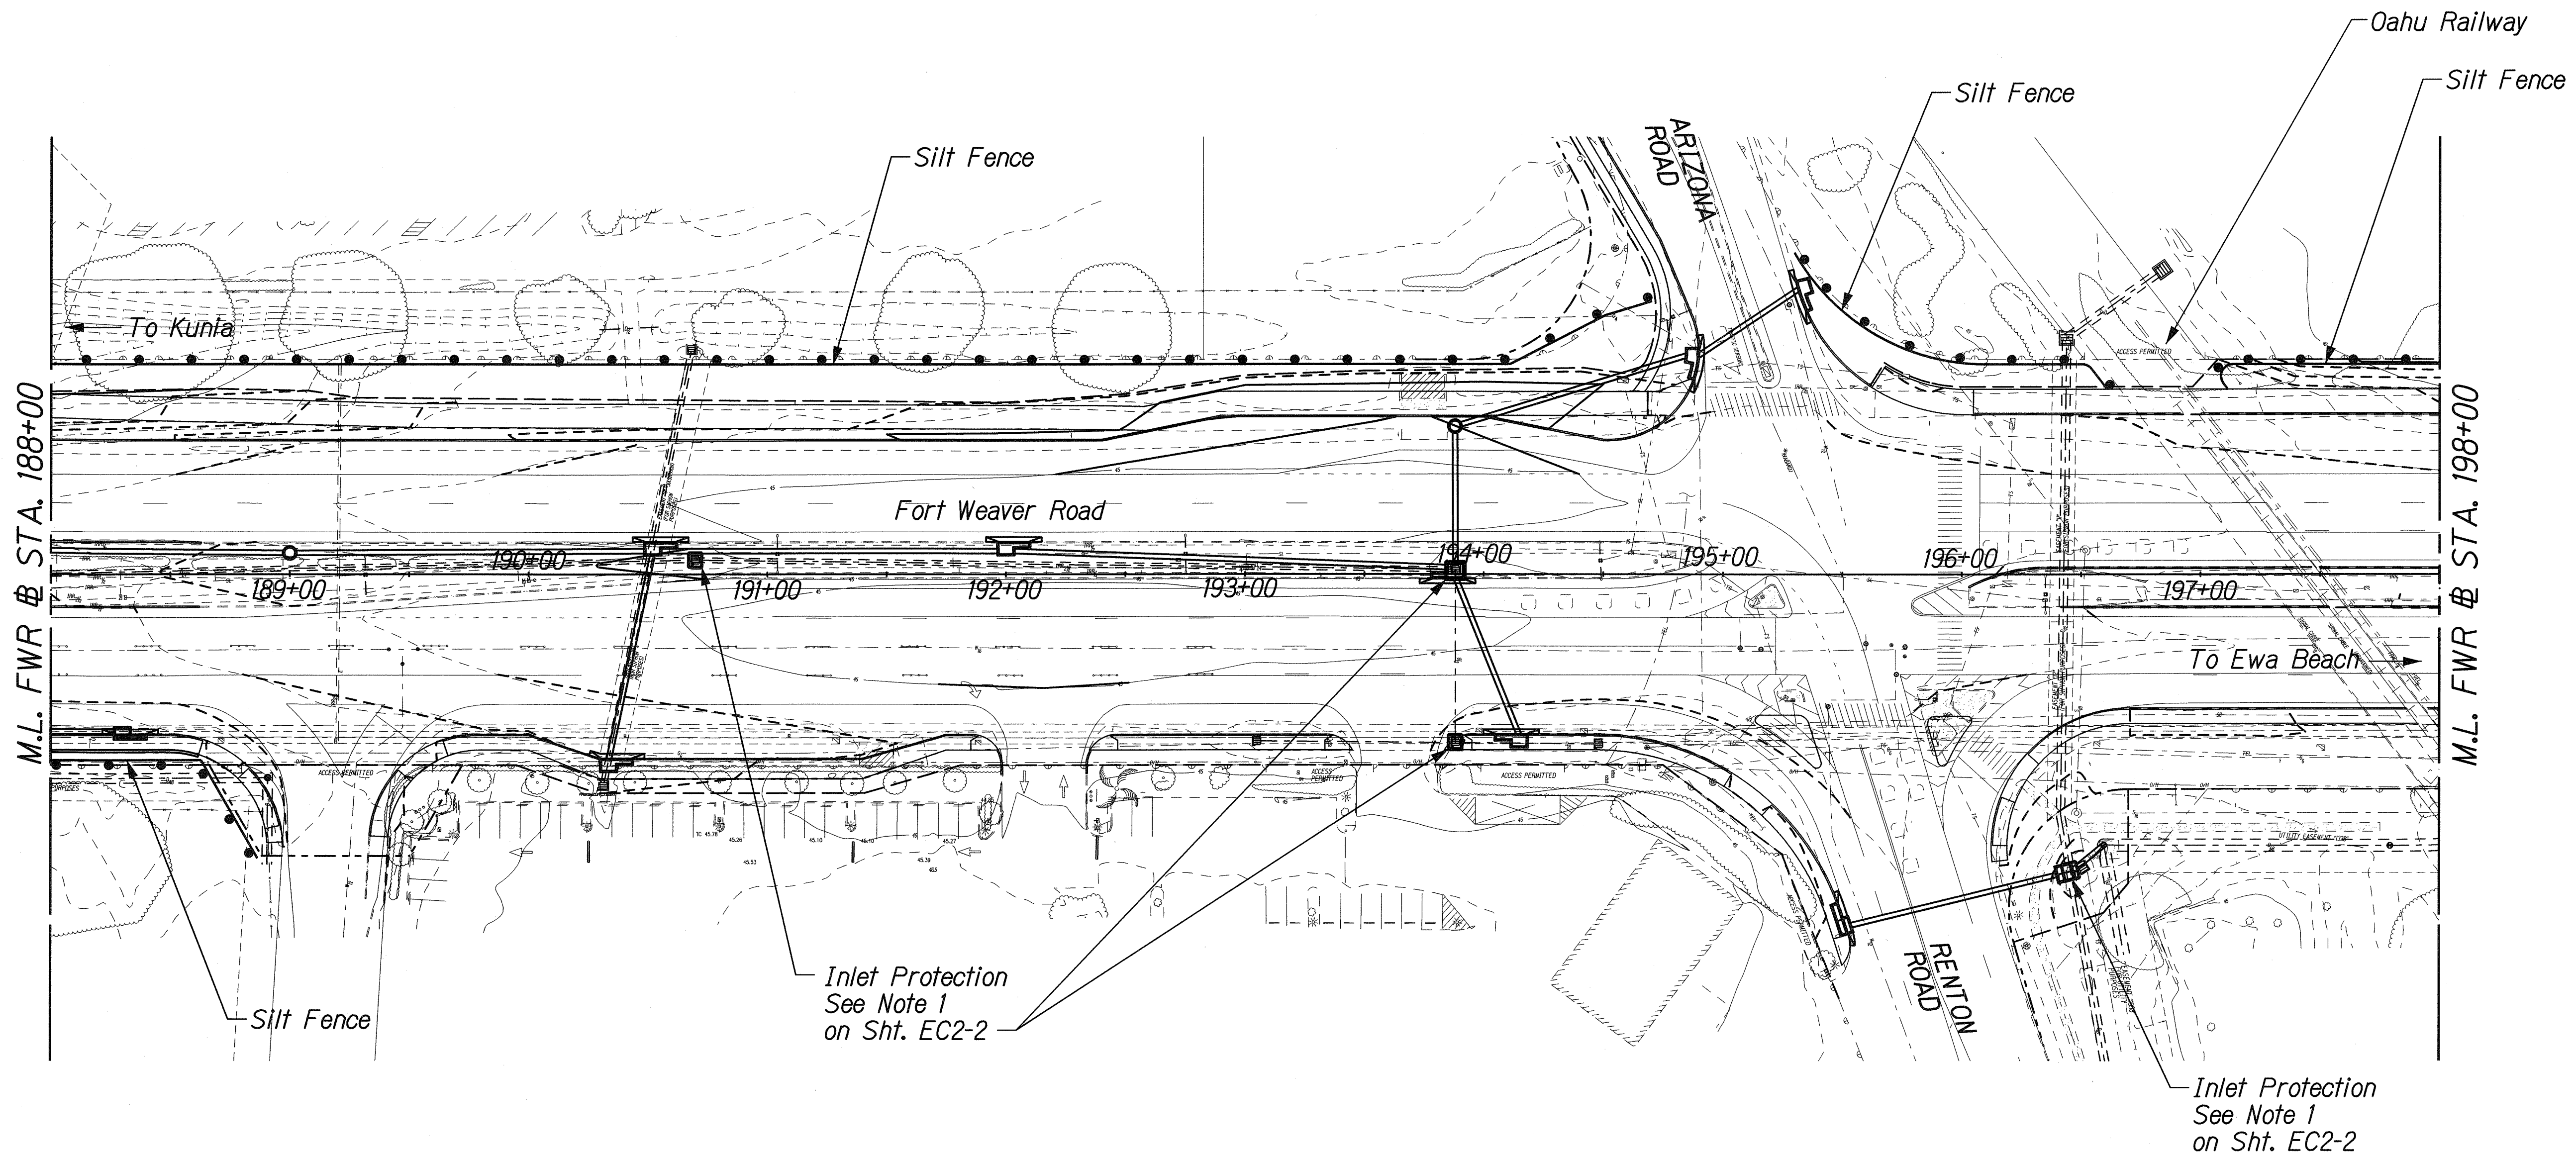

ORIGINAL PLAN	SURVEY PLOTTED BY	DATE
NOTE BOOK	DRAWN BY	
	DESIGNED BY	
	CHECKED BY	

J:\FORT WEAVER ROAD\PACKAGE2\EROSION\EROSTON5.dgn

THIS WORK WAS PREPARED BY ME
OR UNDER MY SUPERVISION.
SIGNATURE: *[Signature]* 04/30/10
EXPIRATION DATE OF THE LICENSE


STATE OF HAWAII
DEPARTMENT OF TRANSPORTATION
HIGHWAYS DIVISION

EROSION CONTROL PLAN
STA. 188+00 TO 198+00

FORT WEAVER ROAD WIDENING
VICINITY OF AAWA DRIVE TO GEIGER ROAD

Scale: 1" = 40' Date: Feb. 22, 2008

FED. ROAD DIST. NO.	STATE	FEDERAL AID PROJ. NO.	FISCAL YEAR	SHEET NO.	TOTAL SHEETS
HAWAII	HAW.	CMAQ-076-1(9)	2006	152	371

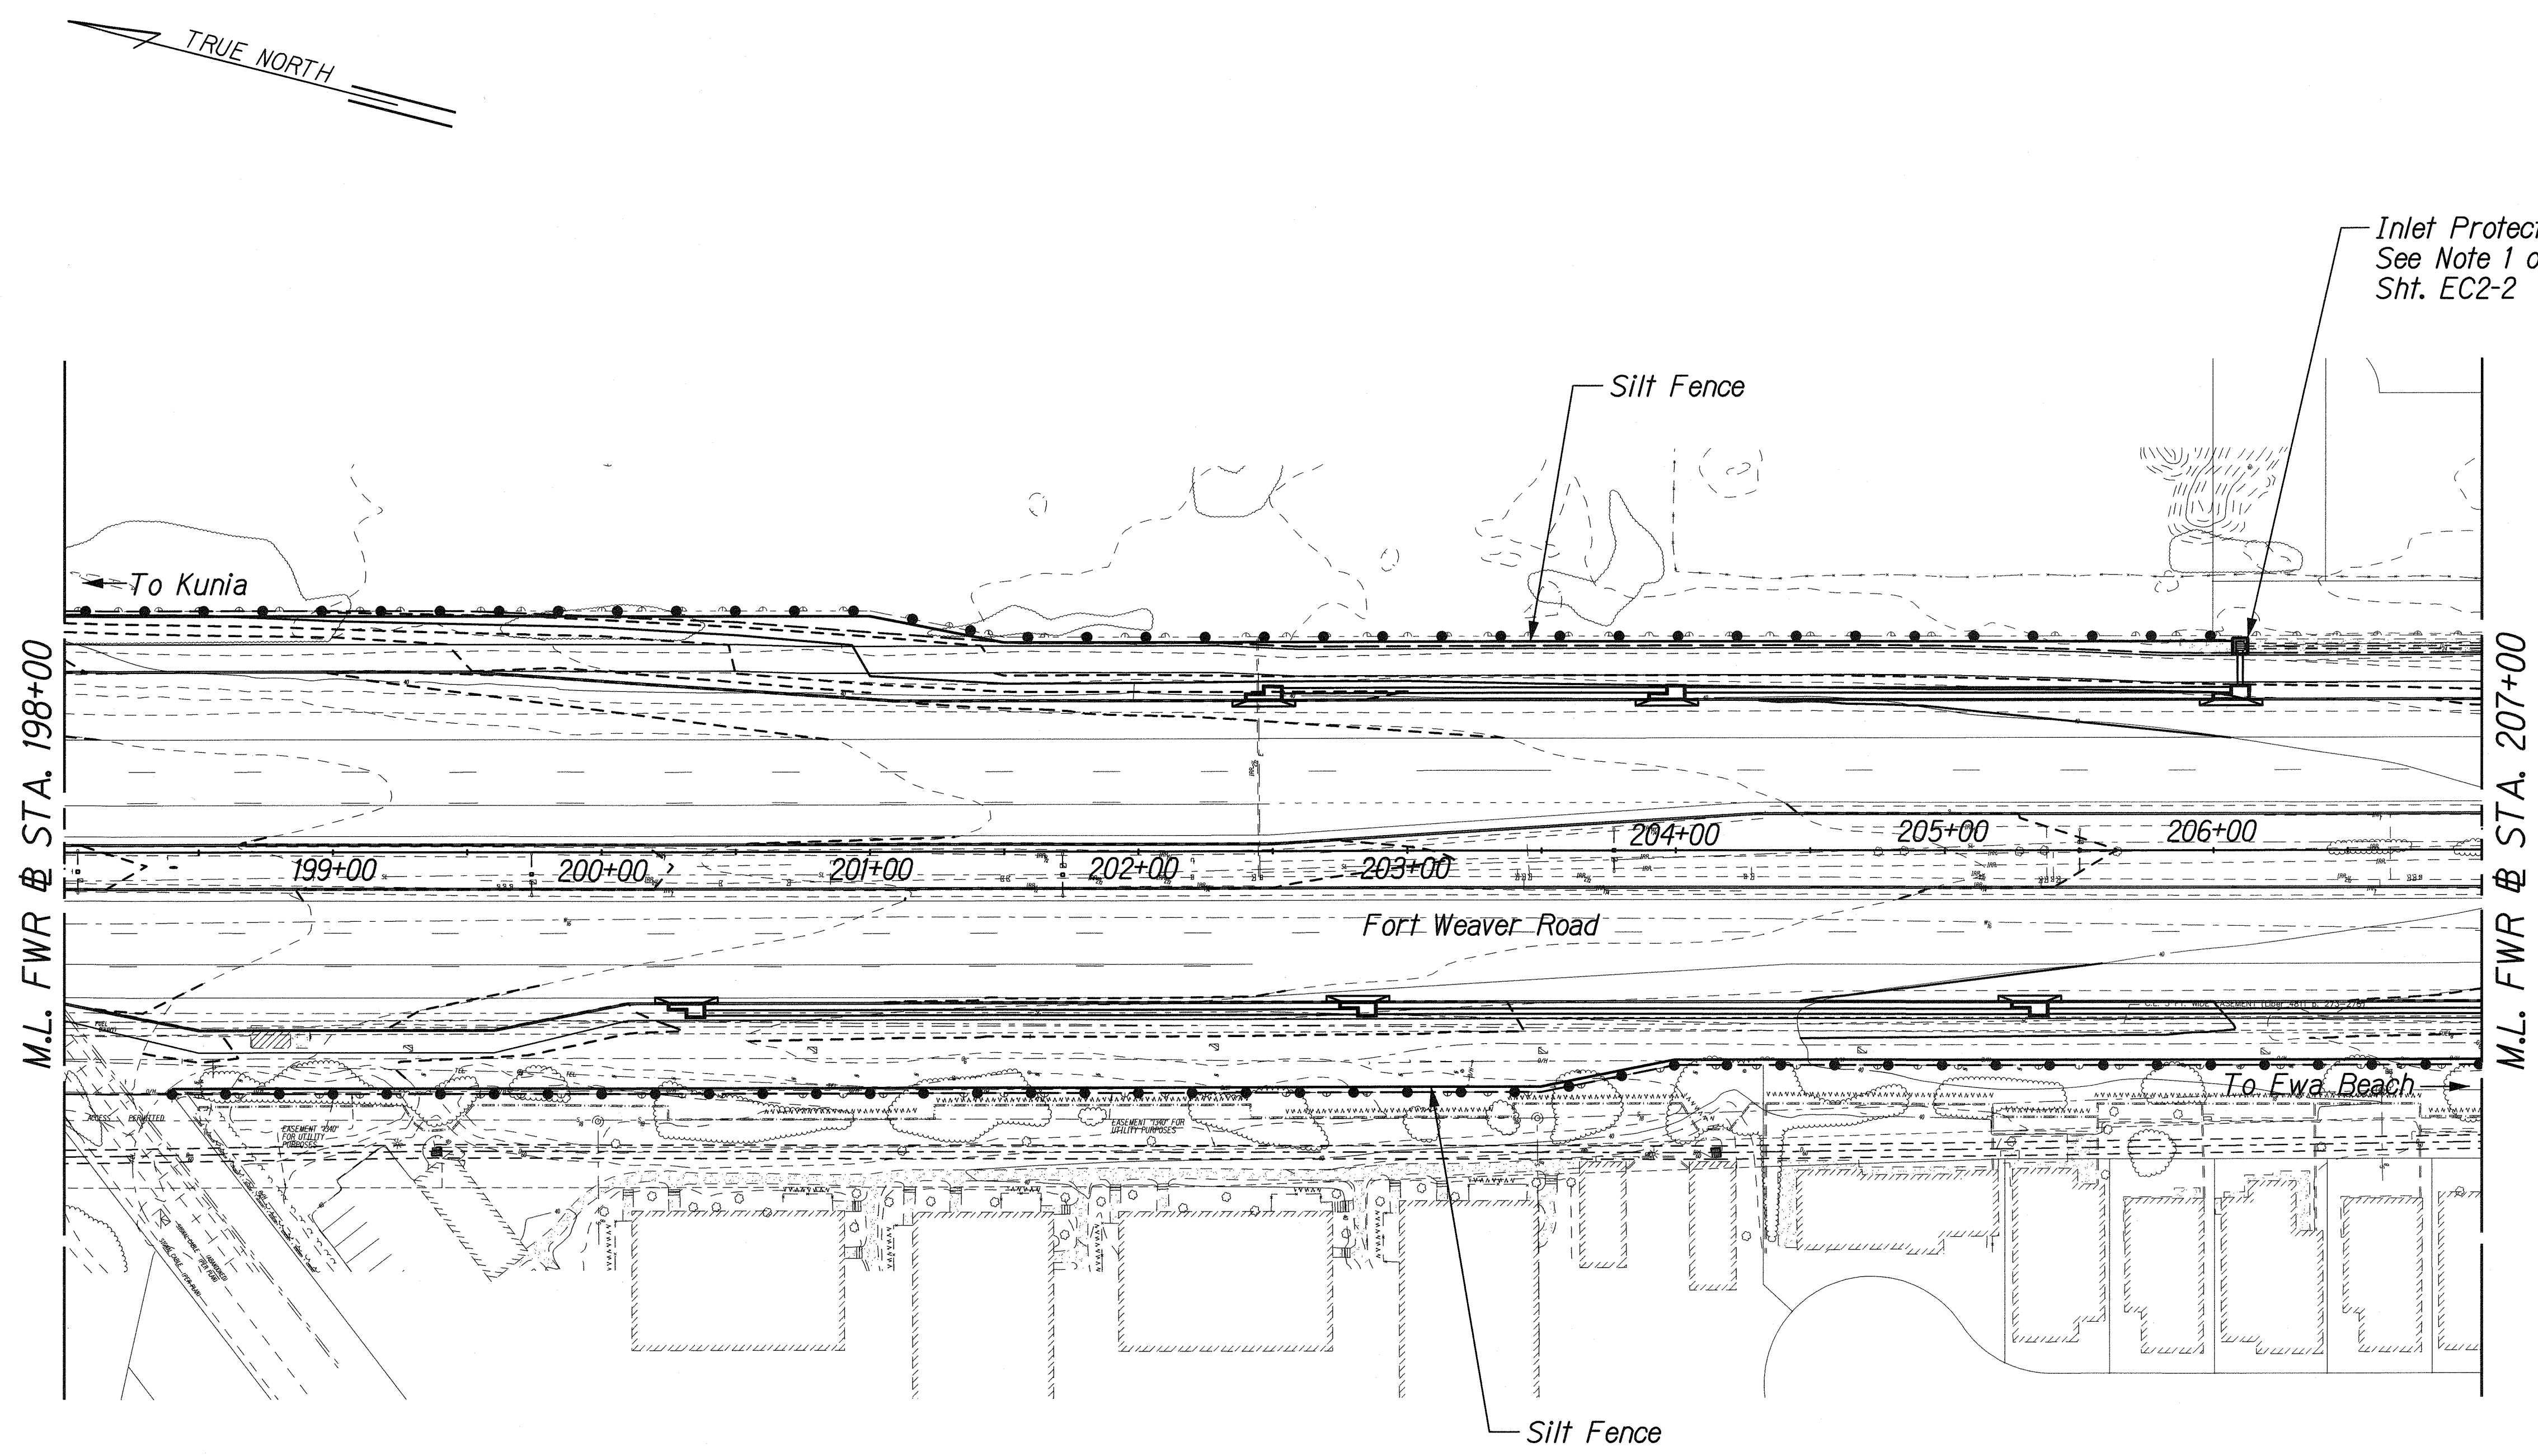

ORIGINAL PLAN	SURVEY PLOTTED BY	DATE
NOTE BOOK	DRAWN BY	
	DESIGNED BY	
	QUANTITIES BY	
	CHECKED BY	

\\FORT WEAVER ROAD\PACKAGE2\EROSTON\EROSTON6.dgn

THIS WORK WAS PREPARED BY ME
OR UNDER MY SUPERVISION.
SIGNATURE *[Signature]* 04/30/10
EXPIRATION DATE
OF THE LICENSE


STATE OF HAWAII
DEPARTMENT OF TRANSPORTATION
HIGHWAYS DIVISION

EROSION CONTROL PLAN
STA. 198+00 TO 207+00

FORT WEAVER ROAD WIDENING
VICINITY OF AAWA DRIVE TO GEIGER ROAD

Scale: 1" = 40' Date: Feb. 22, 2008

FED. ROAD DIST. NO.	STATE	FEDERAL AID PROJ. NO.	FISCAL YEAR	SHEET NO.	TOTAL SHEETS
HAWAII	HAW.	CMAQ-076-1(9)	2006	153	371

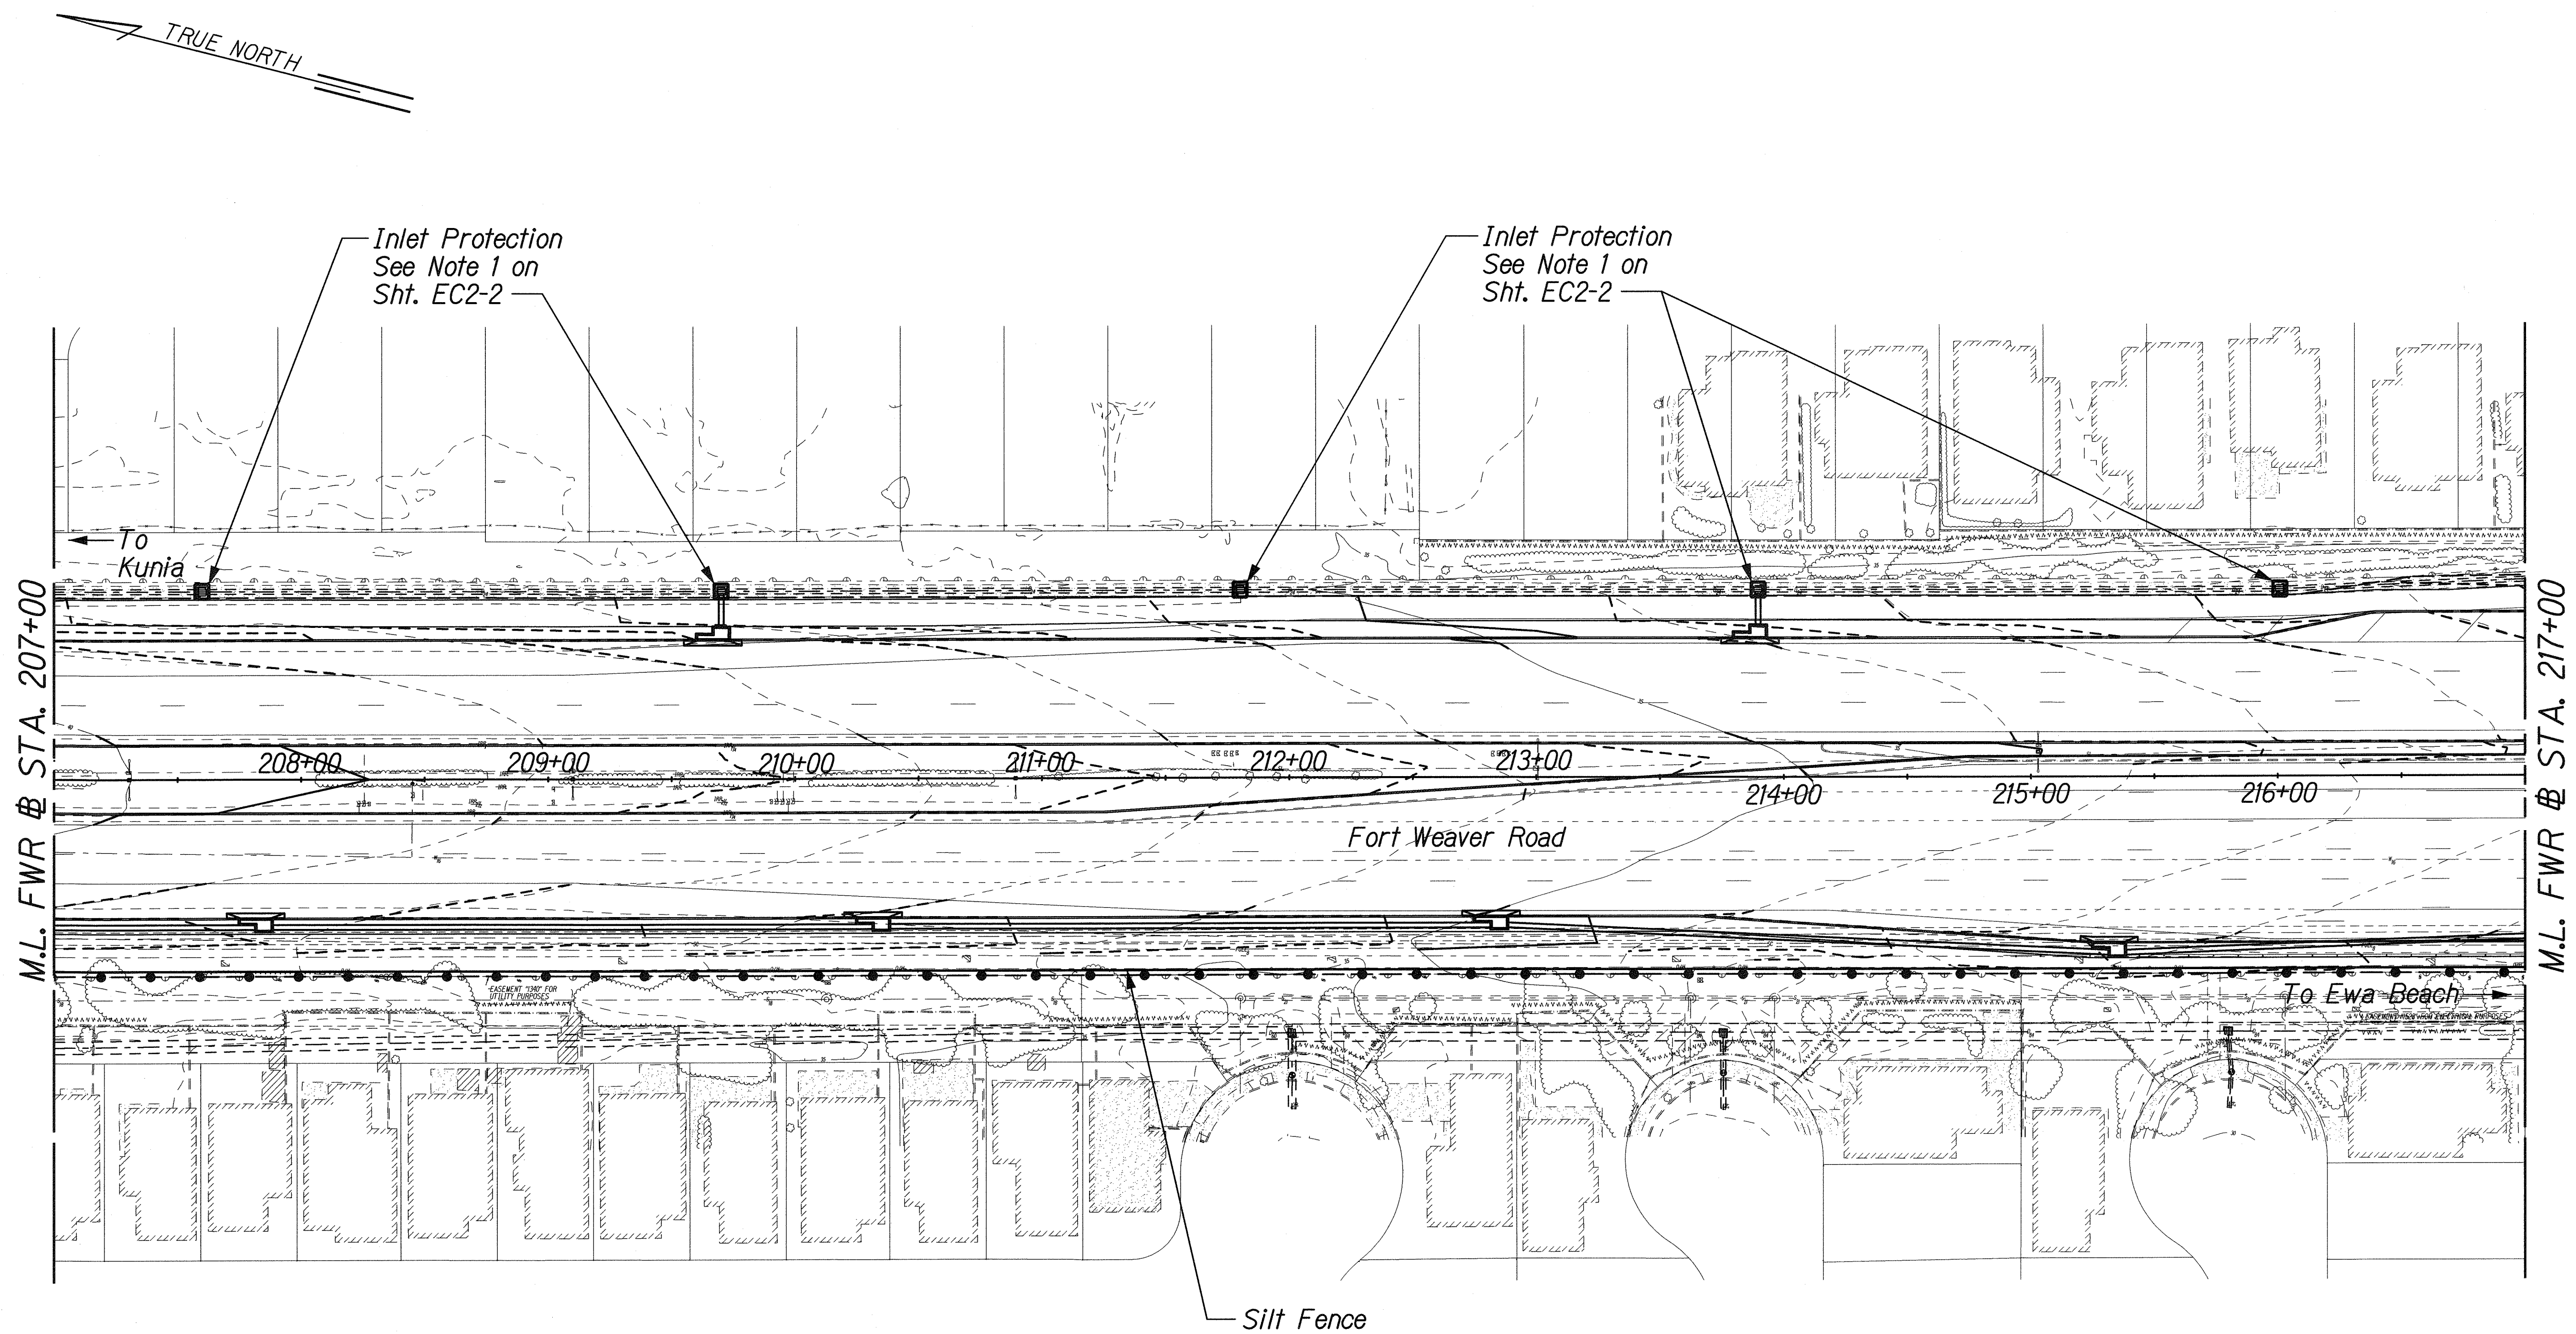

ORIGINAL PLAN	DATE
NOTED BY	DESIGNED BY
CHECKED BY	QUANTITIES BY

\\FORT WEAVER ROAD\PACKAGE2\EROSION\EROSION1.dgn

THIS WORK WAS PREPARED BY ME OR UNDER MY SUPERVISION.
SIGNATURE *R. Urashima* 04/30/10
EXPIRATION DATE OF THE LICENSE

STATE OF HAWAII
DEPARTMENT OF TRANSPORTATION
HIGHWAYS DIVISION



EROSION CONTROL PLAN
STA. 207+00 TO 217+00

FORT WEAVER ROAD WIDENING
VICINITY OF AAWA DRIVE TO GEIGER ROAD

Scale: 1" = 40' Date: Feb. 22, 2008

SHEET No. EC2-9 OF 14 SHEETS

FED. ROAD DIST. NO.	STATE	FEDERAL AID PROJ. NO.	FISCAL YEAR	SHEET NO.	TOTAL SHEETS
HAWAII	HAW.	CMAQ-076-1(9)	2006	154	371

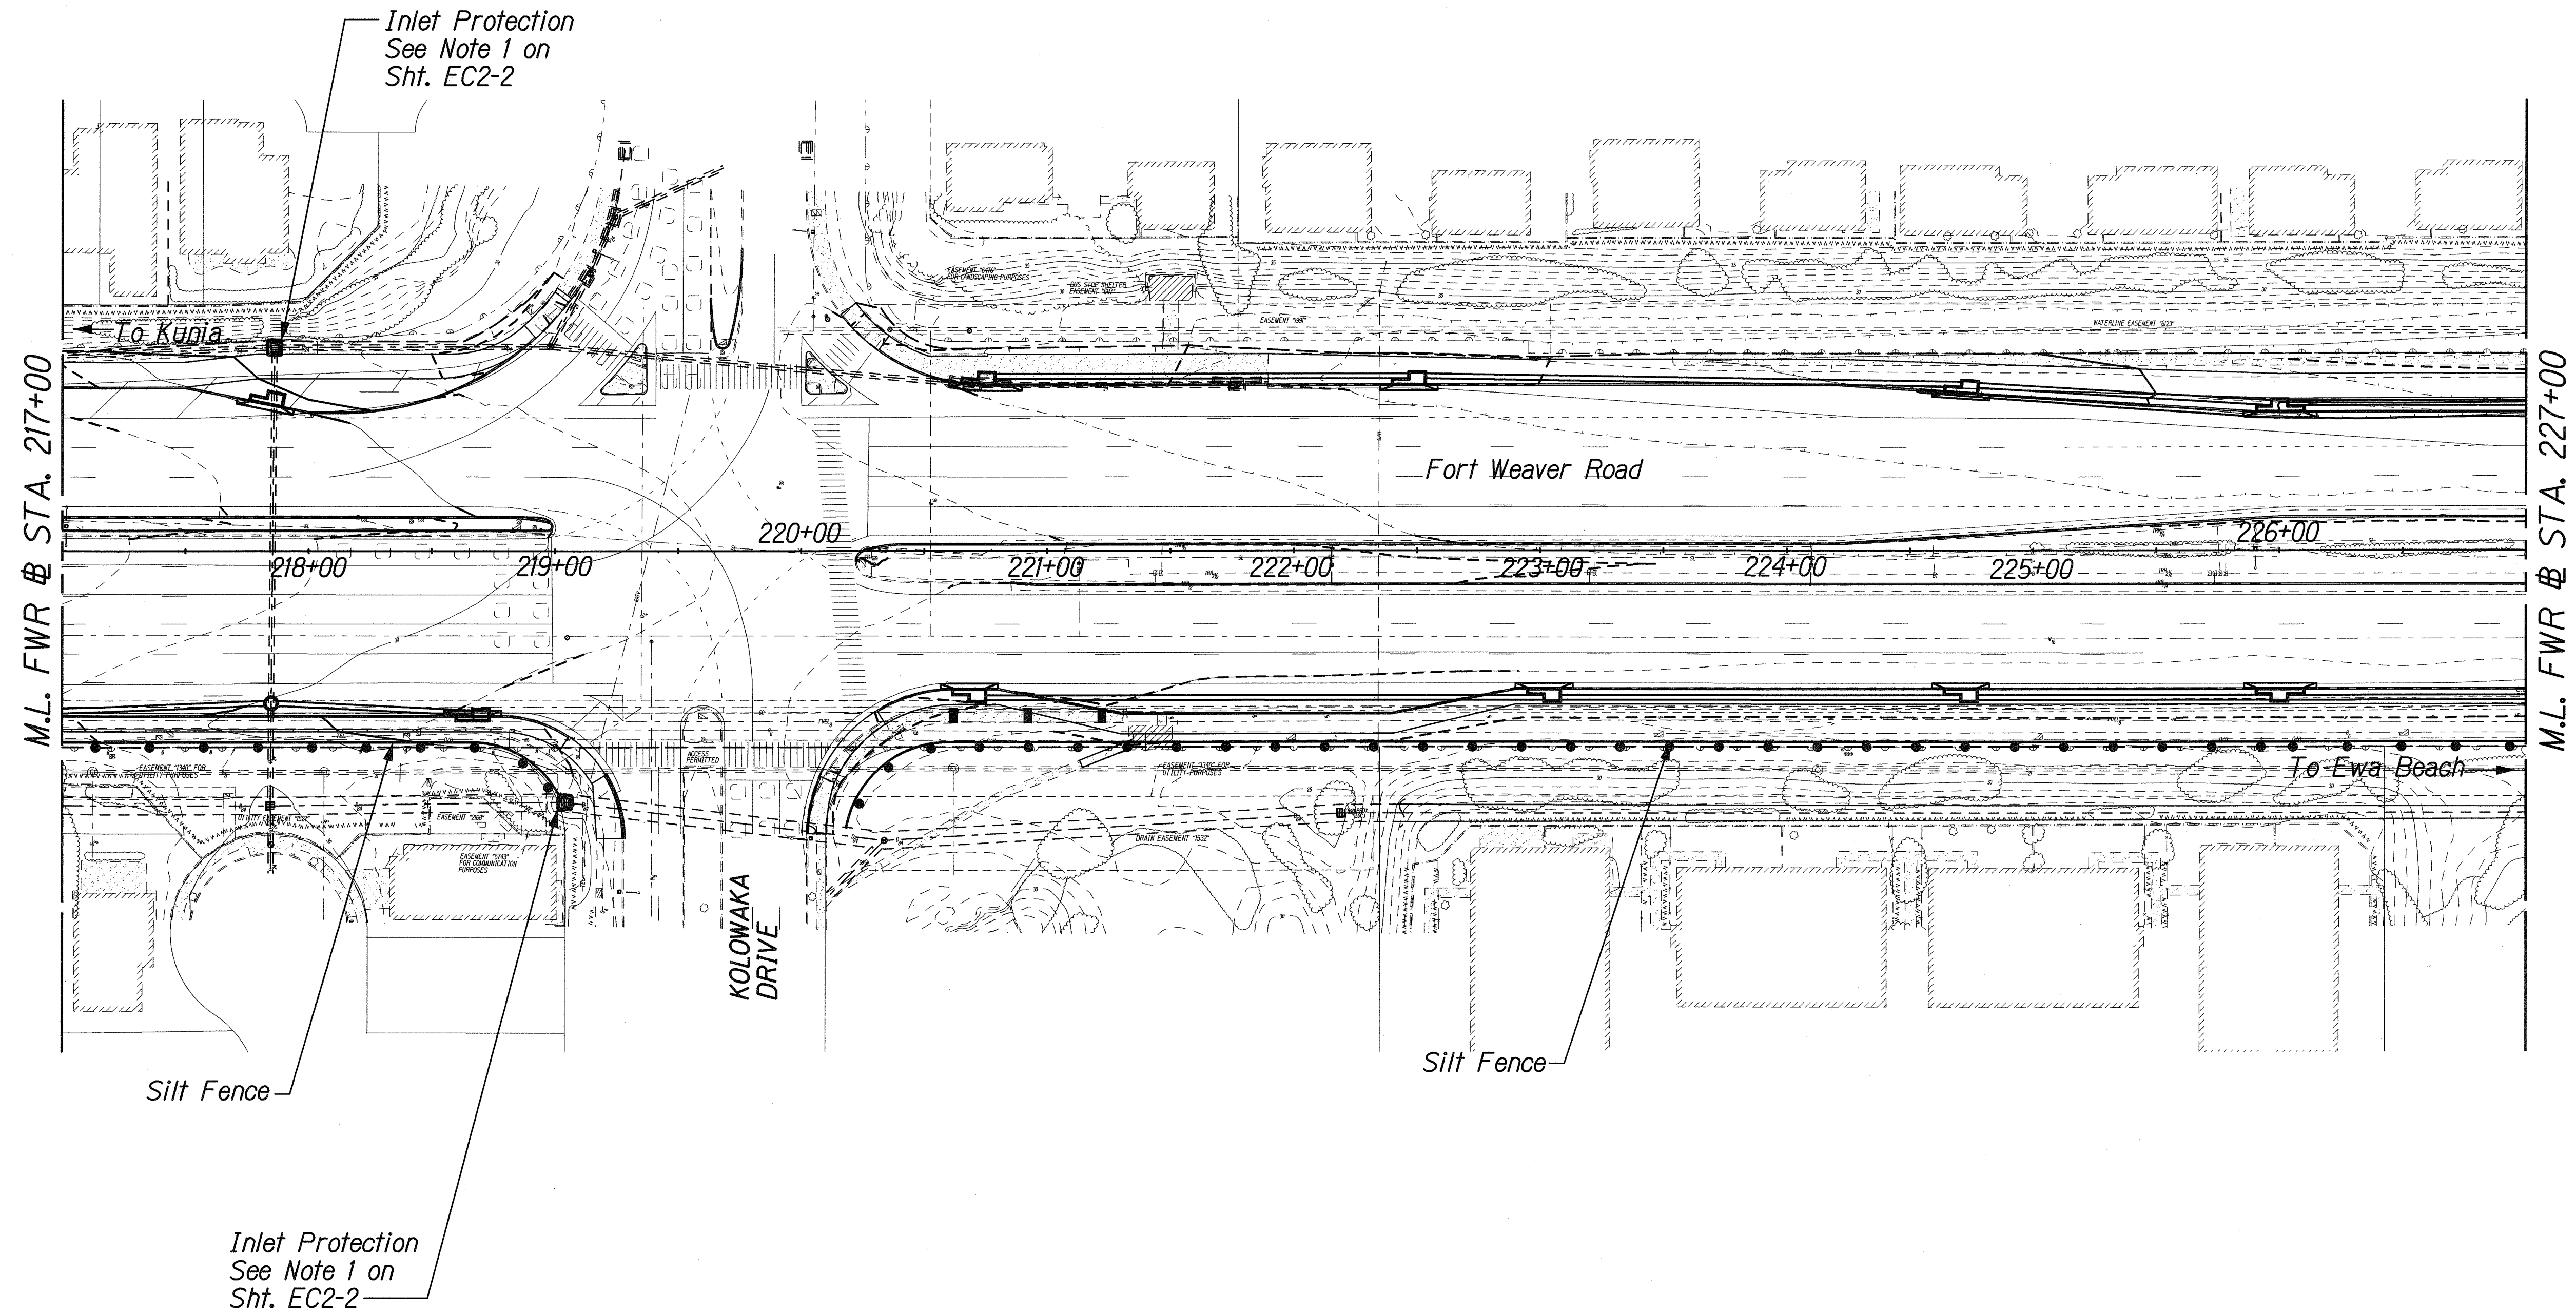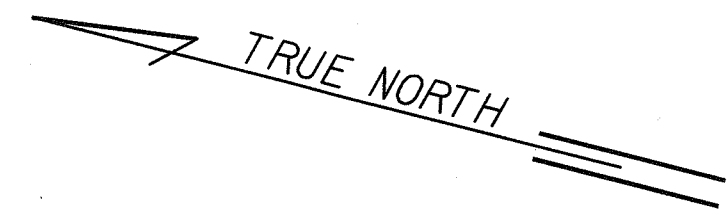

DESIGNED BY	DATE
DRAWN BY	
CHECKED BY	
NOTED BY	
QUANTITIES BY	
IN CHARGE	

J:\FORT WEAVER ROAD\PACKAGE2\EROSION\EROSION.dgn

THIS WORK WAS PREPARED BY ME OR UNDER MY SUPERVISION.

SIGNATURE: *[Signature]* EXPIRATION DATE: 04/30/10



STATE OF HAWAII
DEPARTMENT OF TRANSPORTATION
HIGHWAYS DIVISION

EROSION CONTROL PLAN
STA. 217+00 TO 227+00

FORT WEAVER ROAD WIDENING
VICINITY OF AAWA DRIVE TO GEIGER ROAD


Scale: 1" = 40' Date: Feb. 22, 2008

FED. ROAD DIST. NO.	STATE	FEDERAL AID PROJ. NO.	FISCAL YEAR	SHEET NO.	TOTAL SHEETS
HAWAII	HAW.	CMAQ-076-1(9)	2006	155	371

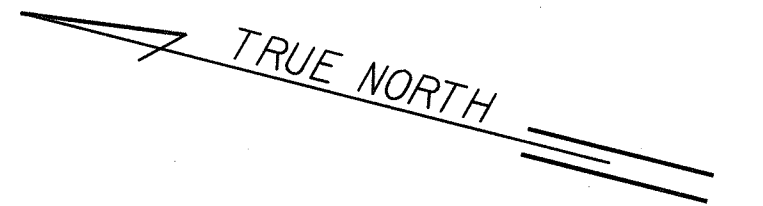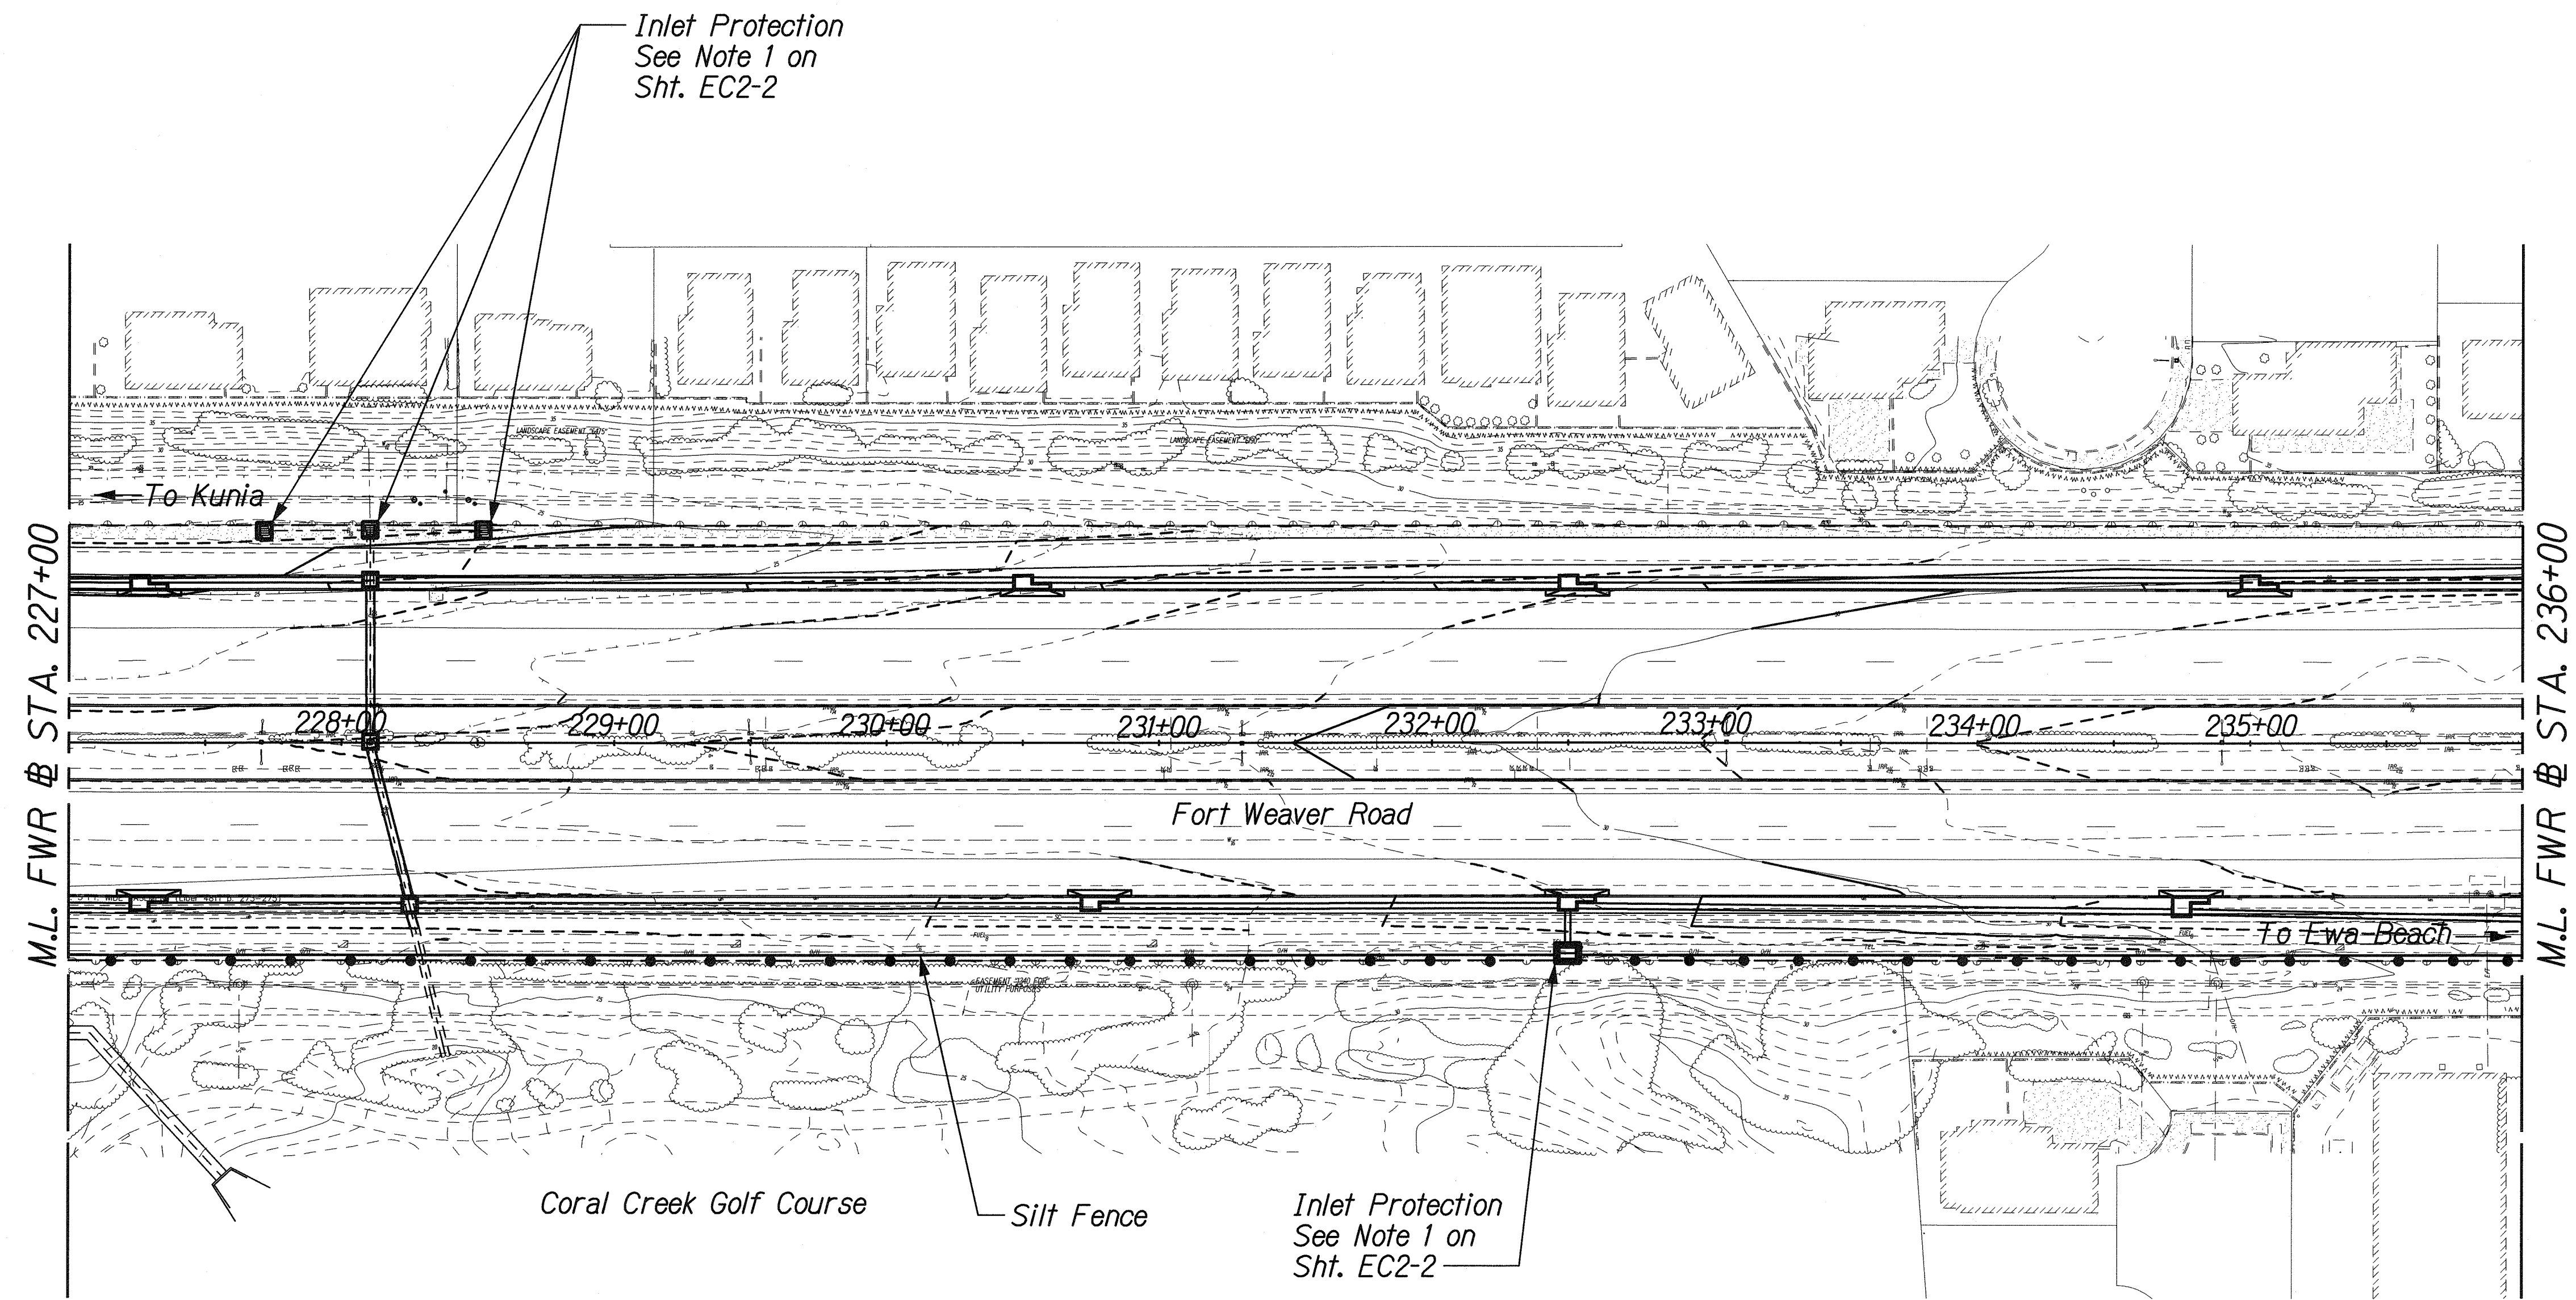

ORIGINAL PLAN	DATE
DESIGNED BY	
TRACED BY	
NOTE BOOK	
QUANTITIES BY	
CHECKED BY	
N.	

\\FORT-WEAVER-ROAD\PACKAGE2\EROSION\EROSION9.dgn



THIS WORK WAS PREPARED BY ME
OR UNDER MY SUPERVISION.

SIGNATURE: *R. M. Uralsky* EXPIRATION DATE: 04/30/10 OF THE LICENSE


STATE OF HAWAII
DEPARTMENT OF TRANSPORTATION
HIGHWAYS DIVISION

EROSION CONTROL PLAN
STA. 227+00 TO 236+00

FORT WEAVER ROAD WIDENING
VICINITY OF AAWA DRIVE TO GEIGER ROAD

Scale: 1" = 40' Date: Feb. 22, 2008

FED. ROAD DIST. NO.	STATE	FEDERAL AID PROJ. NO.	FISCAL YEAR	SHEET NO.	TOTAL SHEETS
HAWAII	HAW.	CMAQ-076-1(9)	2006	156	371

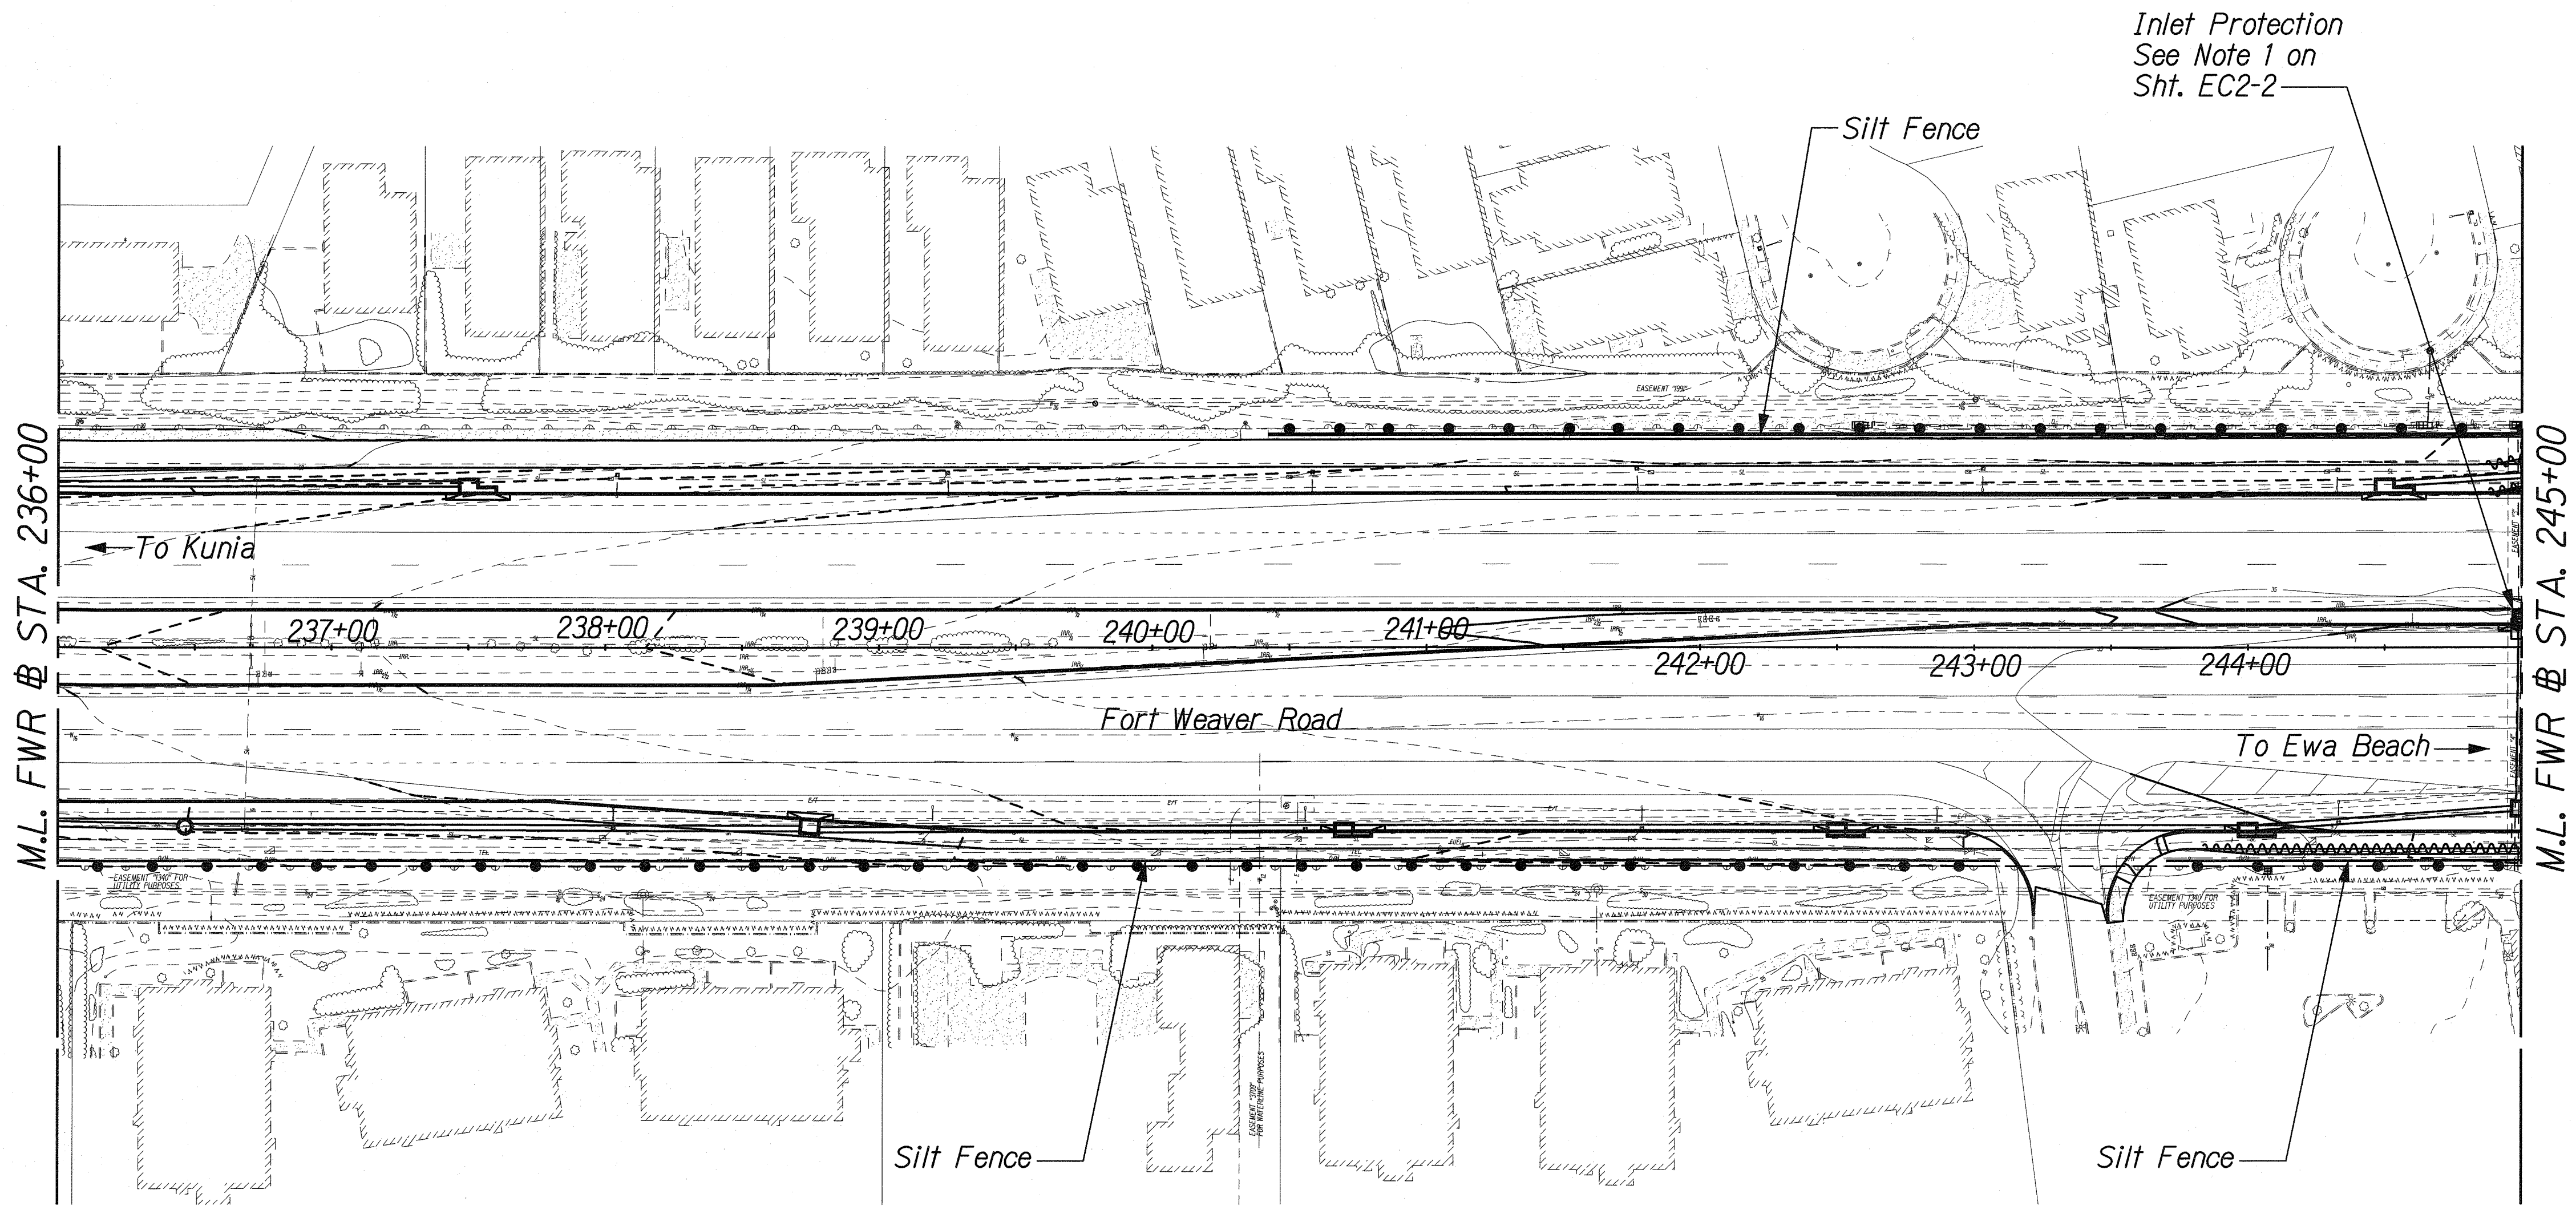

ORIGINAL PLAN	SURVEY PLOTTED BY	DATE
NOTE BOOK	DESIGNED BY	
	CHECKED BY	

L:\FORT WEAVER ROAD\PACKAGE2\EROSION\EROSION1010.dgn

LEGEND FOR AS-BUILT POSTINGS

~~~~~ Squiggly line for as-built deletion

~~100.00~~ Double line for as-built deletion

Roadway Text for as-built posting

THIS WORK WAS PREPARED BY ME OR UNDER MY SUPERVISION.

*R. M. Urasky*

SIGNATURE EXPIRATION DATE OF THE LICENSE 04/30/10

STATE OF HAWAII  
DEPARTMENT OF TRANSPORTATION  
HIGHWAYS DIVISION

**EROSION CONTROL PLAN**  
**STA. 236+00 TO 245+00**


FORT WEAVER ROAD WIDENING  
VICINITY OF AAWA DRIVE TO GEIGER ROAD

Scale: 1" = 40' Date: Feb. 22, 2008

SHEET No. EC2-12 OF 14 SHEETS



| FED. ROAD DIST. NO. | STATE | FEDERAL AID PROJ. NO. | FISCAL YEAR | SHEET NO. | TOTAL SHEETS |
|---------------------|-------|-----------------------|-------------|-----------|--------------|
| HAWAII              | HAW.  | CMAQ-076-1(9)         | 2006        | 157       | 371          |

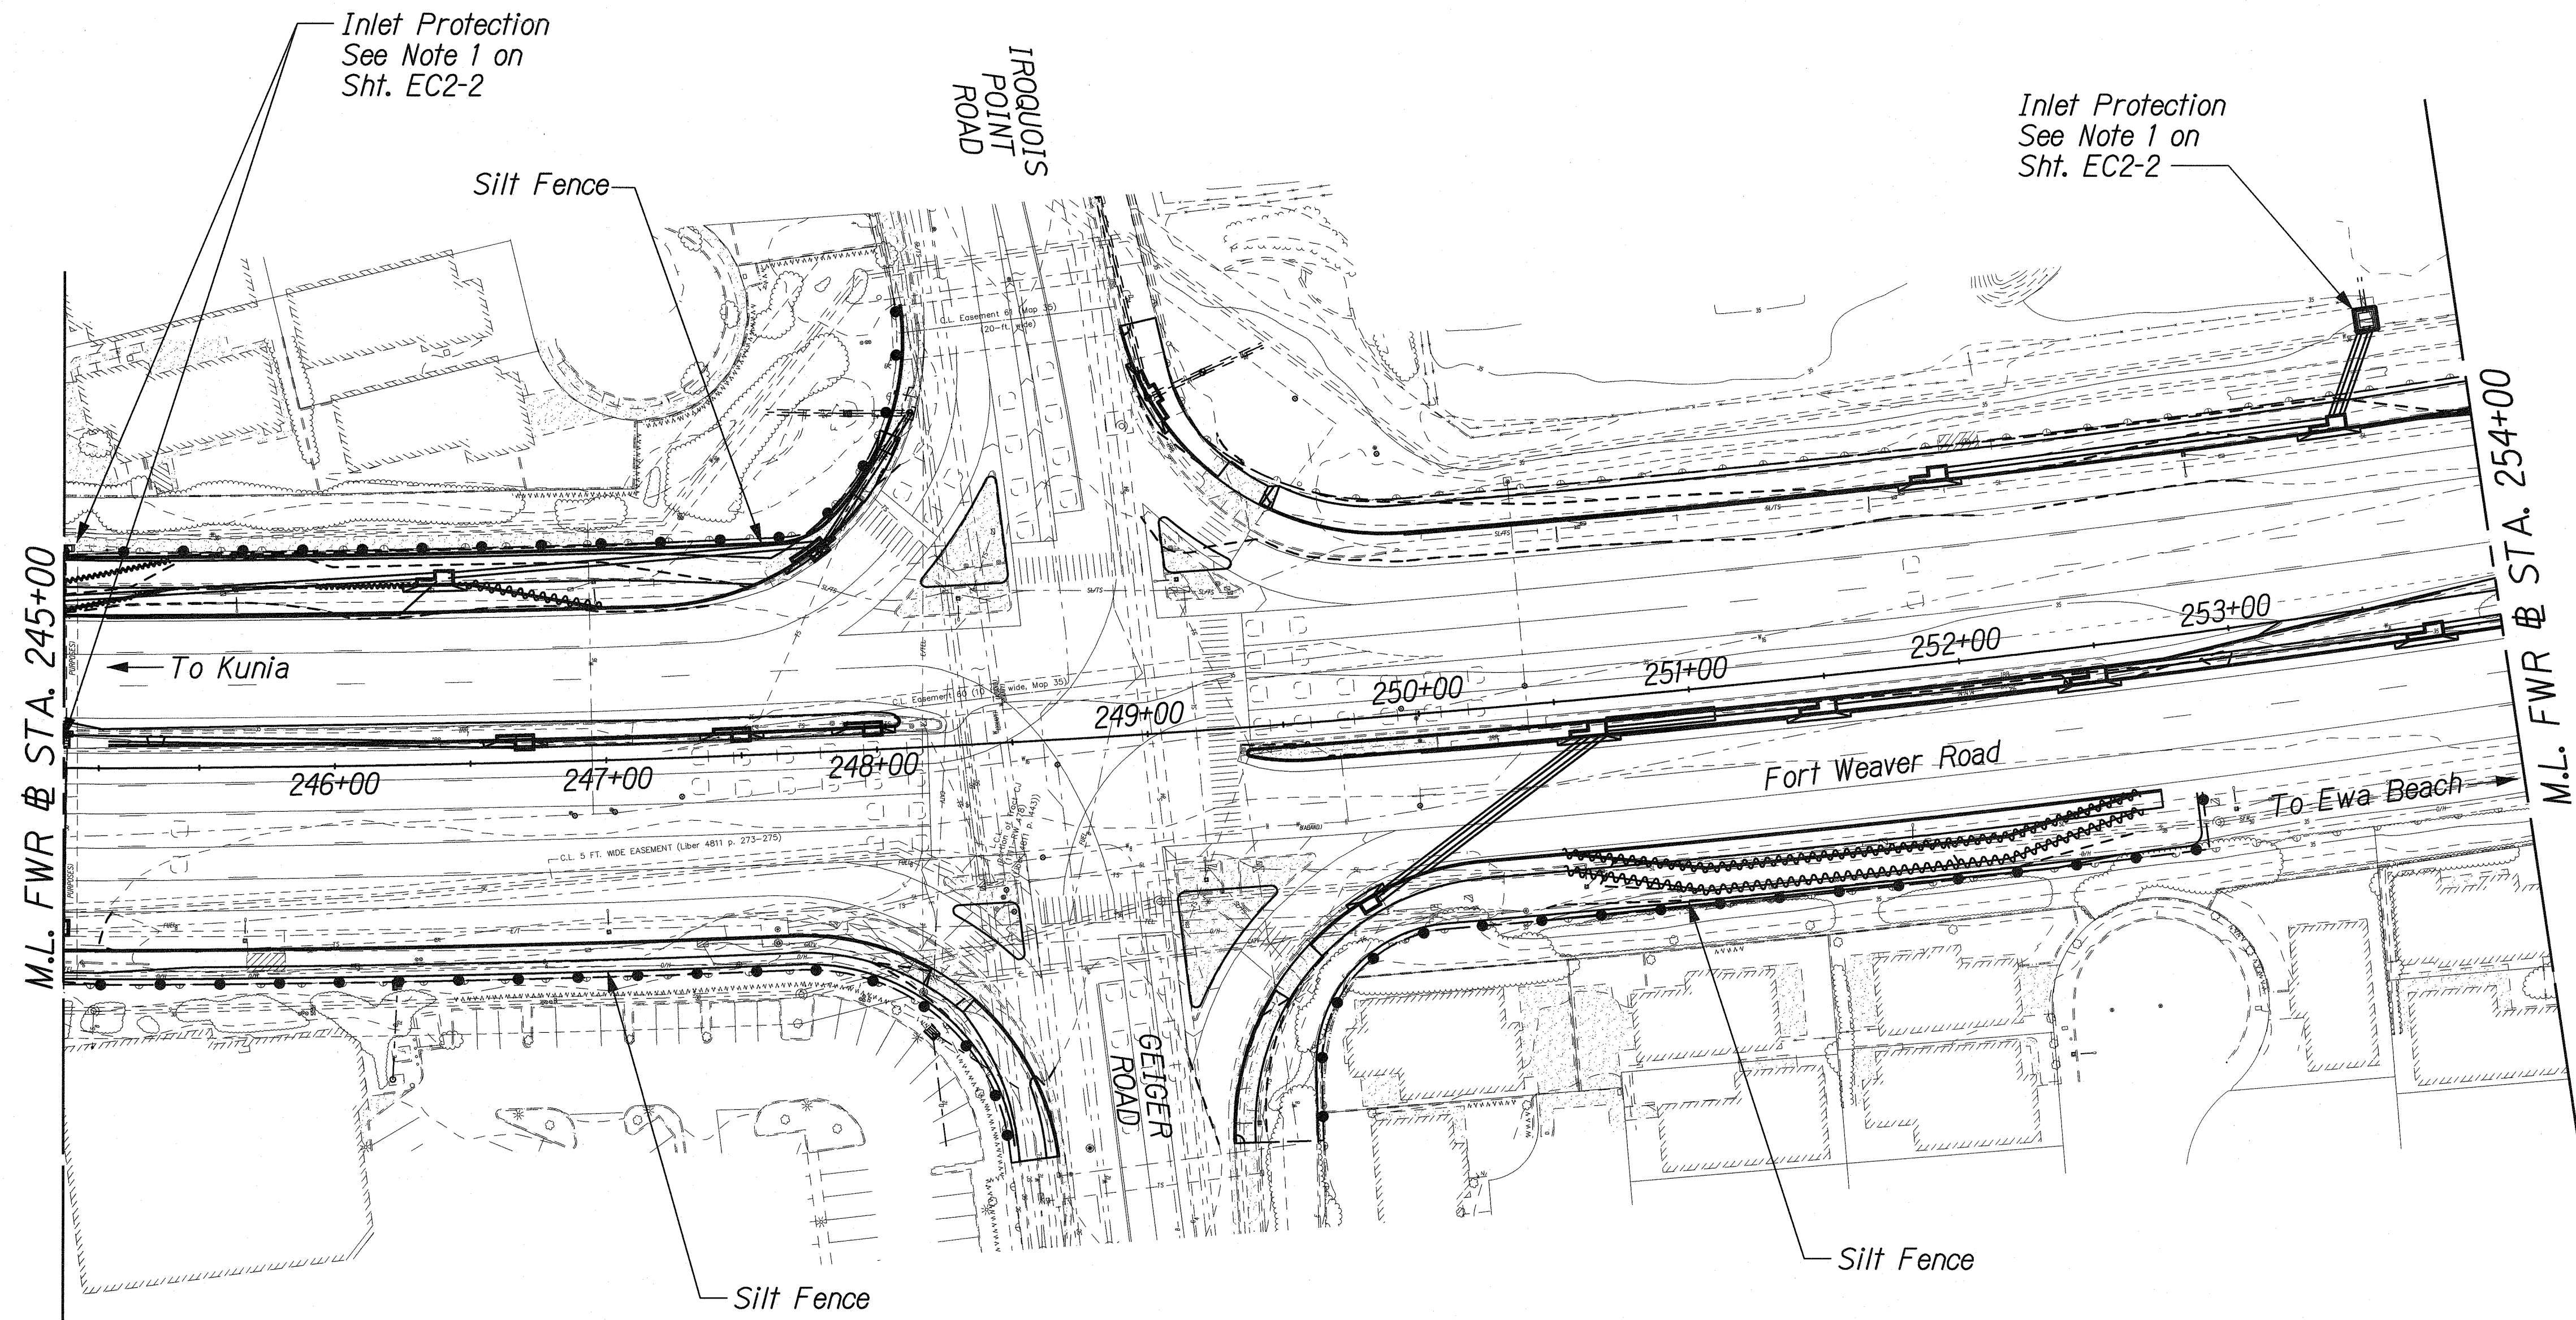

|               |      |
|---------------|------|
| ORIGINAL PLAN | DATE |
| DESIGNED BY   |      |
| TRACED BY     |      |
| NOTE BOOK     |      |
| QUANTITIES BY |      |
| CHECKED BY    |      |

\\FORT-WEAVER-ROAD\PACKAGE2\EROSION\EROSION1.dgn

**LEGEND FOR AS-BUILT POSTINGS**

~~~~~ Squiggly line for as-built deletion

== Double line for as-built deletion

Roadway Text for as-built posting

THIS WORK WAS PREPARED BY ME AND UNDER MY SUPERVISION.

SIGNATURE: *R. Urasky* EXPIRATION DATE: 04/30/10 OF THE LICENSE

STATE OF HAWAII
DEPARTMENT OF TRANSPORTATION
HIGHWAYS DIVISION



EROSION CONTROL PLAN
STA. 245+00 TO 254+00

FORT WEAVER ROAD WIDENING
VICINITY OF AAWA DRIVE TO GEIGER ROAD

Scale: 1" = 40' Date: Feb. 22, 2008

SHEET No. EC2-13 OF 14 SHEETS

| FED. ROAD DIST. NO. | STATE | FEDERAL AID PROJ. NO. | FISCAL YEAR | SHEET NO. | TOTAL SHEETS |
|---------------------|-------|-----------------------|-------------|-----------|--------------|
| HAWAII | HAW. | CMAQ-076-1(9) | 2006 | 158 | 371 |

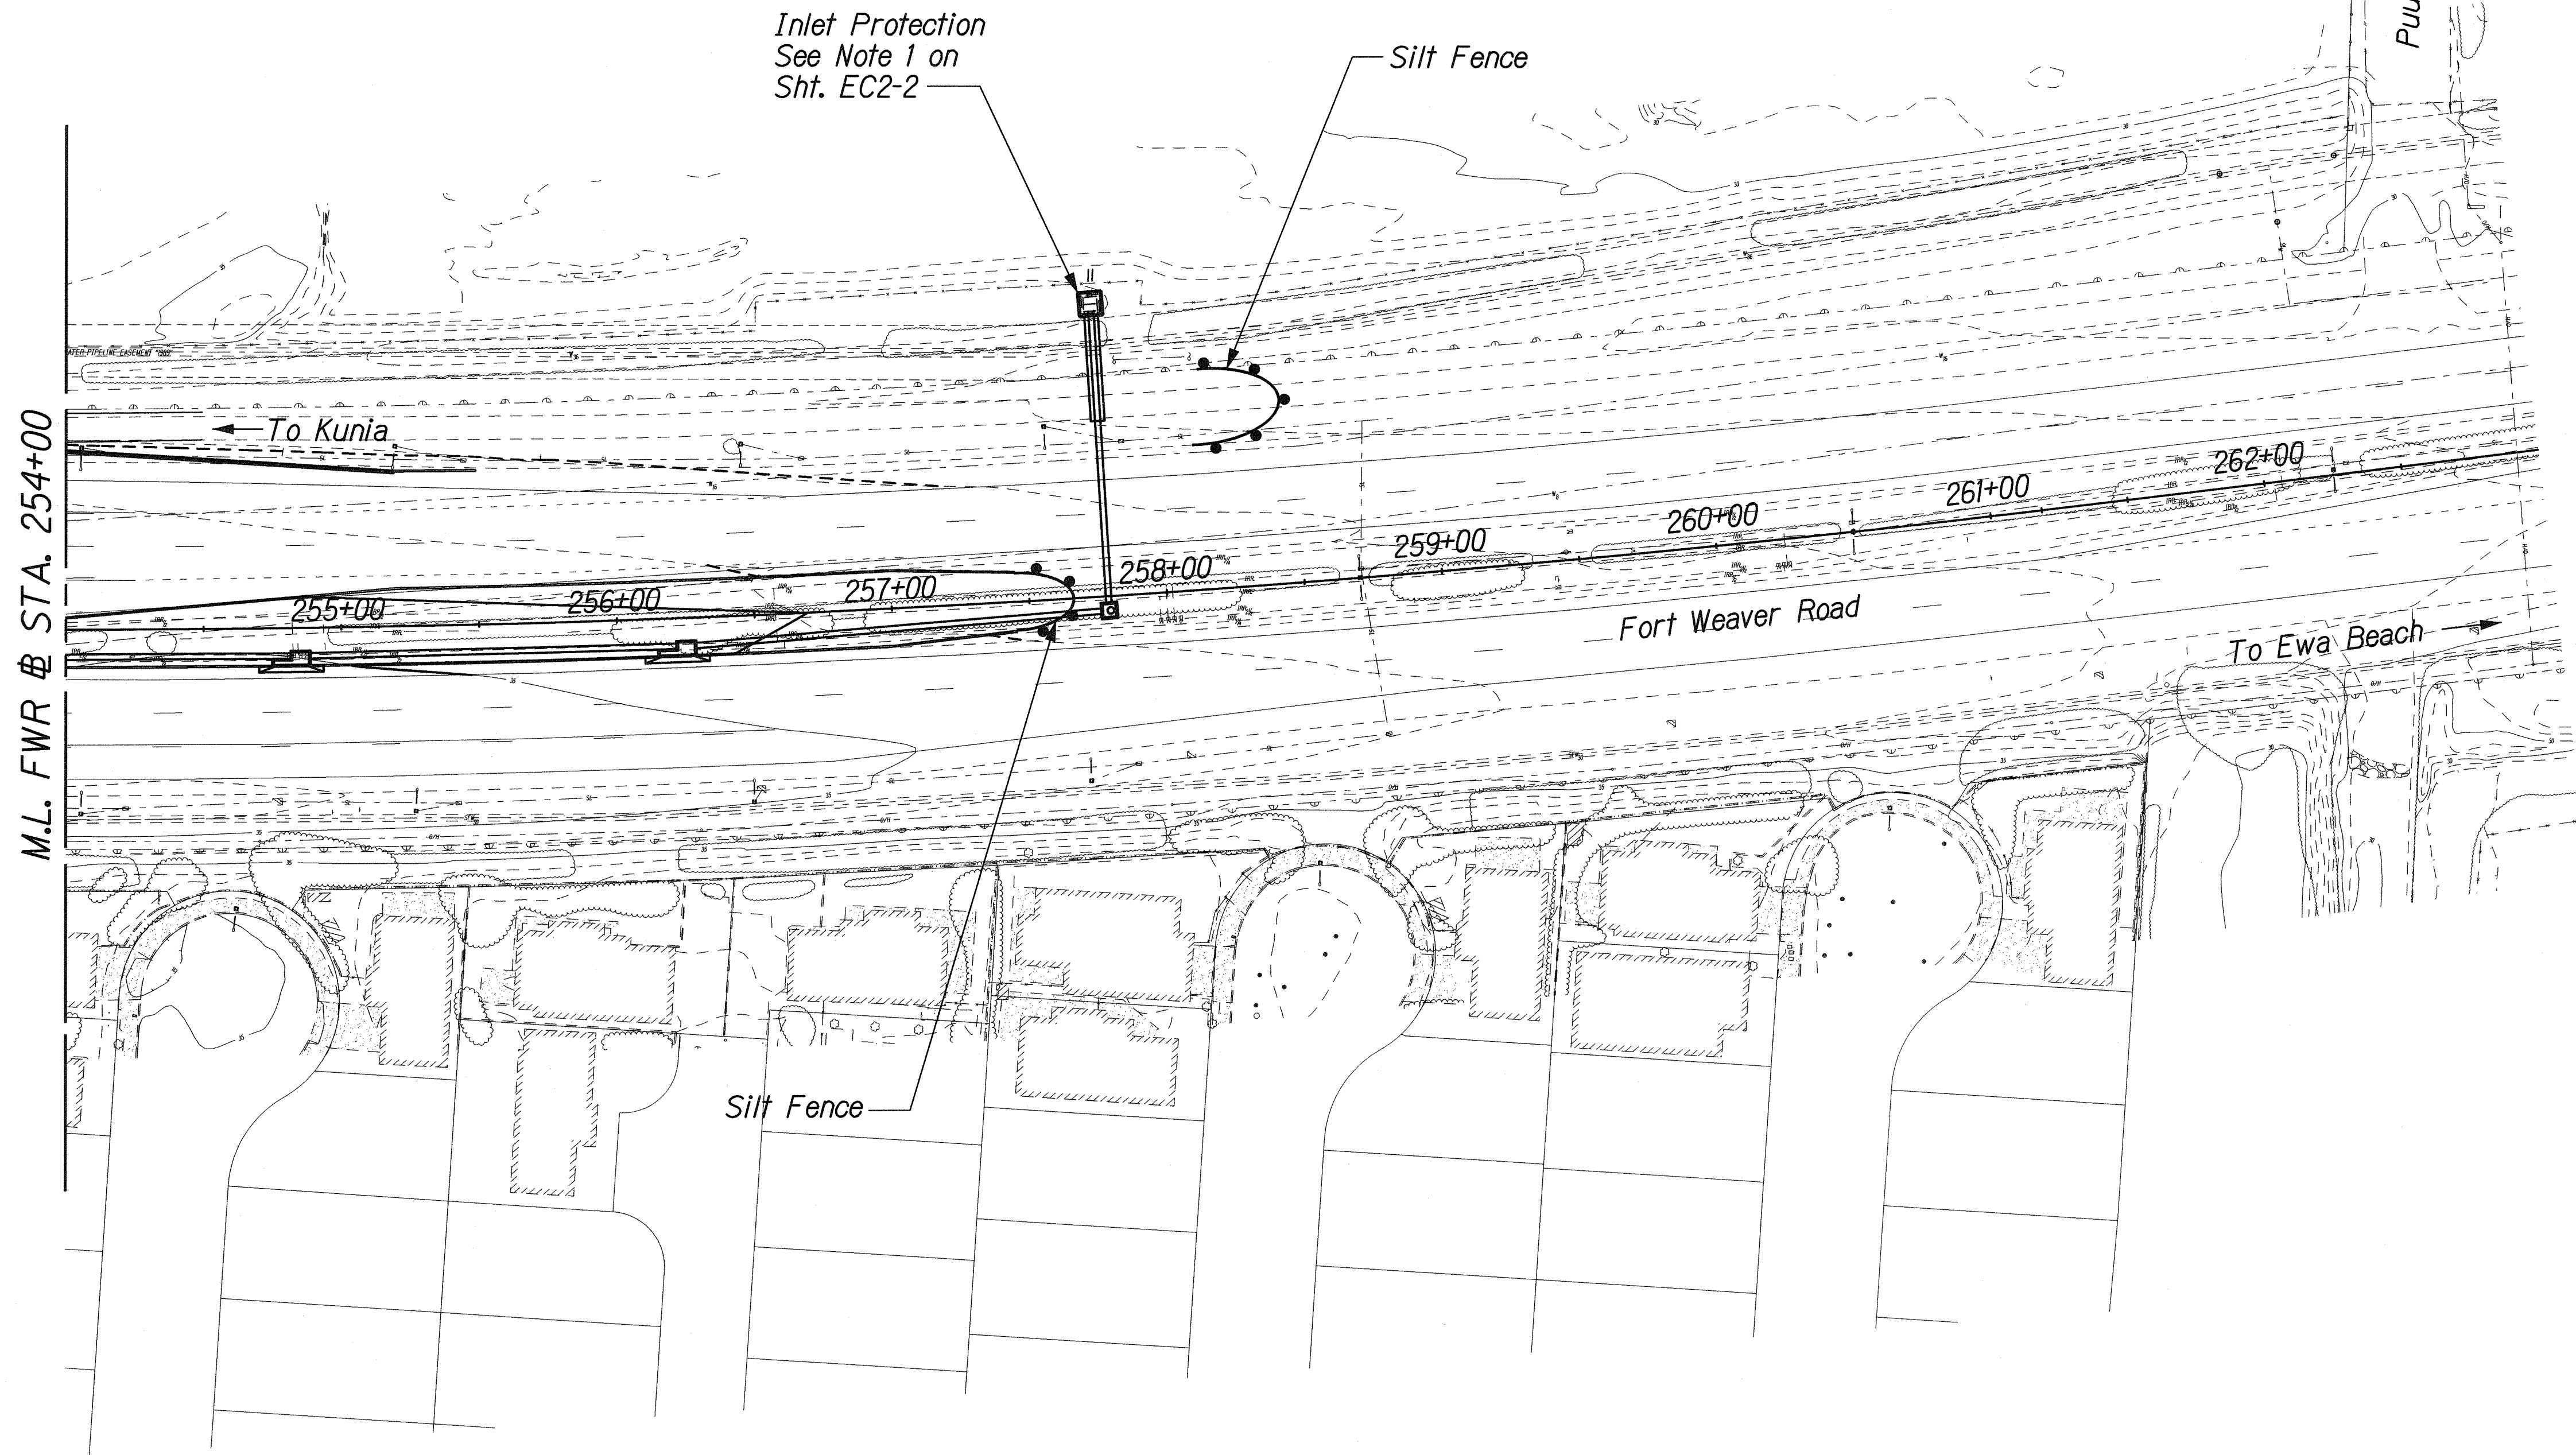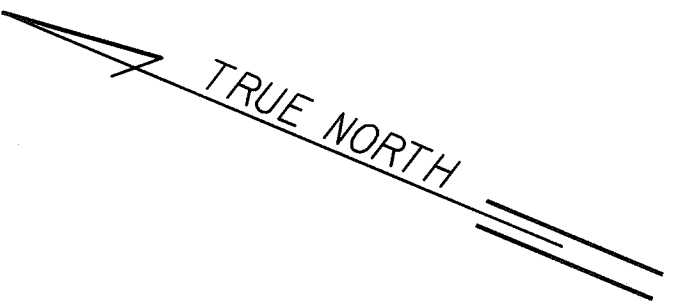

M.L. FWR @ STA. 254+00

| | |
|-------------|------|
| DESIGNED BY | DATE |
| TRACED BY | |
| NOTED BY | |
| CHECKED BY | |

\\FORT-WEAVER-ROAD\PACKAGE2\EROSION\EROSION12.dgn

THIS WORK WAS PREPARED BY ME
OR UNDER MY SUPERVISION.
SIGNATURE: *Rumla* EXPIRATION DATE OF THE LICENSE: 04/30/10

STATE OF HAWAII
DEPARTMENT OF TRANSPORTATION
HIGHWAYS DIVISION

EROSION CONTROL PLAN
STA. 254+00 TO 263+00

FORT WEAVER ROAD WIDENING
VICINITY OF AAWA DRIVE TO GEIGER ROAD

Scale: 1" = 40' Date: Feb. 22, 2008