


FED. ROAD DIST. NO.	STATE	FEDERAL AID PROJ. NO.	FISCAL YEAR	SHEET NO.	TOTAL SHEETS
HAWAII	HAW.	CMAQ-076-1(9)	2006	78	371

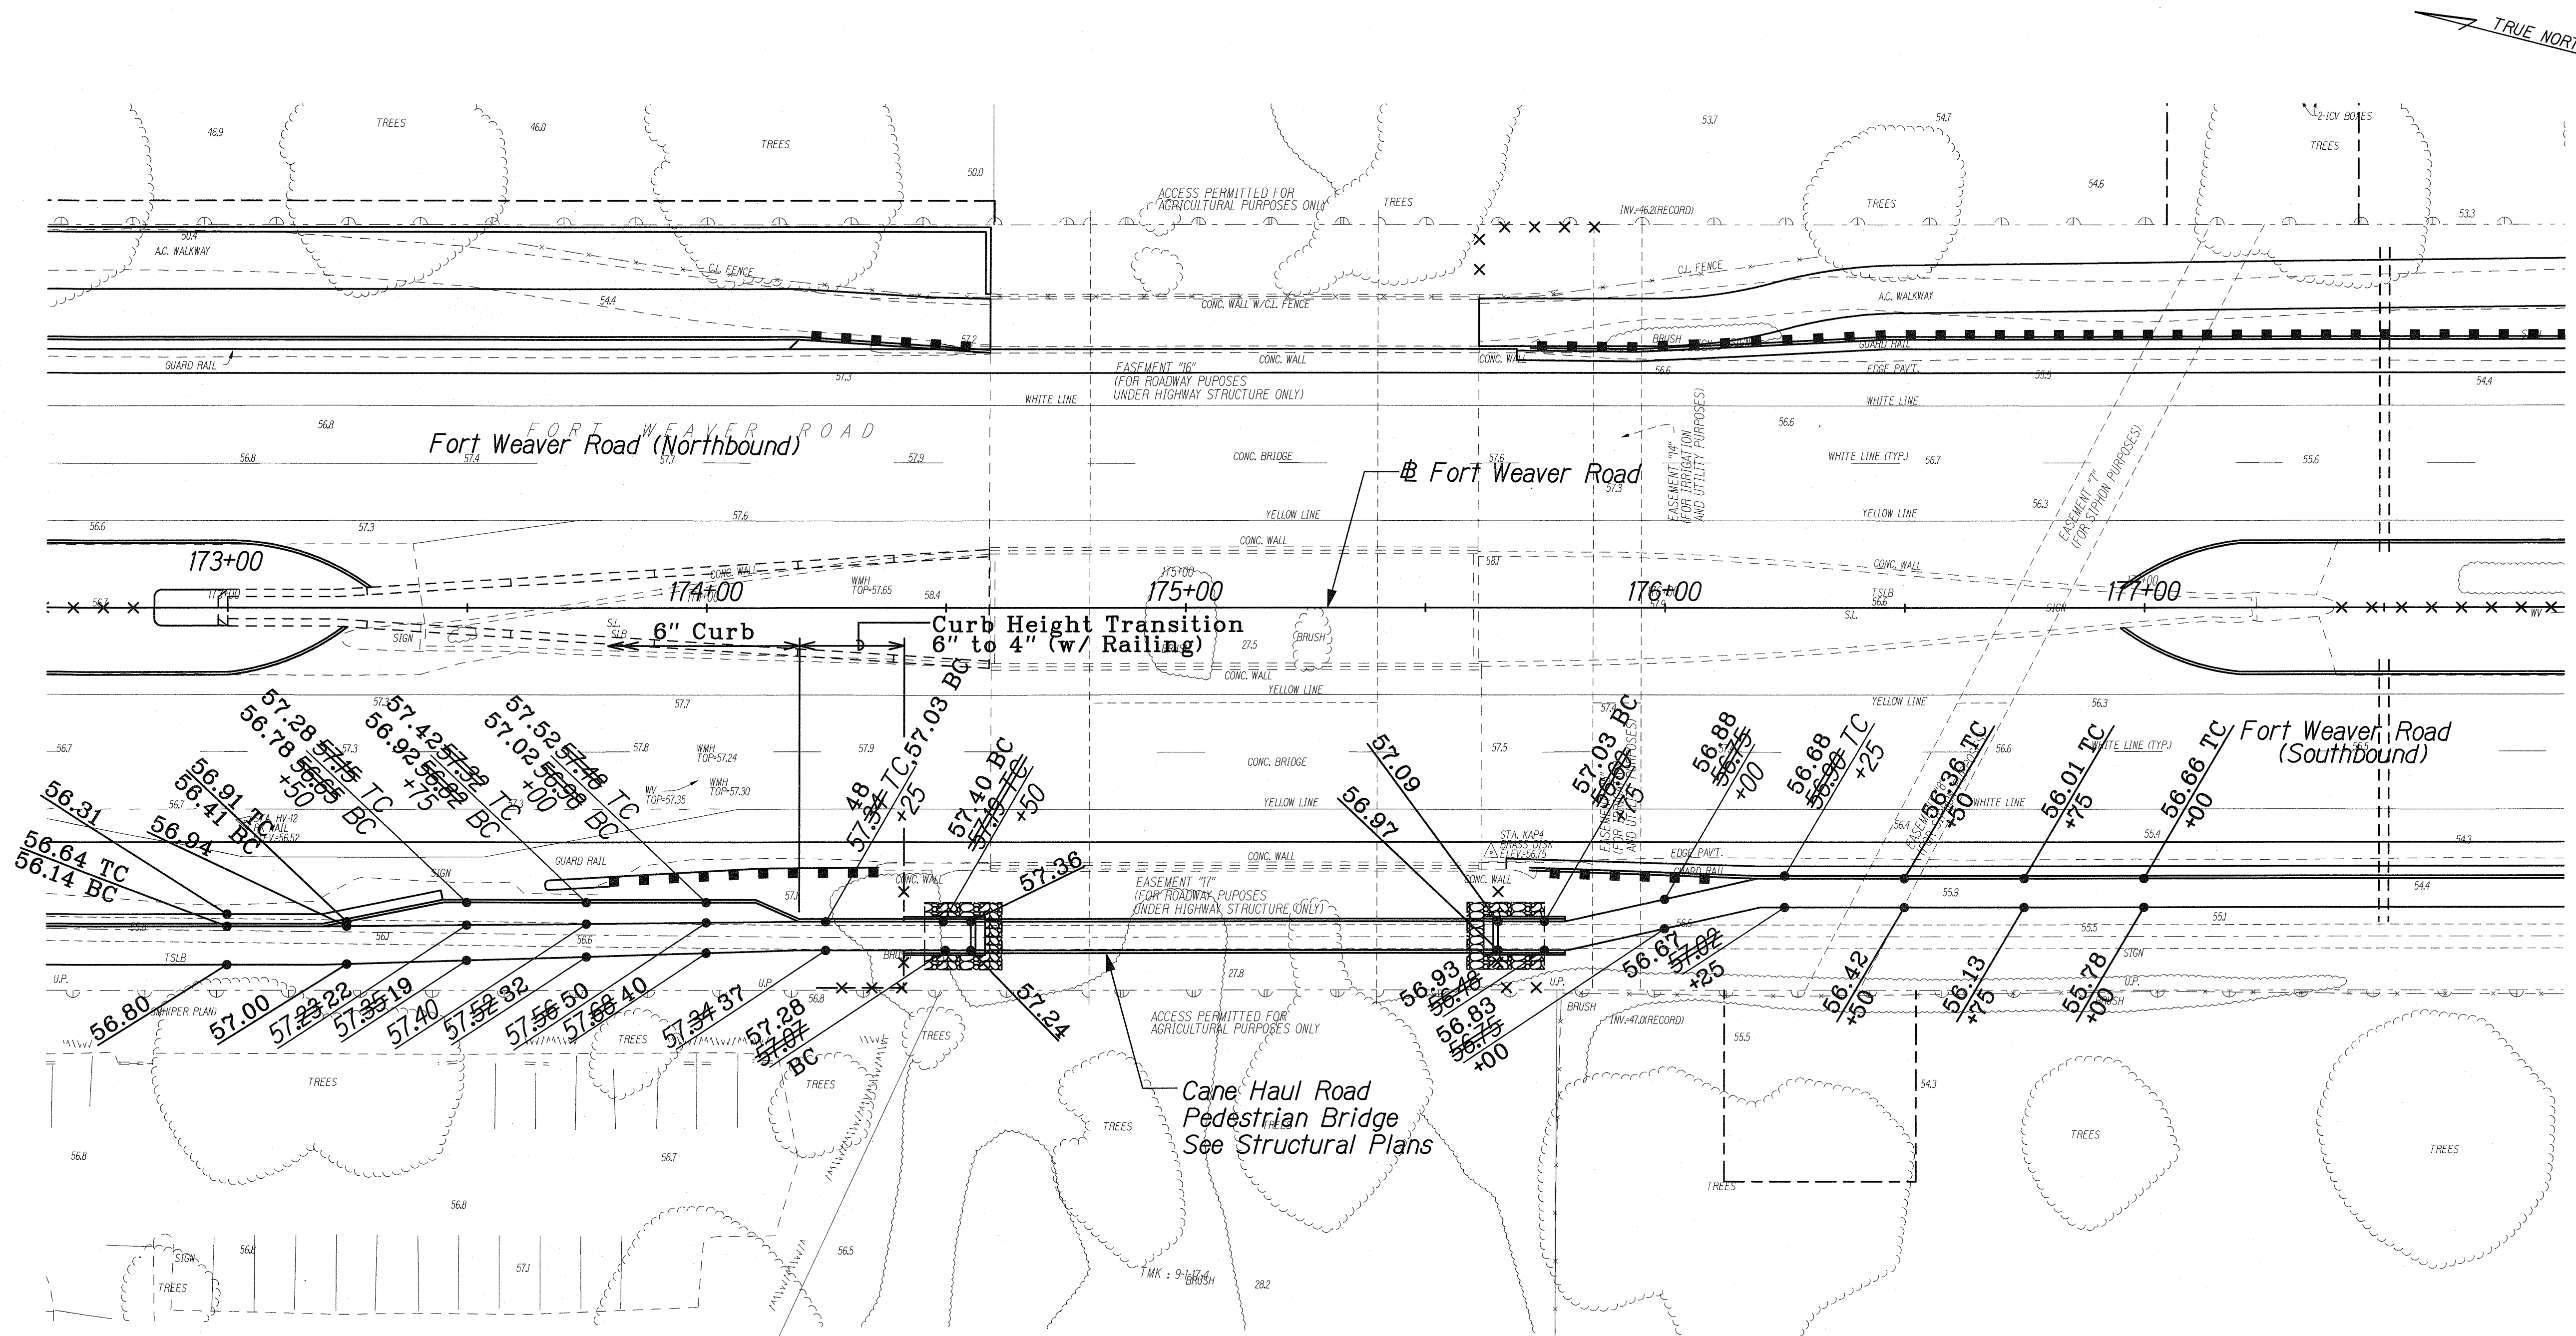

LEGEND FOR AS-BUILT POSTINGS	
	Squiggly line for as-built deletion
	Double line for as-built deletion
Roadway	Text for as-built posting

ORIGINAL PLAN	DATE
DESIGNED BY	
NOTED BY	
CHECKED BY	
DATE	

64 FORT WEAVER ROAD/ROAD/spot elev.dwg

THIS WORK WAS PREPARED BY ME OR UNDER MY SUPERVISION.

Signature: *Ramill* Date: 04/30/10

EXPIRATION DATE OF THE LICENSE

STATE OF HAWAII
DEPARTMENT OF TRANSPORTATION
HIGHWAYS DIVISION

**SIDEWALK SPOT ELEVATIONS
AT CANE HAUL PED. BRIDGE**

FORT WEAVER ROAD WIDENING
VICINITY OF AAWA DRIVE TO GEIGER ROAD

Scale: 1"=20' Date: Feb. 22, 2008

