


FED. ROAD DIST. NO.	STATE	FEDERAL AID PROJ. NO.	FISCAL YEAR	SHEET NO.	TOTAL SHEETS
HAWAII	HAW.	CMAQ-076-1(9)	2006	9	58

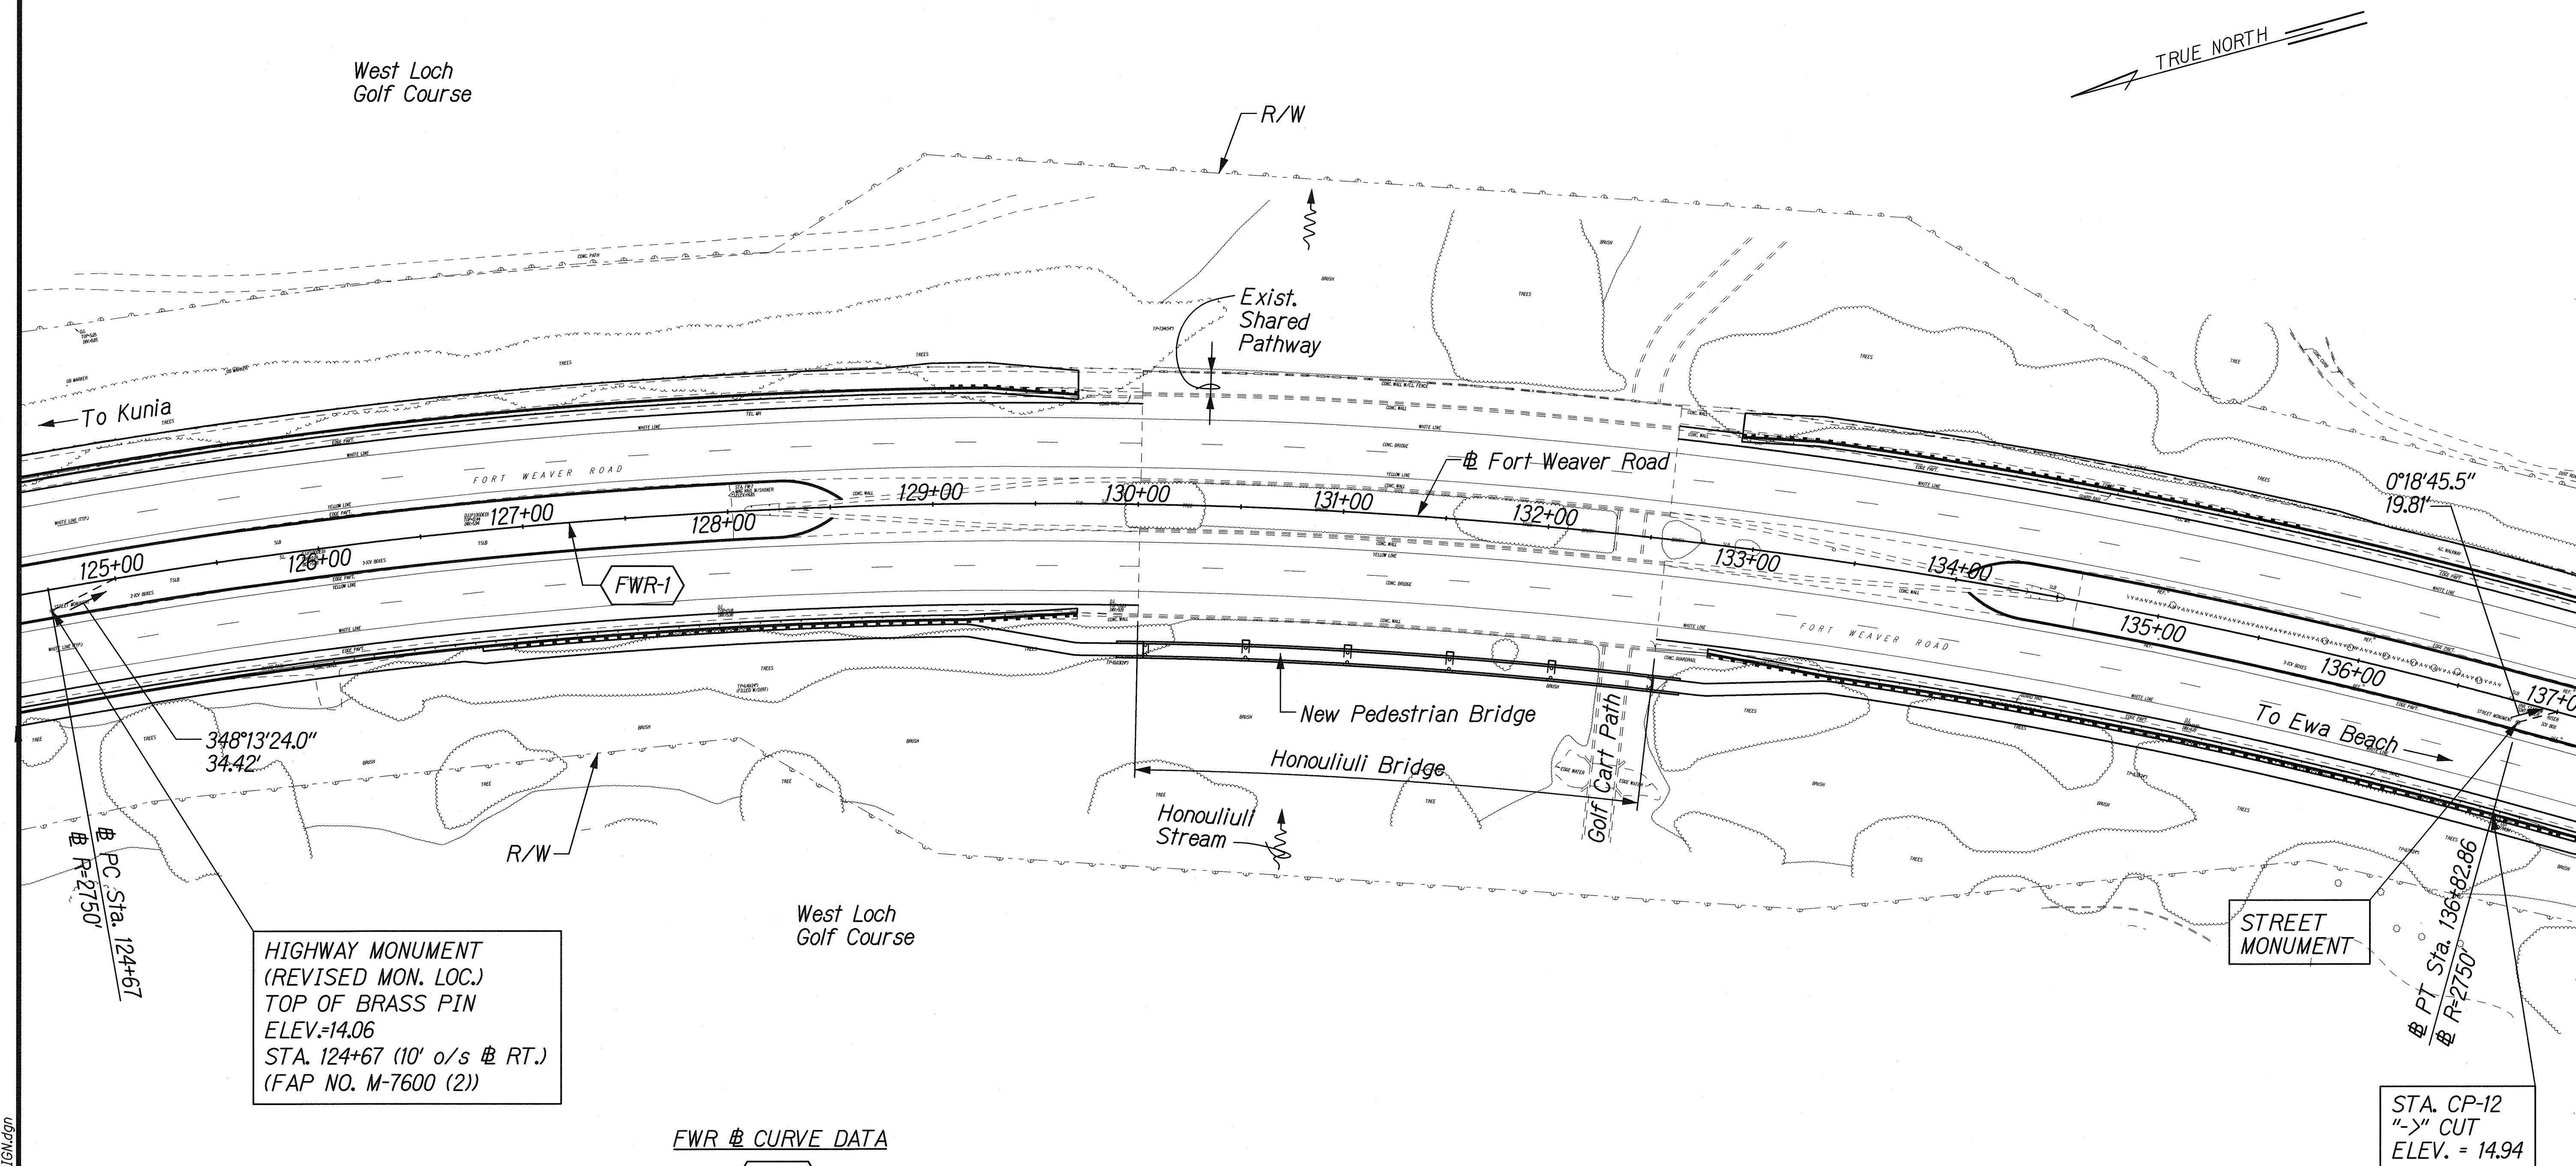

FWR & CURVE DATA

FWR-1

$\Delta = 25^{\circ}19'56''$
 $\Delta/2 = 12^{\circ}39'58''$
 $R = 2750.00'$
 $T = 618.03'$
 $C = 1205.98'$
 $L = 1215.86'$

DATE	_____
DESIGNED BY	_____
TRACED BY	_____
NOTE BOOK	_____
QUANTITIES BY	_____
CHECKED BY	_____

J:\FORT WEAVER ROAD\PACKAGES\ALIGN\ALIGN.dgn

THIS WORK WAS PREPARED BY ME OR UNDER MY SUPERVISION.

R. Urasaka

STATE OF HAWAII
DEPARTMENT OF TRANSPORTATION
HIGHWAYS DIVISION

ALIGNMENT PLAN
STA. TO 125+00 TO 137+00

FORT WEAVER ROAD WIDENING
VICINITY OF AAWA DRIVE TO GEIGER ROAD

Scale: 1" = 40' Date: Feb. 29, 2008

SHEET No. A3-1 OF 1 SHEETS