



FED. ROAD DIST. NO.	STATE	FED. AID PROJ. NO.	FISCAL YEAR	SHEET NO.	TOTAL SHEETS
HAWAII	HAW.	CMAQ-076-1(19)	2006	19	58

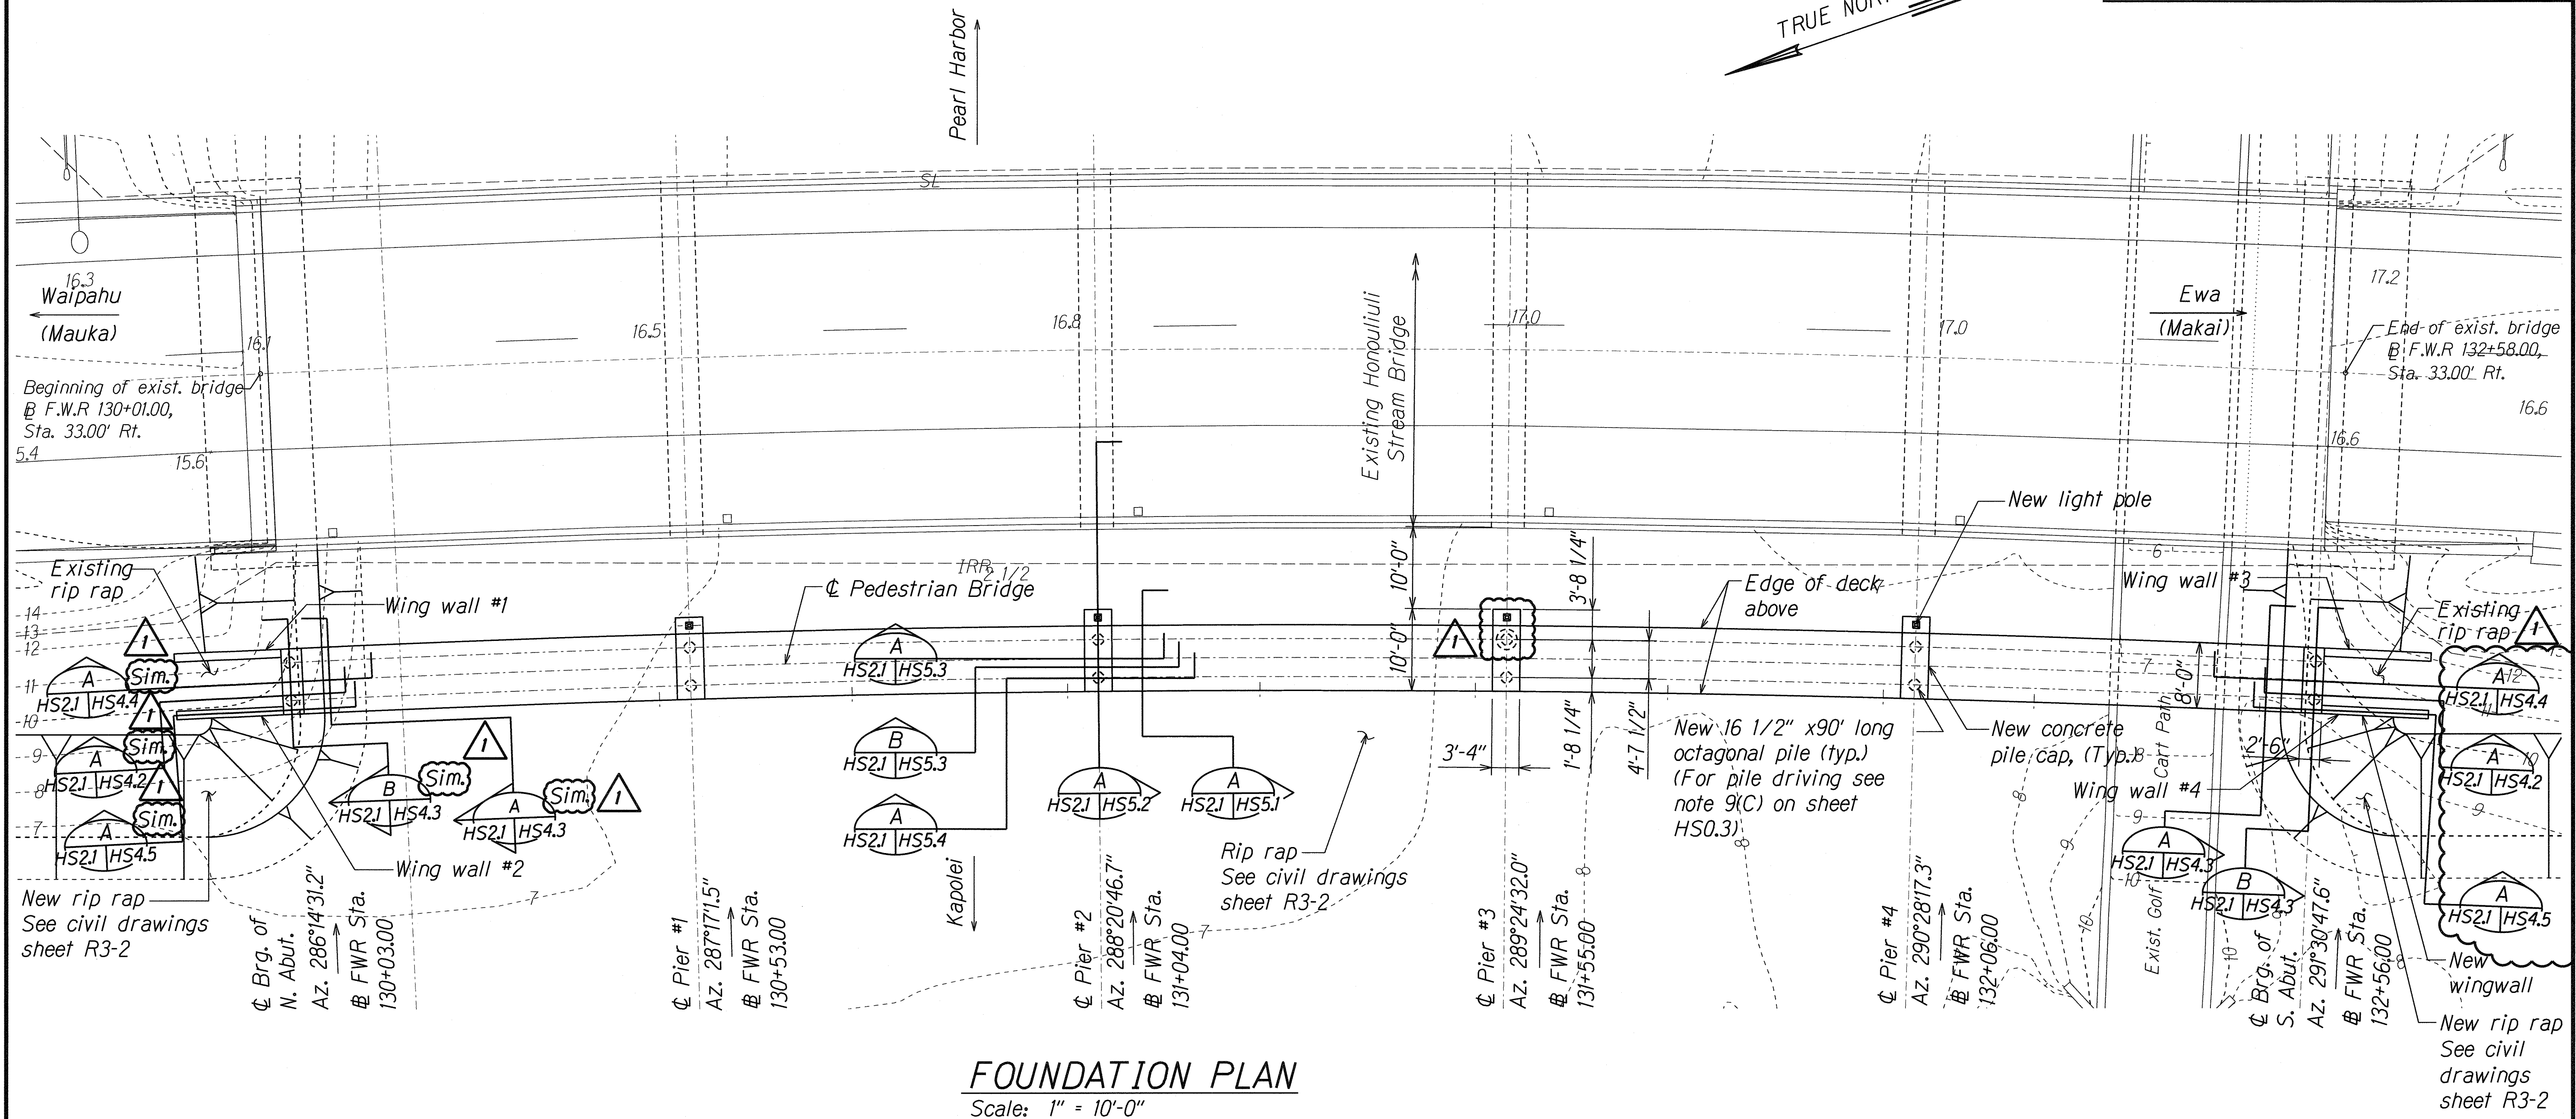

ORIGINAL PLAN	DATE
DRAWN BY	
DESIGNED BY	
QUANTITIES BY	
CHECKED BY	
NO.	

9/30/09	3 As Built
7/3/08	1 Add Concrete Jacket to Pearl Harbor Pile at Pier #3 and Modify Section Marks
DATE	REVISION
STATE OF HAWAII DEPARTMENT OF TRANSPORTATION HIGHWAYS DIVISION FOUNDATION PLAN <i>Fort Weaver Road Widening Honouliuli Stream Pedestrian Bridge Vicinity of Aawa Drive to Geiger Road Federal Aid Project No. CMAQ-076-1(19)</i> Scale: As Shown Date: Feb. 29, 2008	
SHEET No. <i>HS2.1</i> OF 33 SHEETS	

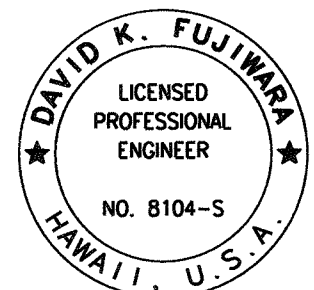

THIS WORK WAS PREPARED BY ME OR UNDER MY SUPERVISION.

Signature: *David K. Fujiwara* 4-30-08
EXPIRATION DATE OF THE LICENSE

AS-BUILT