

SHEET NO.	DESCRIPTION		SHEET NO.	DESCRIPTION
HS0.1	INDEX OF BRIDGE DRAWINGS		HS7.1	METAL RAILING AND POST BLOCKOUT PLAN AND DETAILS
HS0.2	BRIDGE GENERAL NOTES		HS7.2	METAL RAILING ELEVATIONS
HS0.3	BRIDGE GENERAL NOTES		HS7.3	METAL RAILING DETAILS
HS0.4	SYMBOLS AND ABBREVIATIONS - STRUCTURAL ITEMS		HS7.4	METAL RAILING ELEVATIONS
			HS7 . 5	METAL RAILING ELEVATION
HS1.1	LAYOUT PLAN	3	HS7.5A	METAL RAILING SECTIONS
HS1.2	BRIDGE SECTION			
HS1.3	BRIDGE ELEVATION		HS8.1	CONSTRUCTION SEQUENCE
HS2.1	FOUNDATION PLAN			
HS3.1	DECK FRAMING PLAN			
HS3.2	TYPICAL DECK SECTIONS			
HS3.3	DECK FINISH GRADE PLAN			
HS3.4	DECK SCUPPER PLAN AND DETAILS			
HS4.1	ABUTMENT & WING WALL PLANS			
HS4.2	ABUTMENT SECTION			
HS4.3	TYPICAL ABUTMENT ELEVATION AND SECTION			
HS4.4	ABUTMENT SECTION AT DUCT BANK			
HS4 . 5	WING WALL SECTIONS			
HS4 . 6	WING WALL / ABUTMENT DETAILS			
HS5.1	TYPICAL PIER PLAN AND SECTION			
HS5 . 2	TYPICAL PIER SECTIONS			
HS5.3	TYPICAL PIER SECTIONS			
HS5.4	TYPICAL PIER SECTION AND DECK TOPPING REINFORCEMENT AT PIER CAP			
HS5.5	REBAR EXTENSION FROM PRECAST GIRDERS INTO PIER CAP			
HS5.6	PILE TO CAP CONNECTION DETAILS			
HS5.7	PIER #3 CONCRETE JACKET AT PEARL HARBOR PILE			
HS6.1	PRECAST GIRDER PLAN		·	
HS6.2	TYPICAL PRECAST GIRDER ELEVATION			
HS6.3	GIRDER END SECTIONS AT ABUTMENT CAP			
HS6.4	GIRDER END SECTIONS AT PIER CAP AND ABUTMENT CAP	1		

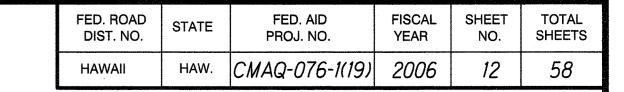

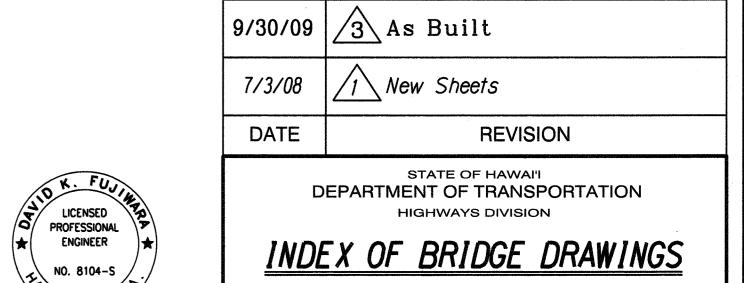

Fort Weaver Road Widening

Honouliuli Stream Pedestrian Bridge

Vicinity of Aawa Drive to Geiger Road

Federal Aid Project No. CMAQ-076-1(9)

Scale: None Date: Feb. 29, 2008

SHEET No. *HS0.1* OF 33 SHEETS

150.1 01 55 0.

JOF :

THIS WORK WAS PREPARED BY ME OR UNDER MY SUPERVISION.