


FED. ROAD DIST. NO.	STATE	FED. AID PROJ. NO.	FISCAL YEAR	SHEET NO.	TOTAL SHEETS
HAWAII	HAW.	CMAQ-076-1(19)	2006	35	58

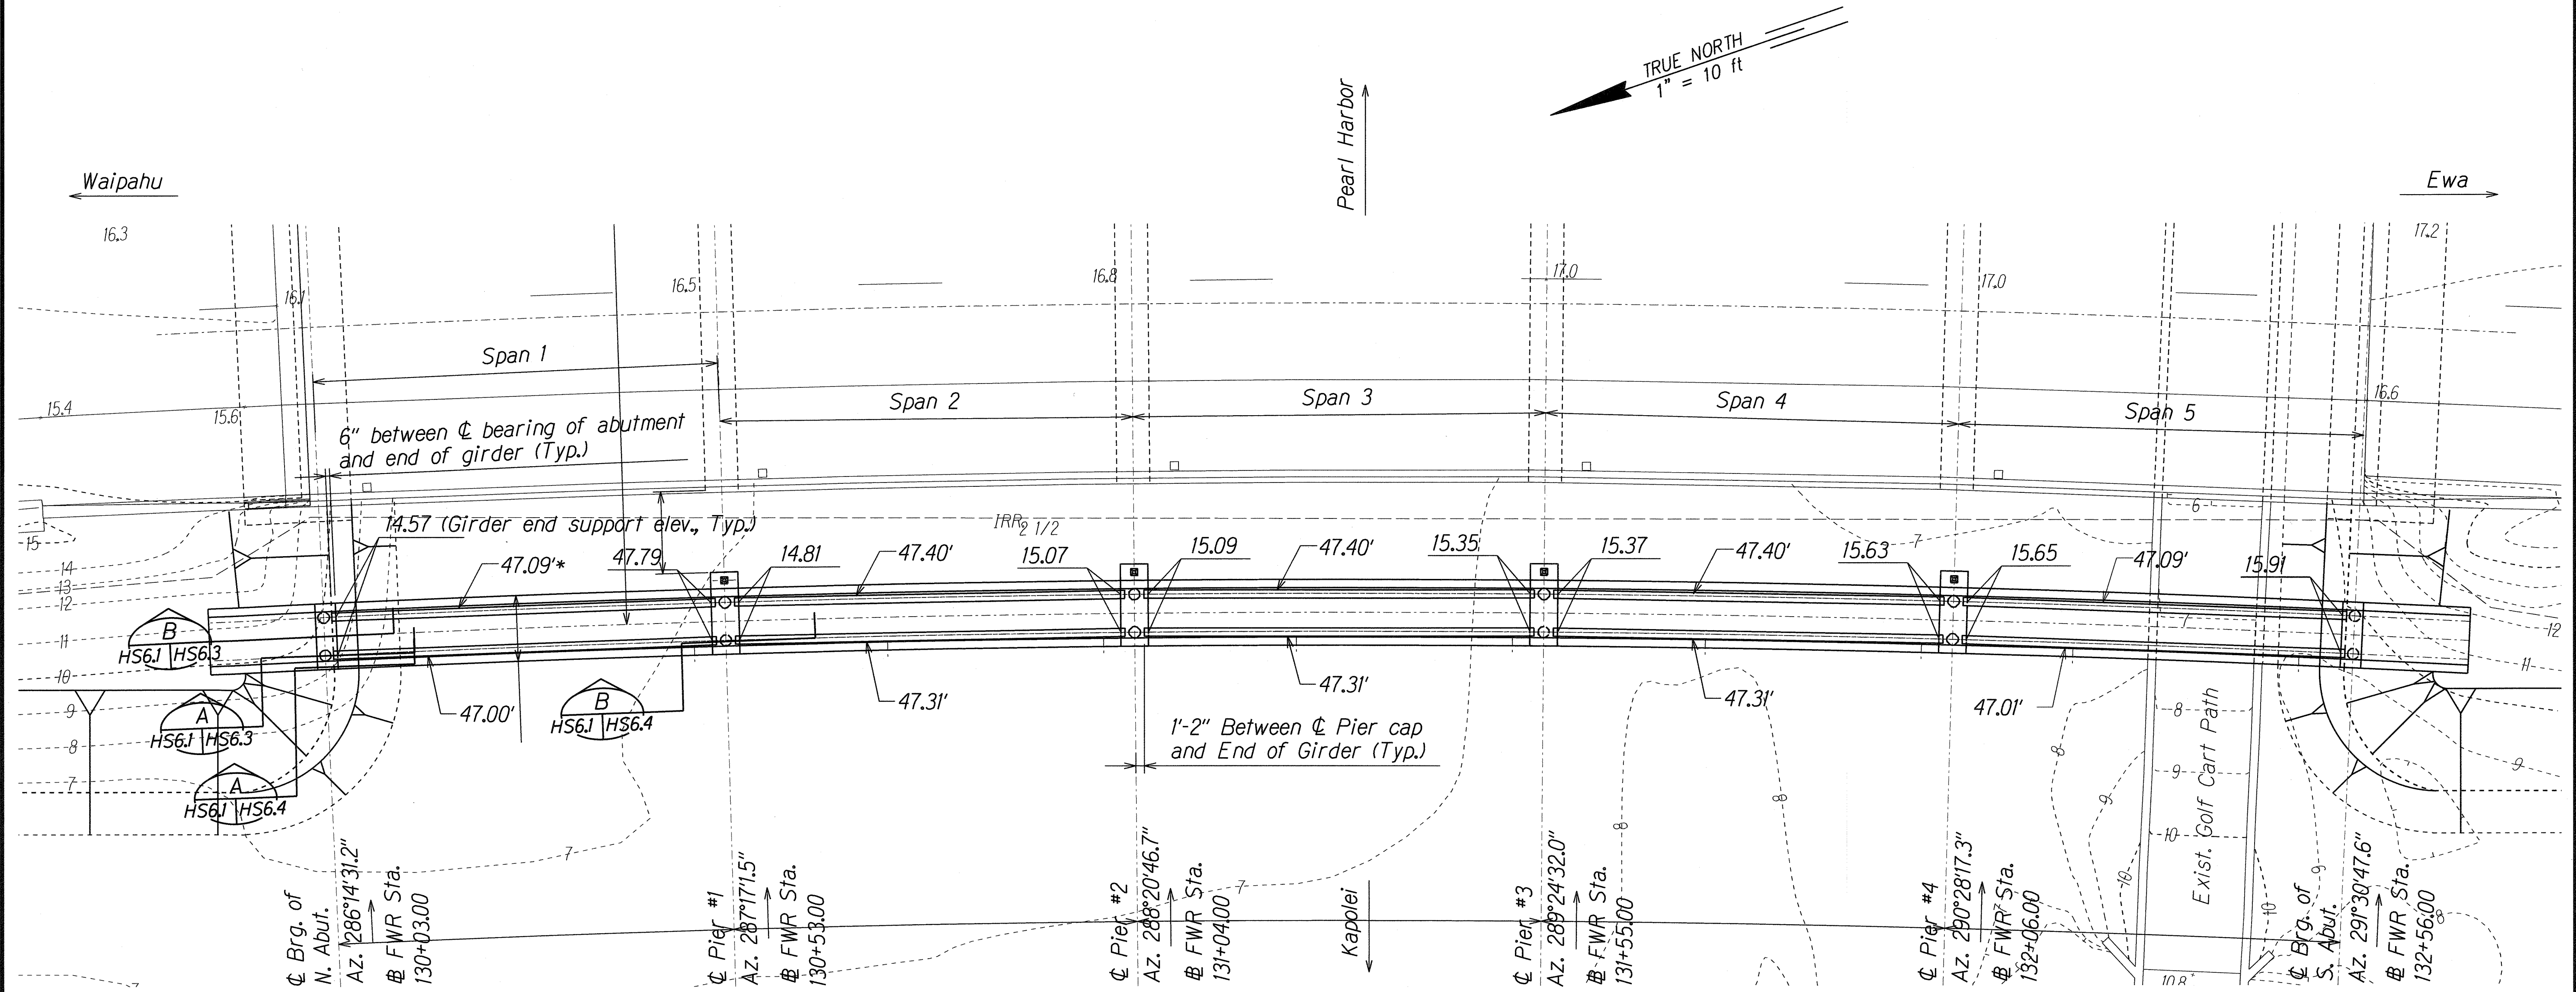


* Girder lengths, measured along centerline, end to end.

PRECAST GIRDER PLAN

Scale: 1" = 10'-0"

ORIGINAL PLAN	DATE
DRAWN BY	
DESIGNED BY	
QUANTITIES BY	
CHECKED BY	
No.	

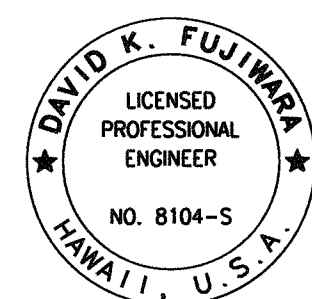


THIS WORK WAS PREPARED BY ME OR UNDER MY SUPERVISION.
 Signature: David K. Fujimura
 EXPIRATION DATE OF THE LICENSE: 4-30-08

9/30/09	3 As Built
DATE	REVISION
STATE OF HAWAII DEPARTMENT OF TRANSPORTATION HIGHWAYS DIVISION PRECAST GIRDER PLAN Fort Weaver Road Widening Honolulu Stream Pedestrian Bridge Vicinity of Aawa Drive to Geiger Road Federal Aid Project No. CMAQ-076-1(19) Scale: As Shown Date: Feb. 29, 2008	
SHEET No. HS6.I OF 33 SHEETS	

AS-BUILT

35


FED. ROAD DIST. NO.	STATE	FED. AID PROJ. NO.	FISCAL YEAR	SHEET NO.	TOTAL SHEETS
HAWAII	HAW.	CMAQ-076-1(19)	2006	37	58

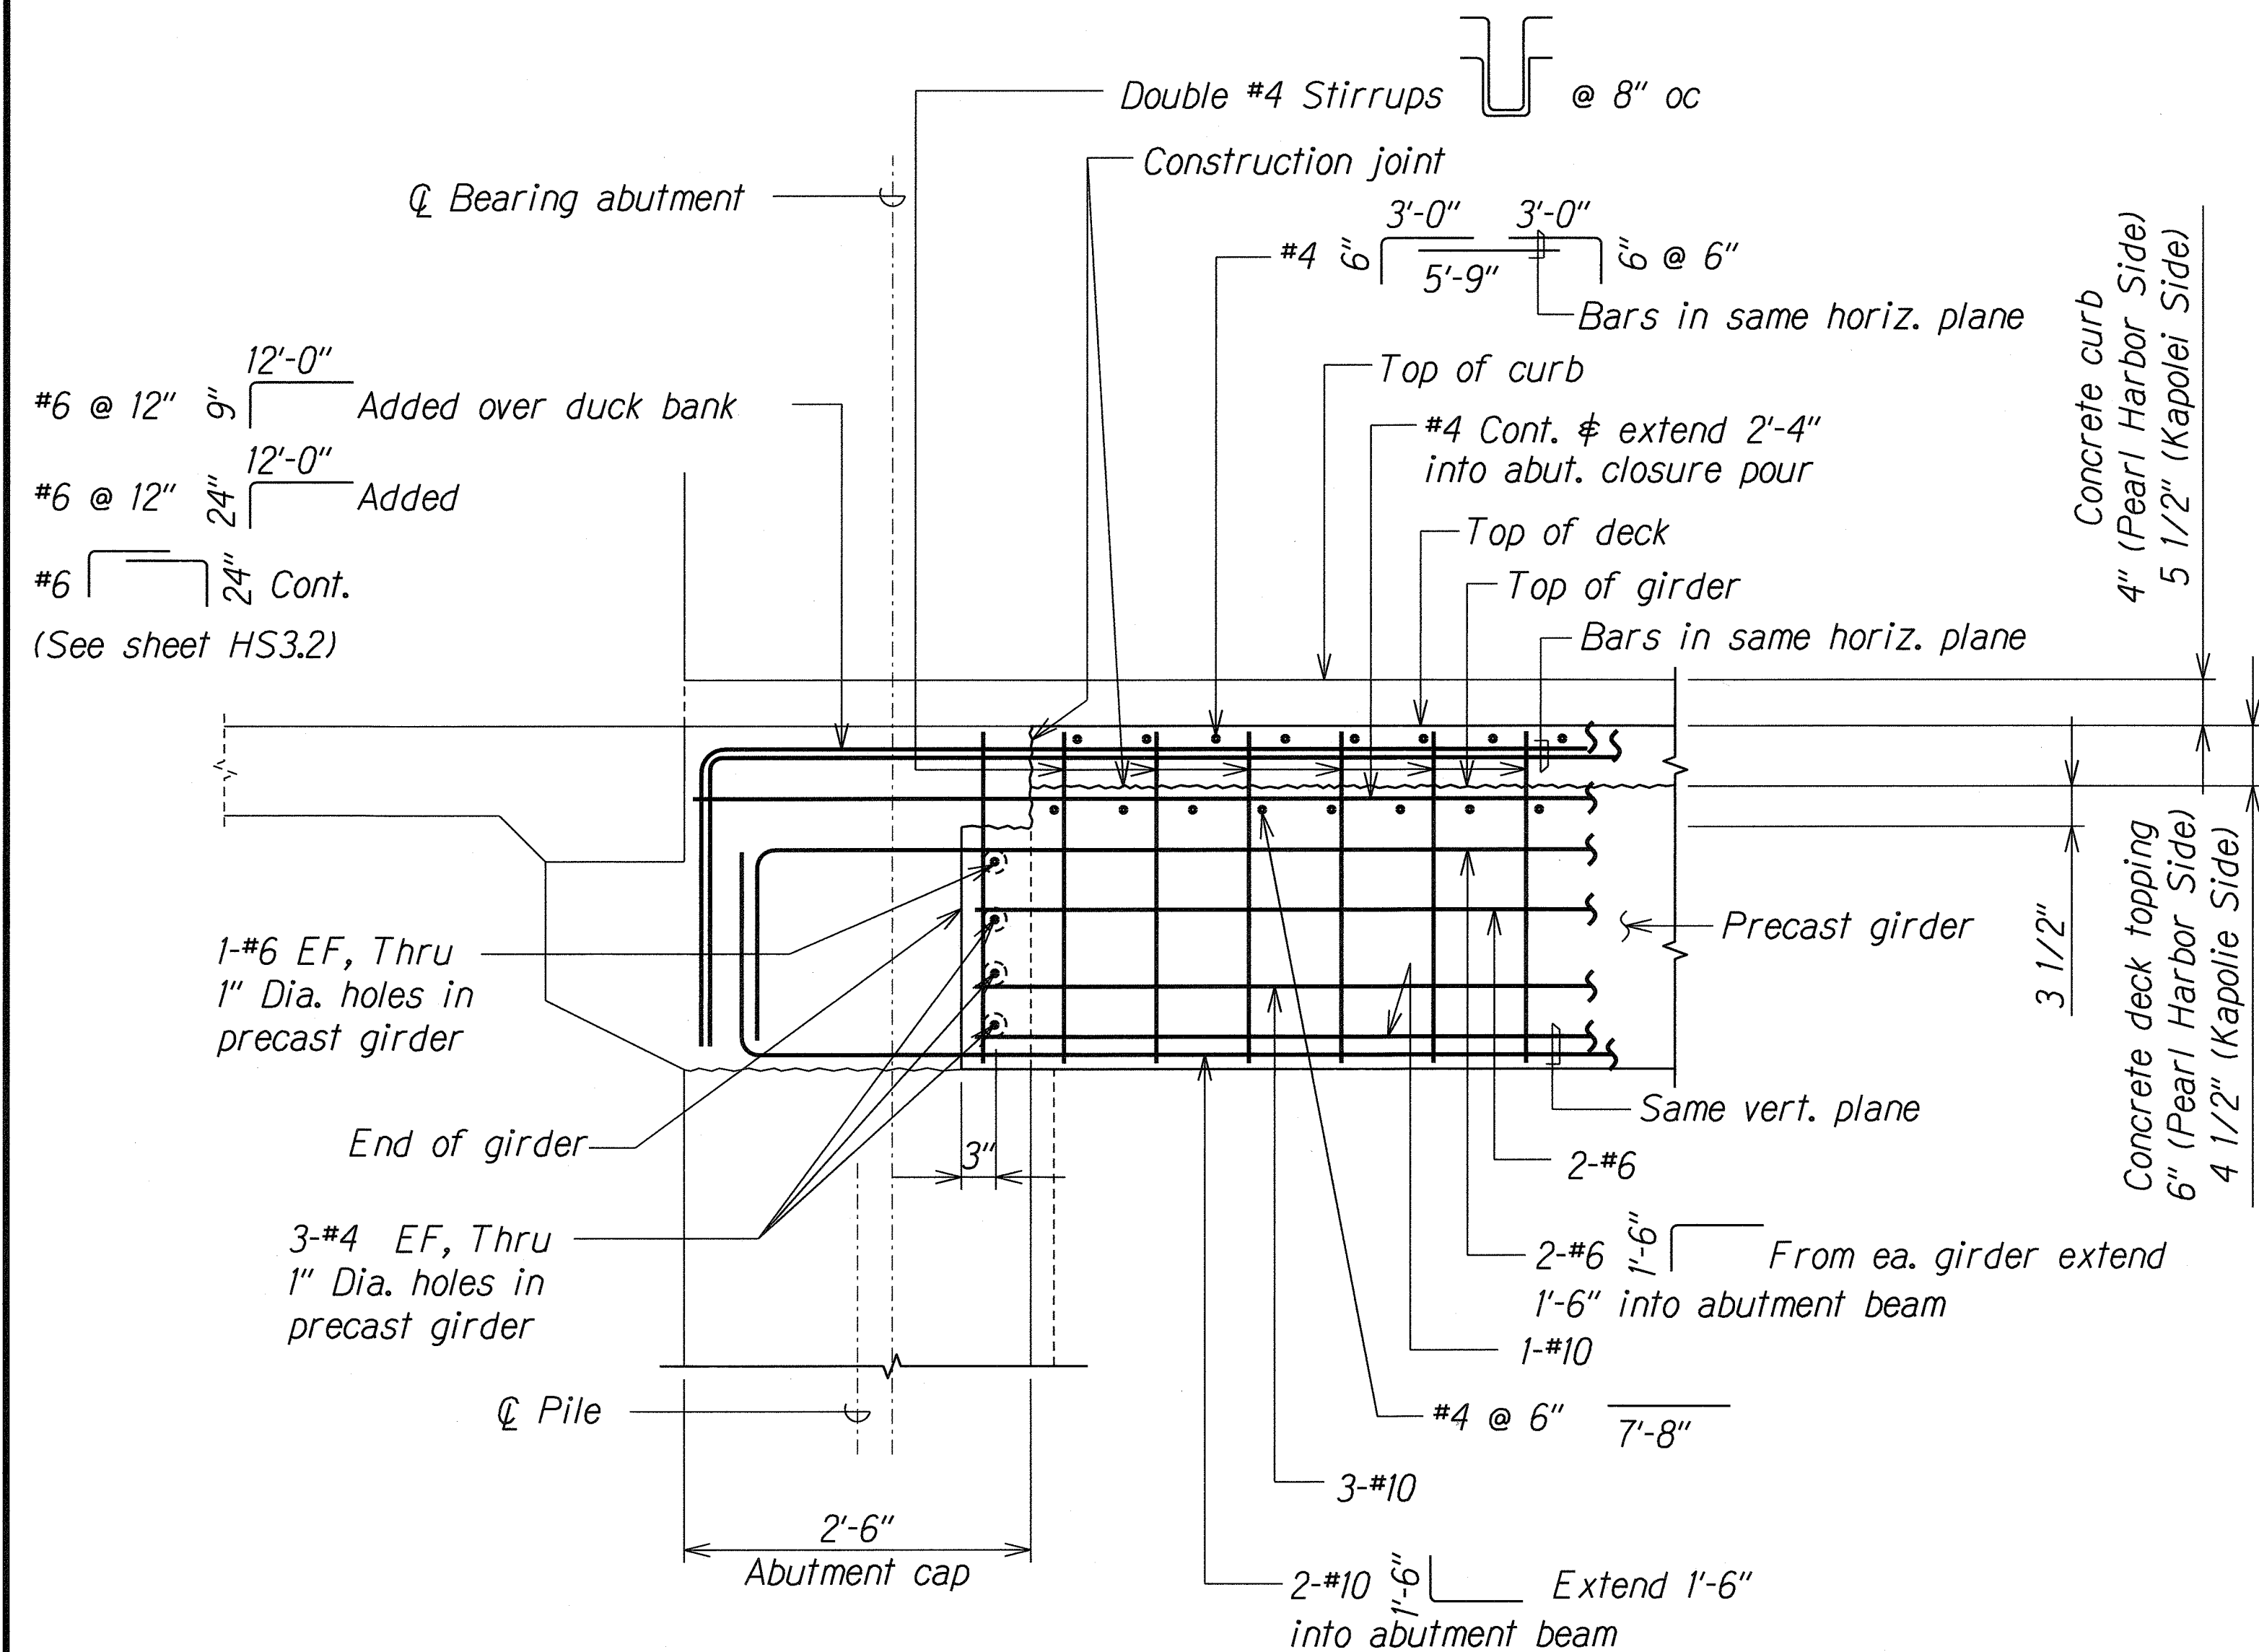

GIRDER END SECTION AT ABUTMENT CAP
(THRU GIRDER WEB)

Scale: 1" = 1'-0"


A
HS6J/HS6.3

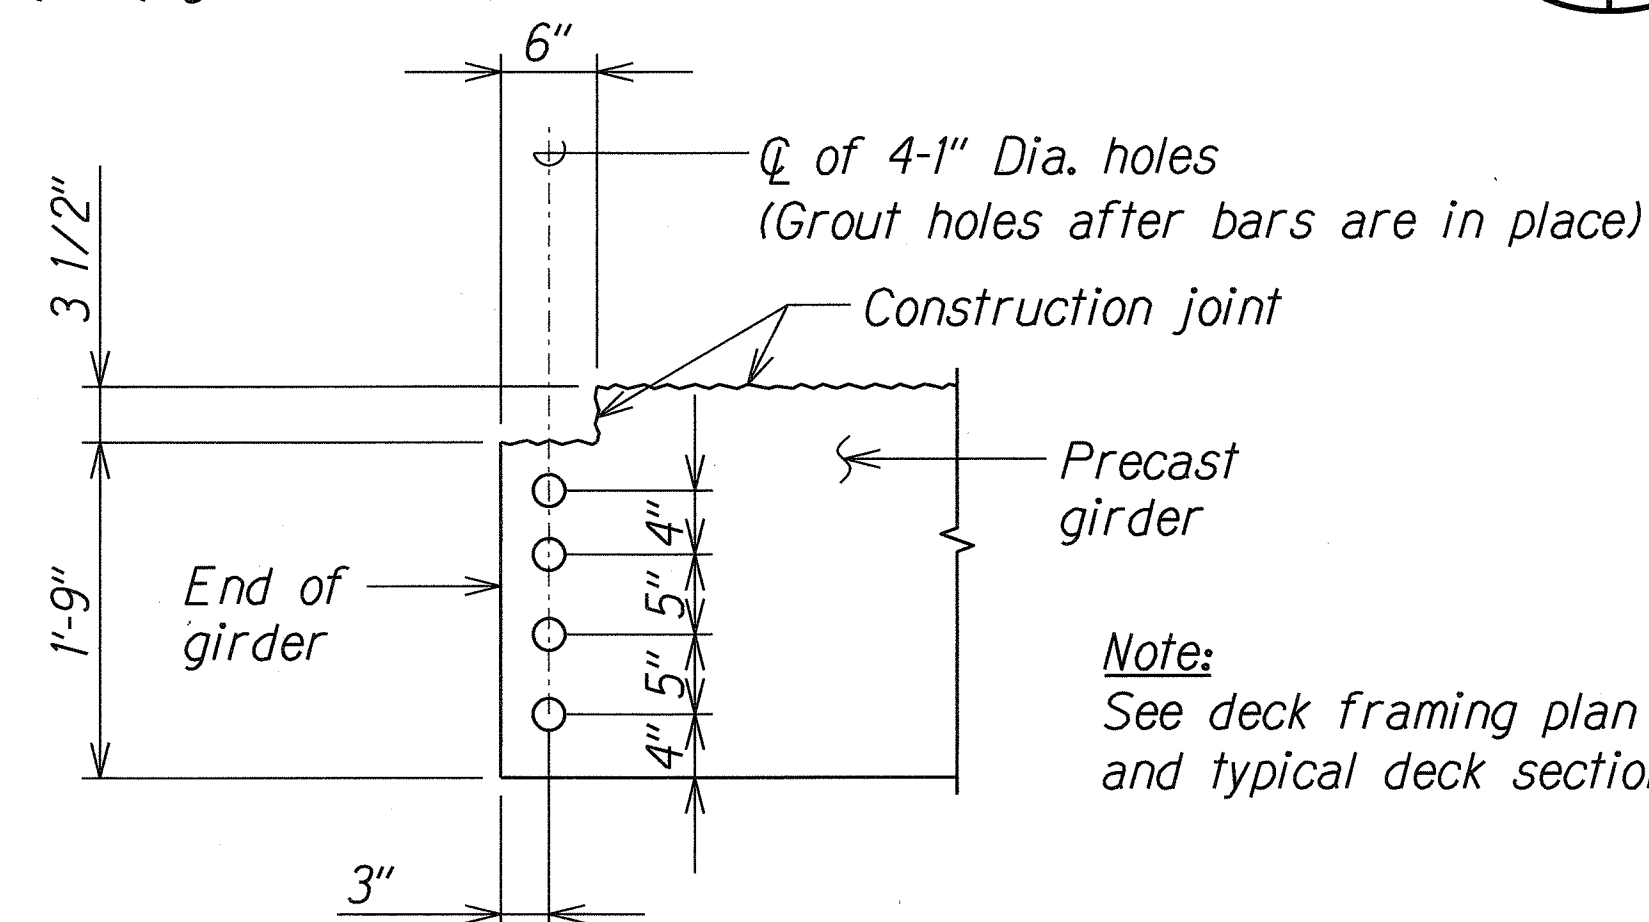

HOLES AT ENDS OF GIRDER - ELEVATION

Scale: 1" = 1'-0"

Note:
See deck framing plan on sheet HS3.1
and typical deck section on plan sheet HS3.2.

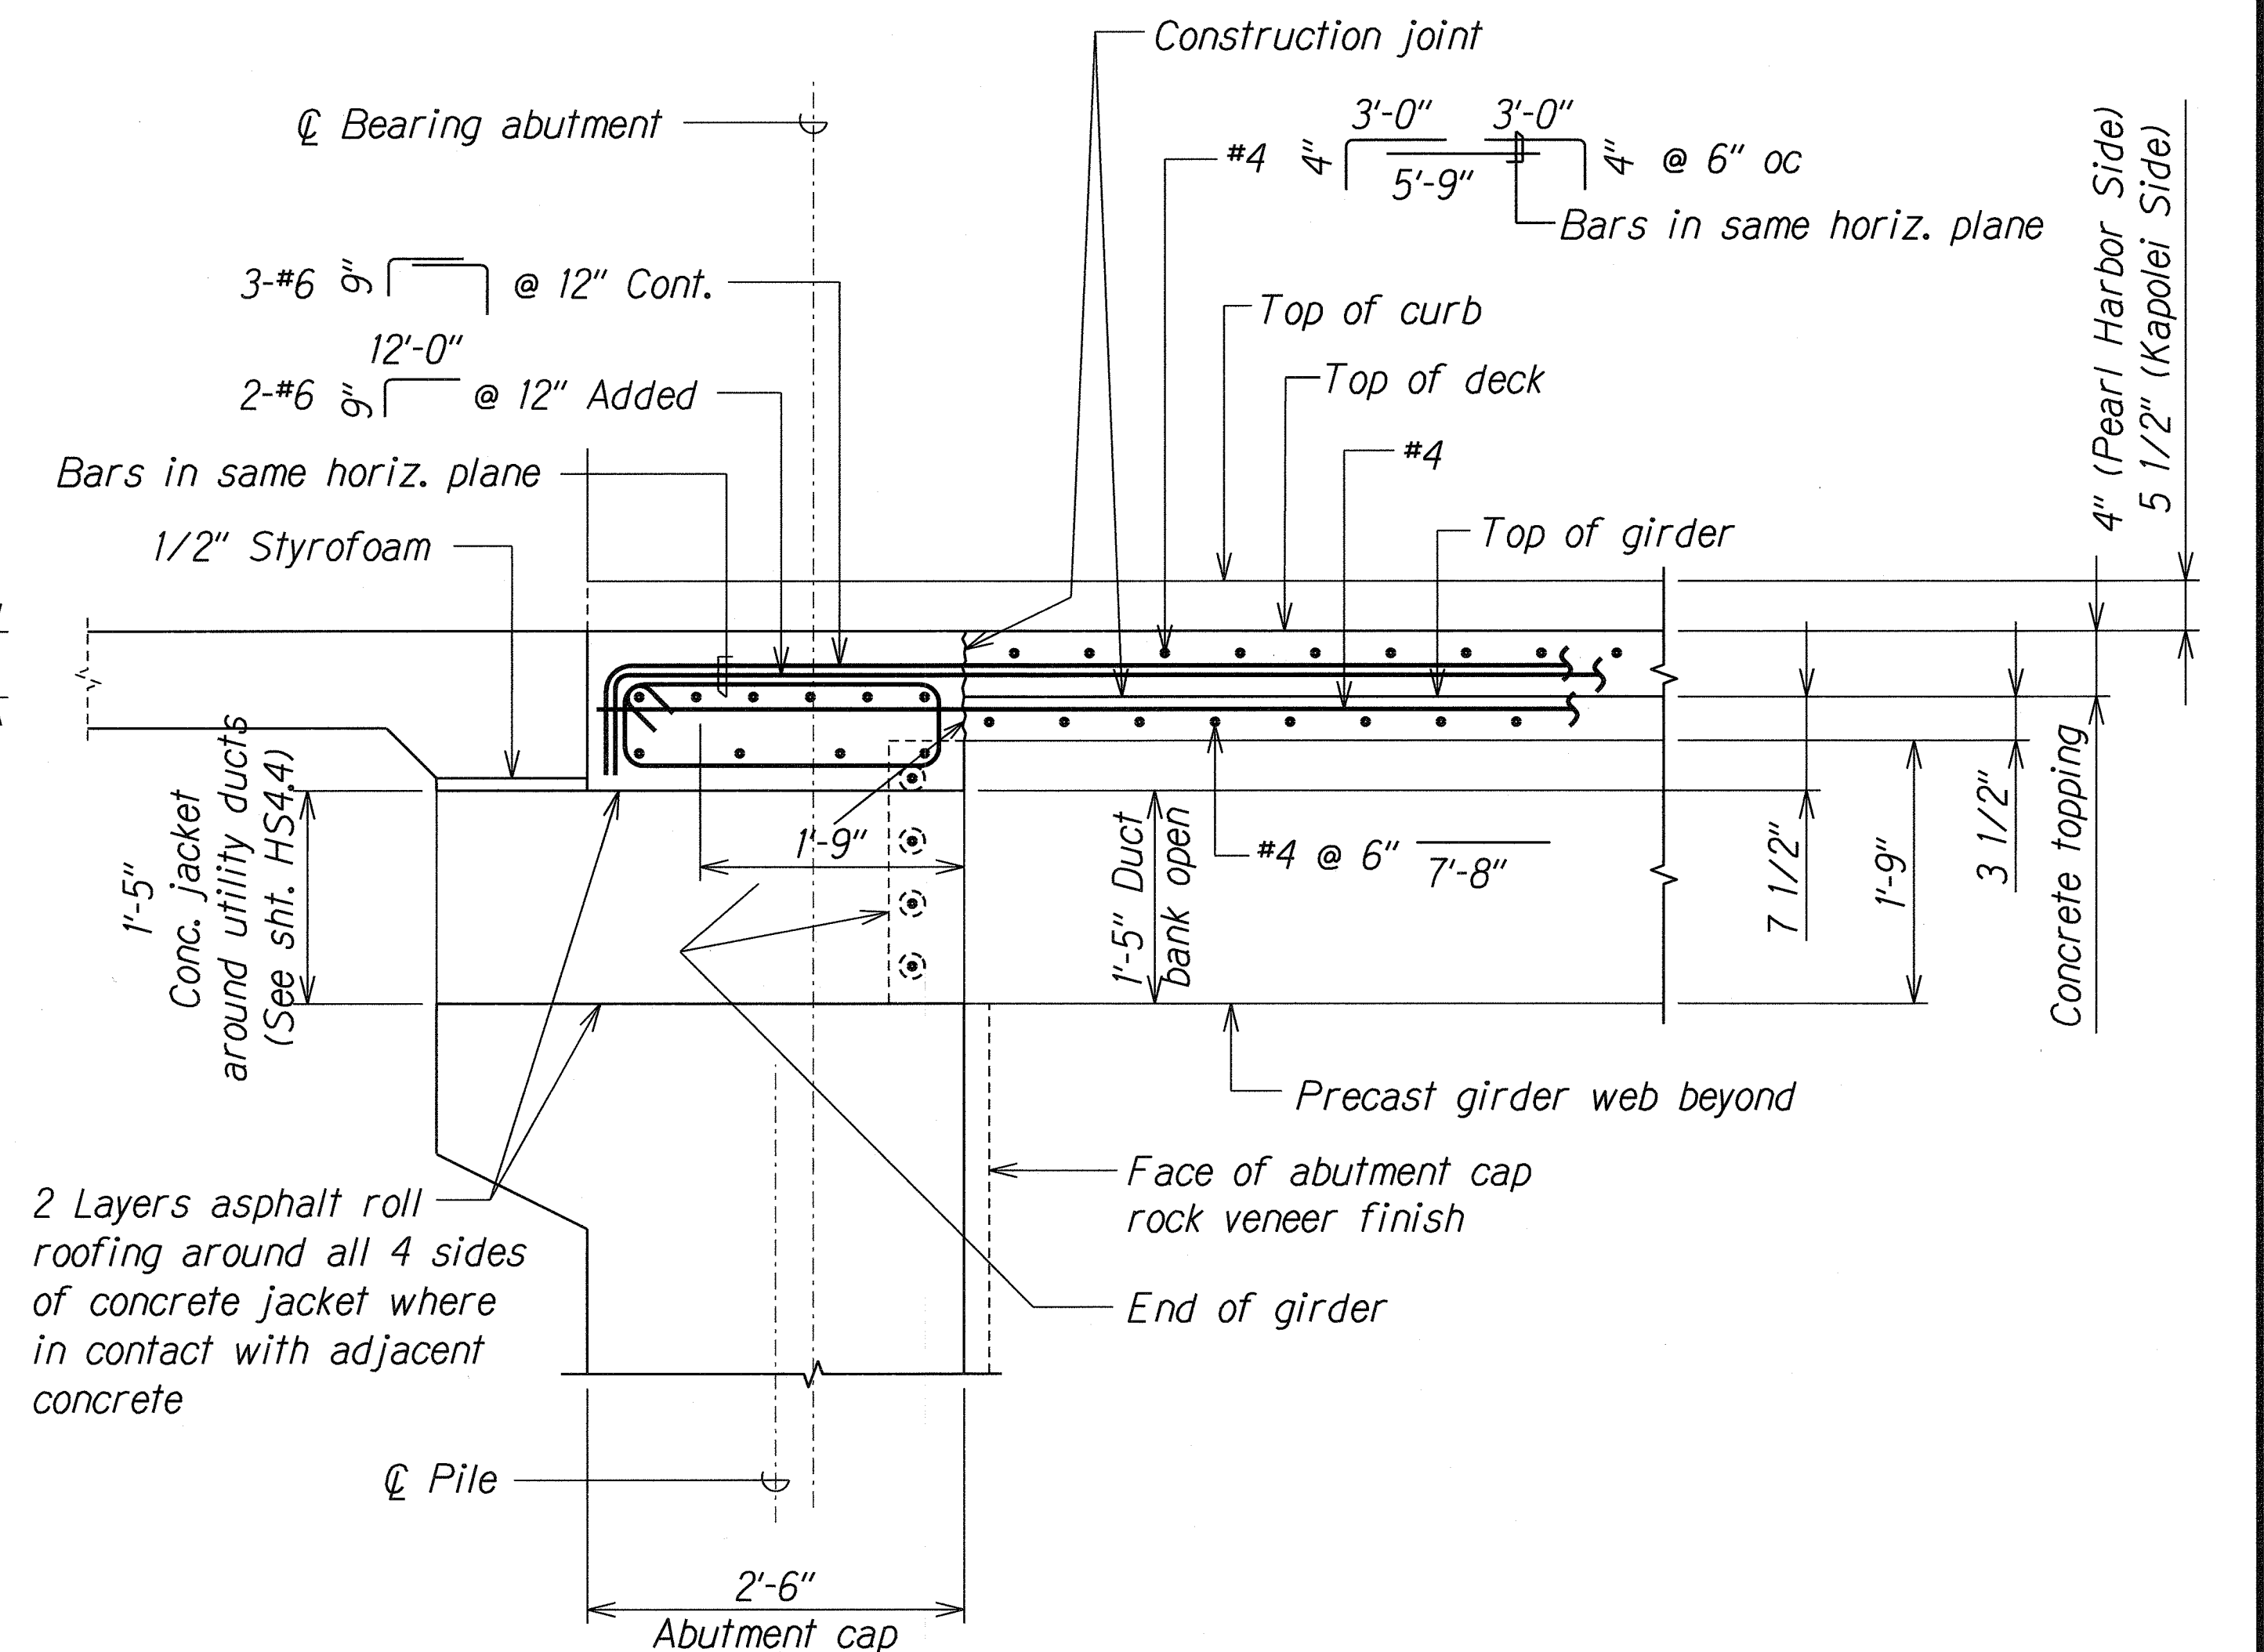


GIRDER END SECTION AT ABUTMENT CAP
(THRU DUCT BANK OPENING)

Scale: 1" = 1'-0"

B
HS4.3/HS6.3

Note:
See deck framing plan on sheet HS3.1
and typical deck section on plan sheet HS3.2.

SURVEY PLOTTED BY	DATE
DRAWN BY	
DESIGNED BY	
QUANTITIES BY	
CHECKED BY	
ORIGINAL PLAN	
NOTE BOOK	
No.	

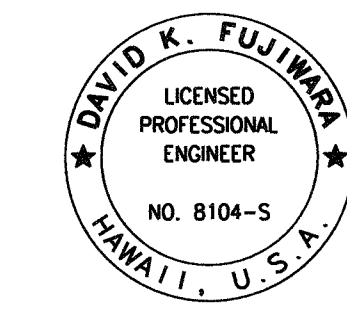

THIS WORK WAS PREPARED BY
ME OR UNDER MY SUPERVISION.

Signature: David K. Fujiwara
EXPIRATION DATE OF THE LICENSE: 4-30-08

9/30/09	 As Built
7/3/08	 New Sheet
DATE	REVISION

STATE OF HAWAII
DEPARTMENT OF TRANSPORTATION
HIGHWAYS DIVISION


GIRDER END SECTIONS AT
ABUTMENT CAP

Fort Weaver Road Widening
Honouliuli Stream Pedestrian Bridge
Vicinity of Aawa Drive to Geiger Road
Federal Aid Project No. CMAQ-076-1(19)

Scale: As Shown Date: Feb. 29, 2008

SHEET No. *HS6.3* OF 33 SHEETS


FED. ROAD DIST. NO.	STATE	FED. AID PROJ. NO.	FISCAL YEAR	SHEET NO.	TOTAL SHEETS
HAWAII	HAW.	CMAQ-076-1(19)	2006	38	58

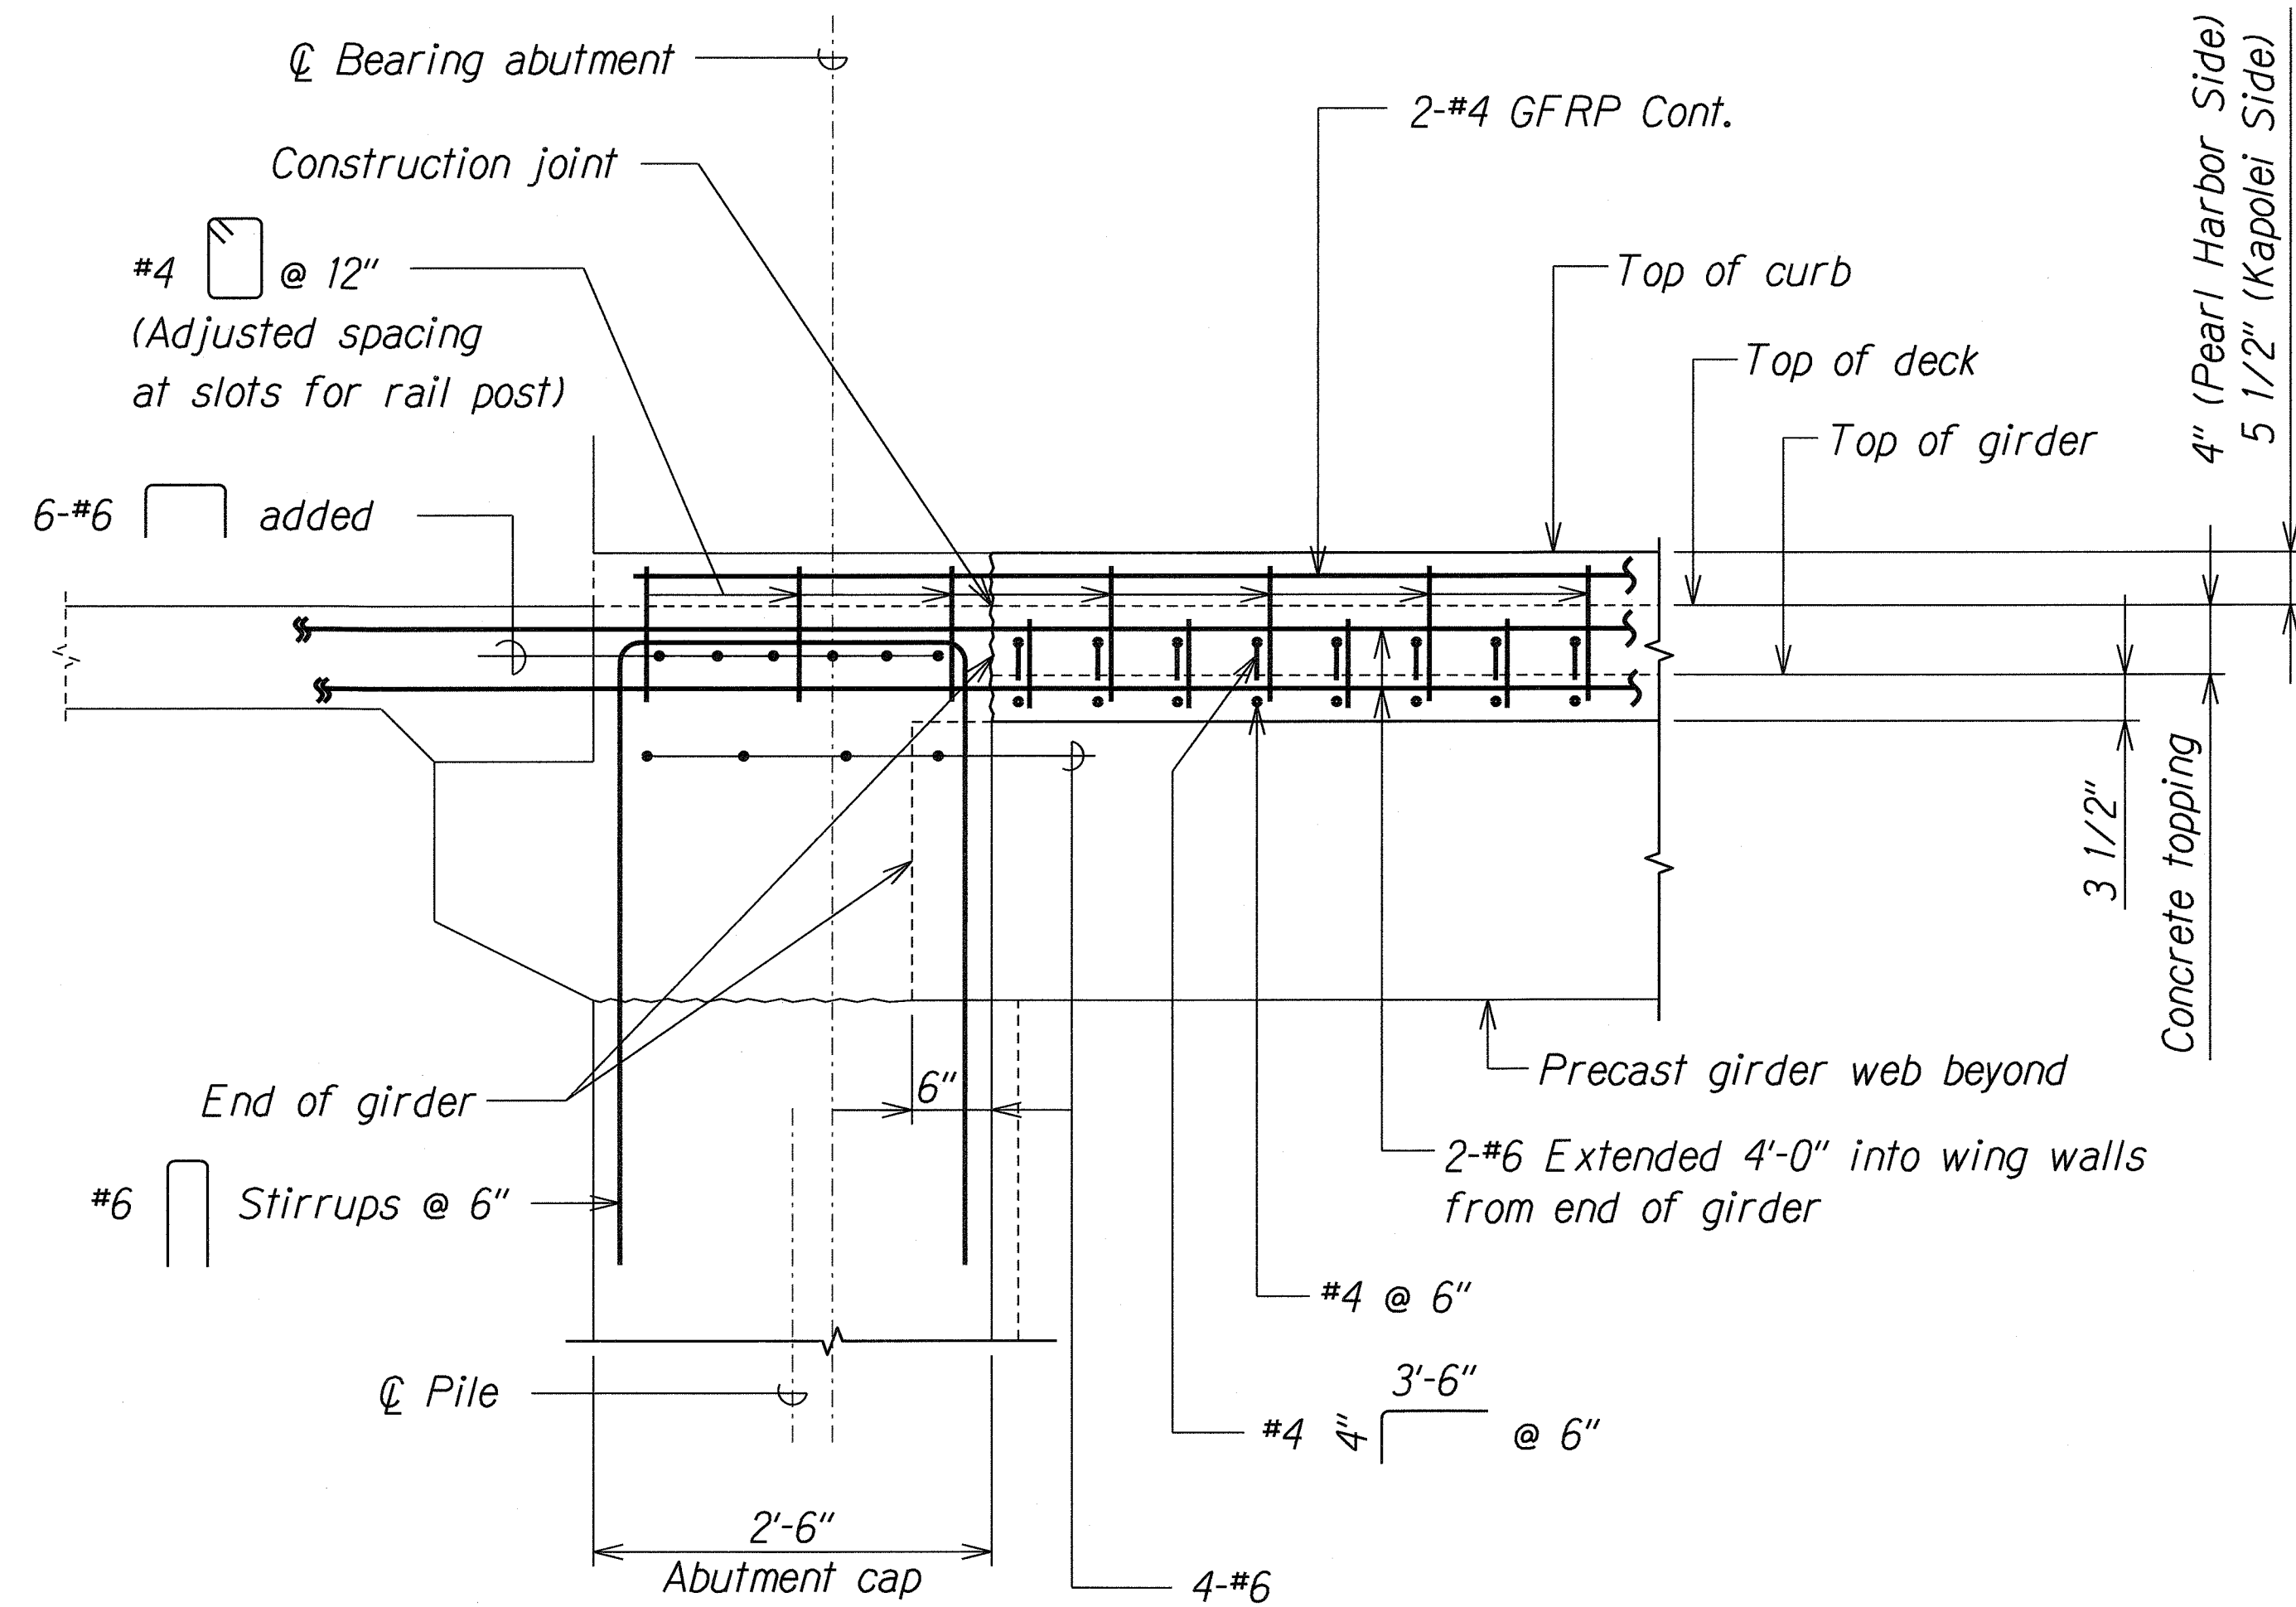

**GIRDER END SECTION AT ABUTMENT CAP
(THRU CURB)**

Scale: 1" = 1'-0"

A
HS6J HS6.4

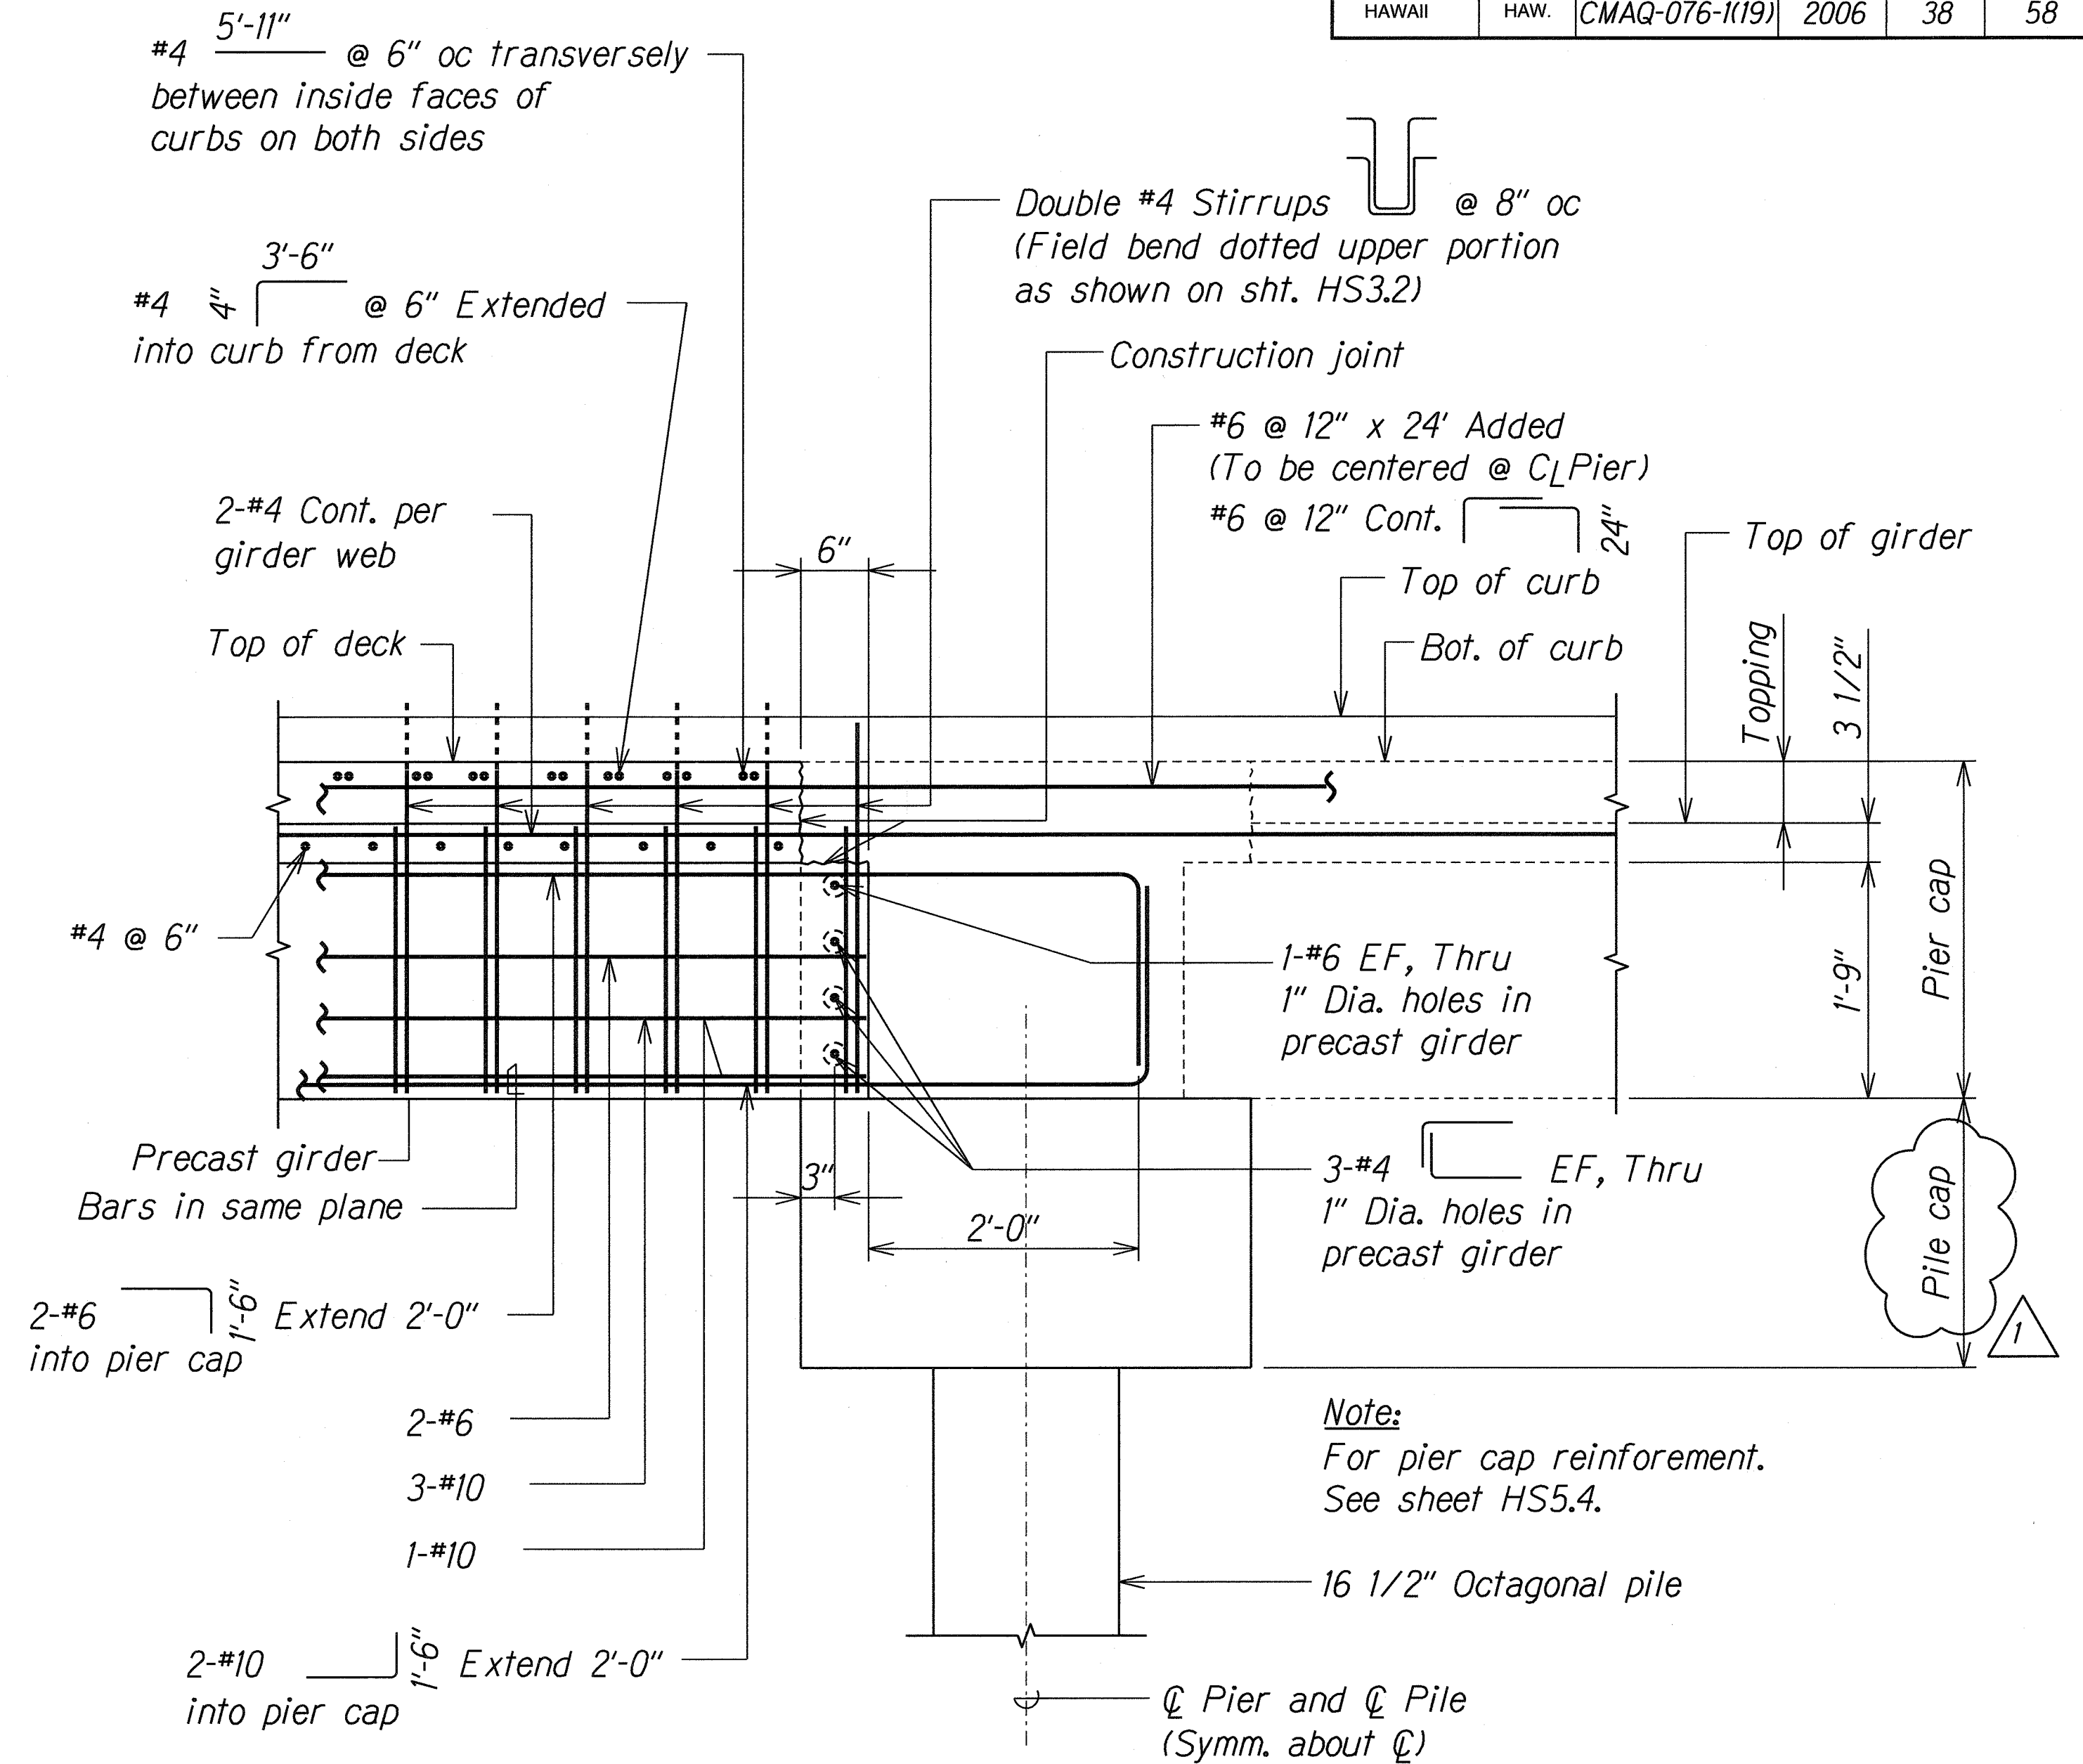


**GIRDER END SECTION AT PIER CAP
(THRU GIRDER WEB)**

Scale: 1" = 1'-0"

B
HS6J HS6.4

- Notes:**
- See deck framing plan on sheet HS3.1 and typical deck section on plan sheet HS3.2.
 - To prevent interference of rebars extended from girder ends into pier caps, See sheet HS5.5.

SURVEY PLOTTED BY	DATE
DRAWN BY	
DESIGNED BY	
QUANTITIES BY	
CHECKED BY	
NO.	

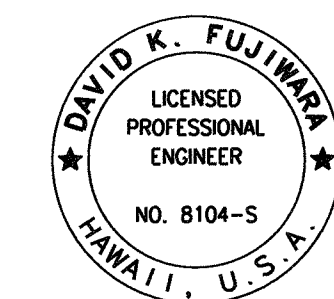

THIS WORK WAS PREPARED BY
ME OR UNDER MY SUPERVISION.
David K. Fujimura
SIGNATURE EXPIRATION DATE OF THE LICENSE 4-30-08

9/30/09	3 As Built
7/3/08	1 Revise Pier Cap Depth
DATE	REVISION
STATE OF HAWAII DEPARTMENT OF TRANSPORTATION HIGHWAYS DIVISION GIRDER END SECTIONS AT PIER CAP AND ABUTMENT CAP <i>Fort Weaver Road Widening Honouliuli Stream Pedestrian Bridge Vicinity of Aawa Drive to Geiger Road Federal Aid Project No. CMAQ-076-1(19)</i> Scale: As Shown Date: Feb. 29, 2008	
SHEET No. HS6.4 OF 33 SHEETS	