

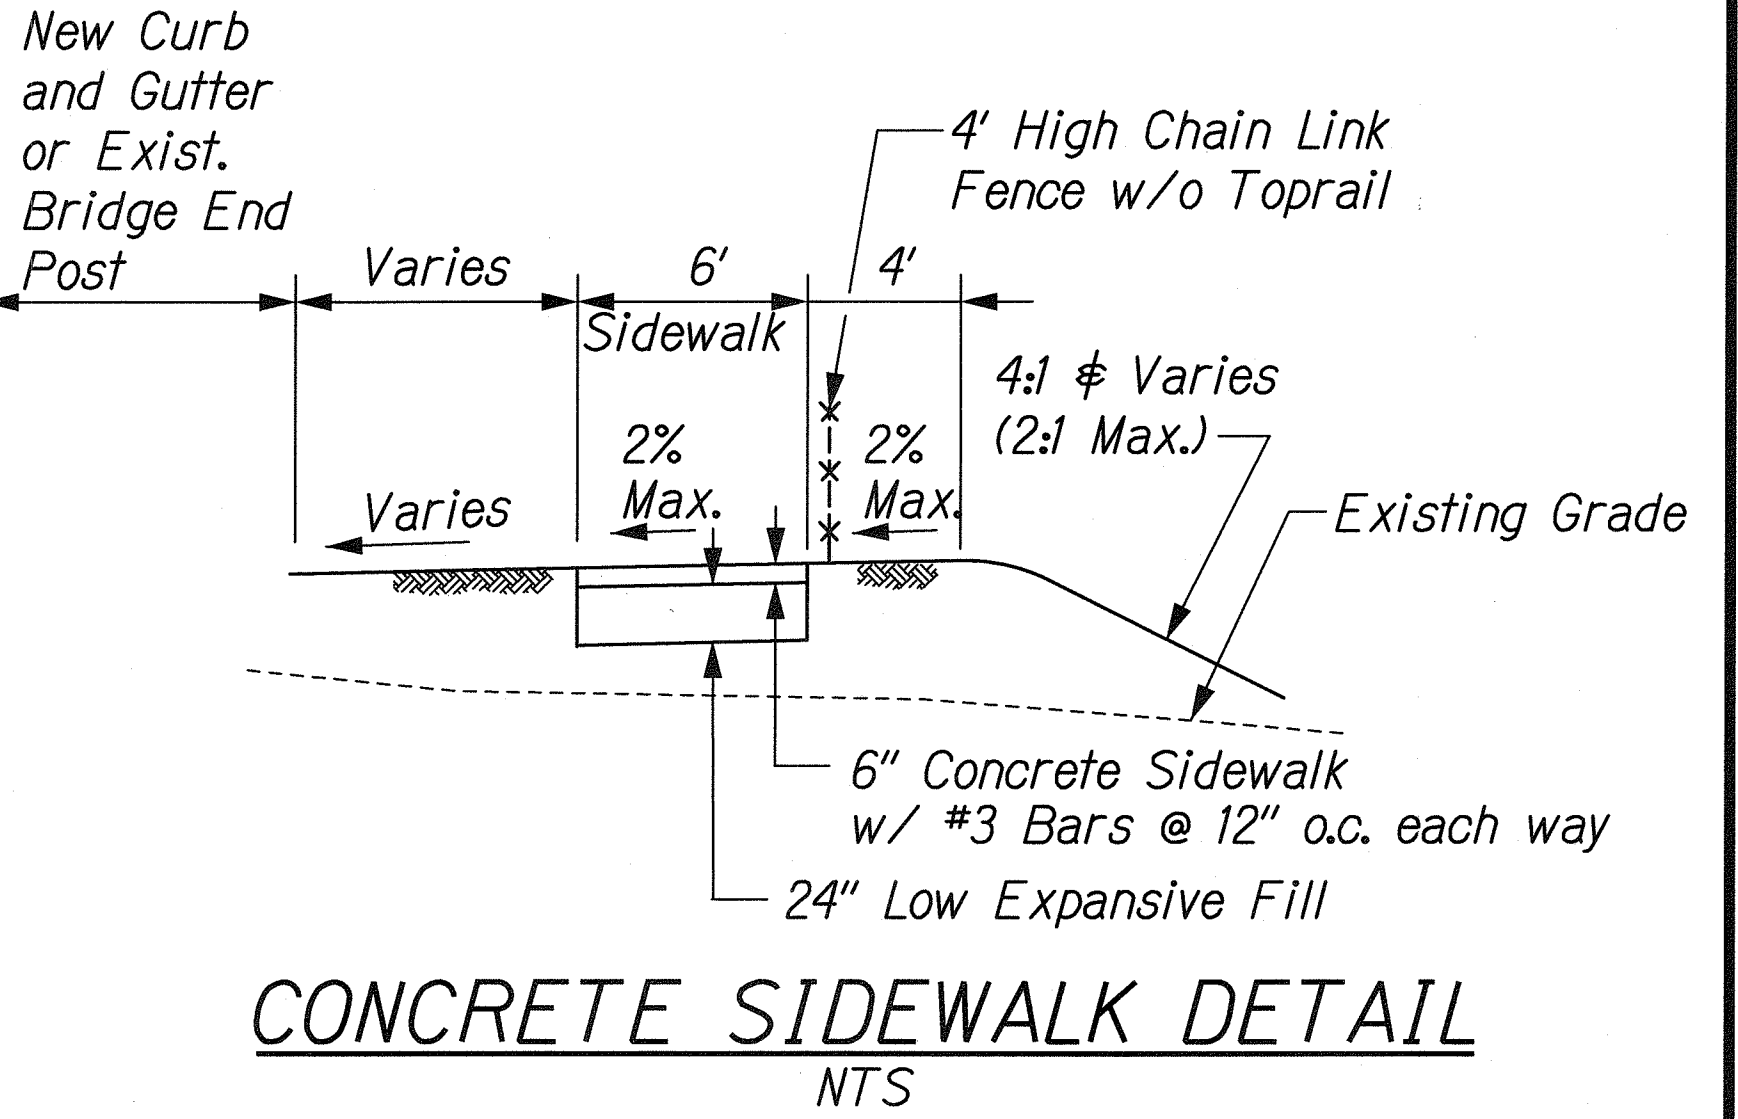
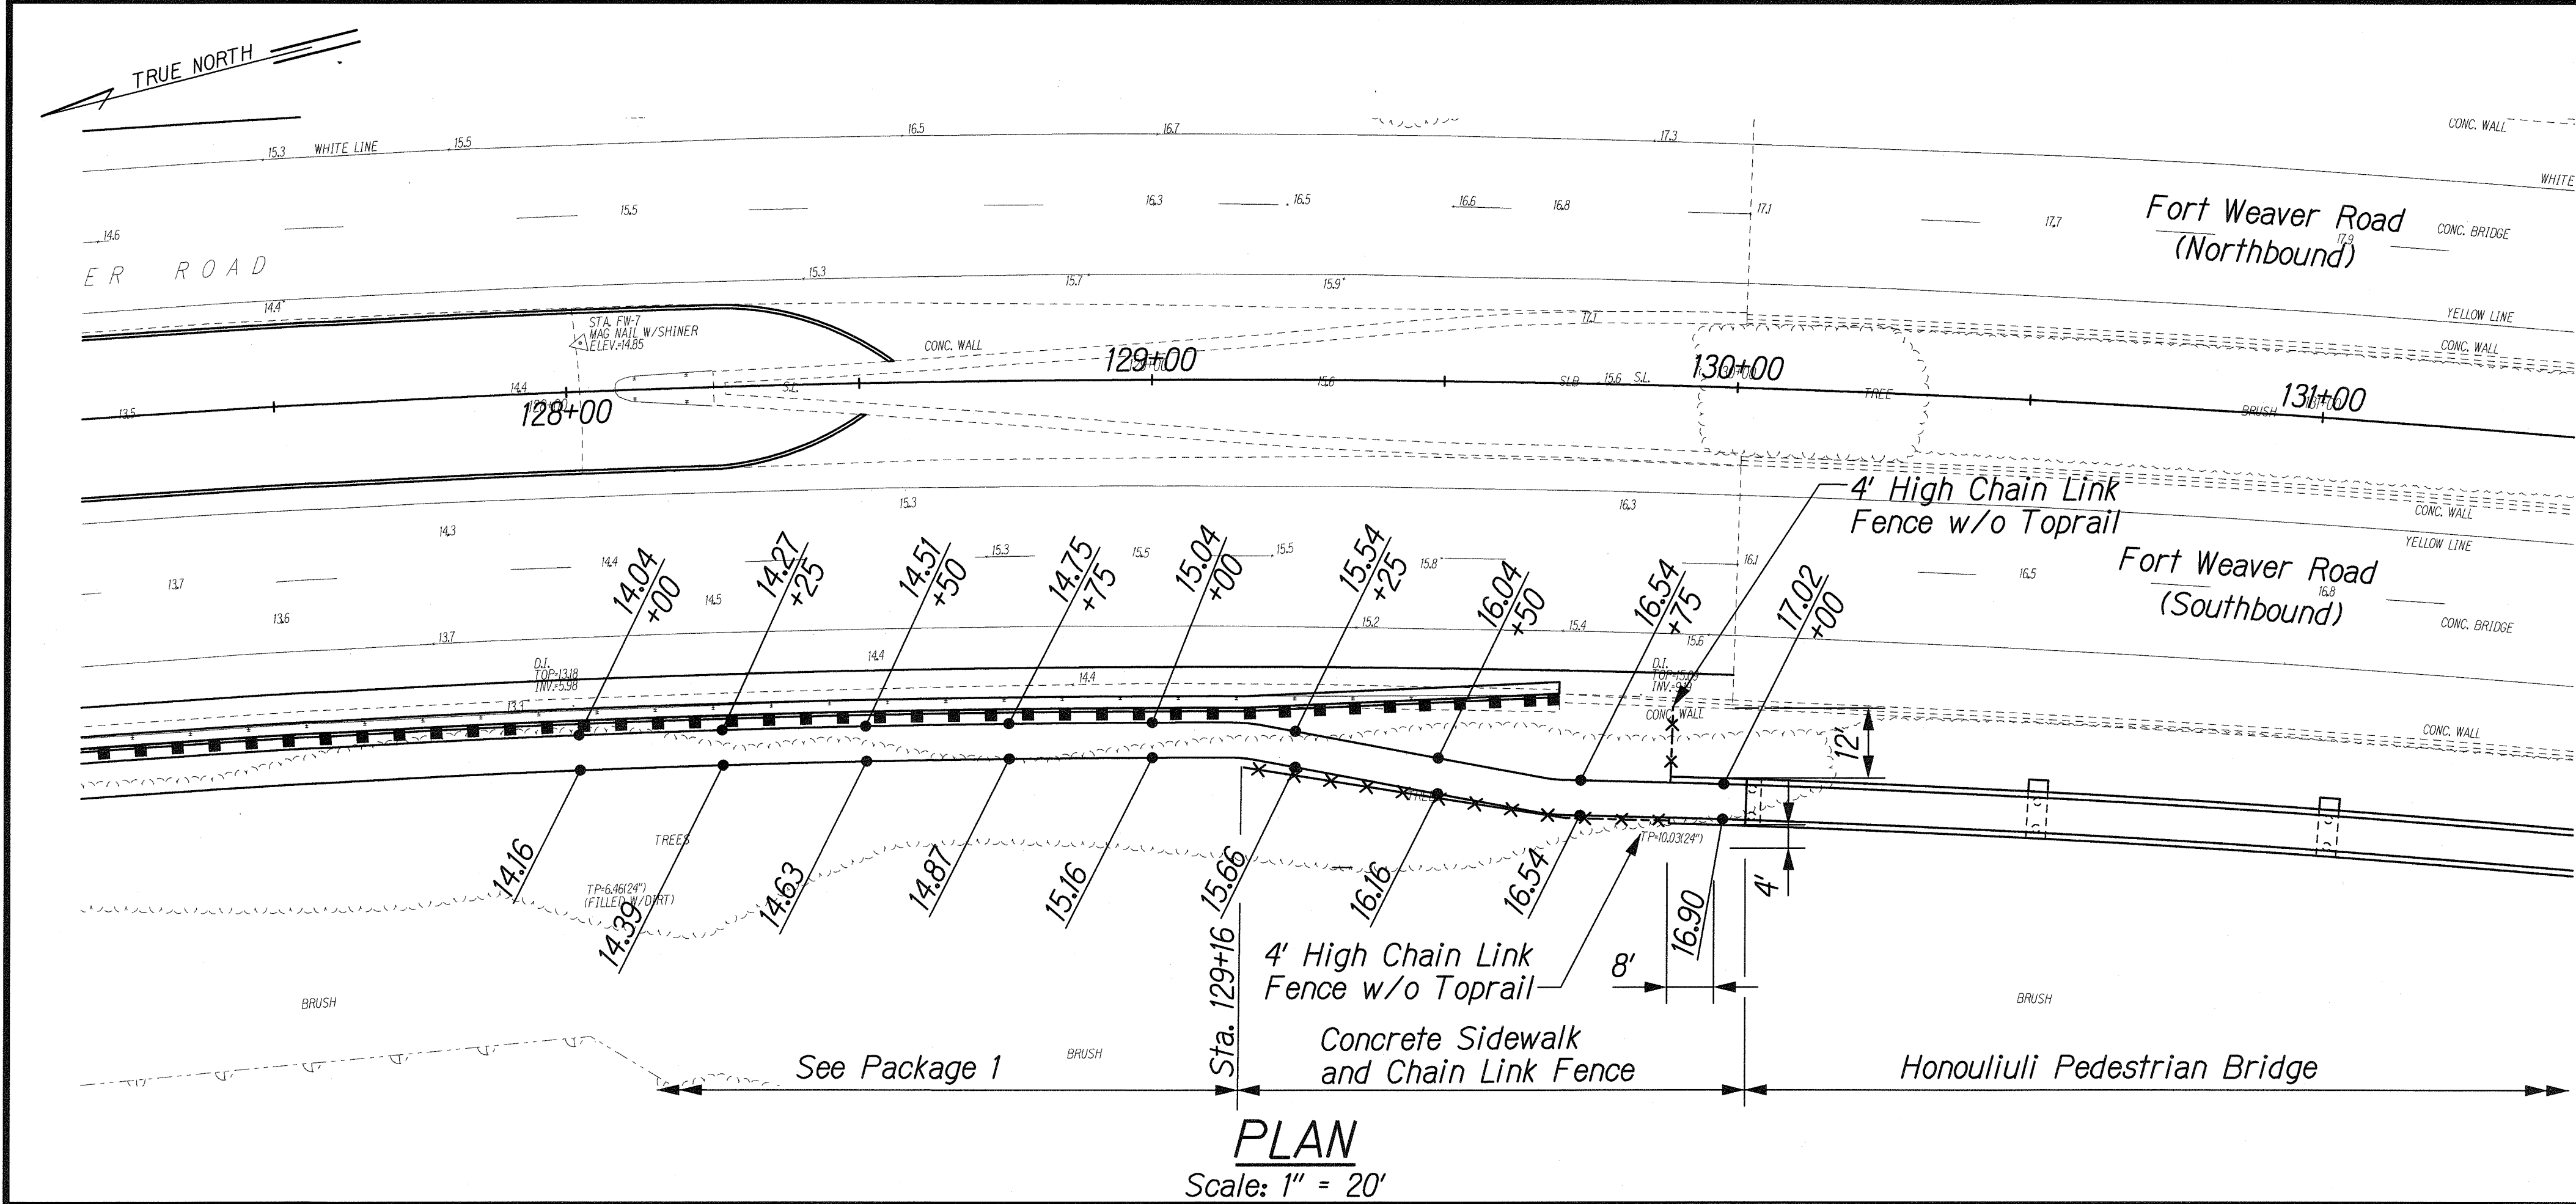


FED. ROAD DIST. NO.	STATE	FEDERAL AID PROJ. NO.	FISCAL YEAR	SHEET NO.	TOTAL SHEETS
HAWAII	HAW.	CMAQ-076-1(9)	2006	10	58

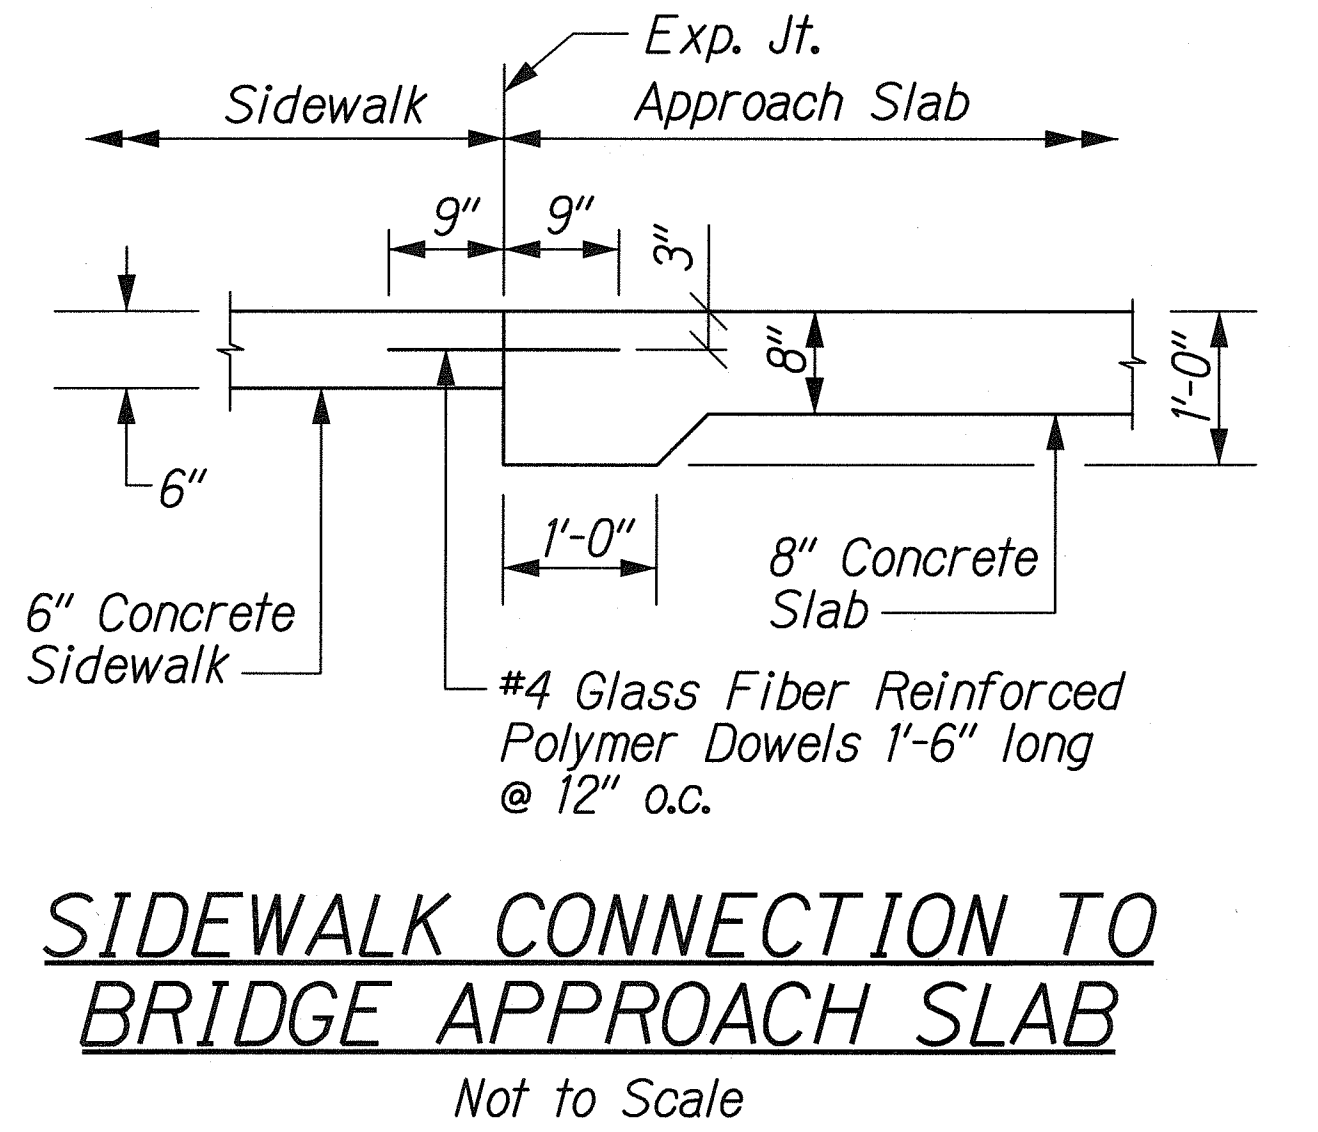

LEGEND FOR AS-BUILT POSTINGS

	Squiggly line for as-built deletion
	Double line for as-built deletion
Roadway	Text for as-built posting

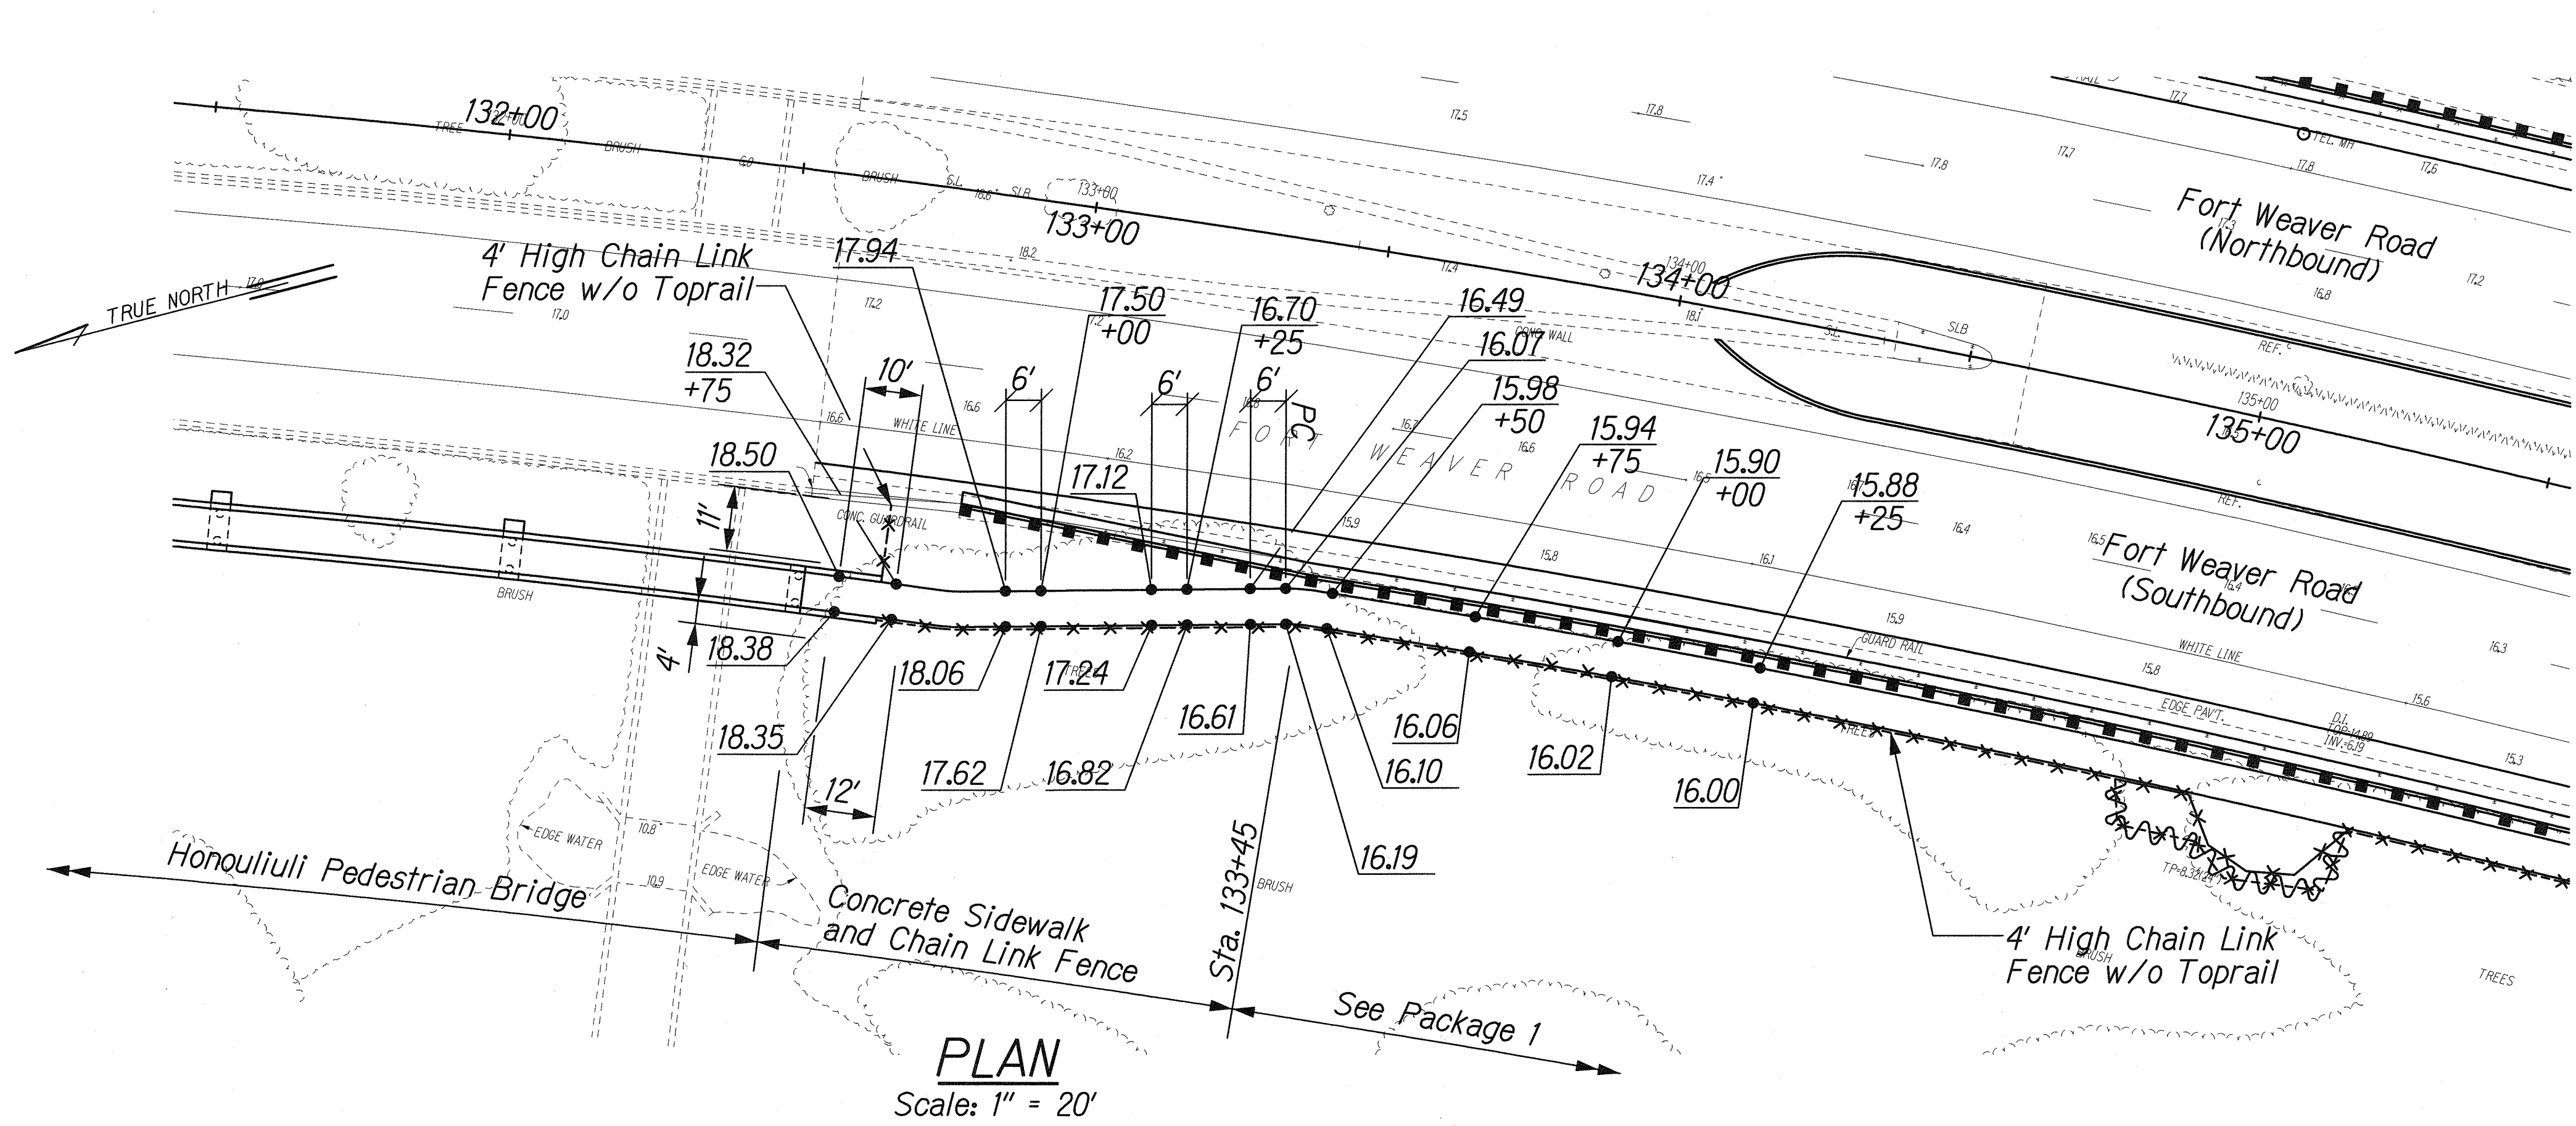

DATE: _____

SURVEY PLOTTED BY	_____
DRAWN BY	_____
NOTED BY	_____
CHECKED BY	_____

ORIGINAL PLAN

NOTE BOOK

N. _____

J:\FORT WEAVER ROAD\PACKAGE 3\ROAD-GRADING\spot_elev_d1.dgn

THIS WORK WAS PREPARED BY ME OR UNDER MY SUPERVISION

R. M. Urasani

STATE OF HAWAII
DEPARTMENT OF TRANSPORTATION
HIGHWAYS DIVISION

**SPOT ELEVATIONS
AT HONOUULIULI PED. BRIDGE**

FORT WEAVER ROAD WIDENING
VICINITY OF AAWA DRIVE TO GEIGER ROAD

Scale: 1"=20' Date: Feb. 29, 2008

SHEET No. R3-1 OF 2 SHEETS