


FED. ROAD DIST. NO.	STATE	FEDERAL AID PROJ. NO.	FISCAL YEAR	SHEET NO.	TOTAL SHEETS
HAWAII	HAW.	CMAQ-076-1(9)	2006	11	58

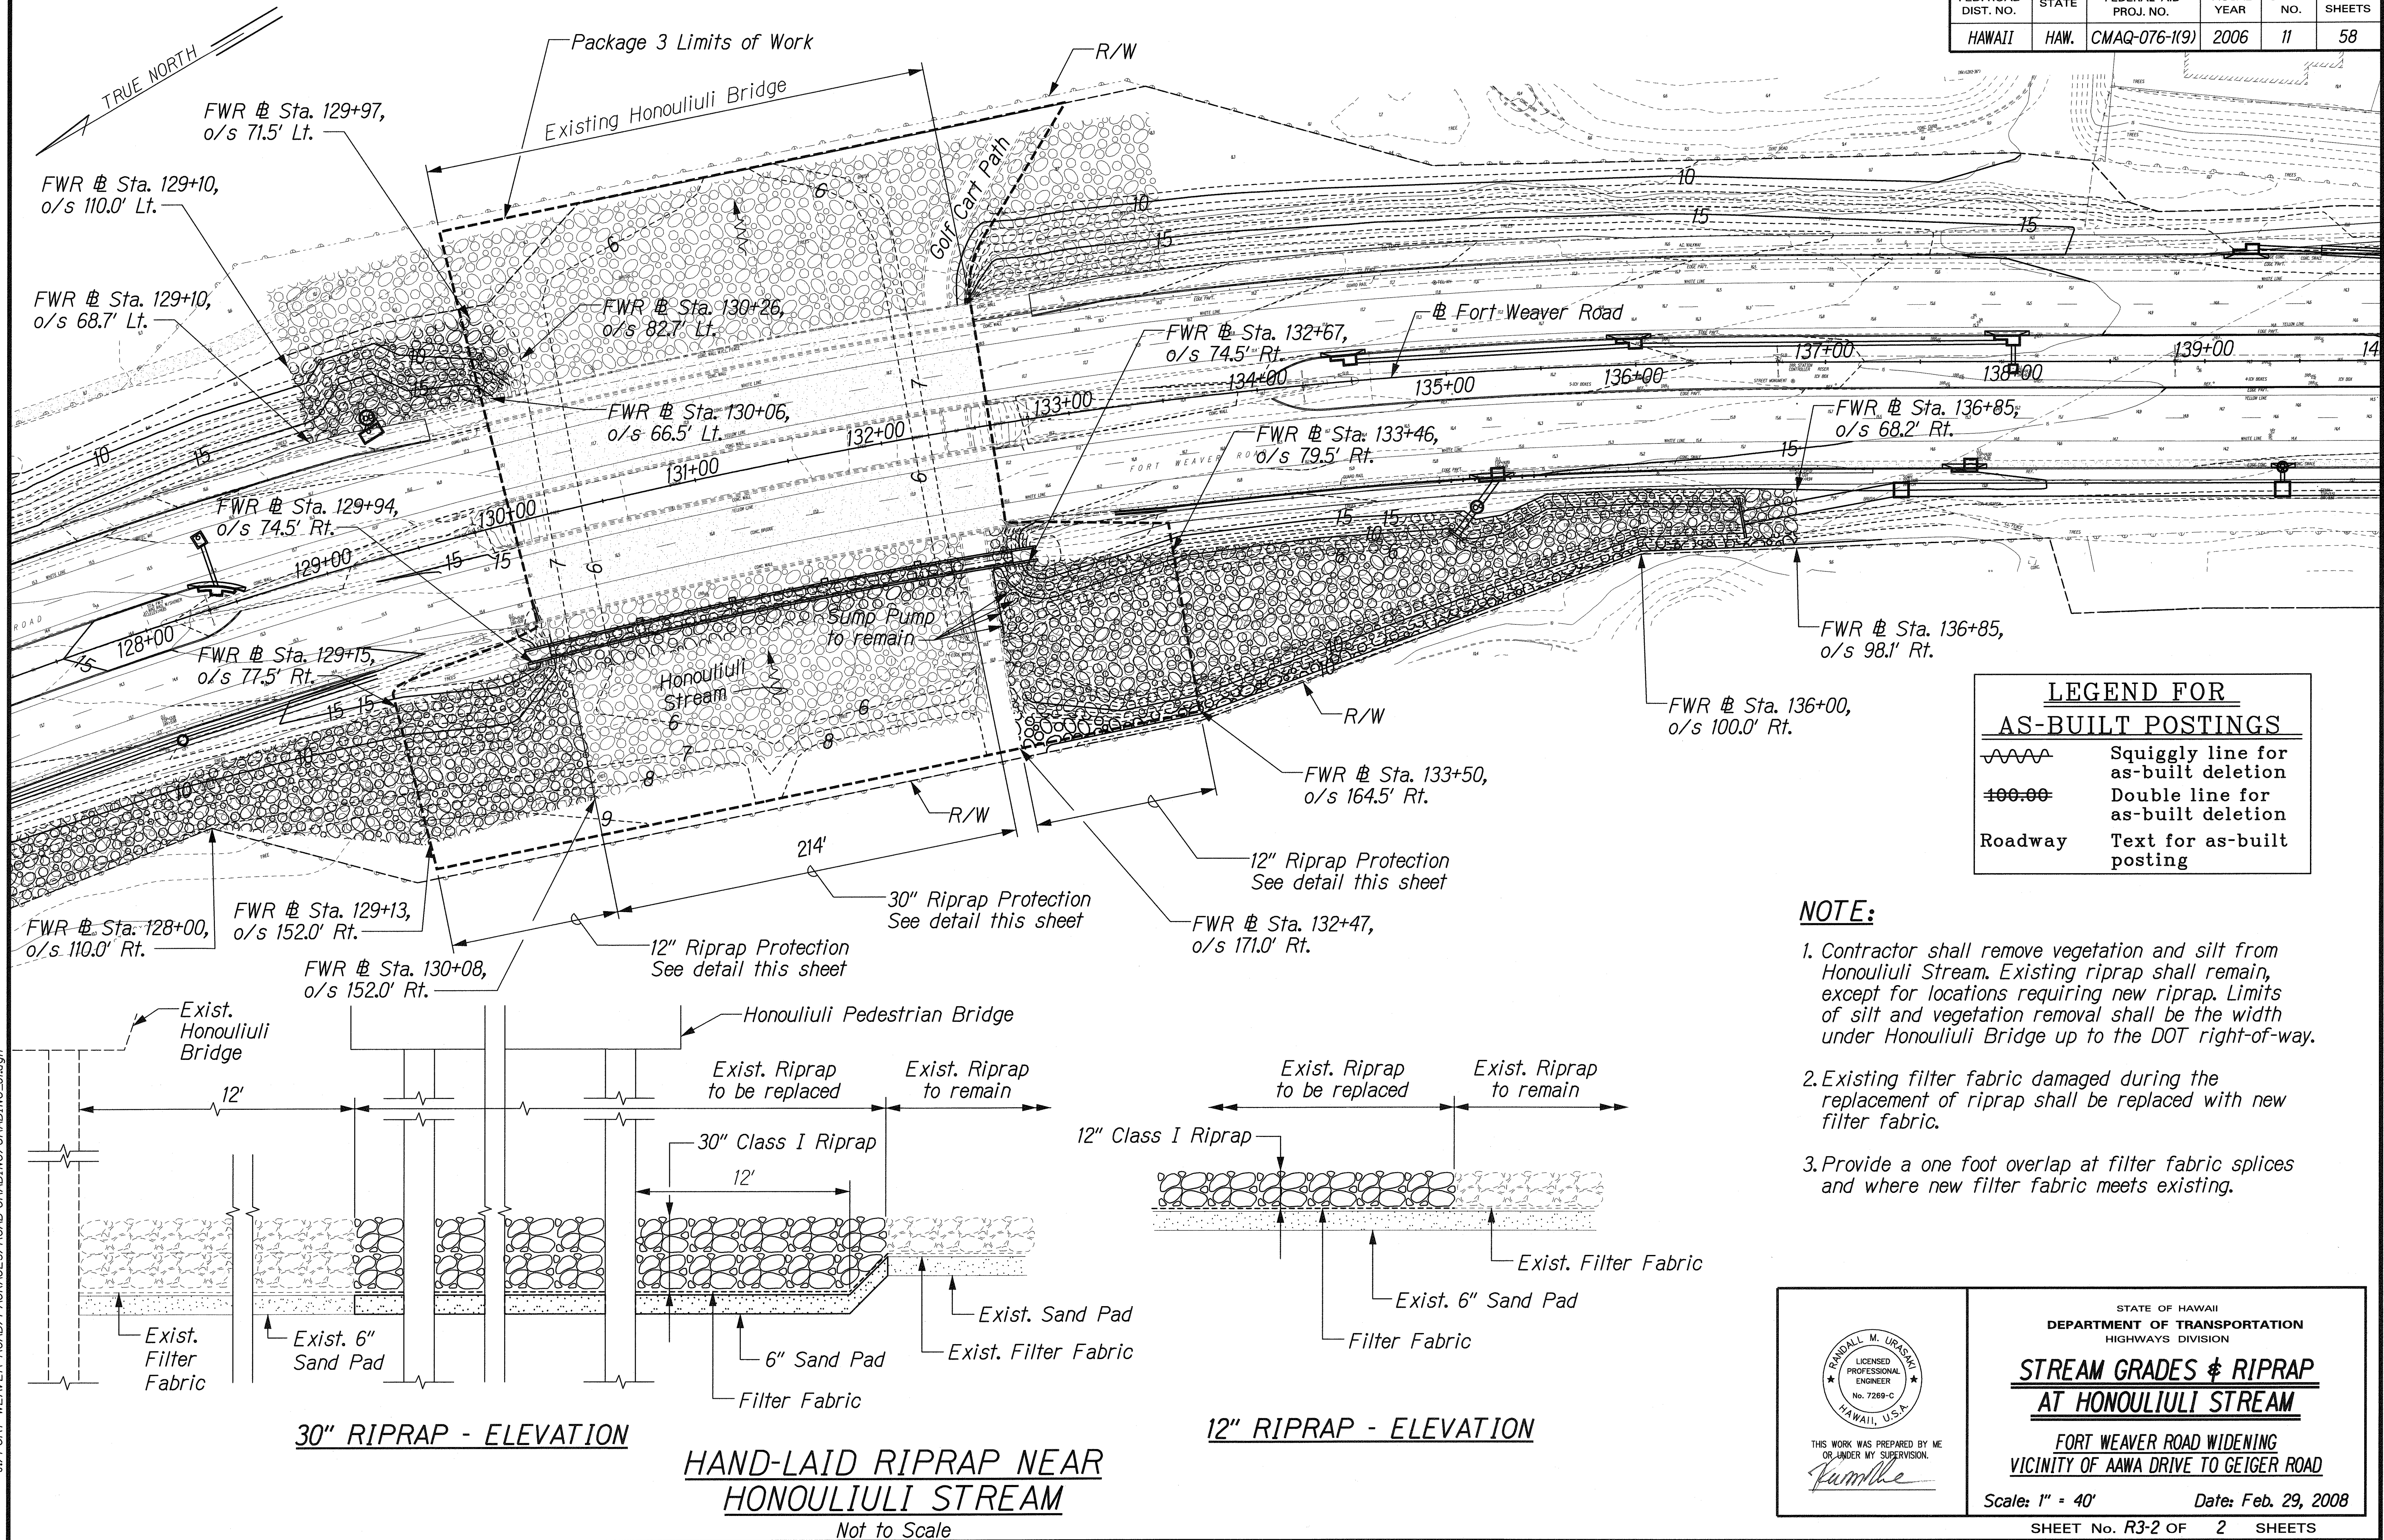

ORIGINAL PLAN	DATE
DRAWN BY	
DESIGNED BY	
CHECKED BY	
NO.	

J:\FORT WEAVER ROAD\PACKAGE3\ROAD-GRADING\GRADING.dgn

THIS WORK WAS PREPARED BY ME OR UNDER MY SUPERVISION.

Rumilke

STATE OF HAWAII
DEPARTMENT OF TRANSPORTATION
HIGHWAYS DIVISION

**STREAM GRADES & RIPRAP
AT HONOUILIULI STREAM**

FORT WEAVER ROAD WIDENING
VICINITY OF AWA DRIVE TO GEIGER ROAD

Scale: 1" = 40' Date: Feb. 29, 2008

SHEET No. R3-2 OF 2 SHEETS