
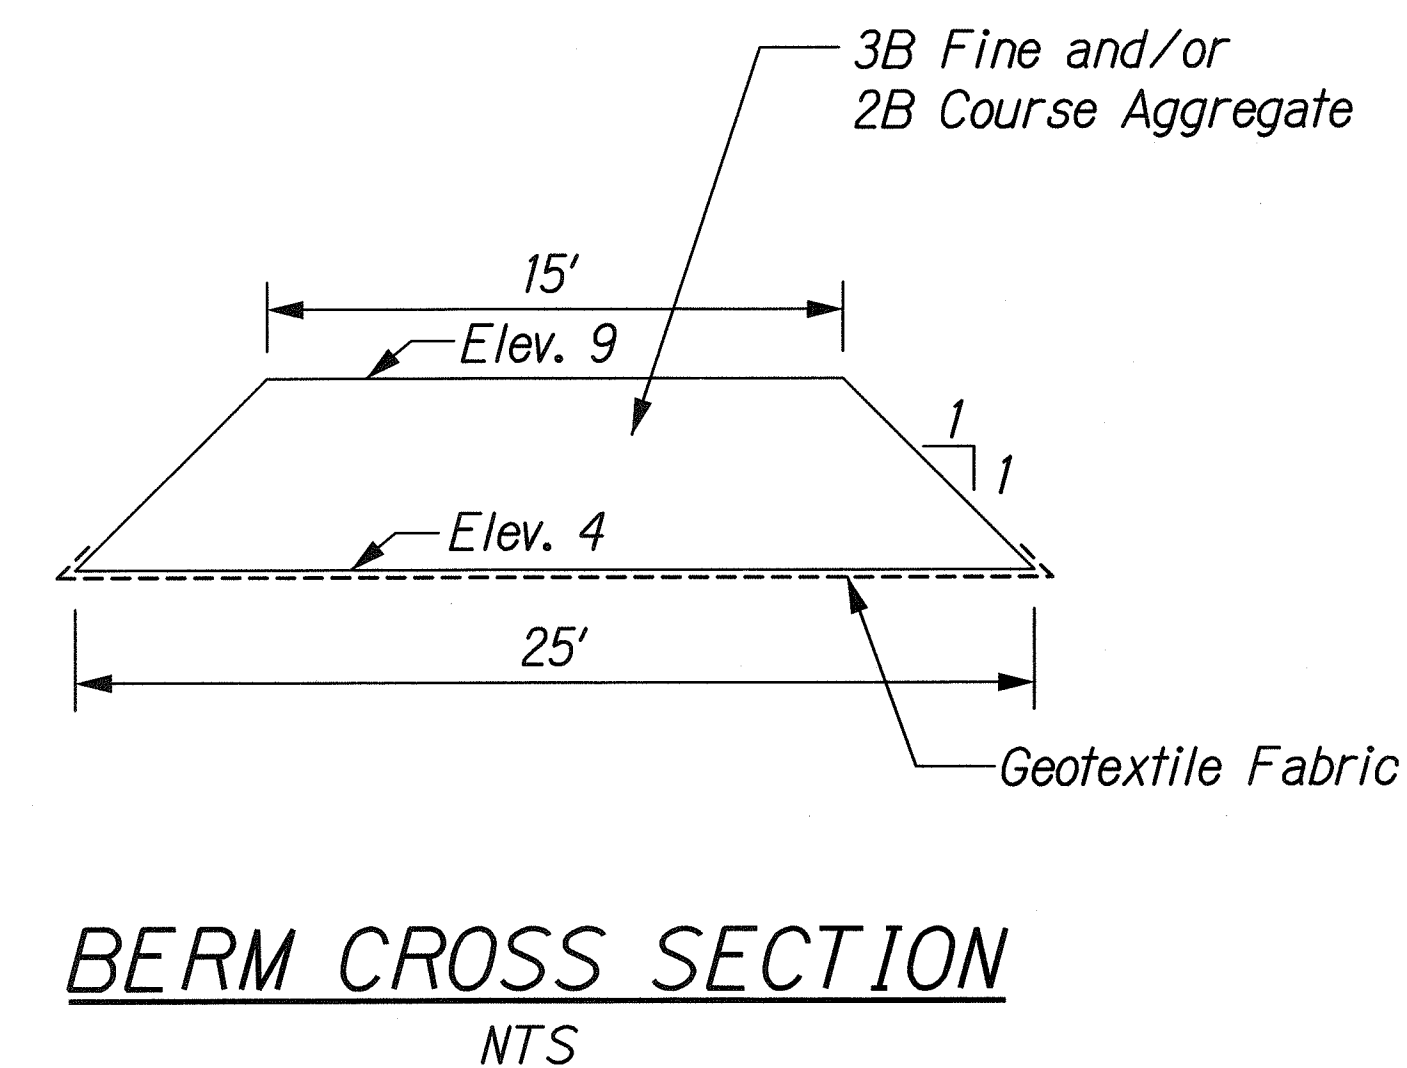
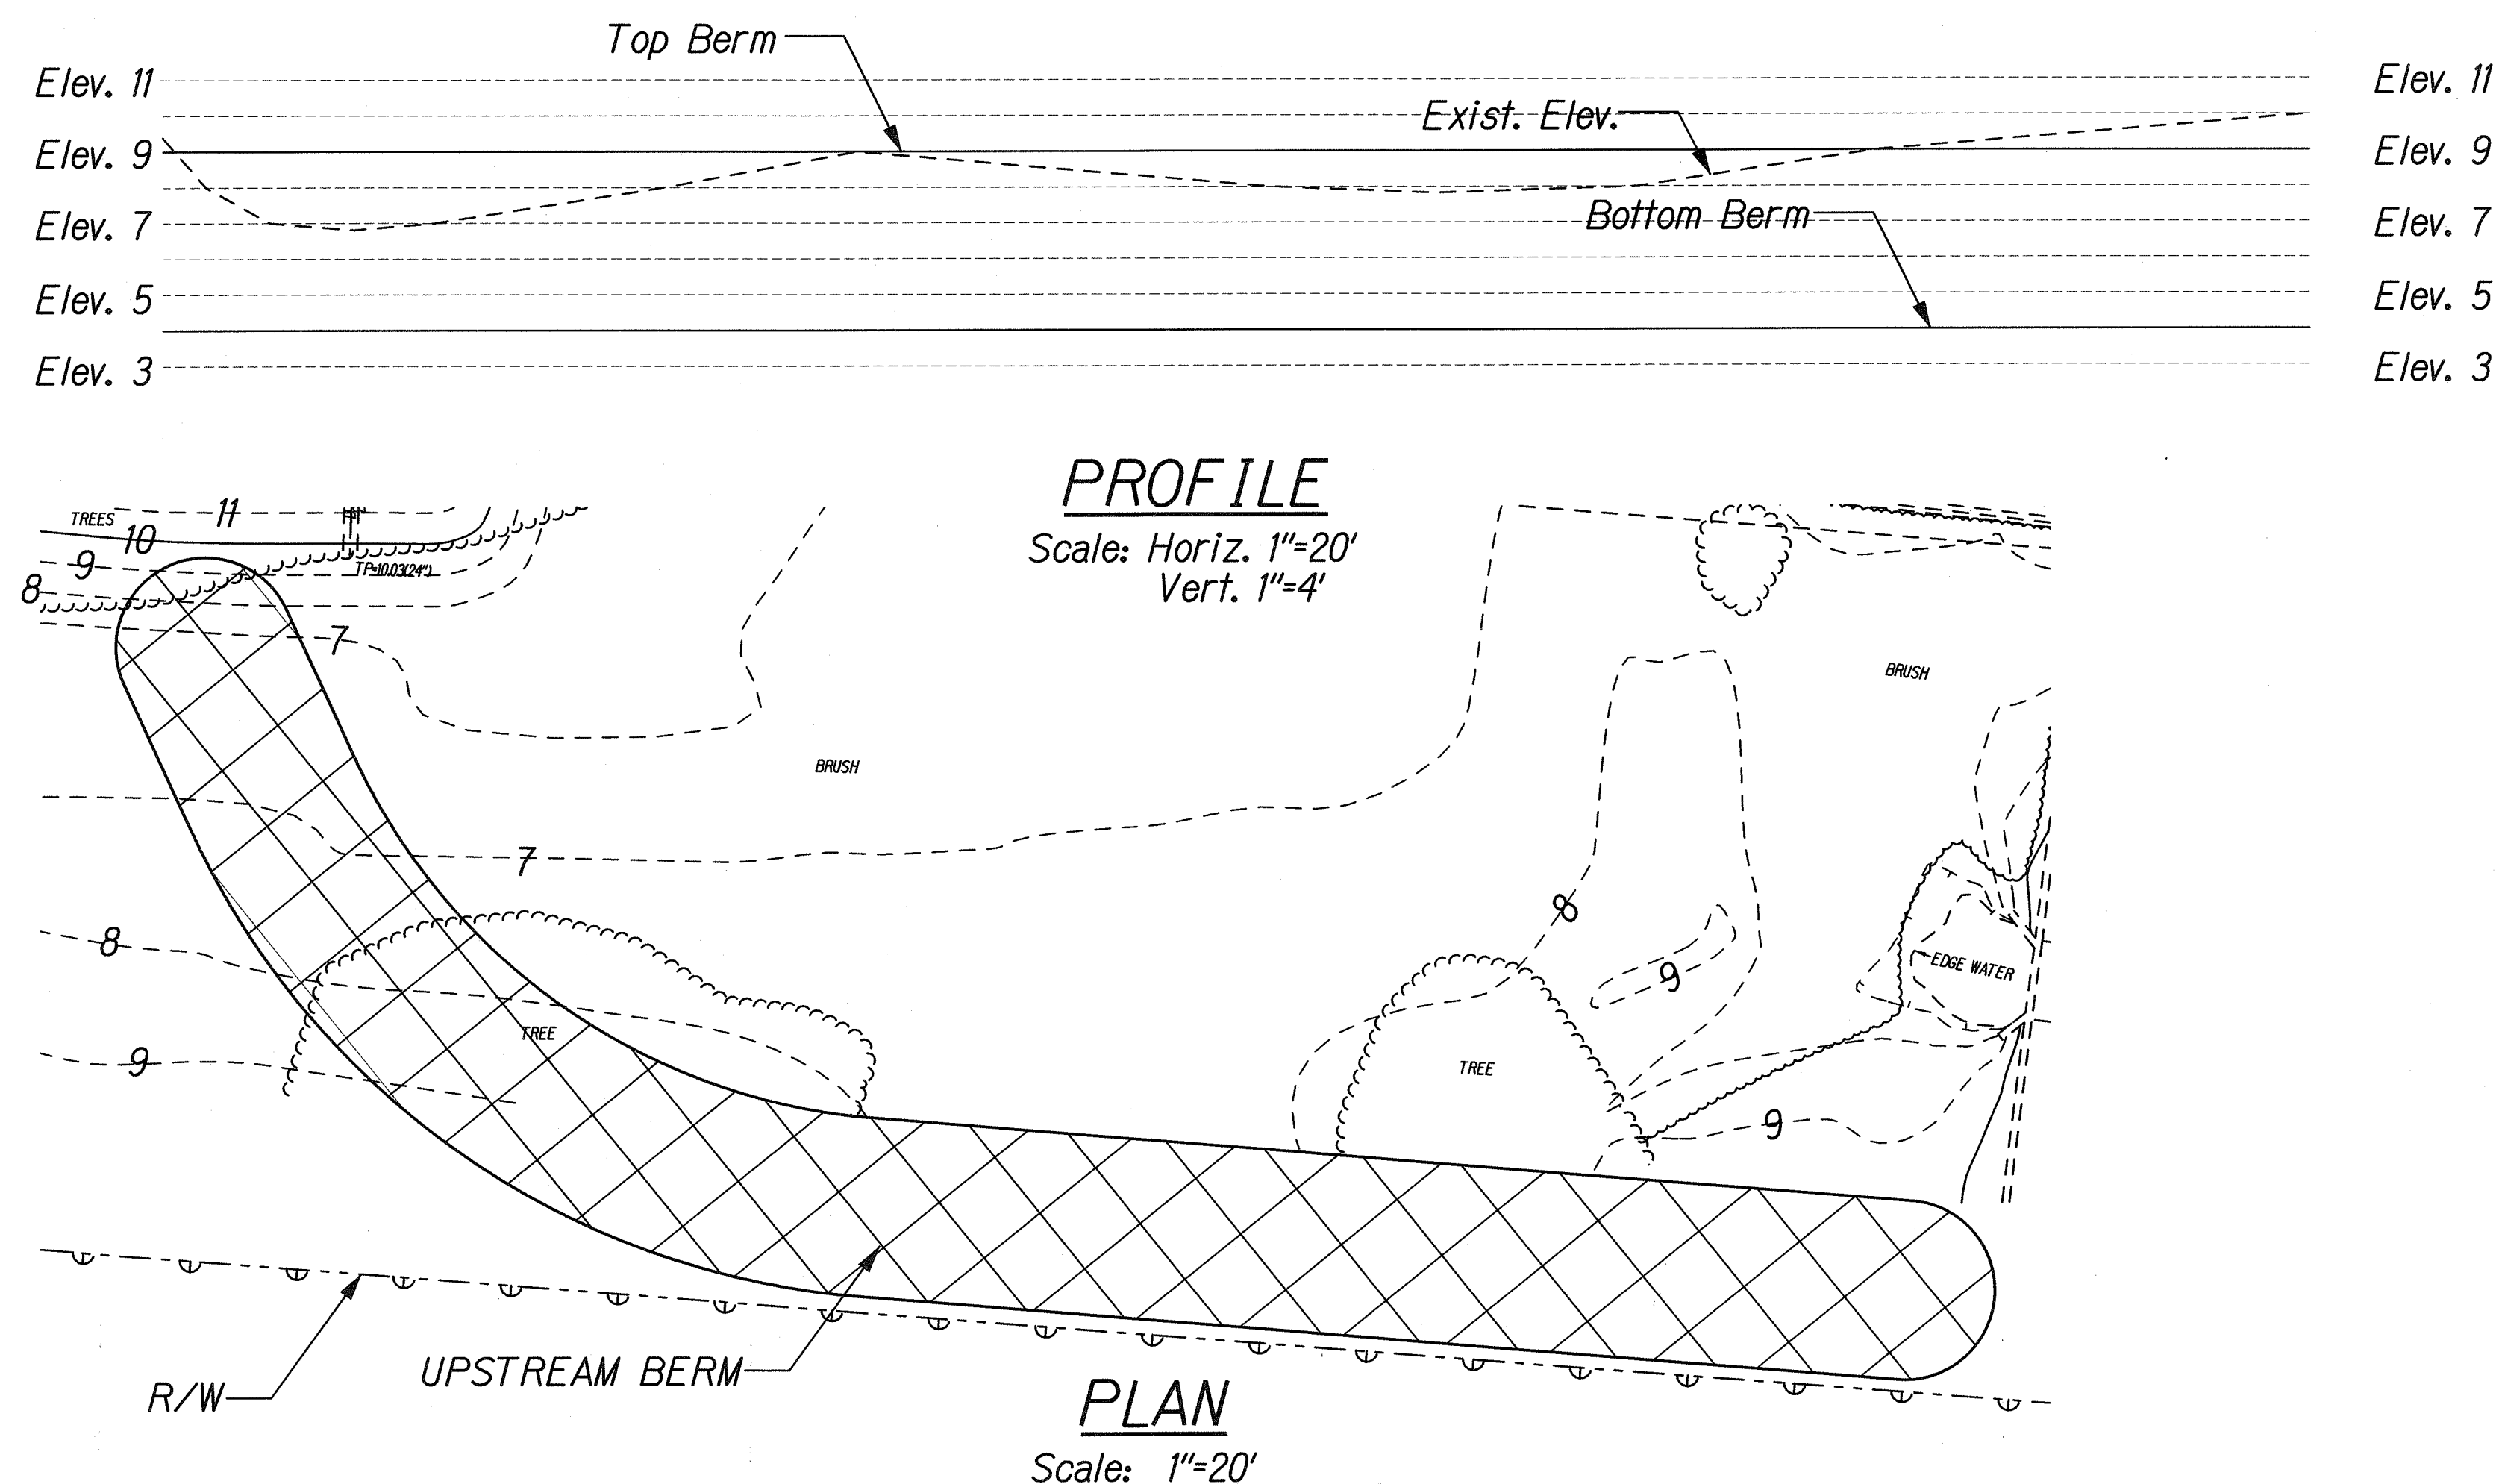
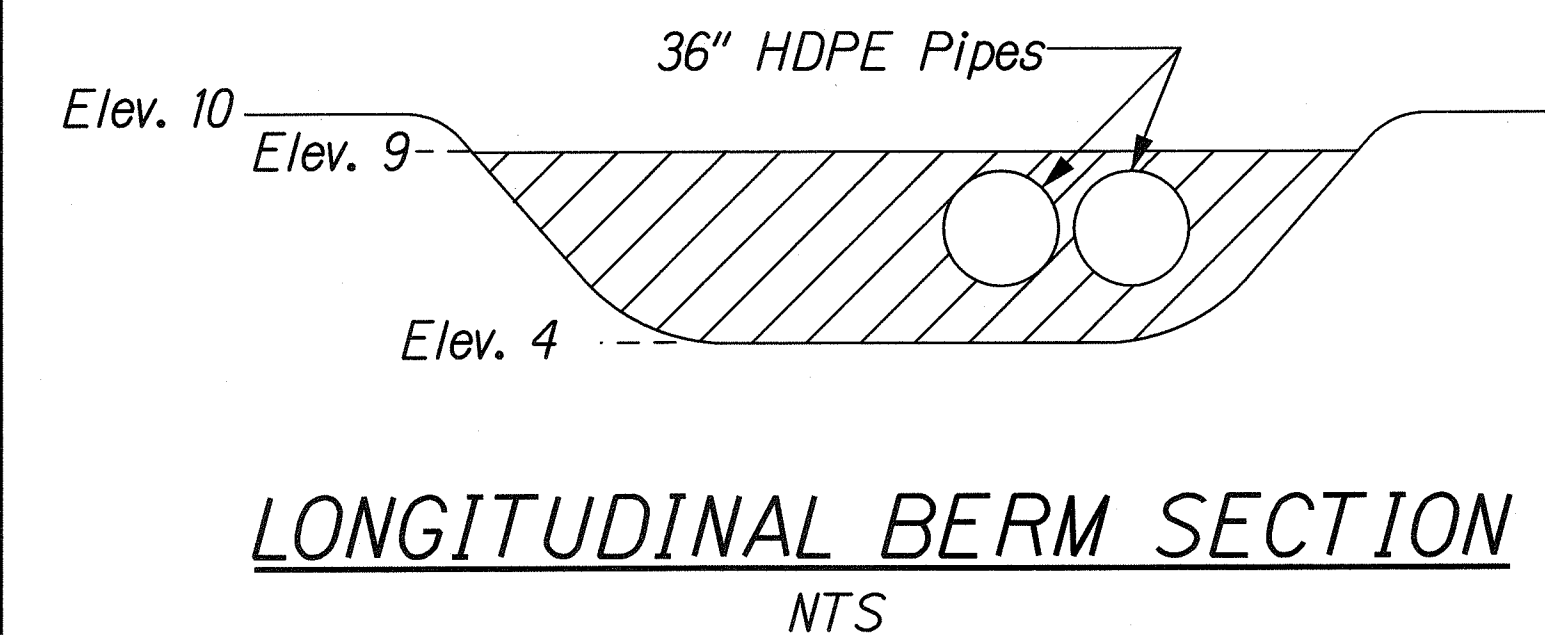


FED. ROAD DIST. NO.	STATE	FEDERAL AID PROJ. NO.	FISCAL YEAR	SHEET NO.	TOTAL SHEETS
HAWAII	HAW.	CMAQ-076-1(9)	2006	48	58

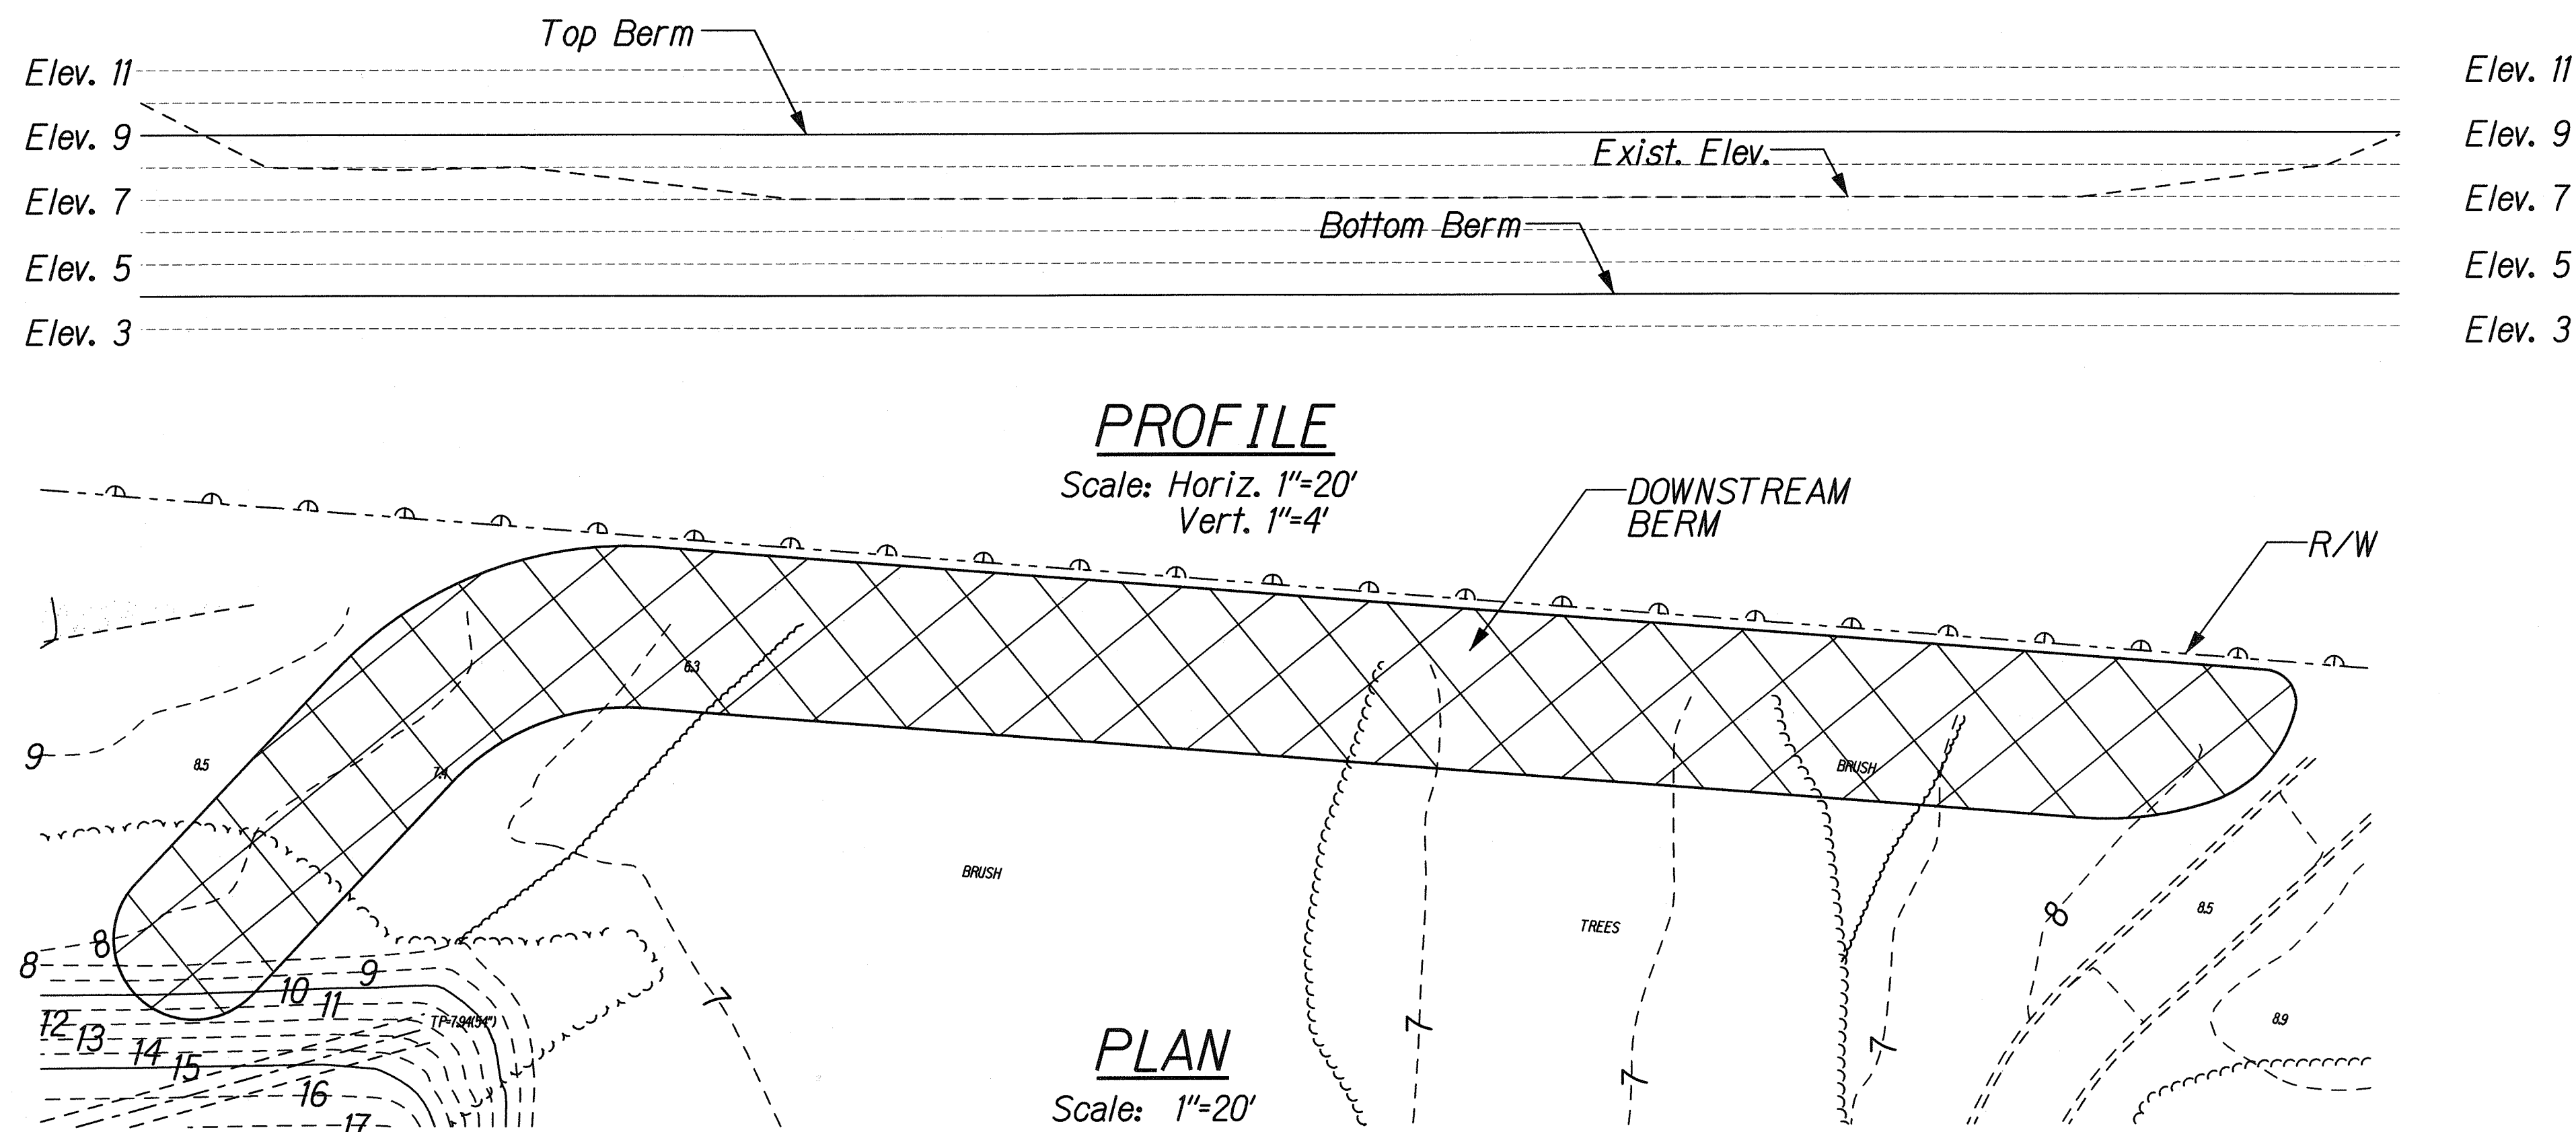

DESIGNED BY	DATE
TRACED BY	
NOTED BY	
CHECKED BY	
QUANTITIES BY	
NO.	

J:\FORT WEAVER ROAD\PACKAGE3\Misc\berm-profile.dgn

THIS WORK WAS PREPARED BY ME
OR UNDER MY SUPERVISION.

R. Urasmu

STATE OF HAWAII
DEPARTMENT OF TRANSPORTATION
HIGHWAYS DIVISION

**TEMPORARY BERMS
AT HONOLULI STREAM**

FORT WEAVER ROAD WIDENING
VICINITY OF AAWA DRIVE TO GEIGER ROAD

Scale: 1"=20' Date: Feb. 29, 2008