


FINAL SURVEY NOTE BOOK NO.	SURVEYED PLOTTED AREAS CHECKED	DATE
		BY

ORIGINAL SURVEY NOTE BOOK NO.	SURVEYED PLOTTED AREAS CHECKED	DATE
		BY

FED. ROAD DIST. NO.	STATE	FED. AID PROJ. NO.	FISCAL YEAR	SHEET NO.	TOTAL SHEETS
10000	MASSACHUSETTS	10000	1944	12	100

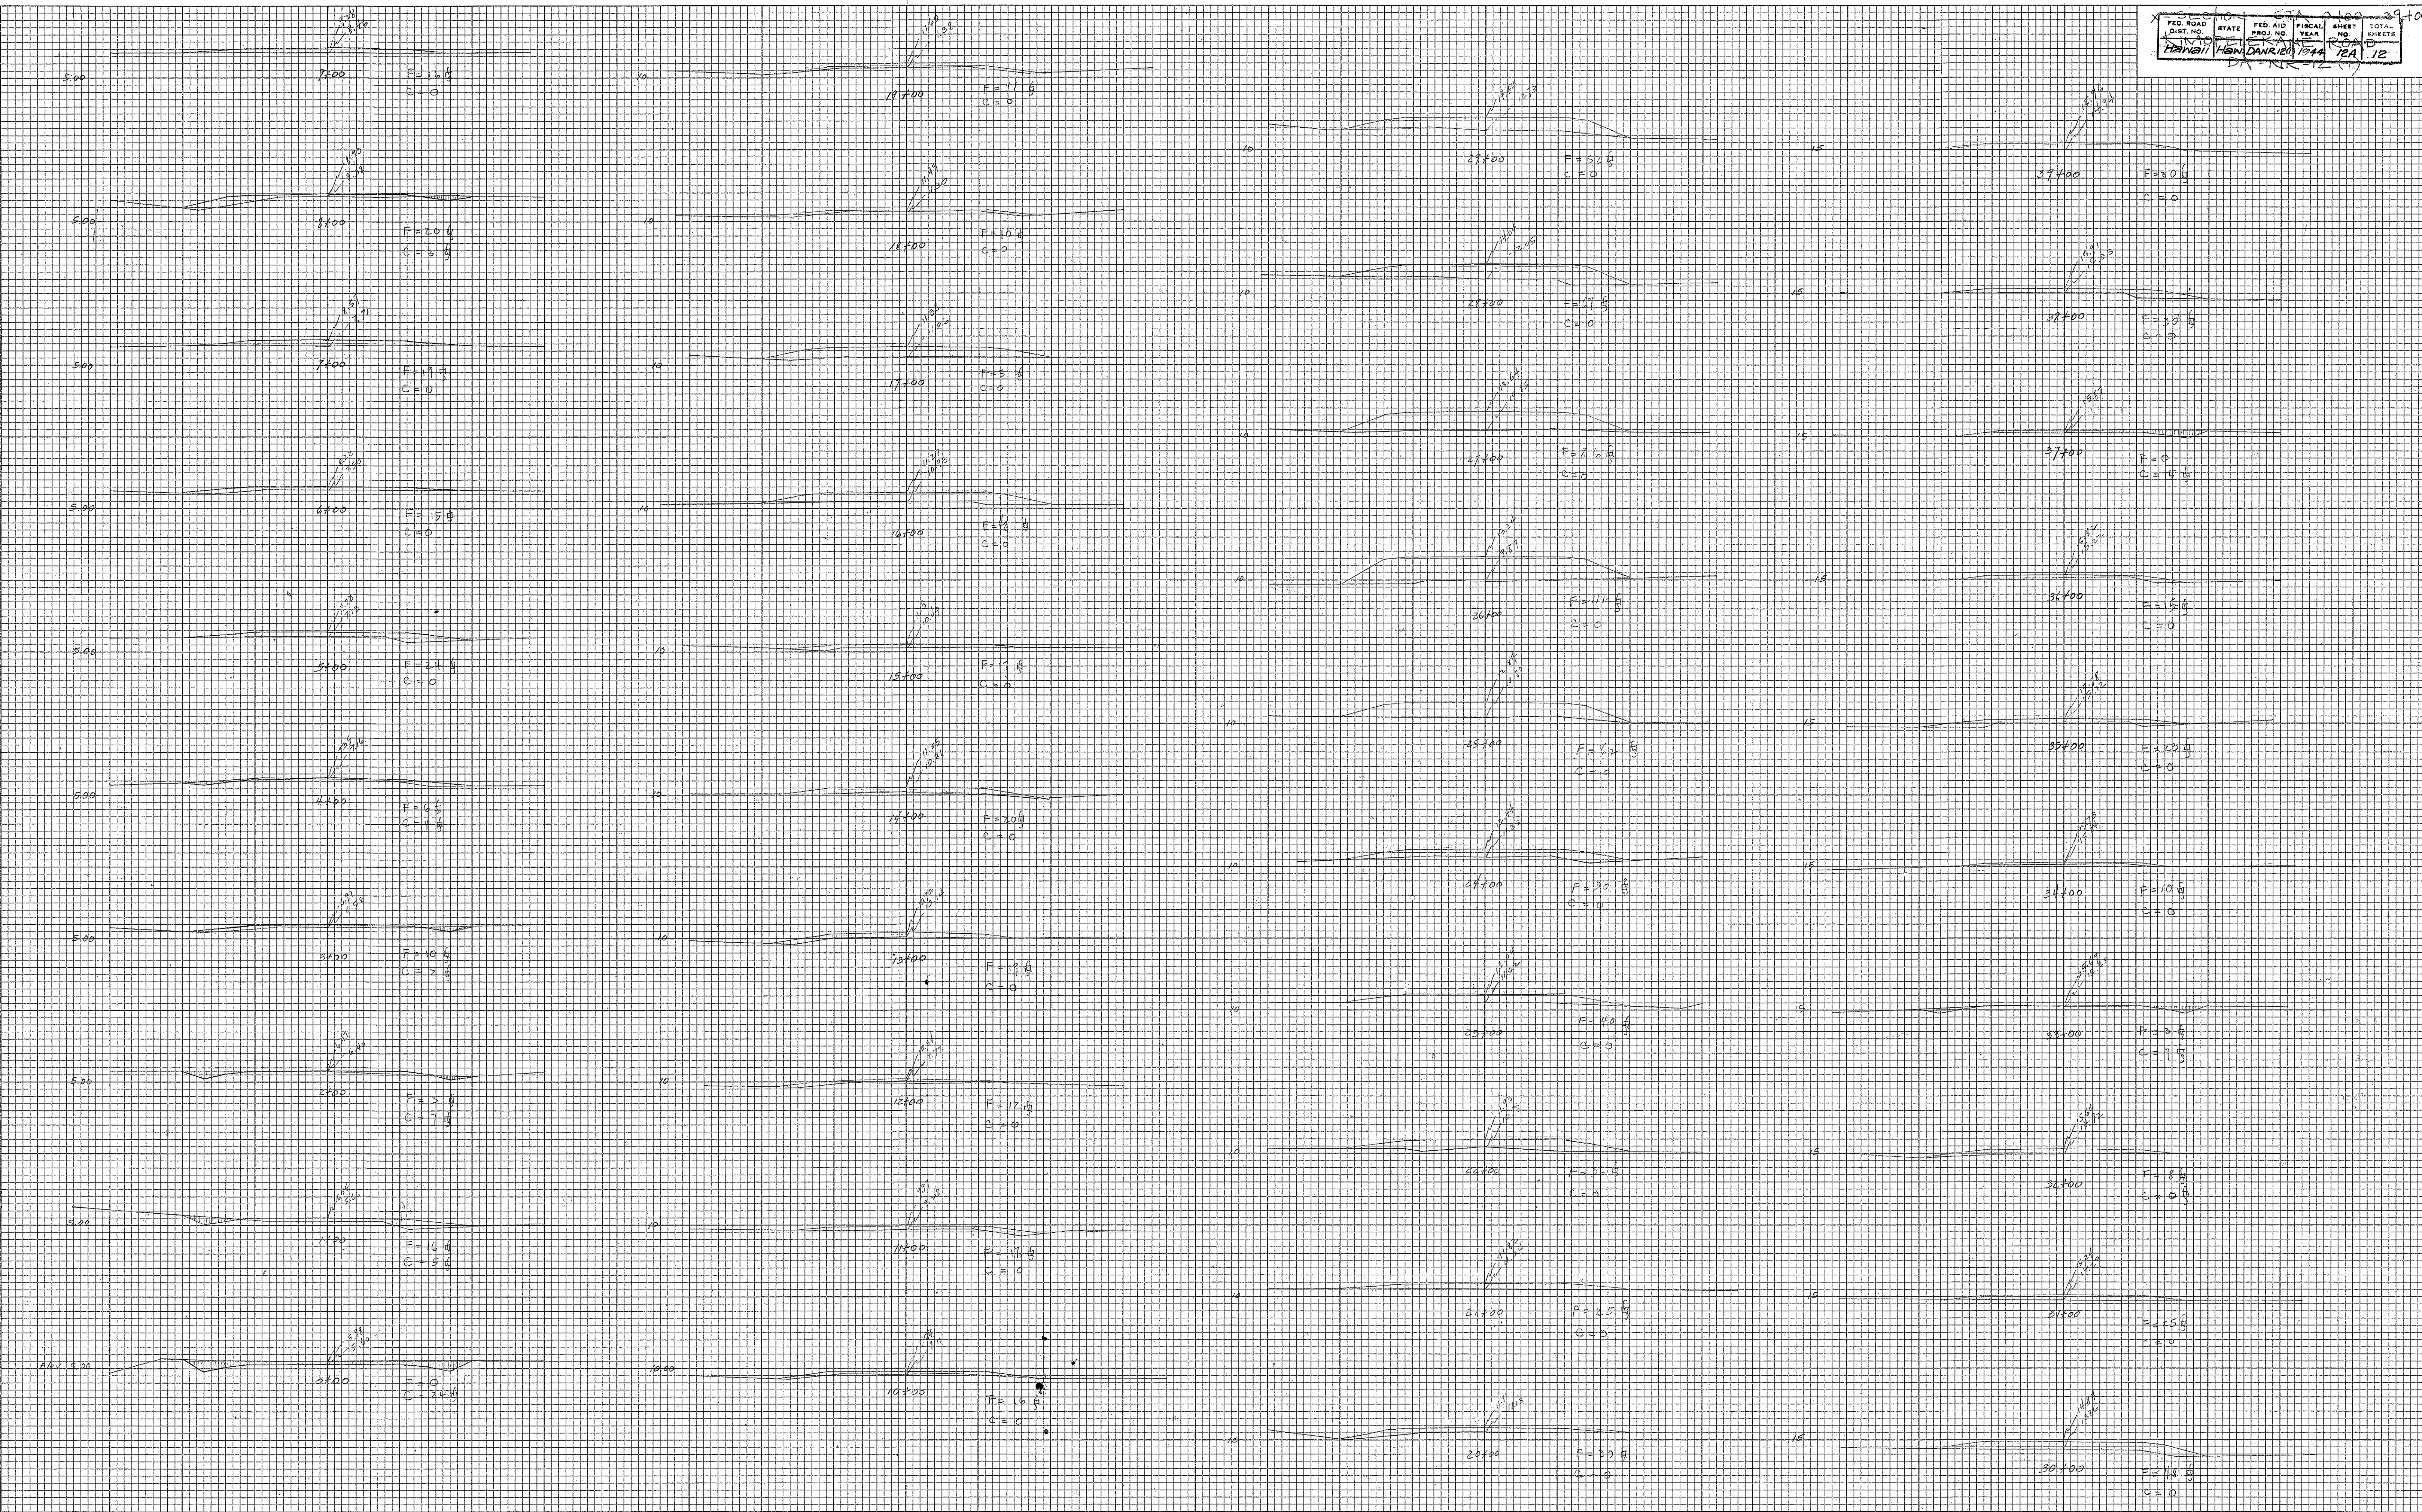


5133.12 AD
These X Sect. sheets incorporated as part of
plans - A-1/44

FINAL SURVEY	BY	DATE
NO.		SURVEYED
		PLOTTED
		TEMPLATE
		AREAS CHECKED

ORIGINAL SURVEY	BY	DATE
NO.		SURVEYED
		PLOTTED
		TEMPLATE
		AREAS CHECKED

X-SECTION		STATE		PROJ. NO.		YEAR		NO.		SHEETS	
HARBOR		HARBOR		1944		1944		12B		12	

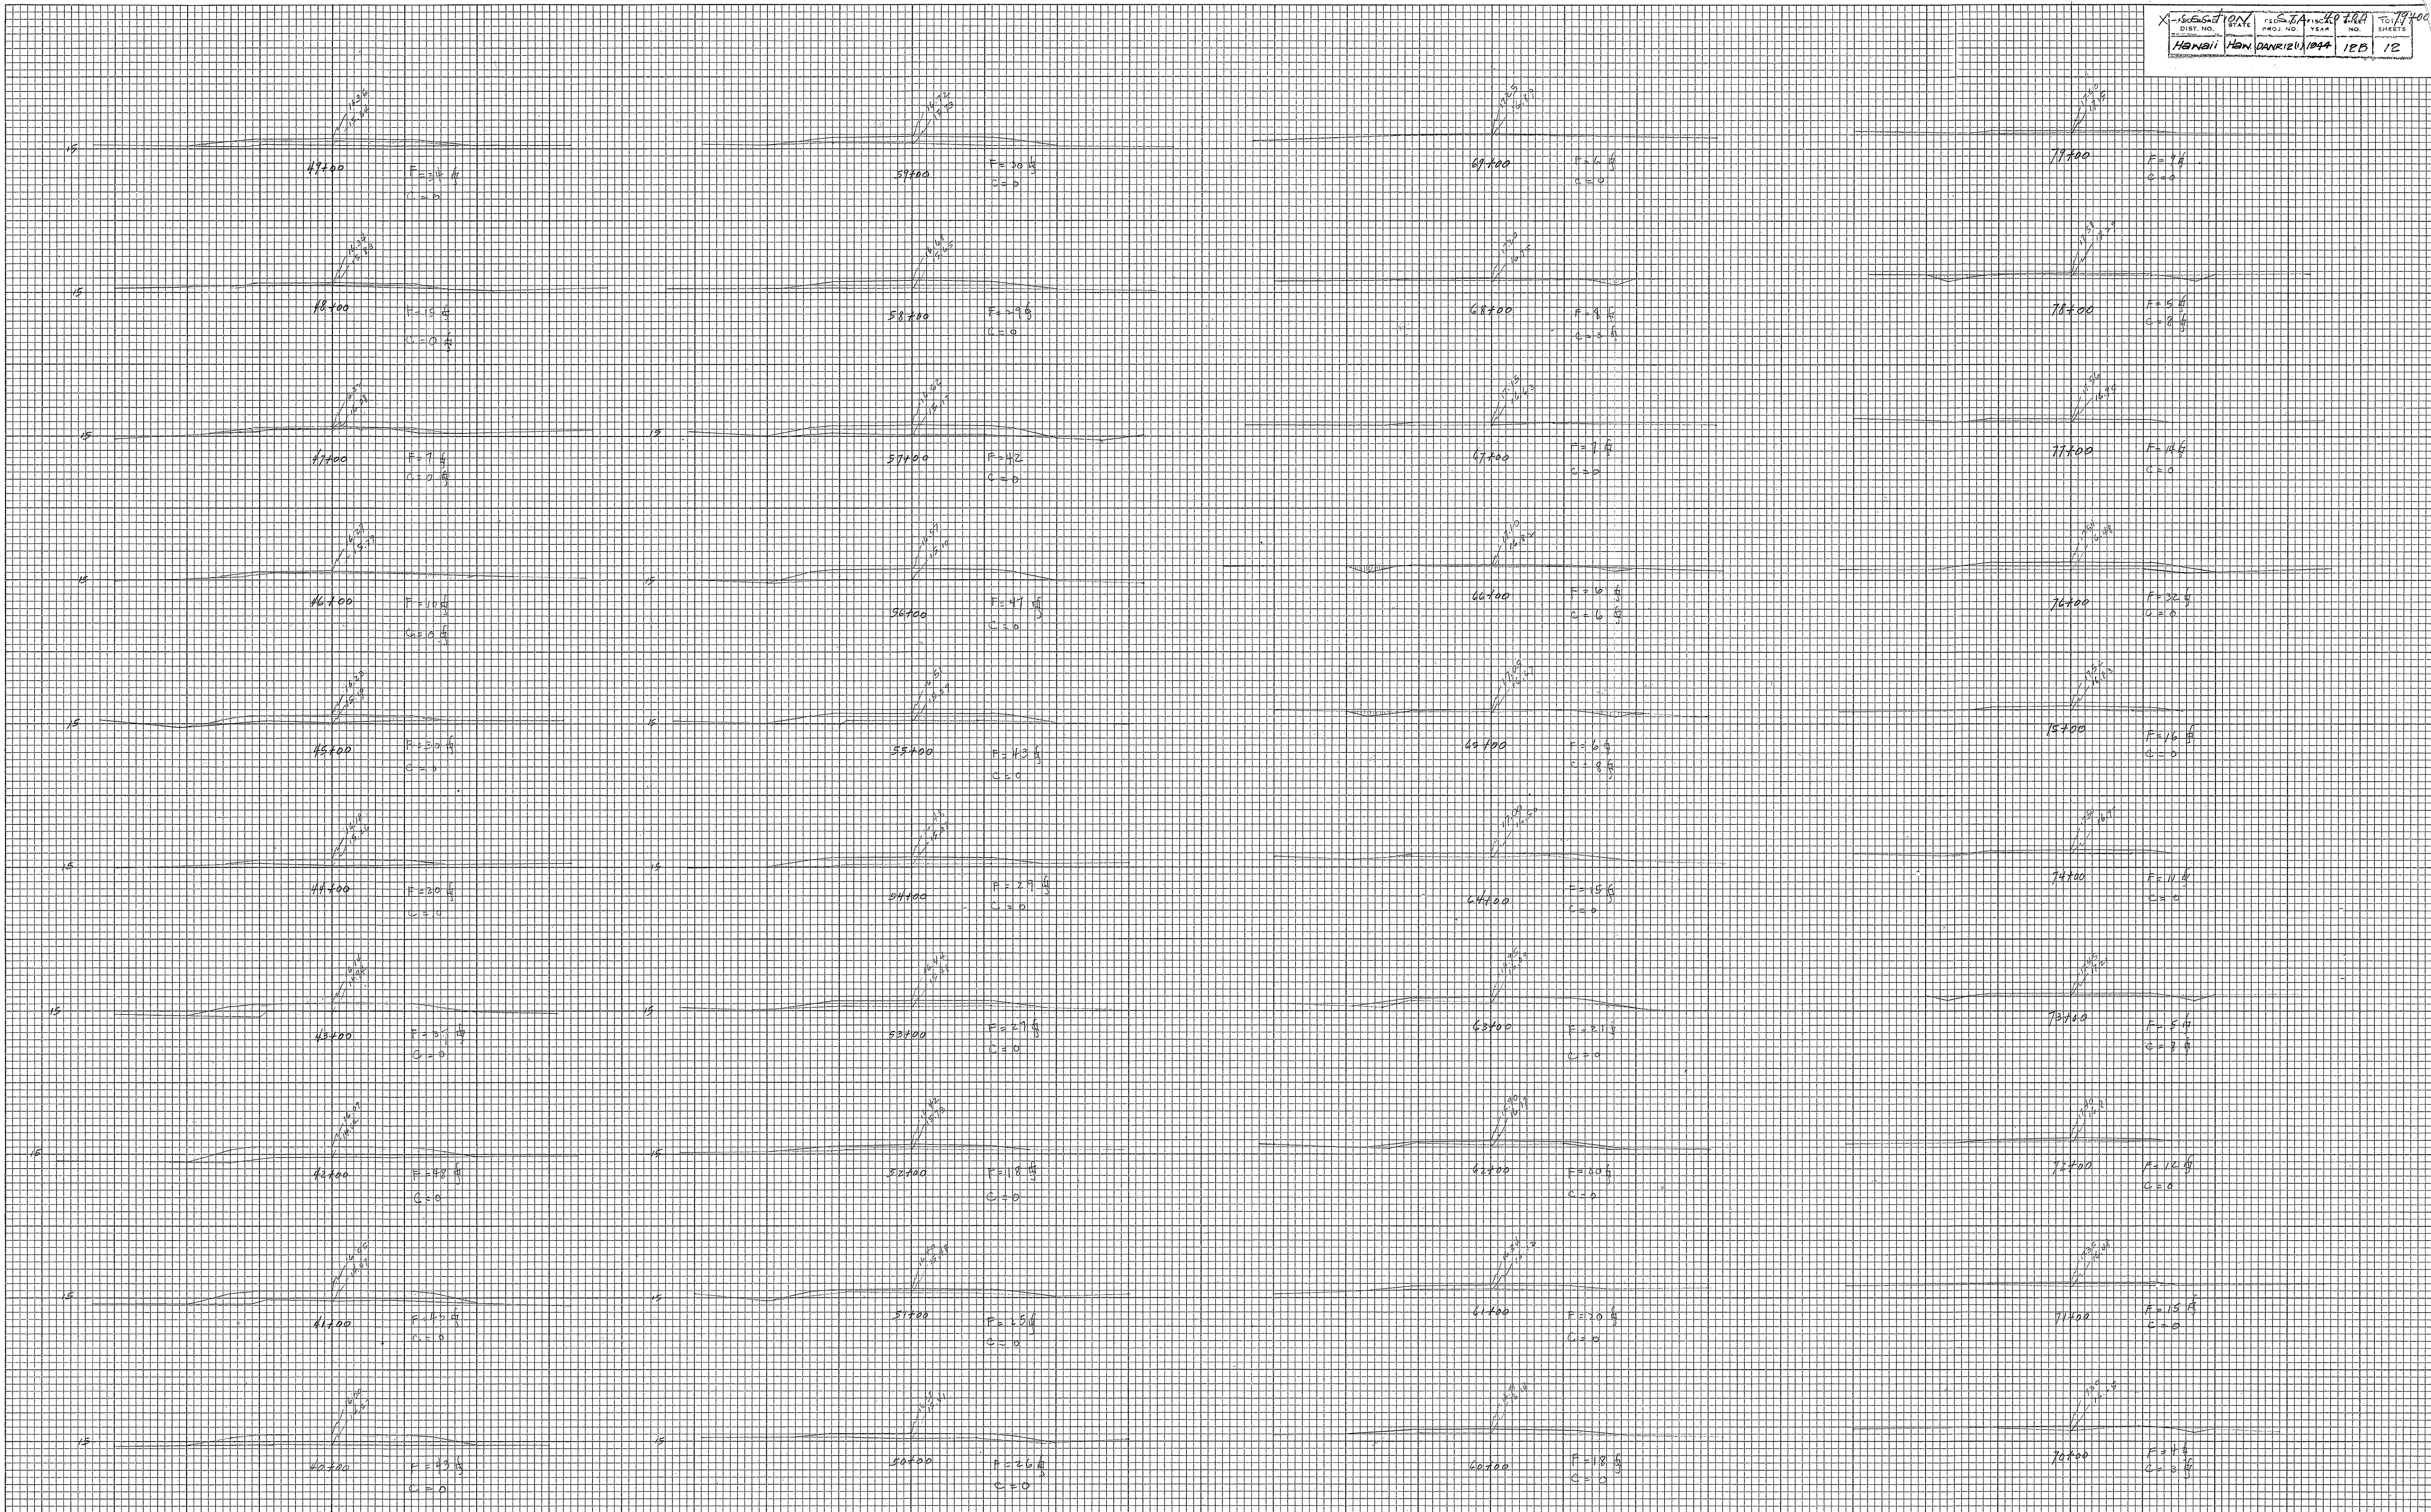


5133.12B

FINAL SURVEY	BY	DATE	SURVEYED	PLOTTED	DATE
			NOTE BOOK	TEMPLATE	
			NO.		
			AREAS CHECKED		

ORIGINAL SURVEY	BY	DATE	SURVEYED	PLOTTED	DATE
			NOTE BOOK	TEMPLATE	
			NO.		
			AREAS CHECKED		

DIST. NO. 30100
 STATE HAWAII
 PROJECT NO. 12
 YEAR 1944
 SHEET 12
 X SECTION 30100 TO 117+00

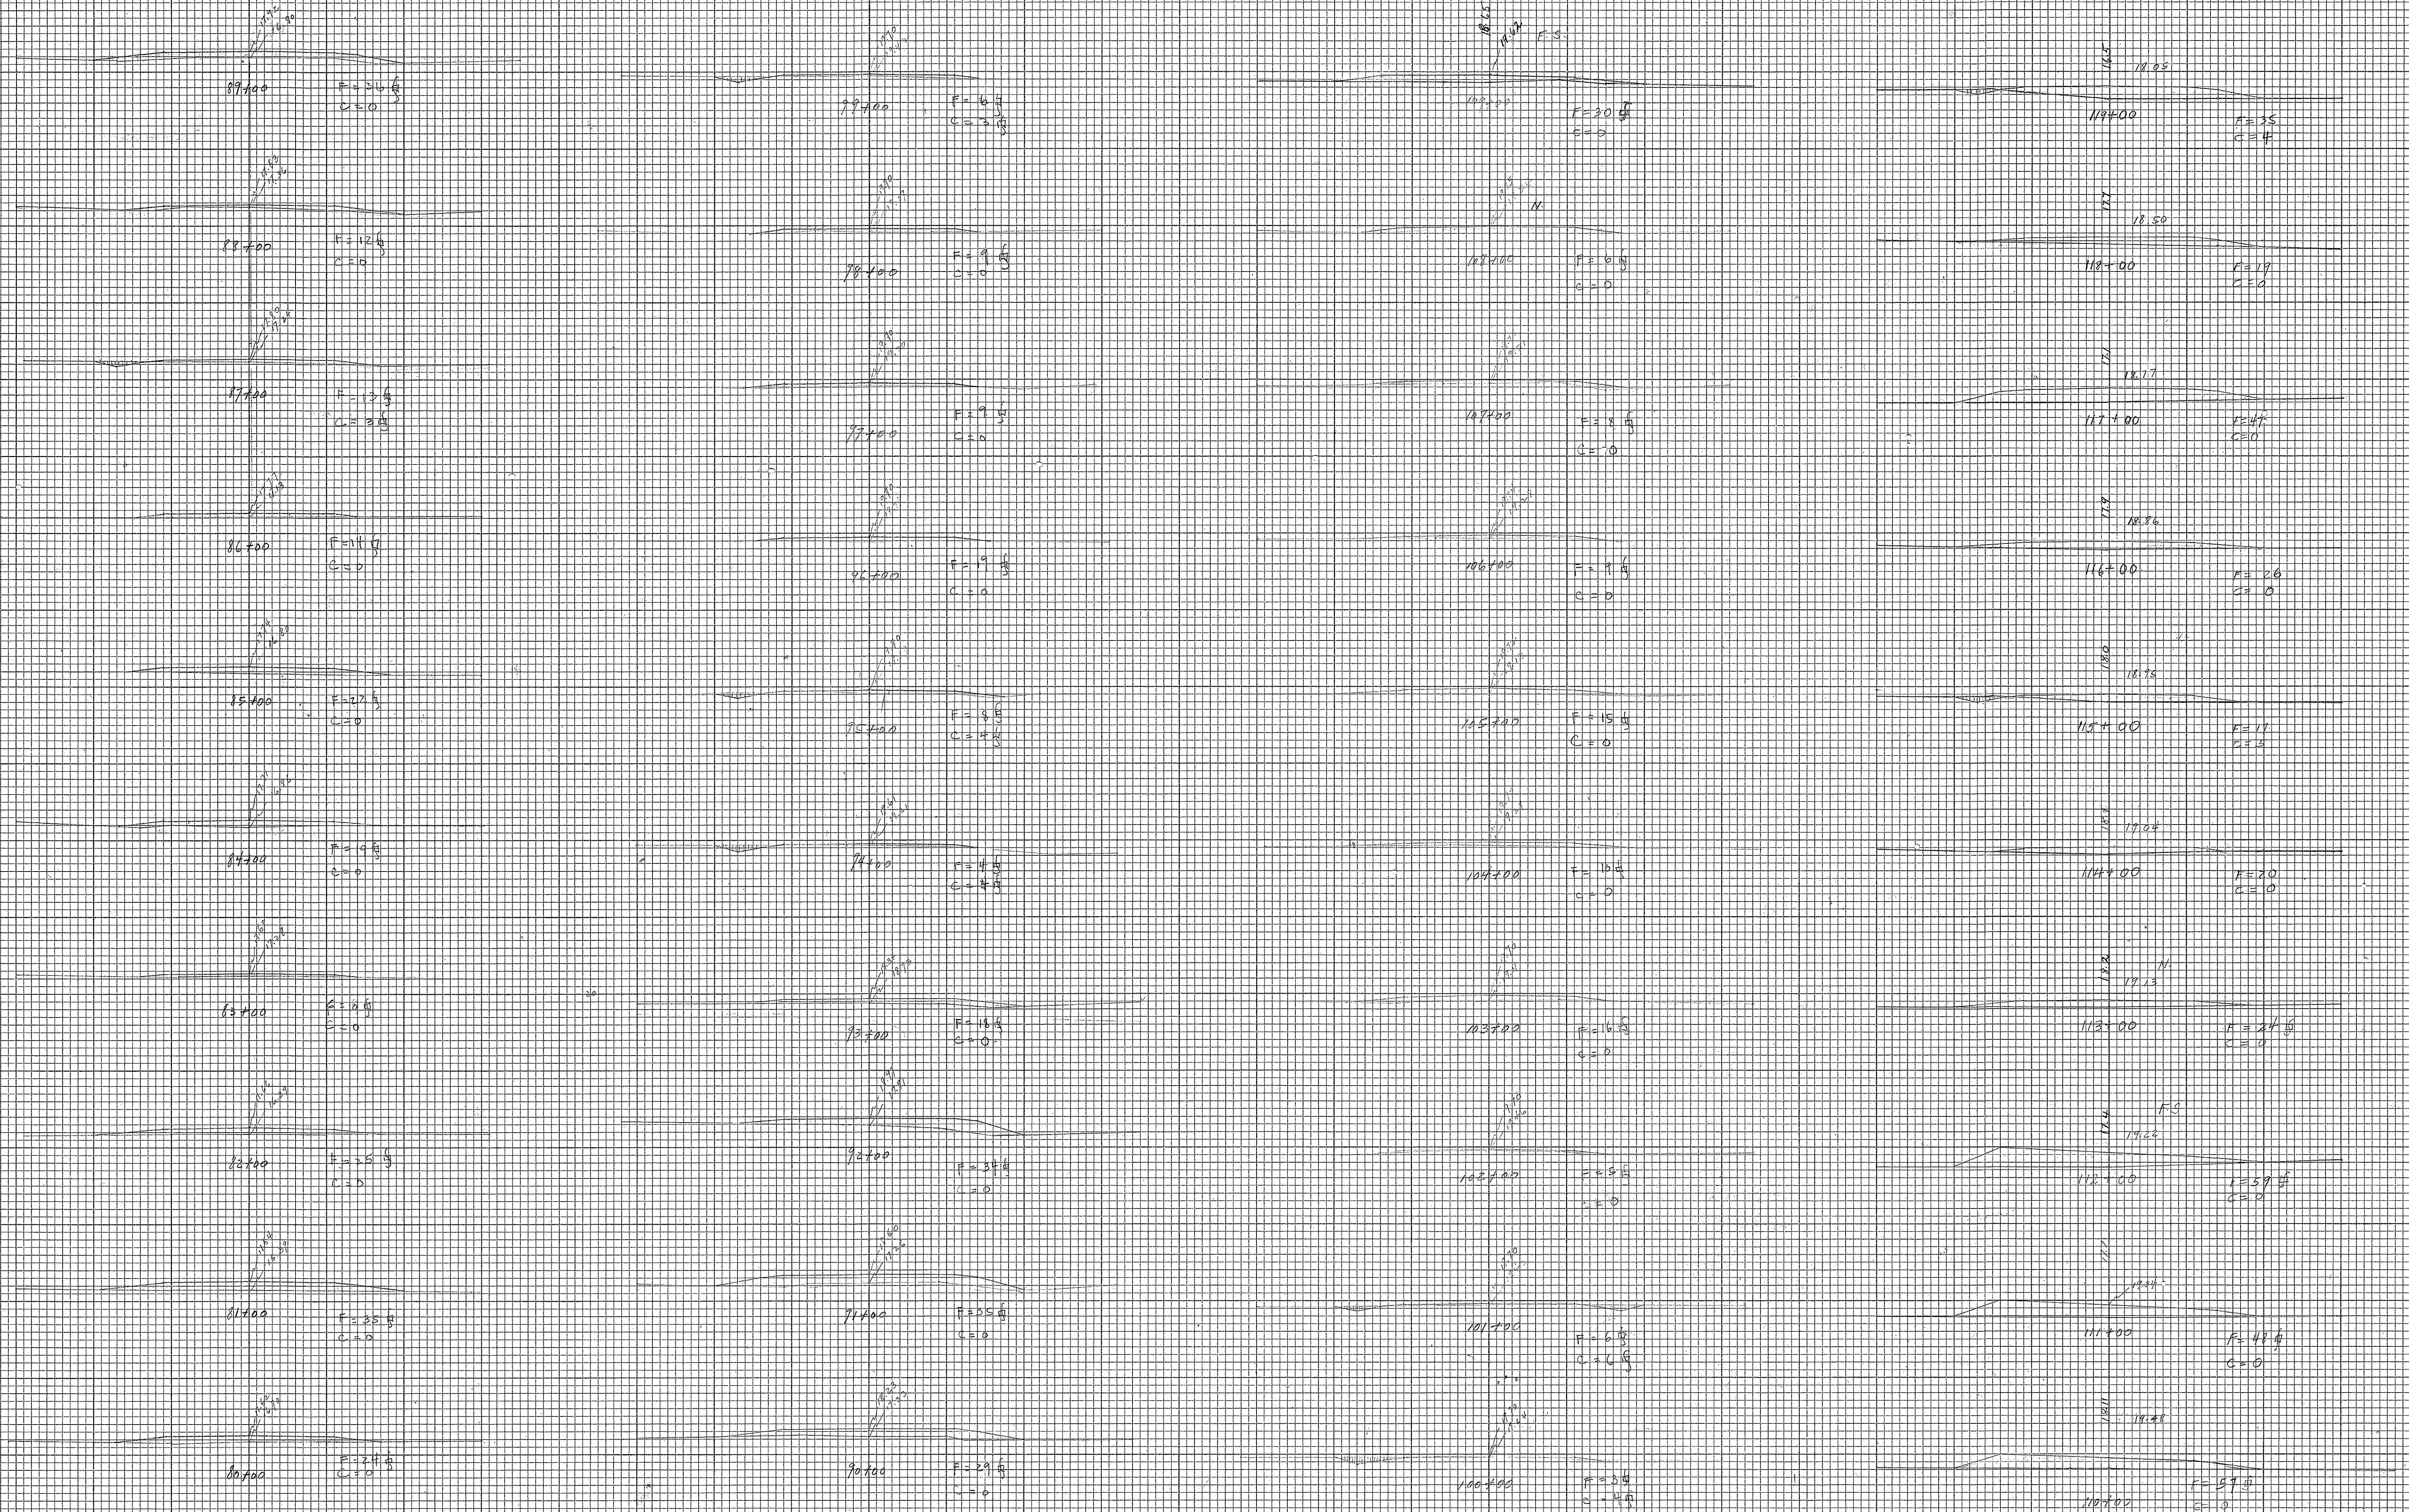

5133.12C

ORIGINAL SURVEY	SURVED _____	BY _____	DATE _____
NOTE BOOK	PLOTTED _____		
	TEMPLATE _____		
	AREAS _____		
NO. _____	AREAS CHECKED _____		

FED. ROAD DIST. NO.	STATE	FED. AID PROJECT NO.	FISCAL YEAR	SHEET NO.	COUNTY
Hawaii	HAWAII	DANIELSON	1944	12D	12

