

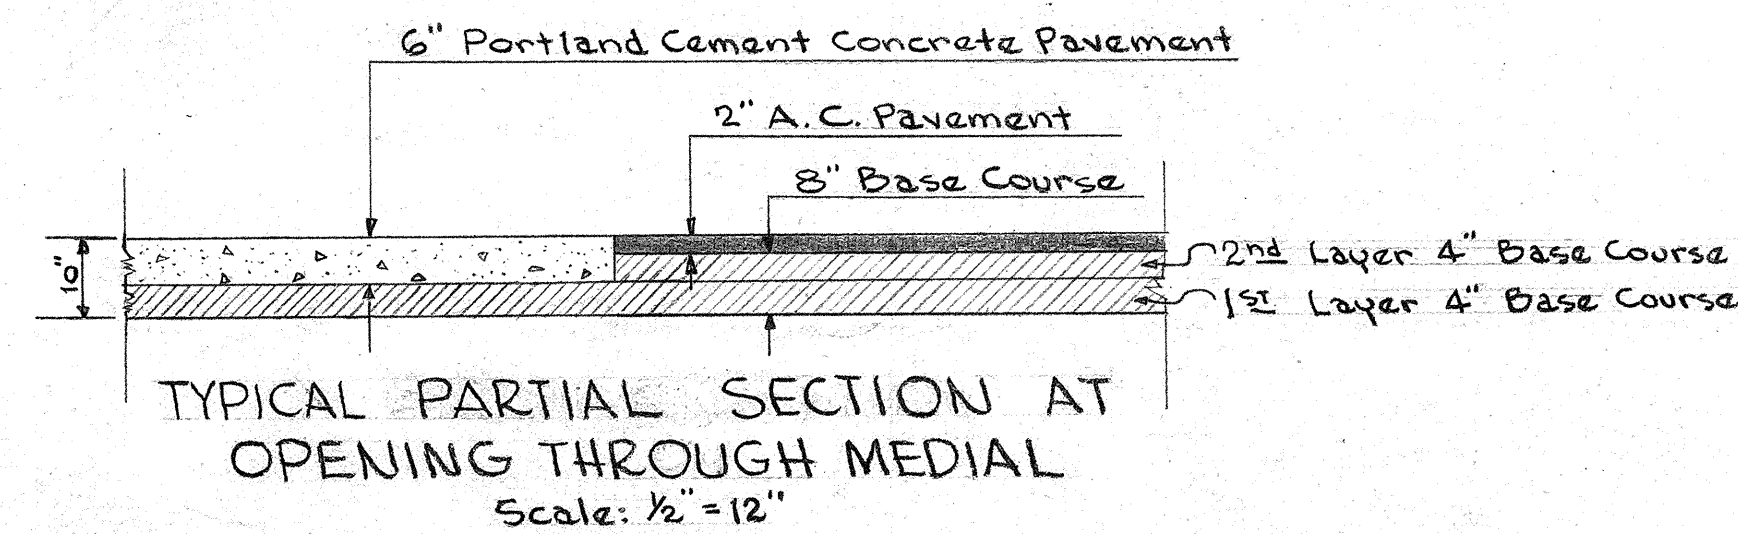
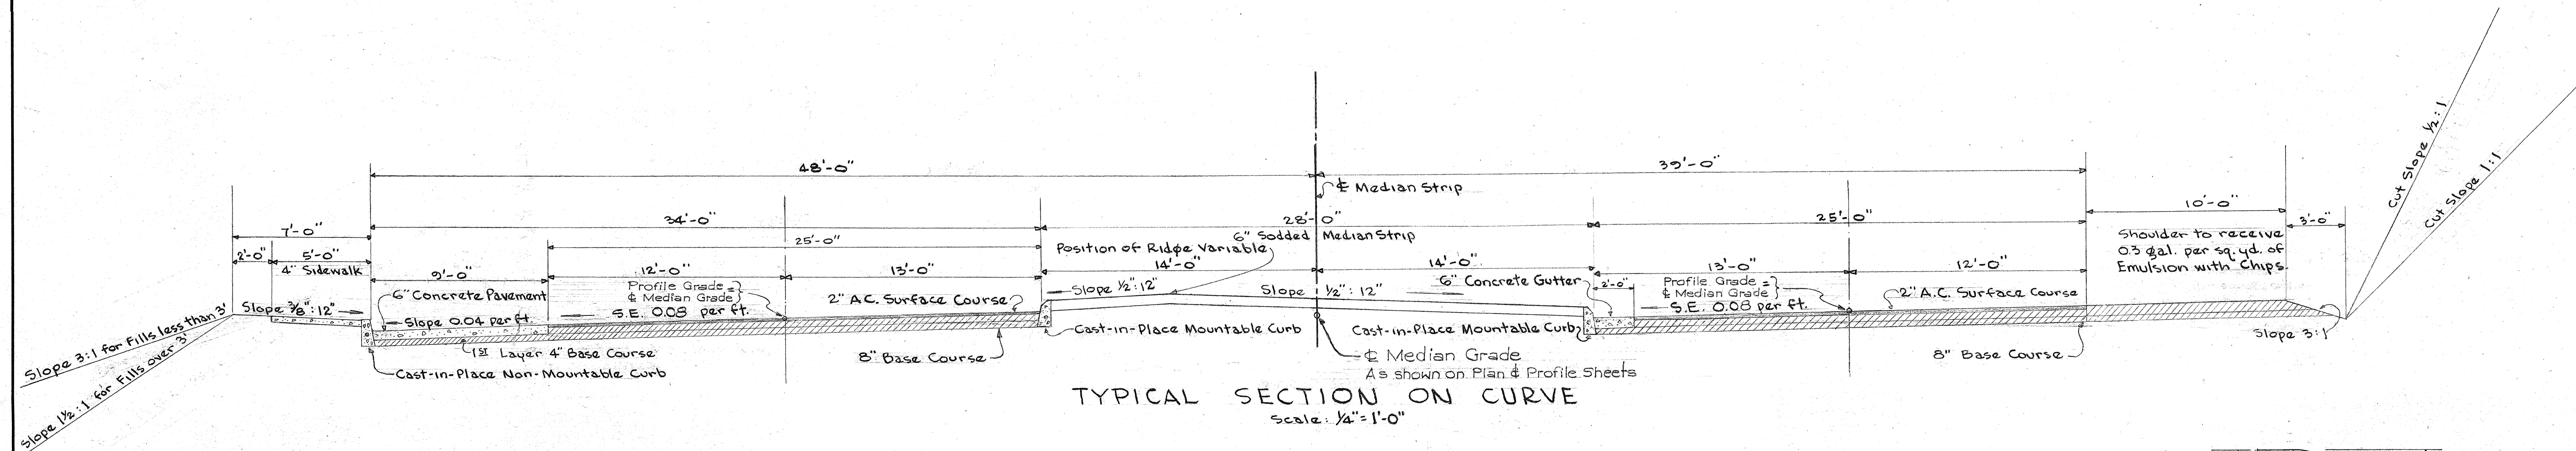


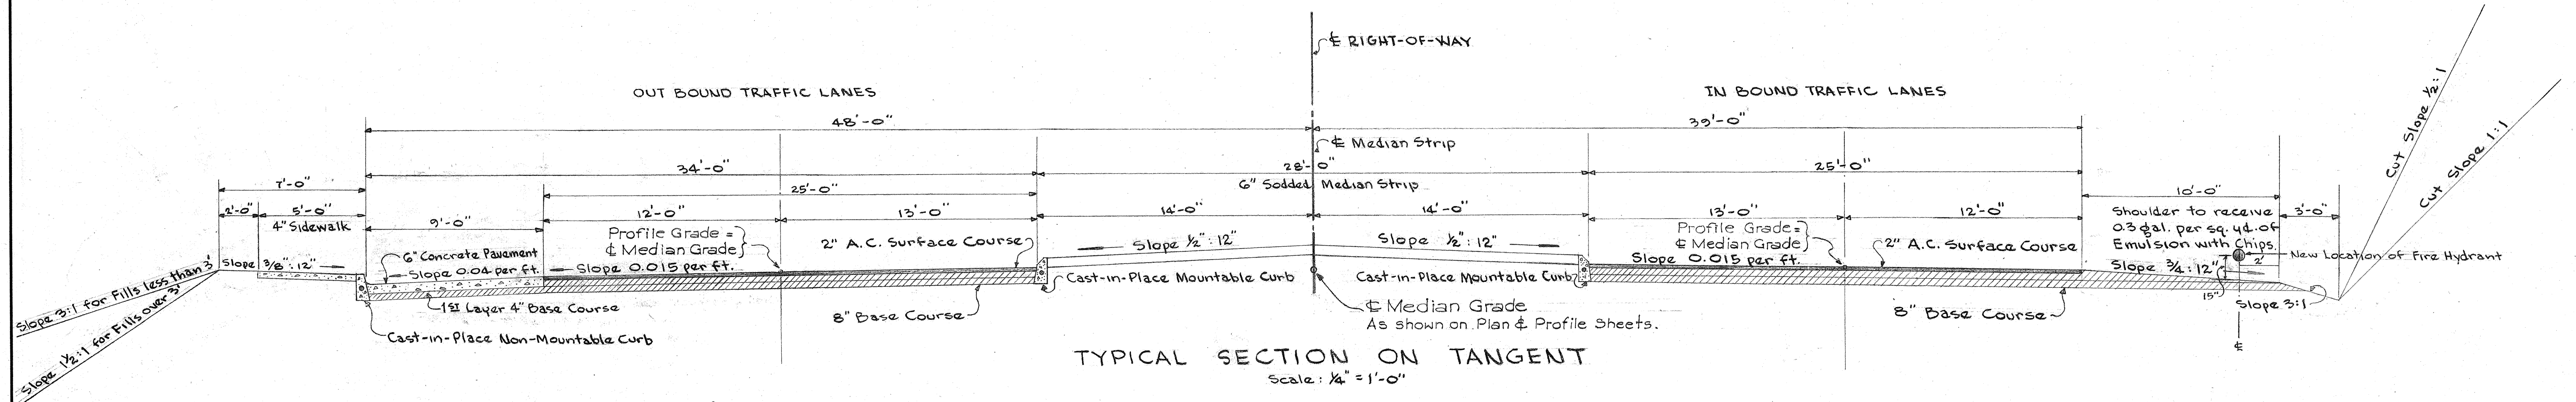


NOTE:
Curb is to be constructed on top of acceptably compacted sub-grade.

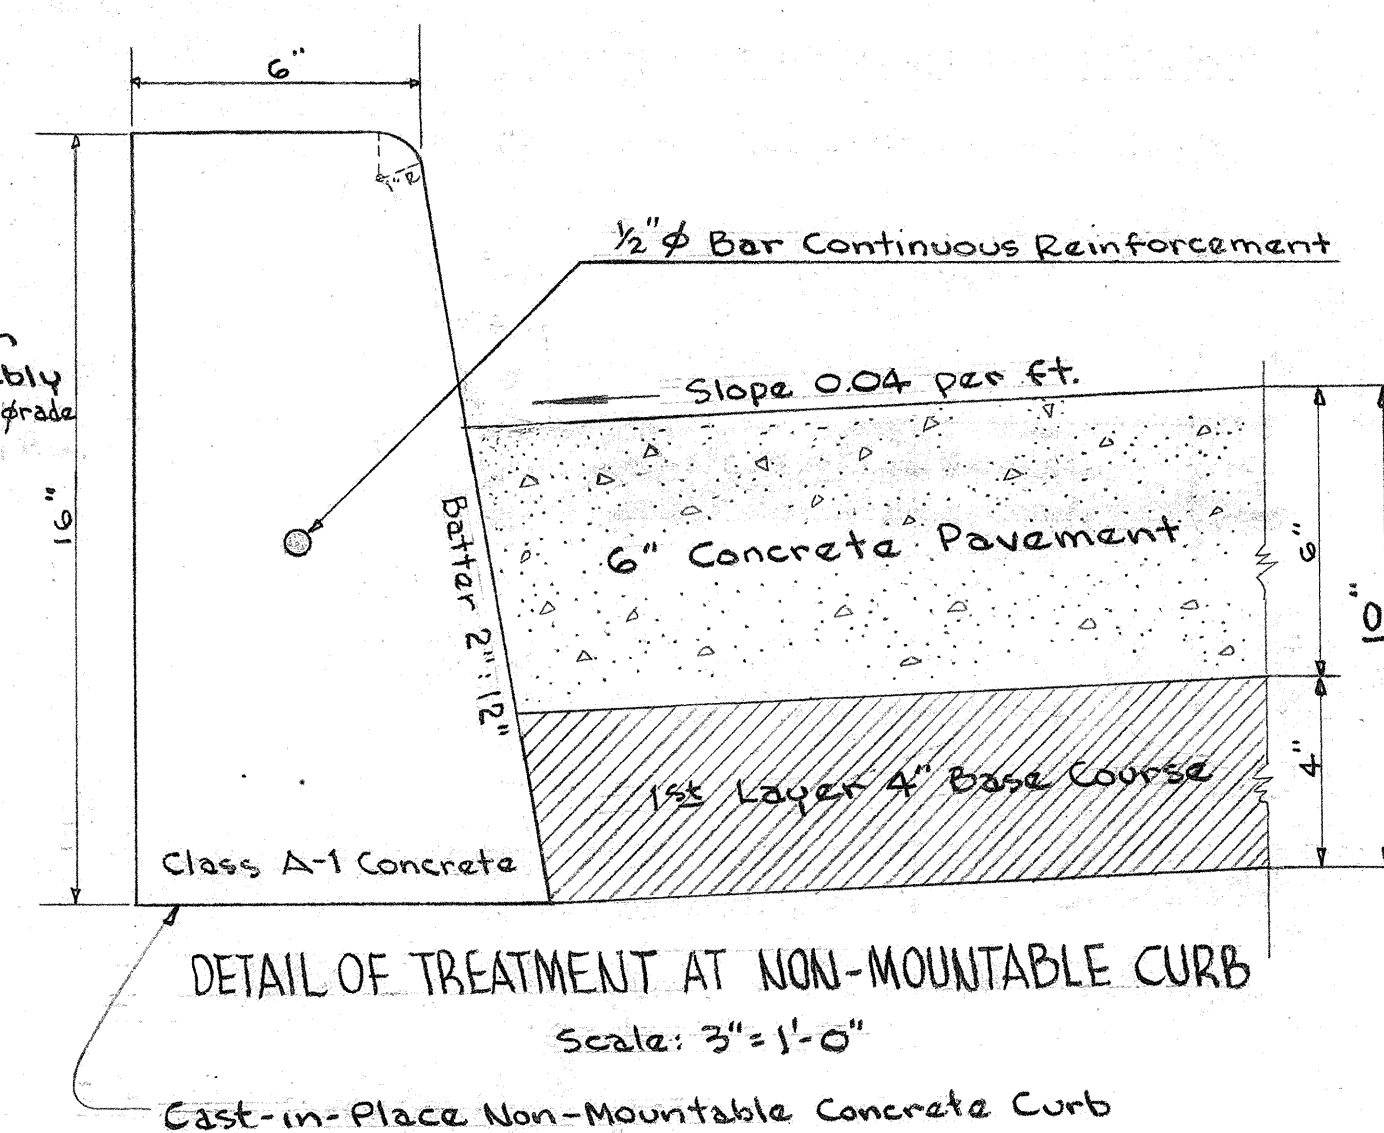

NOTE:
Both mountable and non-mountable types are to be paid for under the item of "Cast-in-Place Concrete Curb."

NOTE:
Curb is to be constructed on top of acceptably compacted sub-grade.

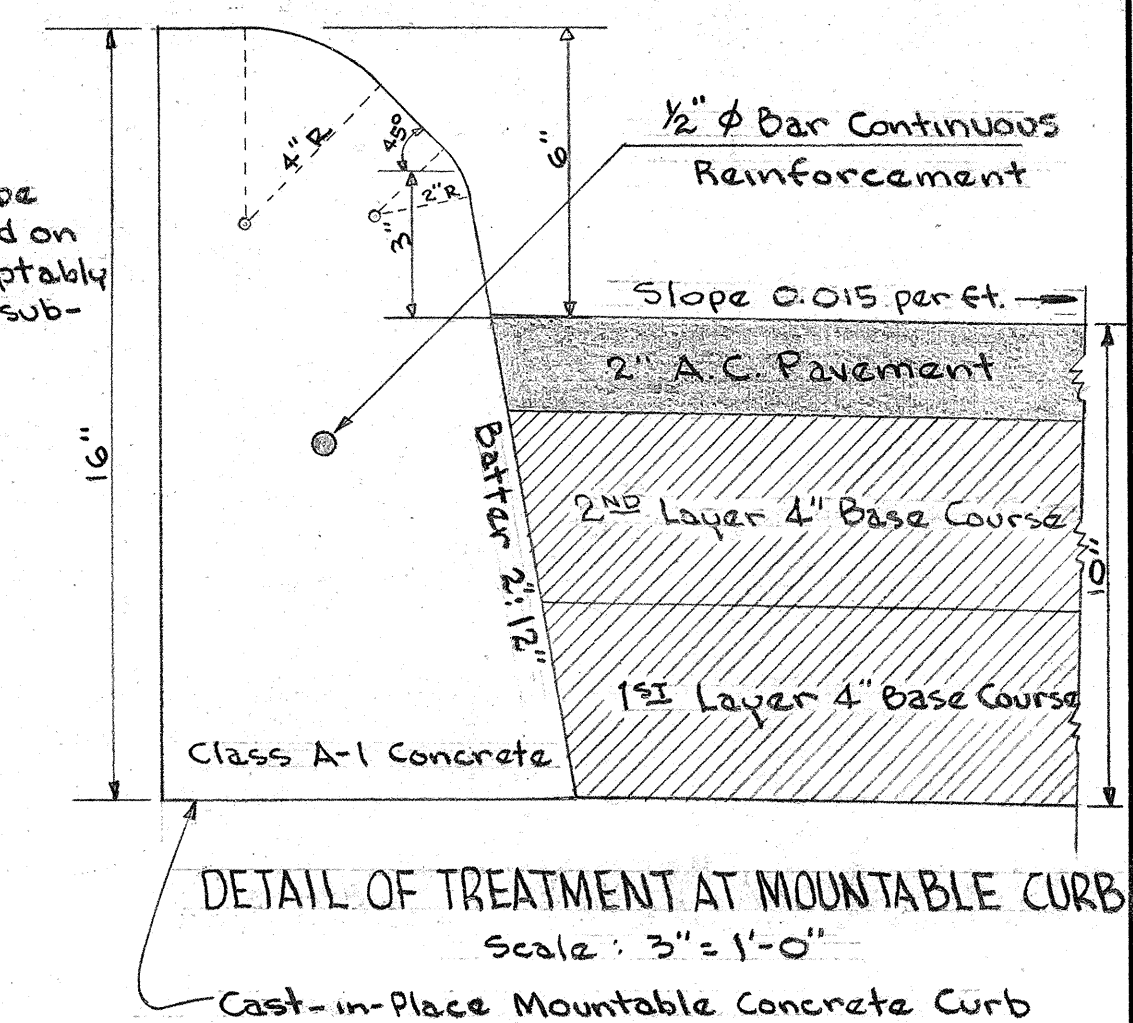

GENERAL NOTES:
PAVEMENTS: Asphalt concrete pavement shall be a surface course 2" thick when fully compacted. Use Mix III.
BASE COURSE: Base Course shall be waterbound macadam base course, 8" compacted thickness placed in two 4" layers.
PRIME COAT: A prime coat of liquid Asphaltic Primer shall be applied to the surface of base course at the rate of 0.35 gal. per sq. yd. before placing surface course.
PORTLAND CEMENT CONCRETE PAVEMENT: Portland Cement Concrete Pavement shall be laid at locations indicated on plans and shall be 6" thick without reinforcement. No longitudinal 'Contact Joints' are permitted - pavement shall be laid full width. Weakened Plane Joints shall be installed on approximately 30 ft. on centers. No Expansion Joints are required.

TERRITORIAL HIGHWAY DEPARTMENT
TERRITORY OF HAWAII
TYPICAL SECTIONS
MOANALUA ROAD
PROJECT No S 19 (2)
Scale: AS NOTED April 1948
SHEET No OF SHEETS

5329.2

SURVEY PLOTTED BY: DATE: _____
DESIGNED BY: _____
DRAWN BY: _____
CHECKED BY: _____
NOTE BOOK No. _____